

O.D.O.T. DISTRICT 2 SURVEY OFFICE (USE ONLY)

PERSONNEL

REFERENCE NO. 39 B

SHEET 10 OF 34

NOTES PRESTON-COLVIN

DATE 9-4-24

ROUTE US 6

H.C. NEISE

WEATHER SUNNY

COUNTY SANDUSKY

R.C. BARRIERE

TEMP. 70°

TOWNSHIP RILEY

SECTION 11

DWG BY PRESTON-COLVIN PID PAVING TRAIN

T 5 N R 16 E

TYPE MONUMENT P.K./WASHER

ON SURFACE - BELOW ON

OFFSET Q PAVEMENT ON LF : RT

12 TO RT EDGE PAVEMENT

STATION: 1341+85

HORIZ.DATUM: NAD83 (2011)


GEOID: NAVD88 2018

GRID: NORTHING: 634945.112


EASTING: 1837266.029

LDP: NORTHING: _____

EASTING: _____

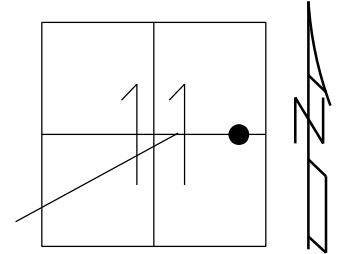

RECORD: P.T.
STA.1343+40.32
PREVIOUS MONUMENTS:
P.K./WASHER
SM.SPIKE/WASHER
FD P.K./WASHER
3/16/02, DCH
SET P.K./WASHER
6/10/02, DCH
FD P.K./WASHER
REFD39
11/22/17, DCH
SET MAG/WASHER
8-2-19, JLL
FD MAG/WASHER
2/10/22, JFO
1/20/23, JMR
DID NOT FIND
TIES DO NOT CROSS
DIG WHEN NEEDED
9-4-24, TDN

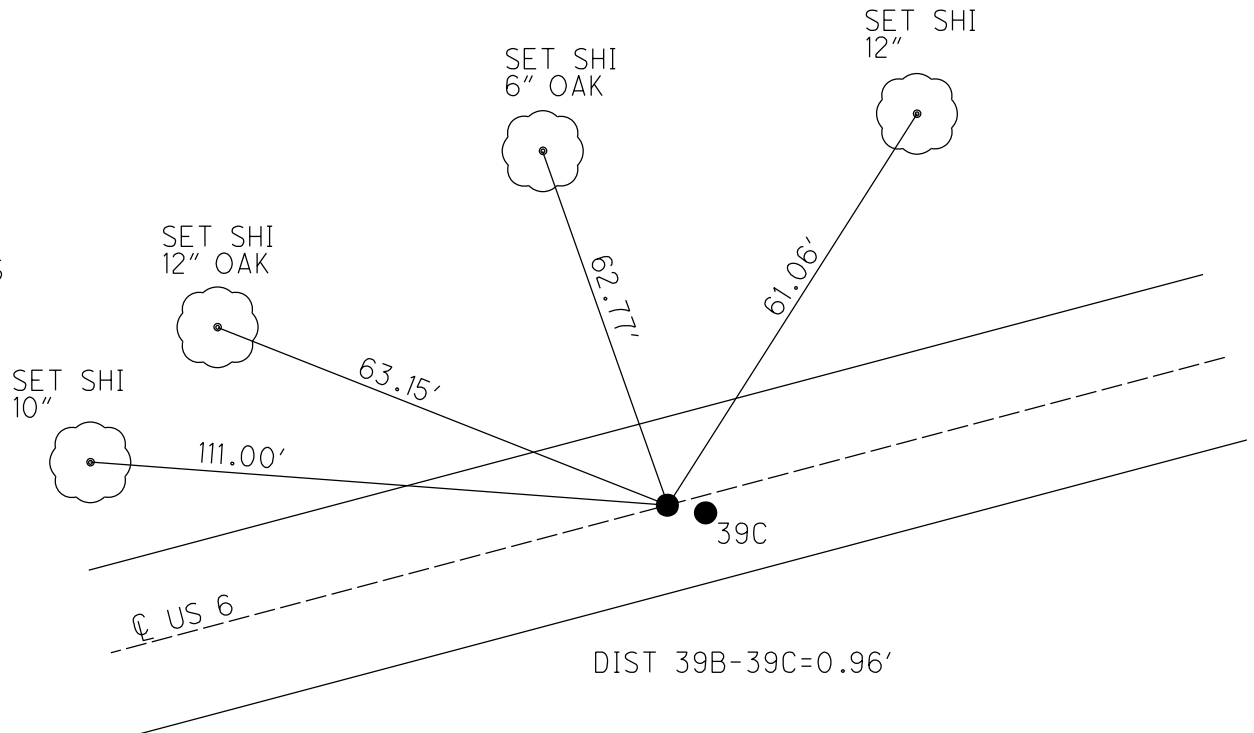

O.D.O.T. DISTRICT 2 SURVEY OFFICE (USE ONLY)

PERSONNEL

REFERENCE NO. 39 B

SHEET 10 OF 34

NOTES LEU

DATE 8/1/18

ROUTE US 6

H.C. LEU

WEATHER CLOUDY

COUNTY SANDUSKY

R.C. TRENKA

TEMP. 75°

TOWNSHIP RILEY

DWG BY AUBLE

PID PAVETRAIN

SECTION 11

T 5 N R 16 E

TYPE MONUMENT P.K./WASHER

ON SURFACE - ~~BELOW~~ ON

OFFSET CL PAVEMENT ON ~~LT~~ : ~~RT~~

12' TO RT EDGE PAVEMENT


STATION: 1341+85

HORZ.DATUM: NAD83 (2011)


GEOID: 2012A

GRID: NORTHING: 634945.112

EASTING: 1837266.029

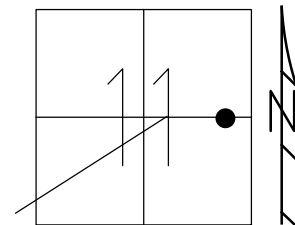

RECORD: P.T.
STA.1343+40.32
PREVIOUS MONUMENTS:
P.K./WASHER
SM.SPIKE/WASHER
FD P.K./WASHER
3/16/02, DCH
SET P.K./WASHER
6/10/02, DCH
FD P.K./WASHER
REFD39
11/22/17, DCH
SET MAG/WASHER
8-2-19, JLL
FD MAG/WASHER
2/10/22, JFO
1/20/23, JMR

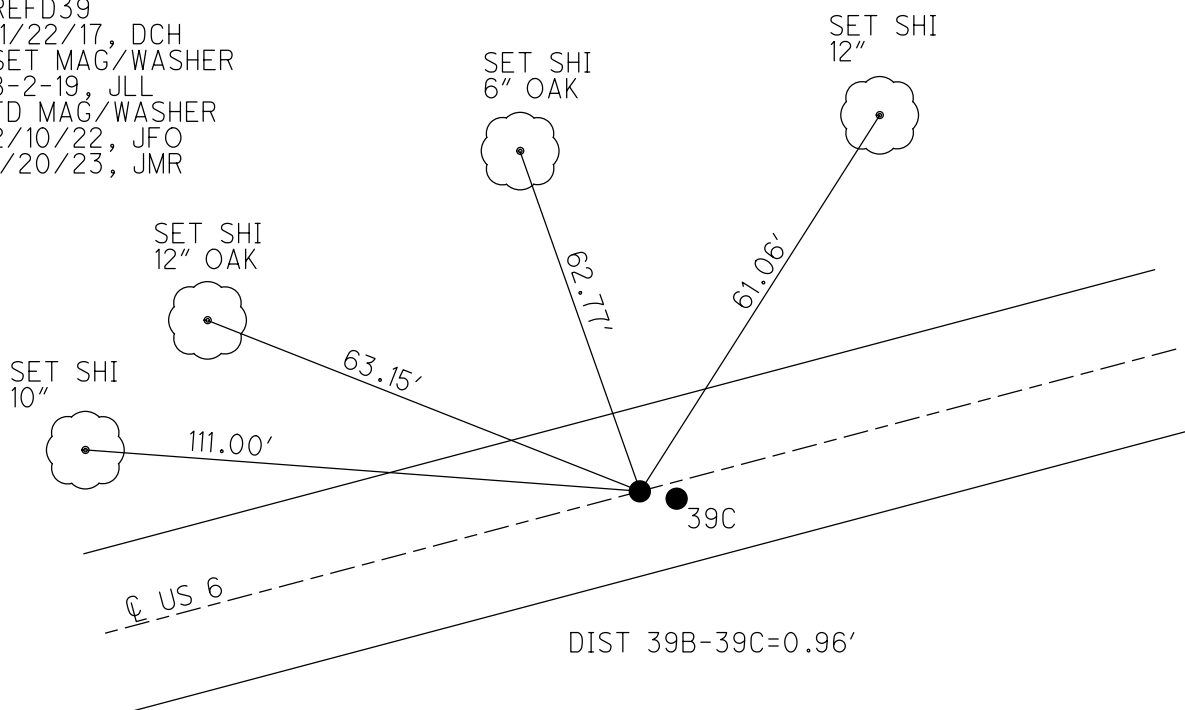

O.D.O.T. DISTRICT 2 SURVEY OFFICE (USE ONLY)

PERSONNEL

REFERENCE NO. 39 B

SHEET 10 OF 34

NOTES LEU

DATE 8/1/18

ROUTE US 6

H.C. LEU

WEATHER CLOUDY

COUNTY SANDUSKY

R.C. TRENKA

TEMP. 75°

TOWNSHIP RILEY

DWG BY AUBLE PID 95769

SECTION 11

T 5 N R 16 E

TYPE MONUMENT P.K./WASHER

ON SURFACE - ~~BELOW~~ ON

OFFSET CL PAVEMENT ON ~~LT~~ : ~~RT~~

12' TO RT EDGE PAVEMENT


STATION: 1341+85

HORZ.DATUM: NAD83 (2011)


GEOID: 2012A

GRID: NORTHING: 634945.112

EASTING: 1837266.029

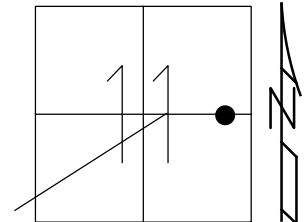

RECORD: P.T.
STA.1343+40.32
PREVIOUS MONUMENTS:
P.K./WASHER
SM.SPIKE/WASHER
FD P.K./WASHER
3/16/02, DCH
SET P.K./WASHER
6/10/02, DCH
FD P.K./WASHER
REFD39
11/22/17, DCH
SET MAG/WASHER
8-2-19, JLL
FD MAG/WASHER
2/10/22, JFO

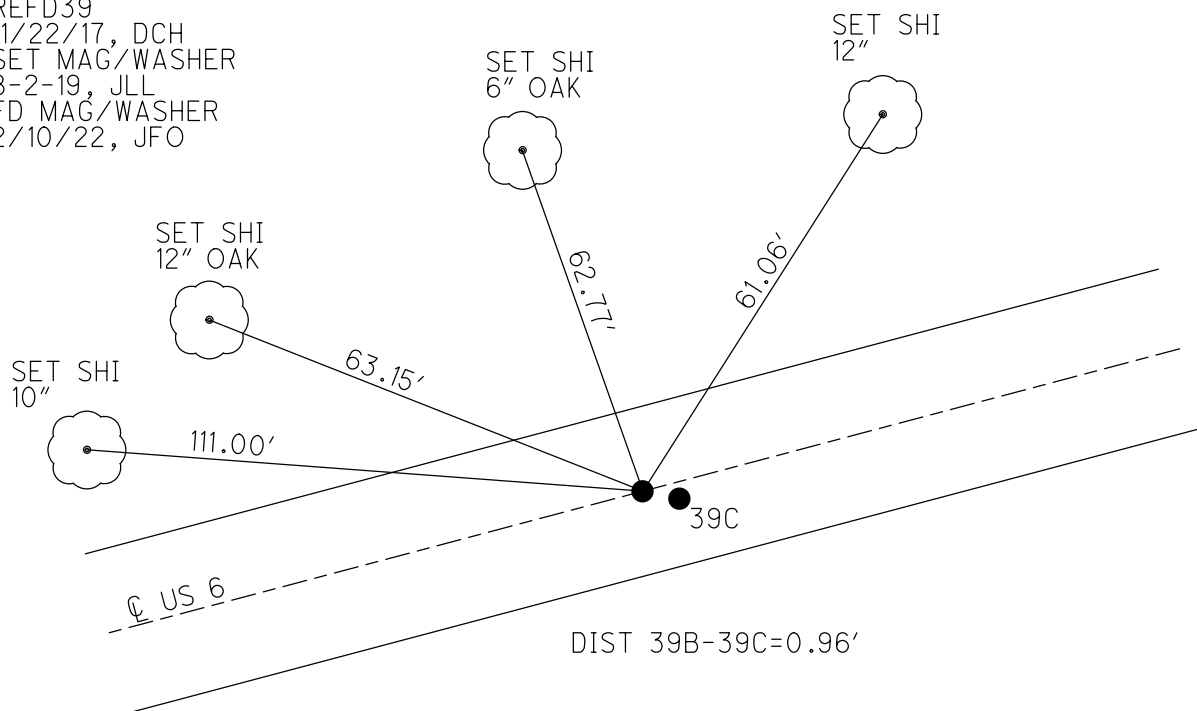

O.D.O.T. DISTRICT 2 SURVEY OFFICE (USE ONLY)

PERSONNEL

REFERENCE NO. 39 B

SHEET 10 OF 34

NOTES LEU

DATE 8/1/18

ROUTE US 6

H.C. LEU

WEATHER CLOUDY

COUNTY SANDUSKY

R.C. TRENKA

TEMP. 75°

TOWNSHIP RILEY

DWG BY AUBLE PID 95769

SECTION 11

T 5 N R 16 E

TYPE MONUMENT P.K./WASHER

ON SURFACE - ~~BELOW~~ ON

OFFSET Q PAVEMENT ON ~~LT~~ : ~~RT~~

12' TO RT EDGE PAVEMENT


STATION: 1341+85

HORZ.DATUM: NAD83 (2011)


GEOID: 2012A

GRID: NORTHING: 634945.112

EASTING: 1837266.029

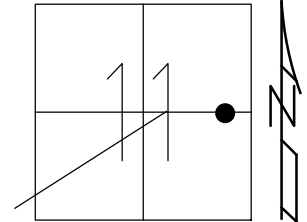



RECORD: P.T.
STA.1343+40.32
PREVIOUS MONUMENTS:
P.K./WASHER
SM.SPIKE/WASHER
FD P.K./WASHER
3/16/02, DCH
SET P.K./WASHER
6/10/02, DCH
FD P.K./WASHER
REFD39
11/22/17, DCH
SET MAG/WASHER
8-2-19, JLL

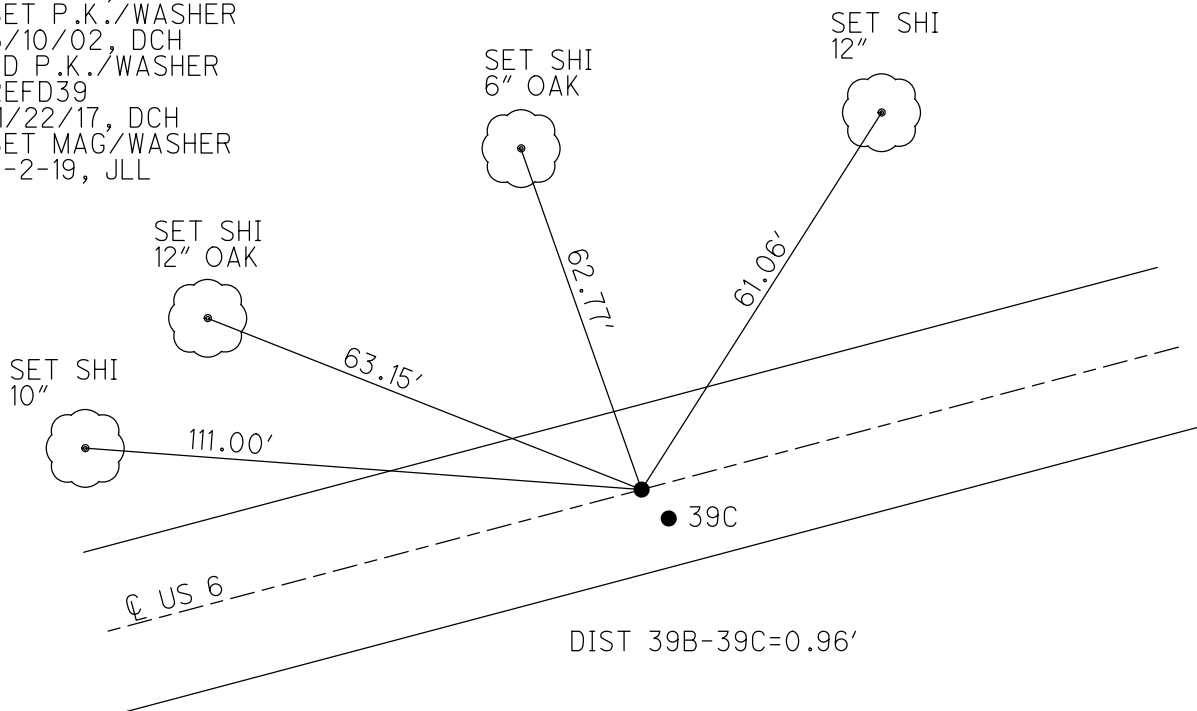

O.D.O.T. DISTRICT 2 SURVEY OFFICE (USE ONLY)

PERSONNEL _____ REFERENCE NO. 39 B SHEET 9 OF 31
 NOTES _____ DATE 03/16/02 ROUTE US 6
 H.C. VAN DUSEN WEATHER WINDY COUNTY SANDUSKY
 R.C. MOSSER TEMP. 28° TOWNSHIP RILEY
 _____ HUMAN _____ SECTION 11
 _____ T 5 N R 16 E

TYPE MONUMENT _____ PK/WASHER _____
 ON SURFACE - ~~BELOW~~ _____ ON _____
~~LEFT~~ - Q PAV'T - ~~RIGHT~~ _____ ON _____
12.0" TO RT EDGE PAVEMENT
 S.L.M. _____ 1341+85
 GRID: NORTHING: _____ EASTING: _____

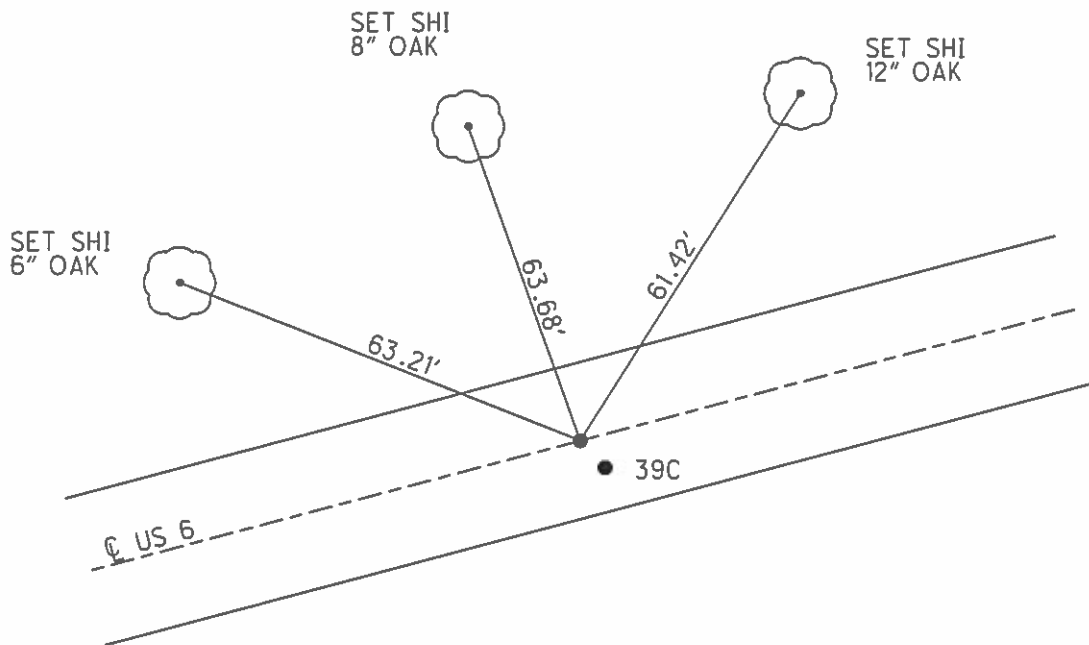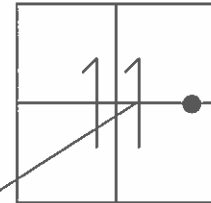

RECORD:
 PT CONST 1343+40.32
 SAN 6 (22.64)(25.02)
 PREVIOUS MONUMENTS
 PK/WASHER
 SM SPK/WASHER
 SET PK/WASHER
 06/10/02 DCH
 DIST 39B-39C=0.95'

O.D.O.T. DISTRICT 2 SURVEY OFFICE

PERSONNEL

NOTES ROUSOS
H.C. VAN DUSEN
R.C. MOSSER
HOMAN

REFERENCE NO. 39-B

DATE 3/16/02
WEATHER WINDY
TEMP. 28°

SHEET 8 OF 27

ROUTE SR 6
COUNTY SANDUSKY
TOWNSHIP RILEY
SECTION 11
T 5 N R 16 E


TYPE MONUMENT PK'S & WASHERS

ON SURFACE - BELOW ON

~~LEFT - C PAV'T - RIGHT~~ "A" ON "B" 1.0' RT


TO EDGE PAVEMENT "A" 12' TO RT EDGE
"B" 11' TO RT EDGE

S.L.M. 1341+85

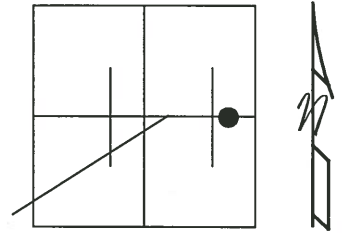

"A"
P.T. CONST 1343+40.32
SAN 6 (22.64)(25.02)
PREVIOUS MONUMENTS
PK/WASHER
SM. SPK/WASHER

SET PK'S & WASHER'S
6-10-02
DCH

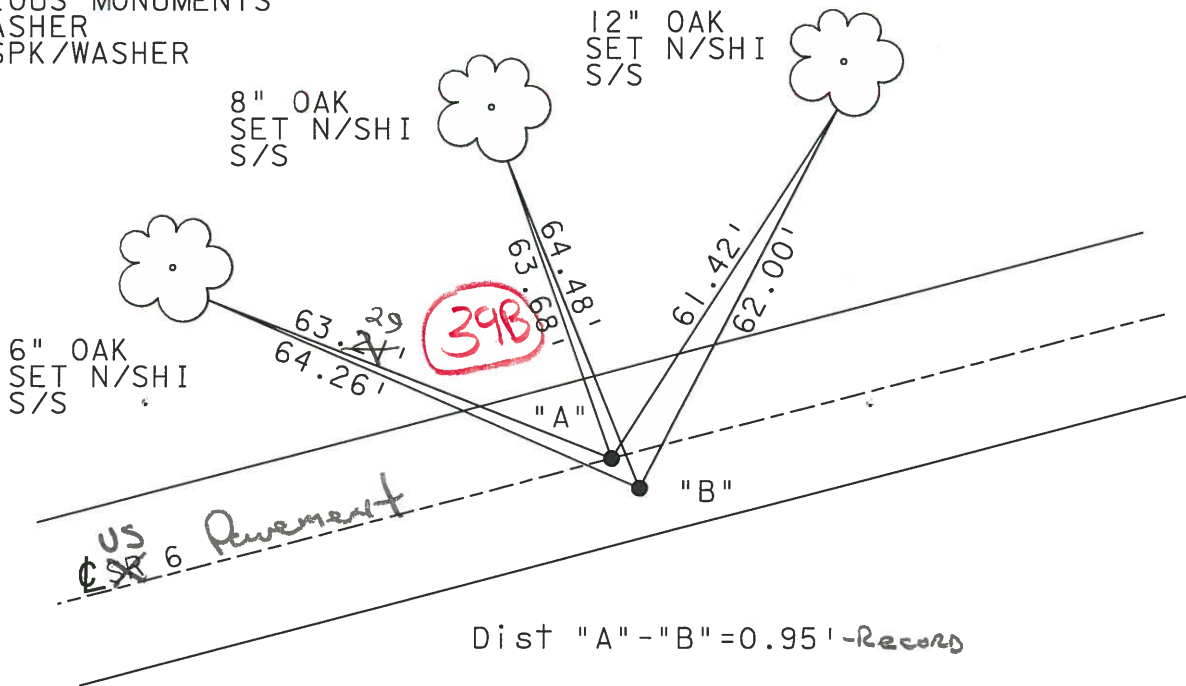

Dist "A" - "B" = 0.95' - Record

"B"
P.T. SURVEY & R/W 1343+40.12
SAN 6 (22.64)(25.02)
OLD STA 101+22.47
PREVIOUS MONUMENTS
PK/WASHER
SM. SPK/WASHER