

O.D.O.T. DISTRICT 2 SURVEY OFFICE (USE ONLY)

PERSONNEL

REFERENCE NO. 41

SHEET 13 OF 34

NOTES PRESTON-COLVIN

DATE 9-4-24

ROUTE US 6

H.C. NEISE

WEATHER SUNNY

COUNTY SANDUSKY

R.C. BARRIERE

TEMP. 78°

TOWNSHIP RILEY

SECTION 12

DWG BY PRESTON-COLVIN PID PAVING TRAIN

T 5 N R 16 E

TYPE MONUMENT MEG/WASHER

~~ON SURFACE~~ - BELOW 1.5"

OFFSET $\odot$ PAVEMENT 0.6' LT : ~~RT~~

- TO - EDGE PAVEMENT

STATION: 1383+29

HORIZ.DATUM: NAD83 (2011)


GEOID: NAVD88 2018

GRID: NORTHING: 635077.737


EASTING: 1841414.113

LDP: NORTHING: 331352.9

EASTING: 201543

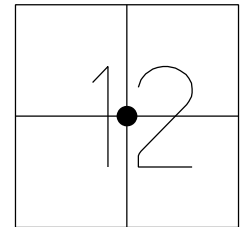

RECORD: P.I.
STA.1421+75.98
PREVIOUS MONUMENTS:
P.K./WASHER
R.R.SPIKE
FD P.K./WASHER
3/16/02, DCH
SET P.K./WASHER
6/10/02, DCH
FD P.K./WASHER
REF41
11/22/17, DCH
SET MAG/WASHER
8-2-19, JLL
FD MAG/WASHER
2/10/22, JFO
1/20/23, JMR
FD MEG/WASHER
REF41
9-4-24, TDN
REMOVED &
SET NEW
MEG/WASHER
1" DOWN
FD MEG/WASHER
10/3/24, JAM
1" DOWN

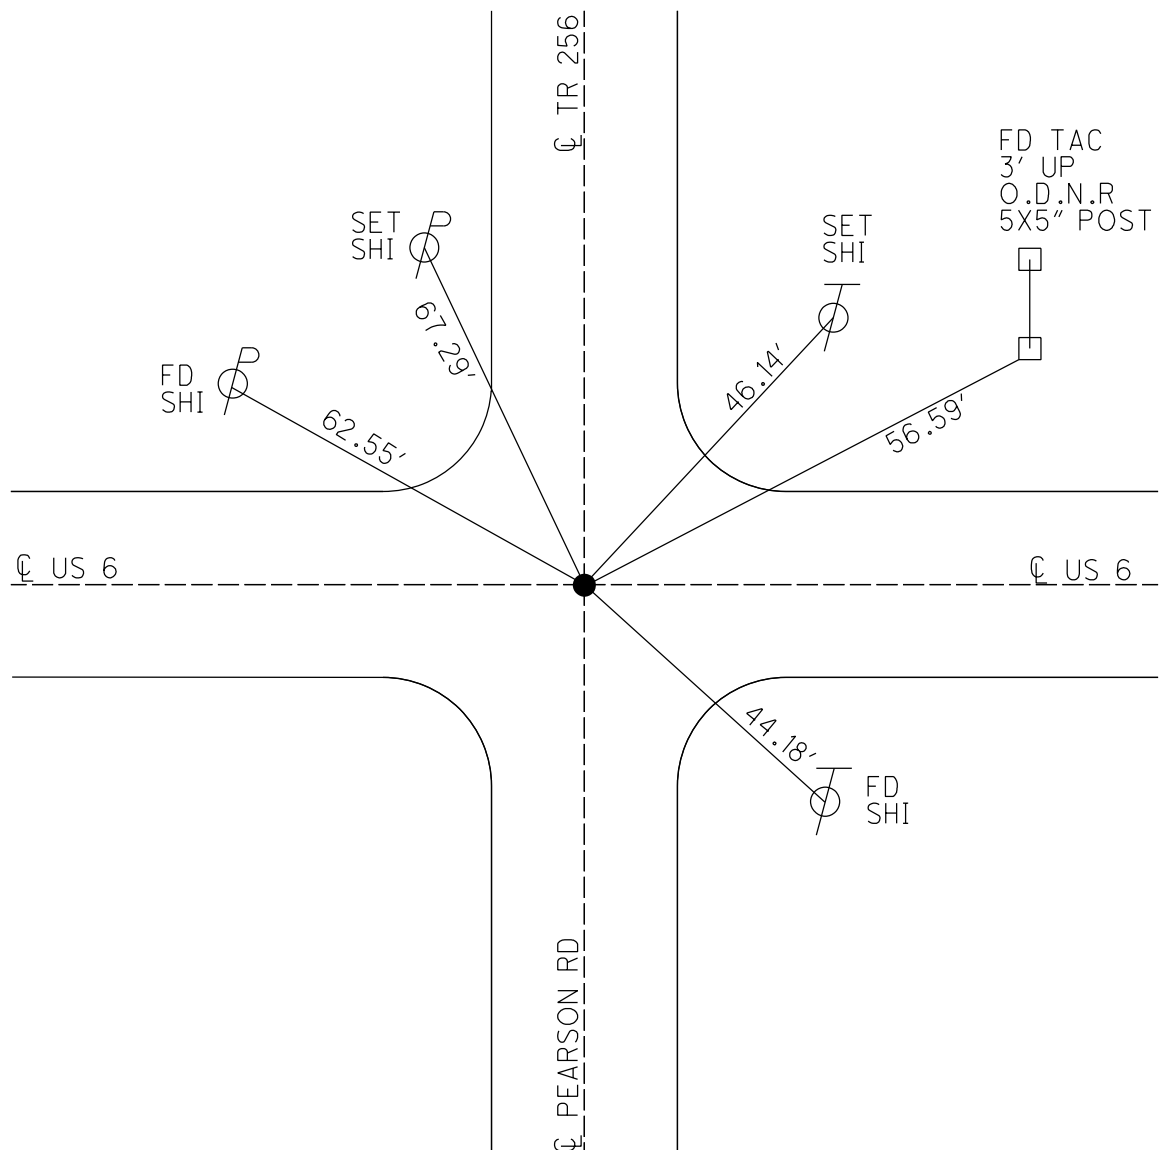

O.D.O.T. DISTRICT 2 SURVEY OFFICE (USE ONLY)

PERSONNEL

REFERENCE NO. 41

SHEET 13 OF 34

NOTES LEU

DATE 8/1/18

ROUTE US 6

H.C. LEU

WEATHER CLOUDY

COUNTY SANDUSKY

R.C. TRENKA

TEMP. 76°

TOWNSHIP RILEY

DWG BY AUBLE

PID PAVETRAIN

SECTION 12

T 5 N R 16 E

TYPE MONUMENT P.K./WASHER

~~ON SURFACE~~ - BELOW 1 1/2"

OFFSET CL PAVEMENT 0.6' LT : ~~RT~~

- TO - EDGE PAVEMENT



STATION: 1383+29

HORZ.DATUM: NAD83 (2011)

GEOID: 2012A

GRID: NORTHING: 635077.737

EASTING: 1841414.113

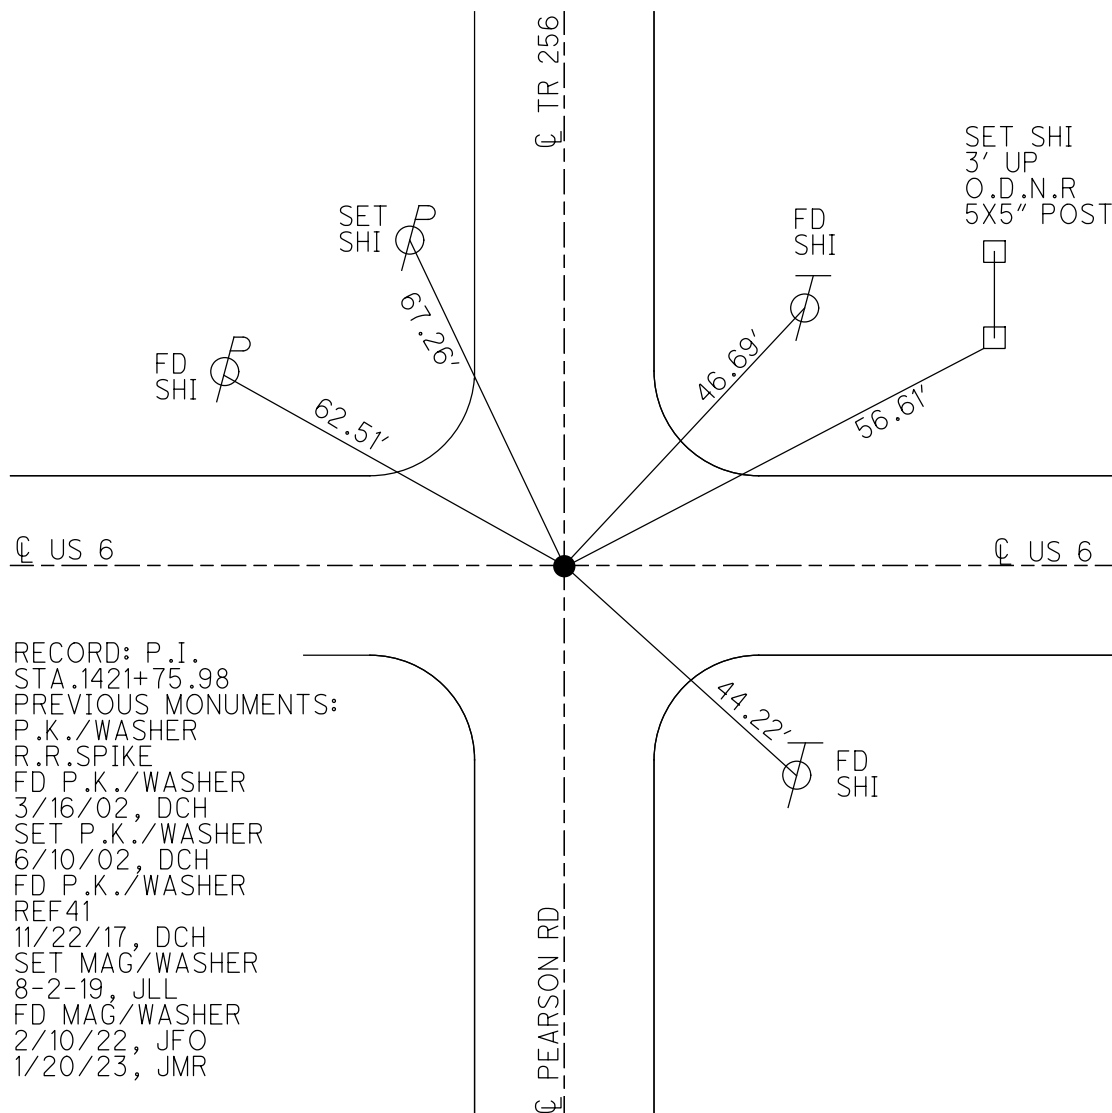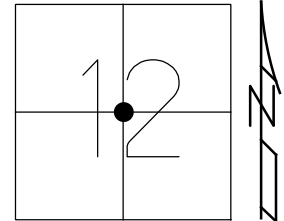

O.D.O.T. DISTRICT 2 SURVEY OFFICE (USE ONLY)

PERSONNEL

REFERENCE NO. 41

SHEET 13 OF 34

NOTES LEU

DATE 8/1/18

ROUTE US 6

H.C. LEU

WEATHER CLOUDY

COUNTY SANDUSKY

R.C. TRENKA

TEMP. 76°

TOWNSHIP RILEY

SECTION 12

DWG BY AUBLE PID 95769

T 5 N R 16 E

TYPE MONUMENT P.K./WASHER

~~ON SURFACE~~ - BELOW 1 1/2"

OFFSET CL PAVEMENT 0.6' LT : ~~RT~~

- TO - EDGE PAVEMENT



STATION: 1383+29

HORIZ.DATUM: NAD83 (2011)

GEOID: 2012A

GRID: NORTHING: 635077.737

EASTING: 1841414.113

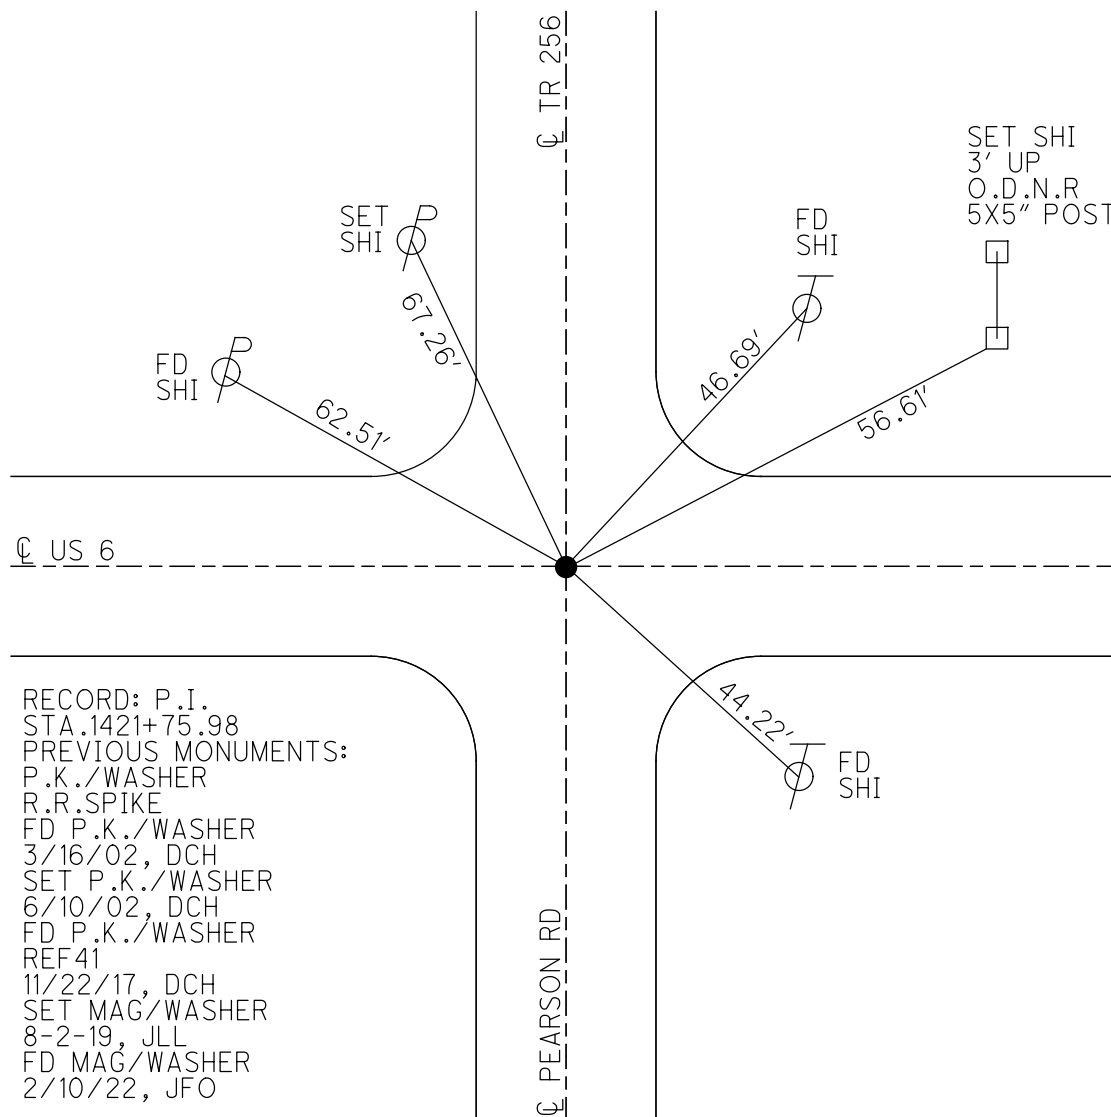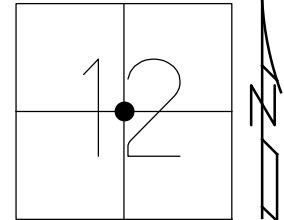

RECORD: P.I.
STA.1421+75.98
PREVIOUS MONUMENTS:
P.K./WASHER
R.R.SPIKE
FD P.K./WASHER
3/16/02, DCH
SET P.K./WASHER
6/10/02, DCH
FD P.K./WASHER
REF41
11/22/17, DCH
SET MAG/WASHER
8-2-19, JLL
FD MAG/WASHER
2/10/22, JFO

O.D.O.T. DISTRICT 2 SURVEY OFFICE (USE ONLY)

PERSONNEL

REFERENCE NO. 41

SHEET 13 OF 34

NOTES LEU

DATE 8/1/18

ROUTE US 6

H.C. LEU

WEATHER CLOUDY

COUNTY SANDUSKY

R.C. TRENKA

TEMP. 76°

TOWNSHIP RILEY

SECTION 12

DWG BY AUBLE

PID 95769

T 5 N R 16 E

TYPE MONUMENT P.K./WASHER

~~ON SURFACE~~ - BELOW 1 1/2"

OFFSET Q PAVEMENT 0.6' LT : ~~RT~~

- TO - EDGE PAVEMENT



STATION: 1383+29

HORZ.DATUM: NAD83 (2011)

GEOID: 2012A

GRID: NORTHING: 635077.737

EASTING: 1841414.113

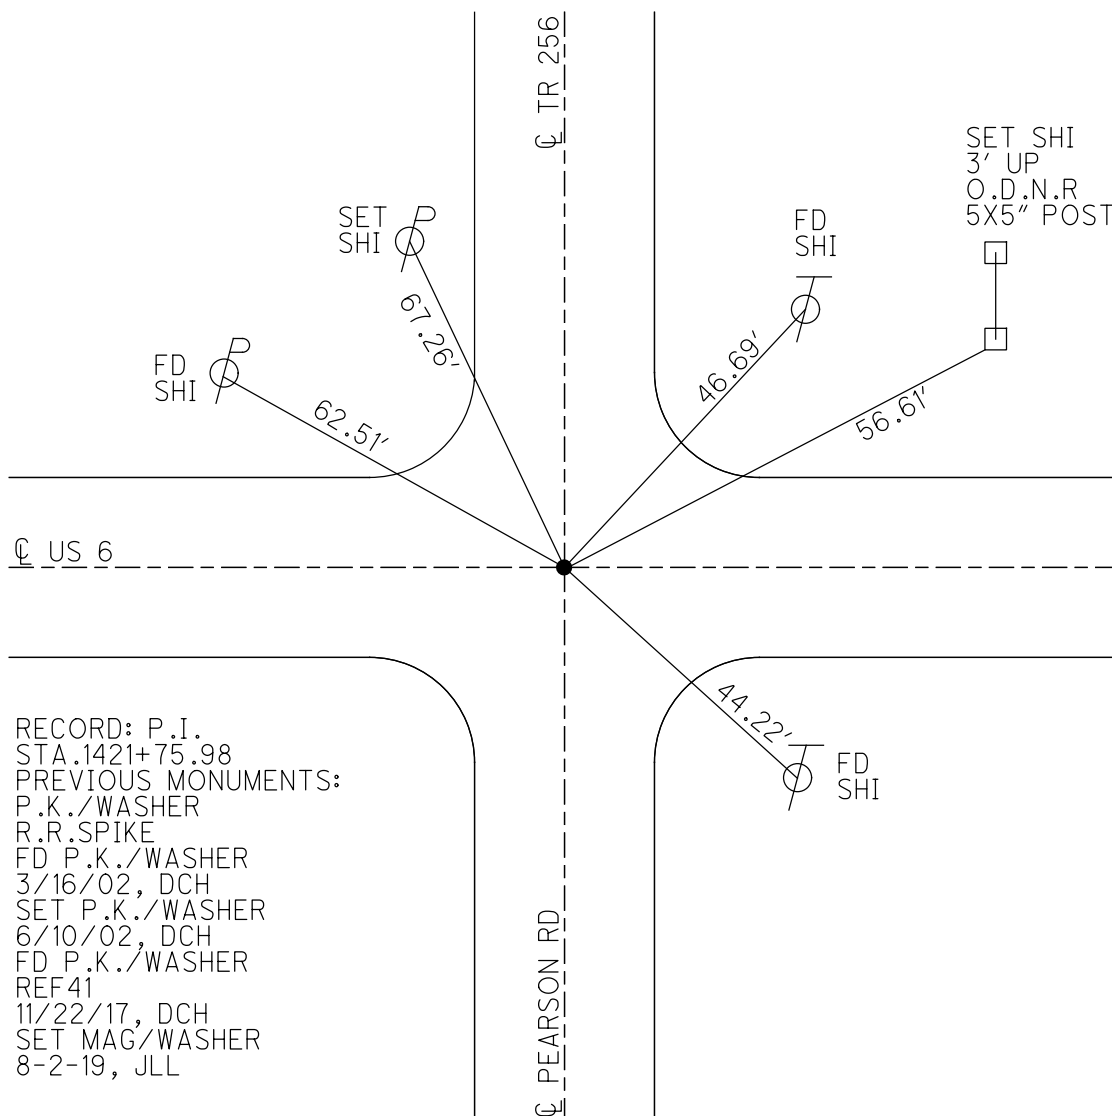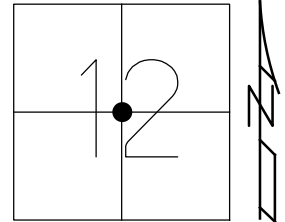

O.D.O.T. DISTRICT 2 SURVEY OFFICE (USE ONLY)

PERSONNEL

REFERENCE NO. 41

SHEET 12 OF 31

NOTES

ROUSOS

DATE

03/16/02

ROUTE

US 6

H.C.

VAN DUSEN

WEATHER

WINDY

COUNTY

SANDUSKY

R.C.

MOSSER

TEMP.

28°

TOWNSHIP

RILEY

HOMAN

SECTION

12

T 5 N R 16 E

TYPE MONUMENT

PK/WASHER

ON SURFACE - ~~BELOW~~

ON

LEFT - Q PAV'T - ~~RIGHT~~

1.0'

- TO - EDGE PAVEMENT

S.L.M.



1383+29

GRID: NORTHING:

-

EASTING:

-

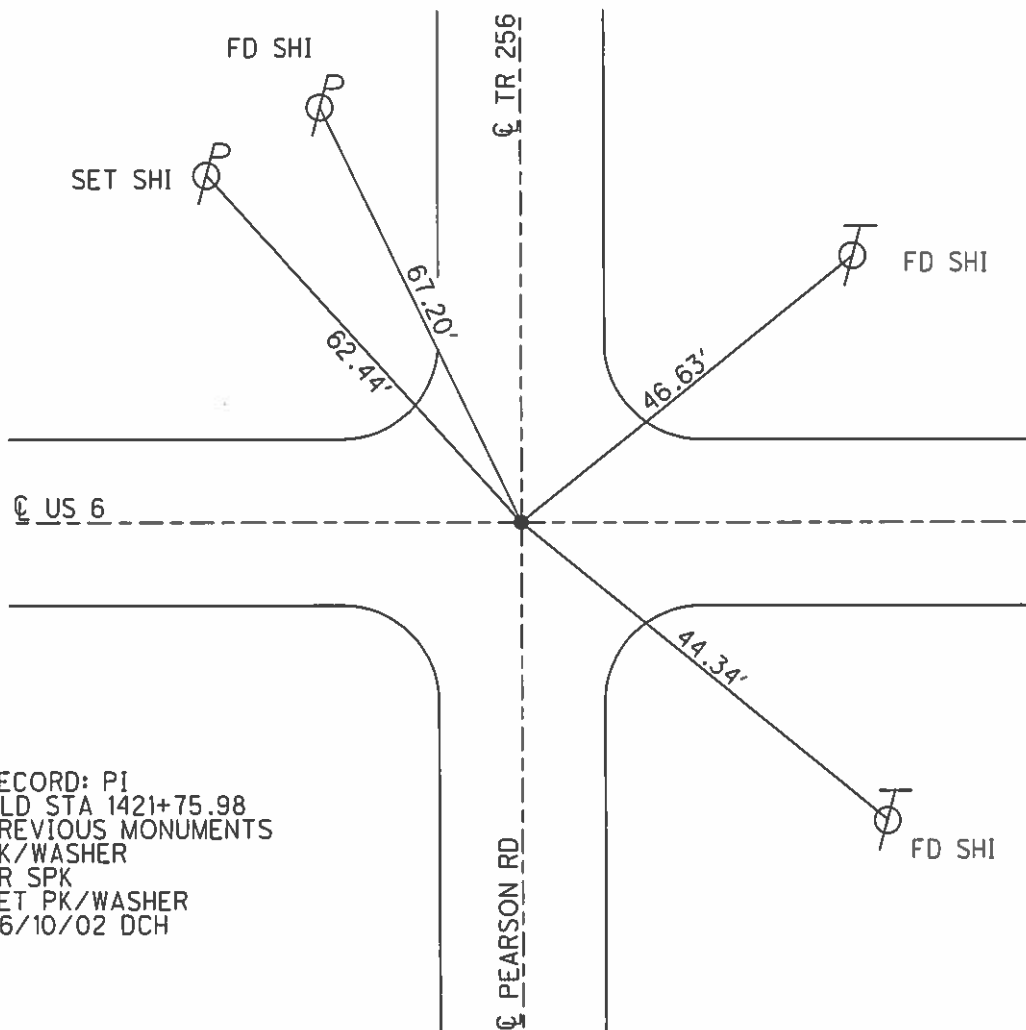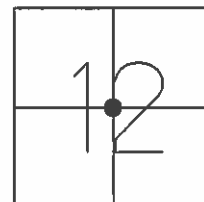

RECORD: PI
OLD STA 1421+75.98
PREVIOUS MONUMENTS
PK/WASHER
RR SPK
SET PK/WASHER
06/10/02 DCH

O.D.O.T. DISTRICT 2 SURVEY OFFICE

PERSONNEL

REFERENCE NO. 41

SHEET 22 OF 39

NOTES CHENEY

H.C. RIPPLE

R.C. BARBOUR

DATE 9-16-1991

WEATHER SUNNY

TEMP. 85°

ROUTE 6

COUNTY SANDUSKY

TOWNSHIP RILEY

SECTION 12

T 5 N R 16 E


TYPE MONUMENT PK/WASHER

ON SURFACE - BELOW

~~LEFT~~ - C PAV'T. - RIGHT

TO EDGE PAVEMENT

S.L.M. 1383+29

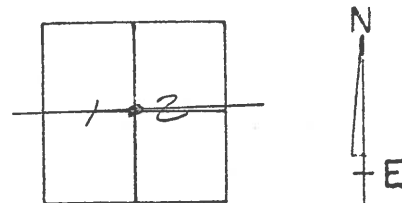


P.I.

OLD STATION: 142+75.98

PREVIOUS MONUMENTS

P.K/WASHER

R.R. SPK.

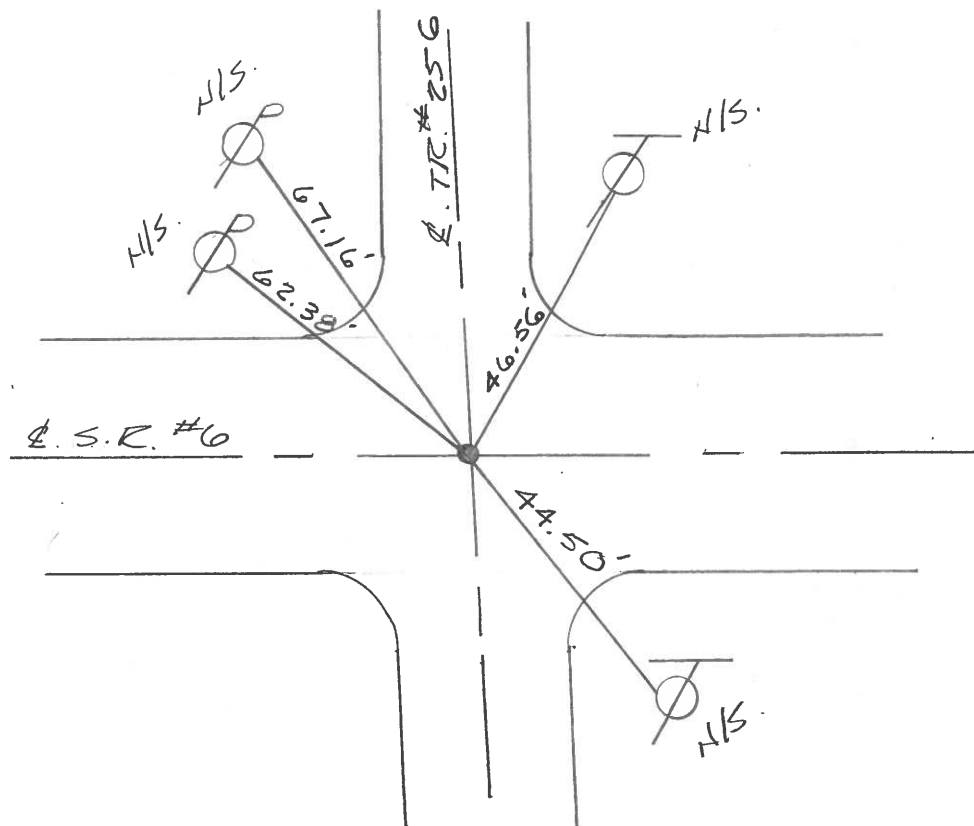

Q.D.O.T. DISTRICT 2 SURVEY OFFICE

SHEET _____ OF _____

County Sandusky S.R. U.S. #6

Township Liley

Section 12

T⁵N, R¹⁶E

Personnel Cronin

Ripple


Geyman

Barbour

Date 9/24/84

Weather overcast

Temp. 65°

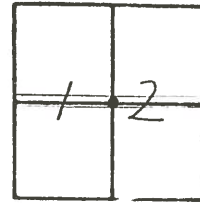

(41)

1383+29

4/03/91
40°

CHENEY
RIPPLE
BARBOUR




P.I.

142+75.98

Set P.K. & washer atop

R.R. spike

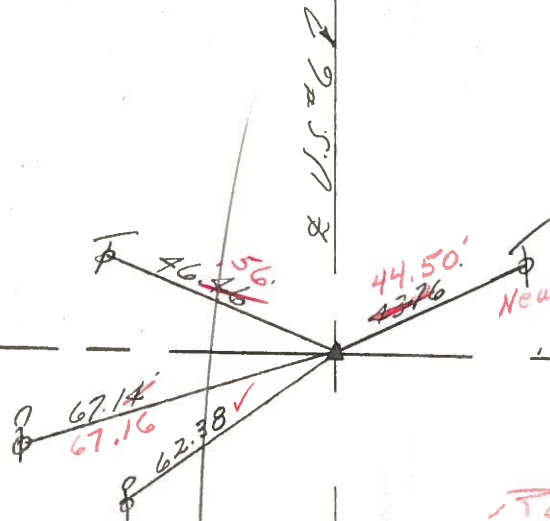

RE-SET P.K. & WASH
9-16-1991 ON E.
85°

Q.D.O.T. DISTRICT 2 SURVEY OFFICE

SHEET _____ OF _____

County Sandusky S. R. U.S. #6

Township Riley

Section 12

T⁵N, R¹⁶E

Personnel Cronin

Ripple

Geuman


Barbour

41


Date 9/24/84

Weather overcast

Temp. 65°

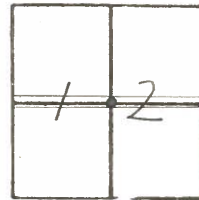

P.I.
142+75.98
set P.K. washer atop
R.R. spike

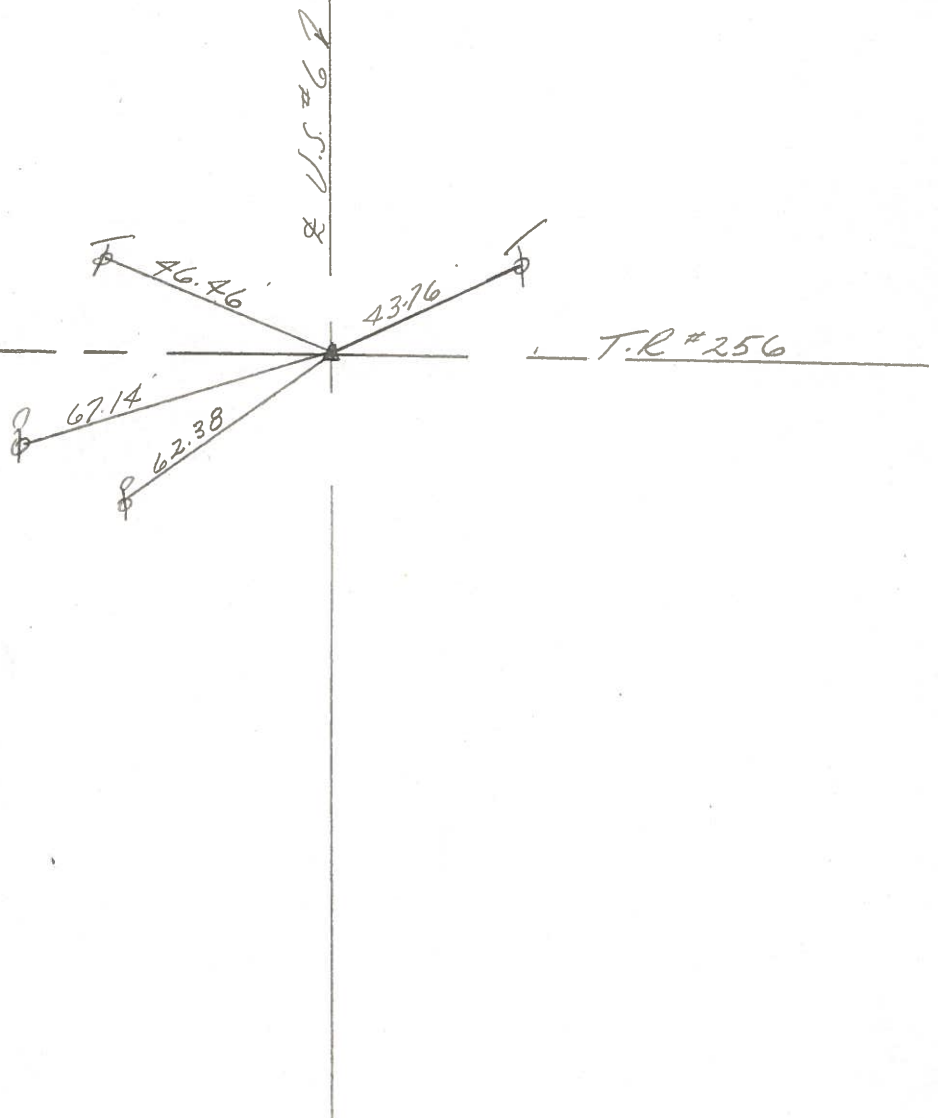



SHEET NO. 12

Tied 7/31/75

DATE drawn 7/30/75

PERSONNEL

TITLE

PERSONNEL

TITLE

Cronin

Schneider

COUNTY Sandusky

Ash

Mosser

S. R. #6

WEATHER sunny

Geyman

Barbour

SEC. "I" - Fremont-East

TEMP. 78°

DESCRIPTION

Ties for Control Points

LEFT

CENTER LINE

RIGHT

JOB NO.

Townsend Twp

Sec. 7

(42)

P.I.

170+01

Roadside nest
sign post
chisel mark
19' up

47.91'

24.15'

46.88'

"X" cut in conc. hdw/.

Riley Twp.

Sec. 12

(41)

P.I.

142+75.87

Set R.R. spike
punch mark

51.28'

43.74'

E.C.R. #256

67.06'

62.31'

PERSONNEL TITLE PERSONNEL TITLE

SchneiderPottsCOUNTY SanduskyDATE Dec-1967MosserS. R. U.S.# 6

WEATHER

BarbourSEC. Fremont-East

TEMP.

ReddingDESCRIPTION Ties for Control Points

JOB NO.

LEFT

CENTER LINE

RIGHT

170+10

~~7067~~

142+82.8

(41)

Co. Rd. #256

North & South

R.R. SPK.

4" Twin Maple

S.C.

26.5'

Surf Cap 12'

~~7066~~

Hd. wh.

52.34'

10.11'

21.41'

C.B.

35.8'

Surf Cap 12" below surface

19.8'

P.I.

1357+82.70

(40)

S.R. # 510 South

Co. Rd. 254 North

Small SPK.

Marathon sign

O

47.88'

11.11'

12.11'

66.64'

69.34'

11.11'

11.11'

O

Surf Cap 20" below surface

~~7065~~

Surf Cap 17"

below surface