

O.D.O.T. DISTRICT 2 SURVEY OFFICE (USE ONLY)

PERSONNEL

REFERENCE NO. 41 A

SHEET 14 OF 34

NOTES PRESTON-COLVIN

DATE 9-4-24

ROUTE US 6

H.C. NEISE

WEATHER SUNNY

COUNTY SANDUSKY

R.C. BARRIERE

TEMP. 75°

TOWNSHIP TOWNSEND

DWG BY PRESTON-COLVIN

PID PAVING TRAIN

T 5 N R 16 E

TYPE MONUMENT MEG/WASHER

ON SURFACE - ~~BELOW~~ ON

OFFSET CL PAVEMENT 1.0' ~~LT~~ : RT

8' TO LT EDGE PAVEMENT

STATION: 1410+42

HORZ.DATUM: NAD83 (2011)


GEOID: NAVD88 2018

GRID: NORTHING: 635165.604


EASTING: 1844086.175

LDP: NORTHING: 331459.2

EASTING: 204214.6

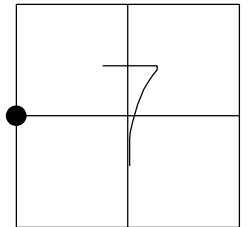

RECORD:
FD P.K./WASHER
REFA42
11/22/18, DCH
SET MAG/WASHER
8-2-19, JLL
FD MAG/WASHER
2/10/22, JFO
1/20/23, JMR
FD MEG/WASHER
REF41A
9/4/24, TDN
FD MEG/WASHER
10/3/24, JAM

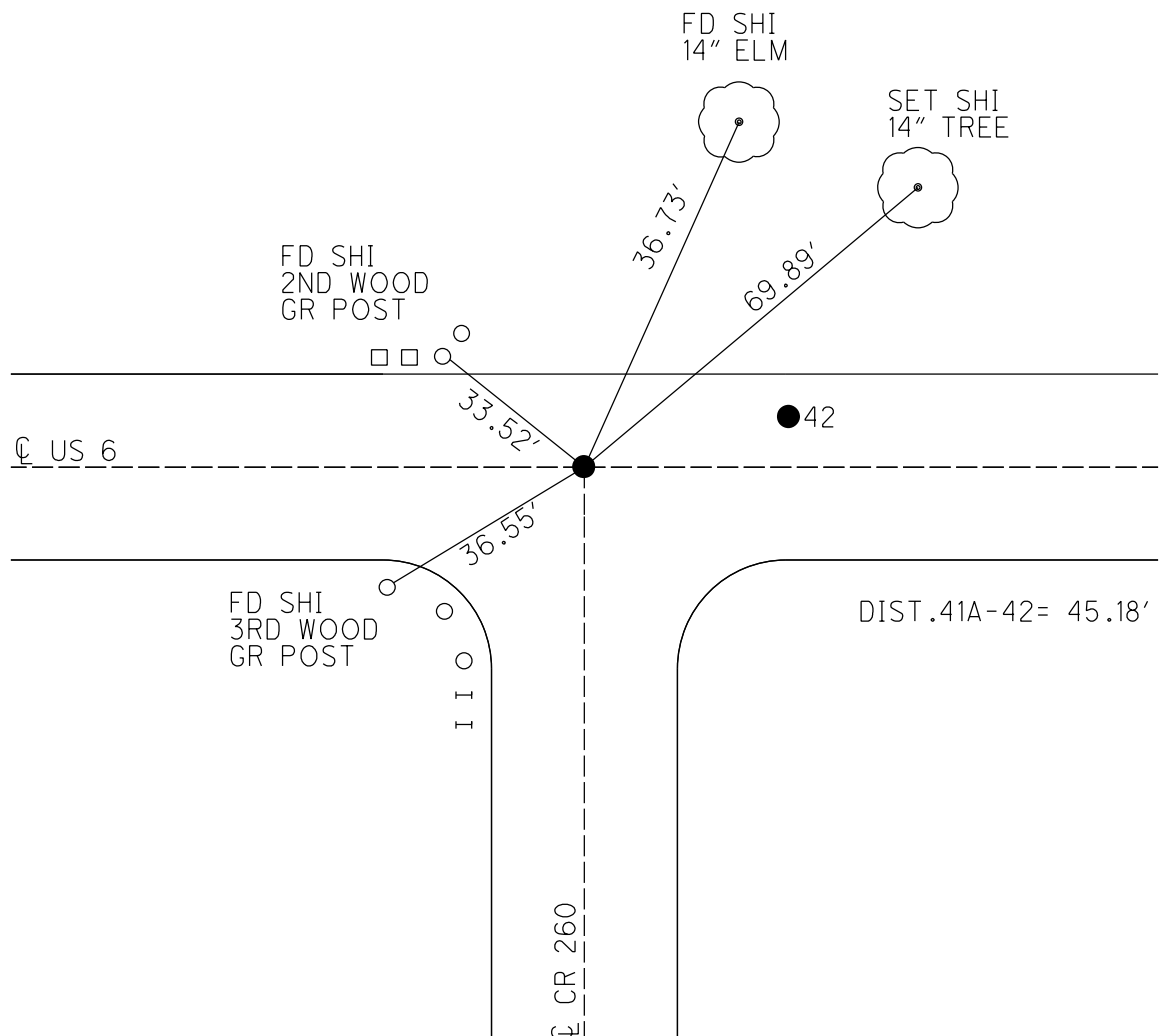

O.D.O.T. DISTRICT 2 SURVEY OFFICE (USE ONLY)

PERSONNEL

REFERENCE NO. 41 A

SHEET 14 OF 34

NOTES MILLER

DATE 12/28/23

ROUTE US 6

H.C. RHOADES

WEATHER RAIN

COUNTY SANDUSKY

R.C. MILLER

TEMP. 44°

TOWNSHIP TOWNSEND

DWG BY RHOADES PID PAVETRAIN

SECTION 7

T 5 N R 16 E

TYPE MONUMENT MAG/WASHER

ON SURFACE - ~~BELOW~~ ON

OFFSET 8' TO LT EDGE PAVEMENT RT


STATION: 1410+42

HORIZ.DATUM: NAD83 (2011)


GEOID: NAVD88 2018

GRID: NORTHING: 635165.604

EASTING: 1844086.175

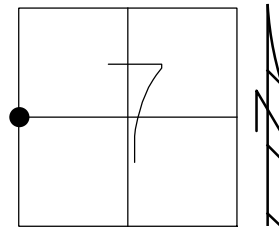

RECORD:
FD P.K./WASHER
REFA42
11/22/18, DCH
SET MAG/WASHER
8-2-19, JLL
FD MAG/WASHER
2/10/22, JFO
1/20/23, JMR

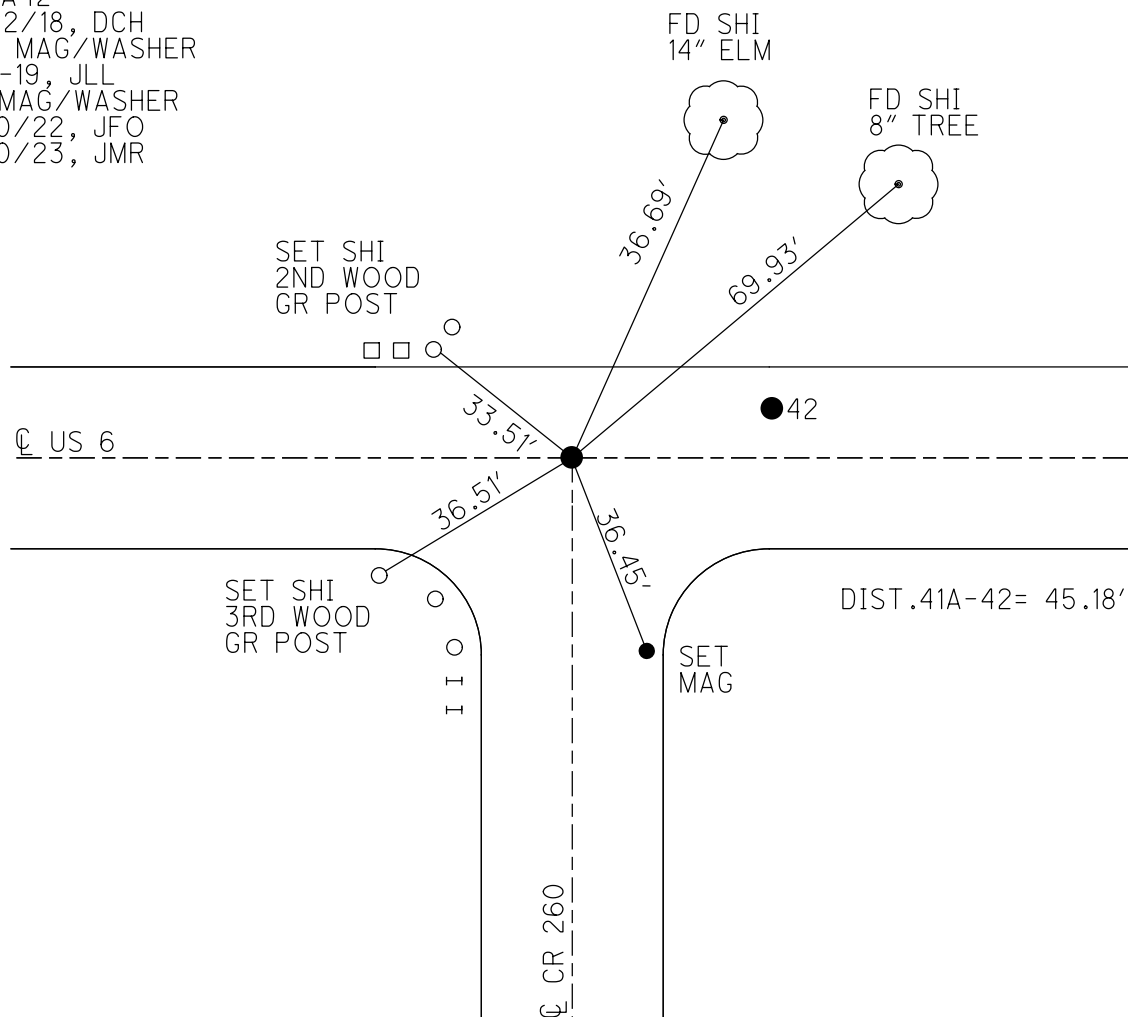

O.D.O.T. DISTRICT 2 SURVEY OFFICE (USE ONLY)

PERSONNEL

REFERENCE NO. 41 A

SHEET 14 OF 34

NOTES LEU

DATE 8/1/18

ROUTE US 6

H.C. LEU

WEATHER CLOUDY

COUNTY SANDUSKY

R.C. TRENKA

TEMP. 76°

TOWNSHIP TOWNSEND

SECTION 7

DWG BY AUBLE PID PAVETRAIN

T 5 N R 16 E

TYPE MONUMENT P.K./WASHER

ON SURFACE - ~~BELOW~~ ON

OFFSET Q PAVEMENT 3.5' LT : ~~RT~~

8' TO LT EDGE PAVEMENT


STATION: 1410+42

HORIZ.DATUM: NAD83 (2011)

GEOID: 2012A


GRID: NORTHING: 635165.604

EASTING: 1844086.175

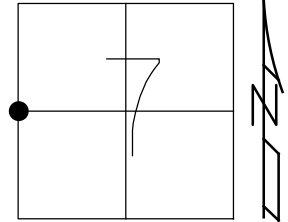

RECORD:

FD P.K./WASHER
REFA42
11/22/18, DCH
SET MAG/WASHER
8-2-19, JLL
FD MAG/WASHER
2/10/22, JFO
1/20/23, JMR

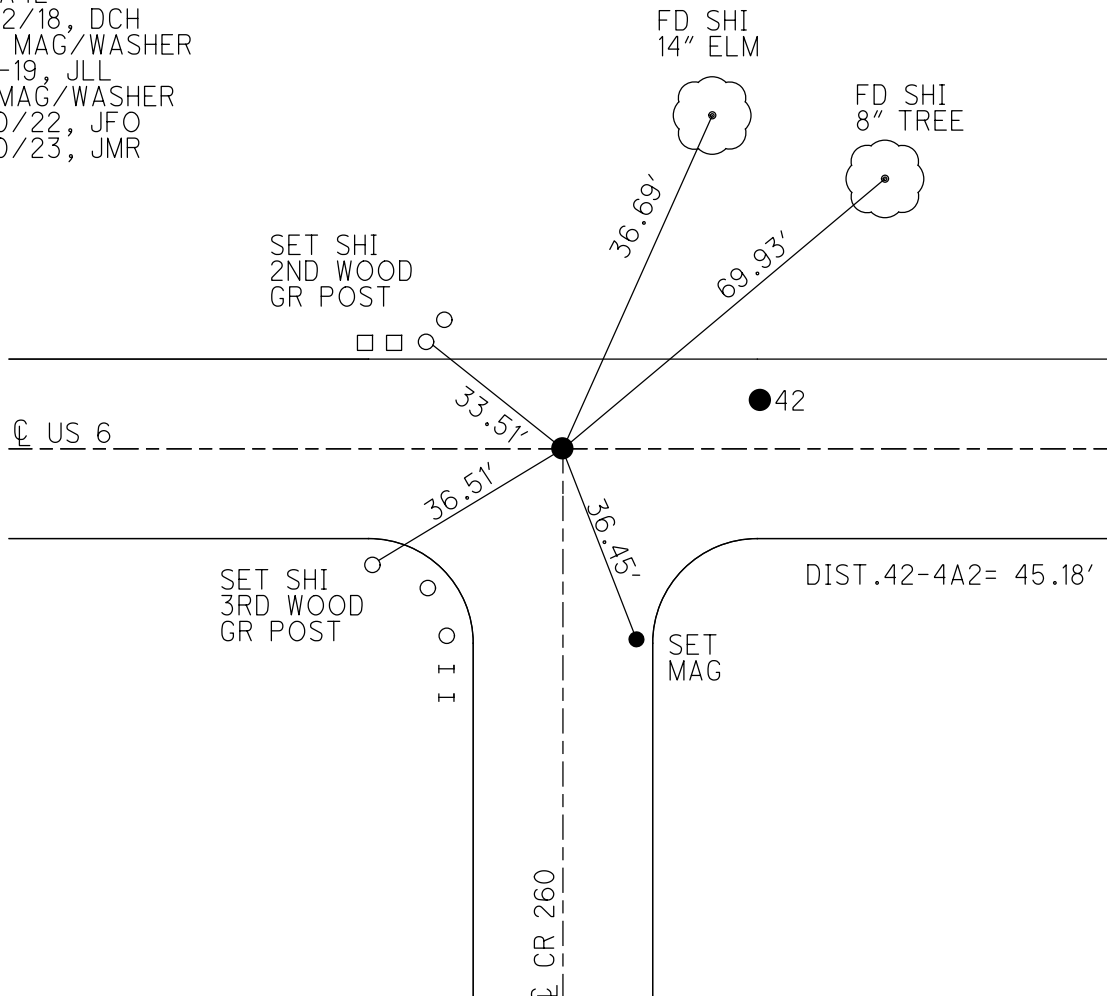

O.D.O.T. DISTRICT 2 SURVEY OFFICE (USE ONLY)

PERSONNEL

REFERENCE NO. 41 A

SHEET 14 OF 34

NOTES LEU

DATE 8/1/18

ROUTE US 6

H.C. LEU

WEATHER CLOUDY

COUNTY SANDUSKY

R.C. TRENKA

TEMP. 76°

TOWNSHIP TOWNSENDDWG BY AUBLE PID 95769

T⁵ N R¹⁶ F

TYPE MONUMENT P.K./WASHER

ON SURFACE - ~~BELOW~~ ON

OFFSET C PAVEMENT 3.5' LT : RT


8' TO LT EDGE PAVEMENT

STATION: 1410+42

HORZ.DATUM: NAD83 (2011)

GEOID: 2012A

GRID: NORTHING: 635165.604

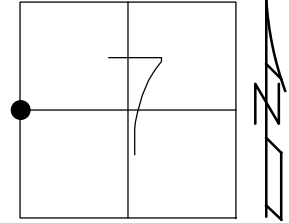EASTING: 1844086.175

RECORD:
FD P.K./WASHER
REFA42
11/22/18, DCH
SET MAG/WASHER
8-2-19, JLL

