


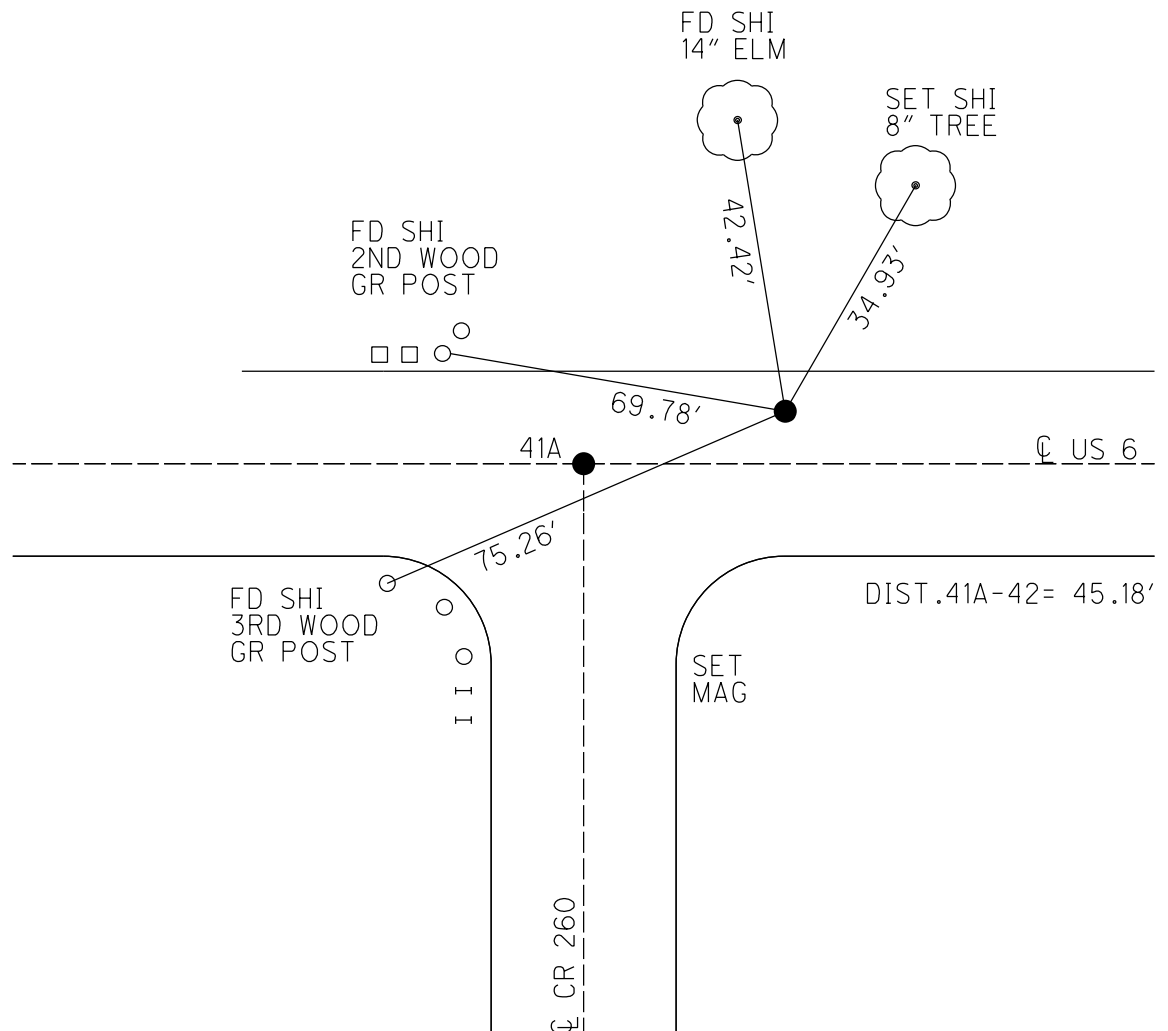

O.D.O.T. DISTRICT 2 SURVEY OFFICE (USE ONLY)

PERSONNEL

REFERENCE NO. 42

SHEET 15 OF 34

NOTES MILLER

DATE 12/28/23

ROUTE US 6

H.C. RHOADES

WEATHER RAIN

COUNTY SANDUSKY

R.C. MILLER

TEMP. 44°

TOWNSHIP TOWNSEND

SECTION 7

DWG BY RHOADES PID PAVETRAIN

T 5 N R 16 E

TYPE MONUMENT MAG/WASHER

ON SURFACE - ~~BELOW~~ ON

OFFSET Q PAVEMENT 2.8' LT : ~~RT~~

- TO - EDGE PAVEMENT


STATION: 1410+42

HORIZ.DATUM: NAD83 (2011)


GEOID: NAVD88 2018

GRID: NORTHING: 635169.141

EASTING: 1844131.190

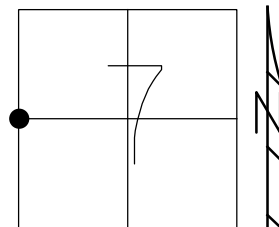

RECORD: P.I.
STA. 170+01
P.K./WASHER
BOAT SPIKE
FD P.K./WASHER
3/16/02, DCH
SET P.K./WASHER
6/10/02, DCH
FD P.K./WASHER
REFA42
11/22/18, DCH
SET MAG/WASHER
8-2-19, JLL
FD MAG/WASHER
2/10/22, JFO
1/20/23,
12/28/23, JMR

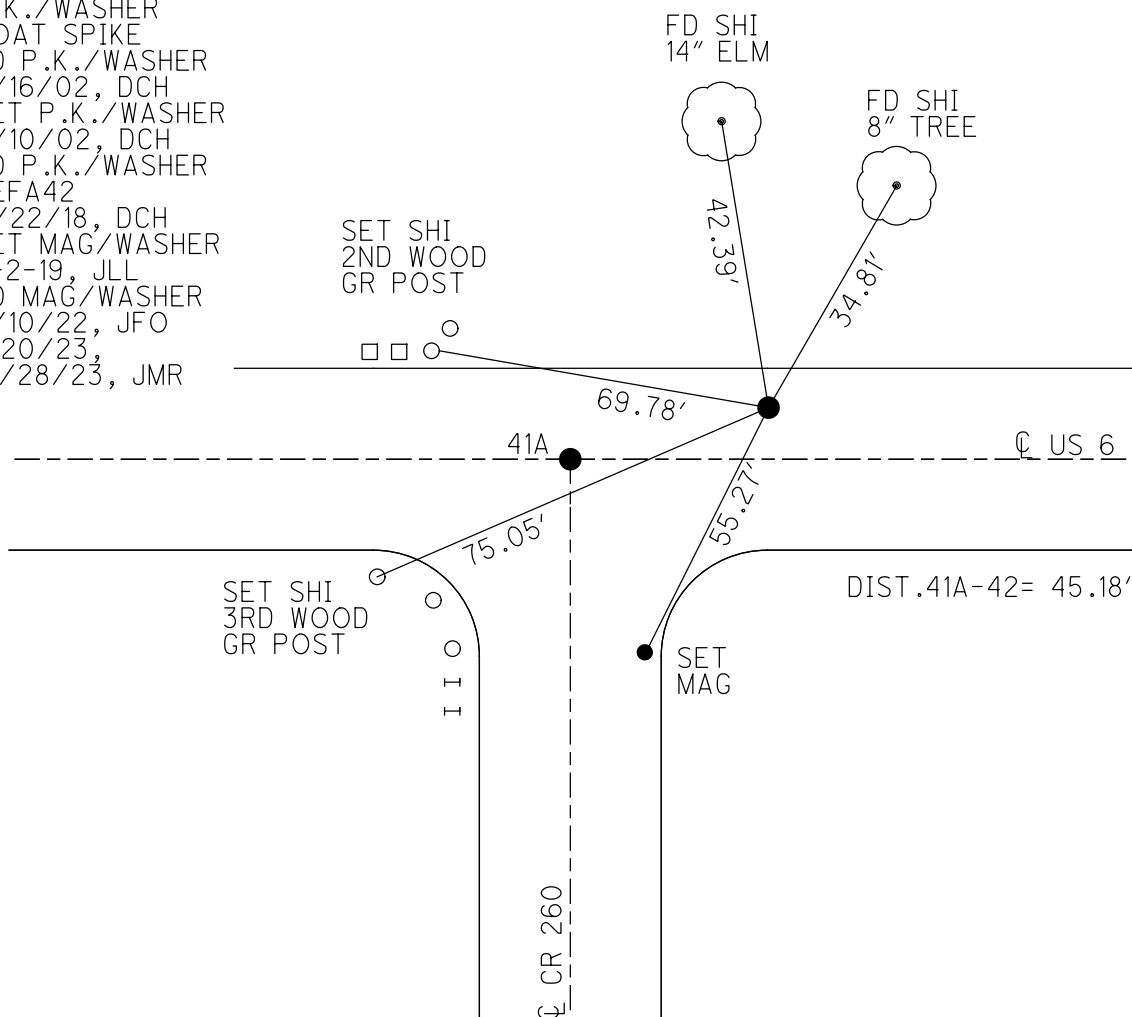

O.D.O.T. DISTRICT 2 SURVEY OFFICE (USE ONLY)

PERSONNEL

REFERENCE NO. 42

SHEET 15 OF 34

NOTES LEU

DATE 8/1/18

ROUTE US 6

H.C. LEU

WEATHER CLOUDY

COUNTY SANDUSKY

R.C. TRENKA

TEMP. 76°

TOWNSHIP TOWNSEND

DWG BY AUBLE

PID PAVETRAIN

SECTION 7

T 5 N R 16 E

TYPE MONUMENT P.K./WASHER

ON SURFACE - ~~BELOW~~ ON

OFFSET Q PAVEMENT 2.8' LT : ~~RT~~

- TO - EDGE PAVEMENT


STATION: 1410+42

HORIZ.DATUM: NAD83 (2011)


GEOID: 2012A

GRID: NORTHING: 635169.141

EASTING: 1844131.190

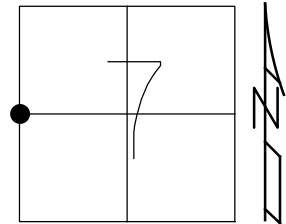

RECORD: P.I.
STA. 170+01
PREVIOUS MONUMENTS:
P.K./WASHER
BOAT SPIKE
FD P.K./WASHER
3/16/02, DCH
SET P.K./WASHER
6/10/02, DCH
FD P.K./WASHER
REFA42
11/22/18, DCH
SET MAG/WASHER
8-2-19, JLL
FD MAG/WASHER
2/10/22, JFO
1/20/23, JMR

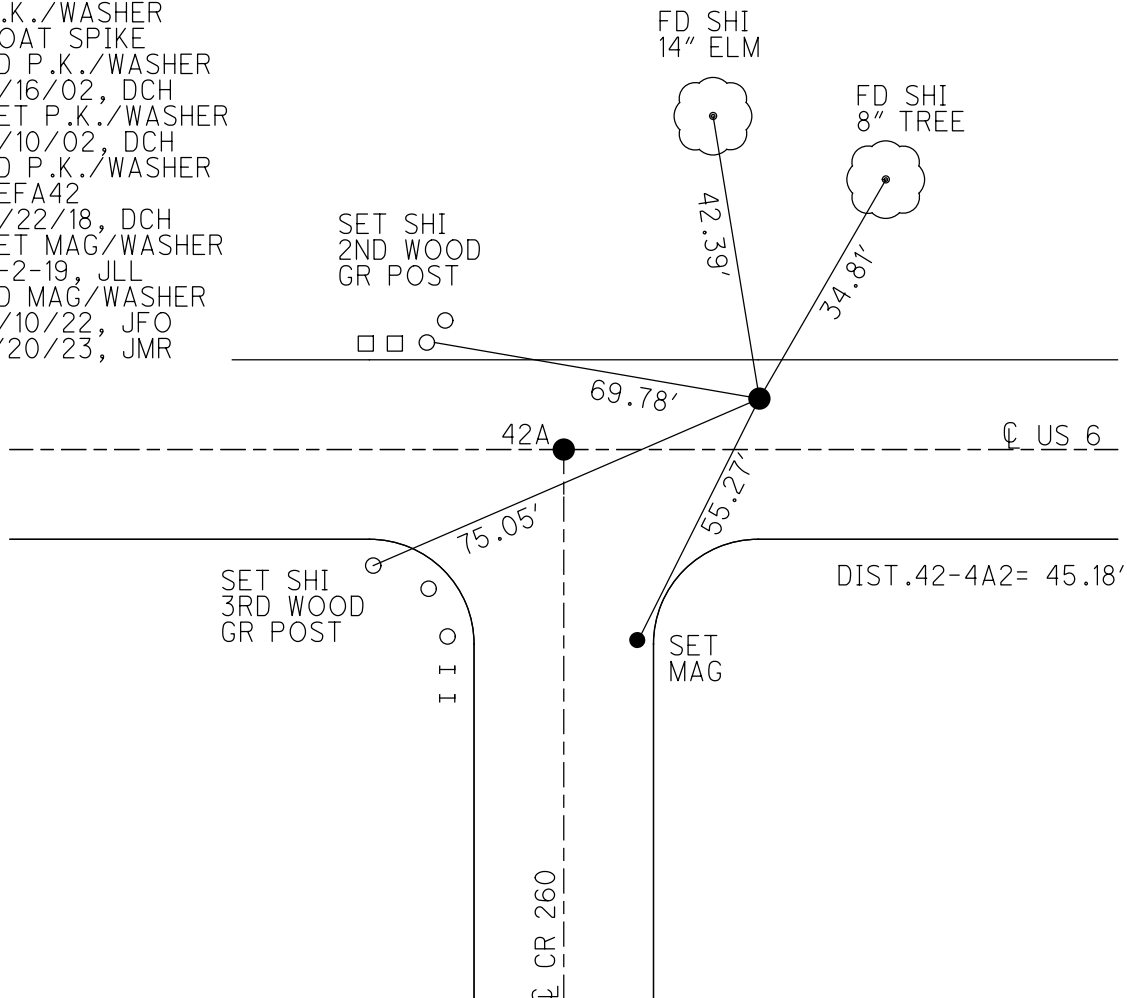

O.D.O.T. DISTRICT 2 SURVEY OFFICE (USE ONLY)

PERSONNEL

REFERENCE NO. 42

SHEET 15 OF 34

NOTES LEU

DATE 8/1/18

ROUTE US 6

H.C. LEU

WEATHER CLOUDY

COUNTY SANDUSKY

R.C. TRENKA

TEMP. 76°

TOWNSHIP TOWNSEND

DWG BY AUBLE PID 95769

SECTION 7

T 5 N R 16 E

TYPE MONUMENT P.K./WASHER

ON SURFACE - ~~BELOW~~ ON

OFFSET Q PAVEMENT ON LT : RT

- TO - EDGE PAVEMENT


STATION: 1410+42

HORZ.DATUM: NAD83 (2011)


GEOID: 2012A

GRID: NORTHING: 635169.141

EASTING: 1844131.190

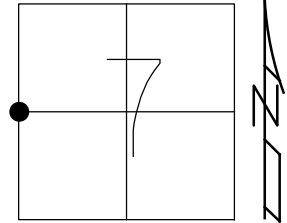

RECORD: P.I.
STA. 170+01
PREVIOUS MONUMENTS:
P.K./WASHER
BOAT SPIKE
FD P.K./WASHER
3/16/02, DCH
SET P.K./WASHER
6/10/02, DCH
FD P.K./WASHER
REFA42
11/22/18, DCH
SET MAG/WASHER
8-2-19, JLL
FD MAG/WASHER
2/10/22, JFO

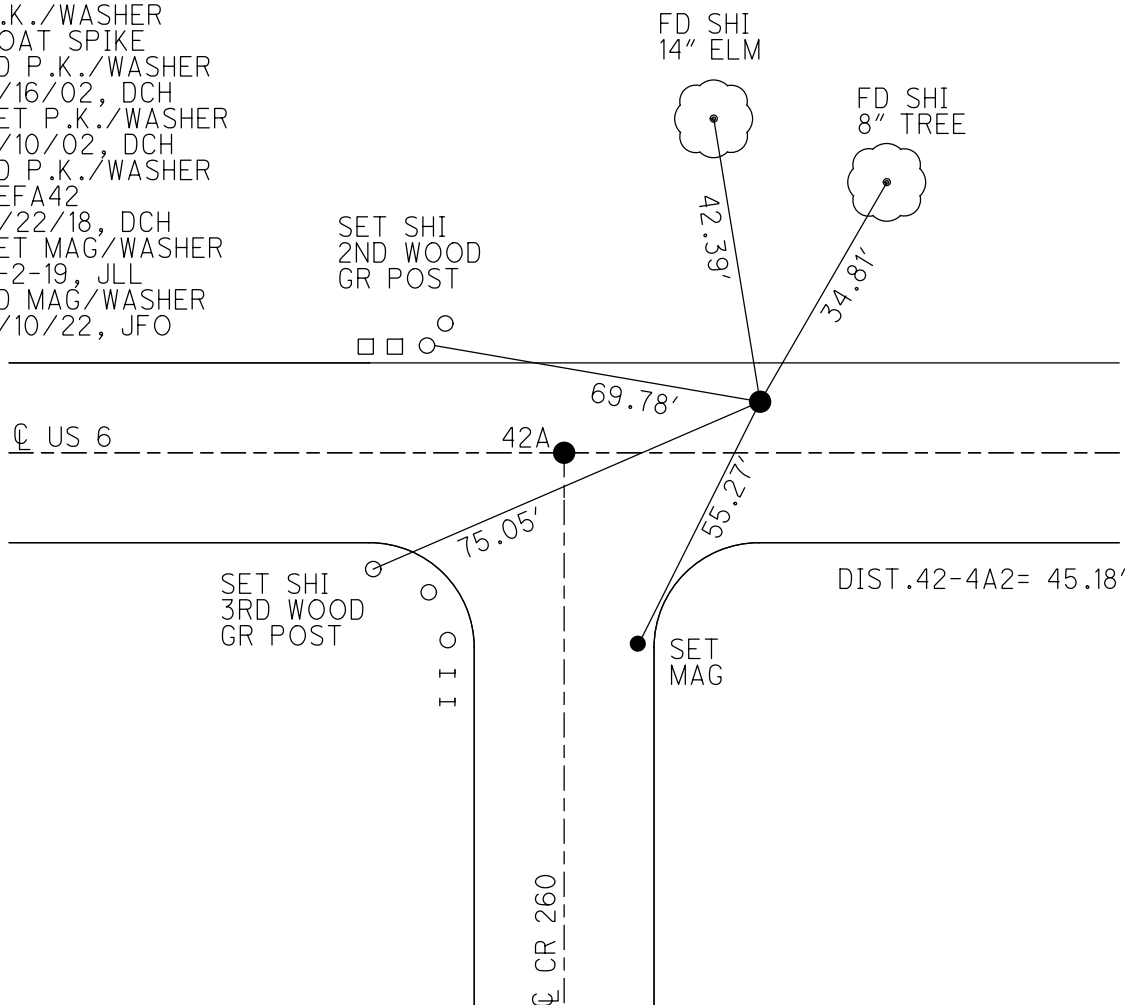

O.D.O.T. DISTRICT 2 SURVEY OFFICE (USE ONLY)

PERSONNEL

REFERENCE NO. 42

SHEET 15 OF 34

NOTES LEU

DATE 8/1/18

ROUTE US 6

H.C.	LEU
------	-----

WEATHER CLOUDY

COUNTY SANDUSKY

R.C. TRENKA

TEMP. 76°

TOWNSHIP TOWNSEND

SECTION 7

DWG BY AUBLE PID 95769

T_5_N R_16_E

TYPE MONUMENT P.K./WASHER

ON SURFACE - ~~BELOW~~ ON _____

OFFSET C PAVEMENT ON LT : RT

_____ TO _____ EDGE PAVEMENT


STATION: 1410+42

HORZ.DATUM: NAD83 (2011)

GEOID: 2012A

GRID: NORTHING: 635169.141

EASTING: 1844131.190

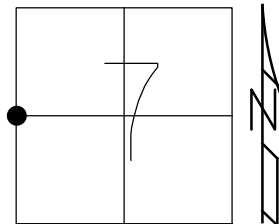

RECORD: P.I.

STA. 170+01

PREVIOUS MONUMENTS:

P.K./WASHER

BOAT SPIKE

FD P.K./WASH

3/16/02, DCH

SET P.K./WAS

6/10/02, DCH
ED, R. K. WACHS

FD P.K./WASHER
BEE-10


REF A42
11/00/11

11/22/18, DCH
GET MAG (WAG)

SET MAG/WASHER

8-2-19, JLL




SET SHI
2ND WOOD
GR POST

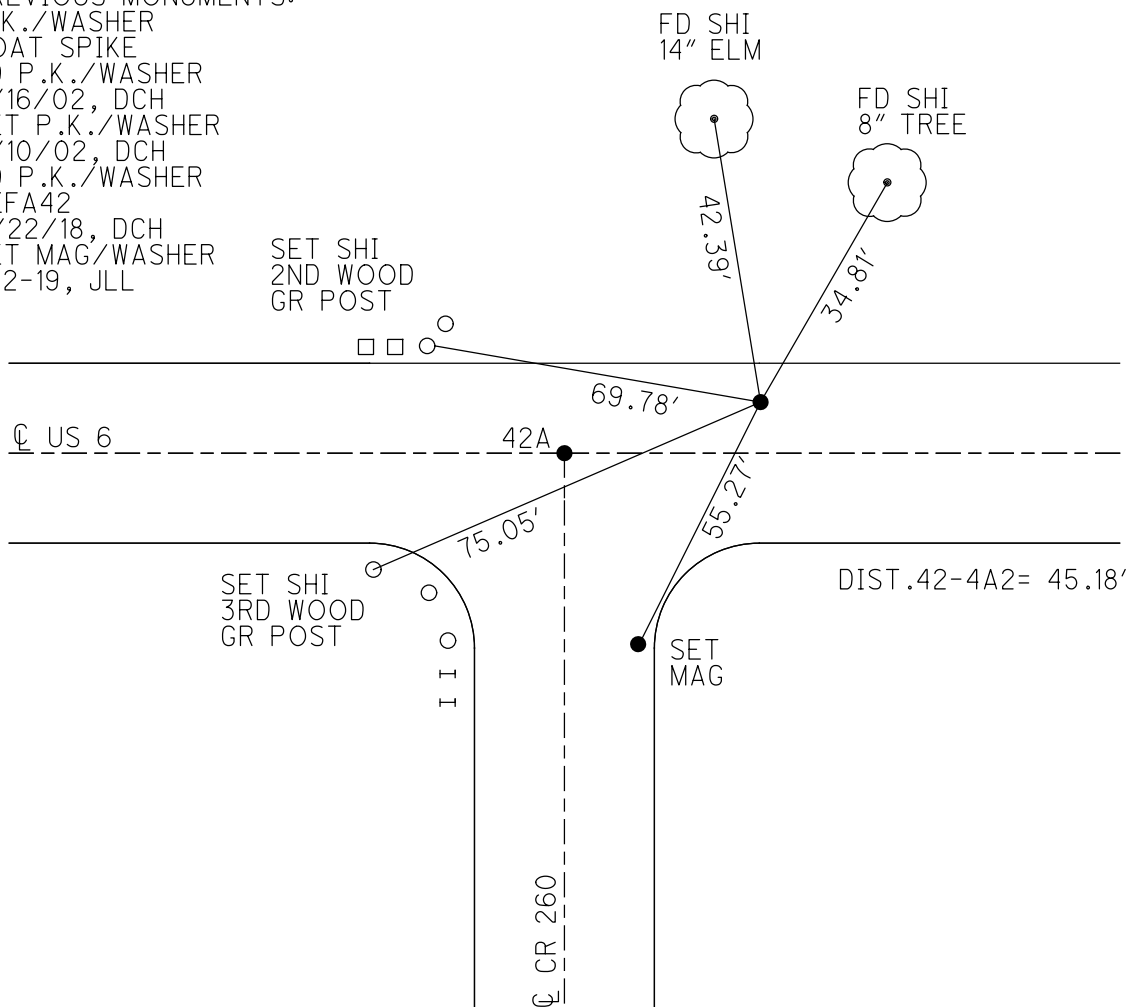

O.D.O.T. DISTRICT 2 SURVEY OFFICE (USE ONLY)

PERSONNEL	REFERENCE NO.	42	SHEET	13	OF	31
NOTES	ROUSOS	DATE	03/16/02	ROUTE	US 6	
H.C.	VAN DUSEN	WEATHER	WINDY	COUNTY	SANDUSKY	
R.C.	MOSSER	TEMP.	28°	TOWNSHIP	TOWNSEND	
	HOMAN			SECTION	7	
				T	5	N R 17 E

TYPE MONUMENT PK/WASHER
ON SURFACE - ~~BELOW~~ ON
LEFT - Q PAV'T - ~~RIGHT~~ 4.0'
8.0' TO LT EDGE PAVEMENT
S.L.M. 1410+42
GRID: NORTHING: - EASTING: -

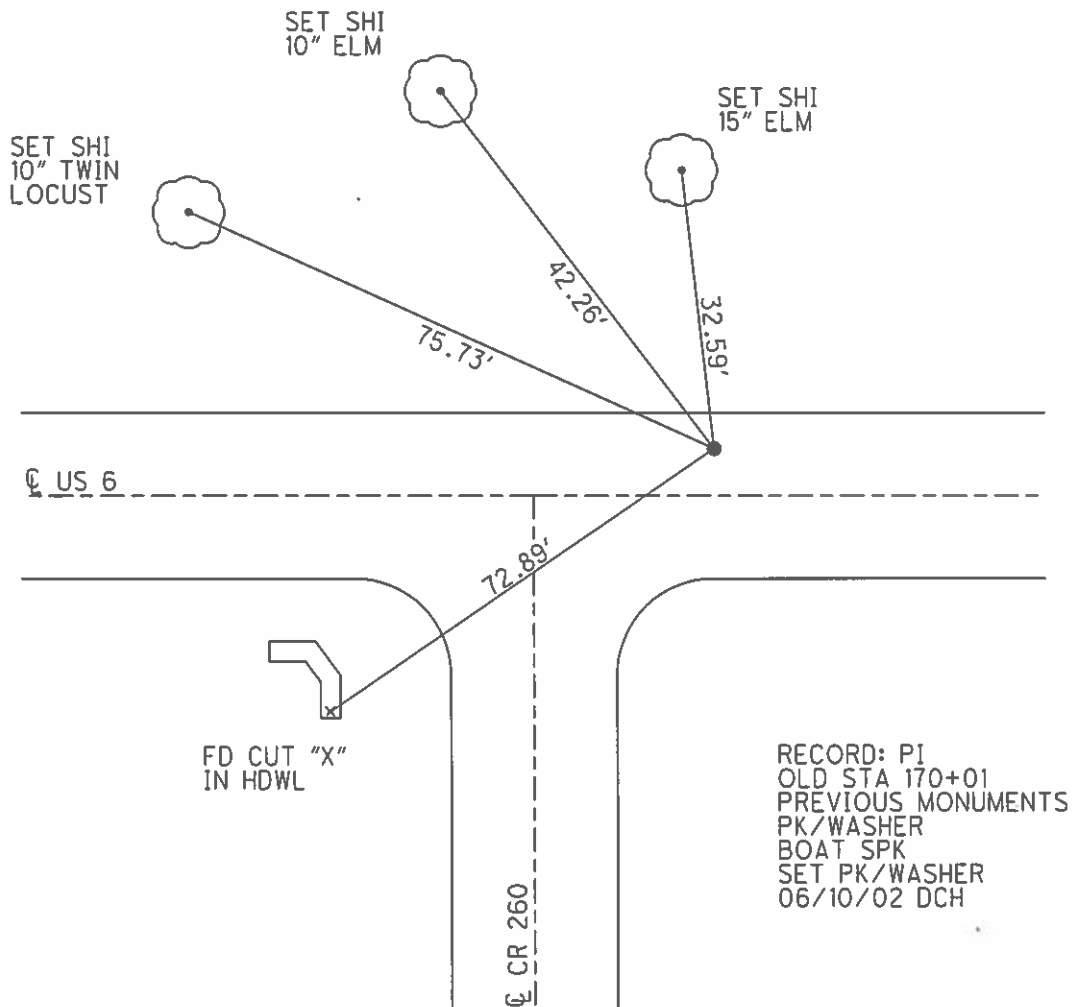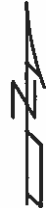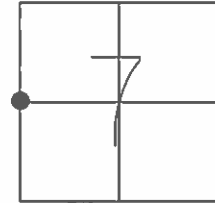

RECORD: P1
OLD STA 170+01
PREVIOUS MONUMENTS
PK/WASHER
BOAT SPK
SET PK/WASHER
06/10/02 DCH

O.D.O.T. DISTRICT 2 SURVEY OFFICE

PERSONNEL

NOTES ROUSOS
H.C. VAN DUSEN
R.C. MOSSER
HOMAN

REFERENCE NO. 42

DATE 3/16/02

WEATHER WINDY

TEMP. 28°

SHEET 11 OF 27

ROUTE SR 6

COUNTY SANDUSKY

TOWNSHIP TOWNSEND

SECTION 7

T 5 N R 17 E


TYPE MONUMENT PK/WASHER

ON SURFACE - ~~BELOW~~ ON

LEFT - Q PAV'T - ~~RIGHT~~ 4.0'


8' TO LT EDGE PAVEMENT

S.L.M. 1410+42

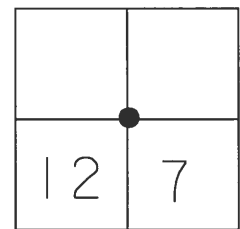

P.I.
OLD STA 170+01
PREVIOUS MONUMENTS
PK/WASHER
BOAT SPK

SET PK/WASHER
6-10-02
DCH

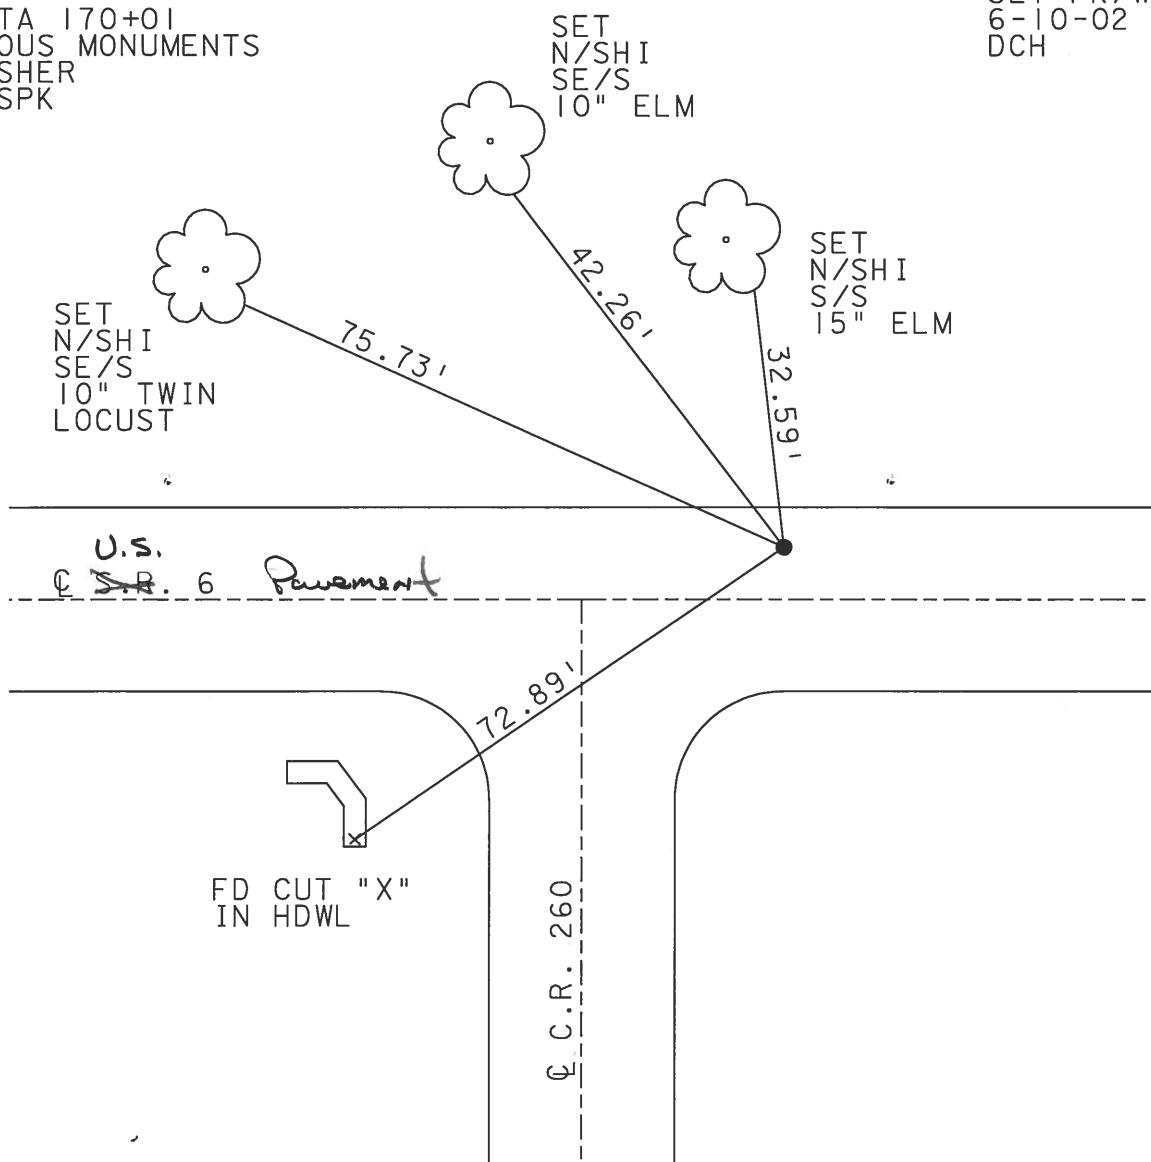

O.D.O.T. DISTRICT 2 SURVEY OFFICE

PERSONNEL

REFERENCE NO. 42

SHEET 23 OF 39

NOTES CHENEY

H.C. RIPPLE

R.C. BARBOUR

DATE 9-16-1991

WEATHER SUNNY

TEMP. 85°

ROUTE 6

COUNTY SANDUSKY

TOWNSHIP TOWNSEND

SECTION 7

T.5 N R.17 E


TYPE MONUMENT PK/WASHER

ON SURFACE - BELOW

LEFT - C PAV'T. - RIGHT 4'±

TO EDGE PAVEMENT

S.L.M. 1410+42

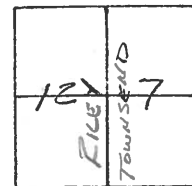


P.I.

OLD. STATION: 170+01

PREVIOUS MONUMENTS

P.K/WASHER

BOAT SPR.

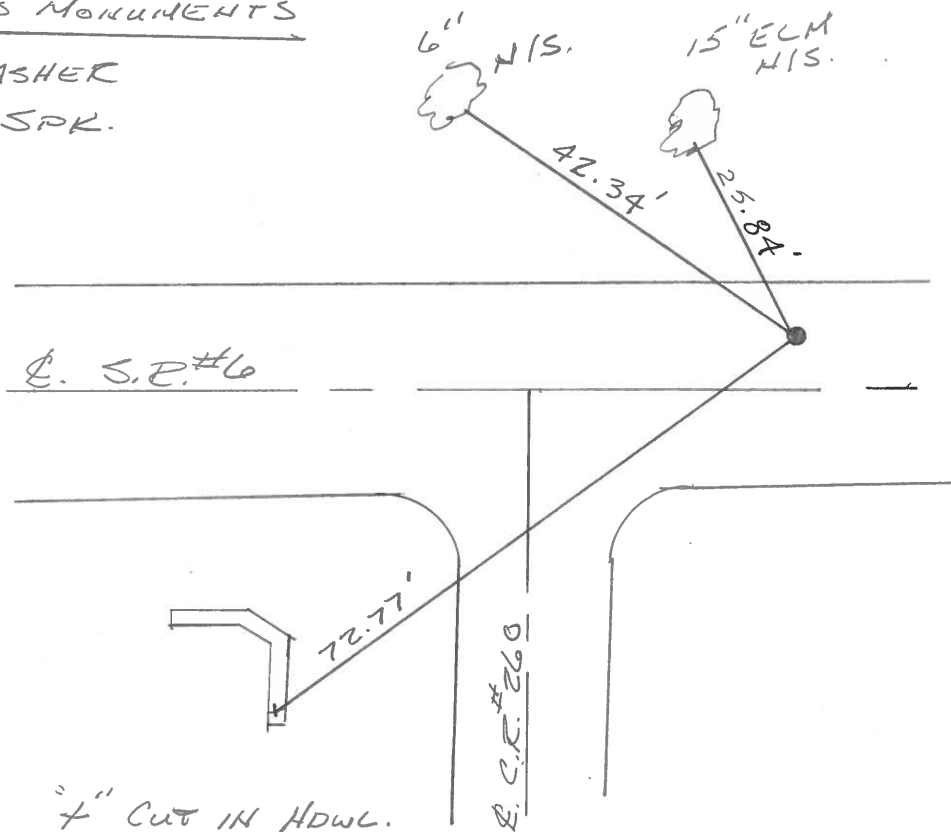

Q.D.O.T. DISTRICT 2 SURVEY OFFICE

SHEET _____ OF _____

County Sandusky S.R. U.S. #6

Township Townsend

Section 7

T5N, R12E

Personnel Cronin

Ripple


Geyman

Barbour

Date 9/24/84


Weather overcast

Temp. 65°

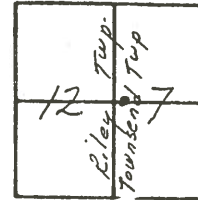

42

CHENEY
RIPPLE
BARBOUR

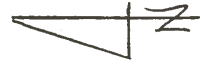


4/03/91
40°

1410+42

P.I.

170+01

Set P.K. & washer at top
boat spike 3.5± ft. & Point.

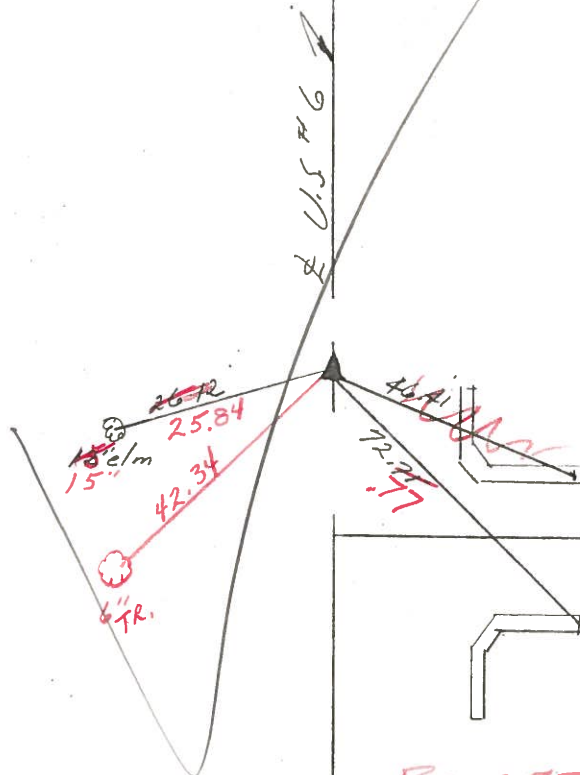

C.R. #260

4' cut in headwalls

RE-SET P.K. & WASHER
9-16-1991 85°
4'± N. OF E.

Q.D.O.T. DISTRICT 2 SURVEY OFFICE

SHEET _____ OF _____

County Sandusky S. R. U.S. #6

Township Townsend

Section 7

T5N, R12E

Personnel Cronin

Ripple

Geyman


Borbour

42

Date 9/24/84

Weather overcast


Temp. 65°

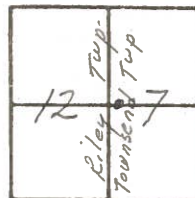

P.I.

170+01

Set P.K. washer at top
boat spike 3.5' Lt. & Point.

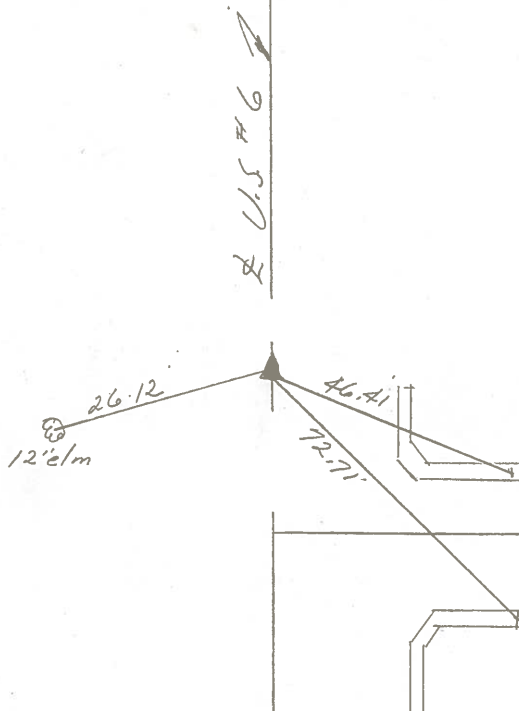

C.R. #260

4' cut in headwalls

PERSONNEL	TITLE	PERSONNEL	TITLE
Cronin		Schneider	
Ash		Mosser	
Geyman		Barbour	

COUNTY Sandusky

DATE drawn 7/30/75

S. R. #6

WEATHER sunny

SEC. "I" - Fremont-East

TEMP. 78°

DESCRIPTION Ties for Control Points

JOB NO.

