

O.D.O.T. DISTRICT 2 SURVEY OFFICE (USE ONLY)

PERSONNEL

REFERENCE NO. 43

SHEET 16 OF 34

NOTES PRESTON-COLVIN

DATE 9-5-24

ROUTE US 6

H.C. NEISE

WEATHER SUNNY

COUNTY SANDUSKY

R.C. BARRIERE

TEMP. 62°

TOWNSHIP TOWNSEND

SECTION 7

DWG BY PRESTON-COLVIN PID PAVING TRAIN

T 5 N R 17 E

TYPE MONUMENT MEG/WASHER

ON SURFACE - ~~BELOW~~ ON

OFFSET CL PAVEMENT 0.3' ~~LT~~ : RT

11' TO RT EDGE PAVEMENT

STATION: 1436+56

HORIZ.DATUM: NAD83 (2011)


GEOID: NAVD88 2018

GRID: NORTHING: 635017.654


EASTING: 1846742.729

LDP: NORTHING: 331329.5

EASTING: 206872.3

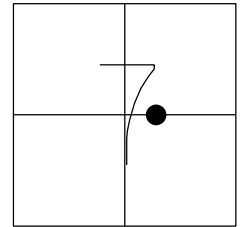

RECORD: P.I.
Δ= 00° 20' LT (PLAN)
STA 196+14.60
FD BOAT SPIKE
2" DOWN
FD P.K./WASHER
1.25" DOWN
FD P.K.WASHER
3/16/02, DCH
SET P.K./WASHER
6/11/02, DCH
FD P.K.SHANK
REF43
11/23/17, DCH
SET MAG/WASHER
7-31-19, JLL
FD MAG/WASHER
2/10/22, JFO
1/20/23, JMR
FD MAG/WASHER
REF43
9/5/24, TDN
FD MAG/WASHER
10/3/24, JAM

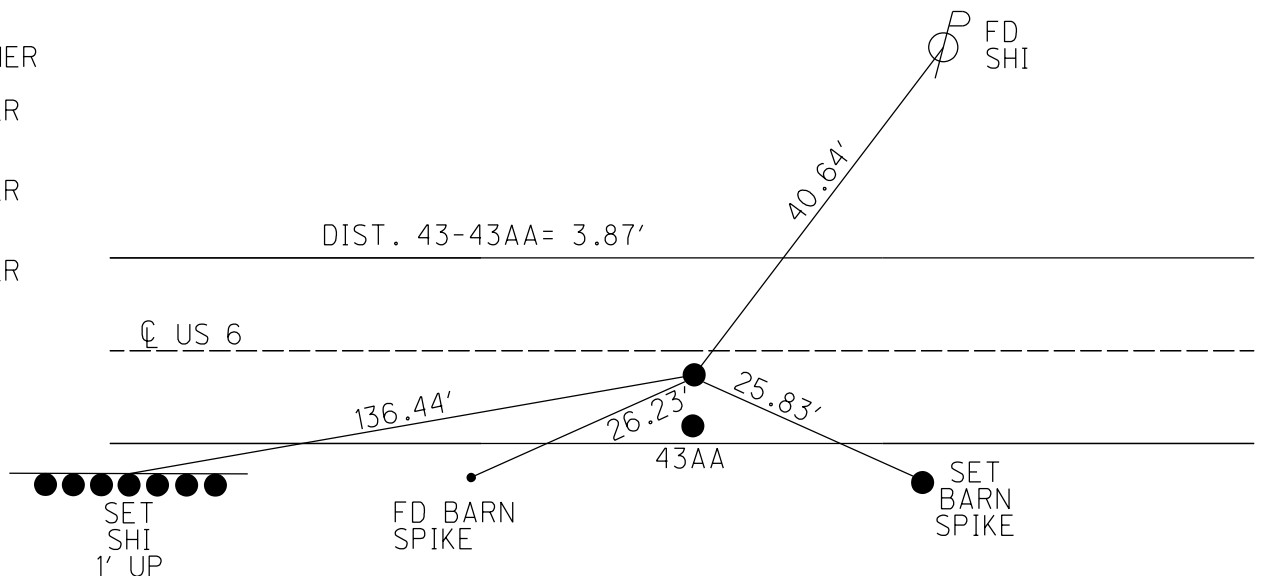

O.D.O.T. DISTRICT 2 SURVEY OFFICE (USE ONLY)

PERSONNEL

REFERENCE NO. 43

SHEET 16 OF 34

NOTES LEU

DATE 8/6/18

ROUTE US 6

H.C. LEU

WEATHER CLOUDY

COUNTY SANDUSKY

R.C. HAGEMEYER

TEMP. 78°

TOWNSHIP TOWNSEND

SECTION 7

DWG BY AUBLE

PID PAVETRAIN

T 5 N R 17 E

TYPE MONUMENT P.K.SHANK

ON SURFACE - ~~BELOW~~ ON

OFFSET Q PAVEMENT 0.3' ~~LT~~ : RT

11' TO RT EDGE PAVEMENT


STATION: 1436+56

HORZ.DATUM: NAD83 (2011)


GEOID: 2012A

GRID: NORTHING: 635017.654

EASTING: 1846742.729

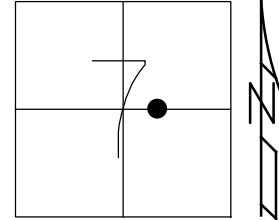

RECORD: P.I.
Δ= 00° 20' LT (PLAN)
STA 196+14.60
FD BOAT SPIKE
2" DOWN
FD P.K./WASHER
1.25" DOWN
FD P.K.WASHER
3/16/02, DCH
SET P.K./WASHER
6/11/02, DCH
FD P.K.SHANK
REF43
11/23/17, DCH
SET MAG/WASHER
7-31-19, JLL
FD MAG/WASHER
2/10/22, JFO
1/20/23, JMR

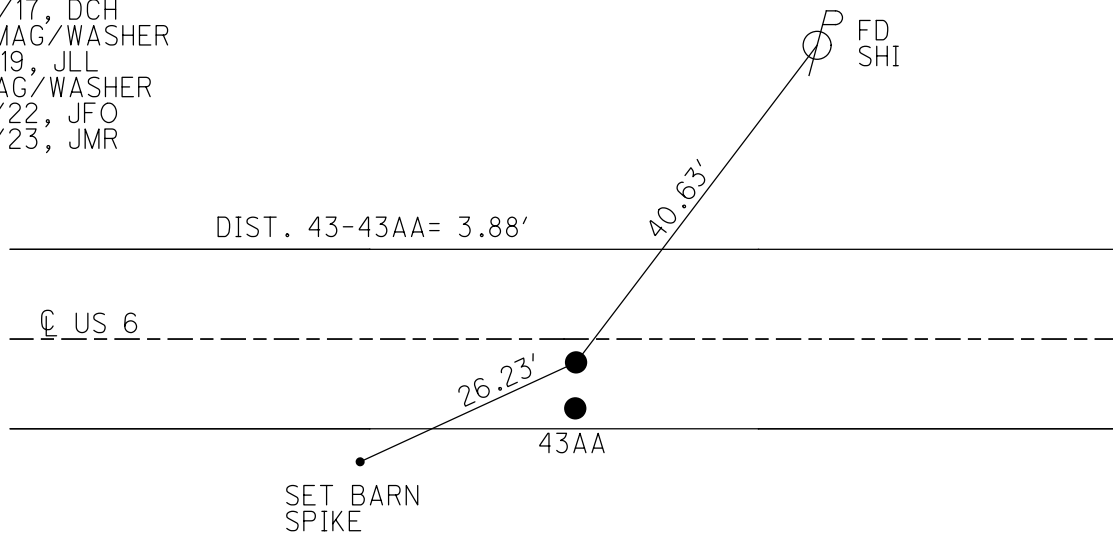

O.D.O.T. DISTRICT 2 SURVEY OFFICE (USE ONLY)

PERSONNEL

REFERENCE NO. 43

SHEET 16 OF 34

NOTES LEU

DATE 8/6/18

ROUTE US 6

H.C. LEU

WEATHER CLOUDY

COUNTY SANDUSKY

R.C. HAGEMeyer

TEMP. 78°

TOWNSHIP TOWNSEND

DWG BY AUBLE

PID 95769

SECTION 7

T 5 N R 17 E

TYPE MONUMENT P.K.SHANK

ON SURFACE - ~~BELOW~~ ON

OFFSET 0.3' LT : RT

11' TO RT EDGE PAVEMENT


STATION: 1436+56

HORZ.DATUM: NAD83 (2011)


GEOID: 2012A

GRID: NORTHING: 635017.654

EASTING: 1846742.729

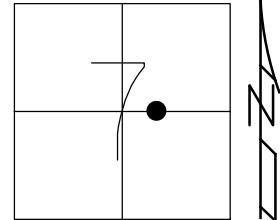

RECORD: P.I.
 $\Delta = 00^\circ 20'$ LT (PLAN)
STA 196+14.60
FD BOAT SPIKE
2" DOWN
FD P.K./WASHER
1.25" DOWN
FD P.K.WASHER
3/16/02, DCH
SET P.K./WASHER
6/11/02, DCH
FD P.K.SHANK
REF43
11/23/17, DCH
SET MAG/WASHER
7-31-19, JLL
FD MAG/WASHER
2/10/22, JFO

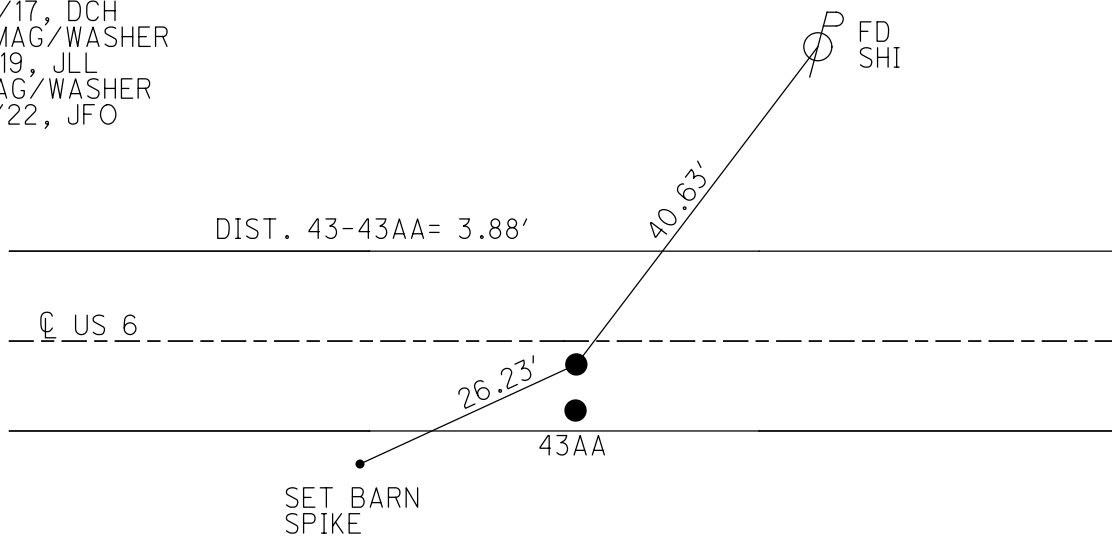

O.D.O.T. DISTRICT 2 SURVEY OFFICE (USE ONLY)

PERSONNEL

REFERENCE NO. 43

SHEET 16 OF 34

NOTES LEU

DATE 8/6/18

ROUTE US 6

H.C. LEU

WEATHER CLOUDY

COUNTY SANDUSKY

R.C. HAGEMEYER

TEMP. 78°

TOWNSHIP TOWNSEND

SECTION 7

DWG BY AUBLE PID 95769

T 5 N R 17 E

TYPE MONUMENT P.K.SHANK

ON SURFACE - ~~BELOW~~ ON

OFFSET CL PAVEMENT 0.3' ~~LT~~ : RT

11' TO RT EDGE PAVEMENT


STATION: 1436+56

HORZ.DATUM: NAD83 (2011)


GEOID: 2012A

GRID: NORTHING: 635017.654

EASTING: 1846742.729

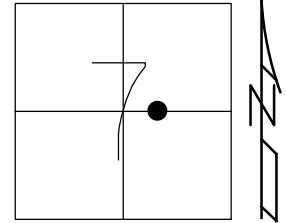


RECORD: P.I.
Δ= 00° 20' LT (PLAN)
STA 196+14.60
FD BOAT SPIKE
2" DOWN
FD P.K./WASHER
1.25" DOWN
FD P.K.WASHER
3/16/02, DCH
SET P.K./WASHER
6/11/02, DCH
FD P.K.SHANK
REF43
11/23/17, DCH
SET MAG/WASHER
7-31-19, JLL

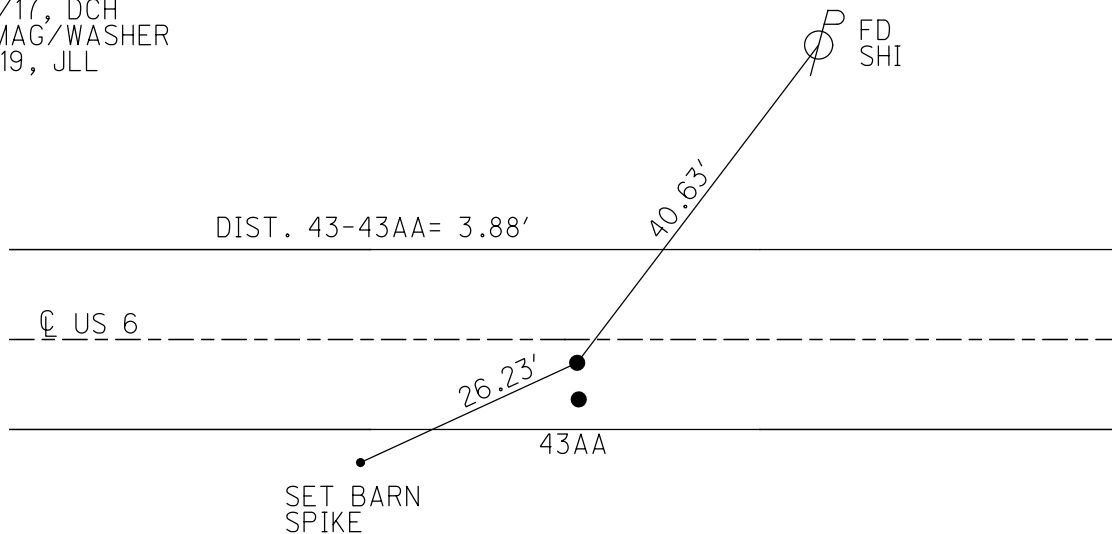


O.D.O.T. DISTRICT 2 SURVEY OFFICE (USE ONLY)

PERSONNEL _____ REFERENCE NO. 43 SHEET 14 OF 31
 NOTES ROUSOS DATE 03/16/02 ROUTE US 6
 H.C. VAN DUSEN WEATHER WINDY COUNTY SANDUSKY
 R.C. MOSSER TEMP. 28° TOWNSHIP TOWNSEND
 _____ SECTION 7
 T 5 N R 17 E

TYPE MONUMENT _____ PK/WASHER _____
 ON SURFACE - ~~BELOW~~ _____ ON _____
~~LEFT~~ - CL PAV'T - RIGHT _____ 1'
11.0' TO RT EDGE PAVEMENT
 S.L.M. _____ 1436+56
 GRID: NORTHING: _____ - EASTING: _____ -

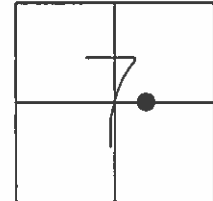

RECORD: PI
 DELTA= 00° 20' LT (PLAN)
 STA 196+14.60
 BOAT SPIKE 2" BELOW
 (FD PK/WASHER 1.25" BELOW SURFACE)
 SET PK/WASHER
 06/11/02 DCH
 DIST 43-43AA=3.88'

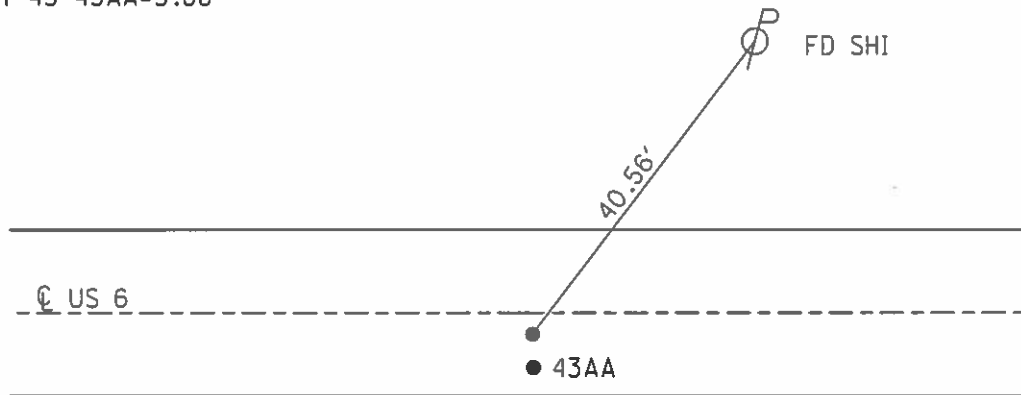

O.D.O.T. DISTRICT 2 SURVEY OFFICE

PERSONNEL

REFERENCE NO. 43

SHEET 12 OF 27

NOTES ROUSOS

DATE 3/16/02

ROUTE SR 6

H.C. VAN DUSEN

WEATHER WINDY

COUNTY SANDUSKY

R.C. MOSSER

TEMP. 28°

TOWNSHIP TOWNSEND

HOMAN

SECTION 7

T 5 N R 17 E


TYPE MONUMENT PK/WASHER

ON SURFACE - BELOW ON

LEFT - ℄ PAV'T - ~~RIGHT~~ "A" = 1' RT "B" 5' RT


TO EDGE PAVEMENT "A" 11' TO RT EDGE
"B" 7.7' TO RT EDGE

S.L.M. 1436+56

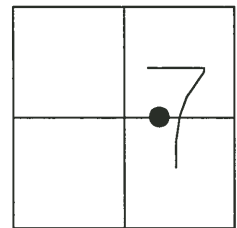

"A"
P.I. DELTA= 00° 20' LT (PLAN)
STA 196+14.60
BOAT SPIKE 2" BELOW
(FD PK/WASHER 1.25" BELOW SURFACE
"B"
PK/WASHER 3" BELOW
PLAN: CORNER STONE 5.4' RT OF ℄
BOOK #1: CORNER STONE 5.2' RT OF ℄
RESET PK/WASHER

SET PK/WASHER
6-11-02
DCH

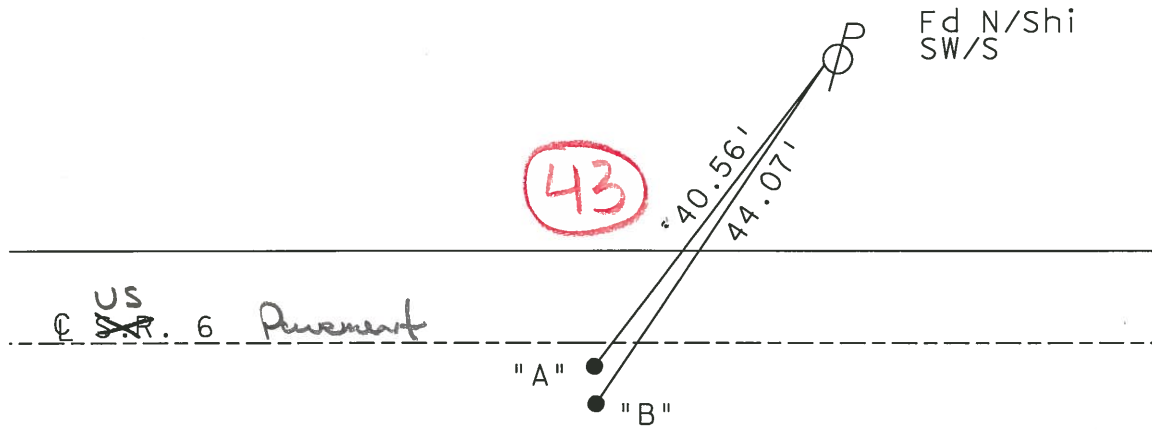

DIST "A" - "B" = 3.88'

O.D.O.T. DISTRICT 2 SURVEY OFFICE

PERSONNEL

REFERENCE NO. _____

SHEET 24 OF 39

NOTES CHENEY

H.C. RIPPLE

R.C. BARBOUR

DATE 9-16-1991

WEATHER SUNNY

TEMP. 85°

ROUTE 6


COUNTY SANDUSKY

TOWNSHIP TOWNSEND

SECTION 7

T 5 N R 17 E

TYPE MONUMENT PK₅/WASHERS
 ON SURFACE - BELOW "A" - 1.25' BELOW "B" - ON
~~LEFT~~ - & PAV'T. - RIGHT "A" - 1' ± "B" - 5' ±
TO - EDGE PAVEMENT
 S.L.M. 1436 + 56

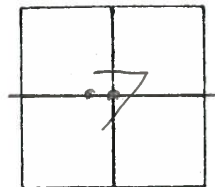

"A"

P.I. $\Delta = 00^{\circ}20'$ LT. (PLAN)

STA. 196 + 14.60

BOAT SPK. 2" ± BELOW (FD. PK/WASHER 1.25" BELOW SURFACE)


"B"

PK/WASHER 3" ± BELOW

PLAN: CORNER STONE 5.4' RT. OF &

BOOK #1; CORNER STONE 5.2' RT. OF &

RE-SET P.K./WASHER

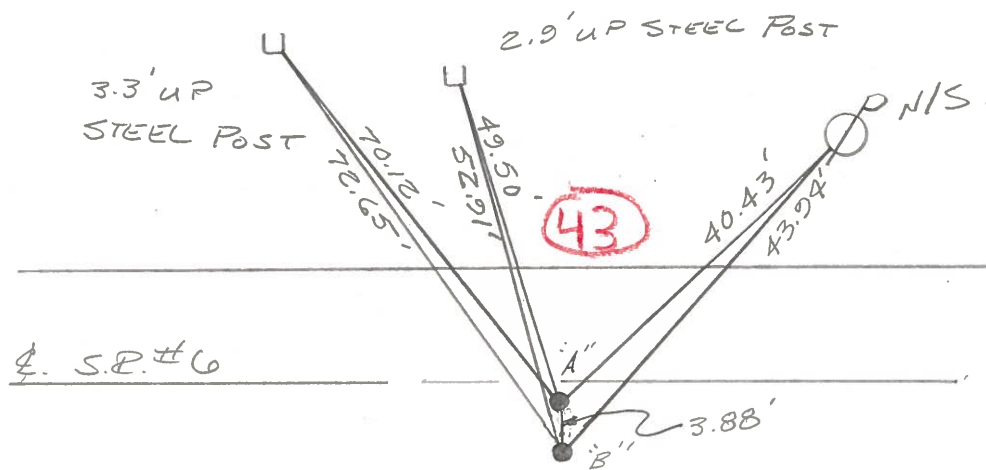

OD.O.T. DISTRICT 2 SURVEY OFFICE

SHEET _____ OF _____

County Sandusky S. R. U.S. #6

Township Townsend

Section 7

T5N, R12E

Personnel Cronin

Ripple


Geyman

Barbour

Date 9/24/84

Weather sunny

Temp. 70°

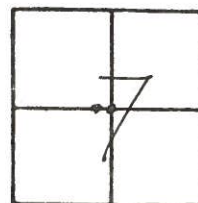

(43)


4/03/91
40°

1436+56

P.I. Δ = 00°20' Lt. (Plan)

196+14.60

Root spike 2'± below
surface

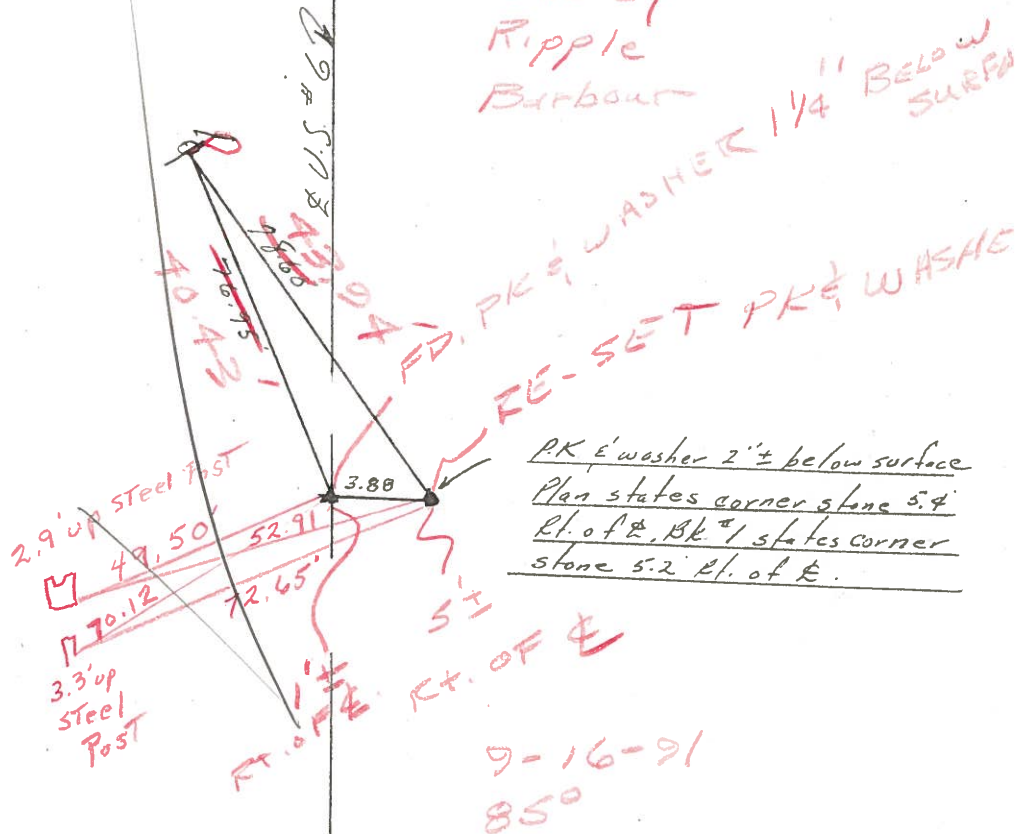

Cheney
Ripple
Barbour

PK & washer 2'± below surface
Plan states corner stone 5.4'
Rt. of E, Bk. #1 states corner
stone 5.2' Rt. of E.

9-16-91
850

Q.D.O.T. DISTRICT 2 SURVEY OFFICE

SHEET _____ OF _____

County Sandusky S. R. U.S. #6

Township Townsend

Section 7

T5N, R12E

Personnel Cronin

Ripple


Geyman

Barbour

Date 9/24/84

Weather sunny

Temp. 70°

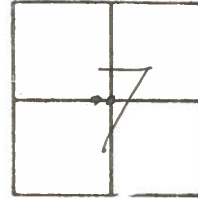


P.I. Δ = 00°20'44" (Plan)

196 + 14.60

Root spike 2'± below
surface

43

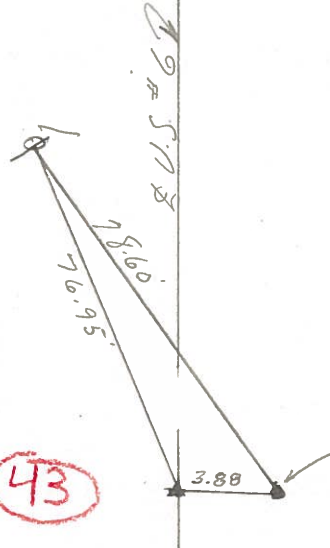

P.K. E' washer 2'± below surface
Plan states corner stone 5.4'
Rt. of E. Bk. #1 states corner
stone 5.2' Rt. of E.

SHEET NO. 13

Tied 7/31/75

DATE drawn 7/30/75

PERSONNEL	TITLE	PERSONNEL	TITLE
<u>Oronin</u>		<u>Schneider</u>	
<u>Ash</u>		<u>Mosser</u>	
<u>Geyman</u>		<u>Barbour</u>	

COUNTY SanduskyS. R. # 6WEATHER SunnySEC. K - Fremont-EastTEMP. 83°DESCRIPTION Ties for Control Points

JOB NO.

