

O.D.O.T. DISTRICT 2 SURVEY OFFICE (USE ONLY)

PERSONNEL

REFERENCE NO. 43 AA

SHEET 17 OF 34

NOTES PRESTON-COLVIN

DATE 9-5-24

ROUTE US 6

H.C. NEISE

WEATHER SUNNY

COUNTY SANDUSKY

R.C. BARRIERE

TEMP. 62°

TOWNSHIP TOWNSEND

DWG BY PRESTON-COLVIN

PID PAVING TRAIN

SECTION 7

T 5 N R 17 E

TYPE MONUMENT MEG/WASHER

ON SURFACE - ~~BELOW~~ ON

OFFSET CL PAVEMENT 5.0' ~~LT~~ : RT

7.7' TO RT EDGE PAVEMENT

STATION: 1436+56

HORIZ.DATUM: NAD83 (2011)


GEOID: NAVD88 2018

GRID: NORTHING: 635013.778

EASTING: 1846742.462

LDP: NORTHING: 331325.6

EASTING: 206872

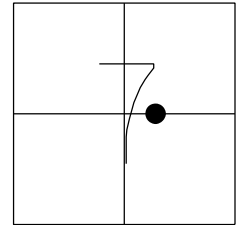

RECORD:

FD P.K./WASHER

3" DOWN

PLAN: CORNER STONE 5.4' RT OF CL

BOOK#1: CORNER STONE 5.2' RT OF CL

SET P.K./WASHER

FD P.K./WASHER

3/16/02, DCH

SET P.K./WASHER

6/11/02, DCH

FD P.K.SHANK

REFA43

11/23/17, DCH

SET MAG/WASHER

7-31-19, JLL

FD MAG/WASHER

2/10/22, JFO

1/20/23, JMR


FD MAG/WASHER

REF 43AA

9/5/24, TDN

FD MAG/WASHER

10/3/24, JAM

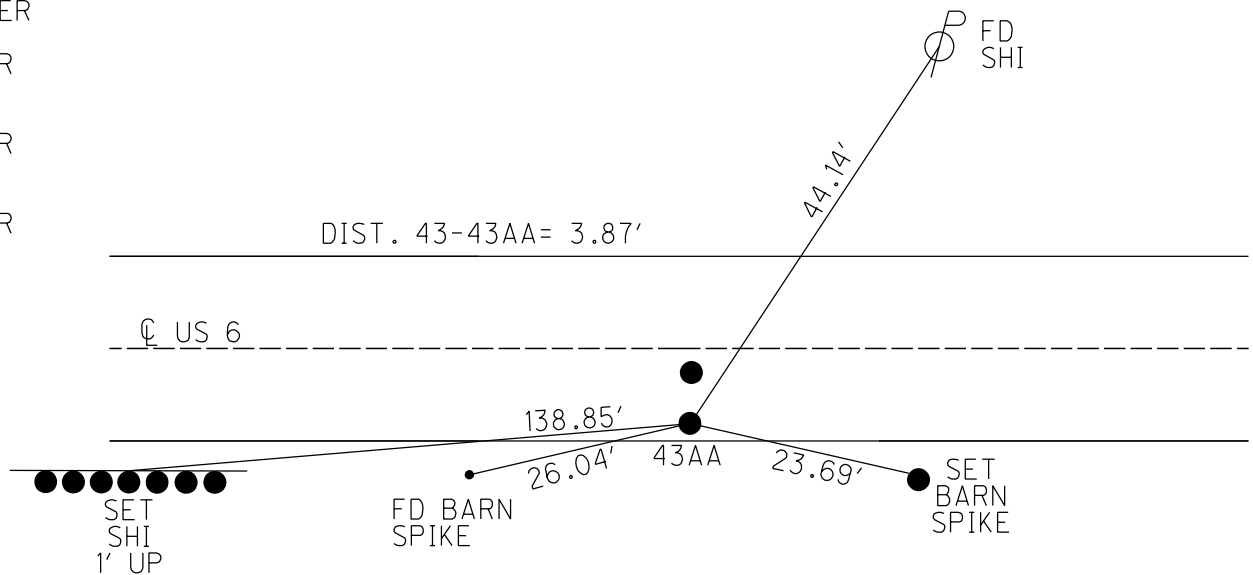

O.D.O.T. DISTRICT 2 SURVEY OFFICE (USE ONLY)

PERSONNEL

REFERENCE NO. 43 AA

SHEET 17 OF 34

NOTES LEU

DATE 8/6/18

ROUTE US 6

H.C. LEU

WEATHER CLOUDY

COUNTY SANDUSKY

R.C. HAGEMeyer

TEMP. 78°

TOWNSHIP TOWNSEND

DWG BY AUBLE

PID PAVETRAIN

SECTION 7

T 5 N R 17 E

TYPE MONUMENT P.K.SHANK

ON SURFACE - ~~BELOW~~ ON

OFFSET CL PAVEMENT 5.0' ~~LT~~ : RT

7.7' TO RT EDGE PAVEMENT


STATION: 1436+56

HORZ.DATUM: NAD83 (2011)

GEOID: 2012A

GRID: NORTHING: 635013.778

EASTING: 1846742.462

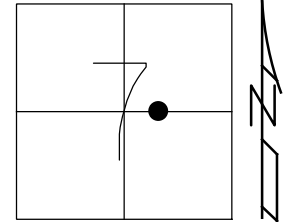

RECORD:

FD P.K./WASHER

3" DOWN

PLAN: CORNER STONE 5.4' RT OF CL

BOOK#1: CORNER STONE 5.2' RT OF CL

SET P.K./WASHER

FD P.K./WASHER

3/16/02, DCH

SET P.K./WASHER

6/11/02, DCH

FD P.K.SHANK

REFA43

11/23/17, DCH


SET MAG/WASHER

7-31-19, JLL

FD MAG/WASHER

2/10/22, JFO

1/20/23, JMR

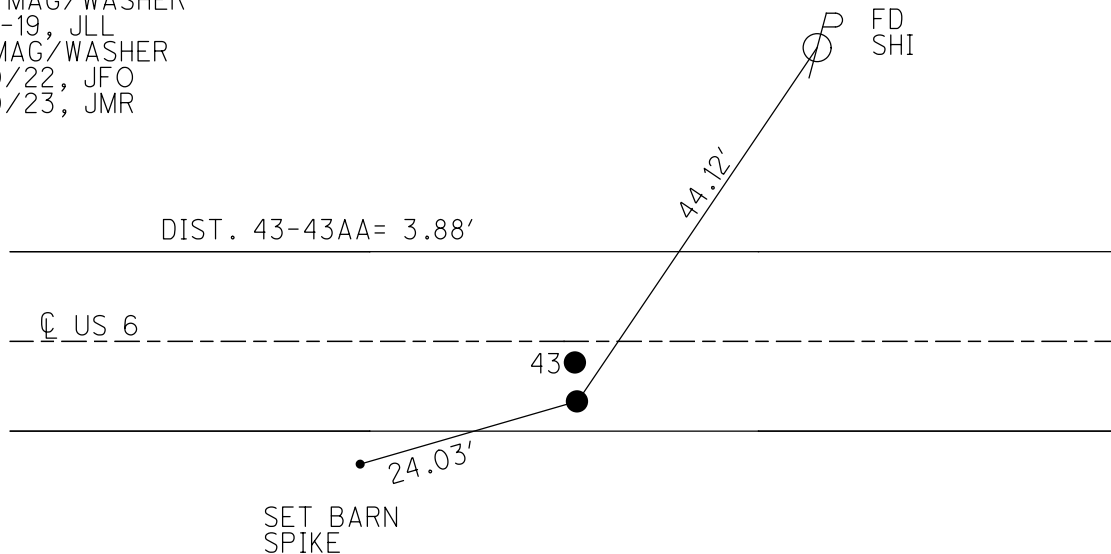

O.D.O.T. DISTRICT 2 SURVEY OFFICE (USE ONLY)

PERSONNEL

REFERENCE NO. 43 AA

SHEET 17 OF 34

NOTES LEU

DATE 8/6/18

ROUTE US 6

H.C. LEU

WEATHER CLOUDY

COUNTY SANDUSKY

R.C. HAGEMEYER

TEMP. 78°

TOWNSHIP TOWNSEND

DWG BY AUBLE

PID 95769

SECTION 7

T 5 N R 17 E

TYPE MONUMENT P.K.SHANK

ON SURFACE - ~~BELOW~~ ON

OFFSET CL PAVEMENT 5.0' ~~LT~~ : RT

7.7' TO RT EDGE PAVEMENT


STATION: 1436+56

HORIZ.DATUM: NAD83 (2011)

GEOID: 2012A

GRID: NORTHING: 635013.778

EASTING: 1846742.462

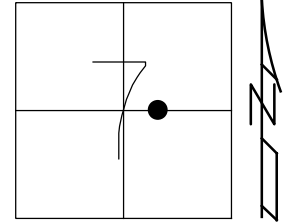

RECORD:

FD P.K./WASHER

3" DOWN

PLAN: CORNER STONE 5.4' RT OF CL

BOOK#1: CORNER STONE 5.2' RT OF CL

SET P.K./WASHER

FD P.K./WASHER

3/16/02, DCH

SET P.K./WASHER

6/11/02, DCH

FD P.K.SHANK

REFA43


11/23/17, DCH

SET MAG/WASHER

7-31-19, JLL

FD MAG/WASHER

2/10/22, JFO

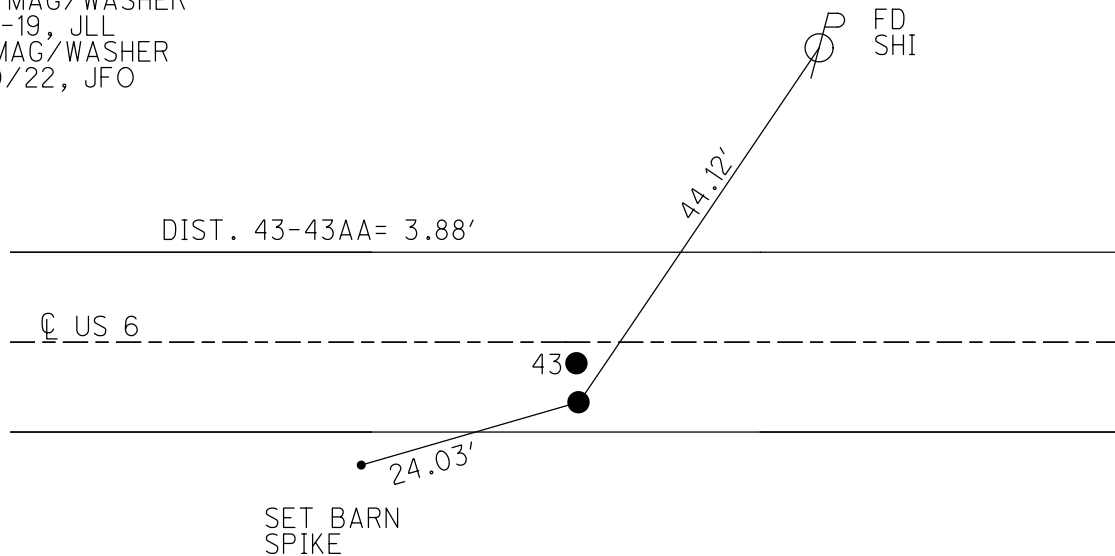

O.D.O.T. DISTRICT 2 SURVEY OFFICE (USE ONLY)

PERSONNEL

REFERENCE NO. 43 AA

SHEET 17 OF 34

NOTES LEU

DATE 8/6/18

ROUTE US 6

H.C. LEU

WEATHER CLOUDY

COUNTY SANDUSKY

R.C. HAGEMEYER

TEMP. 78°

TOWNSHIP TOWNSEND

DWG BY AUBLE

PID 95769

SECTION 7

T 5 N R 17 E

TYPE MONUMENT P.K.SHANK

ON SURFACE - ~~BELOW~~ ON

OFFSET CL PAVEMENT 5.0' ~~LT~~ : RT

7.7' TO RT EDGE PAVEMENT


STATION: 1436+56

HORZ.DATUM: NAD83 (2011)

GEOID: 2012A

GRID: NORTHING: 635013.778

EASTING: 1846742.462

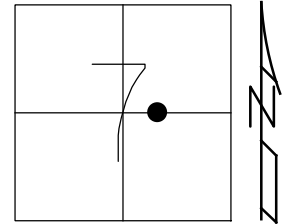

RECORD:

FD P.K./WASHER

3" DOWN

PLAN: CORNER STONE 5.4' RT OF CL

BOOK#1: CORNER STONE 5.2' RT OF CL

SET P.K./WASHER

FD P.K./WASHER

3/16/02, DCH

SET P.K./WASHER

6/11/02, DCH


FD P.K.SHANK

REFA43

11/23/17, DCH

SET MAG/WASHER

7-31-19, JLL

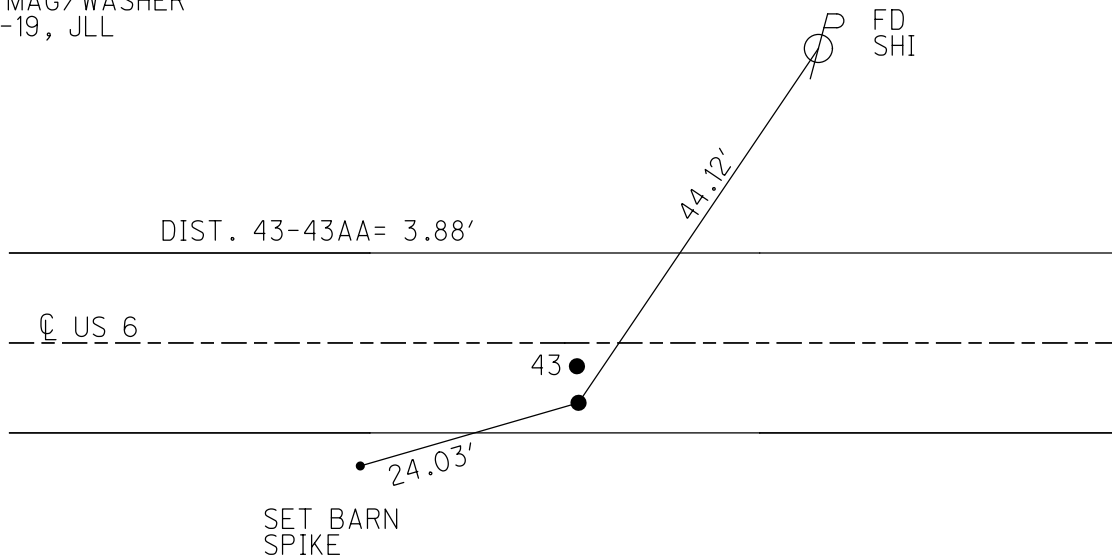

O.D.O.T. DISTRICT 2 SURVEY OFFICE (USE ONLY)

PERSONNEL

REFERENCE NO. 43 AA

SHEET 15 OF 31

NOTES

ROUSOS

DATE

03/16/02

ROUTE

US 6

H.C.

VAN DUSEN

WEATHER

WINDY

COUNTY

SANDUSKY

R.C.

MOSSER

TEMP.

28°

TOWNSHIP

TOWNSEND

HOMAN

SECTION

7

T 5 N R 17 E

TYPE MONUMENT

PK/WASHER

ON SURFACE - ~~BELOW~~

ON

~~LEFT~~ - ℄ PAV'T - RIGHT

5'

7.7' TO RT EDGE PAVEMENT

S.L.M.


1436+56

GRID: NORTHING:

-

EASTING:

-

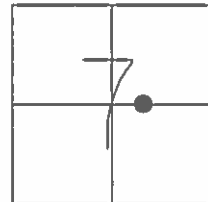

RECORD:

PK/WASHER 3" BELOW

PLAN: CORNER STONE 5.4' RT OF ℄


BOOK#1: CORNER STONE 5.2' RT OF ℄

SET PK/WASHER

SET PK/WASHER

06/11/02 DCH

DIST 43-43AA=3.88'

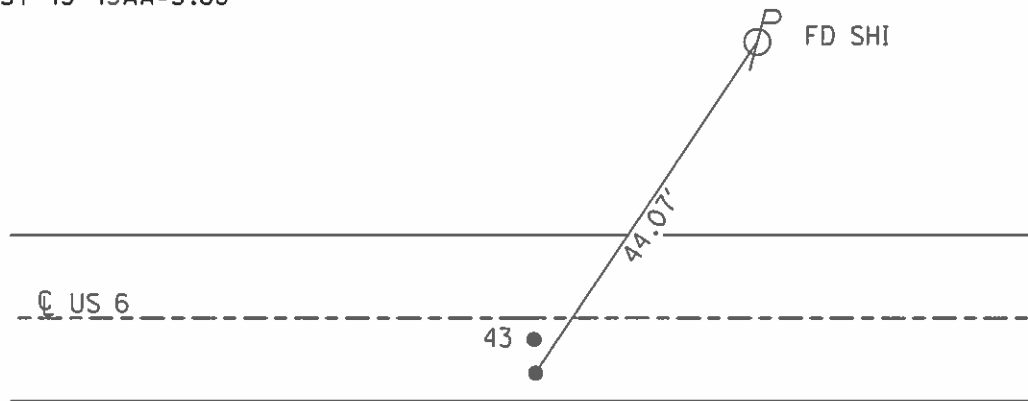

O.D.O.T. DISTRICT 2 SURVEY OFFICE

PERSONNEL

REFERENCE NO. 43

SHEET 12 OF 27

NOTES ROUSOS

DATE 3/16/02

ROUTE US 6

H.C. VAN DUSEN

WEATHER WINDY

COUNTY SANDUSKY

R.C. MOSSER

TEMP. 28°

TOWNSHIP TOWNSEND

HOMAN

SECTION 7

T 5 N R 17 E


TYPE MONUMENT PK/WASHER

ON SURFACE - BELOW ON

LEFT - Q PAV'T - RIGHT "A" = 11' RT "B" 5' RT


TO EDGE PAVEMENT "A" 11' TO RT EDGE

S.L.M. 1436+56 "B" 7.7' TO RT EDGE

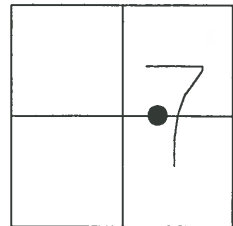

"A"
P.I. DELTA= 00° 20' LT (PLAN)
STA 196+14.60
BOAT SPIKE 2" BELOW
(FD PK/WASHER 1.25" BELOW SURFACE)
"B"
PK/WASHER 3" BELOW
PLAN: CORNER STONE 5.4' RT OF Q
BOOK#1: CORNER STONE 5.2' RT OF Q
RESET PK/WASHER

SET PK/WASHER
6-11-02
DCH

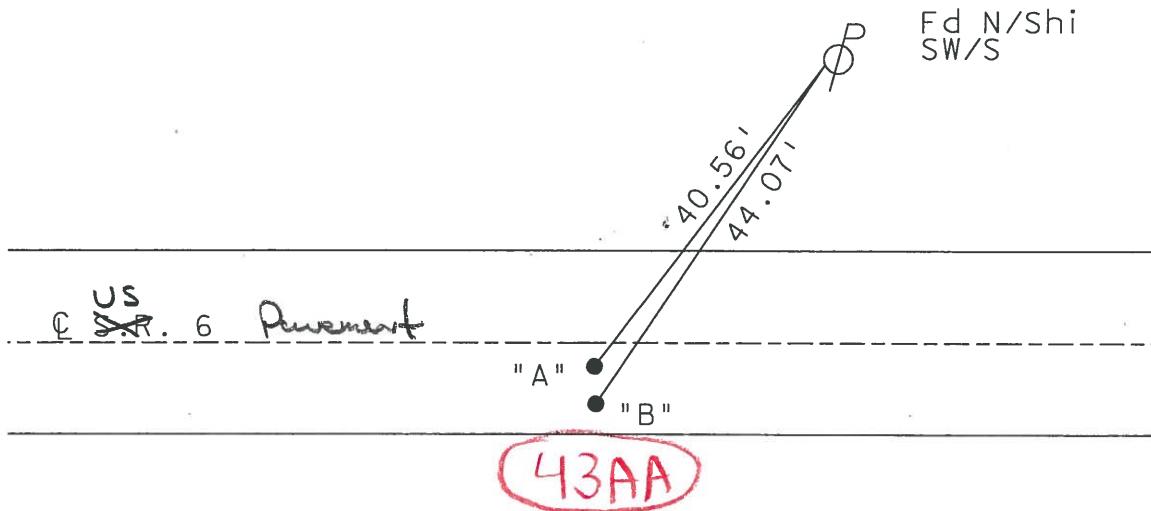

DIST "A" - "B" = 3.88'

O.D.O.T. DISTRICT 2 SURVEY OFFICE

PERSONNEL

REFERENCE NO. _____

SHEET 24 OF 39

NOTES CHENEY

H.C. RIPPLE

R.C. BARBOUR

DATE 9-16-1991

WEATHER SUNNY

TEMP. 85°

ROUTE 6


COUNTY SANDUSKY

TOWNSHIP TOWNSEND

SECTION 7

T 5 N R 17 E

TYPE MONUMENT PKs/WASHERS
ON SURFACE - BELOW "A" - 1.25' BELOW "B" - ON
LEFT - & PAV'T. - RIGHT "A" - 1' ± "B" - 5' ±
TO - EDGE PAVEMENT
S.L.M. 1436+56

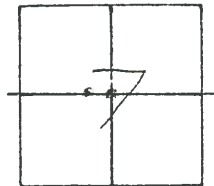

"A"

P.I. $\Delta = 00^{\circ}20'$ LT. (PLAN)

STA. 196+14.60

BOAT SPR. 2" ± BELOW (FO PK/WASHER 1.25" BELOW SURFACE)


"B"

PK/WASHER 3" ± BELOW

PLAN: CORNER STONE 5.4' RT. OF &

BOOK #1: CORNER STONE 5.2' RT OF &

RE-SET PK/WASHER

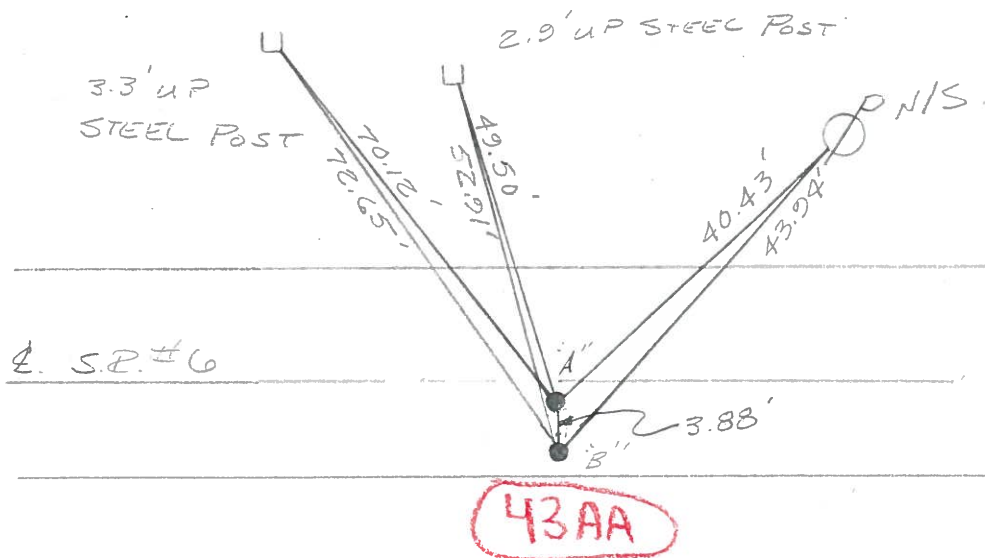

OD.O.T. DISTRICT 2 SURVEY OFFICE

SHEET _____ OF _____

County Sandusky S.R. U.S. #6

Township Townsend

Section 7

T5N, R12E

Personnel Cronin

Ripple


Geyman

Barbour

Date 9/24/84

Weather sunny

Temp. 70°

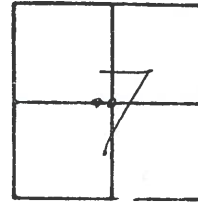

43AA


4103/91
40°

1436+56

P.I. A = 00°20'44" (Plan)

196+14.60

Boat spike 2' below
surface

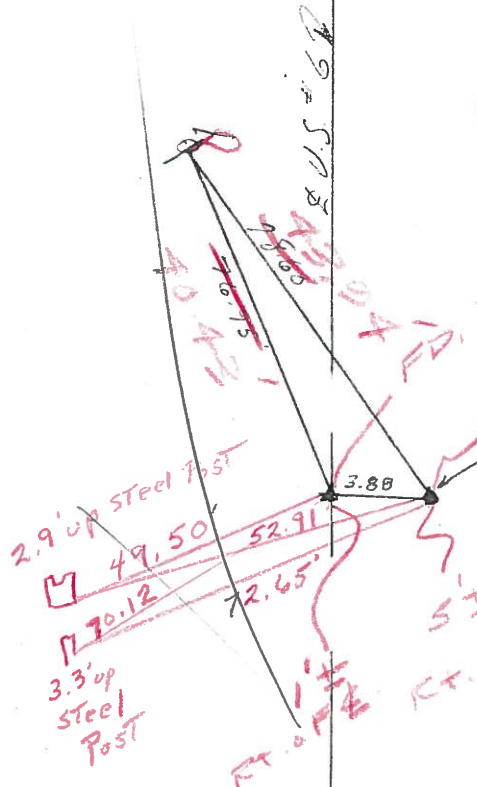

Cheney
Ripple
Barbour

FD, PK & WASHER 1 1/4" BELOW SURFACE

RE-SET PK & WASHER

PK & washer 2' ± below surface
Plan states corner stone 5.4'
El. of E. Bk. 1 states corner
stone 5.2 El. of E.

9-16-91
85°

Q.D.O.T. DISTRICT 2 SURVEY OFFICE

SHEET _____ OF _____

County Sandusky S. R. U.S. #6

Township Townsend

Section 7

T 5 N, R 17 E

Personnel Cronin

Ripple


Gschman

Barbour

Date 9/24/84

Weather sunny


Temp. 70°

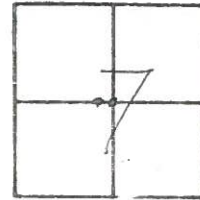

P.I. Δ = 00°20'44" (Plan)

196+14.60

Post spike 2'± below
surface

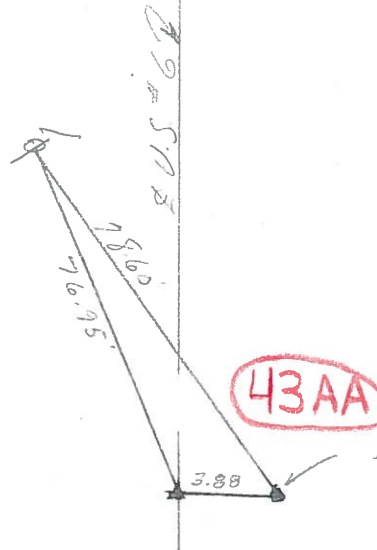

AK & washer 2'± below surface
Plan states corner stone 5.4'
lt. of E, Bk 1 states corner
stone 5.2 lt. of E.

PERSONNEL	TITLE	PERSONNEL	TITLE
Cronin		Schneider	
Ash		Mosser	
Geyman		Barbour	

COUNTY Sandusky

Tied 7/31/75
DATE drawn 7/30/75

S. R. # 6

WEATHER Sunny

SEC. "L" - Fremont - East

TEMP. 83°

DESCRIPTION Ties for Control Points

JOB NO.

