

O.D.O.T. DISTRICT 2 SURVEY OFFICE (USE ONLY)

PERSONNEL

REFERENCE NO. 43 A

SHEET 18 OF 34

NOTES PRESTON-COLVIN

DATE 9-5-24

ROUTE US 6

H.C. NEISE

WEATHER SUNNY

COUNTY SANDUSKY

R.C. BARRIERE

TEMP. 62°

TOWNSHIP TOWNSEND

DWG BY PRESTON-COLVIN

PID PAVING TRAIN

SECTION 7

T 5 N R 17 E

TYPE MONUMENT MEG/WASHER

ON SURFACE - ~~BELOW~~ ON

OFFSET 0.8' ~~LT~~ : RT

12' TO LT EDGE PAVEMENT

STATION: 1448+44

HORIZ.DATUM: NAD83 (2011)


GEOID: NAVD88 2018

GRID: NORTHING: 634956.064


EASTING: 1847928.742

LDP: NORTHING: 331276.1

EASTING: 208058.8

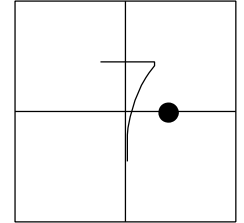

RECORD: P.I.
 $\Delta=00^{\circ} 45' \text{ RT (PLAN)}$
 STA. 208+01.90
 PREVIOUS MONUMENTS:
 P.K./WASHER
 BOAT SPIKE
 FD P.K./WASHER
 3/16/02, DCH
 SET P.K./WASHER
 6/11/02, DCH
 FD P.K./WASHER
 REFB43
 11/23/17, DCH
 SET MAG/WASHER
 7/31/19, JLL
 FD MAG/WASHER
 2/10/22, JFO
 1/20/23, JMR
 FD MAG/WASHER
 REF 43A
 9/5/24, TDN
 FD MAG/WASHER
 10/3/24, JAM

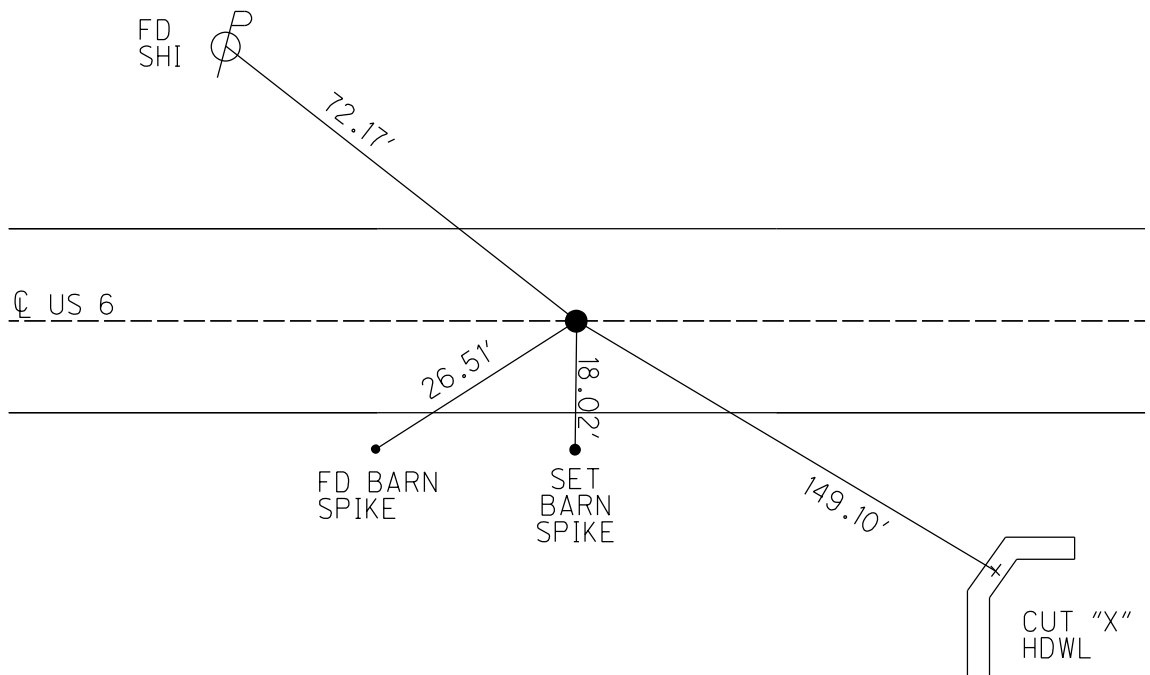

O.D.O.T. DISTRICT 2 SURVEY OFFICE (USE ONLY)

PERSONNEL

REFERENCE NO. 43 A

SHEET 18 OF 34

NOTES LEU

DATE 08-06-2018

ROUTE US 6

H.C. LEU

WEATHER CLOUDY

COUNTY SANDUSKY

R.C. HAGEMEYER

TEMP. 78°

TOWNSHIP TOWNSEND

DWG BY AUBLE

PID PAVETRAIN

SECTION 7

T 5 N R 17 E

TYPE MONUMENT P.K./WASHER

ON SURFACE - ~~BELOW~~ ON

OFFSET CL PAVEMENT 0.8' LT : ~~RT~~

12' TO LT EDGE PAVEMENT


STATION: 1448+44

HORZ.DATUM: NAD83 (2011)


GEOID: 2012A

GRID: NORTHING: 634956.064

EASTING: 1847928.742

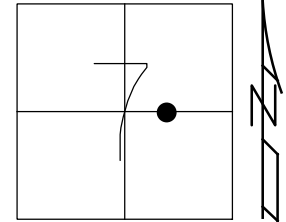

RECORD: P.I.
 $\Delta=00^{\circ} 45' RT (PLAN)$
STA. 208+01.90
PREVIOUS MONUMENTS:
P.K./WASHER
BOAT SPIKE
FD P.K./WASHER
3/16/02, DCH
SET P.K./WASHER
6/11/02, DCH
FD P.K./WASHER
REFB43
11/23/17, DCH
SET MAG/WASHER
7/31/19, JLL
FD MAG/WASHER
2/10/22, JFO
1/20/23, JMR

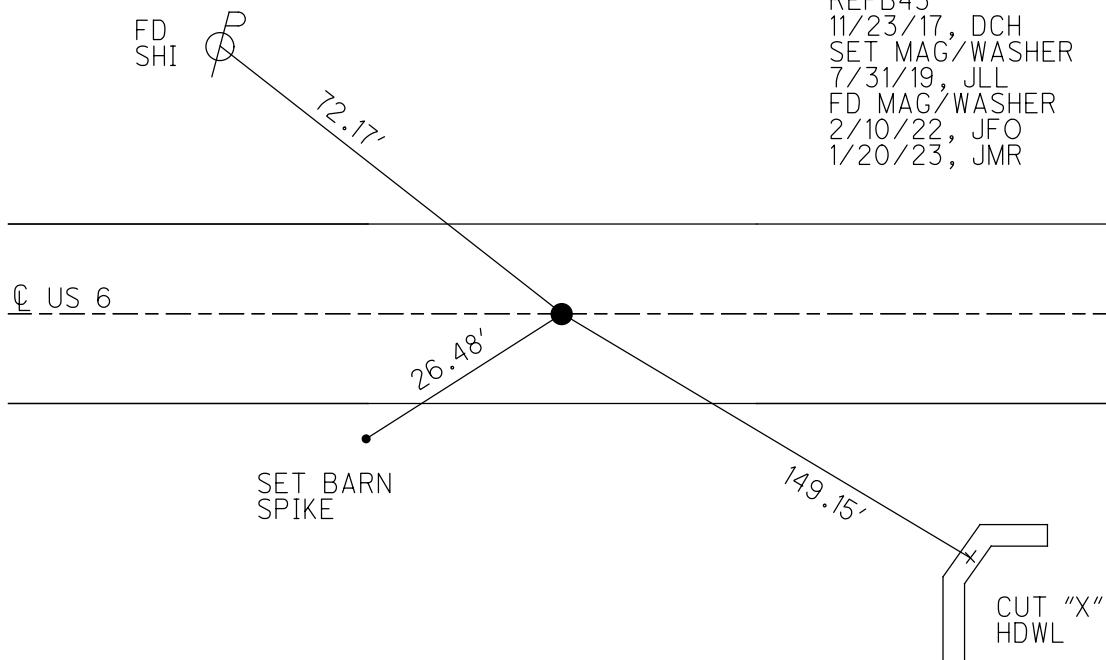

O.D.O.T. DISTRICT 2 SURVEY OFFICE (USE ONLY)

PERSONNEL

REFERENCE NO. 43 A

SHEET 18 OF 34

NOTES LEU

DATE 08-06-2018

ROUTE US 6

H.C. LEU

WEATHER CLOUDY

COUNTY SANDUSKY

R.C. HAGEMeyer

TEMP. 78°

TOWNSHIP TOWNSEND

DWG BY AUBLE

PID 95769

SECTION 7

T 5 N R 17 E

TYPE MONUMENT P.K./WASHER

ON SURFACE - ~~BELOW~~ ON

OFFSET CL PAVEMENT 0.8' LT : ~~RT~~

12' TO LT EDGE PAVEMENT


STATION: 1448+44

HORIZ.DATUM: NAD83 (2011)


GEOID: 2012A

GRID: NORTHING: 634956.064

EASTING: 1847928.742

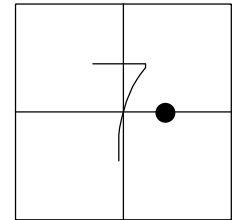

RECORD: P.I.
 $\Delta=00^{\circ} 45' RT$ (PLAN)
STA. 208+01.90
PREVIOUS MONUMENTS:
P.K./WASHER
BOAT SPIKE
FD P.K./WASHER
3/16/02, DCH
SET P.K./WASHER
6/11/02, DCH
FD P.K./WASHER
REFB43
11/23/17, DCH
SET MAG/WASHER
7/31/19, JLL
FD MAG/WASHER
2/10/22, JFO

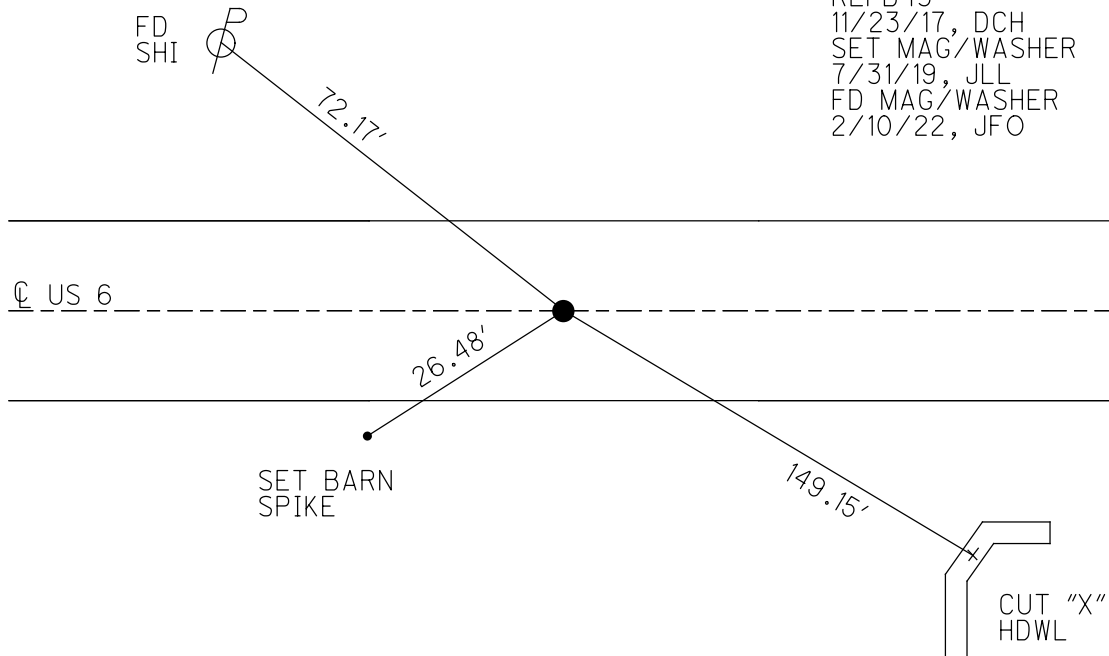

O.D.O.T. DISTRICT 2 SURVEY OFFICE (USE ONLY)

PERSONNEL

REFERENCE NO. 43 A

SHEET 18 OF 34

NOTES LEU

DATE 08-06-2018

ROUTE US 6

H.C. LEU

WEATHER CLOUDY

COUNTY SANDUSKY

R.C. HAGEMeyer

TEMP. 78°

TOWNSHIP TOWNSEND

DWG BY AUBLE

PID 95769

SECTION 7

T 5 N R 17 E

TYPE MONUMENT P.K./WASHER

ON SURFACE - ~~BELOW~~ ON

OFFSET Q PAVEMENT 0.8' LT : ~~RT~~

12' TO LT EDGE PAVEMENT


STATION: 1448+44

HORZ.DATUM: NAD83 (2011)


GEOID: 2012A

GRID: NORTHING: 634956.064

EASTING: 1847928.742

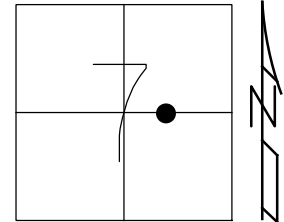


RECORD: P.I.
 $\Delta=00^{\circ} 45' RT$ (PLAN)
STA. 208+01.90
PREVIOUS MONUMENTS:
P.K./WASHER
BOAT SPIKE
FD P.K./WASHER
3/16/02, DCH
SET P.K./WASHER
6/11/02, DCH
FD P.K./WASHER
REFB43
11/23/17, DCH
SET MAG/WASHER
7/31/19, JLL

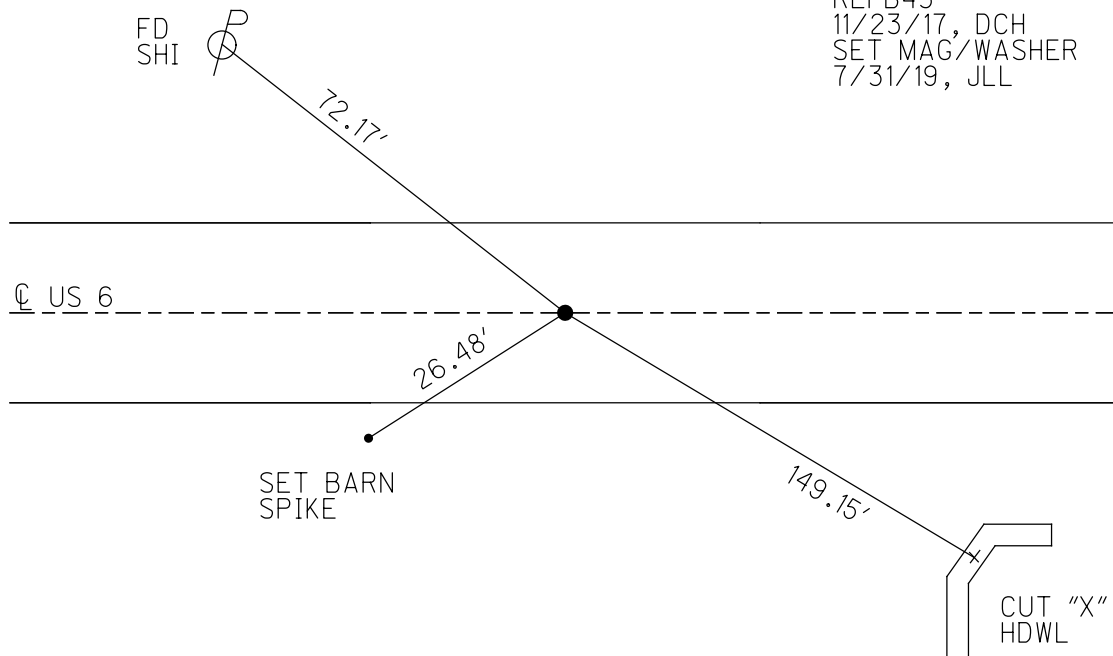


O.D.O.T. DISTRICT 2 SURVEY OFFICE (USE ONLY)

PERSONNEL _____ REFERENCE NO. 43 A SHEET 16 OF 31
 NOTES ROUSOS DATE 03/16/02 ROUTE US 6
 H.C. VAN DUSEN WEATHER WINDY COUNTY SANDUSKY
 R.C. MOSSER TEMP. 28° TOWNSHIP TOWNSEND
 _____ SECTION 7
 T 5 N R 17 E

TYPE MONUMENT _____ PK/WASHER _____
 ON SURFACE - ~~BELOW~~ _____ ON _____
~~LEFT~~ - Q PAV'T - ~~RIGHT~~ _____ ON _____
12' TO LT. EDGE PAVEMENT
 S.L.M. _____ 1448+44
 GRID: NORTHING: _____ - _____ EASTING: _____ - _____

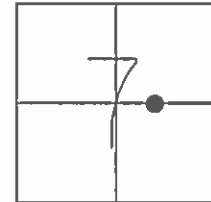

RECORD: P1
 DELTA=00°45' RT (PLAN)
 STA 208+01.90
 PREVIOUS MONUMENTS
 PK/WASHER
 BOAT SPK
 SET PK/WASHER
 06/11/02 DCH

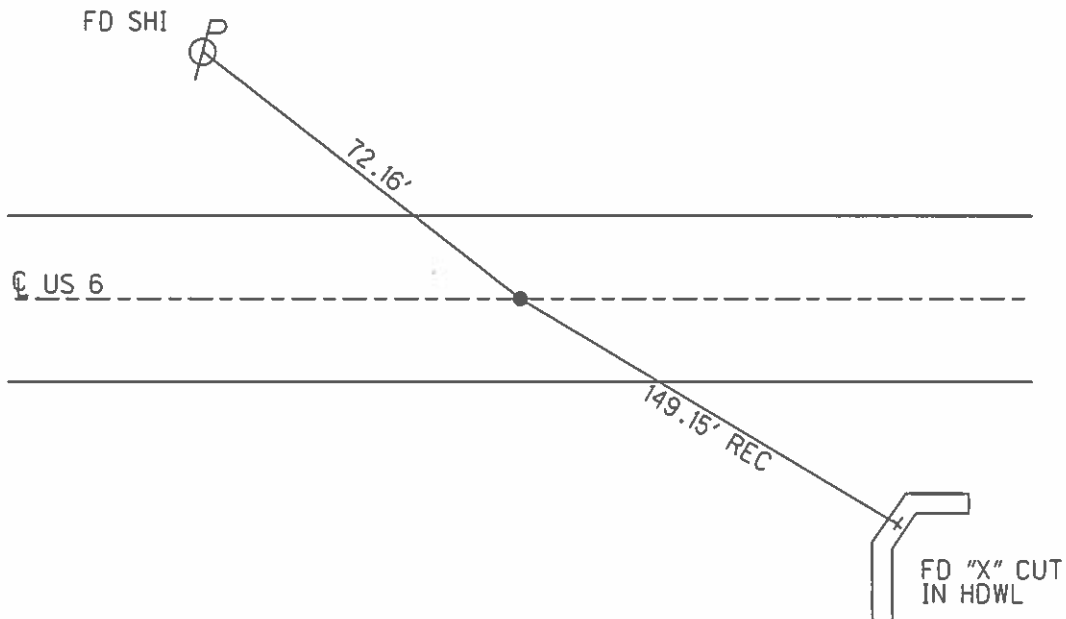

O.D.O.T. DISTRICT 2 SURVEY OFFICE

PERSONNEL

REFERENCE NO. _____

SHEET 25 OF 39

NOTES CHENLEY

H.C. RIPPLE

R.C. BARBON

DATE 9-16-1991

WEATHER Sunny

TEMP. 85°

ROUTE 6

COUNTY SANDUSKY

TOWNSHIP TOWNSENDSECTION 7

T5NR17E


TYPE MONUMENT PIC/WASHER

ON SURFACE - ~~BELOW~~ _____

LEFT - C PAV'T. - RIGHT _____

___JO___EDGE PAVEMENT

S.L.M. 1448 + 44

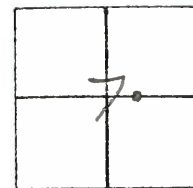

P. 1.

$$\Delta = 00^{\circ}45' \text{ KT. (PLAN)}$$

STA. 208+01.90


PREVIOUS MONUMENTS

P.K/WASHER

BOAT SPK.

43A

TACKED HUBS

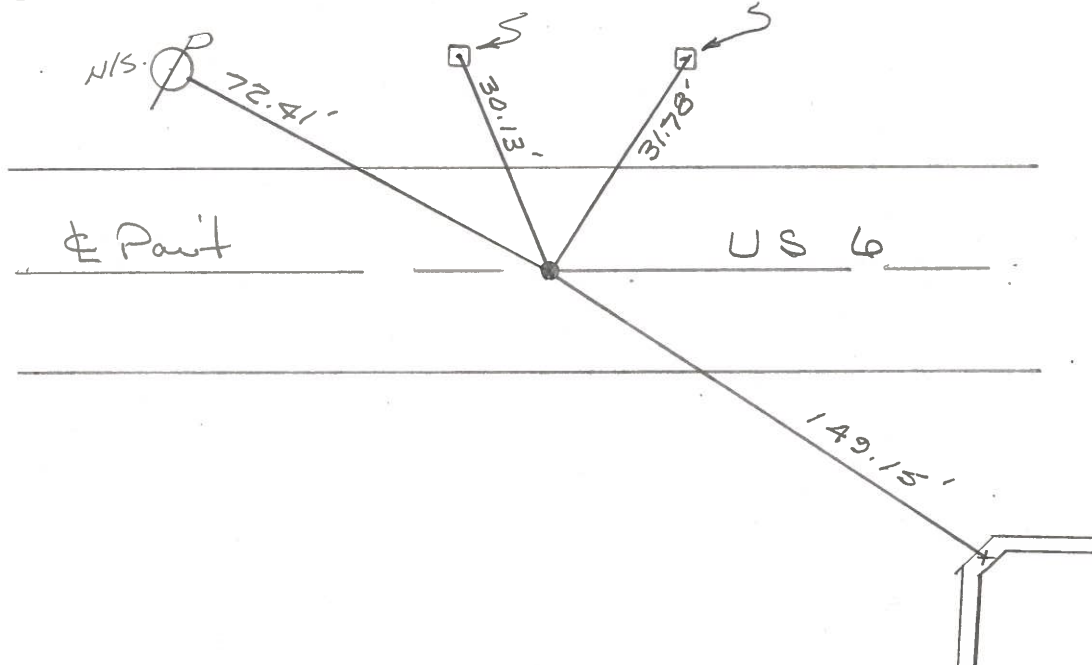

4" CUT IN HDWL.

Date 9/24/84

Weather sunny

Temp. 73°

N
A

Бейман

Barbour

43A

CHENEY
RIPPLE
BARBOUR

4/03/91
40°

$$1448 + 44$$

P.F. $\Delta = 00^{\circ}45'$ Rt. (Plgn)

208 + 0.90

Set P.K. washer atop
boat spike

RE-SET PKE WASHER
9-16-1991
85°

Tacked Hub

Tacked

906

5

30

14

✓

10

44

1

Q.D.O.T. DISTRICT 2 SURVEY OFFICE

SHEET _____ OF _____

County Sandusky S. R. U.S. #6

Township Townsend

Section 7

T5N, R12E

Personnel Cronin

Ripple


Geyman

Barbour


Date 9/24/84

Weather sunny

Temp. 73°

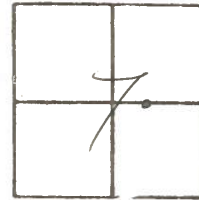

43A

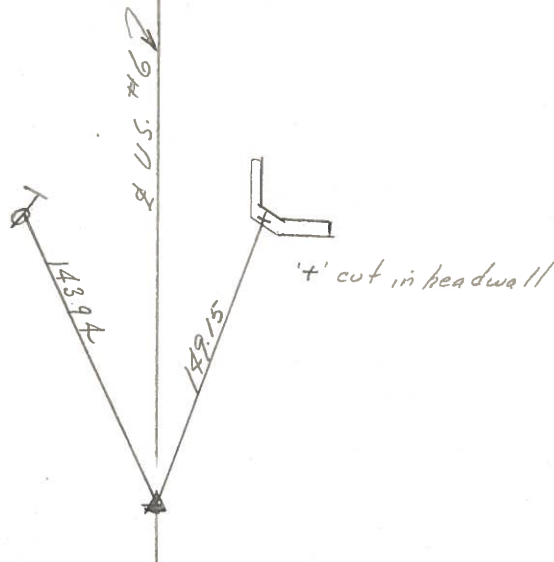

P.F. $\Delta = 00^\circ 45' \text{ Rt. (Plan)}$

208+01.90

Set P.K. Δ washer atop
boat spike

SHEET NO. 13

Tied 7/31/75

DATE drawn 7/30/75

PERSONNEL	TITLE	PERSONNEL	TITLE
<u>Cronin</u>		<u>Schneider</u>	
<u>Ash</u>		<u>Mosser</u>	
<u>Geyman</u>		<u>Barbour</u>	

COUNTY SanduskyS. R. # 6WEATHER SunnySEC. "K" - Fremant - EastTEMP. 83°DESCRIPTION Ties for Control Points

JOB NO. _____

