

# O.D.O.T. DISTRICT 2 SURVEY OFFICE (USE ONLY)

PERSONNEL

REFERENCE NO. 44

SHEET 19 OF 34

NOTES PRESTON-COLVIN

H.C. NEISE

R.C. BARRIERE

DATE 9-5-24

WEATHER SUNNY

TEMP. 62°

ROUTE US 6

COUNTY SANDUSKY

TOWNSHIP TOWNSEND

SECTION 8

T 5 N R 17 E

DWG BY PRESTON-COLVIN PID PAVING TRAIN

TYPE MONUMENT MEG/WASHER

ON SURFACE - ~~BELOW~~ ON

OFFSET  $\odot$  PAVEMENT 2.6' ~~LT~~ : RT

15.7' TO LT EDGE PAVEMENT

STATION: 1463+16

HORIZ.DATUM: NAD83 (2011)


GEOID: NAVD88 2018

GRID: NORTHING: 634860.616


EASTING: 1849397.758

LDP: NORTHING: 331190.8

EASTING: 209528.5

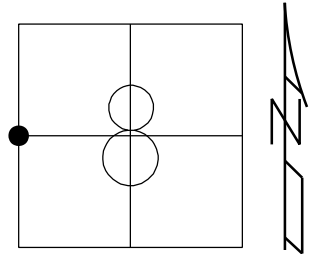

RECORD: P.I.  
 $\Delta = 04^{\circ} 30'$  LT (PLAN)  
 STA. 170+01  
 PREVIOUS MONUMENTS:  
 P.K./WASHER  
 BOAT SPIKE  
 P.K./WASHER  
 3/16/02, DCH  
 SET P.K./WASHER  
 6/10/02, DCH  
 FD P.K./WASHER  
 SV1  
 6/11/09, SAH  
 9/14/12, SDC  
 FD P.K./WASHER  
 REF44  
 11/23/17, DCH  
 SET MAG/WASHER  
 7-31-2019, JLL  
 FD MAG/WASHER  
 2/10/22, JFO  
 1/20/23, JMR

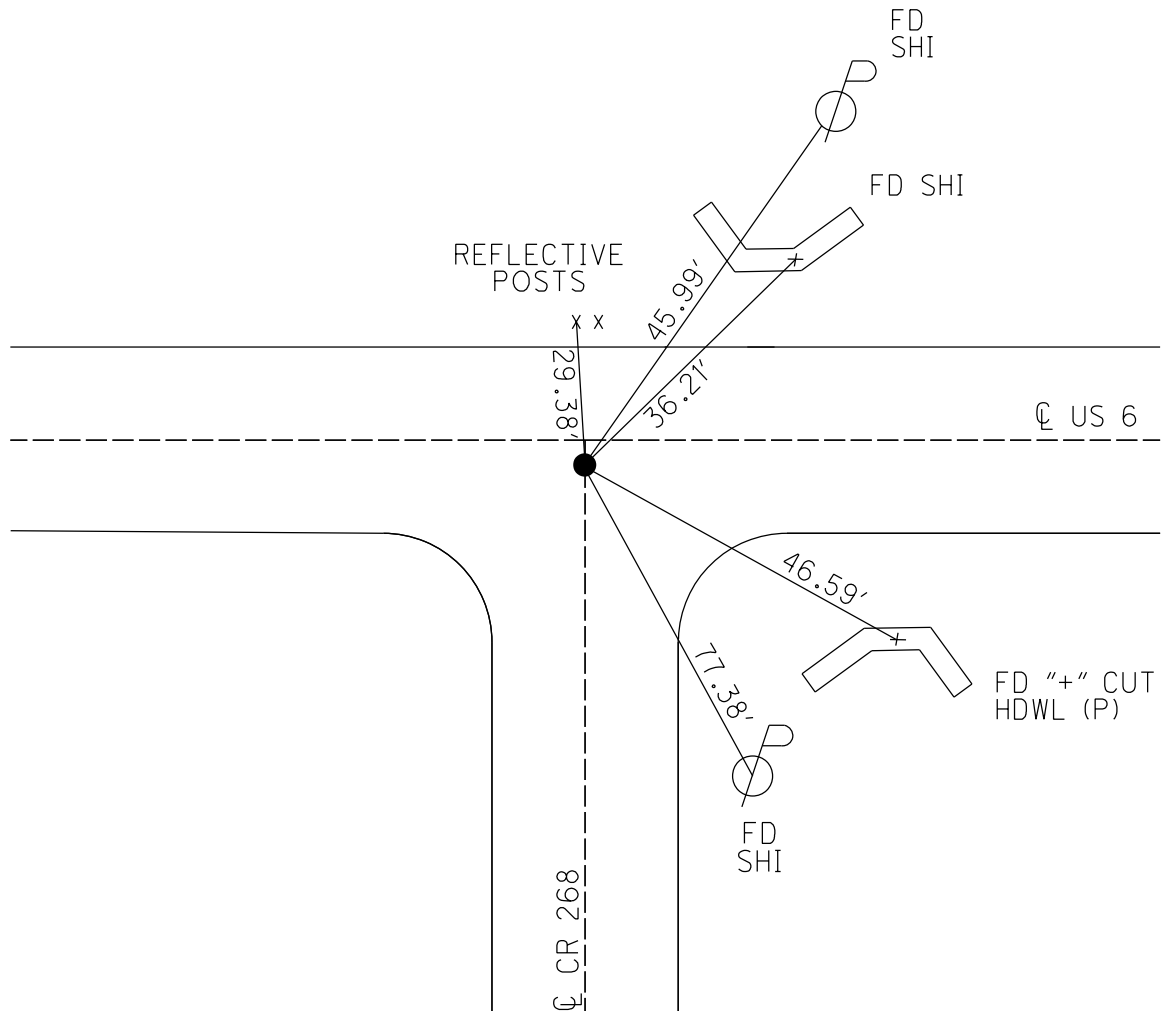

O.D.O.T. DISTRICT 2 SURVEY OFFICE (USE ONLY)

## PERSONNEL

REFERENCE NO. 44

SHEET 19 OF 34

NOTES \_\_\_\_\_ LEU

DATE 8/6/18

ROUTE US 6

H.C. LEU

WEATHER SUNNY

COUNTY SANDUSKY

R.C. HAGEMEYER

TEMP. 84°

TOWNSHIP TOWNSENDSECTION 8

DWG BY AUBLE

PID PAVETRAIN

T 5 N R 17 F

TYPE MONUMENT P.K./WASHER

ON SURFACE - ~~BELOW~~ ON

OFFSET C PAVEMENT 2.6' ~~11~~ : RT


15.7' TO LT EDGE PAVEMENT

STATION: 1463+16

HORZ.DATUM: NAD83 (2011)


GEOID: 2012A

GRID: NORTHING: 634860.616

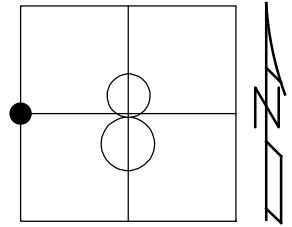EASTING: 1849397.758

PARKING LOT

FD SHI IN  
ONLY REMAINING  
GR POST

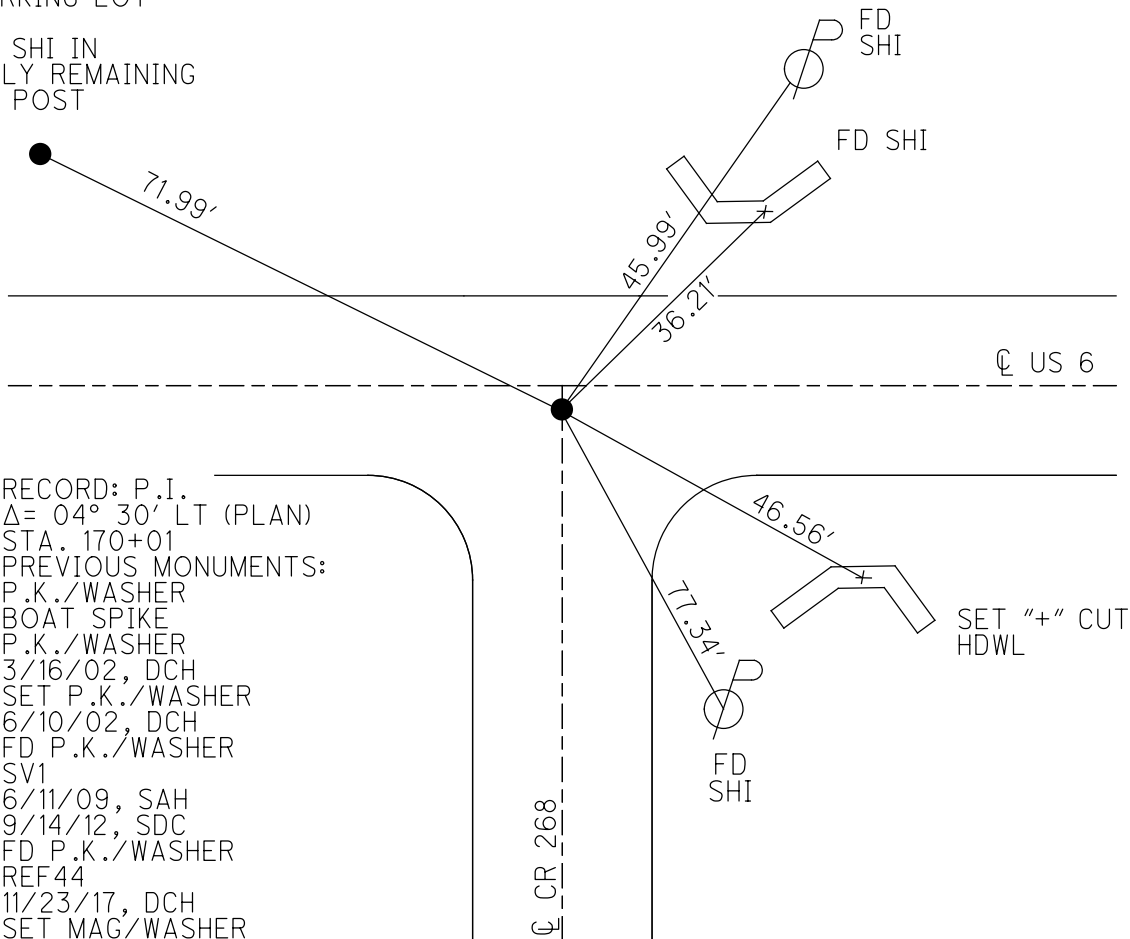

RECORD: P.I.  
Δ= 04° 30' LT (PLAN)  
STA. 170+01  
PREVIOUS MONUMENTS:  
P.K./WASHER  
BOAT SPIKE  
P.K./WASHER  
3/16/02, DCH  
SET P.K./WASHER  
6/10/02, DCH  
FD P.K./WASHER  
SV1  
6/11/09, SAH  
9/14/12, SDC  
FD P.K./WASHER  
REF44  
11/23/17, DCH  
SET MAG/WASHER  
7-31-2019, JLL  
FD MAG/WASHER  
2/10/22, JFO  
1/20/23, JMR

SET "+" CUT  
HDWL

O.D.O.T. DISTRICT 2 SURVEY OFFICE (USE ONLY)

PERSONNEL

REFERENCE NO. 44

SHEET 19 OF 34

NOTES LEU

DATE 8/6/18

ROUTE US 6

H.C. LEU

WEATHER SUNNY

COUNTY SANDUSKY

R.C. HAGEMeyer

TEMP. 84°

TOWNSHIP TOWNSEND

DWG BY AUBLE PID 95769

SECTION 8

T 5 N R 17 E

TYPE MONUMENT P.K./WASHER

ON SURFACE - ~~BELOW~~ ON

OFFSET CL PAVEMENT 2.6' ~~LT~~ : RT

15.7' TO LT EDGE PAVEMENT


STATION: 1463+16

HORZ.DATUM: NAD83 (2011)

GEOID: 2012A


GRID: NORTHING: 634860.616

EASTING: 1849397.758

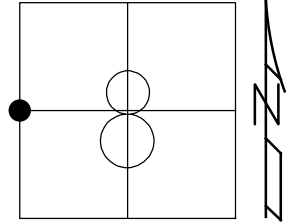

PARKING LOT

FD SHI IN  
ONLY REMAINING  
GR POST

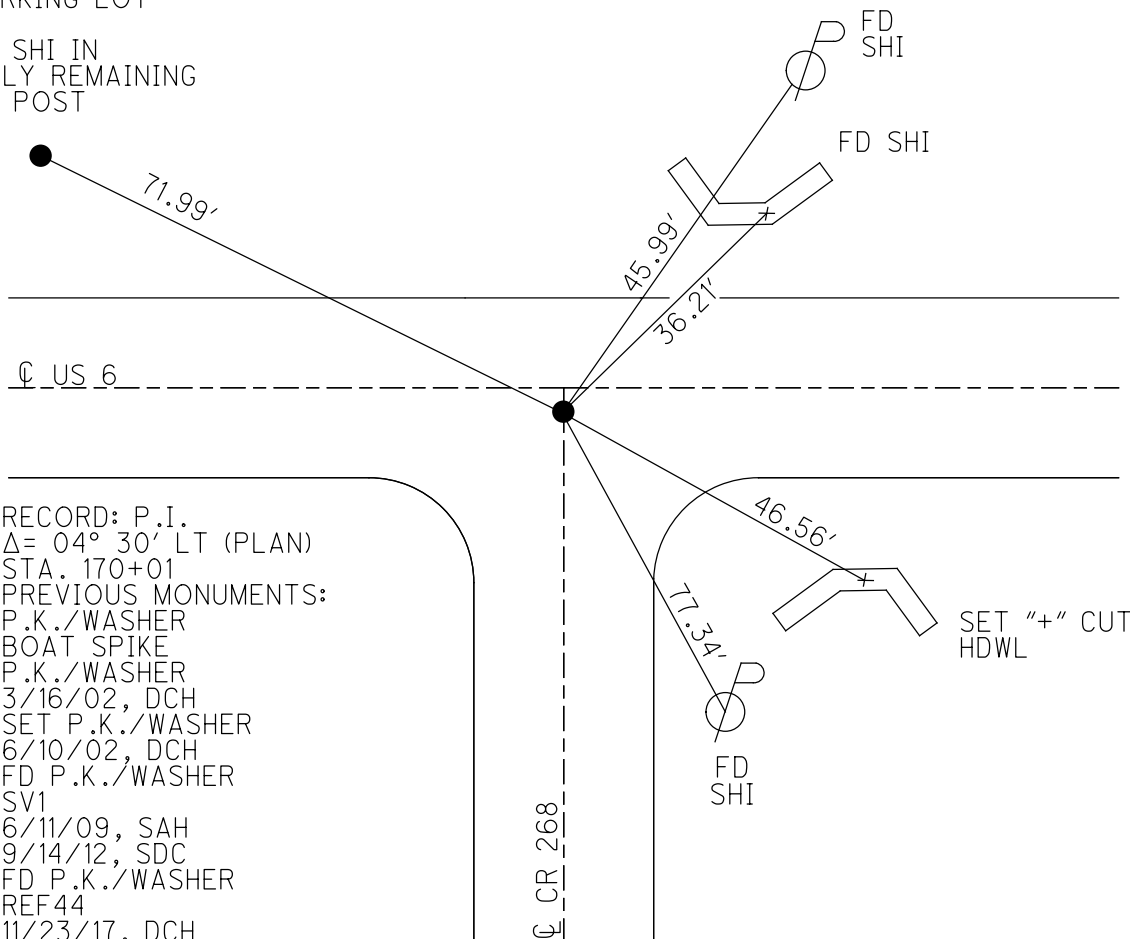


RECORD: P.I.  
 $\Delta = 04^\circ 30'$  LT (PLAN)  
STA. 170+01  
PREVIOUS MONUMENTS:  
P.K./WASHER  
BOAT SPIKE  
P.K./WASHER  
3/16/02, DCH  
SET P.K./WASHER  
6/10/02, DCH  
FD P.K./WASHER  
SV1  
6/11/09, SAH  
9/14/12, SDC  
FD P.K./WASHER  
REF44  
11/23/17, DCH  
SET MAG/WASHER  
7-31-2019, JLL  
FD MAG/WASHER  
2/10/22, JFO

SET "+" CUT  
HDWL


O.D.O.T. DISTRICT 2 SURVEY OFFICE (USE ONLY)

|           |               |         |          |          |          |    |
|-----------|---------------|---------|----------|----------|----------|----|
| PERSONNEL | REFERENCE NO. | 44      | SHEET    | 17       | OF       | 31 |
| NOTES     | RHOADES       | DATE    | 05/16/13 | ROUTE    | US 6     |    |
| H.C.      | CODER         | WEATHER | SUNNY    | COUNTY   | SANDUSKY |    |
| R.C.      | RHOADES       | TEMP.   | 86°      | TOWNSHIP | TOWNSEND |    |
|           |               |         |          | SECTION  | 8        |    |
|           |               |         |          | T        | 5        | N  |
|           |               |         |          | R        | 17       | E  |

TYPE MONUMENT PK/WASHER  
 ON SURFACE - ~~BELOW~~ ON  
~~LEFT~~ - CL PAV'T - RIGHT 2.6'  
15.7' TO LT EDGE PAVEMENT  
 S.L.M. 1465+72.80  
 GRID: NORTHING: 634860.600 EASTING: 1849397.680

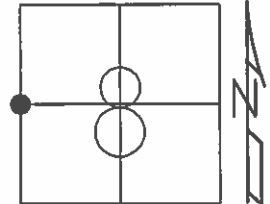

SET SHI'S IN GR POSTS

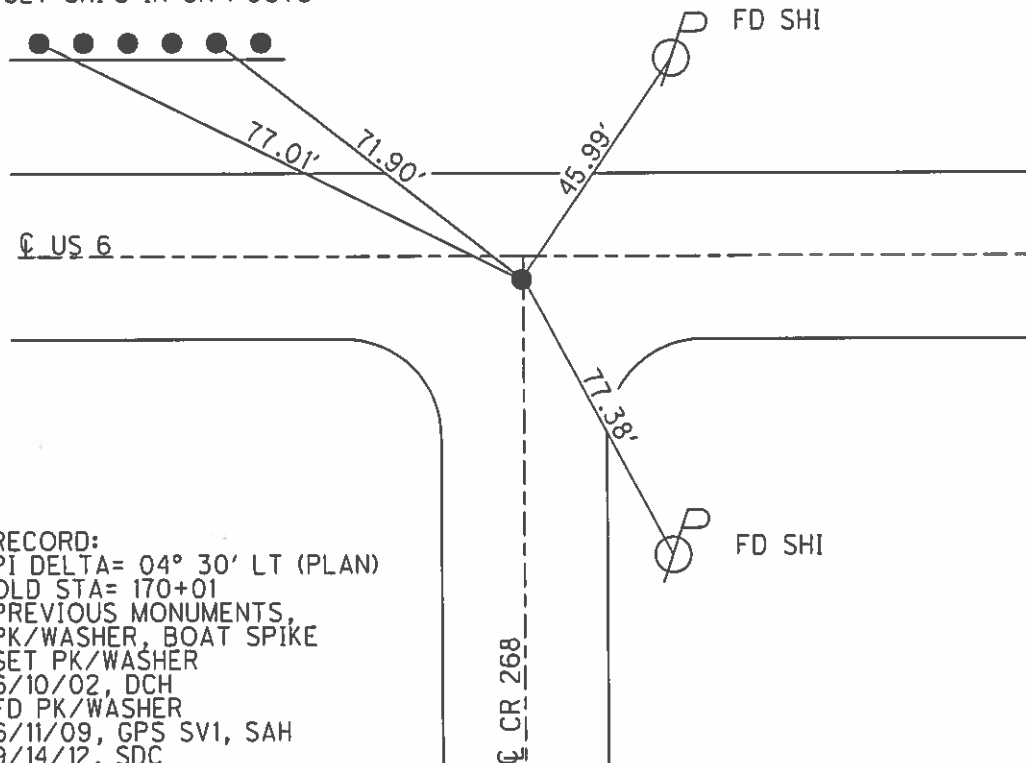

RECORD:  
 PI DELTA= 04° 30' LT (PLAN)  
 OLD STA= 170+01  
 PREVIOUS MONUMENTS,  
 PK/WASHER, BOAT SPIKE  
 SET PK/WASHER  
 6/10/02, DCH  
 FD PK/WASHER  
 6/11/09, GPS SV1, SAH  
 9/14/12, SDC

# O.D.O.T. DISTRICT 2 SURVEY OFFICE USE ONLY

PERSONNEL

REFERENCE NO. 44



SHEET 17 OF 31

NOTES ROUSOS  
H.C. VAN DUSEN  
R.C. MOSSER  
HOMAN

DATE 3/16/02  
WEATHER WINDY  
TEMP. 28°

ROUTE US 6  
COUNTY SANDUSKY  
TOWNSHIP TOWNSEND  
SECTION 8  
T 5 N R 17 E

TYPE MONUMENT PK/WASHER  
ON SURFACE - ~~BELOW~~ ON  
~~LEFT~~ - Q PAV'T - RIGHT 3.0'  
15.7' TO LT EDGE PAVEMENT  
S.L.M. 1463+16

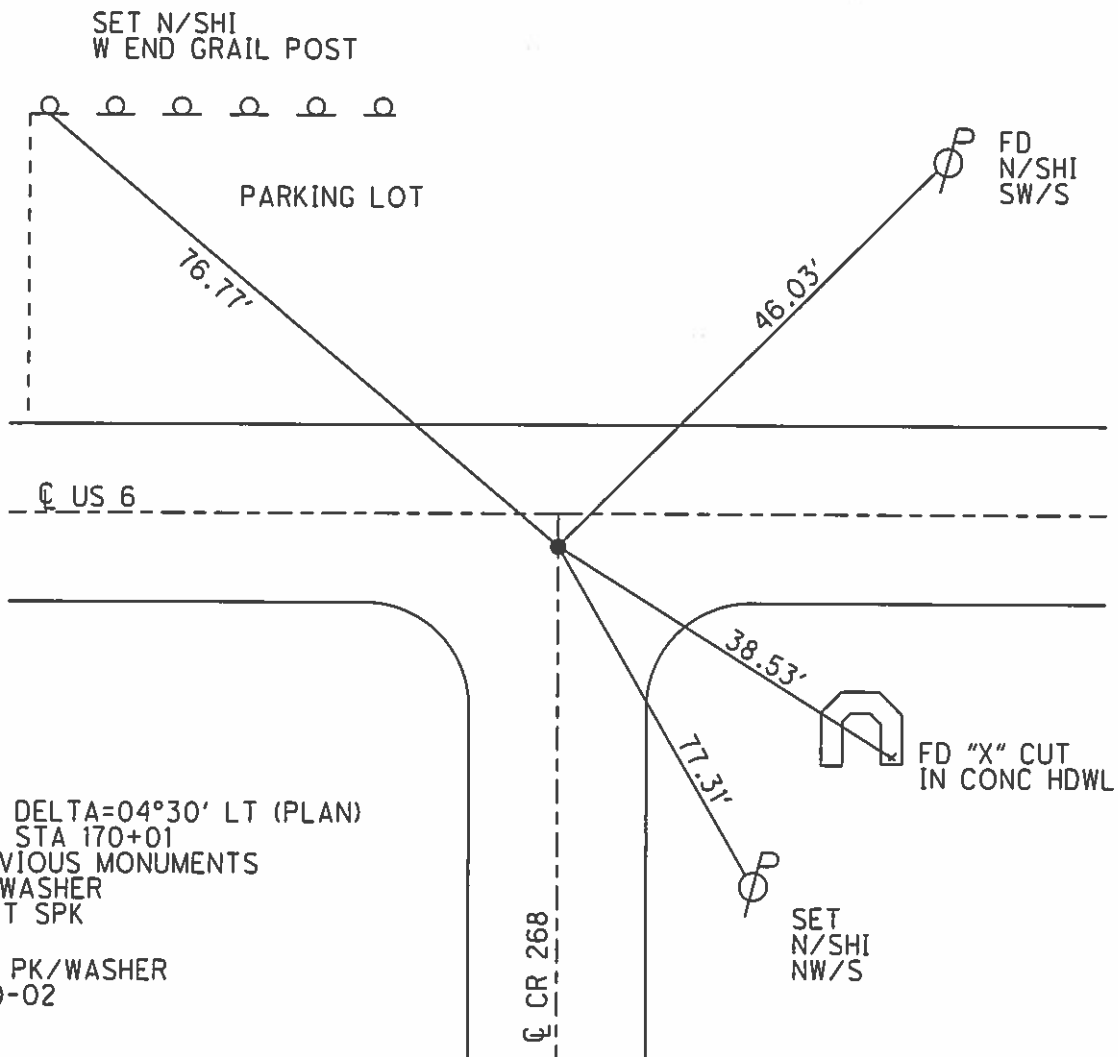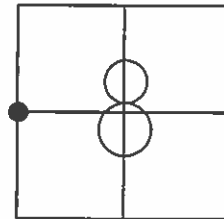

# O.D.O.T. DISTRICT 2 SURVEY OFFICE

PERSONNEL

REFERENCE NO. 44

SHEET 26 OF 39

NOTES CHENEY

H.C. RIPPLE

R.C. BAESOUK

DATE 2-16-1991

WEATHER SUNNY

TEMP. 85°

ROUTE 6

COUNTY SANDUSKY

TOWNSHIP TOWNSEND

SECTION 7-8

T5N R17E


TYPE MONUMENT PK/WASHER

ON SURFACE - BELOW

~~LEFT~~ - PAV'T. - RIGHT 3' ±

TO EDGE PAVEMENT

S.L.M. 1463+16

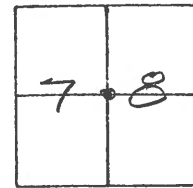

P.I.

$\Delta = 04^{\circ} 30' \text{ LT. (PLAN)}$


STA. = 222+70.8

PREVIOUS MONUMENTS

P.K./WASHER

BOAT SPK.

"+" CUT IN CONC. HOWL.

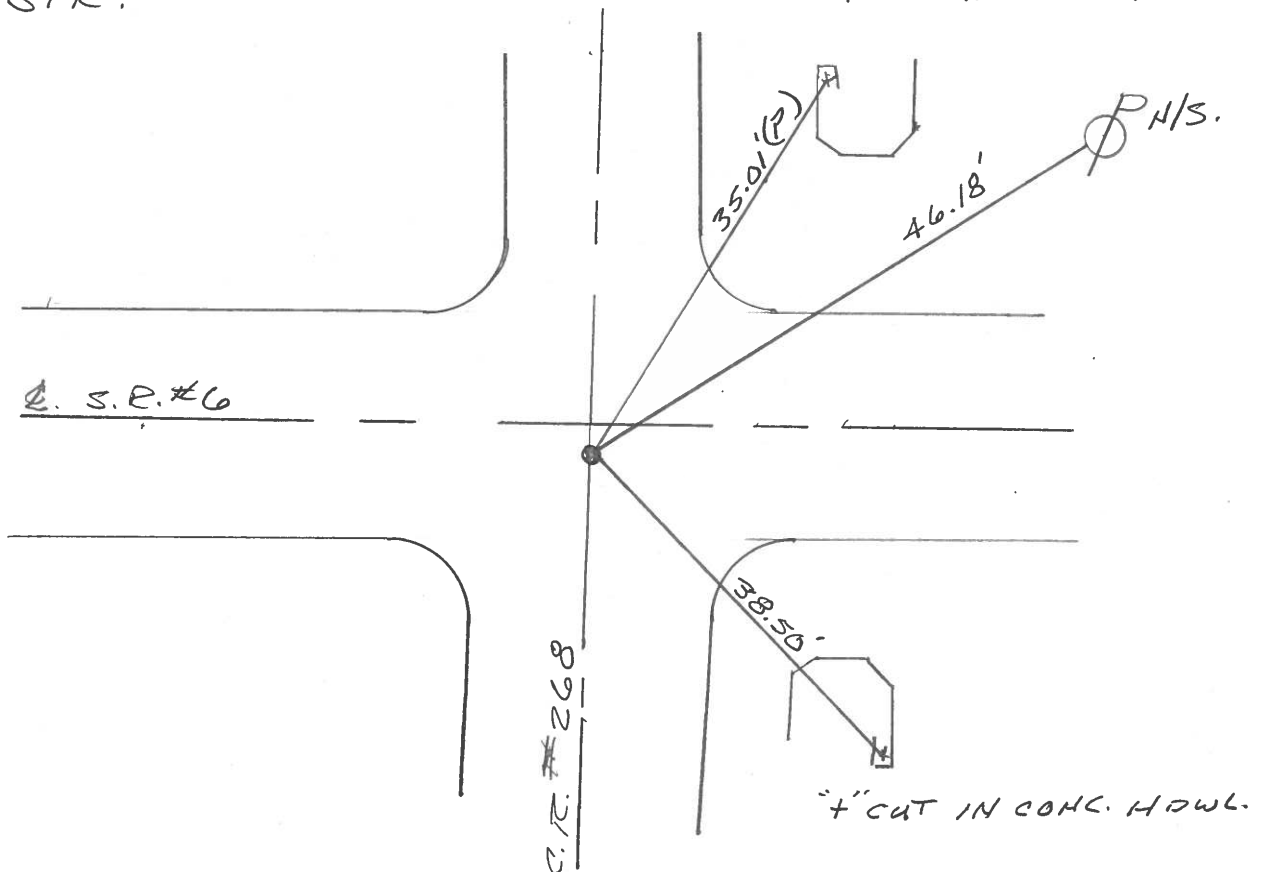

# OD.O.T. DISTRICT 2 SURVEY OFFICE

SHEET \_\_\_\_\_ OF \_\_\_\_\_

County Sandusky S.R. U.S. #6

Township Townsend

Section 7 & 8

T<sup>5</sup>N, R<sup>12</sup>E

Personnel Cronin

Ripple


Geyman

Barbour

Date 9/24/84

Weather sunny

Temp. 75°

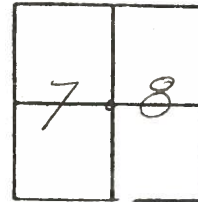

(44)

4/03/91  
40°

1463+16

P.E. A-04'30" Lt. (Plan)

222+70.8

set PK & washer at top

boat spike & washer

3'± Rt. & Plumb

+ cut in  
conc. hdl




350' Plumb

U.S. #6

CHENEY  
RIPPLE  
BARBOUR

9-16-1991  
85°

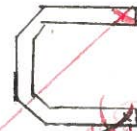

+ cut in conc. hdl  
WALL BROKEN

38.50  
32' 1/4" straight line

C.R. #268

RG-SET PK & WASHER

3'± RT. & L.

85°



# Q.D.O.T. DISTRICT 2 SURVEY OFFICE

SHEET \_\_\_\_\_ OF \_\_\_\_\_

County Sandusky S. R. U.S. #6

Township Townsend

Section 7E'8

T 5 N, R 17 E

Personnel Cronin

Ripple


Geyman

Barbour

Date 9/24/84

Weather SUNNY

Temp. 75°

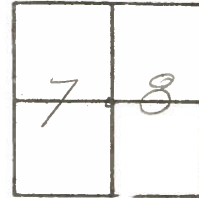

#  
44

P.E. A = 04°30' Lt. (Plan)

222 + 70.8

set PK & washer at top

boat spike & washer


3' ± Rt. & Point

+ cut in  
conc. hdl



35.01  
Plumb

845.46

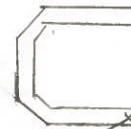

32.14  
Straight Line

+ cut in conc. hdl

C.R. #268

PERSONNEL TITLE PERSONNEL TITLE

Cronin

Schneider

COUNTY Sandusky

DATE 7/31/75

Ash

Mosser

S. R. #6

WEATHER sunny

Geyman


Barbour

SEC. K - Fremont - East

TEMP. 83°

DESCRIPTION Ties for Control Points

JOB NO.

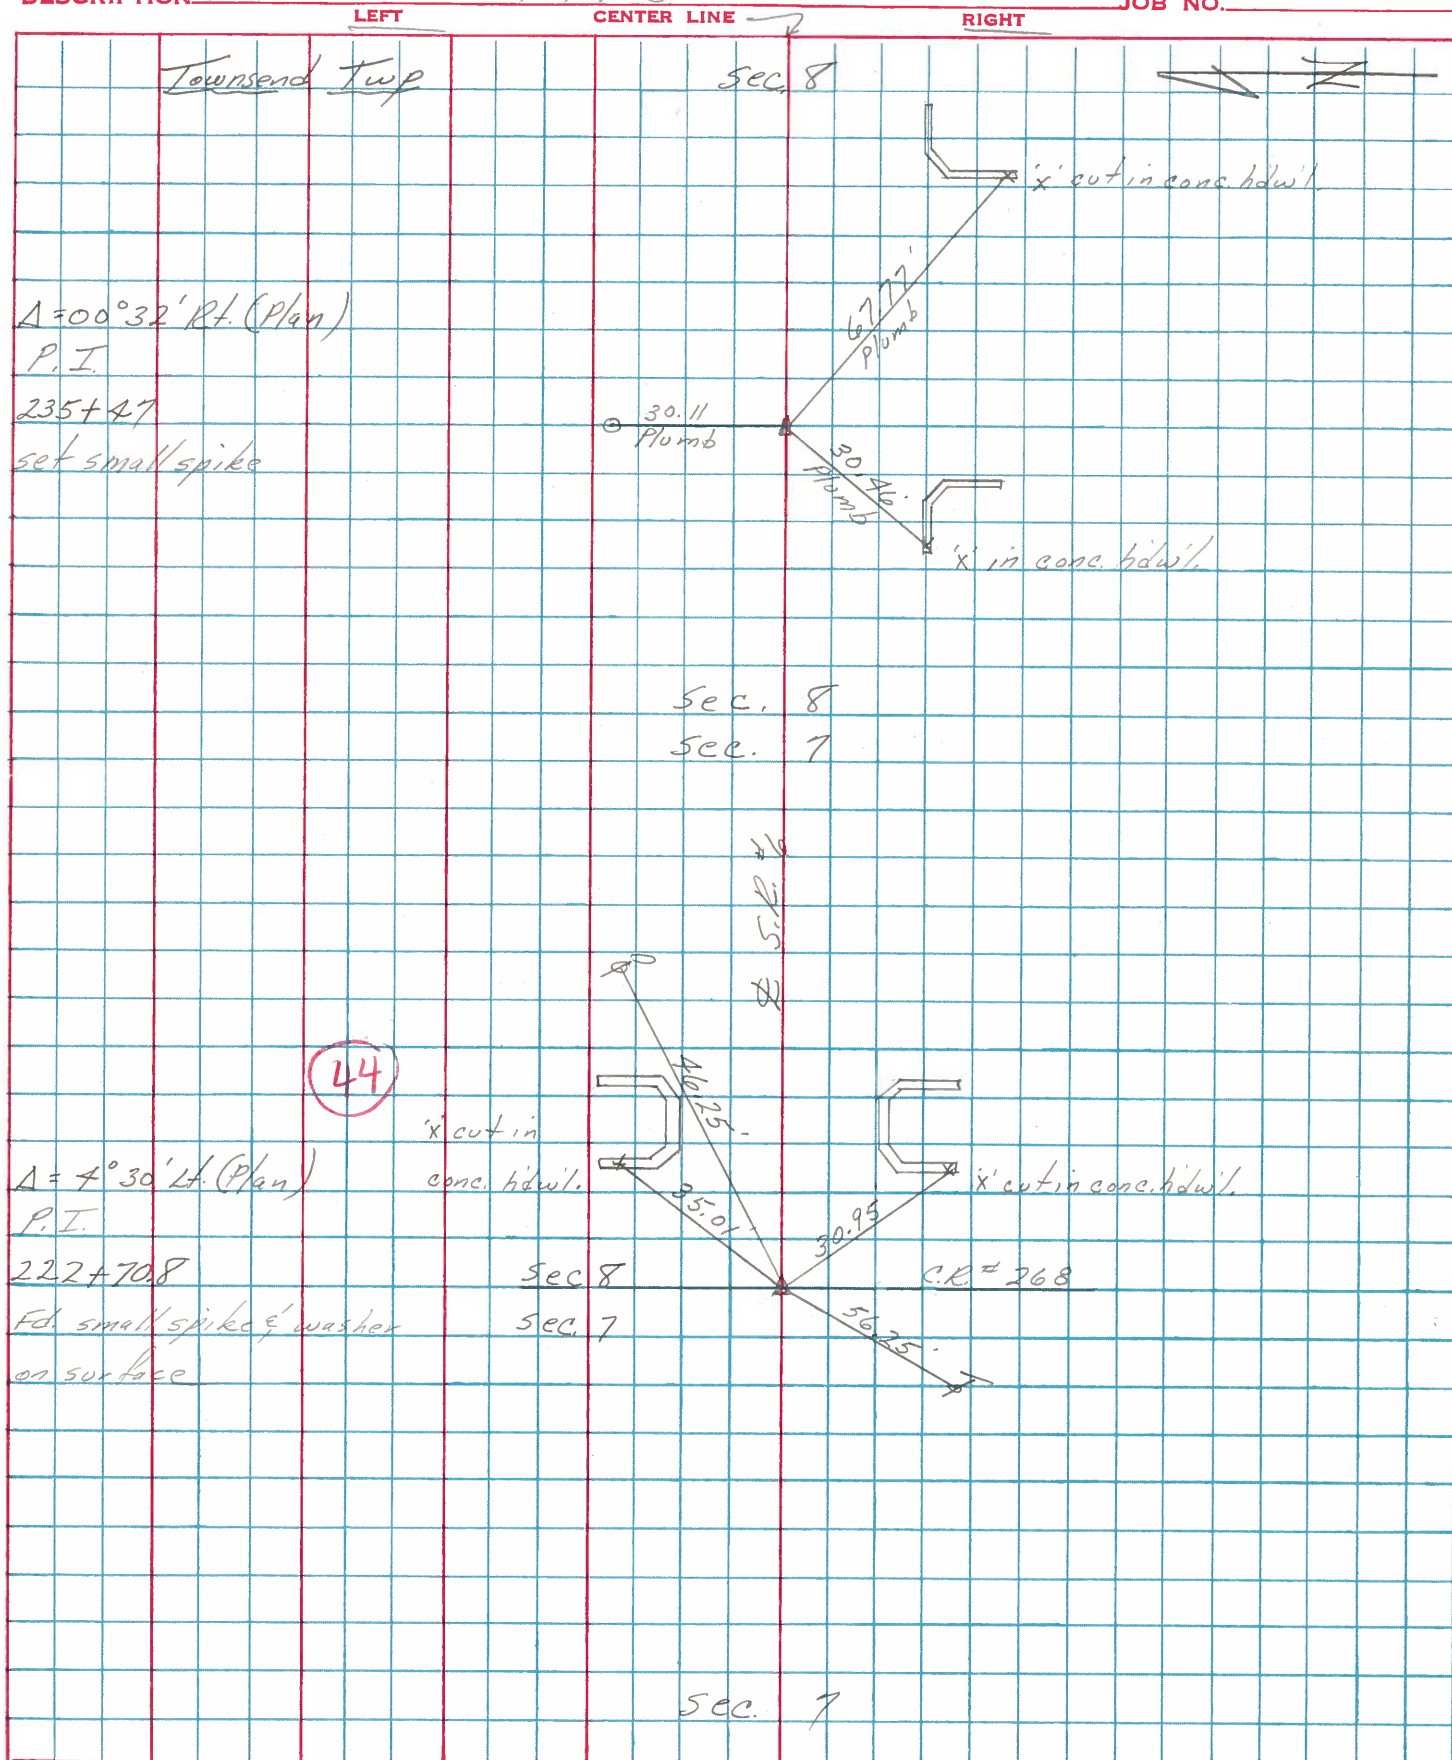

SHEET NO. 6

| PERSONNEL   | TITLE | PERSONNEL | TITLE | COUNTY                  | DATE     | S. R.    | WEATHER | SEC.           | TEMP. | JOB NO. |
|-------------|-------|-----------|-------|-------------------------|----------|----------|---------|----------------|-------|---------|
| Schneider   |       | Potts     |       | Sandusky                | Dec-1967 | U.S. # 6 |         | Fremont - East |       |         |
| Mosser      |       |           |       |                         |          |          |         |                |       |         |
| Barbour     |       |           |       |                         |          |          |         |                |       |         |
| Redding     |       |           |       |                         |          |          |         |                |       |         |
| DESCRIPTION |       |           |       | Ties for Control Points |          |          |         |                |       |         |

DESCRIPTION Ties for Control Points JOB NO. 100

**LEFT**

**CENTER LINE**

**RIGHT**

