

O.D.O.T. DISTRICT 2 SURVEY OFFICE (USE ONLY)

PERSONNEL	REFERENCE NO. <u>47</u>	SHEET <u>22</u> OF <u>34</u>
NOTES <u>PRESTON-COLVIN</u>	DATE <u>9-5-24</u>	ROUTE <u>US 6</u>
H.C. <u>NEISE</u>	WEATHER <u>SUNNY</u>	COUNTY <u>SANDUSKY</u>
R.C. <u>BARRIERE</u>	TEMP. <u>73°</u>	TOWNSHIP <u>TOWNSEND</u>
		SECTION <u>9</u>
		T <u>5</u> N R <u>17</u> E

DWG BY PRESTON-COLVIN PID PAVING TRAIN

TYPE MONUMENT MEG/WASHER

ON SURFACE - ~~BELOW~~ ON

OFFSET ℄ PAVEMENT 2.5' LT : RT

13' TO LT EDGE PAVEMENT

STATION: 1544+09

HORZ.DATUM: NAD83 (2011)


GEOID: NAVD88 2018

GRID: NORTHING: 636229.459


EASTING: 1857209.283

LDP: NORTHING: 332613.6

EASTING: 217330.9

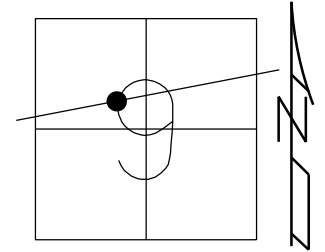

RECORD:
 R.R.SPIKE
 P.K./WASHER
 FD P.K./WASHER
 3/16/02, DCH
 SET MAG/WASHER
 9/26/02 DCH
 SET MAG NAIL
 REF 47
 8/6/18, DCH
 SET MAG/WASHER
 8-2-19, JLL
 FD MAG/WASHER
 2/10/22, JFO
 1/20/23,
 12/28/23, JMR
 FD MEG/WASHER
 REF 47
 9/5/24, TDN
 FD MEG/WASHER
 10/3/24, JAM

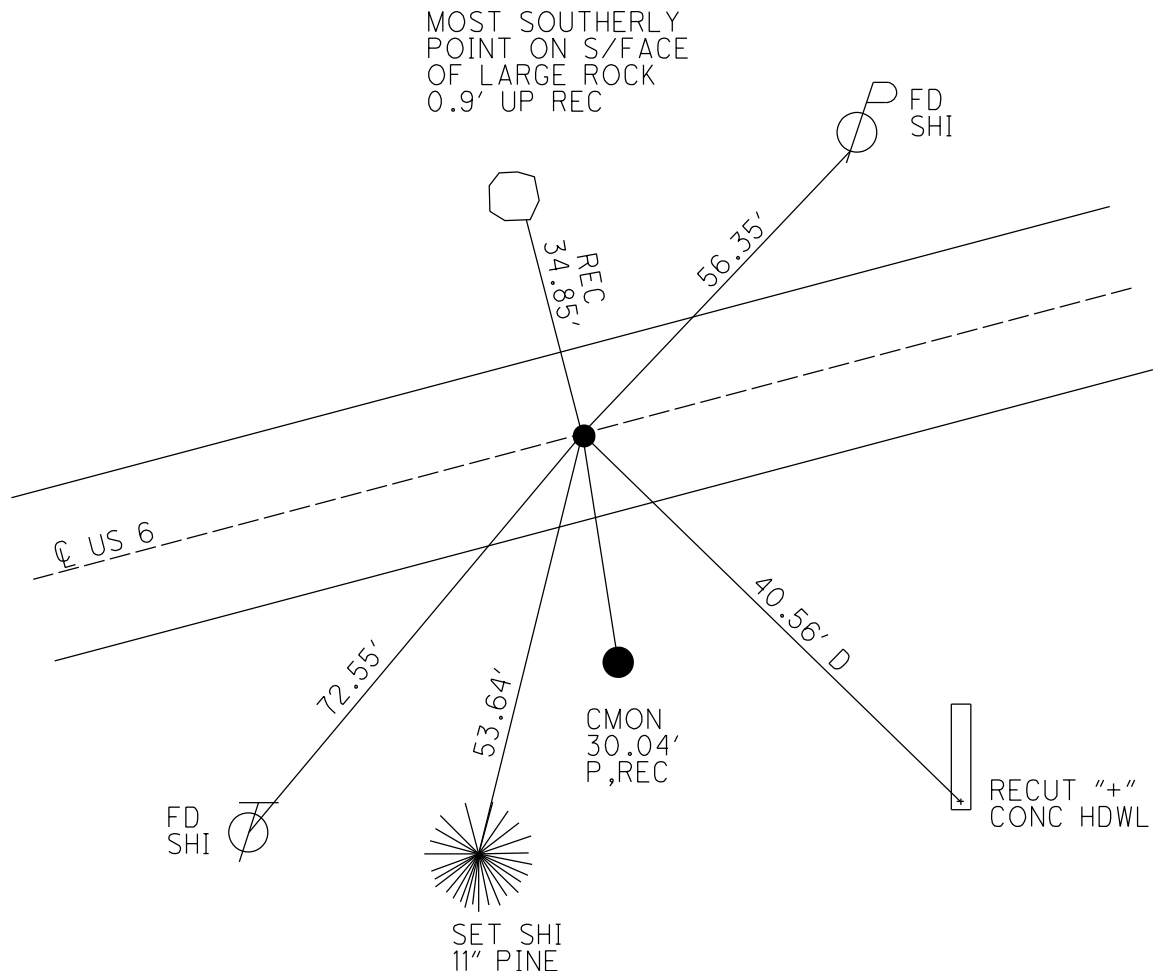

O.D.O.T. DISTRICT 2 SURVEY OFFICE (USE ONLY)

PERSONNEL

REFERENCE NO. 47

SHEET 22 OF 34

NOTES MILLER

DATE 12/28/23

ROUTE US 6

H.C. RHOADES

WEATHER _____ RAIN _____

COUNTY SANDUSKY

R.C. MILLER

TEMP. 44°

TOWNSHIP TOWNSENDSECTION 9

T_5_N R_17_E

DWG BY RHOADES PID PAVETRAIN

TYPE MONUMENT MAG/WASHER

ON SURFACE - ~~BELOW~~ ON

OFFSET @ PAVEMENT 2.5' ~~TT~~ : RT


13' TO LT EDGE PAVEMENT

STATION: 1544+09

HORZ.DATUM: NAD83 (2011)

GEOID: NAVD88 2018

GRID: NORTHING: 636229.459

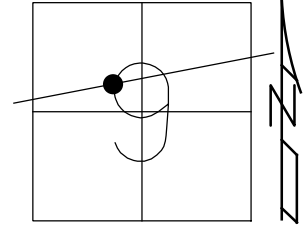EASTING: 1857209.283

RECORD:

R.R.SPIKE

P.K./WASHER

FD P.K./WASHER

3/16/02, DCH

SET MAG/WASHER

9/26/02 DCH

SET MAG NAIL
REF 17

REF 47

8/6/18, DCH

SET MAG/WASHER


8-2-19, JLL

FD MAG/WASHER
0 110 100 150

2/10/22, JFO
1/20/23

1/20/23,
12/20/23

12/28/23, JMR

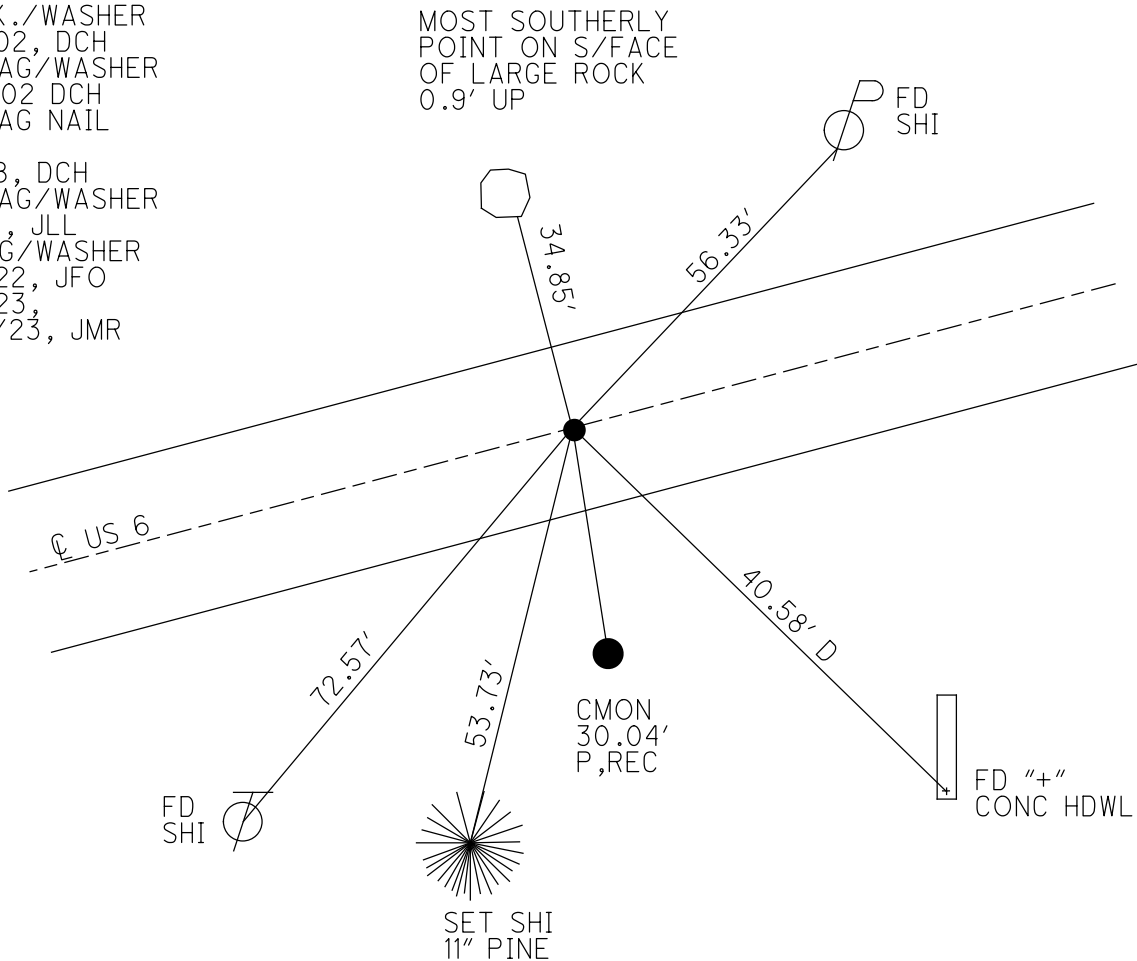

O.D.O.T. DISTRICT 2 SURVEY OFFICE (USE ONLY)

PERSONNEL

REFERENCE NO. 47

SHEET 22 OF 34

NOTES LEU

DATE 8/6/18

ROUTE US 6

H.C. LEU

WEATHER HOT

COUNTY SANDUSKY

R.C. HAGEMeyer

TEMP. 89°

TOWNSHIP TOWNSEND

DWG BY AUBLE

PID PAVETRAIN

SECTION 9

T 5 N R 17 E

TYPE MONUMENT MAG NAIL

ON SURFACE - ~~BELOW~~ ON

OFFSET CL PAVEMENT 2.5' LT : RT

13' TO LT EDGE PAVEMENT


STATION: 1544+09

HORIZ.DATUM: NAD83 (2011)

GEOID: 2012A

GRID: NORTHING: 636229.459


EASTING: 1857209.283

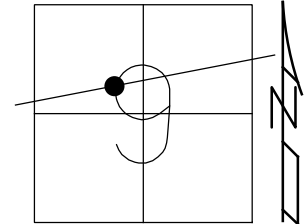

RECORD:
PREVIOUS MONUMENTS:

R.R.SPIKE
P.K./WASHER
FD P.K./WASHER
3/16/02, DCH
SET MAG/WASHER
9/26/02 DCH
SET MAG NAIL
REF47
8/6/18, DCH
SET MAG/WASHER
8-2-19, JLL
FD MAG/WASHER
2/10/22, JFO
1/20/23, JMR

MOST SOUTHERLY
POINT ON S/FACE
OF LARGE ROCK
0.9' UP

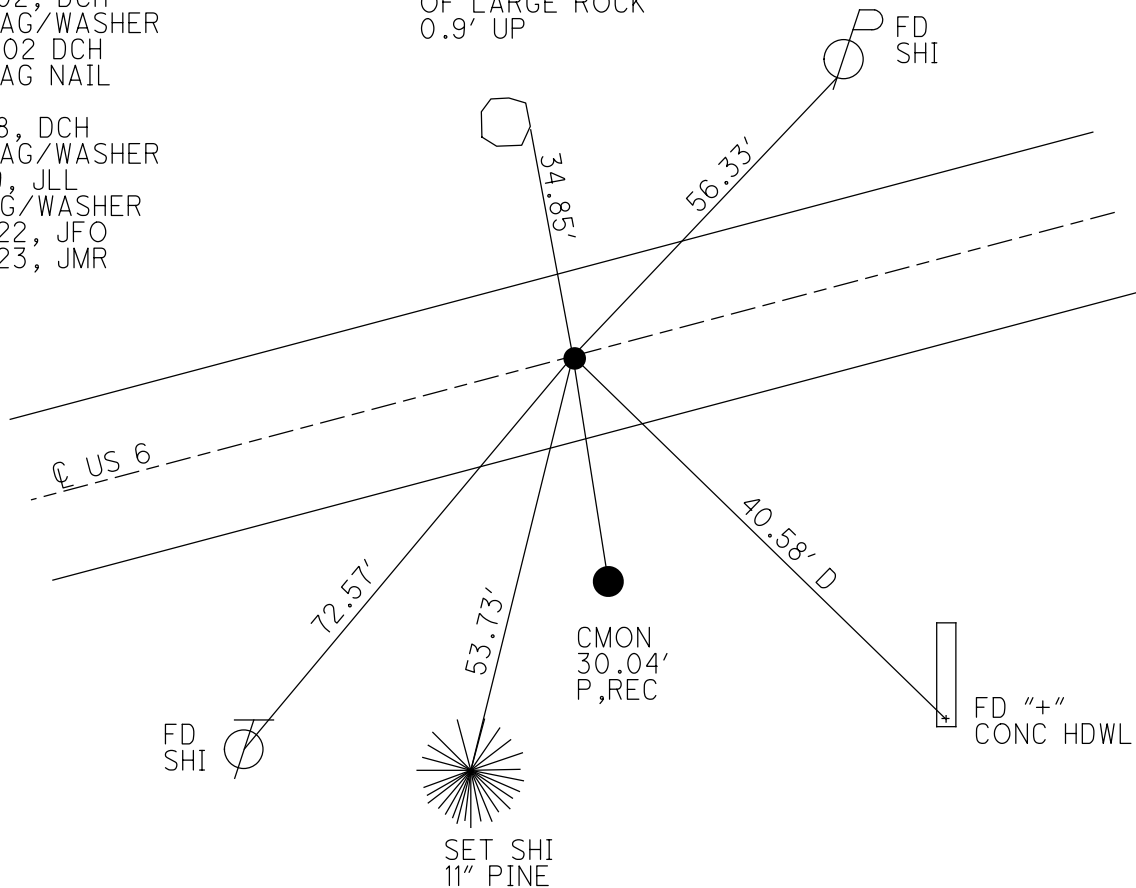

O.D.O.T. DISTRICT 2 SURVEY OFFICE (USE ONLY)

PERSONNEL

REFERENCE NO. 47

SHEET 22 OF 34

NOTES LEU

DATE 8/6/18

ROUTE US 6

H.C. LEU

WEATHER HOT

COUNTY SANDUSKY

R.C. HAGEMEYER

TEMP. 89°

TOWNSHIP TOWNSEND

SECTION 9

DWG BY AUBLE

PID 95769

T 5 N R 17 E

TYPE MONUMENT MAG NAIL

ON SURFACE - ~~BELOW~~ ON

OFFSET CL PAVEMENT 0.2' LT : RT

13' TO LT EDGE PAVEMENT


STATION: 1544+09

HORZ.DATUM: NAD83 (2011)

GEOID: 2012A

GRID: NORTHING: 636229.459

EASTING: 1857209.283

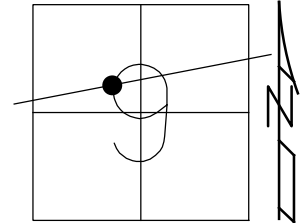

RECORD:

PREVIOUS MONUMENTS:

R.R.SPIKE

P.K./WASHER

FD P.K./WASHER

3/16/02, DCH

SET MAG/WASHER

9/26/02 DCH

SET MAG NAIL

REF47

8/6/18, DCH


SET MAG/WASHER

8-2-19, JLL

FD MAG/WASHER

2/10/22, JFO

MOST SOUTHERLY
POINT ON S/FACE
OF LARGE ROCK
0.9' UP

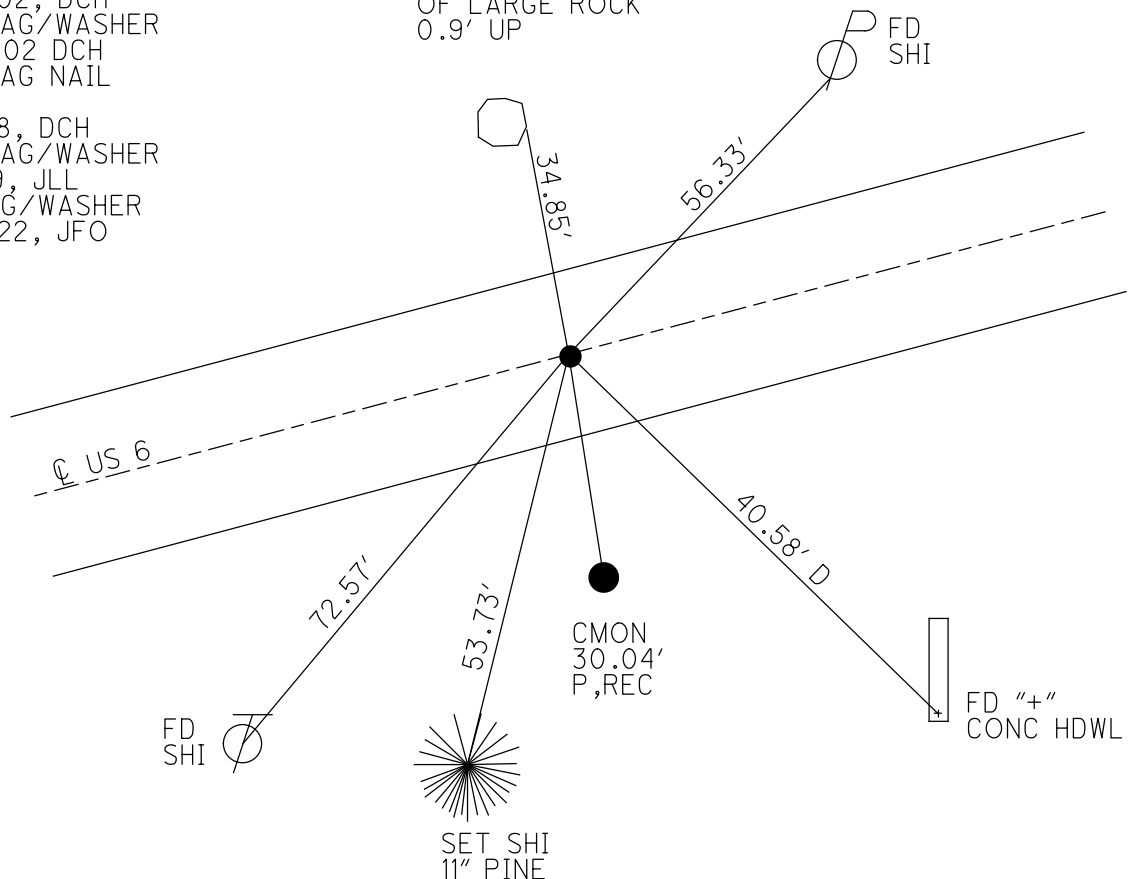

O.D.O.T. DISTRICT 2 SURVEY OFFICE (USE ONLY)

PERSONNEL

REFERENCE NO. 47

SHEET 22 OF 34

NOTES LEU

DATE 8/6/18

ROUTE US 6

H.C. LEU

WEATHER HOT

COUNTY SANDUSKY

R.C. HAGEMeyer

TEMP. 89°

TOWNSHIP TOWNSEND

DWG BY AUBLE PID 95769

SECTION 9

T 5 N R 17 E

TYPE MONUMENT MAG NAIL

ON SURFACE - ~~BELOW~~ ON

OFFSET 0.2' LT : RT

13' TO LT EDGE PAVEMENT


STATION: 1544+09

HORZ.DATUM: NAD83 (2011)

GEOID: 2012A


GRID: NORTHING: 636229.459

EASTING: 1857209.283

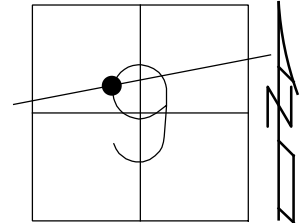

RECORD:
PREVIOUS MONUMENTS:
R.R.SPIKE
P.K./WASHER
FD P.K./WASHER
3/16/02, DCH
SET MAG/WASHER
9/26/02 DCH
SET MAG NAIL
REF47
8/6/18, DCH
SET MAG/WASHER
8-2-19, JLL


MOST SOUTHERLY
POINT ON S/FACE
OF LARGE ROCK
0.9' UP

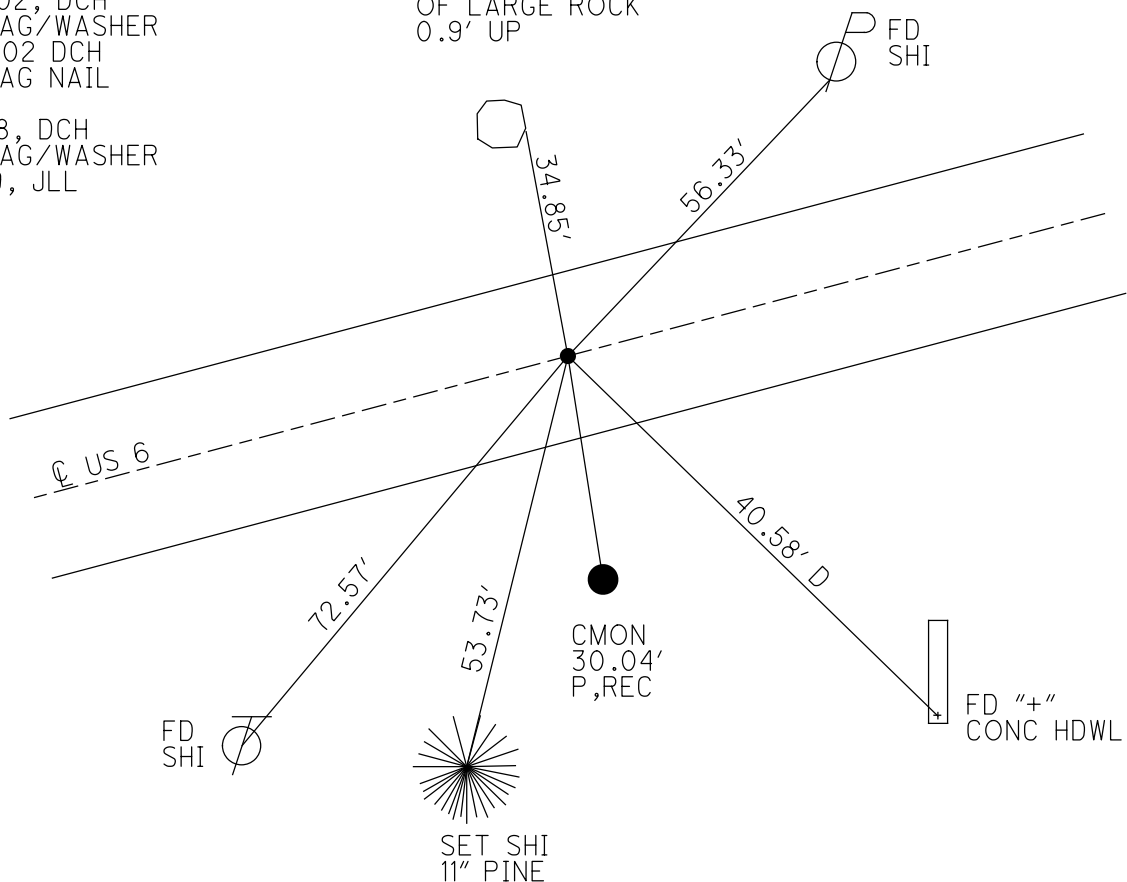


O.D.O.T. DISTRICT 2 SURVEY OFFICE (USE ONLY)

PERSONNEL _____ REFERENCE NO. 47 SHEET 20 OF 31
 NOTES _____ DATE 03/16/02 ROUTE US 6
 H.C. ROUSOS WEATHER WINDY COUNTY SANDUSKY
 R.C. VAN DUSEN TEMP. 28° TOWNSHIP TOWNSEND
MOSSER SECTION 9
HOMAN T 5 N R 17 E

TYPE MONUMENT _____ PK/WASHER
 ON SURFACE - ~~BELOW~~ _____ ON
~~LEFT~~ - C PAV'T - RIGHT _____ 1'
13' TO LT EDGE PAVEMENT
 S.L.M. _____ 1544+09
 GRID: NORTHING: _____ EASTING: _____

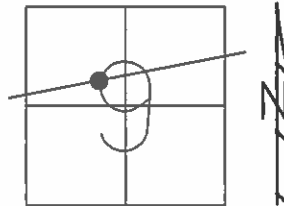

RECORD:
 0+00 AHEAD = SEC HJ
 303+55 BACK = SEC K
 SPK GONE - PK/WASHER
 PREVIOUSLY SET
 SET MAG NAIL/WASHER
 09/26/02 DCH

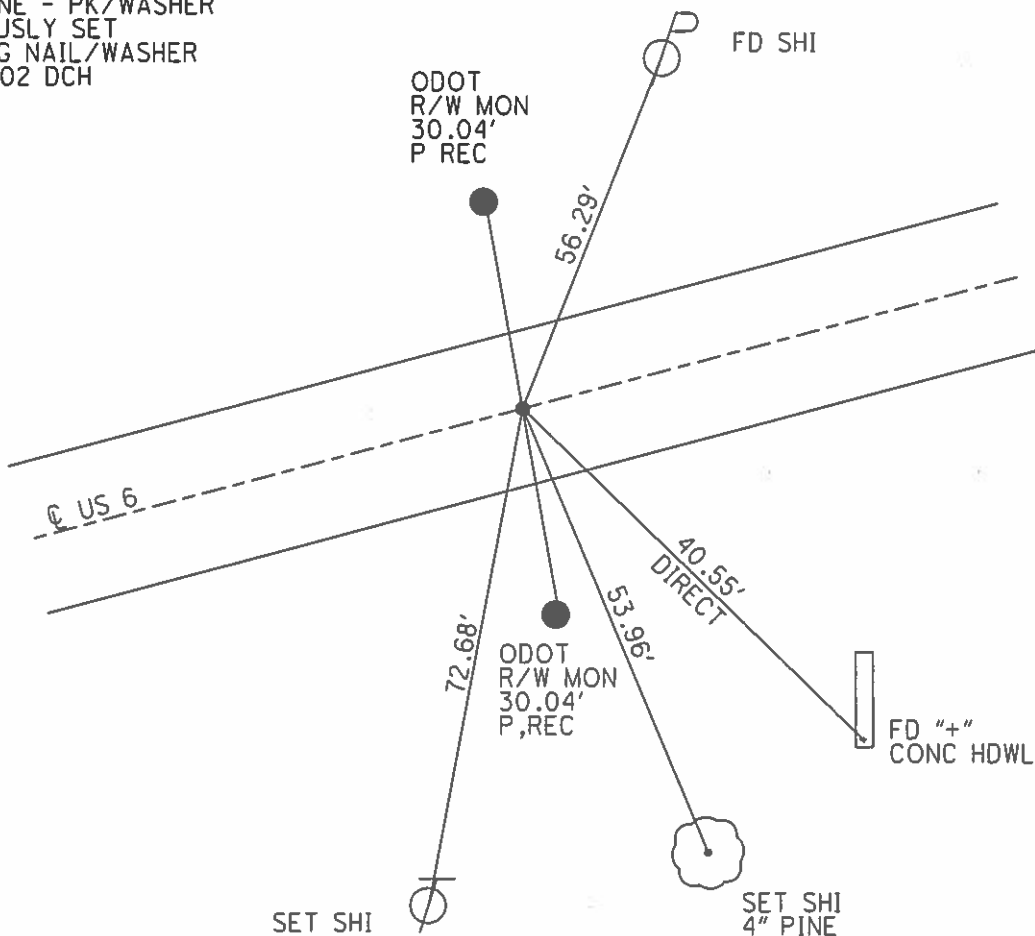

O.D.O.T. DISTRICT 2 SURVEY OFFICE

PERSONNEL

REFERENCE NO. _____

SHEET 29 OF 39

NOTES RIPPLE

H.C. BARBONP

R.C. GEYMAN

DATE 10-3-1991

WEATHER —

TEMP. 75°

ROUTE 6

COUNTY SANDUSKY

TOWNSHIP TOWNSEND

SECTION 9

T5N R1E

TYPE MONUMENT PK/WASHER


ON SURFACE - BELOW

LEFT - — PAV'T. - RIGHT —

— TO — EDGE PAVEMENT

S.L.M. 1544+09


47

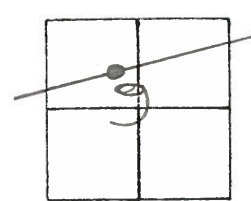

0400 AHEAD = SEC. H.J.

303+55 BACK = SEC. K.

SPK. GONE - PK/WASHER
PREVIOUSLY SET.

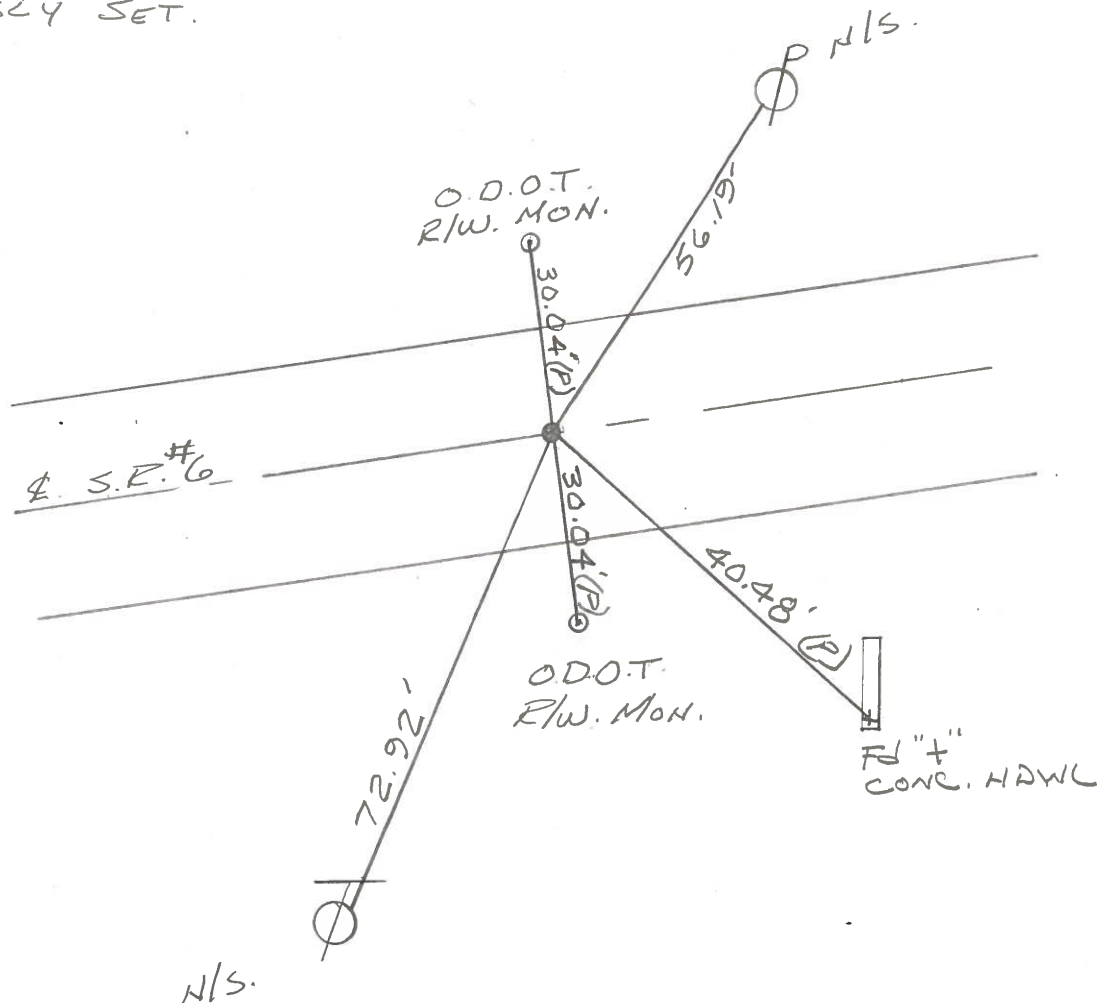

Q.D.O.T. DISTRICT 2 SURVEY OFFICE

SHEET _____ OF _____

County Sandusky S.R. U.S. #6

Township Townsend

Section _____

T5 N, R1 E

Personnel Cronin

Ripple


Geyman

Barbour

Date 9/26/84

Weather sunny

Temp. 48°

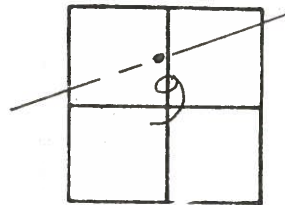

(47)

4/03/91

57°


1544+09

0+00 Ahd. = Sec. H.I.

303+55 Bk. - Sec. K

spike gone - Set PK

e' washer

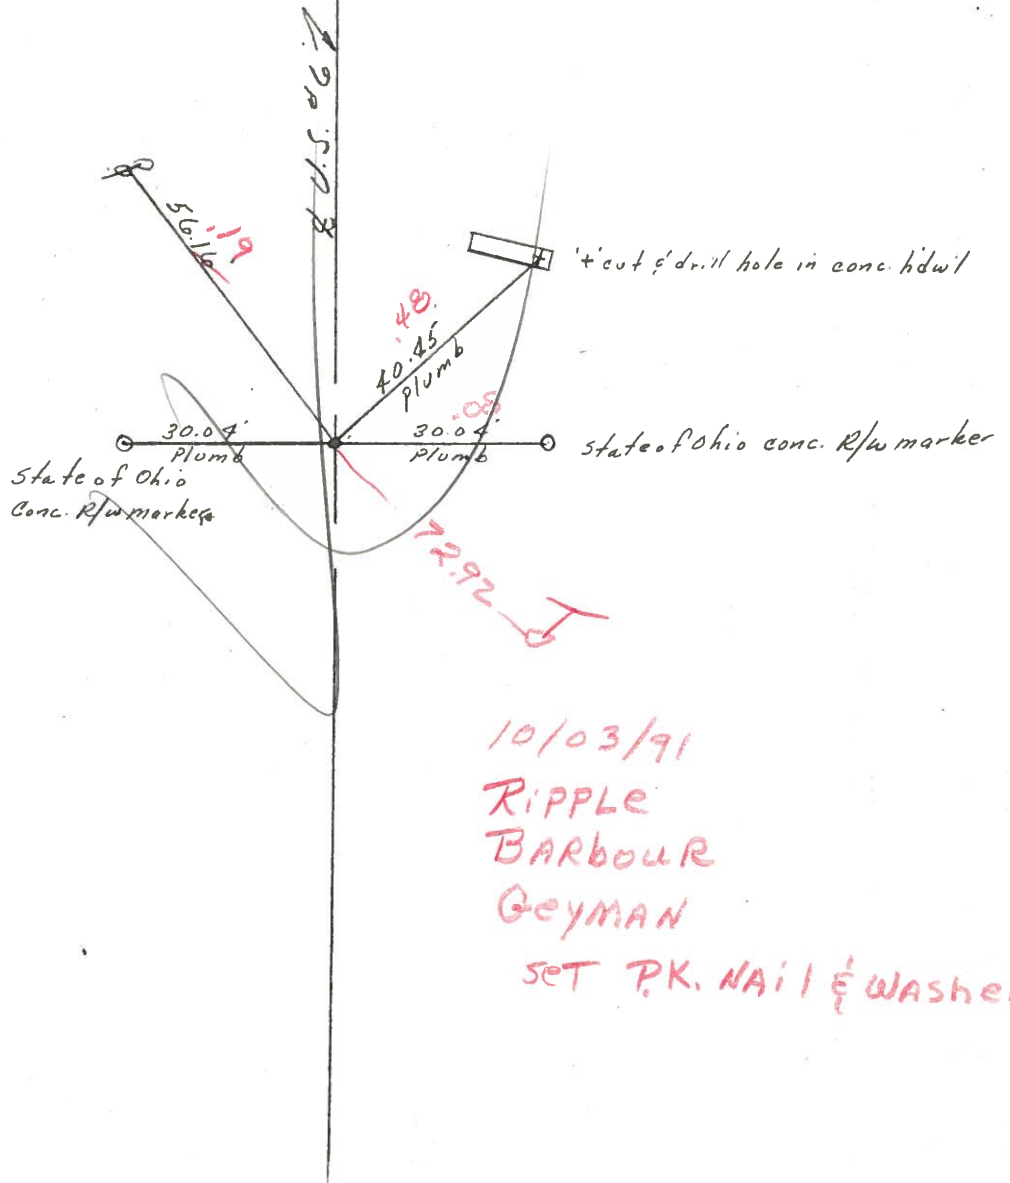

10/03/91

RIPPLE

BARBOUR

GEYMAN

SET P.K. NAIL & WASHER

Q.D.O.T. DISTRICT 2 SURVEY OFFICE

SHEET _____ OF _____

County Sandusky S. R. U.S. #6

Township Townsend

Section _____

T5N, R17E

Personnel Cronin

Ripple


Geyman

Barbour

Date 9/26/84

Weather sunny

Temp. 78°

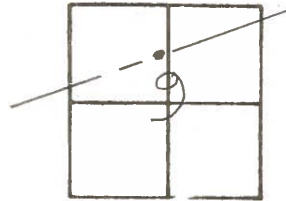


(47)

0+00 Ahd. = Sec. H.J.

303+55 Bk. - Sec. K

spike gone - Set PK

e' washer

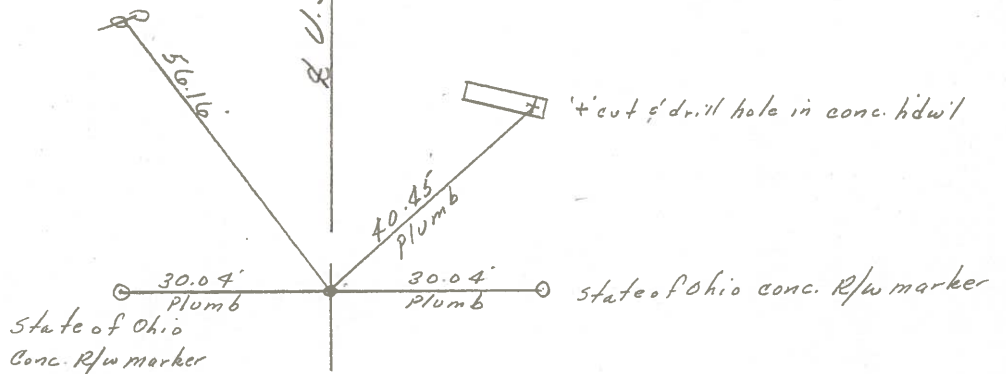

SHEET NO. 15

Tied 8/5/75

DATE drawn 8/4/75

PERSONNEL TITLE PERSONNEL TITLE

Cronin

Schneider

COUNTY Sandusky

WEATHER sunny

Ash

Mosser

S. R. # 6

Ripple

Barbour

SEC. K-H-J - Fremont - East

TEMP. 75°

Geyman

DESCRIPTION Ties for Control Points

JOB NO.

