

O.D.O.T. DISTRICT 2 SURVEY OFFICE (USE ONLY)

PERSONNEL

REFERENCE NO. 48

SHEET 23 OF 34

NOTES RHOADES

DATE 11/20/23

ROUTE US 6

H.C. AUBLE

WEATHER WINDY

COUNTY SANDUSKY

R.C. MILLER

TEMP. 41°

TOWNSHIP TOWNSEND

DWG BY RHOADES

PID PAVETRAIN

SECTION 9

T 5 N R 17 E

TYPE MONUMENT MAG/WASHER

ON SURFACE - ~~BELOW~~ ON

OFFSET Q PAVEMENT 0.3' LT : RT

11.9' TO RT EDGE PAVEMENT


STATION: 1557+29

HORZ.DATUM: NAD83 (2011)

GEOID: NAVD88 2018


GRID: NORTHING: 636760.739

EASTING: 1858413.348

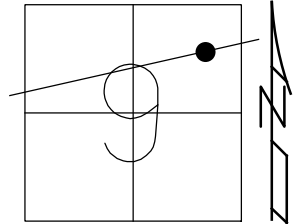

RECORD:

FD P.K./WASHER
3/16/02, DCH
SET MAG/WASHER
9-25-02, DCH
FD MAG/WASHER
REF48
11/23/17, DCH
SET MAG/WASHER
8-5-2019, JLL
FD MAG/WASHER
2/10/22, JFO
SET MAG/WASHER
11/20/23, DSA

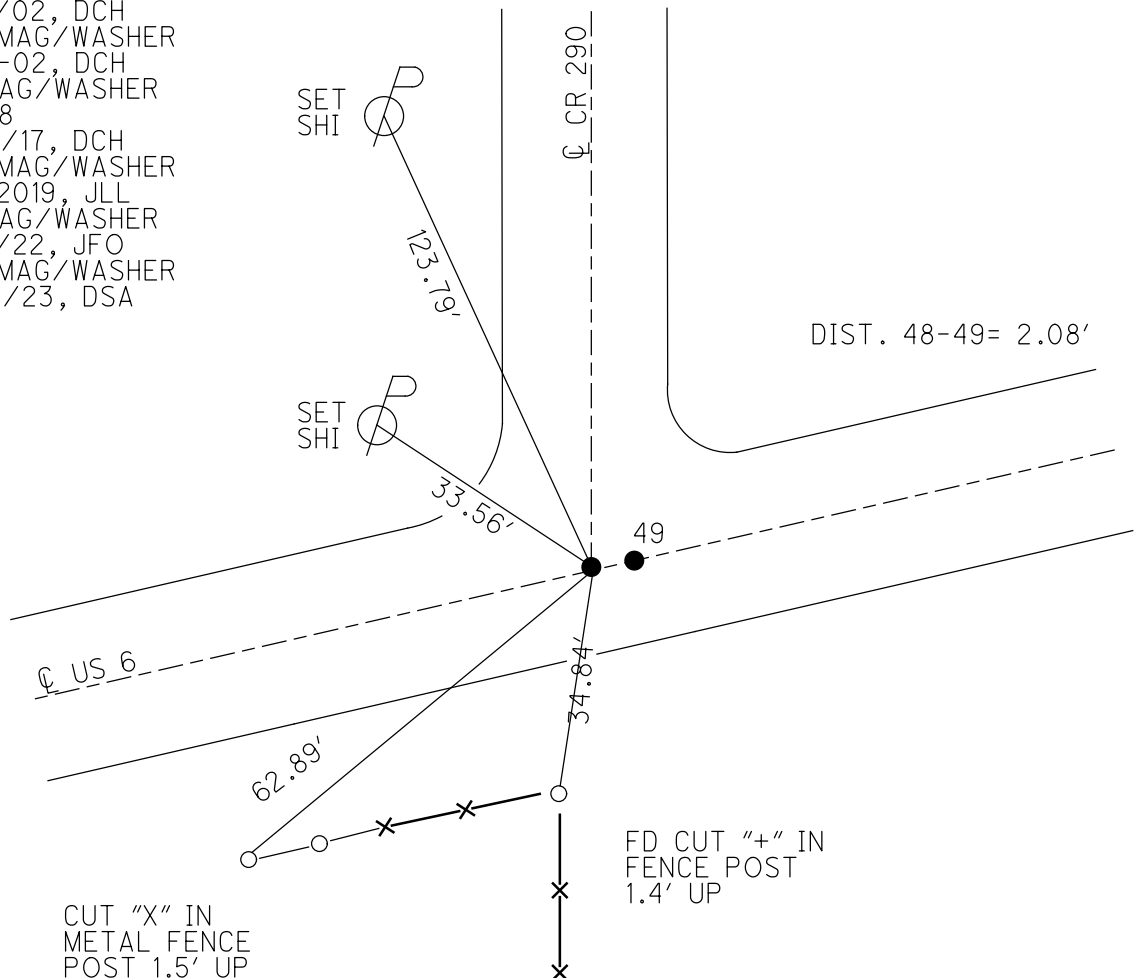

O.D.O.T. DISTRICT 2 SURVEY OFFICE (USE ONLY)

PERSONNEL

REFERENCE NO. 48

SHEET 23 OF 34

NOTES _____ LEU

DATE 8/6/18

ROUTE US 6

H.C. LEU

WEATHER HOT

COUNTY SANDUSKY

R.C. HAGEMEYER

TEMP. 89°

TOWNSHIP TOWNSEND

DWG BY AUBLE

PID 95769

T 5 N R 17 F

TYPE MONUMENT MAG NAIL

ON SURFACE - ~~BELOW~~ ON _____

OFFSET @ PAVEMENT 0.3' LT : RT


11.9' TO RT EDGE PAVEMENT

STATION: 1557+29

HORZ.DATUM: NAD83 (2011)

GEOID: 2012A

GRID: NORTHING: 636760.739

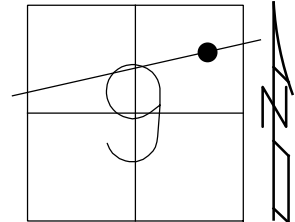EASTING: 1858413.348

RECORD:

FD P.K./WASHER

3/16/02, DCH

SET MAG/WASHER

9-25-02, DCH
ED, MAC (WASH)

FD MAG/WASHER
DEF 10REF 48
11-107-1


11/23/17, DCH
GET MAG MAG

SET MAG/WASHER

8-5-2019, JLL

FD MAG/WASHER

2/10/22, JFO

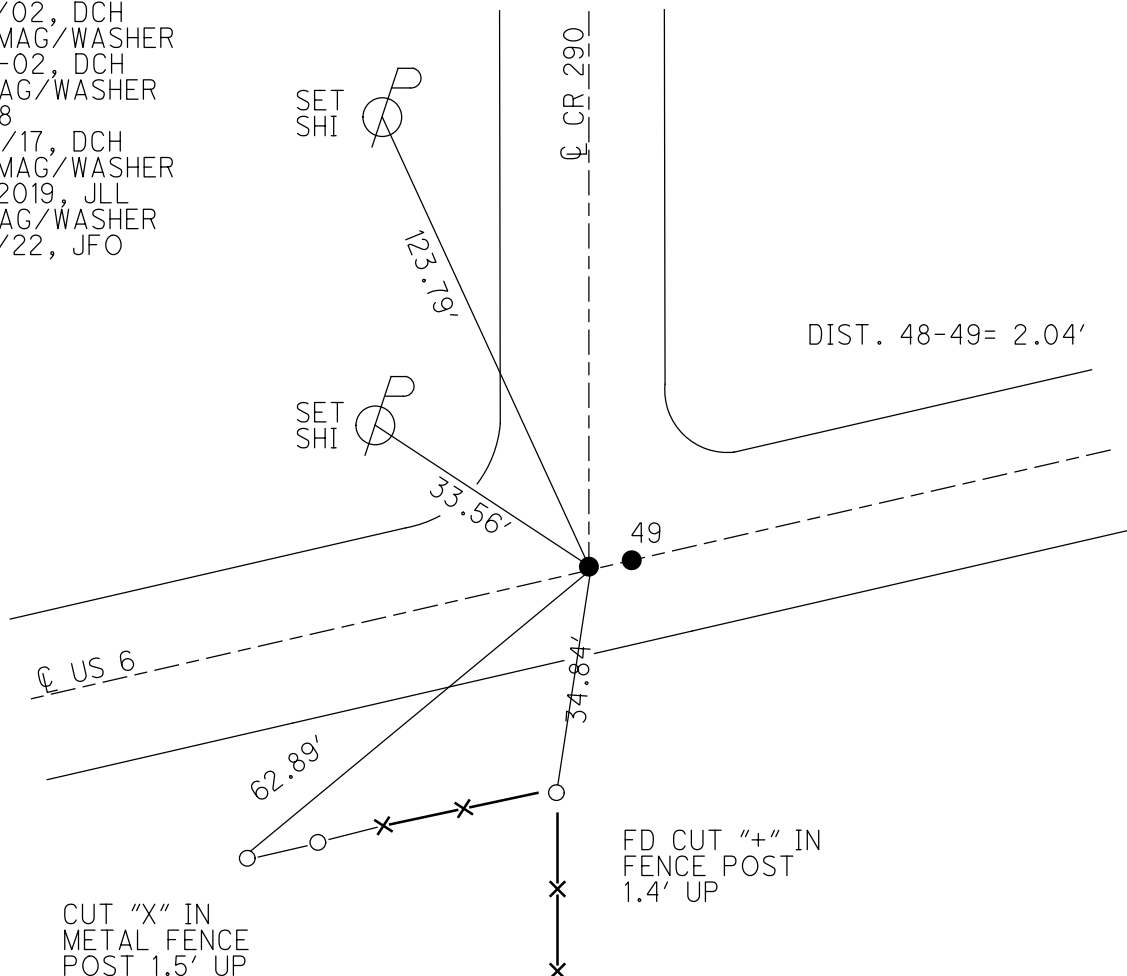

O.D.O.T. DISTRICT 2 SURVEY OFFICE (USE ONLY)

PERSONNEL

REFERENCE NO. 48

SHEET 23 OF 34

NOTES_____LEU

DATE 8/6/18

ROUTE US 6

H.C. LEU

WEATHER HOT

COUNTY SANDUSKY

R.C. HAGEMEYER

TEMP. 89°

TOWNSHIP TOWNSENDSECTION 9

T_5_N R_17_E

DWG BY AUBLE

PID 95769

TYPE MONUMENT MAG NAIL

ON SURFACE - ~~BELOW~~ _____ ON

OFFSET C PAVEMENT 0.3' ~~1.75'~~ : RT


11.9' TO RT EDGE PAVEMENT

STATION: 1557+29

HORZ.DATUM: NAD83 (2011)

GEOID: 2012A

GRID: NORTHING: 636760.739

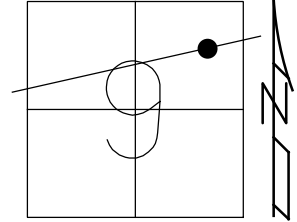EASTING: 1858413.348

RECORD:

FD P.K./WASHER

3/16/02, DCH

SET MAG/WASHER
0.05 00.00 00.00


9-25-02, DCH
ED, MAC/WACH

FD MAG/WASHER
REF 48REF 48
11 / 23 /

11/23/77, DCHA
SET MAC/WASH

8-5-2019 JUL


© 2015, ULL

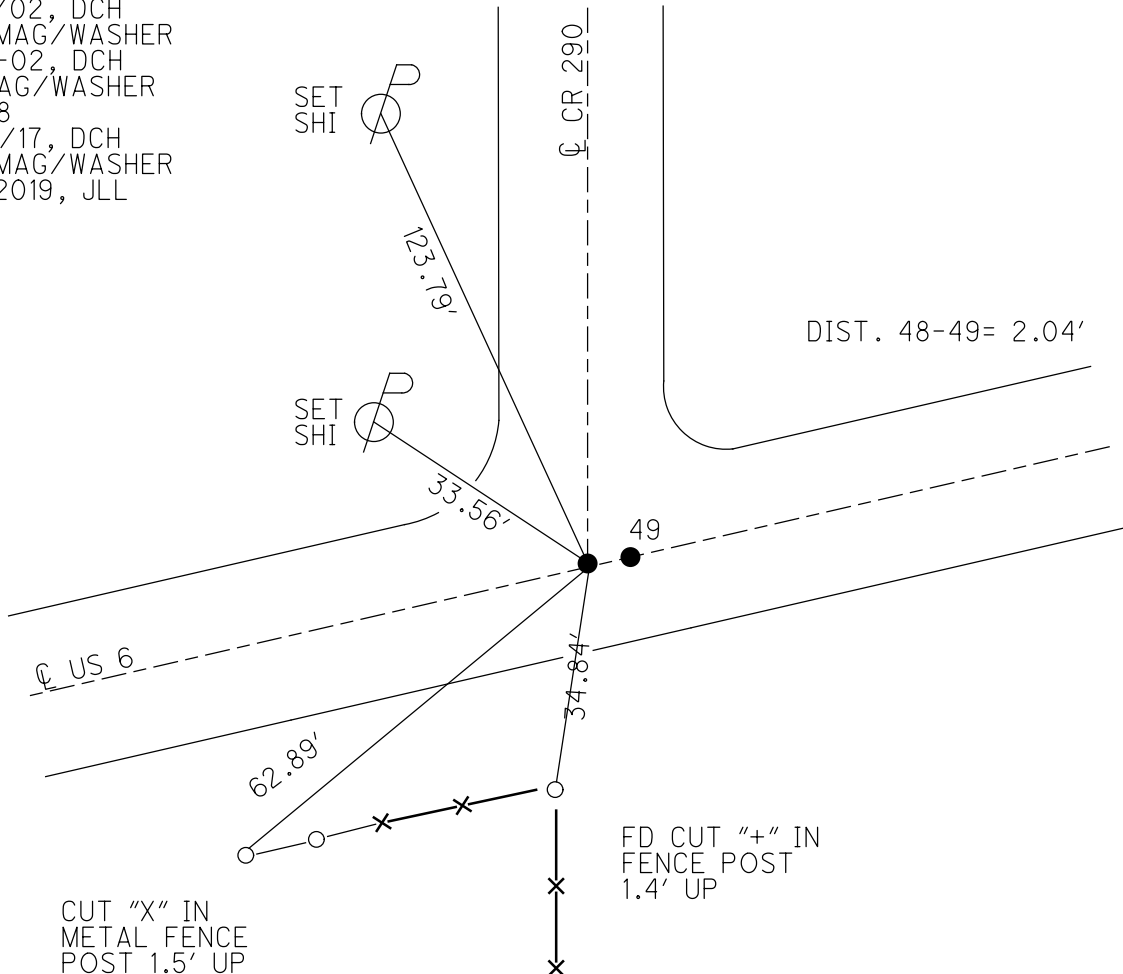


O.D.O.T. DISTRICT 2 SURVEY OFFICE (USE ONLY)

PERSONNEL REFERENCE NO. 48 SHEET 21 OF 31
 NOTES ROUSOS DATE 03/16/02 ROUTE US 6
 H.C. VAN DUSEN WEATHER WINDY COUNTY SANDUSKY
 R.C. MOSSER TEMP. 28° TOWNSHIP TOWNSEND
 HOMAN SECTION 9
 T 5 N R 17 E

TYPE MONUMENT PK/WASHER
 ON SURFACE - BELOW -
~~LEFT~~ - Q PAV'T - RIGHT 0.4'
11.9' TO RT EDGE PAVEMENT
 S.L.M. 1557+29
 GRID: NORTHING: - EASTING: -

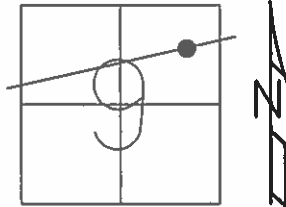

RECORD:
 SET MAG/WASHER
 9-25-02
 DCH

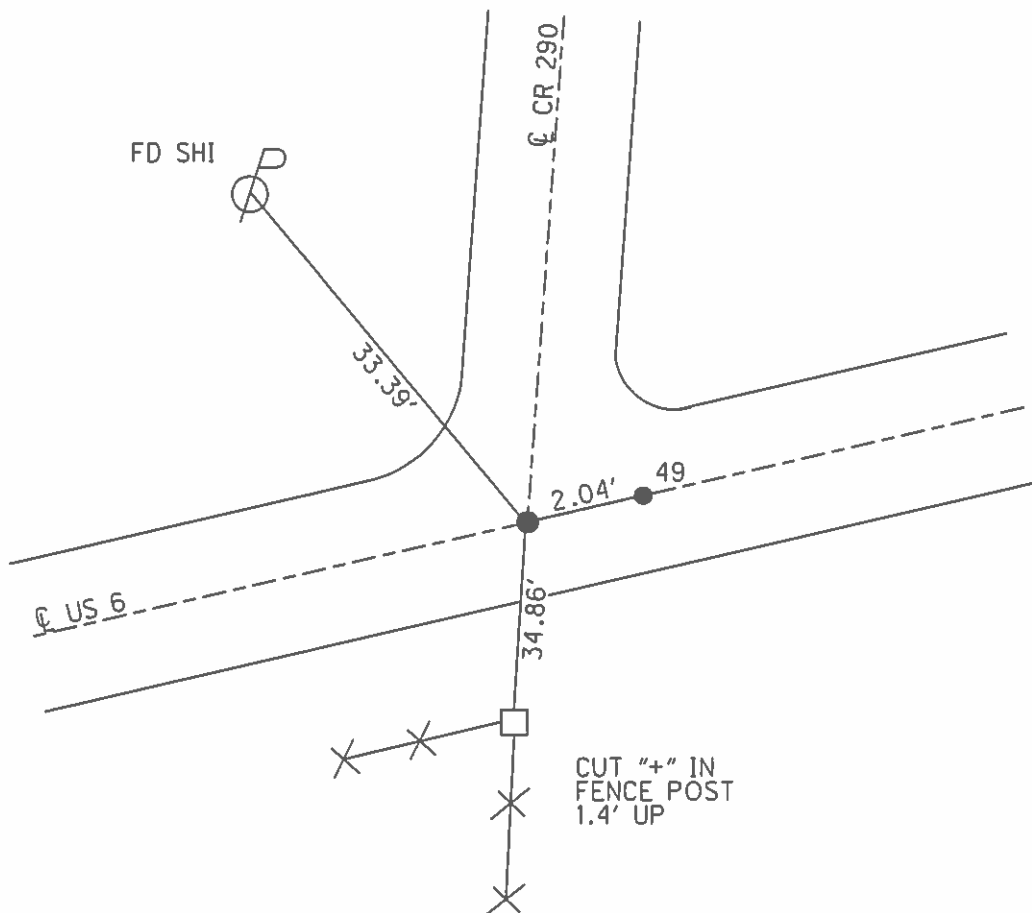

O.D.O.T. DISTRICT 2 SURVEY OFFICE

PERSONNEL

NOTES ROUSOS
H.C. NAN DUSEN
R.C. MOSSER
HOMAN

REFERENCE NO. 48-49

DATE 3-16-02

WEATHER WINDY

TEMP. 28°

SHEET 18 OF 27

ROUTE SR 6

COUNTY Sandusky

TOWNSHIP Townsend

SECTION 9

T5 N R17 E


TYPE MONUMENT PK/Washer (ORIGIN UNKNOWN)

ON SURFACE - BELOW _____


LEFT - Q PAV'T - RIGHT .4' RT

11.9' TO RT EDGE PAVEMENT

S.L.M. 1557+29

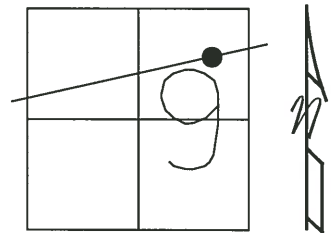

Set Mag Nails & Washers
9-25-02
DCH

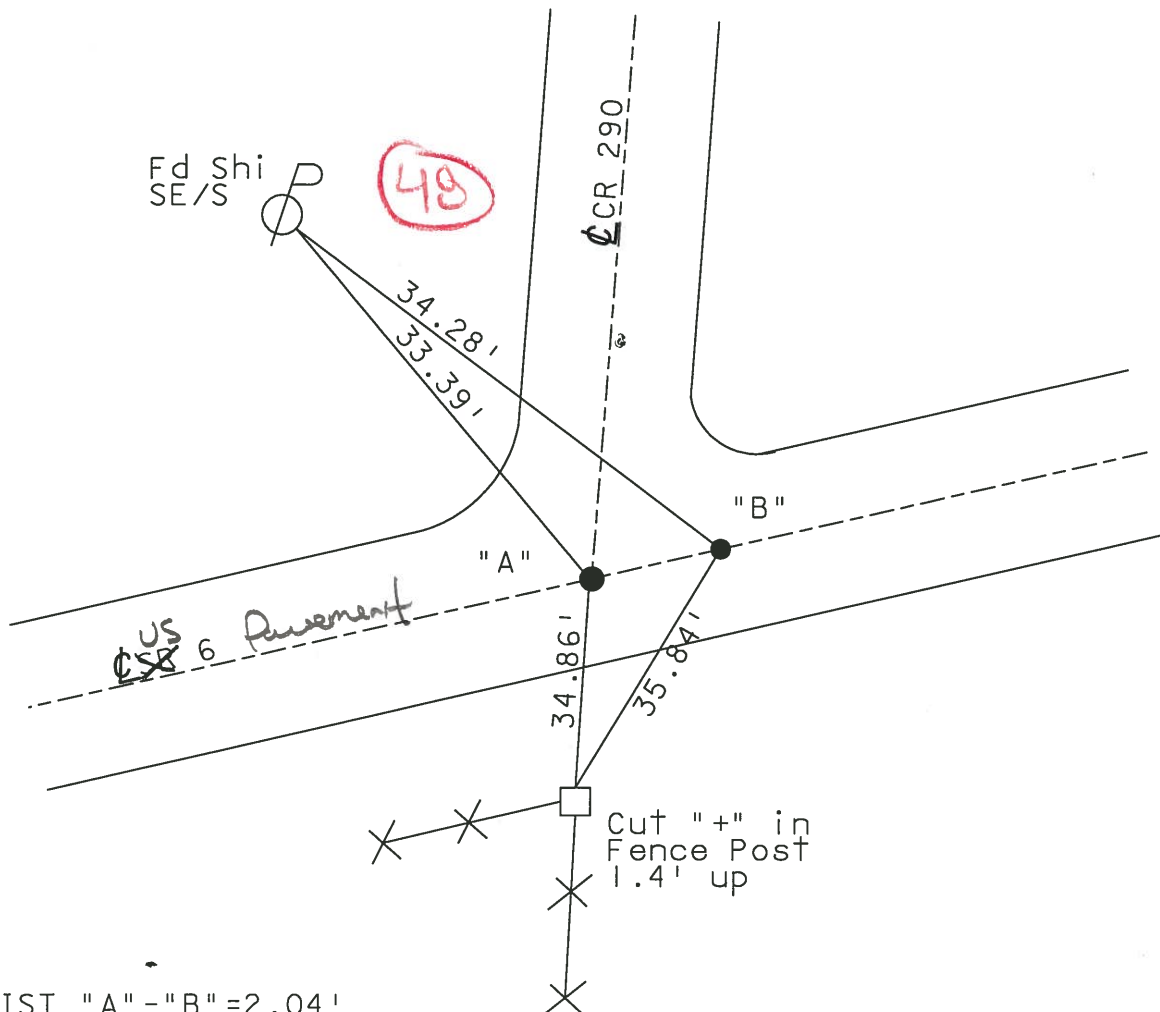

DIST "A" - "B" = 2.04'

O.D.O.T. DISTRICT 2 SURVEY OFFICE

PERSONNEL

REFERENCE NO. _____

SHEET 30 OF 32

NOTES RIPPLE

H.C. BARBOUR

R.C. GEYMAN

DATE 10-3-1991

WEATHER —

TEMP. 75°

ROUTE 6

COUNTY SANDUSKY

TOWNSHIP TOWNSEND

SECTION 2

T5N R17E

TYPE MONUMENT PK/WASHER


~~ON SURFACE~~ - BELOW P.K.

LEFT - & PAV'T. - RIGHT —


— TO — EDGE PAVEMENT

S.L.M. 1557+29

48

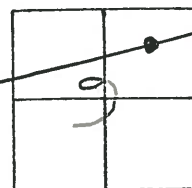

ORIGIN UNKNOWN

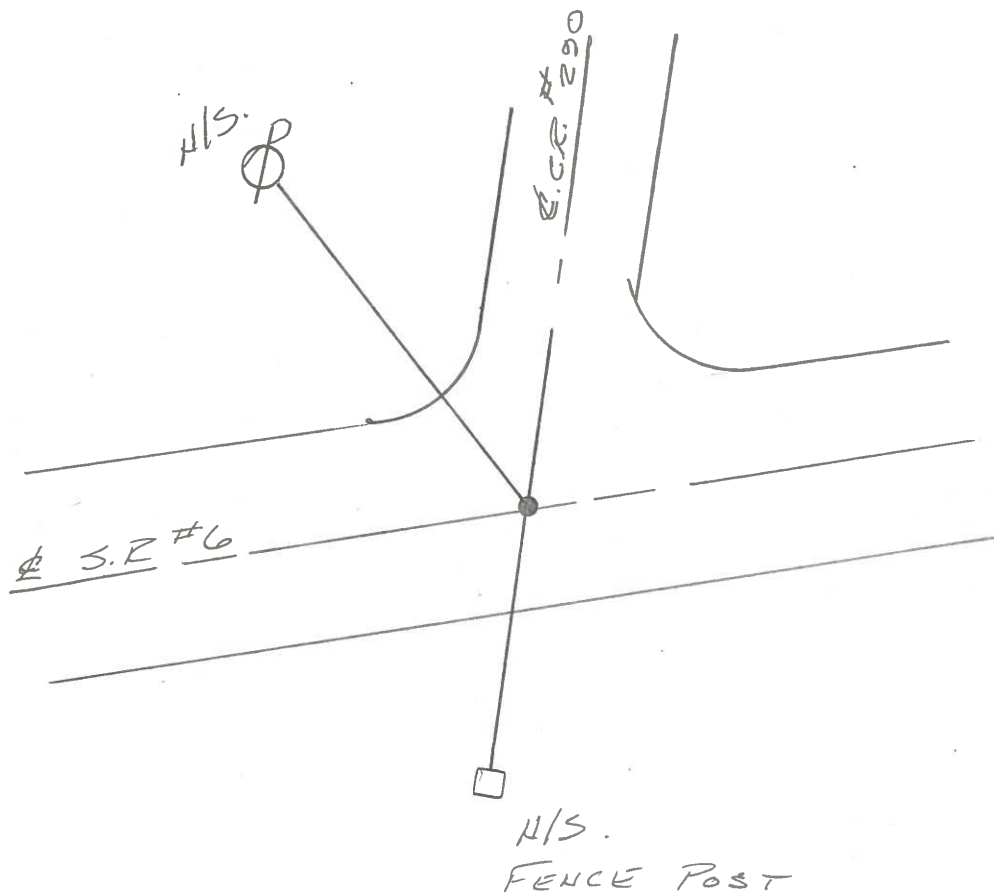

O.D.O.T. DISTRICT 2 SURVEY OFFICE

PERSONNEL

REFERENCE NO. _____

SHEET _____ OF _____

NOTES RIPPLE

H.C. BARBOUR

R.C. GEYMAN

DATE _____

WEATHER _____

TEMP. _____

ROUTE SR. #6

COUNTY SANDUSKY

TOWNSHIP _____

SECTION _____

T _____ R _____


TYPE MONUMENT P.K. Nail

ON SURFACE - BELOW _____

LEFT - & PAW'T. - RIGHT _____

_____ TO _____ EDGE PAVEMENT

S.L.M. _____

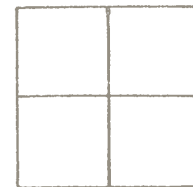

1557+29

4/03/91
57°

48

& CR. 290

34.21

32.53

Fence Post

10/03/91

RIPPLE

BARBOUR

GEYMAN

SET P.K. NAIL & SHINER

Temp 74°