

O.D.O.T. DISTRICT 2 SURVEY OFFICE (USE ONLY)

PERSONNEL

REFERENCE NO. 49

SHEET 24 OF 34

NOTES PRESTON-COLVIN

DATE 9-5-24

ROUTE US 6

H.C. NEISE

WEATHER SUNNY

COUNTY SANDUSKY

R.C. BARRIERE

TEMP. 74°

TOWNSHIP TOWNSEND

DWG BY PRESTON-COLVIN PID PAVING TRAIN

SECTION 9

T 5 N R 17 E

TYPE MONUMENT MEG/WASHER

ON SURFACE - ~~BELOW~~ ON

OFFSET Q PAVEMENT 0.3' ~~LT~~ : RT

11.9' TO RT EDGE PAVEMENT

STATION: 1557+29

HORZ.DATUM: NAD83 (2011)


GEOID: NAVD88 2018

GRID: NORTHING: 636761.650

EASTING: 1858415.240


LDP: NORTHING: 333154.1

EASTING: 218533.2

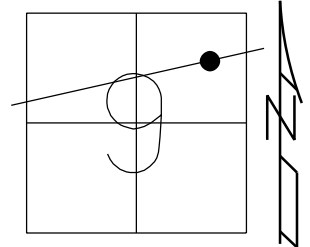

RECORD:

FD P.K./WASHER
3/16/02, DCH
SET MAG/WASHER
9-25-02, DCH
FD MAG/WASHER
REF49
11/23/17, DCH
SET MAG/WASHER
8-5-2019, JLL
FD MAG/WASHER
2/10/22, JFO
SET MAG/WASHER
11/20/23, DSA
FD MAG/WASHER
REF49
9/5/24, TDN
FD MAG/WASHER
10/3/24, JAM

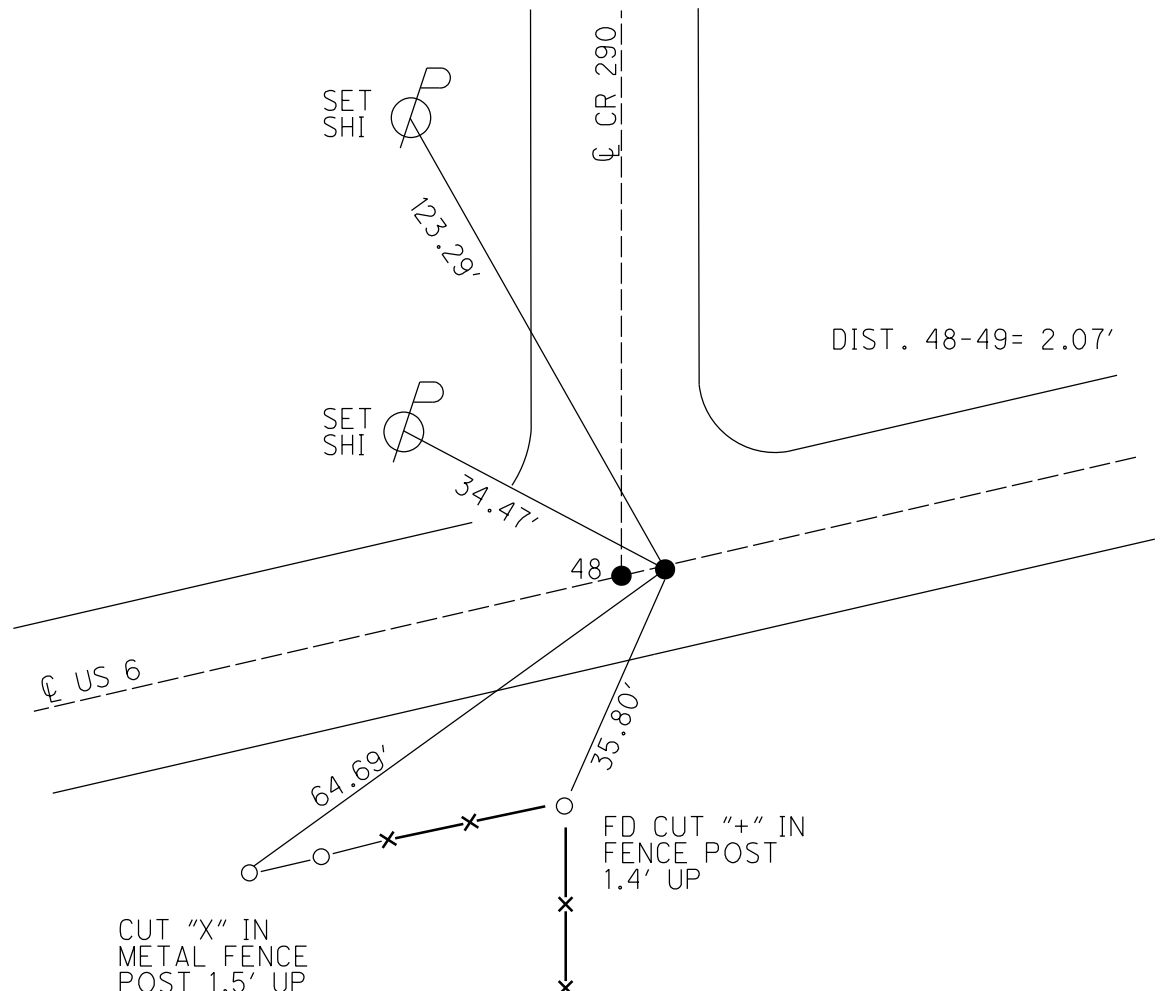

O.D.O.T. DISTRICT 2 SURVEY OFFICE (USE ONLY)

PERSONNEL

REFERENCE NO. 49

SHEET 24 OF 34

NOTES RHOADES

DATE 11/20/23

ROUTE US 6

H.C. AUBLE

WEATHER WINDY

COUNTY SANDUSKY

R.C. MILLER

TEMP. 41°

TOWNSHIP TOWNSEND

DWG BY RHOADES PID PAVETRAN

T 5 N R 17 E

TYPE MONUMENT MAG/WASHER

ON SURFACE - ~~BELOW~~ ON _____

OFFSET C PAVEMENT 0.3' ~~LT~~ : RT

11.9' TO RT EDGE PAVEMENT


STATION: 1557+29

HORZ.DATUM: NAD83 (2011)


GEOID: NAVD88 2018

GRID: NORTHING: 636761.650

EASTING: 1858415.240

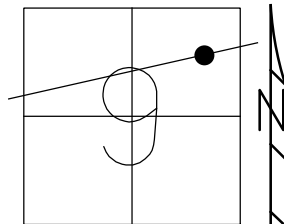

RECORD:
FD P.K./WASHER
3/16/02, DCH
SET MAG/WASHER
9-25-02, DCH
FD MAG/WASHER
REF49
11/23/17, DCH
SET MAG/WASHER
8-5-2019, JLL
FD MAG/WASHER
2/10/22, JFO
SET MAG/WASHER
11/20/23, DSA

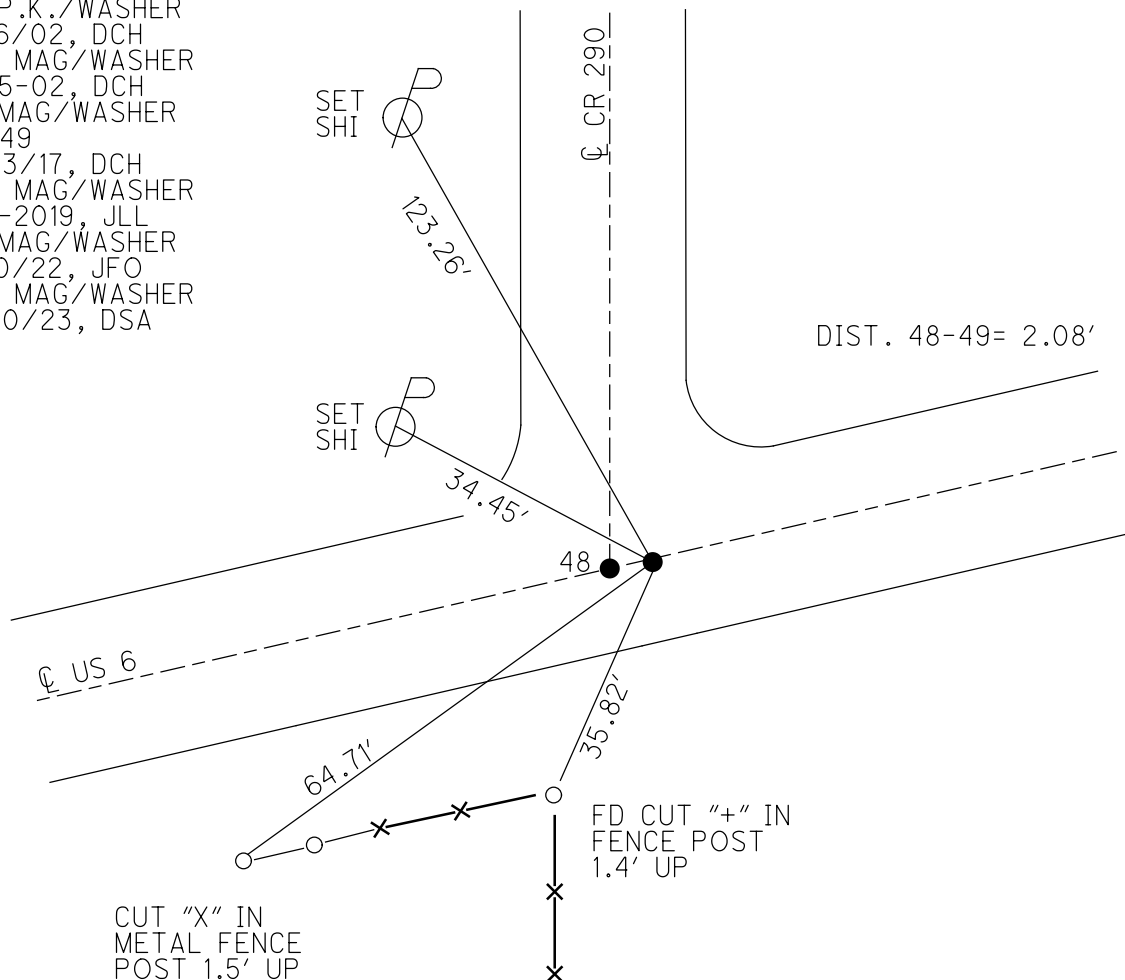

O.D.O.T. DISTRICT 2 SURVEY OFFICE (USE ONLY)

PERSONNEL

REFERENCE NO. 49

SHEET 24 OF 34

NOTES LEU

DATE 8/6/18

ROUTE US 6

H.C. LEU

WEATHER HOT

COUNTY SANDUSKY

R.C. HAGEMeyer

TEMP. 89°

TOWNSHIP TOWNSEND

DWG BY AUBLE PID 95769

SECTION 9

T 5 N R 17 E

TYPE MONUMENT MAG/WASHER

ON SURFACE - ~~BELOW~~ ON

OFFSET 0.3' LT : RT

11.9' TO RT EDGE PAVEMENT


STATION: 1557+29

HORIZ.DATUM: NAD83 (2011)

GEOID: 2012A

GRID: NORTHING: 636761.650

EASTING: 1858415.240

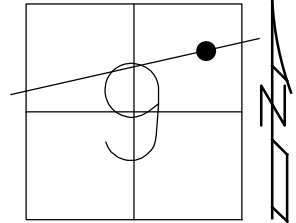

RECORD:

FD P.K./WASHER

3/16/02, DCH

SET MAG/WASHER

9-25-02, DCH

FD MAG/WASHER

REF49


11/23/17, DCH

SET MAG/WASHER

8-5-2019, JLL

FD MAG/WASHER

2/10/22, JFO

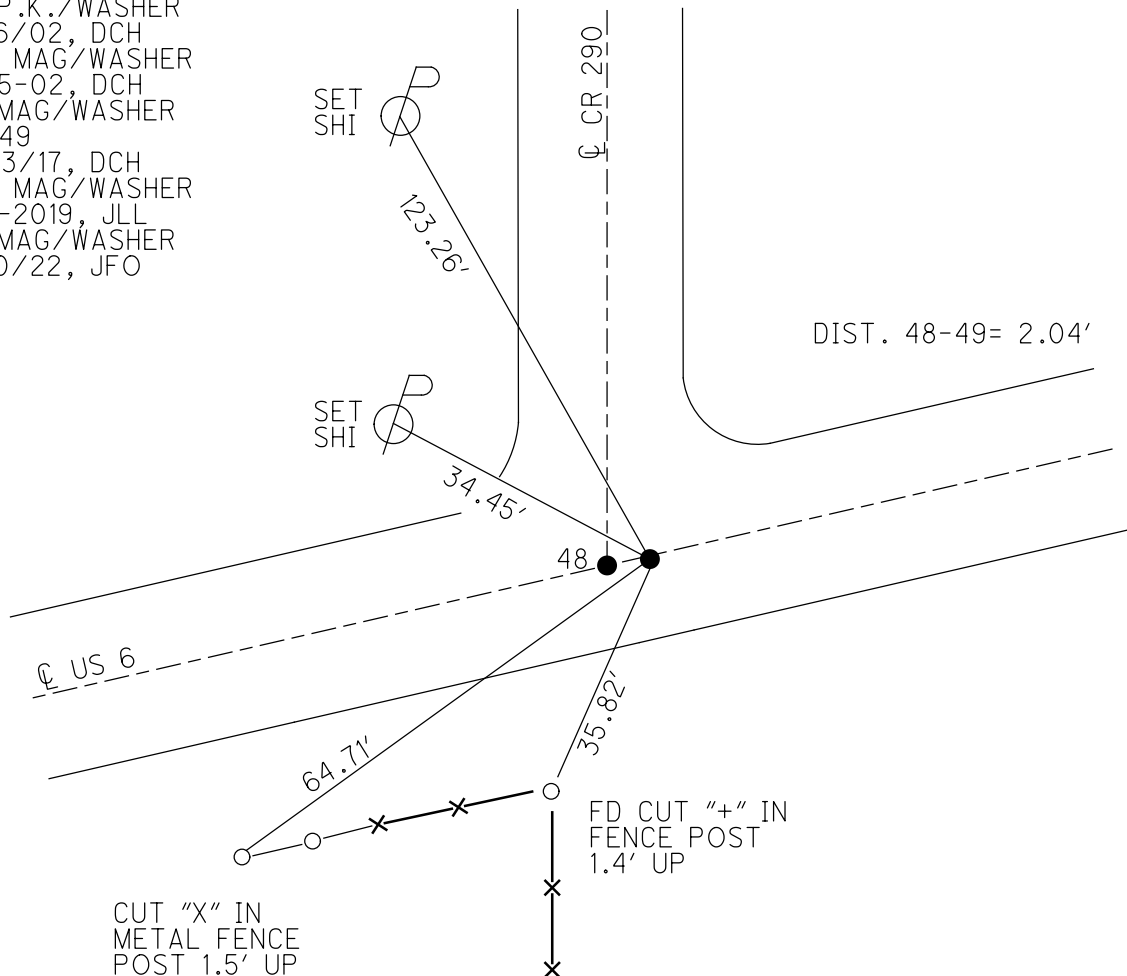

O.D.O.T. DISTRICT 2 SURVEY OFFICE (USE ONLY)

PERSONNEL

REFERENCE NO. 49

SHEET 24 OF 34

NOTES LEU

DATE 8/6/18

ROUTE US 6

H.C. LEU

WEATHER HOT

COUNTY SANDUSKY

R.C. HAGEMEYER

TEMP. 89°

TOWNSHIP TOWNSEND

DWG BY AUBLE

PID 95769

SECTION 9

T 5 N R 17 E

TYPE MONUMENT MAG/WASHER

ON SURFACE - ~~BELOW~~ ON

OFFSET Q PAVEMENT 0.3' ~~LT~~ : RT

11.9' TO RT EDGE PAVEMENT


STATION: 1557+29

HORIZ.DATUM: NAD83 (2011)

GEOID: 2012A


GRID: NORTHING: 636761.650

EASTING: 1858415.240

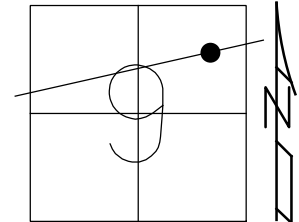

RECORD:


FD P.K./WASHER
3/16/02, DCH
SET MAG/WASHER
9-25-02, DCH
FD MAG/WASHER
REF 49
11/23/17, DCH
SET MAG/WASHER
8-5-2019, JLL

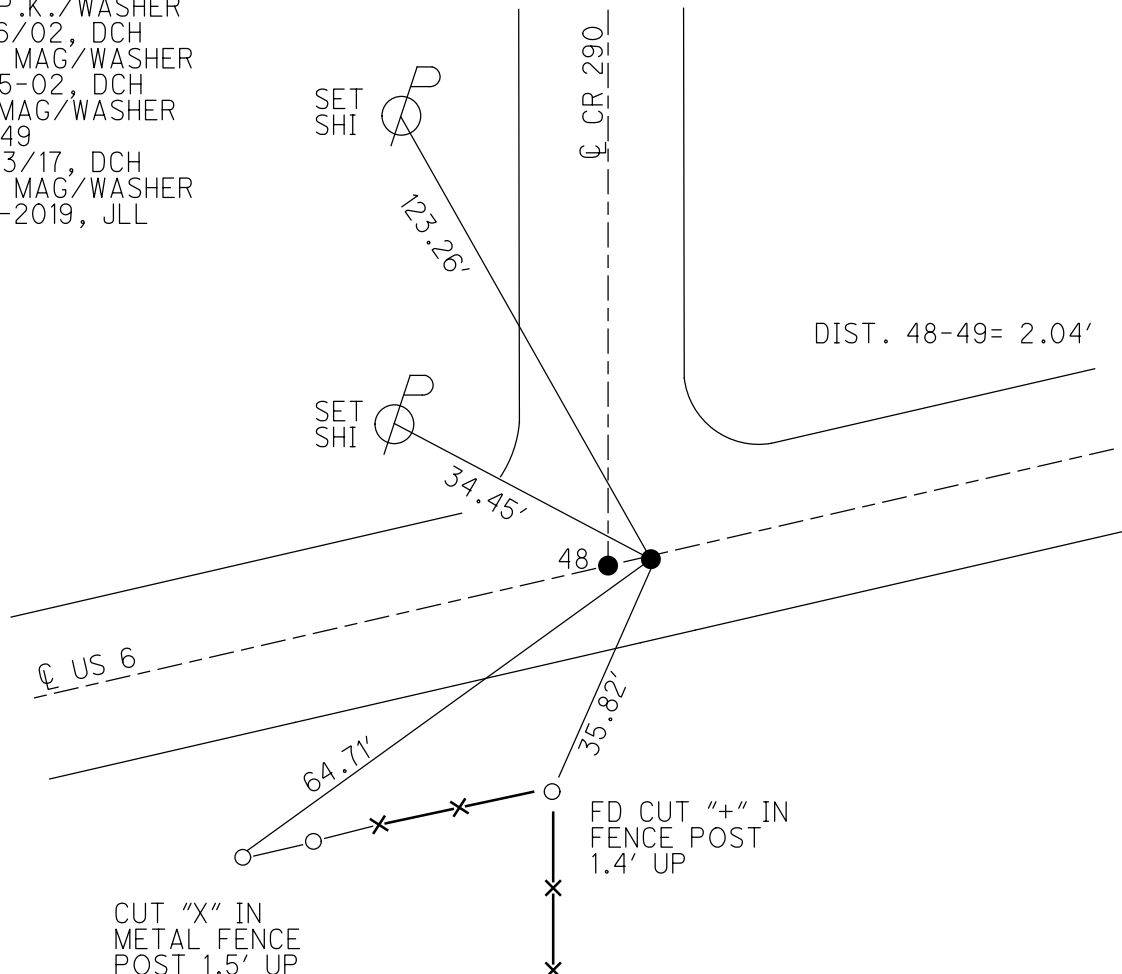


O.D.O.T. DISTRICT 2 SURVEY OFFICE (USE ONLY)

PERSONNEL	REFERENCE NO.	49	SHEET	22	OF	31
NOTES	ROUSOS	DATE	3-16-02	ROUTE	US 6	
H.C.	VAN DUSEN	WEATHER	WINDY	COUNTY	SANDUSKY	
R.C.	MOSSER	TEMP.	28°	TOWNSHIP	TOWNSEND	
	HOMAN			SECTION	9	
				T	5	N
				R	17	E

TYPE MONUMENT _____ PK/WASHER _____
ON SURFACE - BELOW _____ - _____
LEFT - $\odot$ PAV'T - ~~RIGHT~~ _____ 0.4' _____
11.9' TO RT EDGE PAVEMENT
S.L.M. _____ 1557+29
GRID: NORTHING: _____ - _____ EASTING: _____ - _____

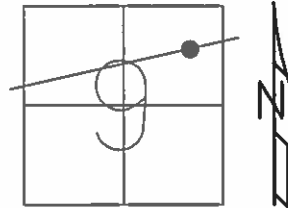

RECORD:
SET MAG/WASHER
9-25-02
DCH

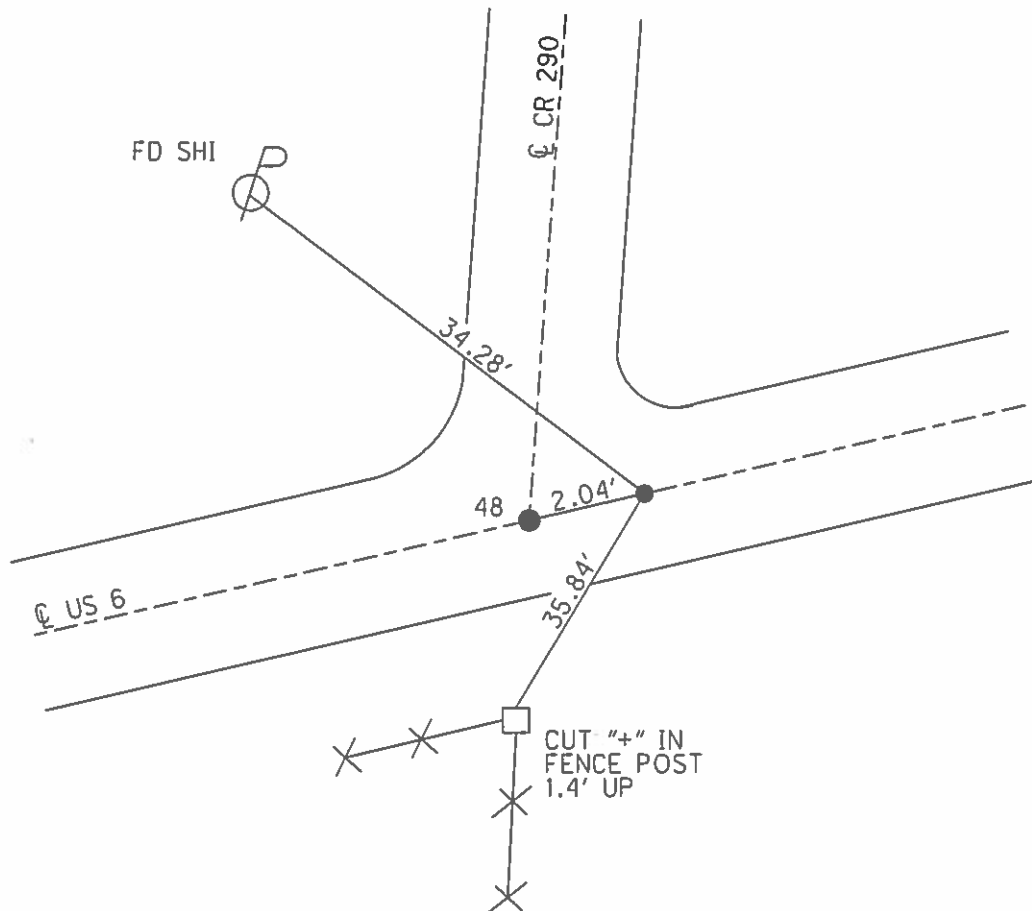

O.D.O.T. DISTRICT 2 SURVEY OFFICE

PERSONNEL

NOTES ROUSOS
H.C. NAN DUSEN
R.C. MOSSER
HOMAN

REFERENCE NO. 48-49 SHEET 18 OF 27

DATE 3-16-02
WEATHER WINDY
TEMP. 28°

ROUTE ^{U.S.} ~~SR~~ 6
COUNTY Sandusky
TOWNSHIP Townsend
SECTION 9
T 5 N R 17 E


TYPE MONUMENT PK/Washer (ORIGIN UNKNOWN)

ON SURFACE - BELOW

LEFT - Q PAV'T - RIGHT .4' RT

11.9' TO RT EDGE PAVEMENT

S.L.M. 1557+29

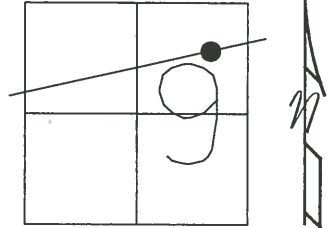

Set Mag Nails & Washers
9-25-02
DCH

