

O.D.O.T. DISTRICT 2 SURVEY OFFICE (USE ONLY)

PERSONNEL

REFERENCE NO. 50

SHEET 25 OF 34

NOTES PRESTON-COLVIN

DATE 9-5-24

ROUTE US 6

H.C. NEISE

WEATHER SUNNY

COUNTY SANDUSKY

R.C. BARRIERE

TEMP. 74°

TOWNSHIP TOWNSEND

DWG BY PRESTON-COLVIN

PID PAVING TRAIN

T 5 N R 17 E

TYPE MONUMENT MEG/WASHER

ON SURFACE - ~~BELOW~~ ON

OFFSET ¢ PAVEMENT ON LT : RT

12.7' TO RT EDGE PAVEMENT

STATION: 1569+12

HORIZ.DATUM: NAD83 (2011)


GEOID: NAVD88 2018

GRID: NORTHING: 637239.209


EASTING: 1859497.565

LDP: NORTHING: 333639.2

EASTING: 219612.4

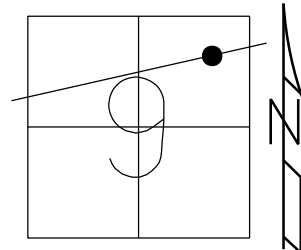

RECORD: P.I.
 $\Delta = 00^\circ 33' \text{ RT (PLAN)}$
 STA. 25+00
 P.K./WASHER
 BOAT SPIKE
 FD P.K./WASHER
 3/16/02, DCH
 FD P.K./WASHER
 REF50
 3-5-14, TMR
 FD MAG/WASHER
 REF50
 11/23/17, DCH
 SET MAG/WASHER
 8-5-19, JLL
 FD MAG/WASHER
 2/10/22, JFO
 1/20/23,
 12/28/23, JMR
 FD MAG/WASHER
 REF50
 9/5/24, TDN
 FD MAG/WASHER
 10/3/24, JAM

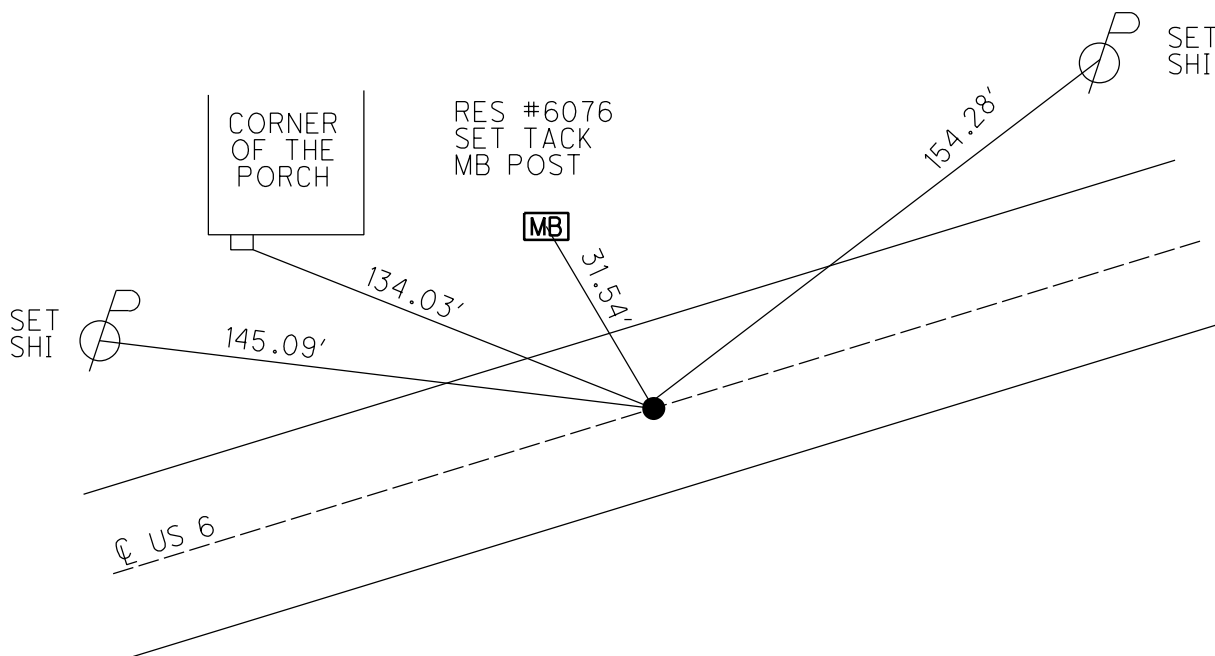

O.D.O.T. DISTRICT 2 SURVEY OFFICE (USE ONLY)

PERSONNEL

REFERENCE NO. 50

SHEET 25 OF 34

NOTES MILLER

DATE 12/28/23

ROUTE US 6

H.C. RHOADES

WEATHER RAIN

COUNTY SANDUSKY

R.C. MILLER

TEMP. 44°

TOWNSHIP TOWNSEND

DWG BY RHOADES

PID PAVETRAIN

SECTION 9

T 5 N R 17 E

TYPE MONUMENT MAG/WASHER

ON SURFACE - ~~BELOW~~ ON

OFFSET Q PAVEMENT ON LT : RT

12.7' TO RT EDGE PAVEMENT


STATION: 1569+12

HORIZ.DATUM: NAD83 (2011)


GEOID: NAVD88 2018

GRID: NORTHING: 637239.209

EASTING: 1859497.565

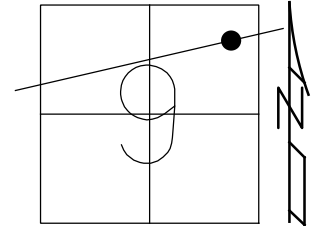

RECORD: P.I.
 $\Delta = 00^{\circ} 33' \text{ RT (PLAN)}$
STA. 25+00
P.K./WASHER
BOAT SPIKE
FD P.K./WASHER
3/16/02, DCH
FD P.K./WASHER
REF50
3-5-14, TMR
FD MAG/WASHER
REF50
11/23/17, DCH
SET MAG/WASHER
8-5-19, JLL
FD MAG/WASHER
2/10/22, JFO
1/20/23,
12/28/23, JMR

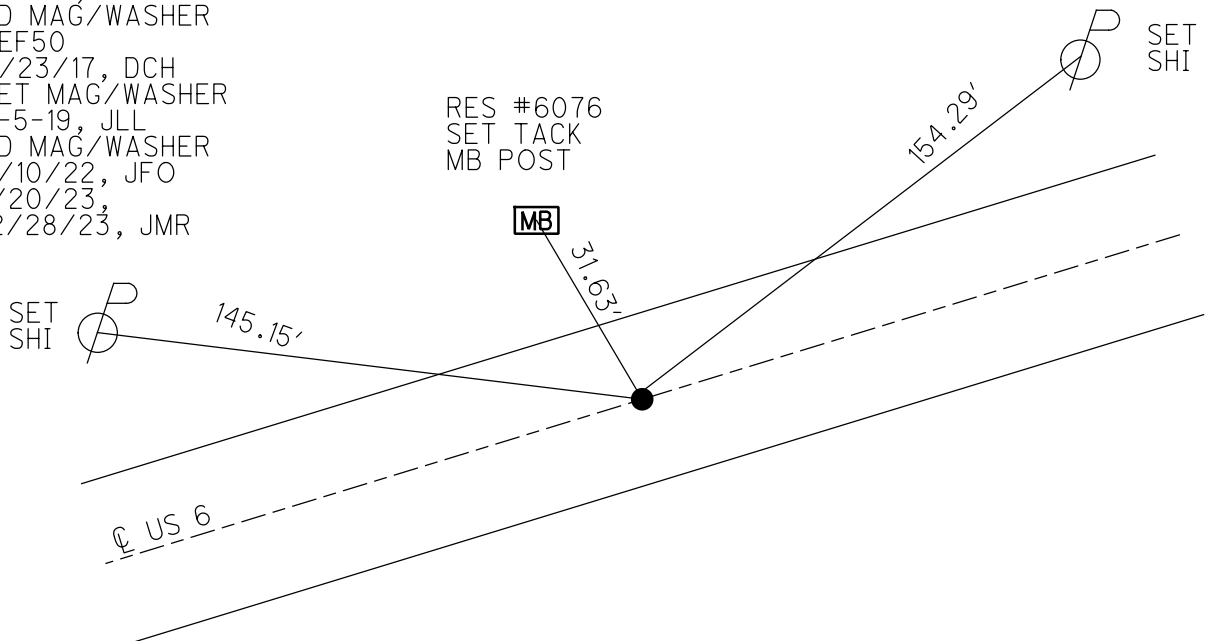

O.D.O.T. DISTRICT 2 SURVEY OFFICE (USE ONLY)

PERSONNEL

REFERENCE NO. 50

SHEET 25 OF 34

NOTES LEU

DATE 8/7/18

ROUTE US 6

H.C. LEU

WEATHER CLOUDY

COUNTY SANDUSKY

R.C. HAGEMEYER

TEMP. 75°

TOWNSHIP TOWNSEND

DWG BY AUBLE

PID PAVETRAIN

SECTION 9

T 5 N R 17 E

TYPE MONUMENT MAG/WASHER

ON SURFACE - ~~BELOW~~ ON

OFFSET Q PAVEMENT 0.6' LT : ~~RT~~

12.7' TO RT EDGE PAVEMENT


STATION: 1569+12

HORZ.DATUM: NAD83 (2011)

GEOID: 2012A

GRID: NORTHING: 637239.209

EASTING: 1859497.565

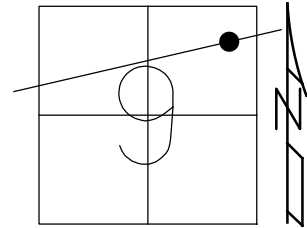

RECORD: P.I.

$\Delta = 00^\circ 33'$ RT (PLAN)

STA. 25+00

PREVIOUS MONUMENTS:

P.K./WASHER

BOAT SPIKE

FD P.K./WASHER

3/16/02, DCH

FD P.K./WASHER

REF50

3-5-14, TMR

FD MAG/WASHER

REF50

11/23/17, DCH


SET MAG/WASHER

8-5-19, JLL

FD MAG/WASHER

2/10/22, JFO

1/20/23, JMR

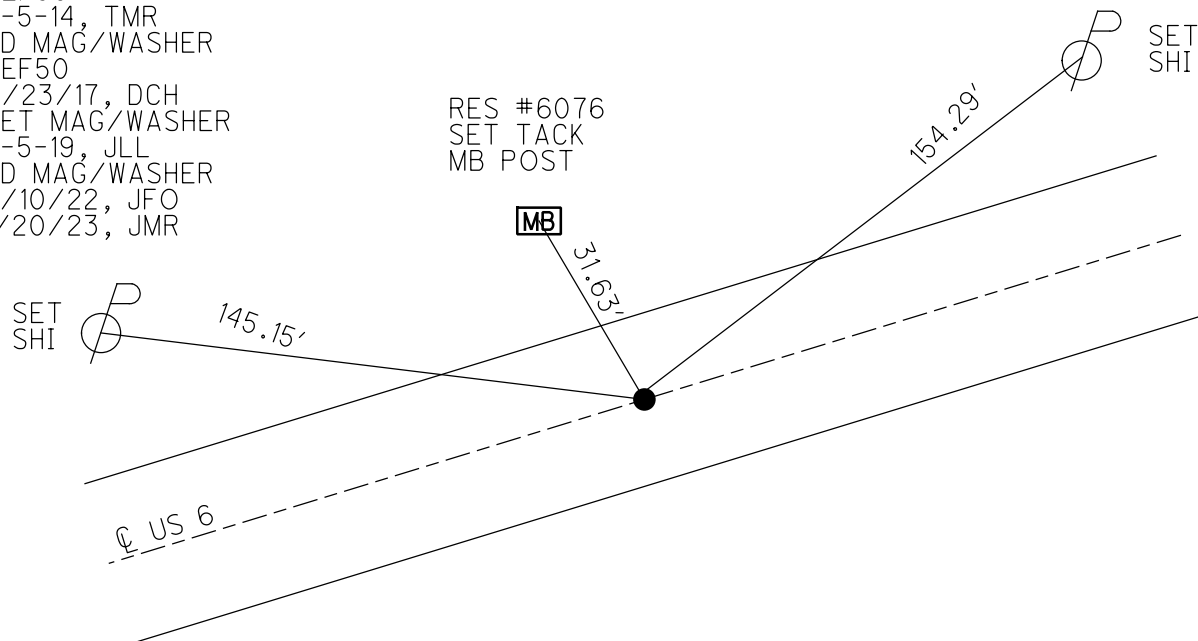

O.D.O.T. DISTRICT 2 SURVEY OFFICE (USE ONLY)

PERSONNEL

REFERENCE NO. 50

SHEET 25 OF 34

NOTES LEU

DATE 8/7/18

ROUTE US 6

H.C. LEU

WEATHER CLOUDY

COUNTY SANDUSKY

R.C. HAGEMeyer

TEMP. 75°

TOWNSHIP TOWNSEND

DWG BY AUBLE PID 95769

SECTION 9

T 5 N R 17 E

TYPE MONUMENT MAG/WASHER

ON SURFACE - ~~BELOW~~ ON

OFFSET CL PAVEMENT 0.6' LT : ~~RT~~

12.7' TO RT EDGE PAVEMENT


STATION: 1569+12

HORIZ.DATUM: NAD83 (2011)


GEOID: 2012A

GRID: NORTHING: 637239.209

EASTING: 1859497.565

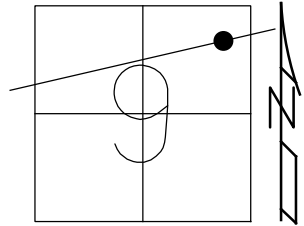

RECORD: P.I.
 $\Delta = 00^\circ 33' \text{ RT (PLAN)}$
STA. 25+00
PREVIOUS MONUMENTS:
P.K./WASHER
BOAT SPIKE
FD P.K./WASHER
3/16/02, DCH
FD P.K./WASHER
REF50
3-5-14, TMR
FD MAG/WASHER
REF50
11/23/17, DCH
SET MAG/WASHER
8-5-19, JLL
FD MAG/WASHER
2/10/22, JFO

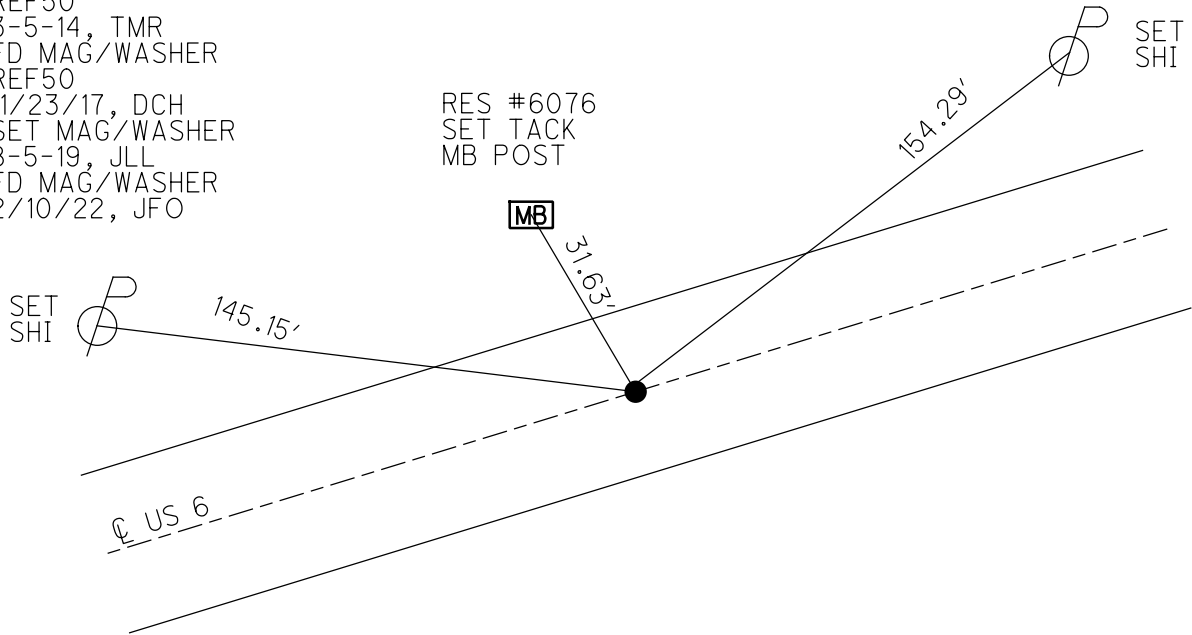

O.D.O.T. DISTRICT 2 SURVEY OFFICE (USE ONLY)

PERSONNEL

REFERENCE NO. 50

SHEET 25 OF 34

NOTES LEU

DATE 8/7/18

ROUTE US 6

H.C. LEU

WEATHER CLOUDY

COUNTY SANDUSKY

R.C. HAGEMEYER

TEMP. 75°

TOWNSHIP TOWNSEND

DWG BY AUBLE

PID 95769

SECTION 9

T 5 N R 17 E

TYPE MONUMENT MAG/WASHER

ON SURFACE - ~~BELOW~~ ON

OFFSET Q PAVEMENT 0.6' LT : ~~RT~~

12.7' TO RT EDGE PAVEMENT


STATION: 1569+12

HORIZ.DATUM: NAD83 (2011)

GEOID: 2012A


GRID: NORTHING: 637239.209

EASTING: 1859497.565

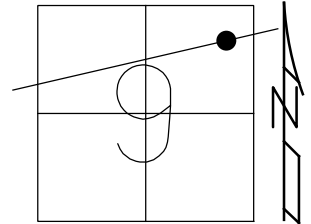

RECORD: P.I.
Δ= 00° 33' RT (PLAN)
STA. 25+00
PREVIOUS MONUMENTS:
P.K./WASHER
BOAT SPIKE
FD P.K./WASHER
3/16/02, DCH
FD P.K./WASHER
REF50
3-5-14, TMR
FD MAG/WASHER
REF50
11/23/17, DCH
SET MAG/WASHER
8-5-19, JLL


RES #6076
SET TACK
MB POST

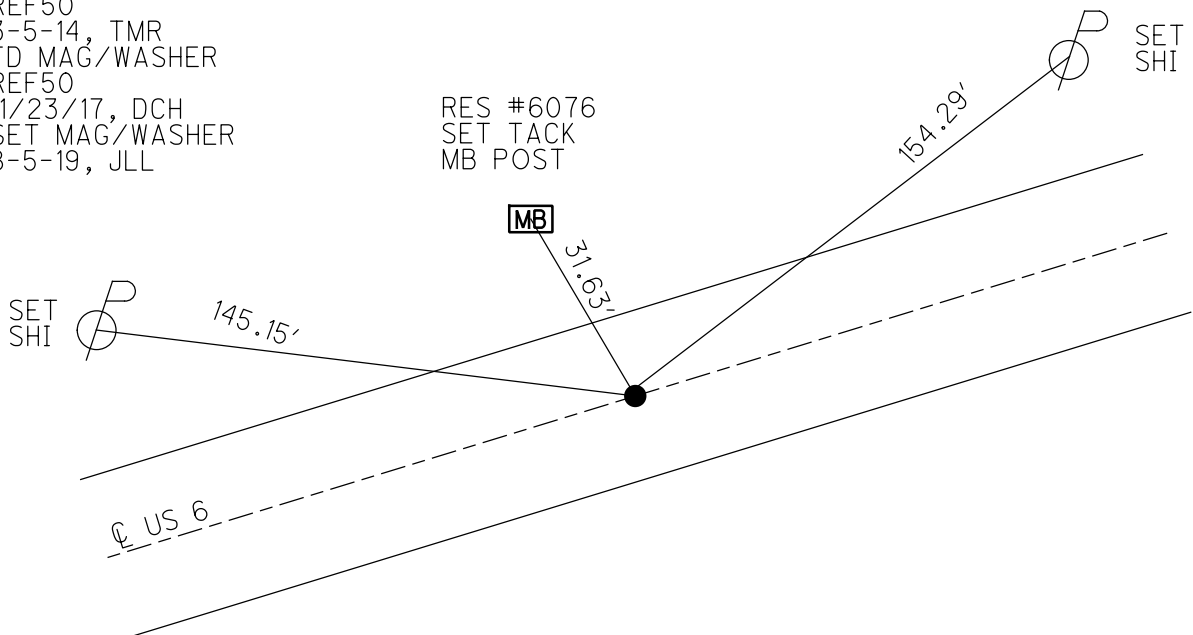


O.D.O.T. DISTRICT 2 SURVEY OFFICE (USE ONLY)

PERSONNEL	REFERENCE NO. <u>50</u>	SHEET <u>23</u> OF <u>31</u>
NOTES	DATE <u>03/16/02</u>	ROUTE <u>US 6</u>
H.C. <u>ROUSOS</u>	WEATHER <u>WINDY</u>	COUNTY <u>SANDUSKY</u>
R.C. <u>VAN DUSEN</u>	TEMP. <u>28°</u>	TOWNSHIP <u>TOWNSEND</u>
<u>MOSSER</u>		SECTION <u>9</u>
<u>HOMAN</u>		
		T <u>5</u> N R <u>17</u> E

TYPE MONUMENT PK/WASHER
 ON SURFACE - ~~BELOW~~ ON
 LEFT - CL PAV'T - ~~RIGHT~~ 0.6'
12.7' TO RT EDGE PAVEMENT
 S.L.M. 1571+16.58
 GRID: NORTHING: 637239.240 EASTING: 1859497.555

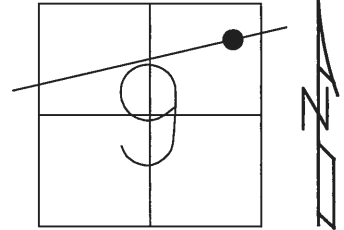


RECORD:
 PI Δ = 00° 33' RT (PLAN)
 STA 25+00
 PK/WASHER
 BOAT SPK
 FD PK/WASHER
 REF50
 3-5-14, TMR

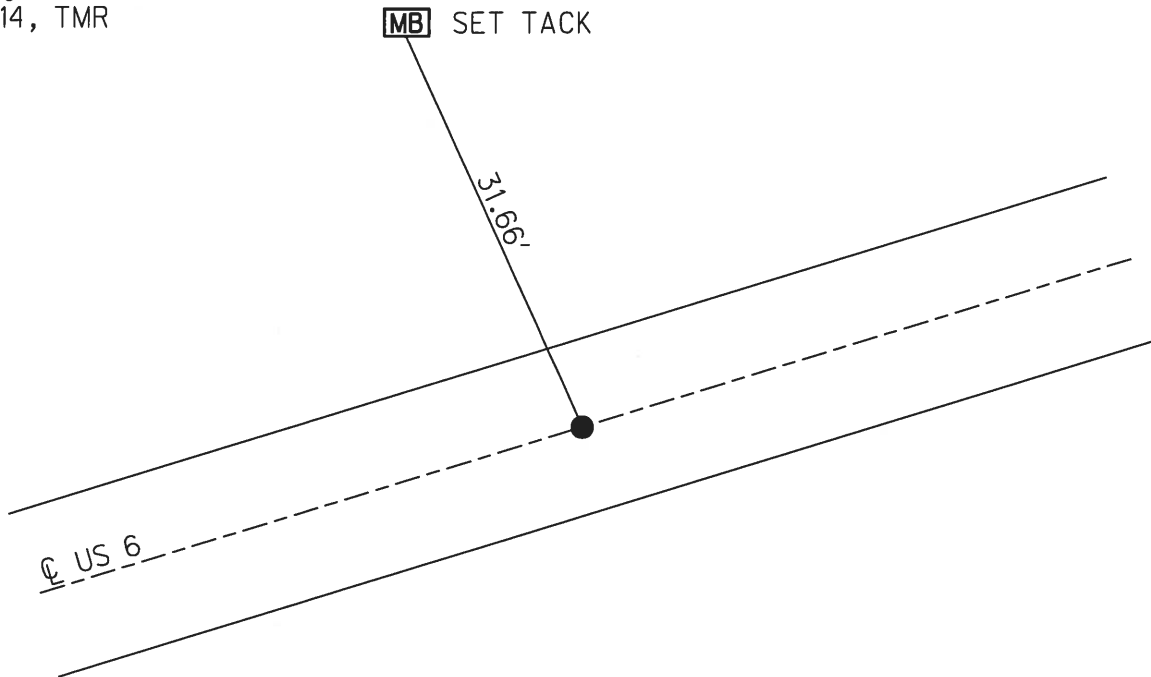


O.D.O.T. DISTRICT 2 SURVEY OFFICE (USE ONLY)

PERSONNEL _____ REFERENCE NO. 50 SHEET 23 OF 31
 NOTES ROUSOS DATE 03/16/02 ROUTE US 6
 H.C. VAN DUSEN WEATHER WINDY COUNTY SANDUSKY
 R.C. MOSSER TEMP. 28° TOWNSHIP TOWNSEND
 _____ SECTION 9
 _____ T 5 N R 17 E

TYPE MONUMENT _____ PK/WASHER _____
 ON SURFACE - ~~BELOW~~ _____ ON _____
 LEFT - ℄ PAV'T - ~~RIGHT~~ 0.6'
12.7' TO RT EDGE PAVEMENT
 S.L.M. 1569+12
 GRID: NORTHING: _____ EASTING: _____

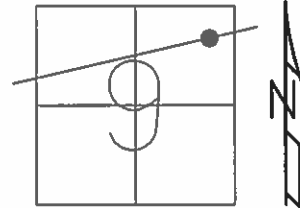

RECORD: PI
 $\Delta = 00^\circ 33'$ RT (PLAN)
 STA 25+00
 PREVIOUS MONUMENTS
 PK/WASHER
 BOAT SPK

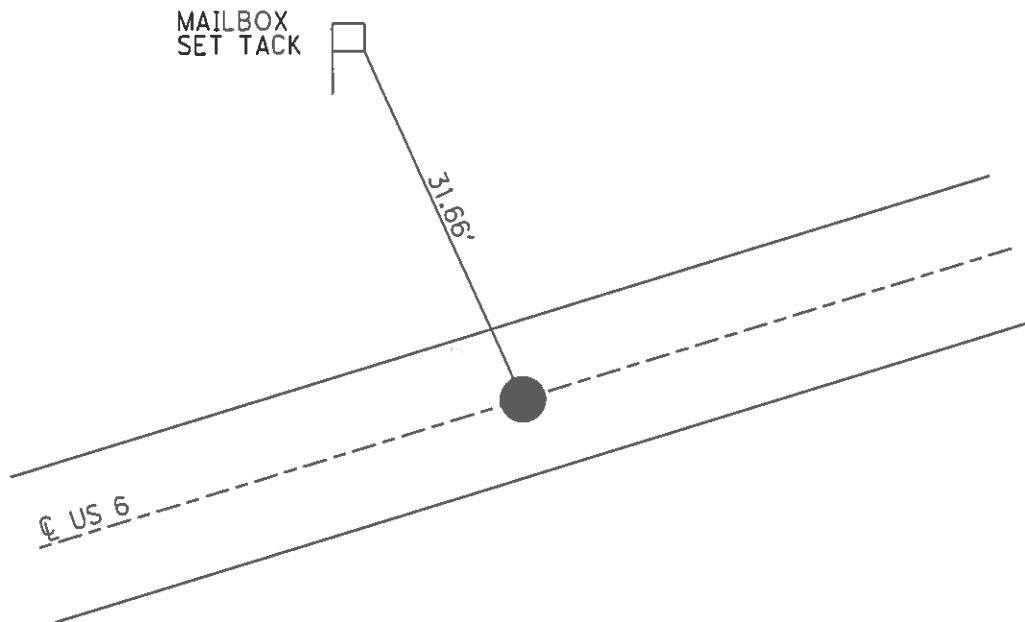

O.D.O.T. DISTRICT 2 SURVEY OFFICE

PERSONNEL

REFERENCE NO. _____

SHEET 31 OF 32

NOTES RIPPLE

H.C. BARBOR

DATE 10-3-1991

ROUTE 6

R.C. GEYMAN

WEATHER _____

COUNTY SANDUSKY

TEMP. 75°

TOWNSHIP TOWNSEND

SECTION 9

T 5 N R 17 E

TYPE MONUMENT PK/WASHER


ON SURFACE - BELOW

LEFT- & PAV'T. - RIGHT _____

TO _____ EDGE PAVEMENT

S.L.M. 1569+12

(50)

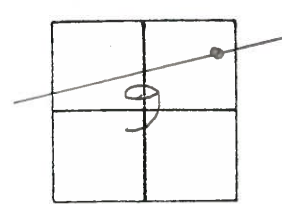

P.I.


$\Delta = 00^{\circ} 33' \text{ RT. (PLAN)}$

STA. 25+00

PREVIOUS MONUMENTS

PK/WASHER

BOAT SPK.

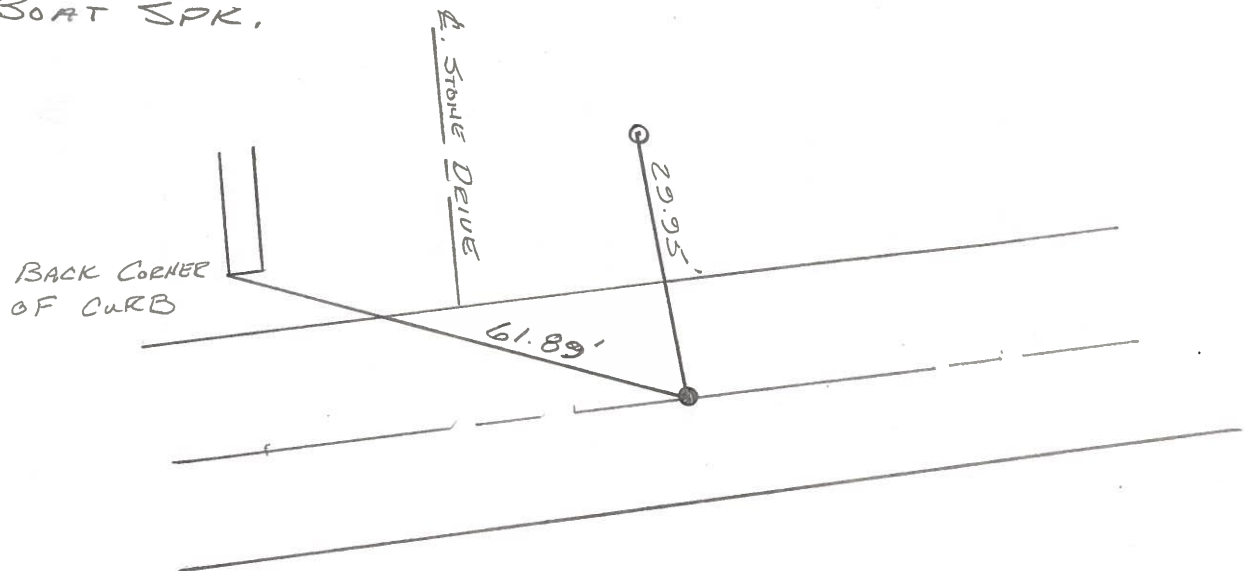

ODOT DISTRICT 2 SURVEY OFFICE

SHEET _____ OF _____

County Sandusky S.R.U.S. # 6

Township Townsend

Section 9

T 5 N, R 17 E

Personnel Cronin

Ripple


Geyman

Barbour

Date 9/24/84

Weather sunny

Temp. 82°

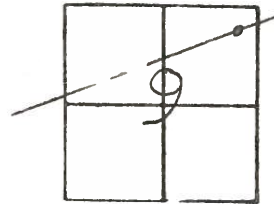

(50)

4/03/91

57°

10/03/91

RIPPLE

BARBOUR

GEYMAN

SET P.K. NAIL & WASHER

Temp 74°

1569+12

P.I. Δ = 00°33' Rt (Plan)

25+00

set P.K. & washer at top

boat spike

State of Ohio
R/W Marker

29.95

Stone drive

89

61.87

Back corner
of four

84.12

Q.D.O.T. DISTRICT 2 SURVEY OFFICE

SHEET _____ OF _____

County Sandusky S.R.U.S. # 6

Township Townsend

Section 9

T 5 N, R 17 E

Personnel Cronin

Ripple


Geyman

Barbour

Date 9/24/84

Weather sunny

Temp. 82°

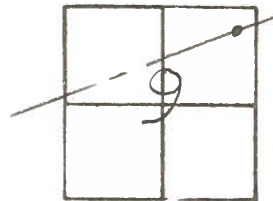

(50)

P.I. $\Delta = 00^\circ 33' \text{RT}$ (Plan)

25+00

set P.K.'s washer atop
boat spike

State of Ohio
R/W Marker

29.95

& Stone drive

61.87

Back corner
of fourb

84.12



PERSONNEL	TITLE	PERSONNEL	TITLE	COUNTY	DATE	WEATHER	TEMP.
Cronin		Schneider		Sandusky	8/4/75	sunny	78°
Ash		Mosser		S. R. #6			
Ripple		Barbour					
Geyman				SEC. H-1 - Fremont - East			

DESCRIPTION Ties for Control Points

JOB NO.

