

O.D.O.T. DISTRICT 2 SURVEY OFFICE (USE ONLY)

PERSONNEL

REFERENCE NO. 51

SHEET 26 OF 34

NOTES PRESTON-COLVIN

DATE 10/3/24

ROUTE US 6

H.C. NEISE

WEATHER SUNNY

COUNTY SANDUSKY

R.C. BARRIERE

TEMP. 74°

TOWNSHIP TOWNSEND

SECTION 3

DWG BY PRESTON-COLVIN PID PAVING TRAIN

T 5 N R 17 E

TYPE MONUMENT MEG/WASHER

ON SURFACE - ~~BELOW~~ ON

OFFSET Q PAVEMENT ON LT : RT

12.5' TO LT EDGE PAVEMENT

STATION: 1600+09

HORZ.DATUM: NAD83 (2011)


GEOID: NAVD88 2018

GRID: NORTHING: 637239.209


EASTING: 1859497.565

LDP: NORTHING: _____

EASTING: _____

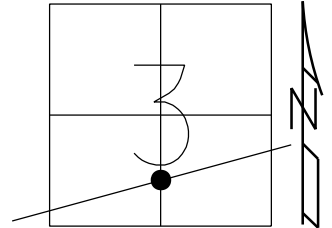

RECORD: P.I.
STA.56+00
 $\Delta = 00^\circ 10'$ LT (PLAN)
STA.1602+11.93
PREVIOUS MONUMENTS:
P.K./WASHER
SM.SQ HEADED SPIKE
SET FROM BRIDGE PLANS
FD P.K./WASHER
3/16/02, DCH
SET MAG/WASHER
9/26/02, DCH
FD PK/WASHER
REF51
3-5-14, TMR
SET MAG/WASHER
8/6/19, JLL
FD MAG/WASHER
2/10/22, JFO
1/20/23, JMR
FD MAG/WASHER
10/3/24, JAM

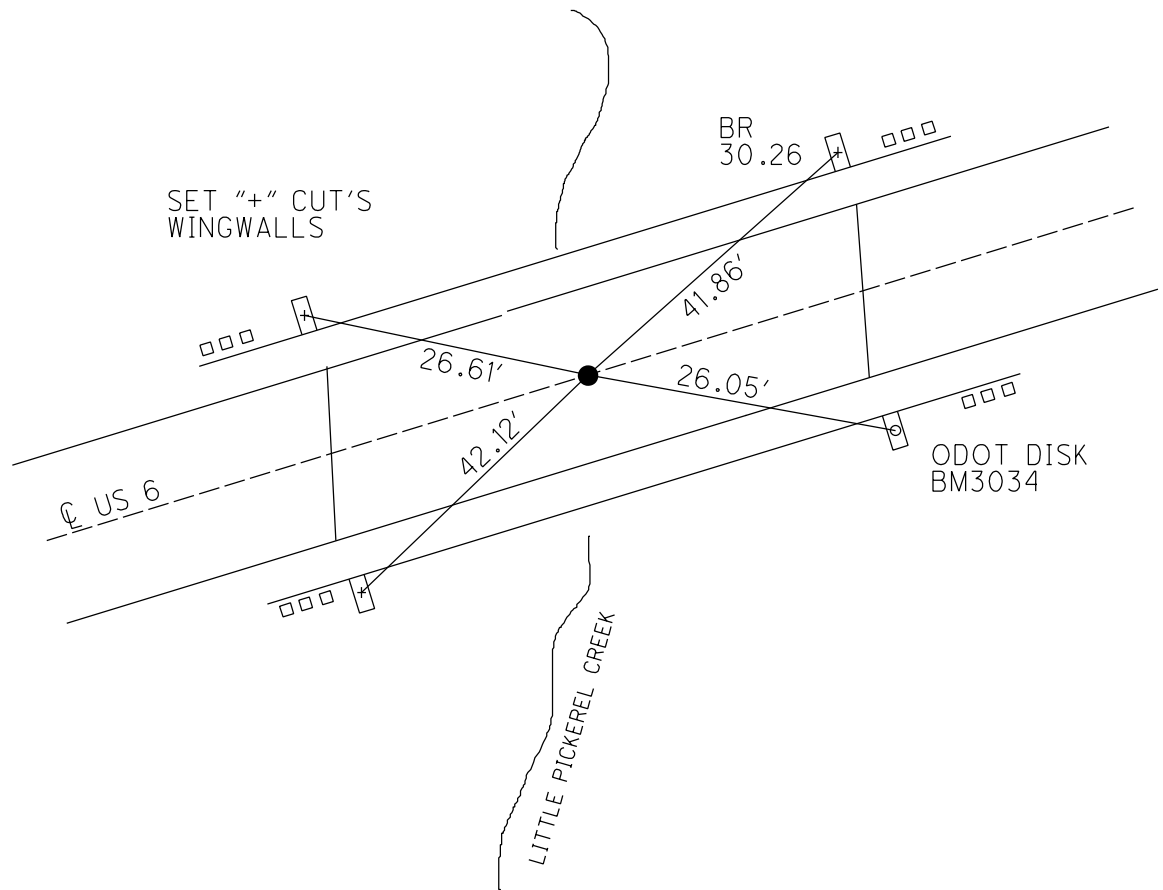

FD MAG NAIL
@ CR 294
NO INFO
LOOK INTO IT
10/3/24, JAM

O.D.O.T. DISTRICT 2 SURVEY OFFICE (USE ONLY)

PERSONNEL

REFERENCE NO. 51

SHEET 26 OF 34

NOTES LEU

DATE 8/7/18

ROUTE US 6

H.C. LEU

WEATHER CLOUDY

COUNTY SANDUSKY

R.C. HAGEMeyer

TEMP. 75°

TOWNSHIP TOWNSEND

DWG BY AUBLE

PID PAVETRAIN

SECTION 3

T 5 N R 17 E

TYPE MONUMENT MAG/WASHER

ON SURFACE - ~~BELOW~~ ON

OFFSET Q PAVEMENT ON LT : RT

12.5' TO LT EDGE PAVEMENT



STATION: 1600+09

HORIZ.DATUM: NAD83 (2011)

GEOID: 2012A

GRID: NORTHING: 638461.126

EASTING: 1862341.556

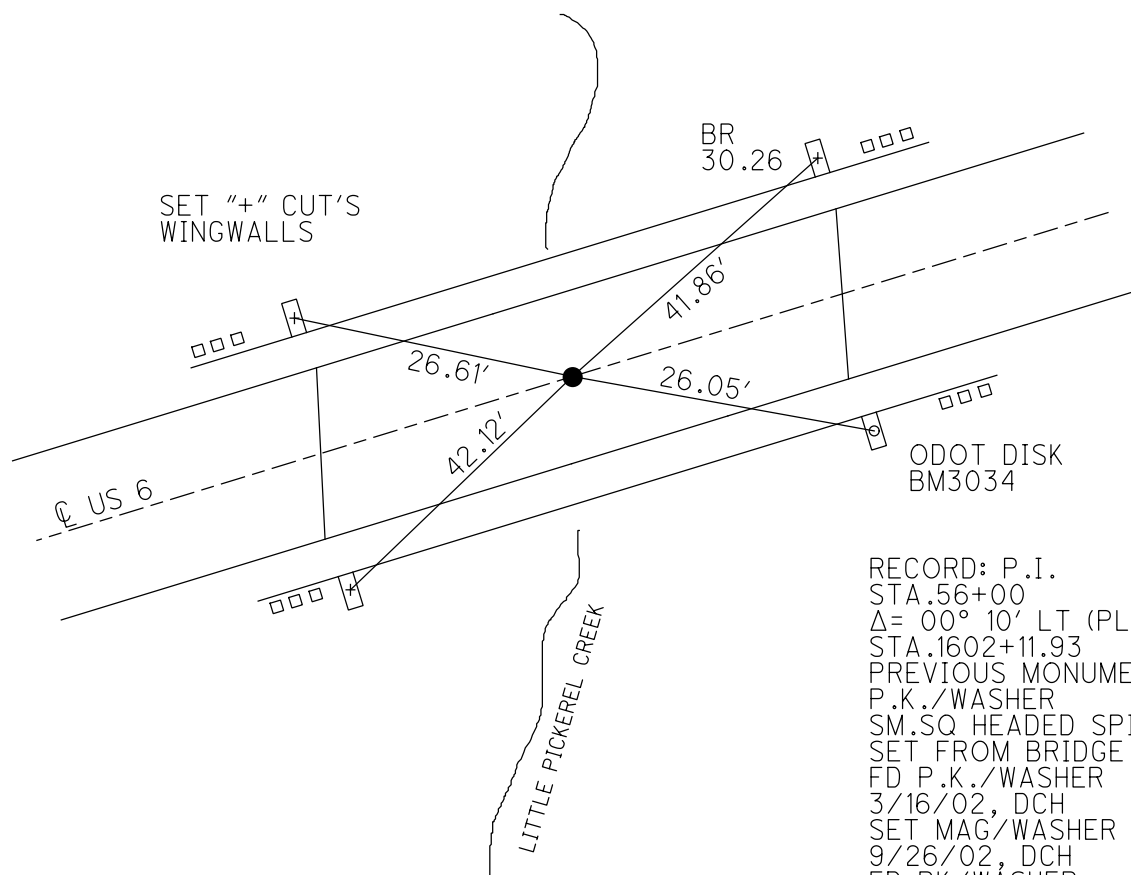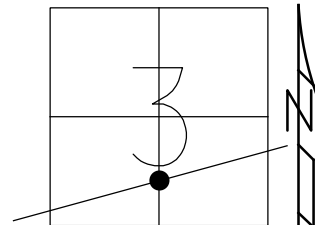

RECORD: P.I.
STA.56+00
 $\Delta = 00^\circ 10' \text{ LT (PLAN)}$
STA.1602+11.93
PREVIOUS MONUMENTS:
P.K./WASHER
SM.SQ HEADED SPIKE
SET FROM BRIDGE PLANS
FD P.K./WASHER
3/16/02, DCH
SET MAG/WASHER
9/26/02, DCH
FD PK/WASHER
REF51
3-5-14, TMR
SET MAG/WASHER
8/6/19, JLL
FD MAG/WASHER
2/10/22, JFO
1/20/23, JMR

O.D.O.T. DISTRICT 2 SURVEY OFFICE (USE ONLY)

PERSONNEL

REFERENCE NO. 51

SHEET 26 OF 34

NOTES LEU

DATE 8/7/18

ROUTE US 6

H.C. LEU

WEATHER CLOUDY

COUNTY SANDUSKY

R.C. HAGEMeyer

TEMP. 75°

TOWNSHIP TOWNSEND

DWG BY AUBLE PID 95769

SECTION 3

T 5 N R 17 E

TYPE MONUMENT MAG/WASHER

ON SURFACE - ~~BELOW~~ ON

OFFSET Q PAVEMENT ON LT : RT

12.5' TO LT EDGE PAVEMENT



STATION: 1600+09

HORZ.DATUM: NAD83 (2011)

GEOID: 2012A

GRID: NORTHING: 638461.126

EASTING: 1862341.556

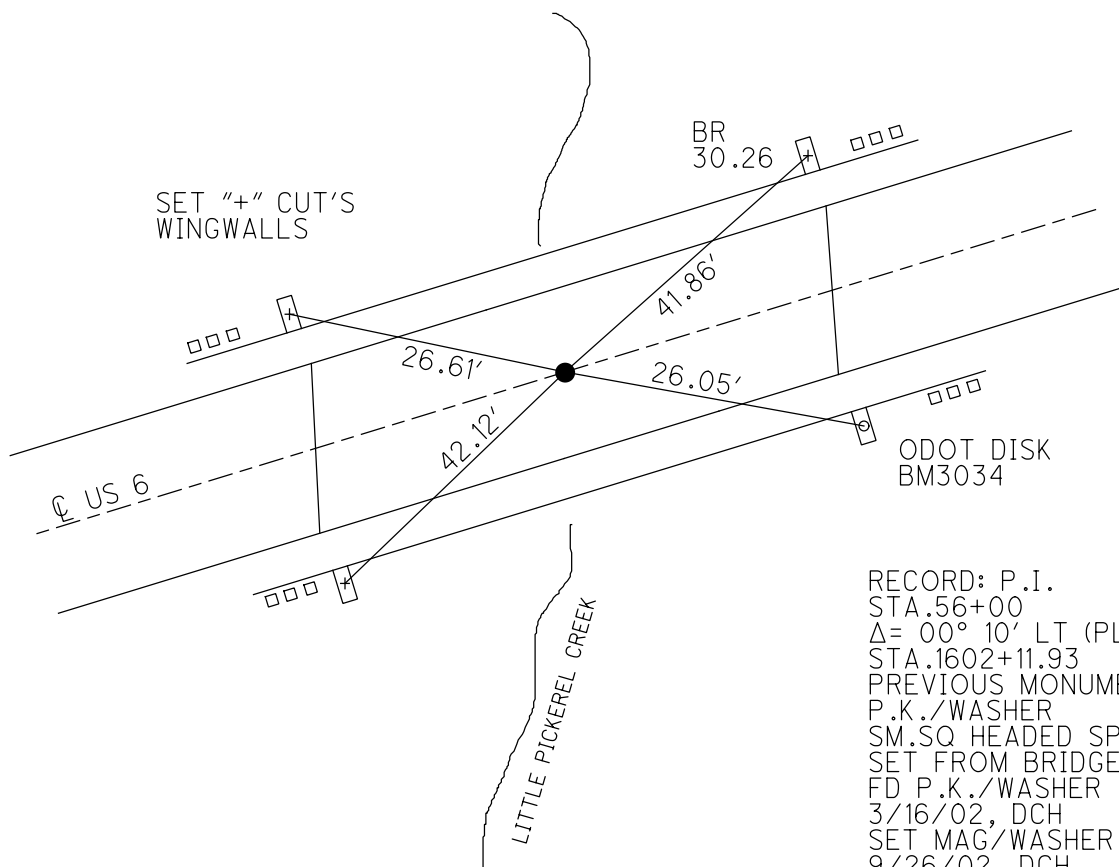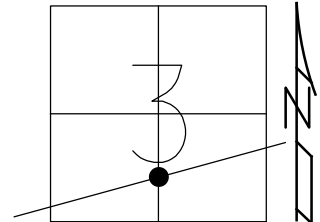

RECORD: P.I.
STA.56+00
 $\Delta = 00^\circ 10' \text{ LT (PLAN)}$
STA.1602+11.93
PREVIOUS MONUMENTS:
P.K./WASHER
SM.SQ HEADED SPIKE
SET FROM BRIDGE PLANS
FD P.K./WASHER
3/16/02, DCH
SET MAG/WASHER
9/26/02, DCH
FD PK/WASHER
REF51
3-5-14, TMR
SET MAG/WASHER
8/6/19, JLL
FD MAG/WASHER
2/10/22, JFO

O.D.O.T. DISTRICT 2 SURVEY OFFICE (USE ONLY)

PERSONNEL

REFERENCE NO. 51

SHEET 26 OF 34

NOTES LEU

DATE 8/7/18

ROUTE US 6

H.C. LEU

WEATHER CLOUDY

COUNTY SANDUSKY

R.C. HAGEMeyer

TEMP. 75°

TOWNSHIP TOWNSEND

DWG BY AUBLE

PID 95769

SECTION 3

T 5 N R 17 E

TYPE MONUMENT MAG/WASHER

ON SURFACE - ~~BELOW~~ ON

OFFSET CL PAVEMENT ON LT : RT

12.5' TO LT EDGE PAVEMENT



STATION: 1600+09

HORZ.DATUM: NAD83 (2011)

GEOID: 2012A

GRID: NORTHING: 638461.126

EASTING: 1862341.556

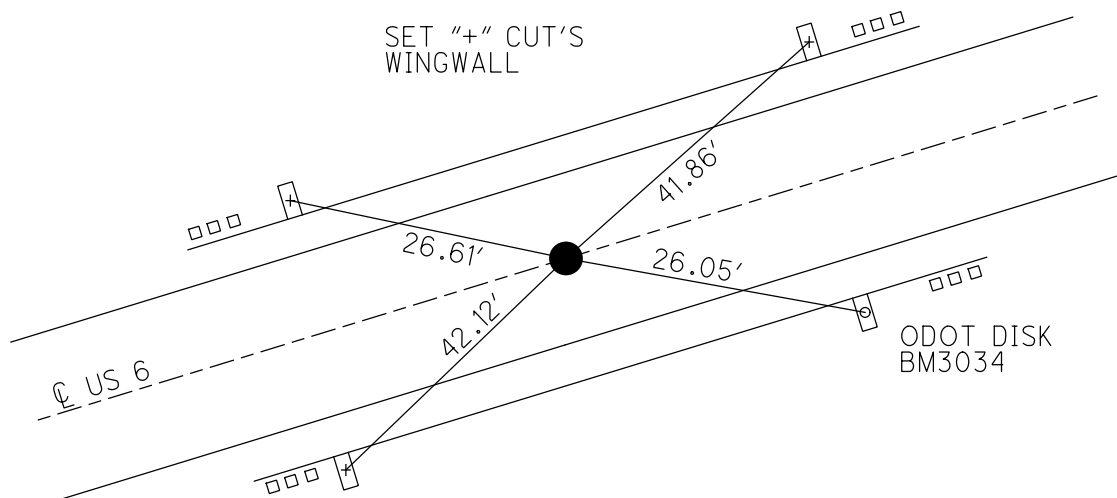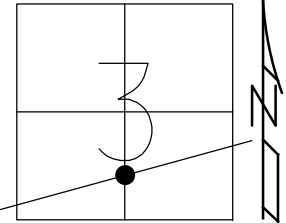

RECORD: P.I.
STA.56+00
 $\Delta = 00^\circ 10'$ LT (PLAN)
STA.1602+11.93
PREVIOUS MONUMENTS:
P.K./WASHER
SM.SQ HEADED SPIKE
SET FROM BRIDGE PLANS
FD P.K./WASHER
3/16/02, DCH
SET MAG/WASHER
9/26/02, DCH
FD PK/WASHER
REF51
3-5-14, TMR
SET MAG/WASHER
8/6/19, JLL

O.D.O.T. DISTRICT 2 SURVEY OFFICE (USE ONLY)

PERSONNEL	REFERENCE NO. <u>51</u>	SHEET <u>24</u> OF <u>31</u>	
NOTES	ROUSOS	DATE <u>03/16/02</u>	ROUTE <u>US 6</u>
H.C.	VAN DUSEN	WEATHER <u>WINDY</u>	COUNTY <u>SANDUSKY</u>
R.C.	MOSSER	TEMP. <u>28°</u>	TOWNSHIP <u>TOWNSEND</u>
	HOMAN		SECTION <u>3</u>
			T <u>5</u> N R <u>17</u> E

TYPE MONUMENT PK/WASHER



ON SURFACE - ~~BELOW~~ ON

~~LEFT~~ - Q PAV'T - ~~RIGHT~~ ON

12.5' TO LT EDGE PAVEMENT

S.L.M. 1602+11.95

GRID: NORTHING: 638461.126 EASTING: 1862341.557

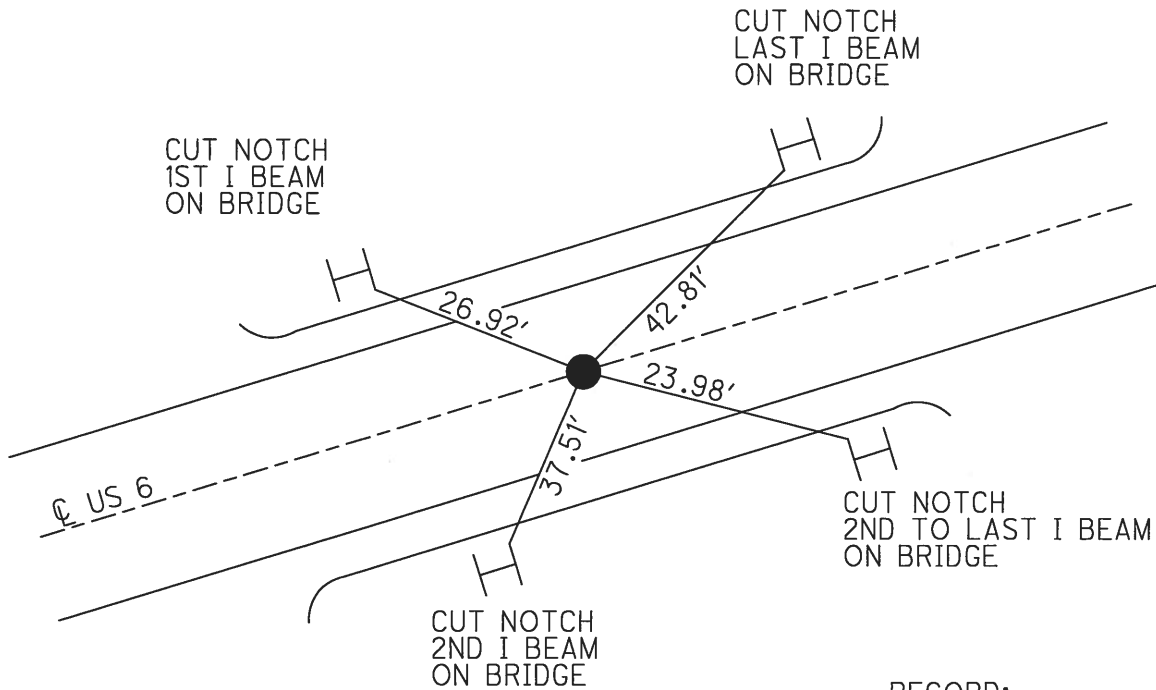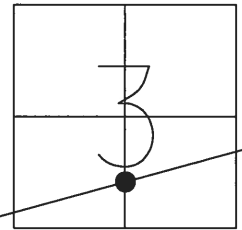

RECORD:
 PI (56+00)
 $\Delta = 00^\circ 10'$ LT (PLAN)
 OLD STA 1602+11.93
 PK/WASHER
 SM SQ HEADED SPK SET
 FROM BRIDGE PLANS
 SET MAG/WASHER
 9/26/02, DCH
 FD PK/WASHER
 REF51
 3-5-14, TMR

O.D.O.T. DISTRICT 2 SURVEY OFFICE (USE ONLY)

PERSONNEL

REFERENCE NO. 51

SHEET 24 OF 31

NOTES

ROUSOS

DATE

03/16/02

ROUTE

US 6

H.C.

VAN DUSEN

WEATHER

WINDY

COUNTY

SANDUSKY

R.C.

MOSSER

TEMP.

28°

TOWNSHIP

TOWNSEND

HOMAN

SECTION

3

T 5 N R 17 E

TYPE MONUMENT

PK/WASHER

ON SURFACE - ~~BELOW~~

ON

~~LEFT~~ - Q PAV'T - ~~RIGHT~~

ON

12.5' TO LT EDGE PAVEMENT

S.L.M.



1600+09

GRID: NORTHING:

-

EASTING:

-

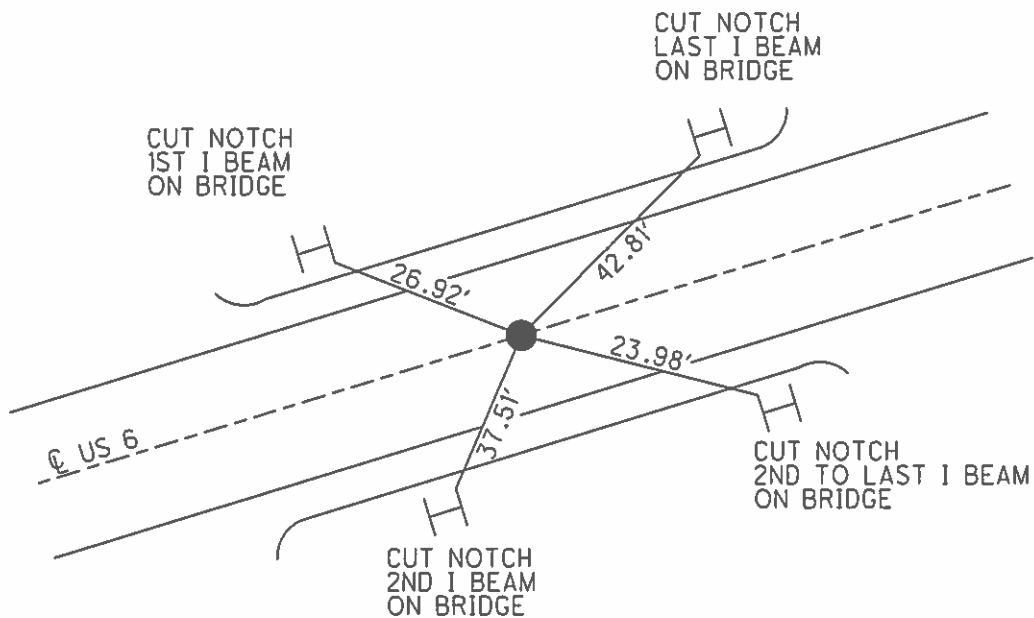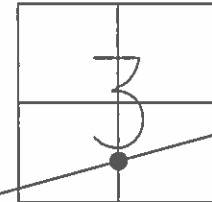

RECORD: P1
(56+00)

$\Delta = 00^\circ 10'$ LT (PLAN)

OLD STA 1602+11.93

PREVIOUS MONUMENTS

PK/WASHER

SM SQ HEADED SPK SET

FROM BRIDGE PLANS

SET MAG/WASHER

09/26/02 DCH

O.D.O.T. DISTRICT 2 SURVEY OFFICE

PERSONNEL

NOTES ROUSOS
H.C. VAN DUSEN
R.C. MOSSER
HOMAN

REFERENCE NO. 51

DATE 3-16-02

WEATHER WINDY

TEMP. 28°

SHEET 20 OF 27

ROUTE SR 6

COUNTY Sandusky

TOWNSHIP Townsend

SECTION 3

T5 N R17 E


TYPE MONUMENT PK/Washer

ON SURFACE - ~~BELOW~~ On Surface

~~LEFT - & PAV'T - RIGHT~~


12.5' TO LT EDGE PAVEMENT

S.L.M. 1600+09

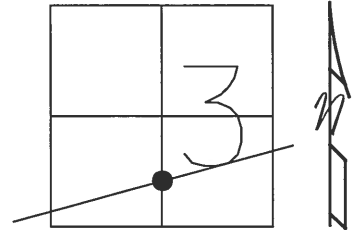

P.I. (56+00)
 $\Delta = 00^{\circ} 10'$ LT (PLAN)
Old STA 1602+11.93
Previous Monuments
PK/Washer
Sm Sq headed Spk Set
From Bridge Plans

Set Mag Nail & Washer
9-26-02
DCH

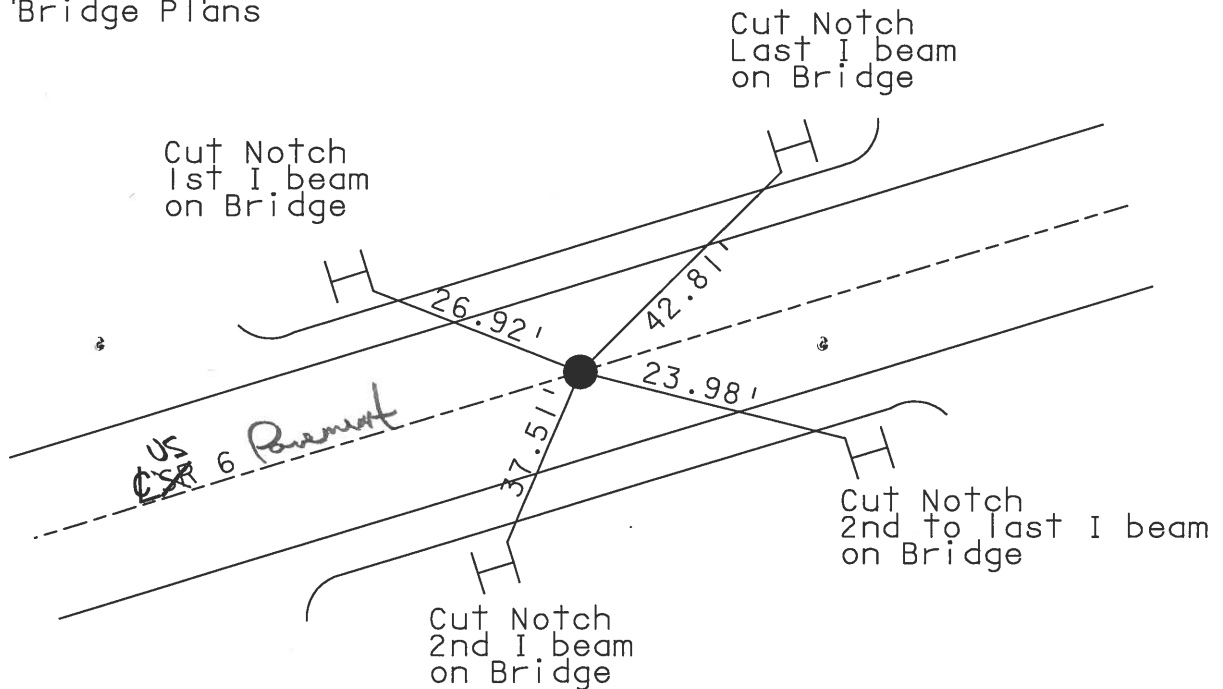

O.D.O.T. DISTRICT 2 SURVEY OFFICE

PERSONNEL

REFERENCE NO. 51

SHEET 32 OF 39

NOTES PIDPLE

H.C. BARBOUR

DATE 10-3-1991

ROUTE 6

R.C. GEYMAN

WEATHER —

COUNTY SANDUSKY

TEMP. 74°

TOWNSHIP TOWNSEND

SECTION 3

T 5 N R 17 E


TYPE MONUMENT PK/WASHER

ON SURFACE - BELOW

LEFT - ℄ PAV'T. - RIGHT —

— TO — EDGE PAVEMENT

S.L.M. 1600+09

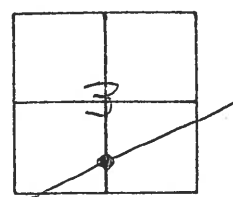

P.I. (56+00)


$\Delta = 00^{\circ} 10'$ LT. (PLAN)

OLD STA. 1602+11.93

PREVIOUS MONUMENTS

① PK/WASHER

② SM. SQ. HEADED SPK. SET FROM BRIDGE PLANS.

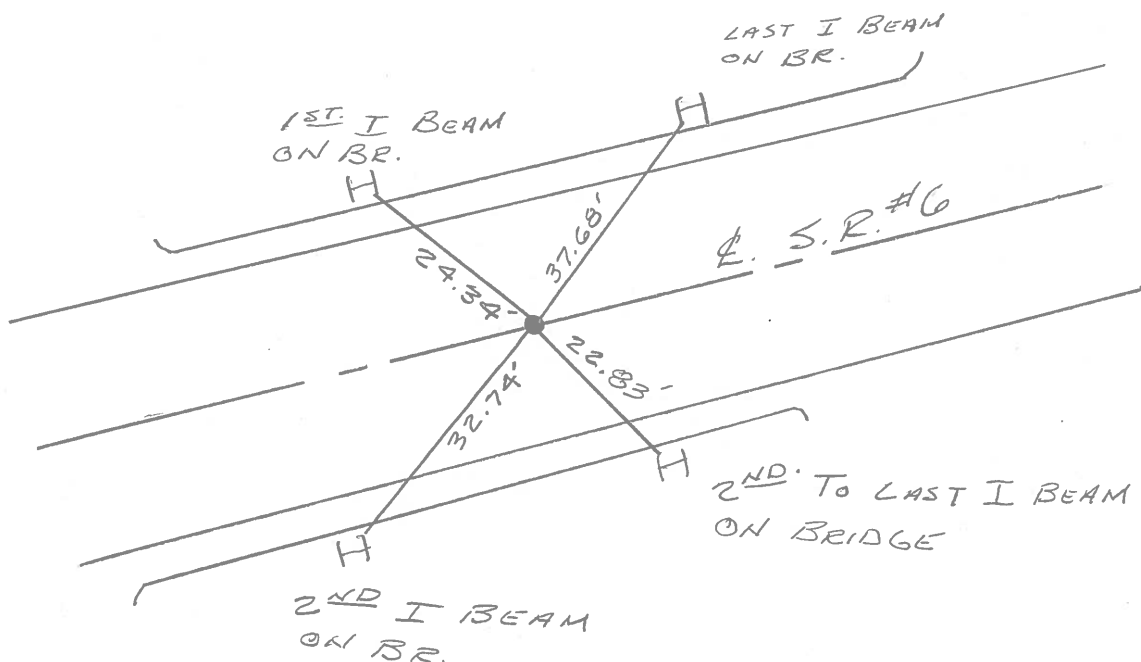

Q.D.O.T. DISTRICT 2 SURVEY OFFICE

SHEET _____ OF _____

County Sandusky S.R. #6

Township Townsend

Section 3

T5N, R7E

Personnel Cronin

Ripple


Geyman

Barbour

Date 8/14/84

Weather sunny

Temp. 80°

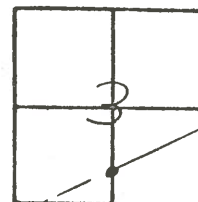

(51)

4/03/91

1600+09

P.I. A = 00°10' LT (Pka)

1602+11.93 56+00

Set small 59' headed spike
from bridge plans - Set P.K. &
washer 9/26/84

Knocked out
By Life Lite

10/03/91


RIPPLE

BARBOUR

GEYMAN

Reset P.K. Nail & Washer

Temp. 74°

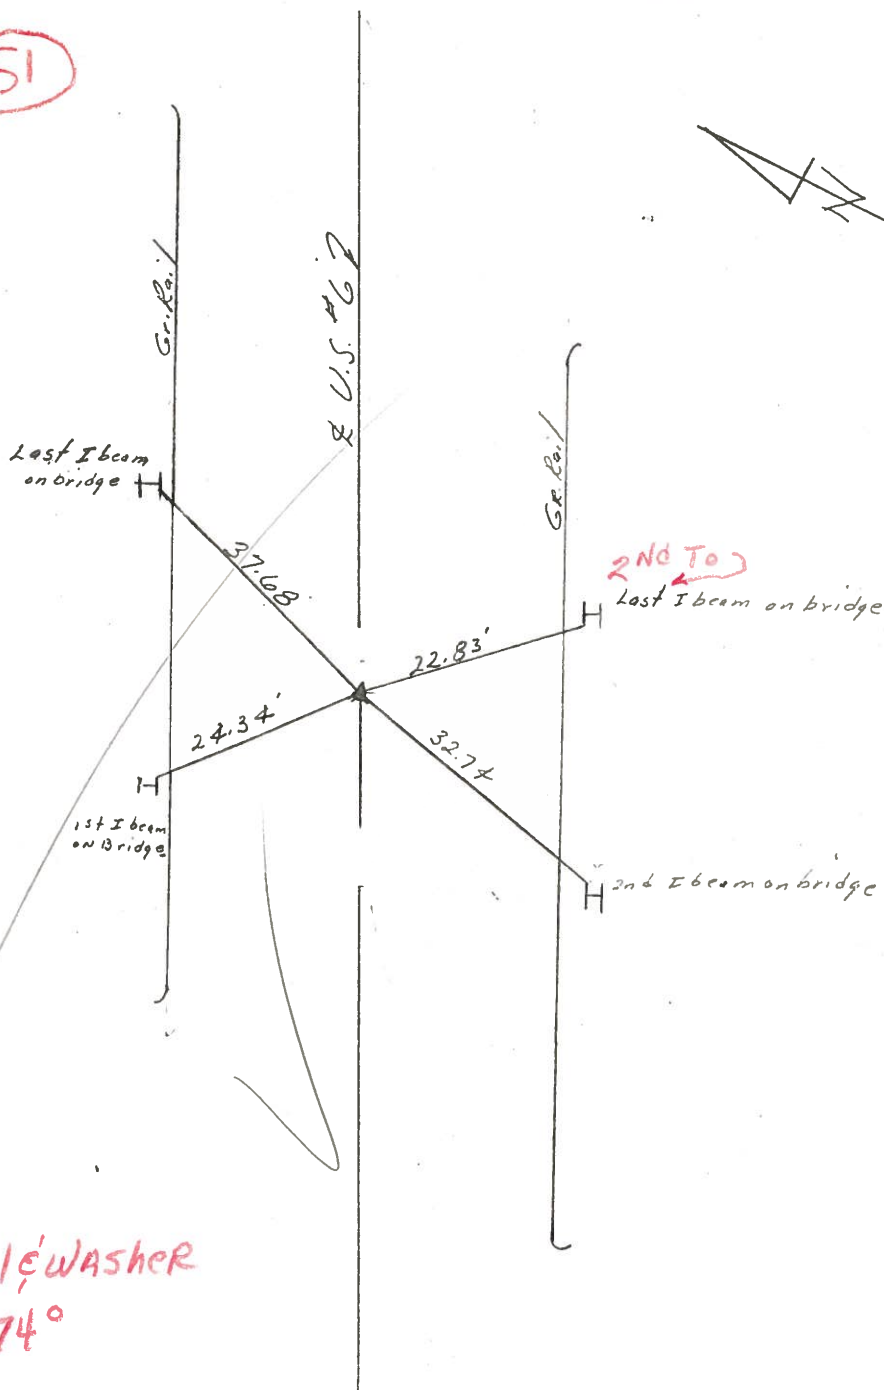

Q.D.O.T. DISTRICT 2 SURVEY OFFICE

SHEET _____ OF _____

County Sandusky S.R. #6

Township Townsend

Section 3

T5N, R17E

Personnel Cronin

Ripple

Geyman


Barbour

51

Date 8/14/84

Weather sunny

Temp. 80°

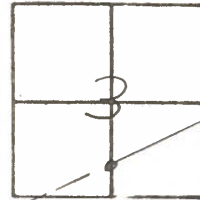


STA 56+00

P.I. Δ = 00°10' Lt (Plan)

1602+11.93

Set small sq headed spike
from bridge plans - Set P.R. &
washer 9/26/84

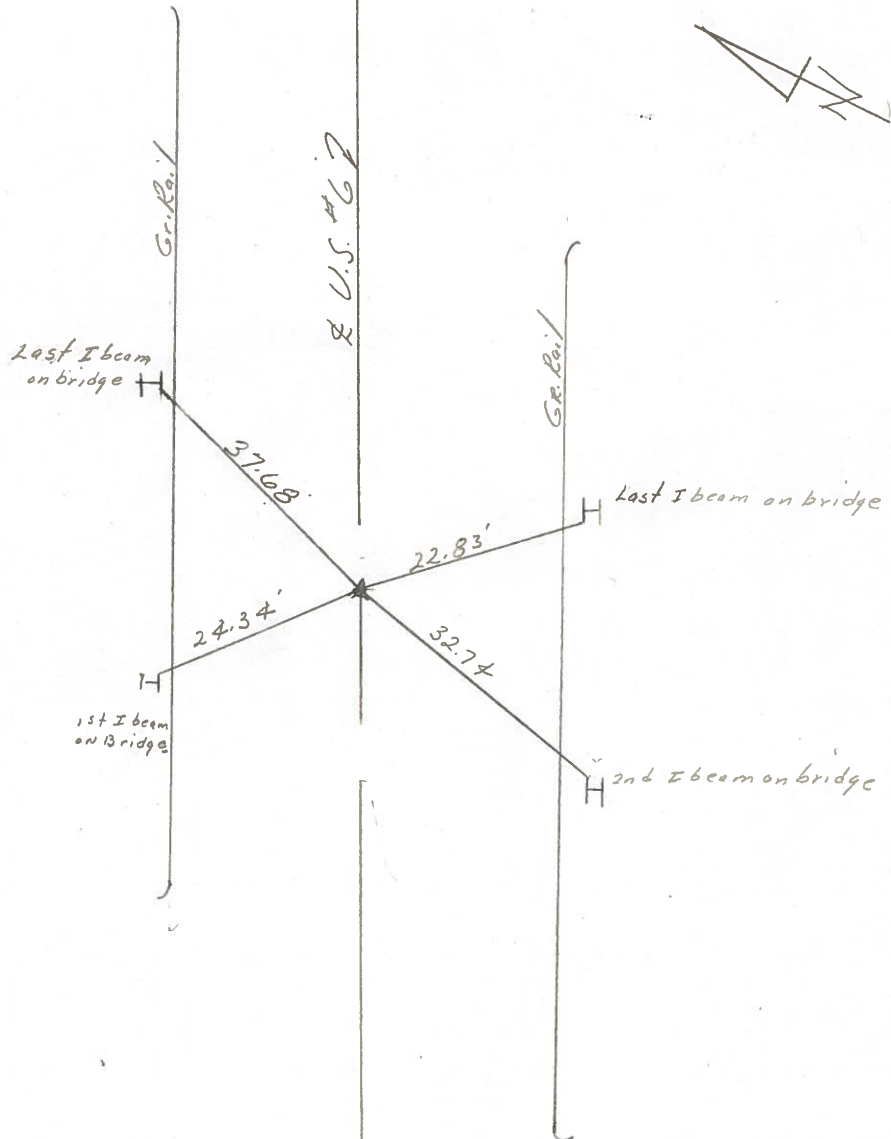

PERSONNEL TITLE PERSONNEL TITLE

Cronin

Schneider

COUNTY Sandusky

DATE drawn 8/4/75

Ash

Mosses

S. R. #6

WEATHER sunny

Ripple

Barbour

SEC. H-1 - Fremont - East

TEMP. 78°

DESCRIPTION Ties for Control Points

JOB NO.

LEFT

CENTER LINE

RIGHT

Townsend Twp

Sec 3

51

 $\Delta = 00^\circ 10' 21''$ (Plan)

P.I.

56+00 @ 88.30.34

Ed small spike

E washer on surface

conc.

R/Lw Marker

29.89'

39.51'

29.93'

Plumbed

conc. R/Lw Marker

37.63'

Sec 3

Sec. 9

55.46'

 $\Delta = 00^\circ 33' 21''$ (Plan)

P.I.

25+00

set small spike

conc.

R/Lw Marker

29.96'

Plumbed

115.81'

Plumbed

84.10'

2 story
frame
res.

Sec. 9

PERSONNEL	TITLE	PERSONNEL	TITLE
<u>Schneider</u>		<u>Potts</u>	
<u>Mosser</u>			
<u>Barbour</u>			
<u>Redding</u>			

COUNTY Sandusky DATE Dec-196
 S. R. U. S. # 6 WEATHER _____
 SEC. Fremont-East TEMP. _____

DESCRIPTION Ties for Control Points JOB NO. _____

