

O.D.O.T. DISTRICT 2 SURVEY OFFICE (USE ONLY)

PERSONNEL

REFERENCE NO. 51 AA

SHEET 27 OF 34

NOTES PRESTON-COLVIN

DATE 10/3/24

ROUTE US 6

H.C. NEISE

WEATHER SUNNY

COUNTY SANDUSKY

R.C. BARRIERE

TEMP. 77°

TOWNSHIP TOWNSEND

DWG BY PRESTON-COLVIN

PID PAVING TRAIN

SECTION 3

T 5 N R 17 E

TYPE MONUMENT MEG/WASHER

ON SURFACE - ~~BELOW~~ ON

OFFSET ¢ PAVEMENT 0.4' LT : ~~RT~~

- TO - EDGE PAVEMENT

STATION: 1614+19

HORZ.DATUM: NAD83 (2011)


GEOID: NAVD88 2018

GRID: NORTHING: 639024.160


EASTING: 1863641.387

LDP: NORTHING: 335452.7

EASTING: 223744.1

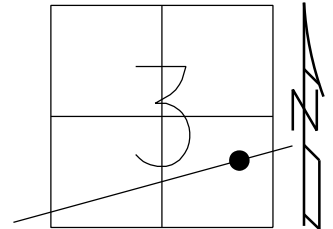

RECORD:
FD P.K.NAIL
REFAA51
8/8/18, JLL
SET MAG/WASHER
8-5-19, JLL
FD MAG/WASHER
2/10/22, JFO
1/20/23, JMR
FD MAG/WASHER
REF51AA
9/5/24, TDN
FD MAG/WASHER
10/3/24, JAM

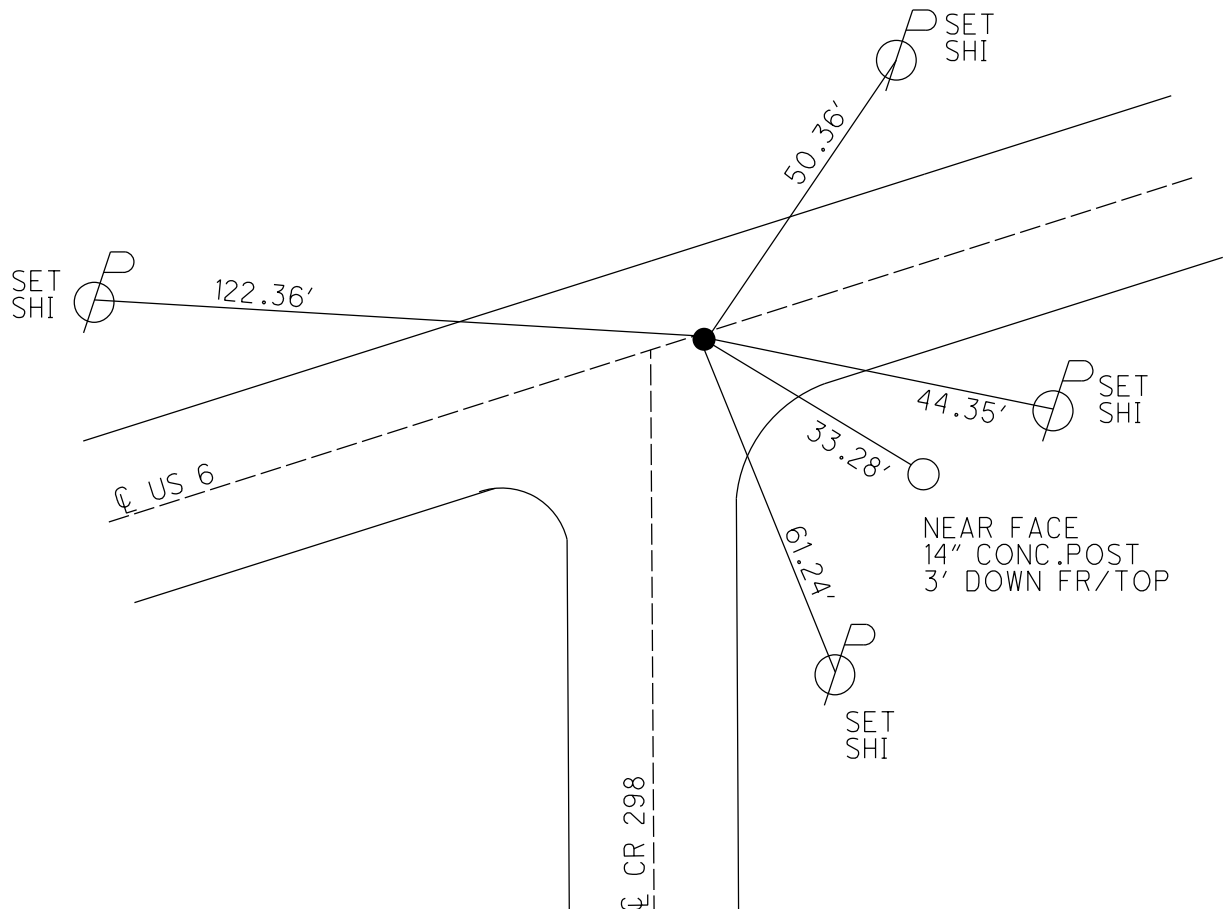

O.D.O.T. DISTRICT 2 SURVEY OFFICE (USE ONLY)

PERSONNEL

REFERENCE NO. 51 AA

SHEET 27 OF 34

NOTES LEU

DATE 8/8/18

ROUTE US 6

H.C. LEU

WEATHER CLOUDY

COUNTY SANDUSKY

R.C. HAGEMEYER

TEMP. 75°

TOWNSHIP TOWNSEND

DWG BY AUBLE

PID PAVETRAIN

SECTION 3

T 5 N R 17 E

TYPE MONUMENT MAG/WASHER

ON SURFACE - ~~BELOW~~ ON

OFFSET ℄ PAVEMENT 0.4' LT : ~~RT~~

- TO - EDGE PAVEMENT 4' E. ℄ S.


STATION: 1614+19 ±

HORIZ.DATUM: NAD83 (2011)


GEOID: 2012A

GRID: NORTHING: 639024.160

EASTING: 1863641.387

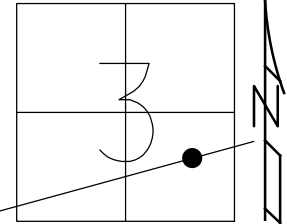

RECORD:
FD P.K.NAIL
REFAA51
8/8/18, JLL
SET MAG/WASHER
8-5-19, JLL
FD MAG/WASHER
2/10/22, JFO
1/20/23, JMR

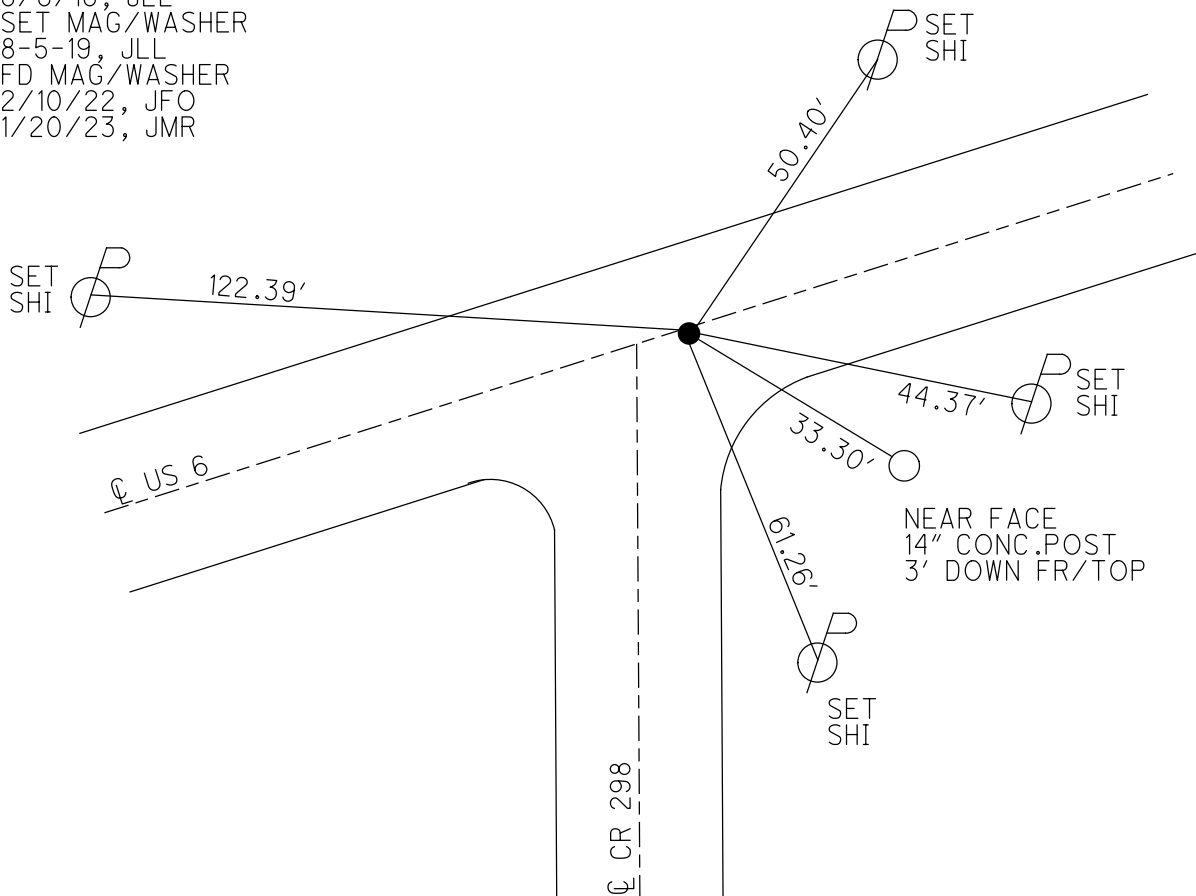

O.D.O.T. DISTRICT 2 SURVEY OFFICE (USE ONLY)

PERSONNEL

REFERENCE NO. 51 AA

SHEET 27 OF 34

NOTES LEU

DATE 8/8/18

ROUTE US 6

H.C. LEU

WEATHER CLOUDY

COUNTY SANDUSKY

R.C. HAGEMeyer

TEMP. 75°

TOWNSHIP TOWNSEND

DWG BY AUBLE

PID 95769

SECTION 3

T 5 N R 17 E

TYPE MONUMENT MAG/WASHER

ON SURFACE - ~~BELOW~~ ON

OFFSET Q PAVEMENT 0.4' LT : ~~RT~~

- TO - EDGE PAVEMENT 4' E. Q S.


STATION: 1614+19 ±

HORIZ.DATUM: NAD83 (2011)


GEOID: 2012A

GRID: NORTHING: 639024.160

EASTING: 1863641.387

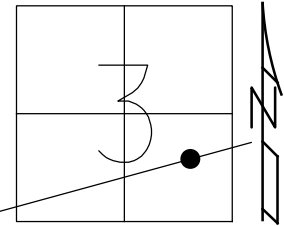

RECORD:
FD P.K.NAIL
REFAA51
8/8/18, JLL
SET MAG/WASHER
8-5-19, JLL
FD MAG/WASHER
2/10/22, JFO

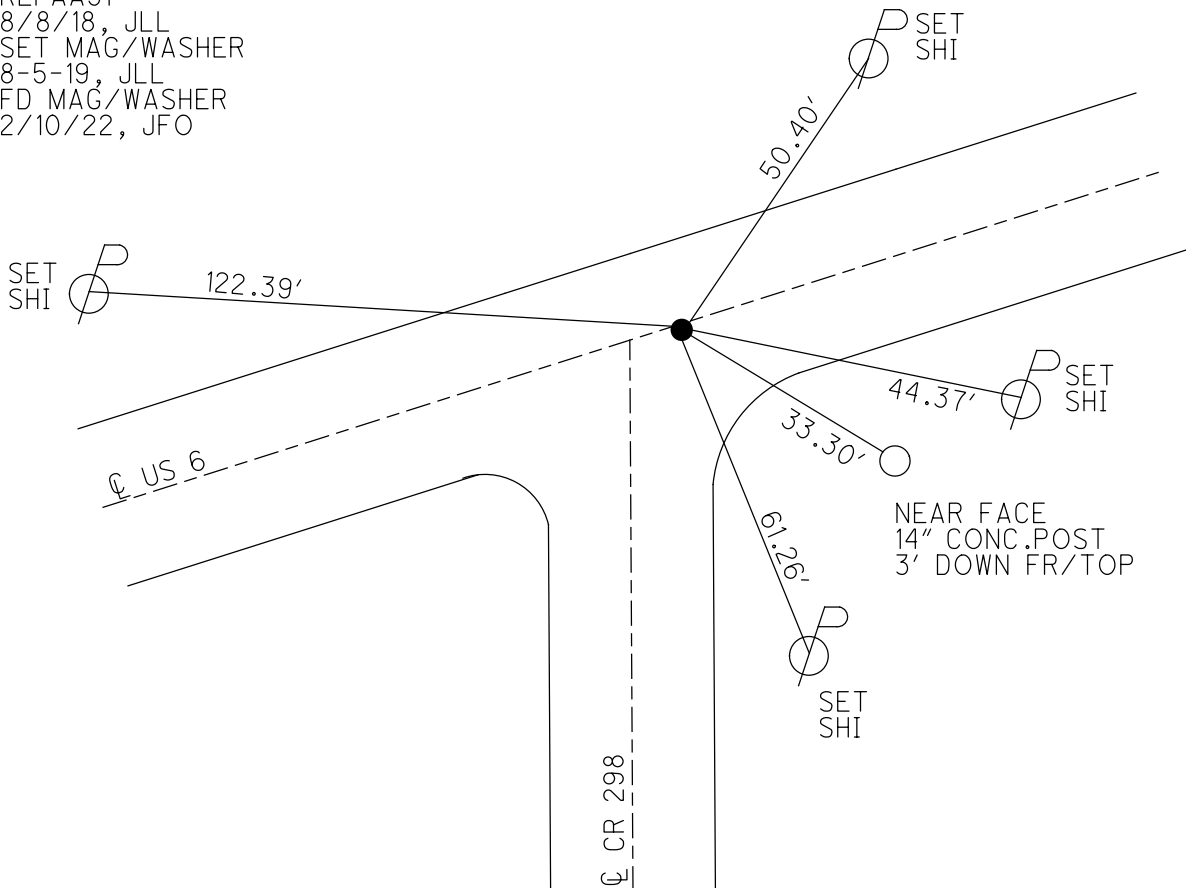

O.D.O.T. DISTRICT 2 SURVEY OFFICE (USE ONLY)

PERSONNEL

REFERENCE NO. 51 AA

SHEET 27 OF 34

NOTES LEU

DATE 8/8/18

ROUTE US 6

H.C. LEU

WEATHER CLOUDY

COUNTY SANDUSKY

R.C. HAGEMEYER

TEMP. 75°

TOWNSHIP TOWNSEND

DWG BY AUBLE

PID 95769

SECTION 3

T 5 N R 17 E

TYPE MONUMENT MAG/WASHER

ON SURFACE - ~~BELOW~~ ON

OFFSET 0.4' LT : RT

- TO - EDGE PAVEMENT 4' E. & S.


STATION: 1614+19 ±

HORZ.DATUM: NAD83 (2011)

GEOID: 2012A

GRID: NORTHING: 639024.160

EASTING: 1863641.387

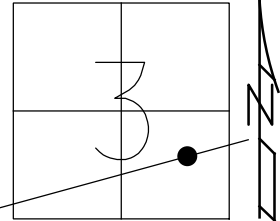

RECORD:
FD P.K.NAIL
REFAA51
8/8/18, JLL
SET MAG/WASHER
8-5-19, JLL

