

O.D.O.T. DISTRICT 2 SURVEY OFFICE (USE ONLY)

PERSONNEL

REFERENCE NO. 51 A

SHEET 28 OF 34

NOTES PRESTON-COLVIN

DATE 9/5/24

ROUTE US 6

H.C. NEISE

WEATHER SUNNY

COUNTY SANDUSKY

R.C. BARRIERE

TEMP. 80°

TOWNSHIP TOWNSEND

SECTION 2

DWG BY PRESTON-COLVIN PID PAVING TRAIN

T 5 N R 17 E

TYPE MONUMENT MEG/WASHER

ON SURFACE - ~~BELOW~~ ON

OFFSET ¢ PAVEMENT 0.5' ~~LT~~ : RT

13' TO LT EDGE PAVEMENT

STATION: 1629+81

HORZ.DATUM: NAD83 (2011)


GEOID: NAVD88 2018

GRID: NORTHING: 639640.754


EASTING: 1865066.673

LDP: NORTHING: 336079.2

EASTING: 225165.2

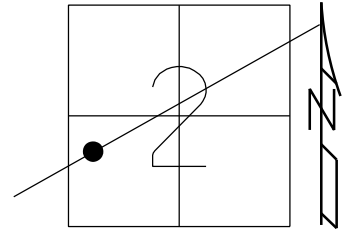

RECORD: P.I.
Δ= 00° 09' LT (PLAN)
STA.85+63.80
PREVIOUS MONUMENTS:
P.K./WASHER
BOAT SPIKE/WASHER
FD P.K./WASHER
3/16/02, DCH
SET MAG/WASHER
9/26/02 DCH
FD PK/WASHER
REFA51
3-5-14, TMR
FD MAG/WASHER
REFA51
11/23/17, DCH
SET MAG/WASHER
8-5-19, JLL
FD MAG/WASHER
2/10/22, JFO
1/20/23, JMR
FD MAG/WASHER
REF 51A
9/5/24, TDN
FD MAG/WASHER
10/3/24, JAM

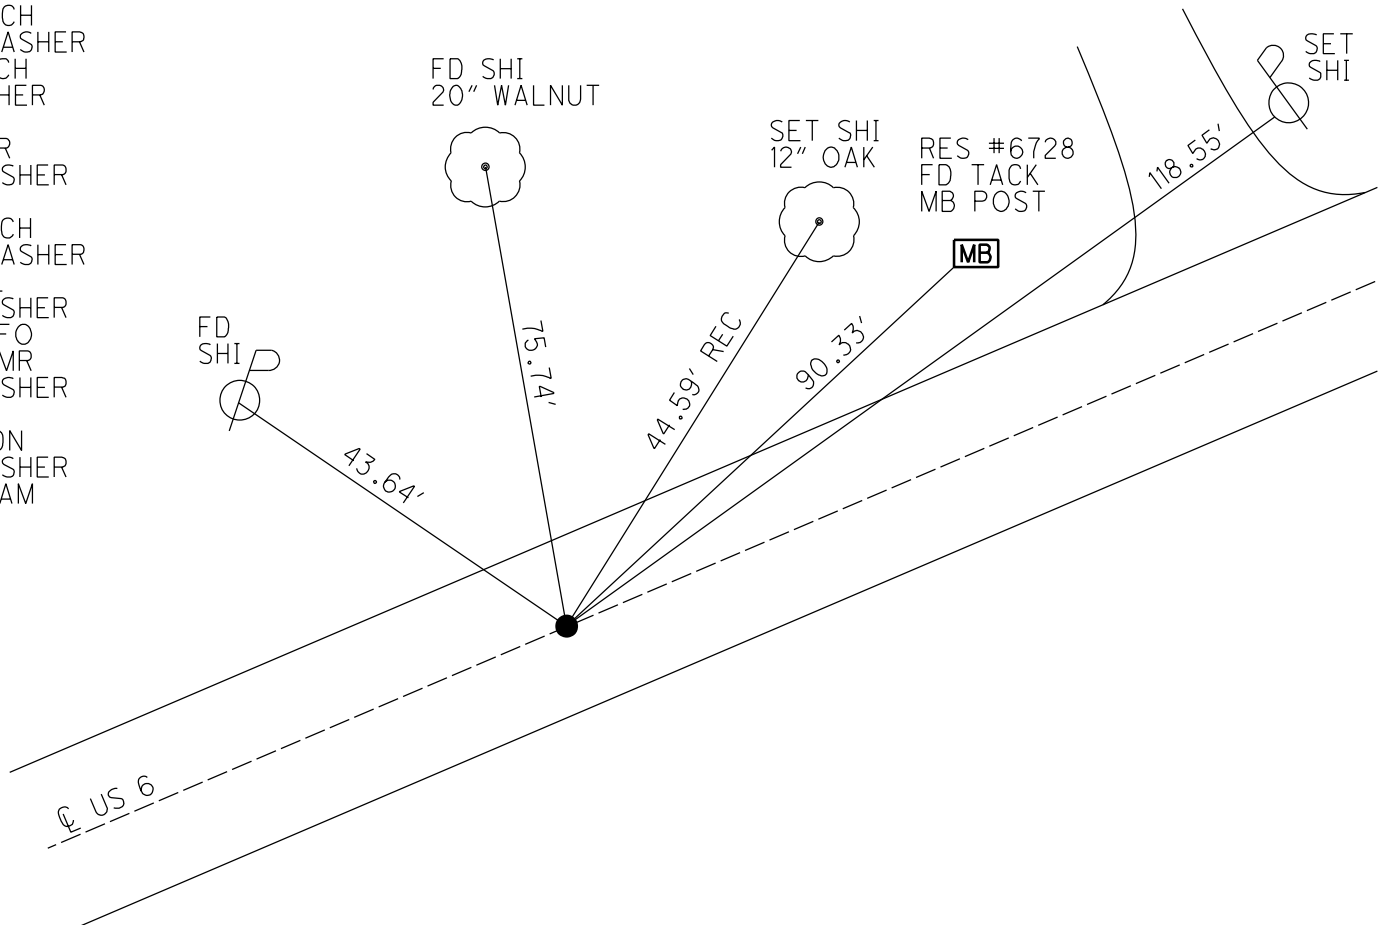

O.D.O.T. DISTRICT 2 SURVEY OFFICE (USE ONLY)

PERSONNEL

REFERENCE NO. 51 A

SHEET 28 OF 34

NOTES LEU

DATE 8/8/18

ROUTE US 6

H.C. LEU

WEATHER CLOUDY

COUNTY SANDUSKY

R.C. HAGEMEYER

TEMP. 75°

TOWNSHIP TOWNSEND

DWG BY AUBLE

PID PAVETRAIN

SECTION 2

T 5 N R 17 E

TYPE MONUMENT MAG/WASHER

ON SURFACE - ~~BELOW~~ ON

OFFSET Q PAVEMENT 0.5' LT : RT

13' TO LT EDGE PAVEMENT


STATION: 1629+81

HORIZ.DATUM: NAD83 (2011)

GEOID: 2012A

GRID: NORTHING: 639640.754

EASTING: 1865066.673

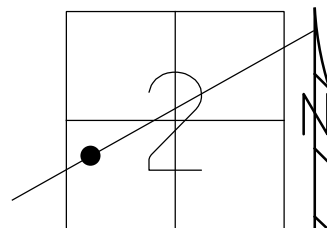

RECORD: P.I.

$\Delta = 00^\circ 09' \text{ LT (PLAN)}$

STA.85+63.80

PREVIOUS MONUMENTS:

P.K./WASHER

BOAT SPIKE/WASHER

FD P.K./WASHER

3/16/02, DCH

SET MAG/WASHER

9/26/02 DCH

FD PK/WASHER

REFA51

3-5-14, TMR

FD MAG/WASHER

REFA51

11/23/17, DCH


SET MAG/WASHER

8-5-19, JLL

FD MAG/WASHER

2/10/22, JFO

1/20/23, JMR

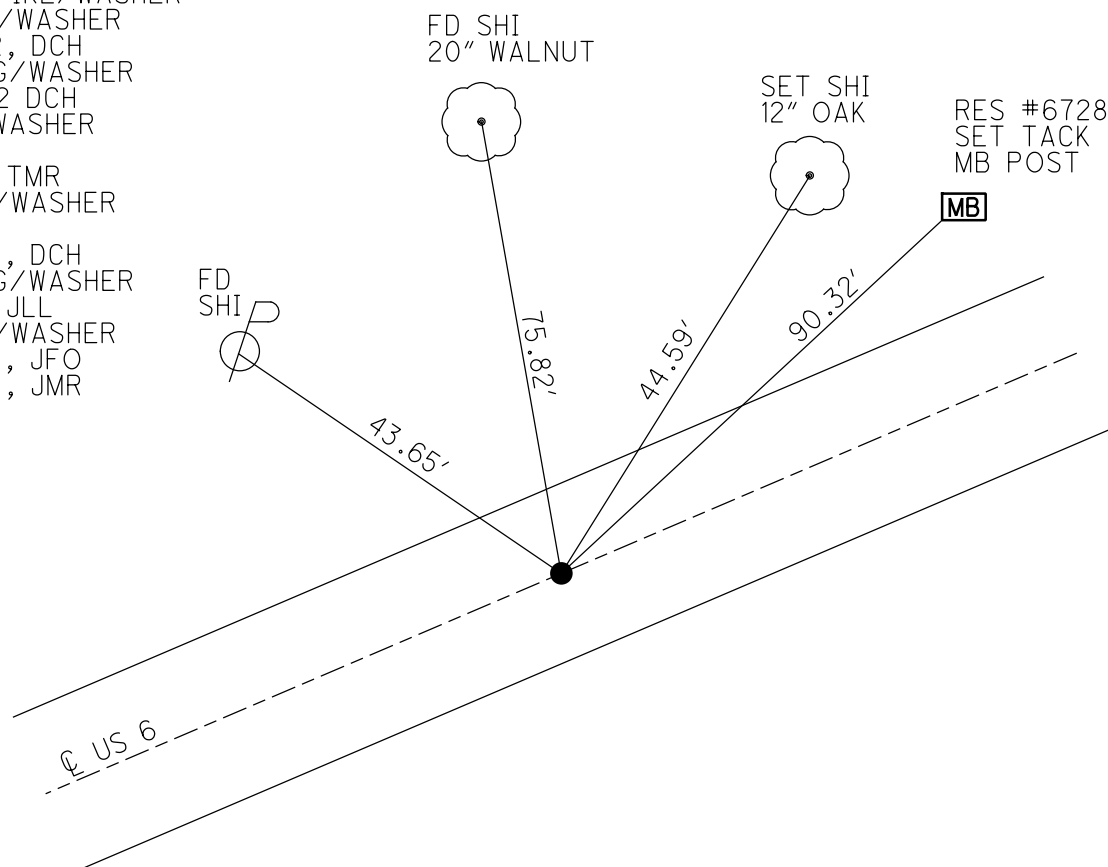

O.D.O.T. DISTRICT 2 SURVEY OFFICE (USE ONLY)

PERSONNEL

REFERENCE NO. 51 A

SHEET 28 OF 34

NOTES LEU

DATE 8/8/18

ROUTE US 6

H.C. LEU

WEATHER CLOUDY

COUNTY SANDUSKY

R.C. HAGEMeyer

TEMP. 75°

TOWNSHIP TOWNSEND

DWG BY AUBLE

PID 95769

SECTION 2

T 5 N R 17 E

TYPE MONUMENT MAG/WASHER

ON SURFACE - ~~BELOW~~ ON

OFFSET 13' Q PAVEMENT 0.5' LT : RT

13' TO LT EDGE PAVEMENT


STATION: 1629+81

HORIZ.DATUM: NAD83 (2011)

GEOID: 2012A

GRID: NORTHING: 639640.754

EASTING: 1865066.673

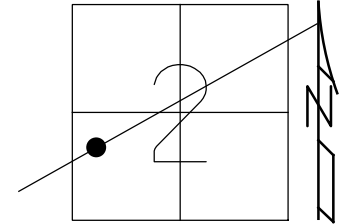

RECORD: P.I.

$\Delta = 00^{\circ} 09' \text{ LT (PLAN)}$

STA.85+63.80

PREVIOUS MONUMENTS:

P.K./WASHER

BOAT SPIKE/WASHER

FD P.K./WASHER

3/16/02, DCH

SET MAG/WASHER

9/26/02 DCH

FD PK/WASHER

REFA51

3-5-14, TMR

FD MAG/WASHER

REFA51


11/23/17, DCH

SET MAG/WASHER

8-5-19, JLL

FD MAG/WASHER

2/10/22, JFO

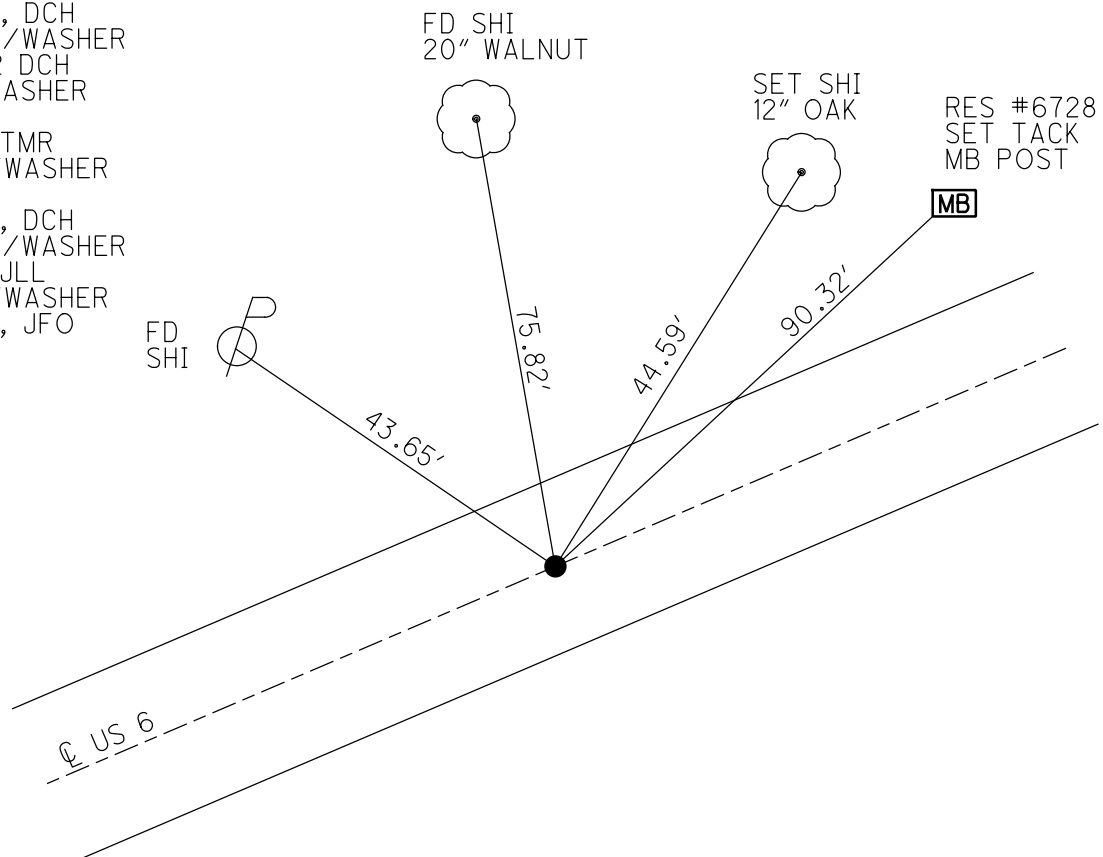

O.D.O.T. DISTRICT 2 SURVEY OFFICE (USE ONLY)

PERSONNEL

REFERENCE NO. 51 A

SHEET 28 OF 34

NOTES LEU

DATE 8/8/18

ROUTE US 6

H.C. LEU

WEATHER CLOUDY

COUNTY SANDUSKY

R.C. HAGEMEYER

TEMP. 75°

TOWNSHIP TOWNSEND

DWG BY AUBLE PID 95769

SECTION 2

T 5 N R 17 E

TYPE MONUMENT MAG/WASHER

ON SURFACE - ~~BELOW~~ ON

OFFSET Q PAVEMENT 0.5' LT : RT

13' TO LT EDGE PAVEMENT


STATION: 1629+81

HORZ.DATUM: NAD83 (2011)


GEOID: 2012A

GRID: NORTHING: 639640.754

EASTING: 1865066.673

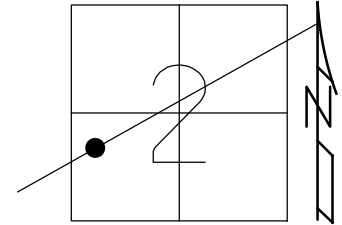


RECORD: P.I.
 $\Delta = 00^{\circ} 09' \text{ LT (PLAN)}$
STA.85+63.80
PREVIOUS MONUMENTS:
P.K./WASHER
BOAT SPIKE/WASHER
FD P.K./WASHER
3/16/02, DCH
SET MAG/WASHER
9/26/02 DCH
FD PK/WASHER
REFA51
3-5-14, TMR
FD MAG/WASHER
REFA51
11/23/17, DCH
SET MAG/WASHER
8-5-19, JLL

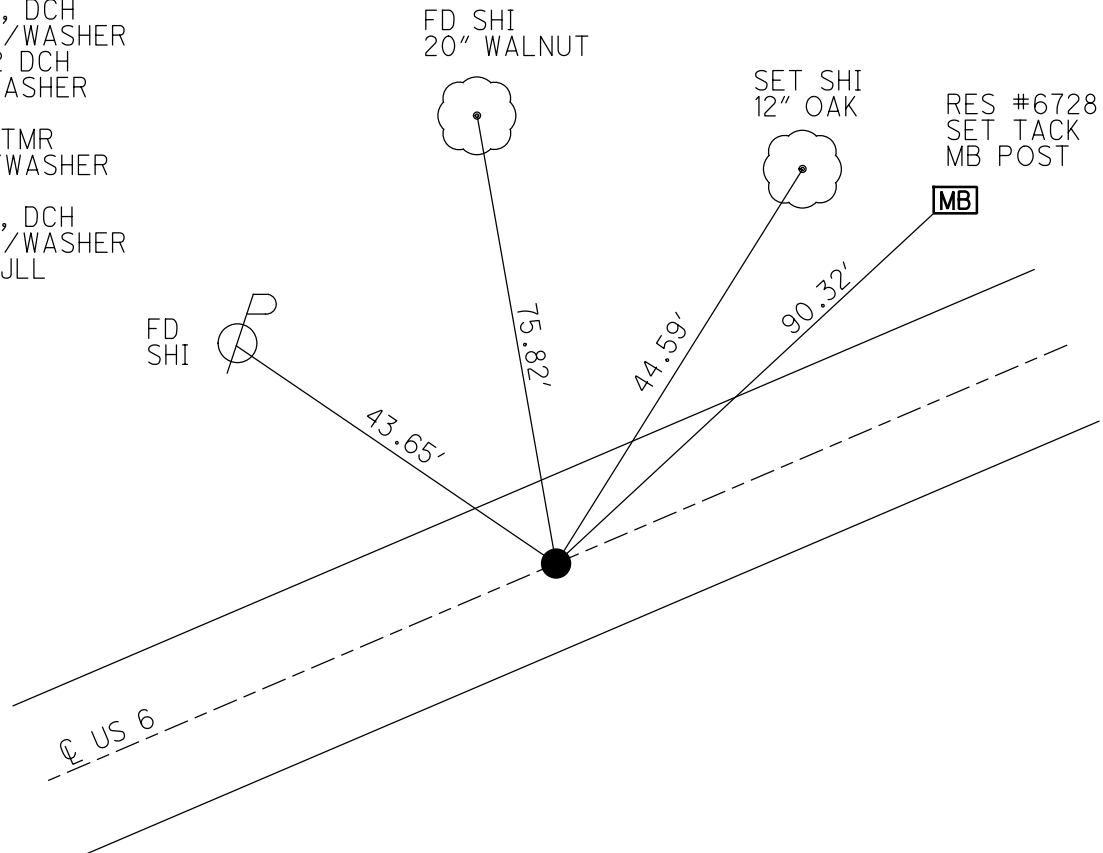


O.D.O.T. DISTRICT 2 SURVEY OFFICE (USE ONLY)

PERSONNEL	REFERENCE NO. <u>51 A</u>	SHEET <u>25</u> OF <u>31</u>	
NOTES	DATE <u>03/16/02</u>	ROUTE <u>US 6</u>	
H.C. <u>ROUSOS</u>	WEATHER <u>WINDY</u>	COUNTY <u>SANDUSKY</u>	
R.C. <u>VAN DUSEN</u>	TEMP. <u>28°</u>	TOWNSHIP <u>TOWNSEND</u>	
<u>MOSSER</u>		SECTION <u>2</u>	
<u>HOMAN</u>		T <u>5</u> N R <u>17</u> E	

TYPE MONUMENT PK/WASHER
 ON SURFACE - ~~BELOW~~ ON
~~LEFT~~ - Q PAV'T - RIGHT 0.6'
13' TO LT EDGE PAVEMENT
 S.L.M. 1631+81.43
 GRID: NORTHING: 639640.734 EASTING: 1865066.688

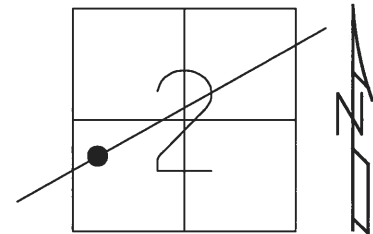


RECORD:
 PI $\Delta=00^{\circ} 09'$ LT (PLAN)
 OLD STA = 85+63.80
 PK/WASHER
 BOAT SPK/WASHER
 SET MAG/WASHER
 9/26/02 DCH
 FD PK/WASHER
 REFA51
 3-5-14, TMR

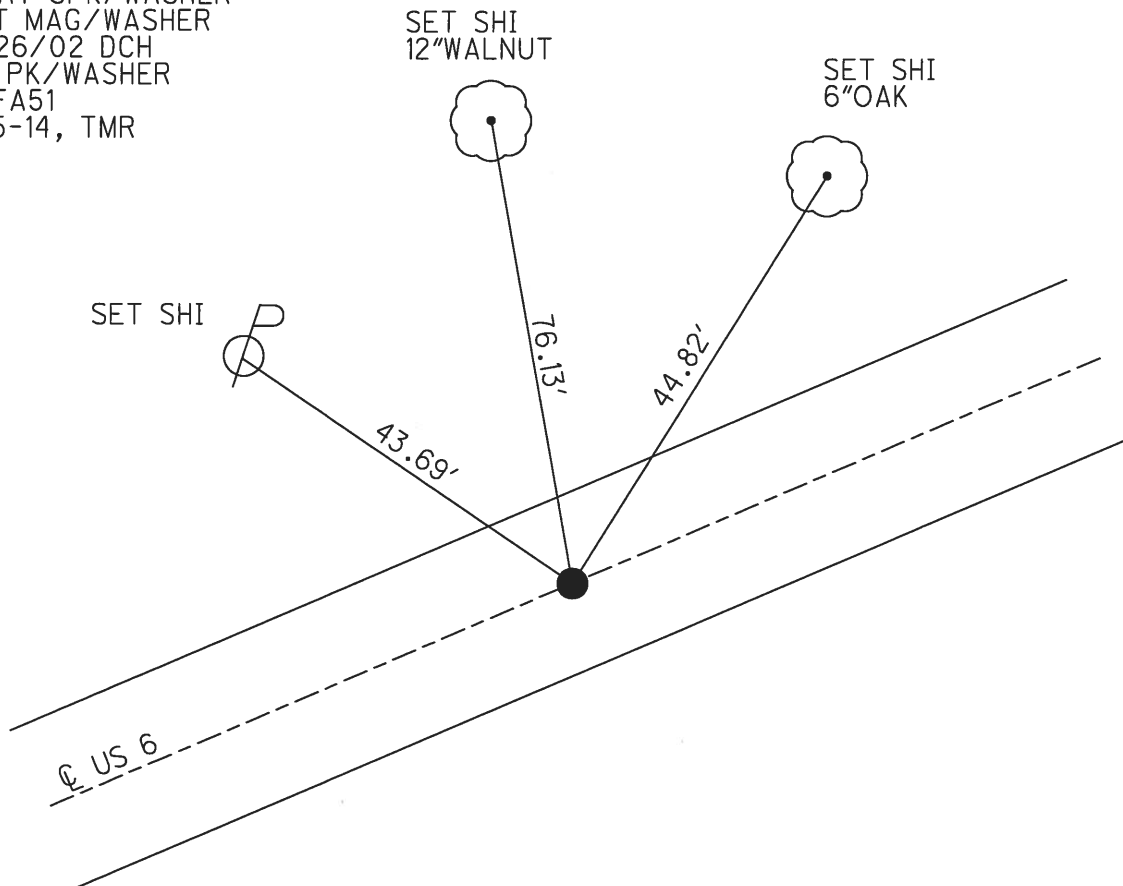


O.D.O.T. DISTRICT 2 SURVEY OFFICE (USE ONLY)

PERSONNEL _____ REFERENCE NO. 51 A SHEET 25 OF 31
 NOTES ROUSOS DATE 03/16/02 ROUTE US 6
 H.C. VAN DUSEN WEATHER WINDY COUNTY SANDUSKY
 R.C. MOSSER TEMP. 28° TOWNSHIP TOWNSEND
 _____ SECTION 2
 _____ T 5 N R 17 E

TYPE MONUMENT _____ PK/WASHER
 ON SURFACE - ~~BELOW~~ _____ ON
~~LEFT~~ - CL PAV'T - RIGHT _____ 0.6'
13' TO LT. EDGE PAVEMENT
 S.L.M. _____ 1629+81
 GRID: NORTHING: _____ EASTING: _____

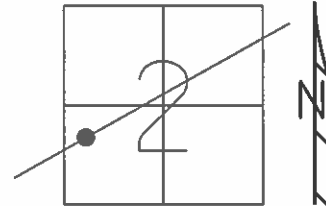

RECORD: P1
 $\Delta = 00^\circ 09' \text{ LT (PLAN)}$
 OLD STA = 85+63.80
 PREVIOUS MONUMENTS
 PK/WASHER
 BOAT SPK/WASHER
 SET MAG/WASHER
 09/26/02 DCH

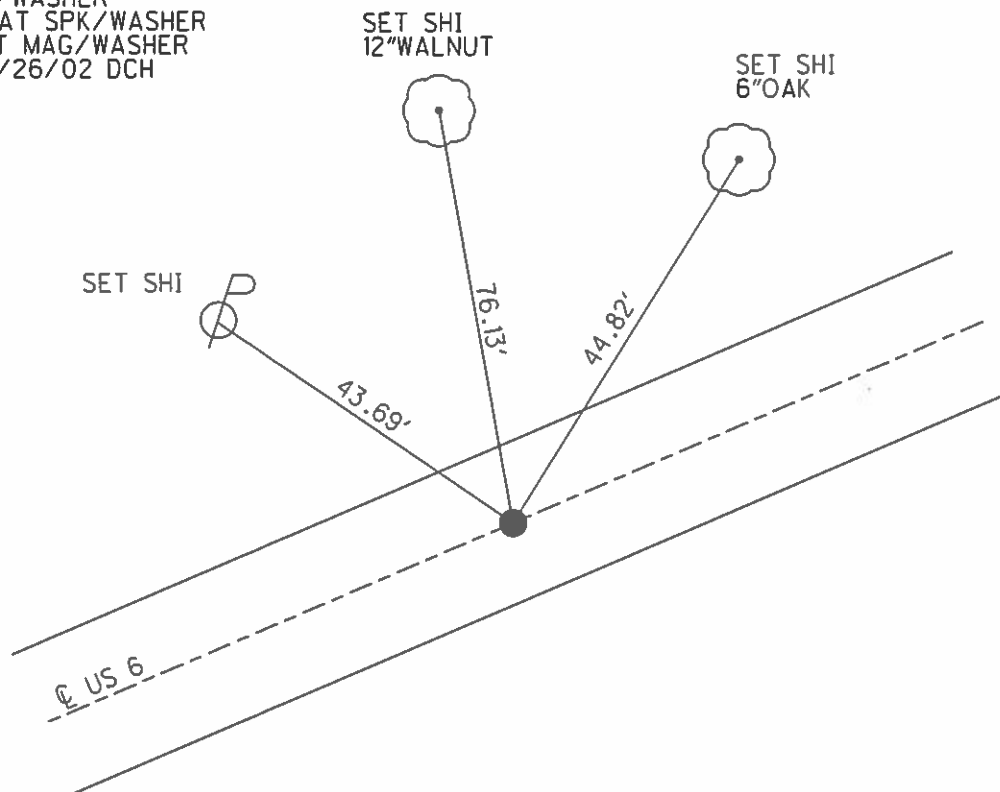

O.D.O.T. DISTRICT 2 SURVEY OFFICE

PERSONNEL

REFERENCE NO. _____

SHEET 33 OF 39

NOTES RIPPLE

H.C. BARBOWE

R.C. GEYMAN

DATE 10-3-1991

WEATHER —

TEMP. 74°

ROUTE 6

COUNTY SANDUSKY

TOWNSHIP TOWNSEND

SECTION 2

T5 N R 7 E

TYPE MONUMENT PK/WASHER


ON SURFACE - BELOW

LEFT- & PAV'T. - RIGHT —

— TO — EDGE PAVEMENT

S.L.M. 1629+81

51A

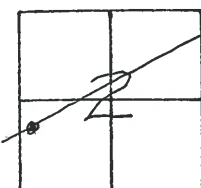

P.I.

$\Delta = 00^{\circ} 09' \text{ LT. (PLAN)}$

OLD STA - 85+63.80

PREVIOUS MONUMENTS


PK/WASHER

BOAT SPK/WASHER

8" WALNUT

N/S.

N/S.

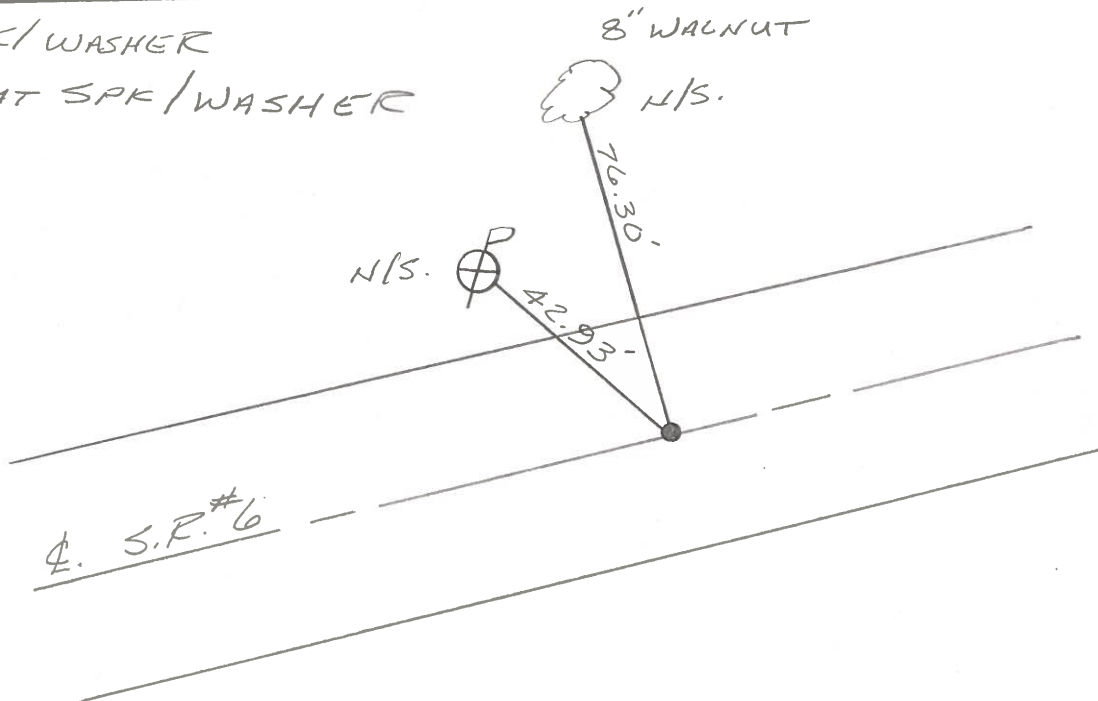

Q.D.O.T. DISTRICT 2 SURVEY OFFICE

SHEET _____ OF _____

County Sandusky S.R. U.S. #6

Township Townsend

Section 2

T5N, R1E

Personnel Cronin

Ripple


Geyman

Barbour

Date 9/26/84

Weather sunny - windy

Temp. 78°

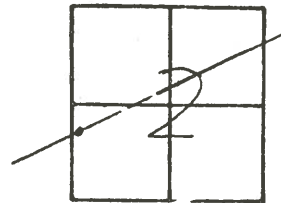

51A

4/03/91
57°


10/03/91
RIPPLE
BARBOUR
GEYMAN
SET 7K NAIL WASHER
TEMP 74°

1629+81

P.I. Δ: 00°09' Lt. (Plan)

85+63.80

Set P.K. & washer atop boat
spike & washer

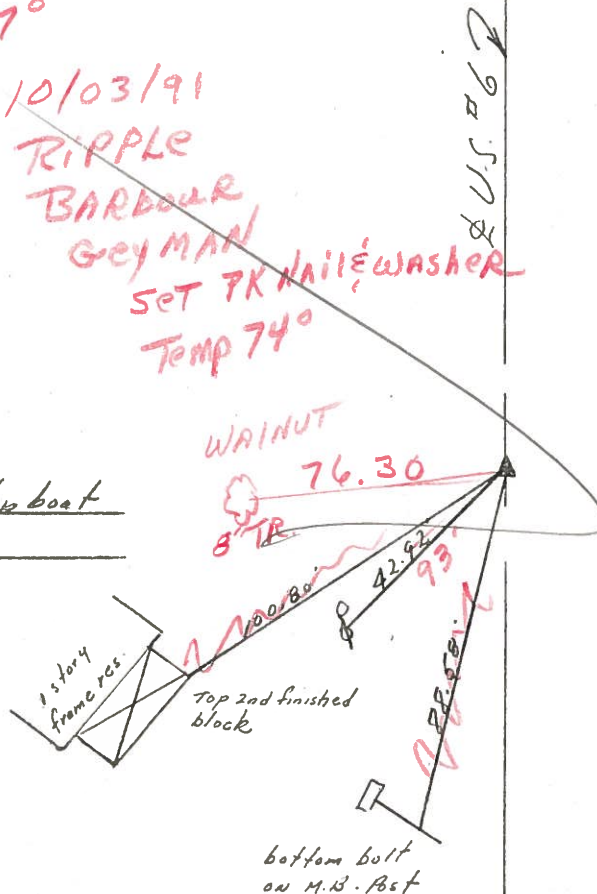

Q.D.O.T. DISTRICT 2 SURVEY OFFICE

SHEET _____ OF _____

County Sandusky S. R. U.S. #6

Township Townsend

Section 2

T5N, R12E

Personnel Cronin

Ripple


Geyman

Barbour

Date 9/26/84

Weather sunny - windy

Temp. 48°

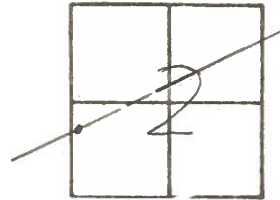

51A


U.S. #6

P.I. $\Delta = 00^{\circ}09'14''$ (Plan)

85 + 63.80

Set P.K. & washer atop boat

spike & washer

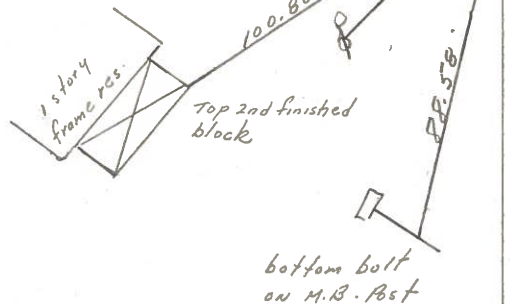

PERSONNEL TITLE PERSONNEL TITLE

Cronin Schneider

Ash Mosser

Ripke Barbour

Geyman

COUNTY Sandusky

S. R. #6

WEATHER Sunny

SEC. H.I. - Fremont - East

TEMP. 78°

DESCRIPTION Ties for Control Points

JOB NO.

LEFT

CENTER LINE

RIGHT

Townsend Twp


Sec. 2



P.I.

98+53.4

Fd. small spike & washer on surface

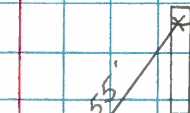30.00'
PlumbedState Highway conc.
R/W marker

55.88'

S.R. #6


 $\Delta = 00^{\circ}09'41''$ (Plan)

P.I.

85+63.8

Fd. small spike & washer on surface

51A

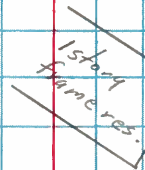

Top 2nd finished block

31.30'

Sec. 3

PERSONNEL	TITLE	PERSONNEL	TITLE	COUNTY	DATE	S. R.	WEATHER
Schneider		Potts		Sandusky	Dec-1967	U.S. #6	
Mosser							
Barbour							
Redding				SEC. Fremont-East			TEMP.

DESCRIPTION Ties for Control Points JOB NO. _____

