

O.D.O.T. DISTRICT 2 SURVEY OFFICE (USE ONLY)

PERSONNEL

REFERENCE NO. 52

SHEET 29 OF 34

NOTES PRESTON-COLVIN

DATE 9/5/24

ROUTE US 6

H.C. NEISE

WEATHER SUNNY

COUNTY SANDUSKY

R.C. BARRIERE

TEMP. 80°

TOWNSHIP TOWNSEND

DWG BY PRESTON-COLVIN PID PAVING TRAIN

T 5 N R 17 E

TYPE MONUMENT MEG/WASHER

ON SURFACE - ~~BELOW~~ ON

OFFSET Q PAVEMENT ON LT : RT

12.4' TO RT EDGE PAVEMENT

STATION: 1642+72

HORZ.DATUM: NAD83 (2011)


GEOID: NAVD88 2018

GRID: NORTHING: 640156.370


EASTING: 1866248.935

LDP: NORTHING: 336603

EASTING: 226343.9

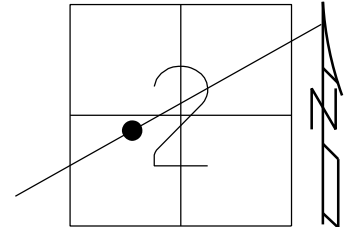

RECORD: P.I.
Δ0° 11' RT
STA. 98+53.4
PREVIOUS MONUMENTS
P.K./WASHER
BOAT SPIKE/WASHER
FD P.K./WASHER
3/16/02, DCH
SET MAG/WASHER
9/25/02, DCH
DNF
11/23/17, DCH
SET MAG/WASHER
8-6-19, JLL
FD MAG/WASHER
2/10/22, JFO
1/20/23, JMR
FD MAG/WASHER
9/5/24, TDN
FD MAG/WASHER
10/3/24, JAM

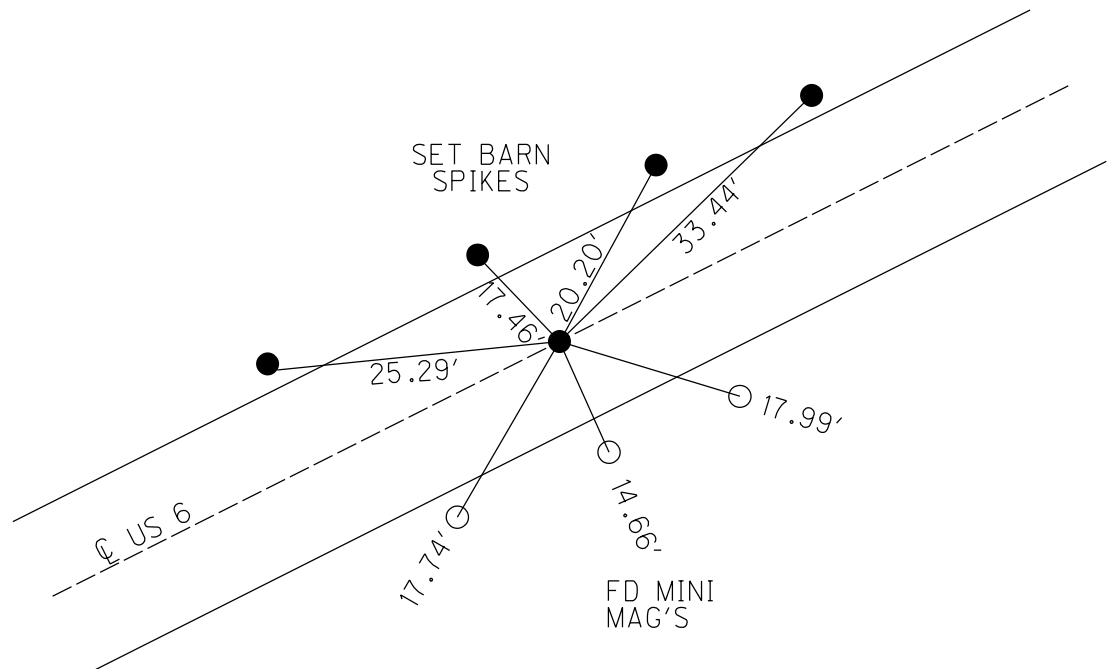

O.D.O.T. DISTRICT 2 SURVEY OFFICE (USE ONLY)

PERSONNEL

REFERENCE NO. 52

SHEET 29 OF 34

NOTES LEU

DATE 8/8/18

ROUTE US 6

H.C. LEU

WEATHER CLOUDY

COUNTY SANDUSKY

R.C. HAGEMeyer

TEMP. 75°

TOWNSHIP TOWNSEND

DWG BY AUBLE

PID PAVETRAIN

SECTION 2

T 5 N R 17 E

TYPE MONUMENT MAG/WASHER

ON SURFACE - ~~BELOW~~ ON

OFFSET Q PAVEMENT ON LT : RT

12.4' TO RT EDGE PAVEMENT


STATION: 1642+72

HORZ.DATUM: NAD83 (2011)


GEOID: NAVD88 2018

GRID: NORTHING: 640156.370

EASTING: 1866248.935

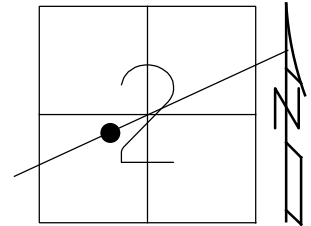

RECORD: P.I.
 $\Delta 0^{\circ} 11' RT$
STA. 98+53.4
PREVIOUS MONUMENTS
P.K./WASHER
BOAT SPIKE/WASHER
FD P.K./WASHER
3/16/02, DCH
SET MAG/WASHER
9/25/02, DCH
DNF
11/23/17, DCH
SET MAG/WASHER
8-6-19, JLL
FD MAG/WASHER
2/10/22, JFO
1/20/23, JMR

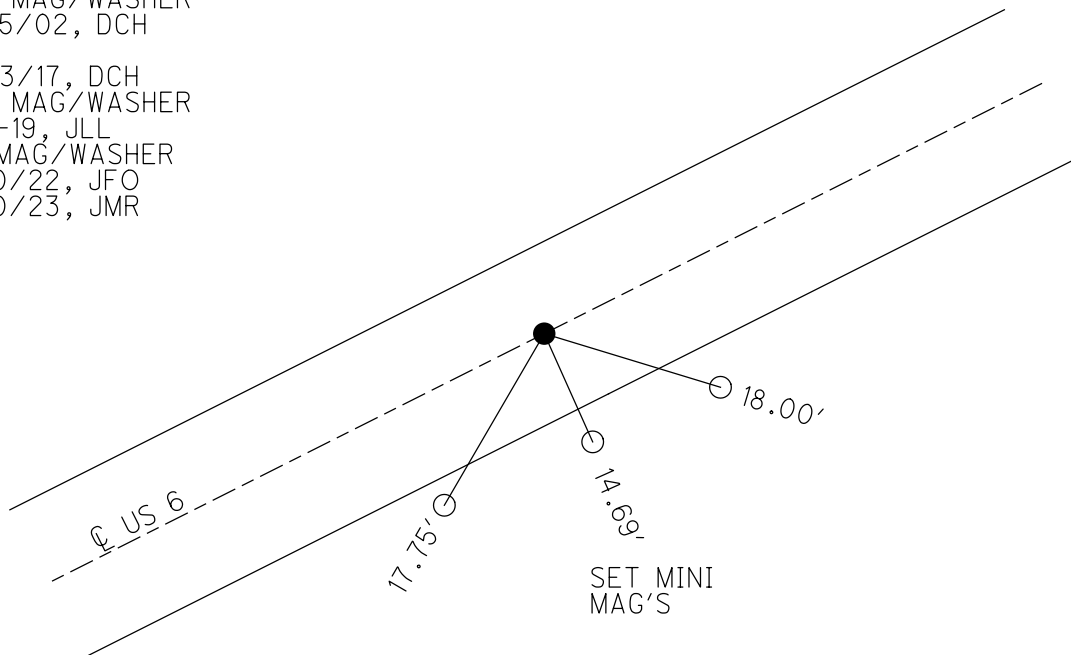


O.D.O.T. DISTRICT 2 SURVEY OFFICE (USE ONLY)


PERSONNEL	REFERENCE NO. <u>52</u>	SHEET <u>29</u> OF <u>34</u>
NOTES <u>LEU</u>	DATE <u>8/8/18</u>	ROUTE <u>US 6</u>
H.C. <u>LEU</u>	WEATHER <u>CLOUDY</u>	COUNTY <u>SANDUSKY</u>
R.C. <u>HAGEMeyer</u>	TEMP. <u>75°</u>	TOWNSHIP <u>TOWNSEND</u>
DWG BY <u>AUBLE</u>	PID <u>95769</u>	SECTION <u>2</u>
		T <u>5</u> N R <u>17</u> E

TYPE MONUMENT MAG/WASHER
ON SURFACE - ~~BELOW~~ ON
OFFSET Q PAVEMENT ON LT : RT
12.4' TO RT EDGE PAVEMENT
STATION: 1642+72

HORIZ.DATUM: NAD83 (2011) GEOID: 2012A
GRID: NORTHING: 640156.370 EASTING: 1866248.935

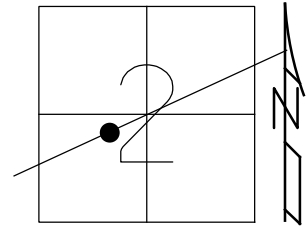

RECORD: P.I.
 $\Delta 0^{\circ} 11' RT$
STA. 98+53.4
PREVIOUS MONUMENTS
P.K./WASHER
BOAT SPIKE/WASHER
FD P.K./WASHER
3/16/02, DCH
SET MAG/WASHER
9/25/02, DCH
DNF
11/23/17, DCH
SET MAG/WASHER
8-6-19, JLL
FD MAG/WASHER
2/10/22, JFO

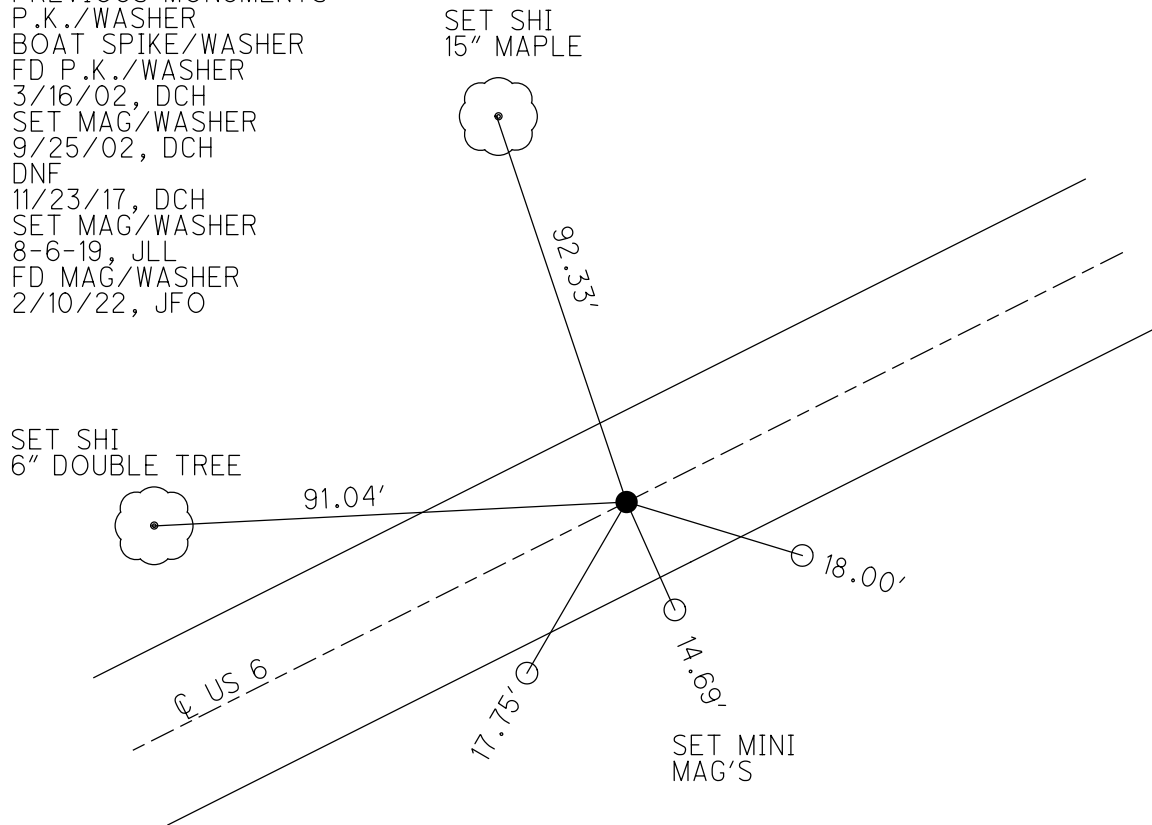

O.D.O.T. DISTRICT 2 SURVEY OFFICE (USE ONLY)

PERSONNEL

REFERENCE NO. 52

SHEET 29 OF 34

NOTES LEU

DATE 8/8/18

ROUTE US 6

H.C. LEU

WEATHER CLOUDY

COUNTY SANDUSKY

R.C. HAGEMeyer

TEMP. 75°

TOWNSHIP TOWNSEND

DWG BY AUBLE PID 95769

SECTION 2

T 5 N R 17 E

TYPE MONUMENT MAG/WASHER

ON SURFACE - ~~BELOW~~ ON

OFFSET Q PAVEMENT ON LT : RT

12.4' TO RT EDGE PAVEMENT


STATION: 1642+72

HORZ.DATUM: NAD83 (2011)


GEOID: 2012A

GRID: NORTHING: 640156.370

EASTING: 1866248.935

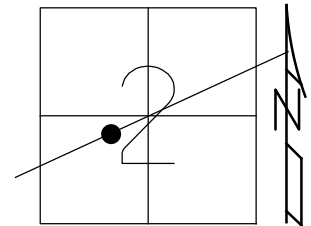


RECORD: P.I.
 $\Delta 0^{\circ} 11' RT$
STA. 98+53.4
PREVIOUS MONUMENTS
P.K./WASHER
BOAT SPIKE/WASHER
FD P.K./WASHER
3/16/02, DCH
SET MAG/WASHER
9/25/02, DCH
DNF
11/23/17, DCH
SET MAG/WASHER
8-6-19, JLL

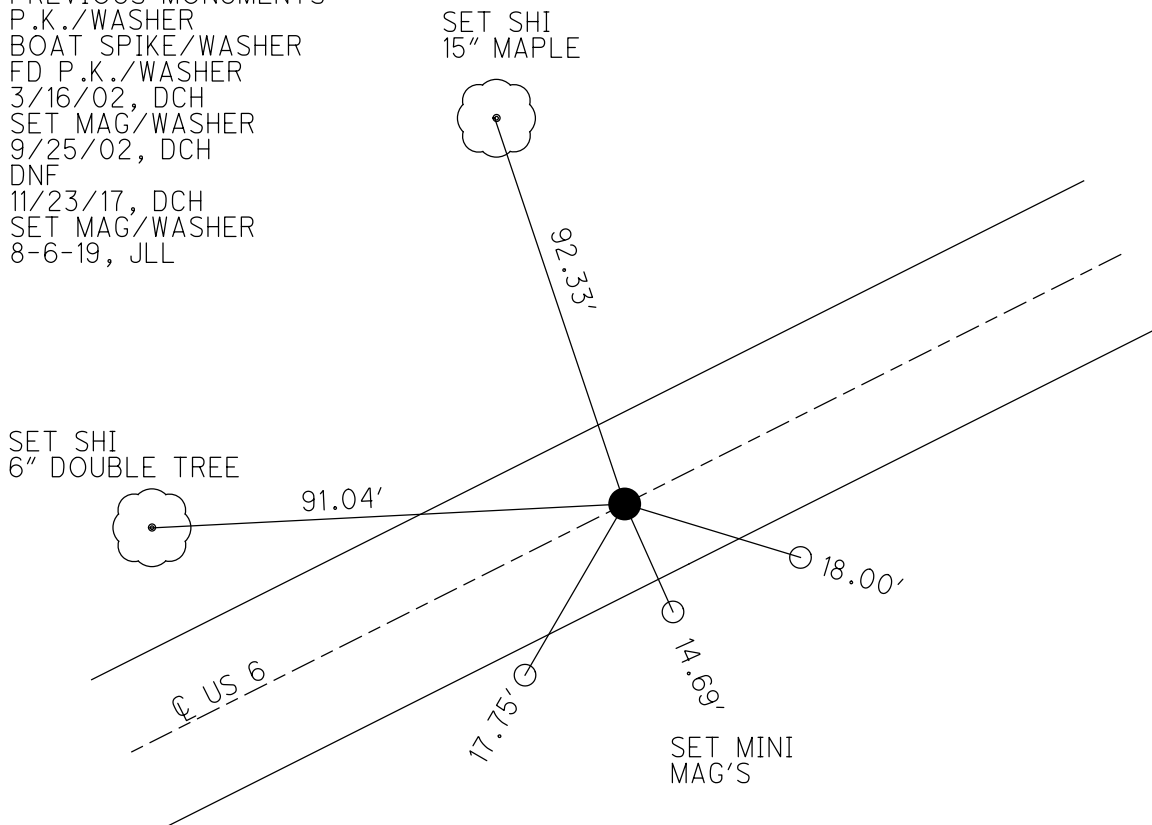

O.D.O.T. DISTRICT 2 SURVEY OFFICE (USE ONLY)

PERSONNEL _____ REFERENCE NO. 52 SHEET 26 OF 31
 NOTES ROUSOS DATE 03/16/02 ROUTE US 6
 H.C. VAN DUSEN WEATHER WINDY COUNTY SANDUSKY
 R.C. MOSSER TEMP. 28° TOWNSHIP TOWNSEND
 _____ SECTION 2
 _____ T 5 N R 17 E

TYPE MONUMENT _____ PK/WASHER
 ON SURFACE - ~~BELOW~~ _____ ON
~~LEFT~~ - C PAV'T - ~~RIGHT~~ _____ ON
12.4' TO RT EDGE PAVEMENT
 S.L.M. _____ 1642+72
 GRID: NORTHING: _____ EASTING: _____

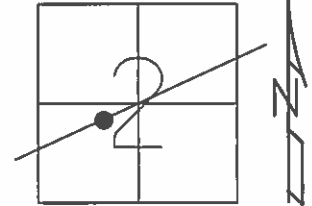

RECORD: PI
 0° 11' RT
 OLD STA = 98+53.4
 PREVIOUS MONUMENTS
 PK/WASHER
 BOAT SPK/WASHER
 SET MAG/WASHER
 09/25/02 DCH

FD SHI



115.45' (REC)

US 6

75.41'

30.00' (P)

ODOT R/W
MONUMENT

SET SHI
12" MAPLE



O.D.O.T. DISTRICT 2 SURVEY OFFICE

PERSONNEL

REFERENCE NO. _____

SHEET 34 OF 39

NOTES RIPPLE

H.C. BARBOUR

R.C. GEYMAN

DATE 10-3-1991

WEATHER _____

TEMP. 74°

ROUTE 6

COUNTY SANDUSKY

TOWNSHIP TOWNSEND

SECTION 2

TS N R 17 E

TYPE MONUMENT PK/WASHER


ON SURFACE - BELOW

LEFT - & PAW'T. - RIGHT _____

— TO — EDGE PAVEMENT

S.L.M. 1642+72

52

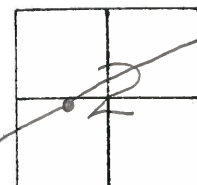


P.I.

OLD STA. = 98+53.4

PREVIOUS MONUMENTS

PK/WASHER

BOAT SPK/WASHER

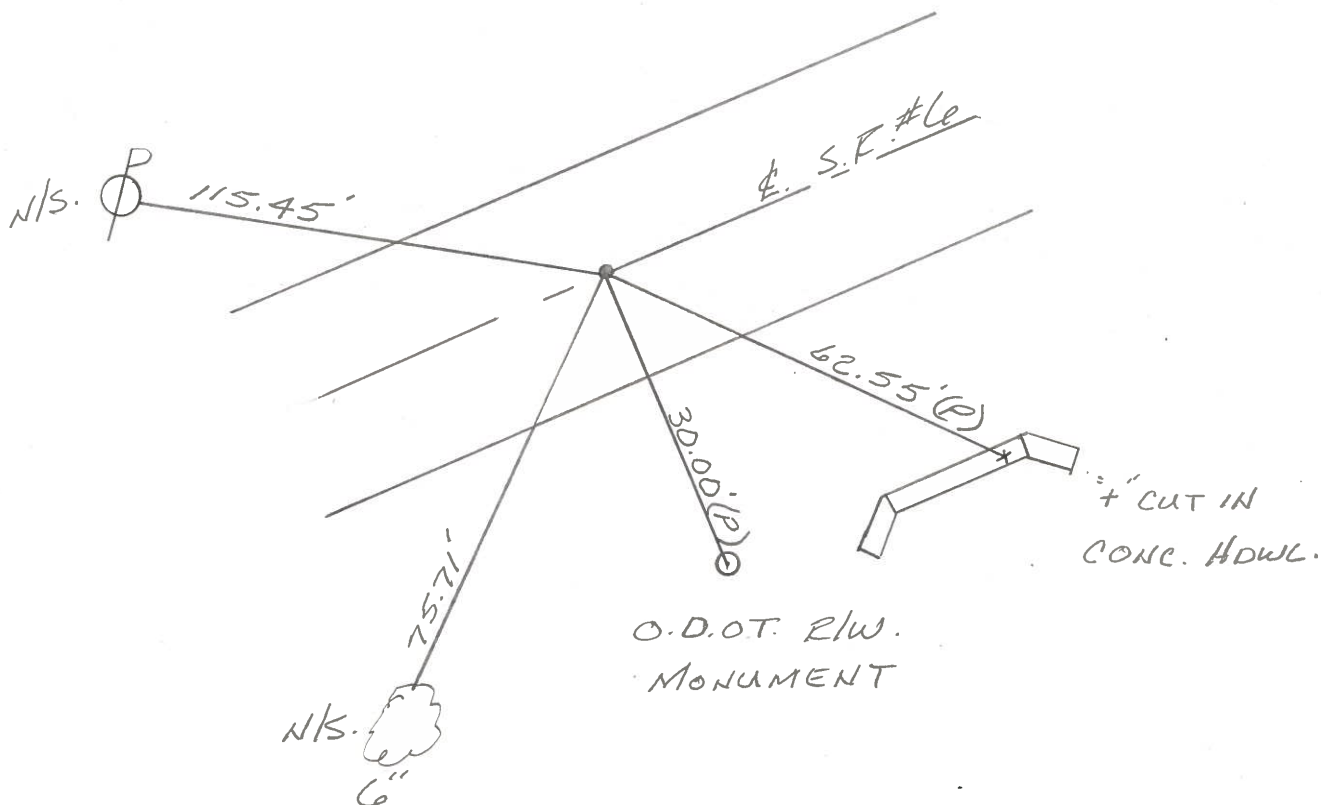

Q.D.O.T. DISTRICT 2 SURVEY OFFICE

SHEET _____ OF _____

County Sandusky S.R. U.S. #6

Township Townsend

Section 2

T 5 N, R 17 E

Personnel Cronin

Ripple


Geyman

Barbour

Date 9/26/84

Weather sunny - windy

Temp. 50°

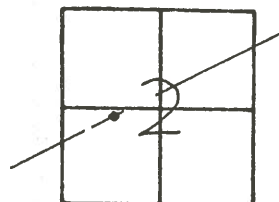

(52)

4/03/91 57°

1642+72

P.I.

98+53.4

set P.K. & washer atop

boat spike & washer

10/03/91


RIPPLE

BARBOUR

GEYMAN

SET P.K. NAIL & WASHER

Temp. 74°

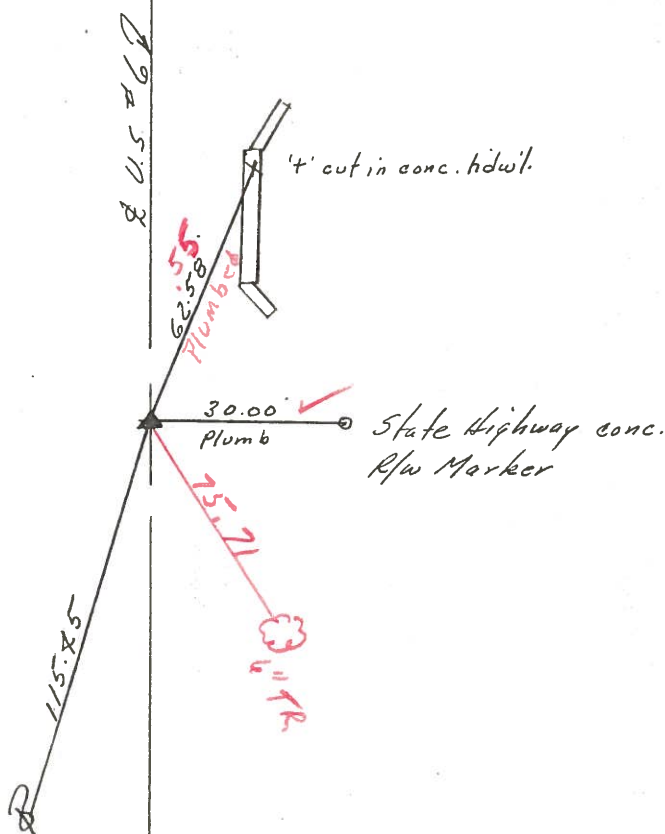

Q.D.O.T. DISTRICT 2 SURVEY OFFICE

SHEET _____ OF _____

County Sandusky S. R. U.S. #6

Township Townsend

Section 2

T₅N, R₁₇E

Personnel Cronin

Ripple


Geyman

Barbour

Date 9/26/84

Weather sunny - windy

Temp. 50°

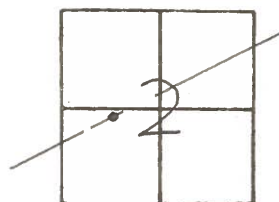


(52)

P.I.

98+53.4

Set P.K. & washer atop

boat spike & washer

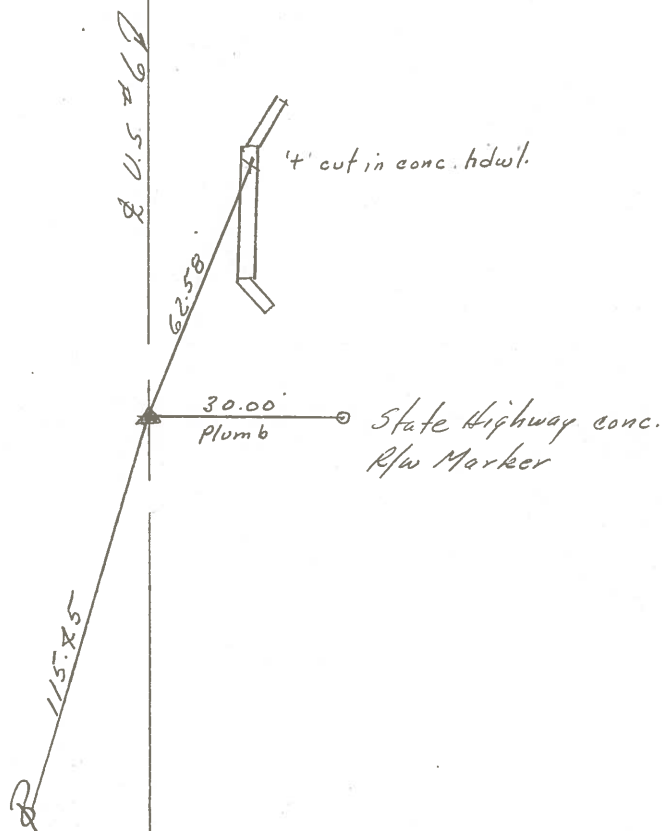

SHEET NO. 17

PERSONNEL	TITLE	PERSONNEL	TITLE
Cronin		Schneider	
Ash		Mosser	
Ripple		Barbour	
Geyman			

COUNTY Sandusky

Tied 8/5/75

DATE drawn 8/4/75

S. R. #6


WEATHER Sunny

SEC. H.I. - Fremont - East

TEMP. 78°

DESCRIPTION Ties for Control Points

JOB NO.

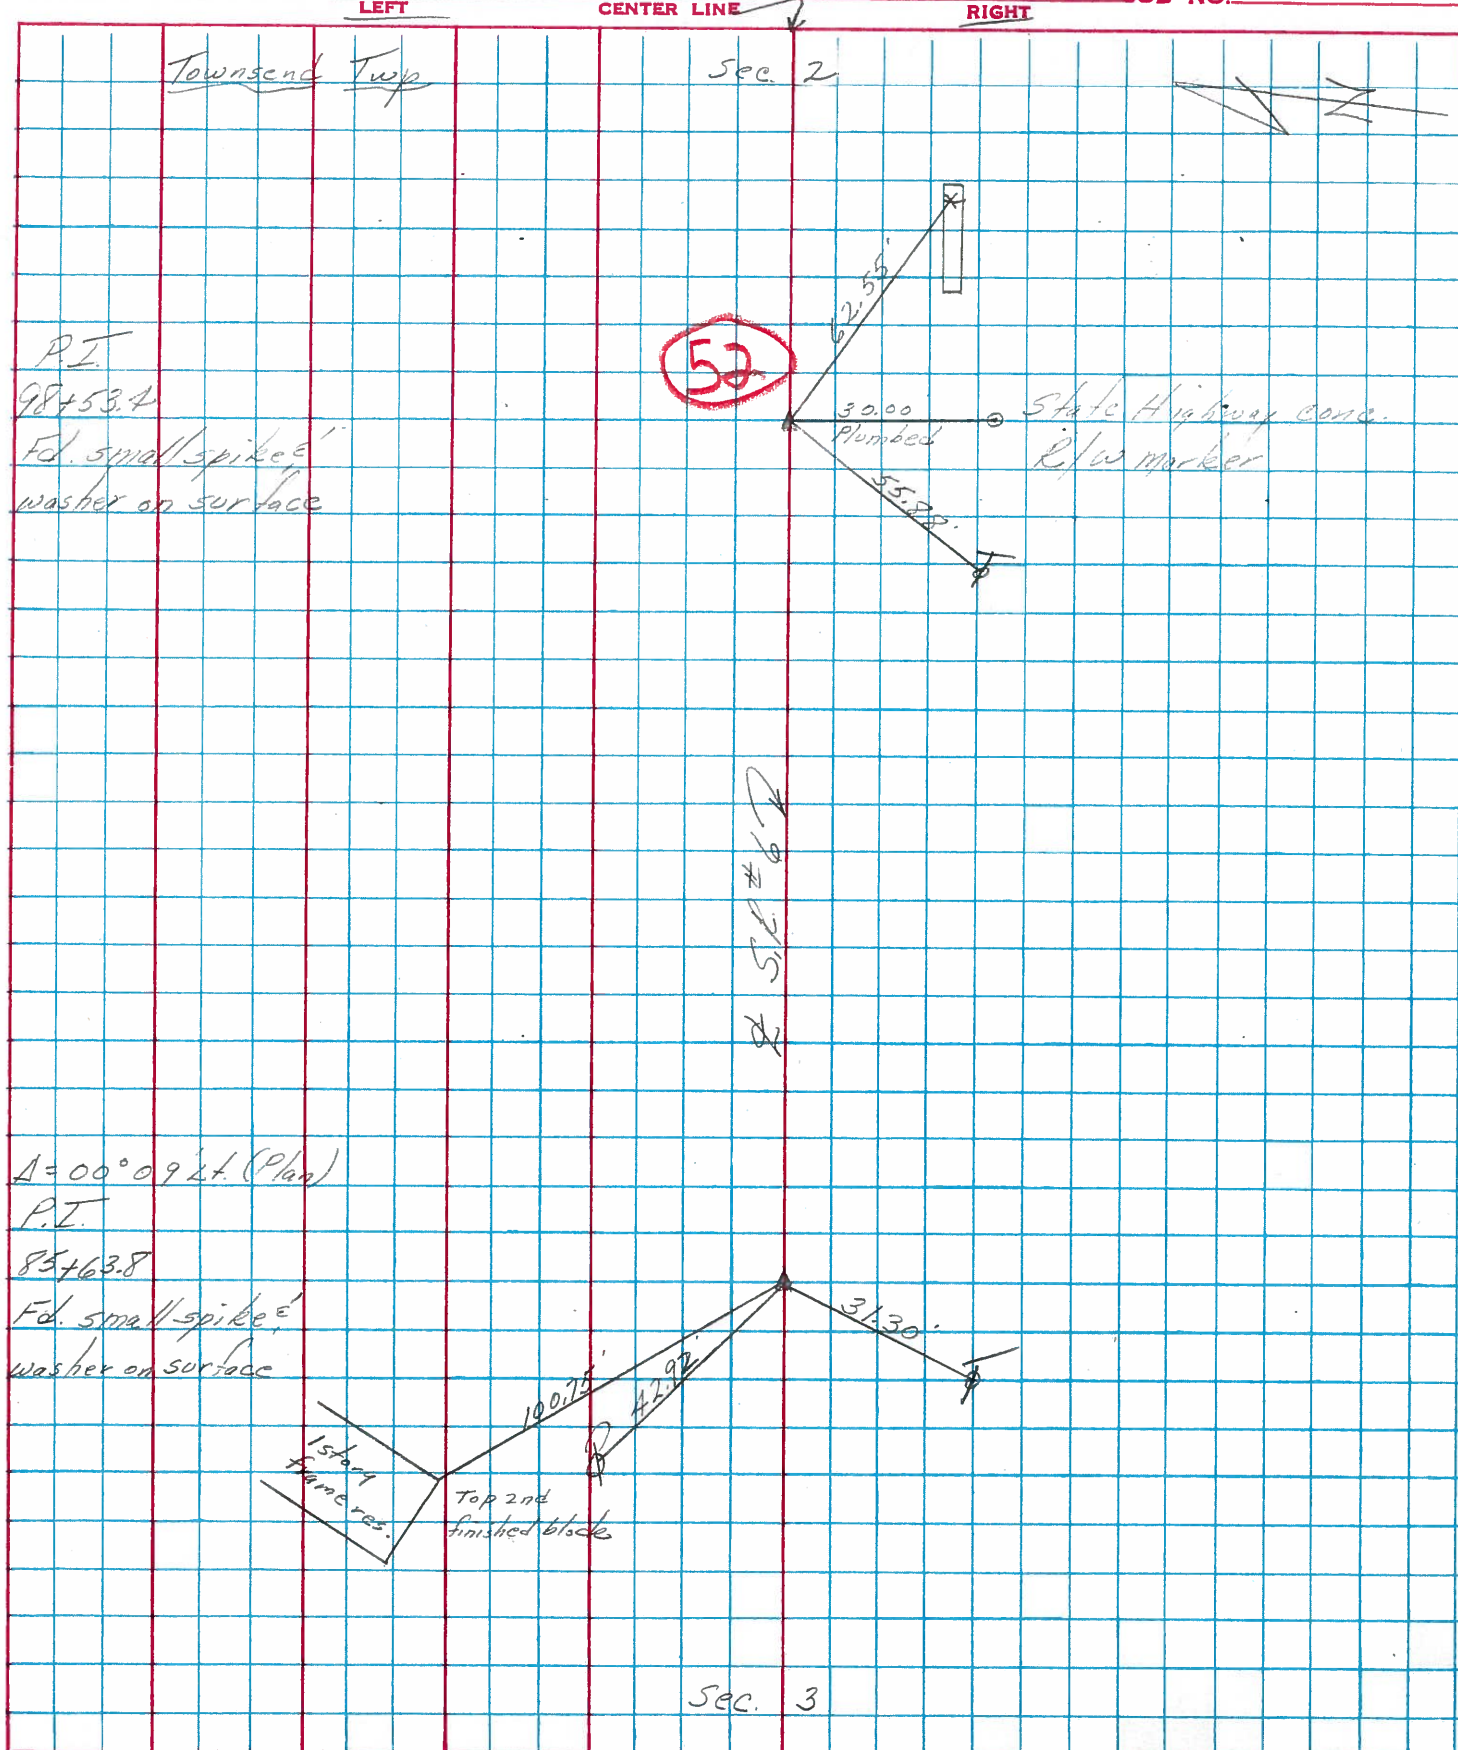

PERSONNEL	TITLE	PERSONNEL	TITLE	COUNTY	DATE
Schneider		Potts		Sandusky	Dec-1967
Mosser				S. R. U.S. #6	WEATHER
Barbour				SEC. Fremont-East	TEMP.
Redding					
DESCRIPTION	Ties for Control Points			JOB NO.	

