

O.D.O.T. DISTRICT 2 SURVEY OFFICE (USE ONLY)

PERSONNEL

REFERENCE NO. 1

SHEET 1 OF 25

NOTES RHOADES

DATE 6/1/20

ROUTE SR 53

H.C. O'DONNELL

WEATHER SUNNY

COUNTY SANDUSKY

R.C. LEU

TEMP. 46°

TOWNSHIP BALLVILLE

SECTION 31

DWG BY O'DONNELL PID 101277

T 4 N R 5 E

TYPE MONUMENT MONBOX W/ 1" IPIN

ON SURFACE - ~~BELOW~~ ON

~~LEFT~~ - Q PAV'T - RIGHT 9.5'

2.0' TO RT EDGE PAVEMENT


STATION: 0+00

HORZ.DATUM: NAD83 (2011)

GEOID: 2012A

GRID: NORTHING: 579541.497

EASTING: 1784953.199

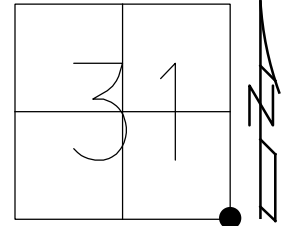

RECORD: P.I.
FD MONBOX
SVA122
6/5/12, MC
FD MONBOX
W/ 1" IPIN
REF1
6/1/20, JFO
NEWREF1
2/10/21, JFO

SANDUSKY CO.

SENECA CO.

CUT NOTCH
1' UP
SIGN POST

Q SR 53

30.98'

M

15.03'

40.23'

FD
SHI

FD CUT NOTCH
2' UP
SIGN POST
MP 0 ENTER SANDUSKY

O.D.O.T. DISTRICT 2 SURVEY OFFICE (USE ONLY)

PERSONNEL

REFERENCE NO. 2

SHEET 2 OF 25

NOTES RHOADES
H.C. O'DONNELL
R.C. LEU

DATE 6/1/20
WEATHER SUNNY
TEMP. 46°

ROUTE SR 53
COUNTY SANDUSKY
TOWNSHIP BALLVILLE
SECTION 31

DWG BY O'DONNELL PID 101277

T 4 N R 5 E

TYPE MONUMENT MONBOX W/ 1" IPIN

ON SURFACE - ~~BELOW~~ ON

LEFT - ℄ PAV'T - ~~RIGHT~~ 0.9'

10.7' TO LT EDGE PAVEMENT


STATION: 16+81.24

HORIZ.DATUM: NAD83 (2011)


GEOID: 2012A

GRID: NORTHING: 581221.637

EASTING: 1784892.692

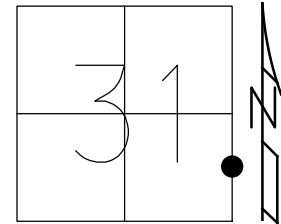

RECORD: P.I
FD MONBOX
SV99
6/14/10, KPM
FD MONBOX
6/5/12, MC
FD MONBOX
W/ 1" IPIN
REF2
6/1/20
2/10/21, JFO

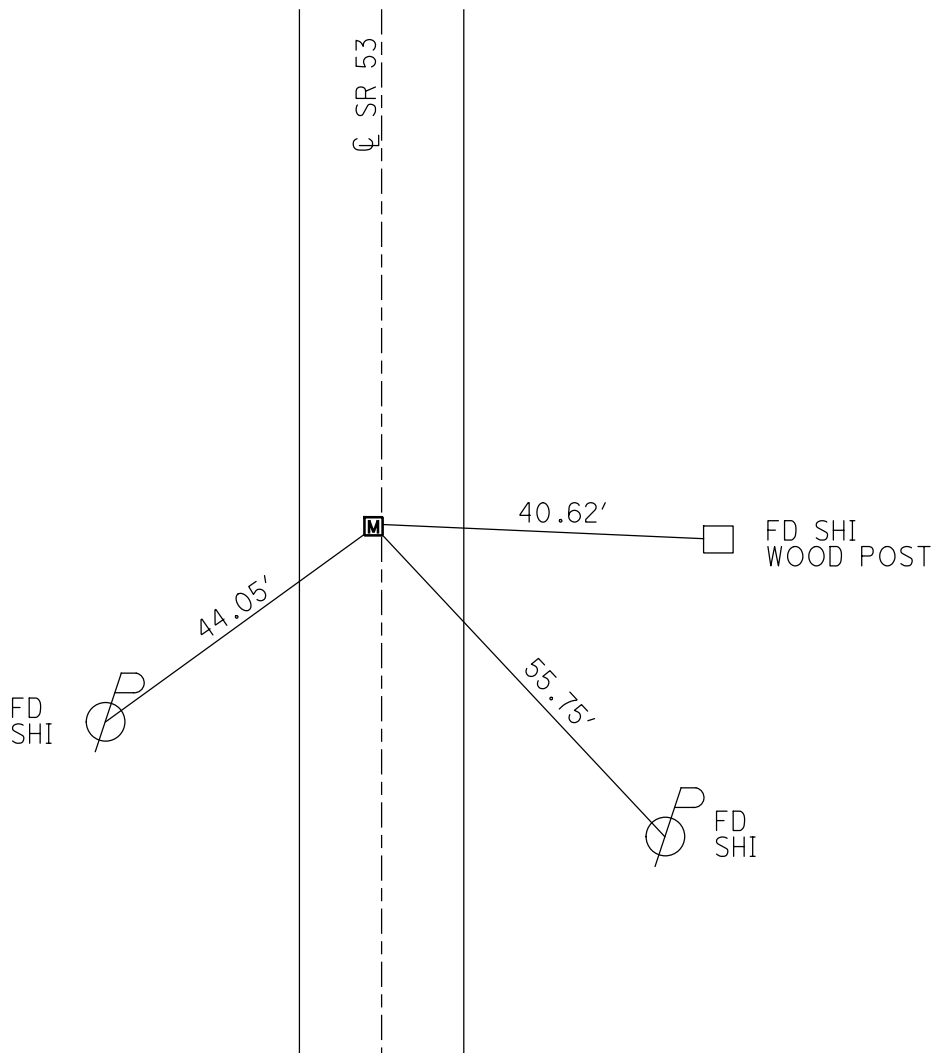

O.D.O.T. DISTRICT 2 SURVEY OFFICE (USE ONLY)

PERSONNEL

REFERENCE NO. 3

SHEET 3 OF 25

NOTES RHOADES

DATE 6/1/20

ROUTE SR 53

H.C. O'DONNELL

WEATHER SUNNY

COUNTY SANDUSKY

R.C. LEU

TEMP. 46°

TOWNSHIP BALLVILLE

SECTION 31

DWG BY O'DONNELL PID 101277

T 4 N R 5 E

TYPE MONUMENT MONBOX W/ 1" IPIN

ON SURFACE - ~~BELOW~~ ON

~~LEFT~~ - CL PAV'T - RIGHT 0.6', ±4' N. OF CL WEST

- TO - EDGE PAVEMENT


STATION: 26+45.64

HORZ.DATUM: NAD83 (2011)


GEOID: 2012A

GRID: NORTHING: 582185.643

EASTING: 1784865.003

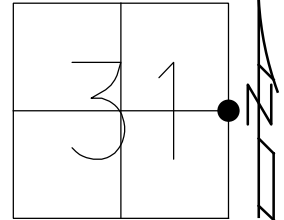

RECORD: P.I.
FD MONBOX
SV100
6/14/10, KPM
FD MONBOX
6/5/12, MC
FD MONBOX
W/ 1" IPIN
REF3
6/1/20
2/10/21, JFO

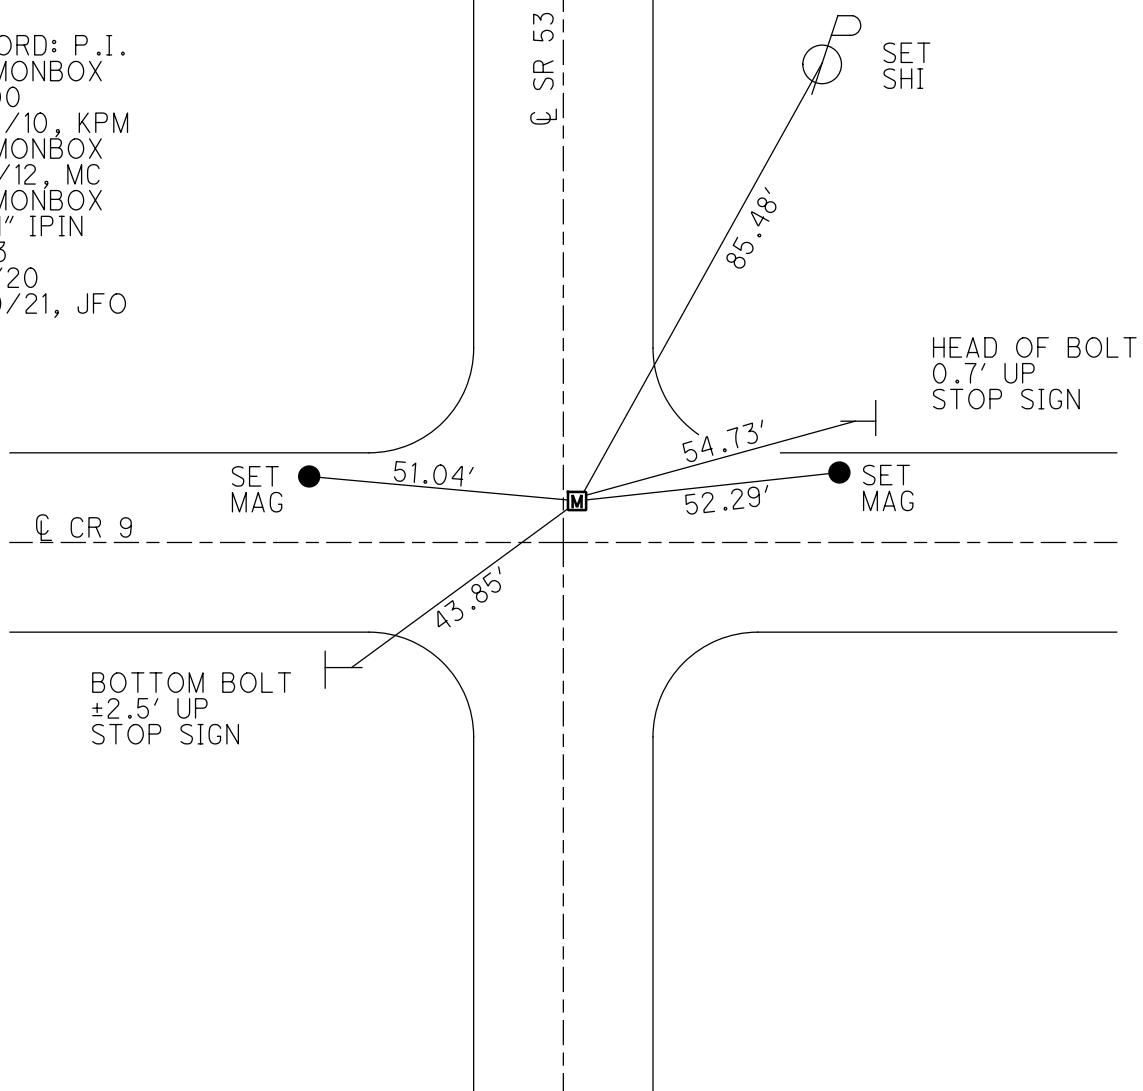

O.D.O.T. DISTRICT 2 SURVEY OFFICE (USE ONLY)

PERSONNEL

REFERENCE NO.

4

SHEET

4

OF 25

NOTES RHOADES

DATE

6/1/20

ROUTE

SR 53

H.C. O'DONNELL

WEATHER

SUNNY

COUNTY

SANDUSKY

R.C. LEU

TEMP.

46°

TOWNSHIP

BALLVILLE

SECTION

31

DWG BY O'DONNELL

PID 101277

T 4 N

R 5 E

TYPE MONUMENT MONBOX W/ 1" IPIN

ON SURFACE - ~~BELOW~~ ON

LEFT - C PAV'T - ~~RIGHT~~ 5.2'

6.7' TO LT EDGE PAVEMENT


STATION: 52+93.86

HORIZ.DATUM: NAD83 (2011)

GEOID: 2012A

GRID: NORTHING: 584831.039

EASTING: 1784744.613

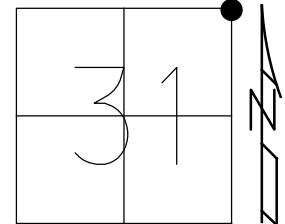

FD SHI
16" TWIN
MAPLE



54.62'

FD DUPLEX
CUT OFF
WOOD POST



35.06'

SET SHI
36" TWIN
MAPLE



37.20'

C SR 53



RECORD: P.I.
FD MONBOX
SV101
6/14/10, KPM
FD MONBOX
6/5/12, MC
FD MONBOX
W/ 1" IPIN
REF4
6/1/20, JFO
NEWREF4
2/10/21, JFO

O.D.O.T. DISTRICT 2 SURVEY OFFICE (USE ONLY)

PERSONNEL _____ REFERENCE NO. 4 A SHEET 5 OF 25

NOTES RHOADES DATE 6/1/20 ROUTE SR 53
H.C. O'DONNELL WEATHER SUNNY COUNTY SANDUSKY
R.C. LEU TEMP. 68° TOWNSHIP BALLVILLE
SECTION 30

DWG BY O'DONNELL PID 101277

T 4 N R 5 E

TYPE MONUMENT MONBOX W/ 1" IPIN

ON SURFACE - ~~BELOW~~ ON

LEFT - ℄ PAV'T - RIGHT ON

11.4' TO LT EDGE PAVEMENT


STATION: 81+14.74

HORIZ.DATUM: NAD83 (2011)

GEOID: 2012A


GRID: NORTHING: 587652.061

EASTING: 1784757.777

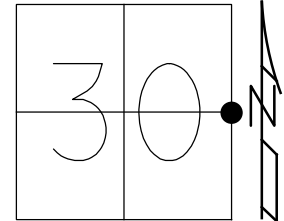

FD SHI'S
PINES

SET SHI
STUMP

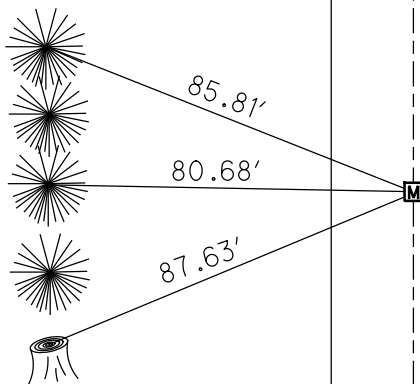

RECORD: P.C.
FD MONBOX
SV102
SHOT 0.1± S. OF IPIN.
IPIN UNDER N.EDGE OF BOX
6/14/10, KPM
FD MONBOX
7/6/12, MC
FD MONBOX
W/ 1" IPIN
REFA4
6/1/20
3/31/21, JFO

O.D.O.T. DISTRICT 2 SURVEY OFFICE (USE ONLY)

PERSONNEL _____ REFERENCE NO. 6 SHEET 6 OF 25

NOTES RHOADES DATE 6/1/20 ROUTE SR 53

H.C. O'DONNELL WEATHER SUNNY COUNTY SANDUSKY

R.C. LEU TEMP. 70° TOWNSHIP BALLVILLE

SECTION 30

DWG BY O'DONNELL PID 101277

T 4 N R 5 E

TYPE MONUMENT MONBOX W/ 1" IPIN

ON SURFACE - ~~BELOW~~ ON



LEFT - ℄ PAV'T - RIGHT ON

12.3' TO RT EDGE PAVEMENT

STATION: 97+75.38

HORZ.DATUM: NAD83 (2011) GEOID: 2012A

GRID: NORTHING: 589273.049 EASTING: 1784448.122

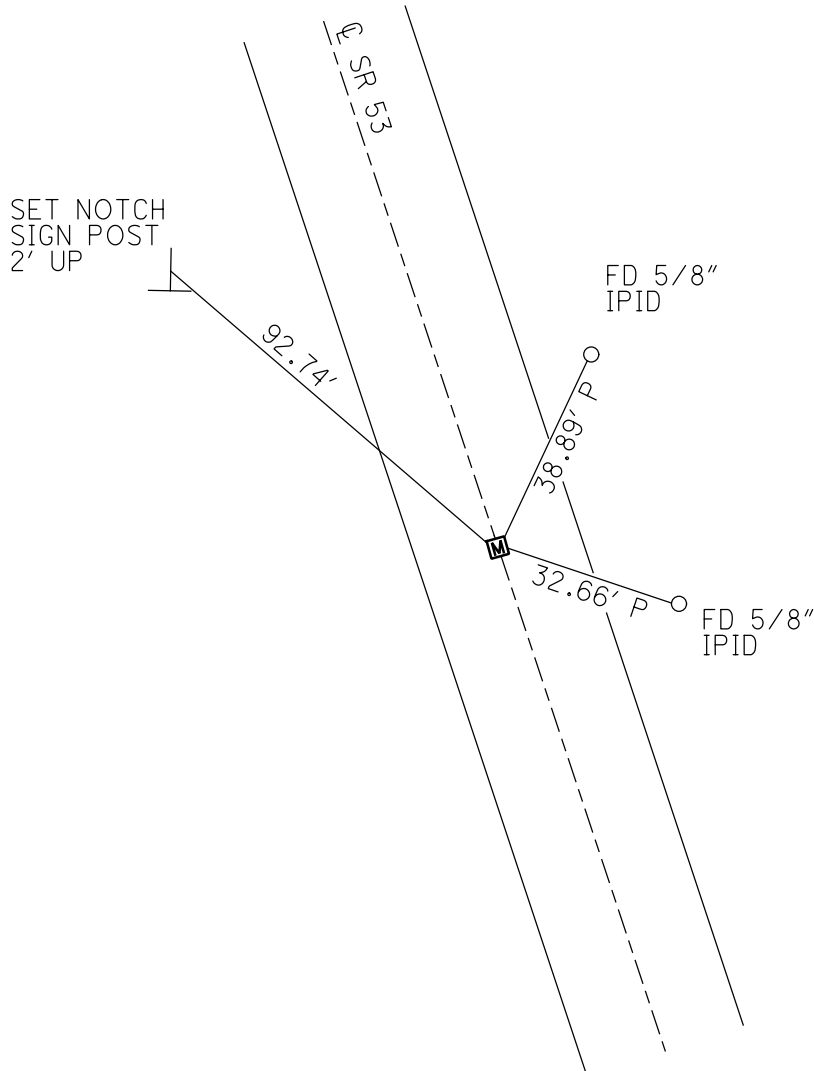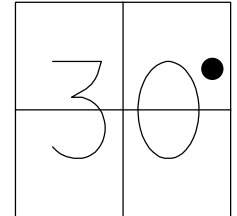

RECORD: P.T.
FD MONBOX
SV103
6/14/10, KPM
FD MONBOX
7/6/12, MC
FD MONBOX
W/ 1" IPIN
REF6
6/1/20
3/31/21, JFO

O.D.O.T. DISTRICT 2 SURVEY OFFICE (USE ONLY)

PERSONNEL _____ REFERENCE NO. 7 SHEET 7 OF 25

NOTES RHOADES DATE 6/3/20 ROUTE SR 53
H.C. O'DONNELL WEATHER SUNNY/WINDY COUNTY SANDUSKY
R.C. LEU TEMP. 82° TOWNSHIP BALLVILLE
SECTION 30

DWG BY O'DONNELL PID 101277

T 4 N R 5 E

TYPE MONUMENT MONBOX W/ 1" IPIN

ON SURFACE - ~~BELOW~~ ON


LEFT - Q PAV'T - RIGHT ON

12.3' TO RT EDGE PAVEMENT


STATION: 103+16.18

HORIZ.DATUM: NAD83 (2011) GEOID: 2012A

GRID: NORTHING: 589774.944 EASTING: 1784246.805

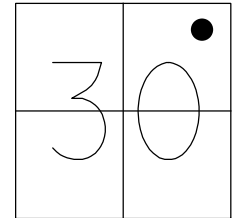

RECORD: P.C.
FD MONBOX
SV104
6/14/10, KPM
FD MONBOX
7/9/12, MC
FD MONBOX
W/ 1" IPIN
REF7
6/3/20
NEWREF7
2/10/21, JFO

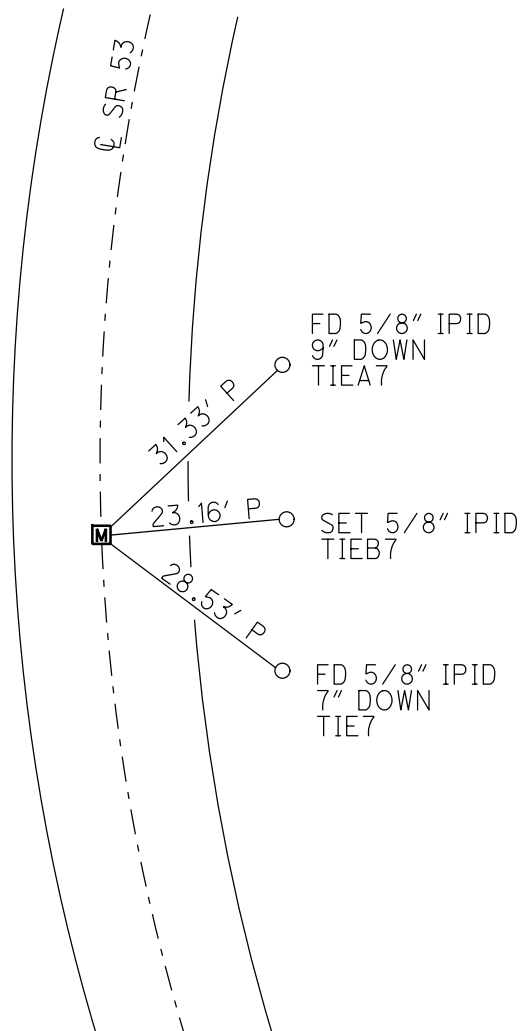

O.D.O.T. DISTRICT 2 SURVEY OFFICE (USE ONLY)

PERSONNEL _____ REFERENCE NO. 8 A SHEET 8 OF 25

NOTES RHOADES DATE 6/3/20 ROUTE SR 53
H.C. O'DONNELL WEATHER SUNNY/WINDY COUNTY SANDUSKY
R.C. LEU TEMP. 82° TOWNSHIP BALLVILLE
SECTION 19

DWG BY O'DONNELL PID 101277

T 4 N R 5 E

TYPE MONUMENT MONBOX W/ 1" IPIN

ON SURFACE - ~~BELOW~~ ON

LEFT - CL PAV'T - RIGHT ON

18.8' TO RT EDGE PAVEMENT


STATION: 135+65.70

HORIZ.DATUM: NAD83 (2011)

GEOID: 2012A


GRID: NORTHING: 592947.550

EASTING: 1784235.786

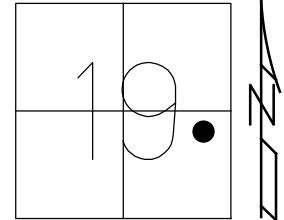

RECORD: P.T.
FD MONBOX
SV105
6/14/10, KPM
FD MONBOX
7/9/12, MC
FD MONBOX
W/ 1" IPIN
REFA8
6/3/20
3/31/21, JFO

CUT NOTCH
1' UP SIGN
LANE LINES

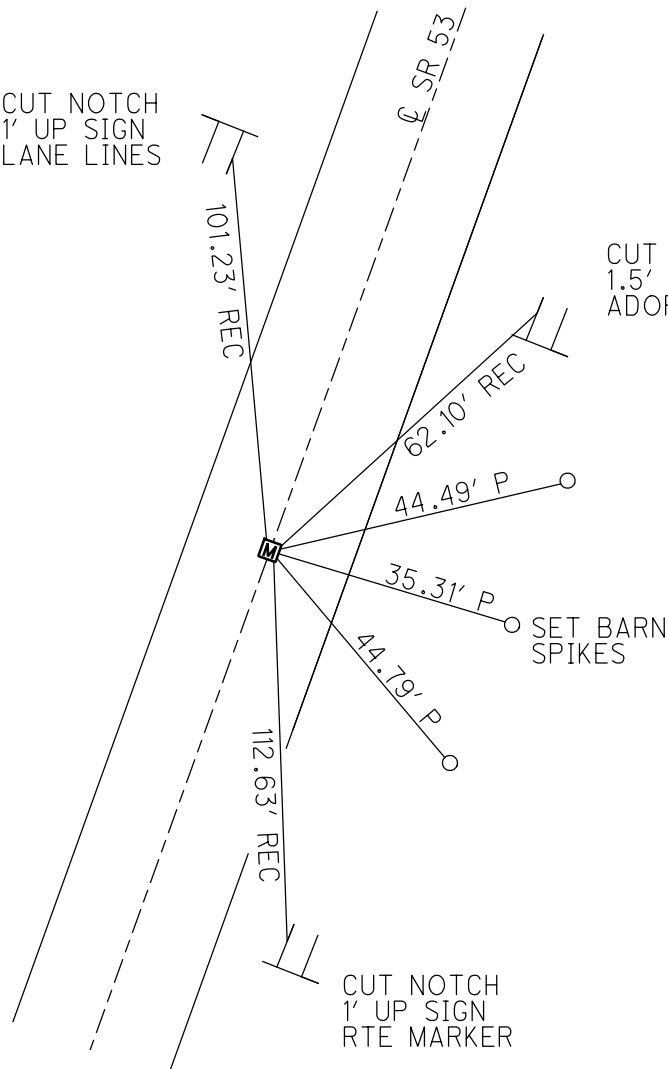

O.D.O.T. DISTRICT 2 SURVEY OFFICE (USE ONLY)

PERSONNEL

REFERENCE NO. 105 A

SHEET 1 OF 1

NOTES RHOADES

DATE 5/22/13

ROUTE SR 53

H.C. CODER

WEATHER CLOUDY

COUNTY SANDUSKY

R.C. RHOADES

TEMP. 70°

TOWNSHIP BALLVILLE

SECTION 19

T 4 N R 15 E

TYPE MONUMENT MONBOX


ON SURFACE - ~~BELOW~~ ON

LEFT - Q PAV'T - RIGHT ON

- TO - EDGE PAVEMENT


S.L.M. SR 53= 133+05.6, CR 201= 617.84

Grid: Northing: 592689.564 Easting: 1784762.897

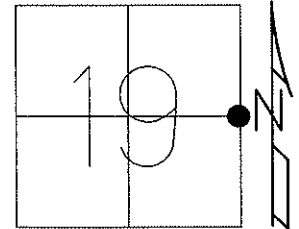

NOTE:
REF 105
N= 592947.528
E= 1784235.728

NOTE:
E. 1/4 POST
OF SEC. 19

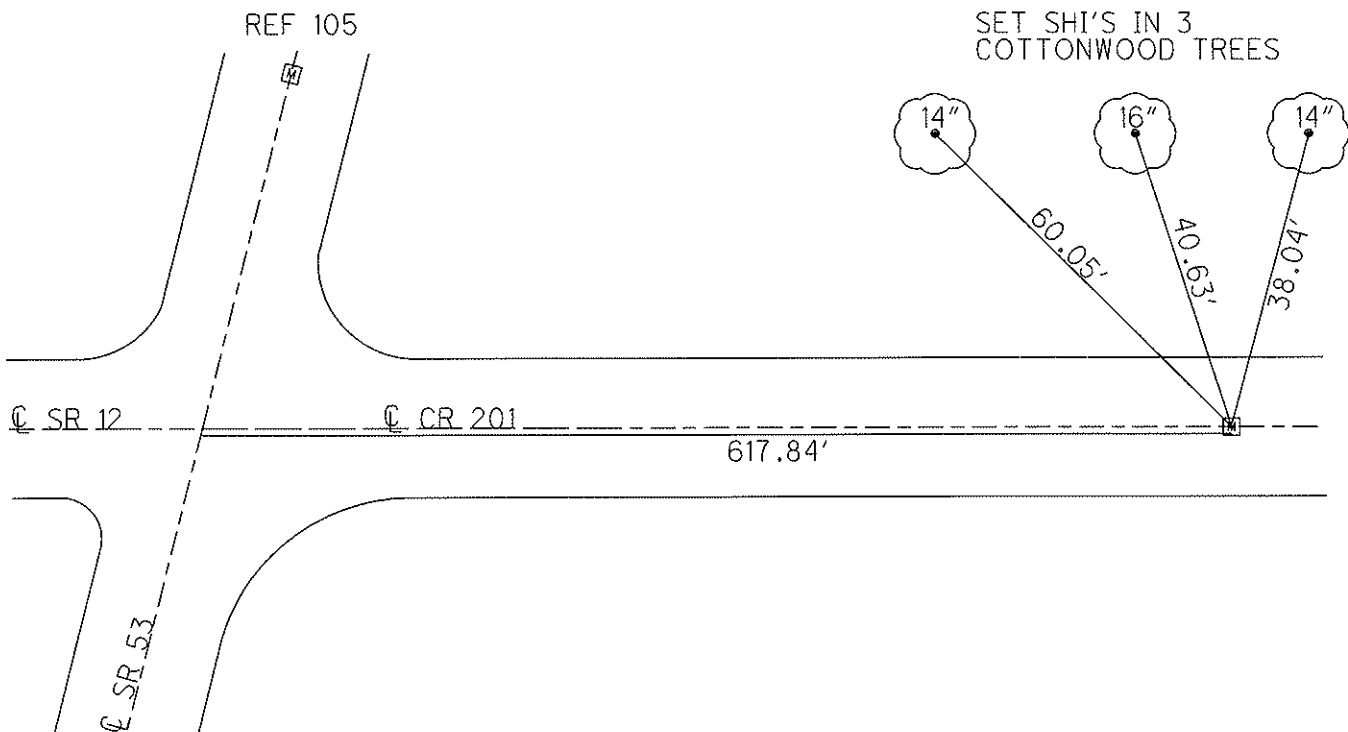

FD MONBOX (EMPTY)
GPS, SV5004
5/16/13, SDC

PULLED TIES TO
\"+\" CUT ON LID

O.D.O.T. DISTRICT 2 SURVEY OFFICE (USE ONLY)

PERSONNEL

REFERENCE NO.

8 B

SHEET

9

OF 25

NOTES RHOADES

DATE 6/3/20

ROUTE SR 53

H.C. O'DONNELL

WEATHER SUNNY/WINDY

COUNTY SNADUSKY

R.C. LEU

TEMP. 82°

TOWNSHIP BALLVILLE

SECTION 19

DWG BY O'DONNELL PID 101277

T 4 N R 5 E

TYPE MONUMENT MONBOX W/ 1" IPIN

ON SURFACE - ~~BELOW~~ ON

LEFT - ℄ PAV'T - RIGHT ON

11.4' TO LT EDGE PAVEMENT


STATION: 143+56.37

HORZ.DATUM: NAD83 (2011)


GEOID: 2012A

GRID: NORTHING: 593683.299

EASTING: 1784525.344

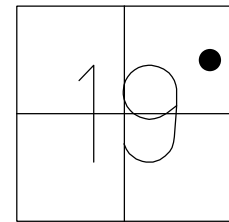

RECORD: P.C.
FD MONBOX
SV106
6/14/10, KPM
FD MONBOX
7/9/12, MC
FD MONBOX
W/ 1" IPIN
REFB8
6/3/20
3/31/21, JFO

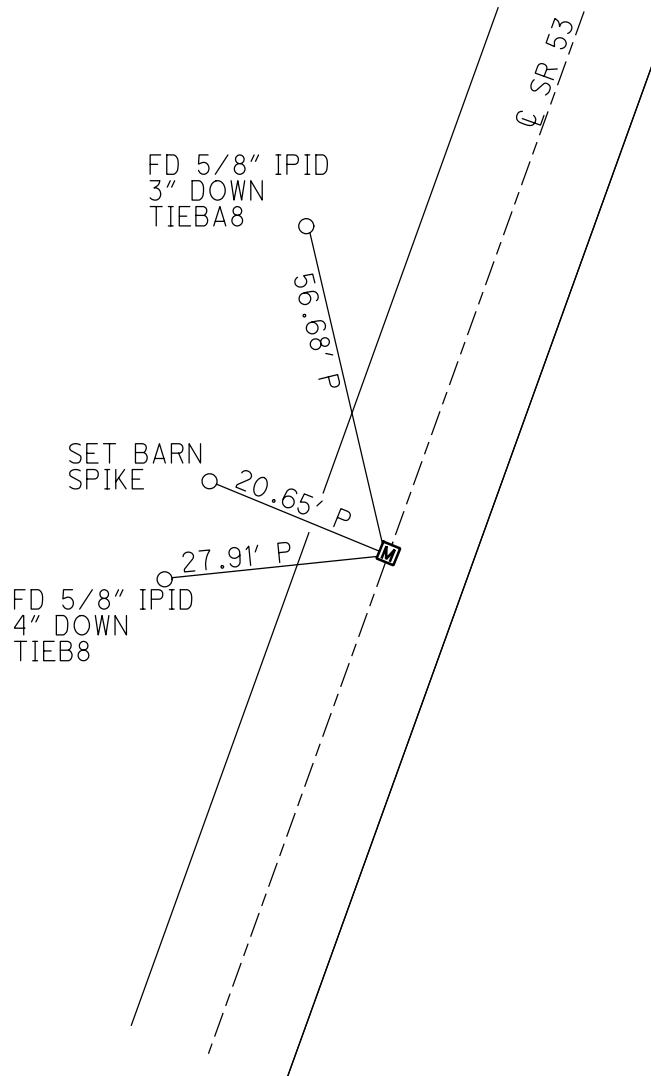

O.D.O.T. DISTRICT 2 SURVEY OFFICE (USE ONLY)

PERSONNEL

REFERENCE NO.

8 C

SHEET

10

OF 25

NOTES RHOADES

DATE

6/5/20

ROUTE

SR 53

H.C. O'DONNELL

WEATHER

SUNNY

COUNTY

SANDUSKY

R.C. LEU

TEMP.

73°

TOWNSHIP

BALLVILLE

SECTION

19

DWG BY O'DONNELL

PID 101277

T 4 N

R 5 E

TYPE MONUMENT MONBOX W/ 1" IPIN

ON SURFACE - ~~BELOW~~ ON

LEFT - CL PAV'T - ~~RIGHT~~ 1.2'

10.5' TO LT EDGE PAVEMENT



STATION: 159+55.87

HORZ.DATUM: NAD83 (2011)

GEOID: 2012A

GRID: NORTHING: 595245.420

EASTING: 1784823.680

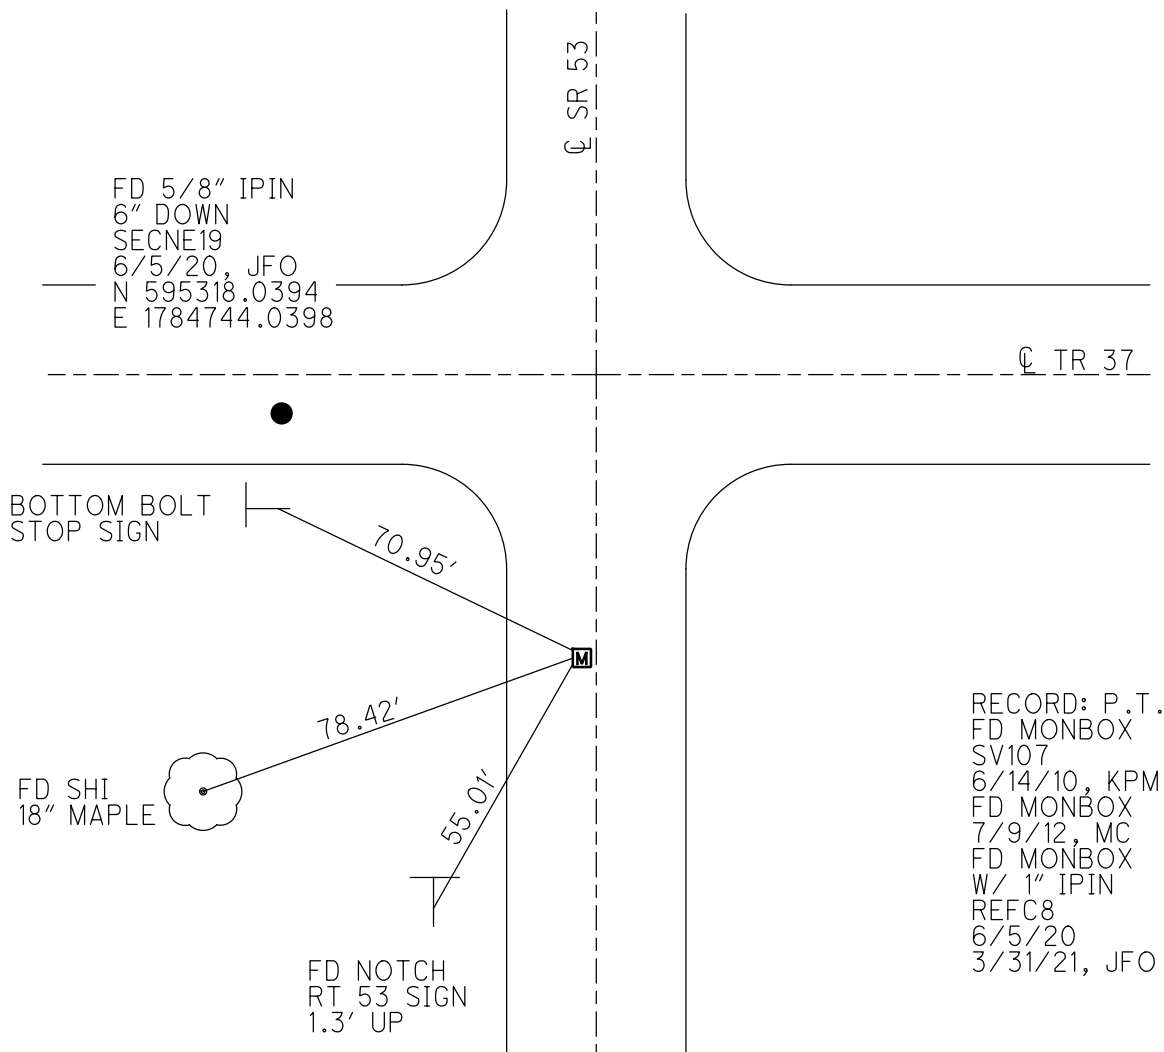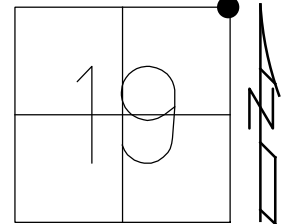

O.D.O.T. DISTRICT 2 SURVEY OFFICE (USE ONLY)

PERSONNEL _____ REFERENCE NO. 9 A SHEET 11 OF 25

NOTES RHOADES DATE 6/5/20 ROUTE SR 53
H.C. O'DONNELL WEATHER SUNNY COUNTY SANDUSKY
R.C. LEU TEMP. 73° TOWNSHIP BALLVILLE
SECTION 17

DWG BY O'DONNELL PID 101277

T 4 N R 5 E

TYPE MONUMENT MONBOX W/ 1" IPIN

ON SURFACE - ~~BELOW~~ ON

LEFT - CL PAV'T - RIGHT ON, 2.0' S. OF CL W.

- TO - EDGE PAVEMENT



STATION: 186+79.47

HORIZ.DATUM: NAD83 (2011)

GEOID: 2012A

GRID: NORTHING: 597969.005

EASTING: 1784830.471

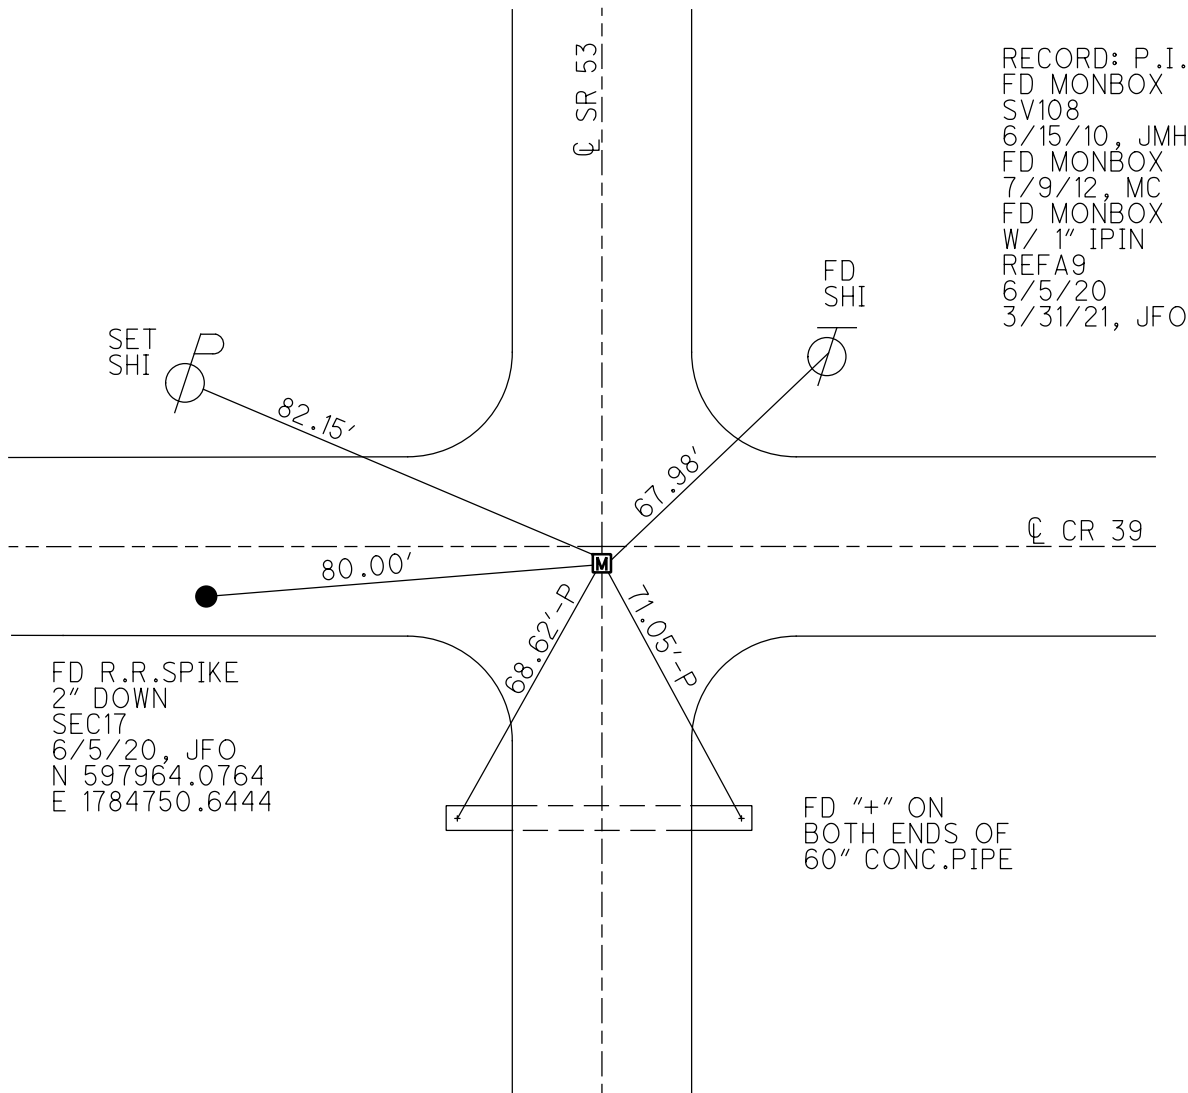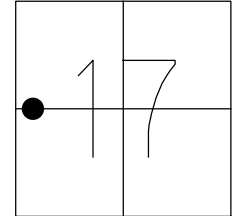

O.D.O.T. DISTRICT 2 SURVEY OFFICE (USE ONLY)

PERSONNEL

REFERENCE NO. 10

SHEET 12 OF 25

NOTES RHOADES

DATE 6/5/20

ROUTE SR 53

H.C. O'DONNELL

WEATHER SUNNY

COUNTY SANDUSKY

R.C. LEU

TEMP. 79°

TOWNSHIP BALLVILLE

SECTION 17

DWG BY O'DONNELL PID 101277

T 4 N R 5 E

TYPE MONUMENT MONBOX W/ 1" IPIN

ON SURFACE - ~~BELOW~~ ON

LEFT - ℄ PAV'T - RIGHT ON, 3.4' S. ℄ WEST

- TO - EDGE PAVEMENT 8.8' S. ℄ EAST


STATION: 213+20.23

HORIZ.DATUM: NAD83 (2011)


GEOID: 2012A

GRID: NORTHING: 600609.151

EASTING: 1784883.126

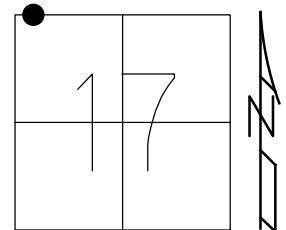

RECORD: P.I.
FD MONBOX
SV109
6/15/10, JMH
FD MONBOX
7/9/12, MC
FD MONBOX
W/ 1" IPIN
REF10
6/5/20
2/10/21, JFO


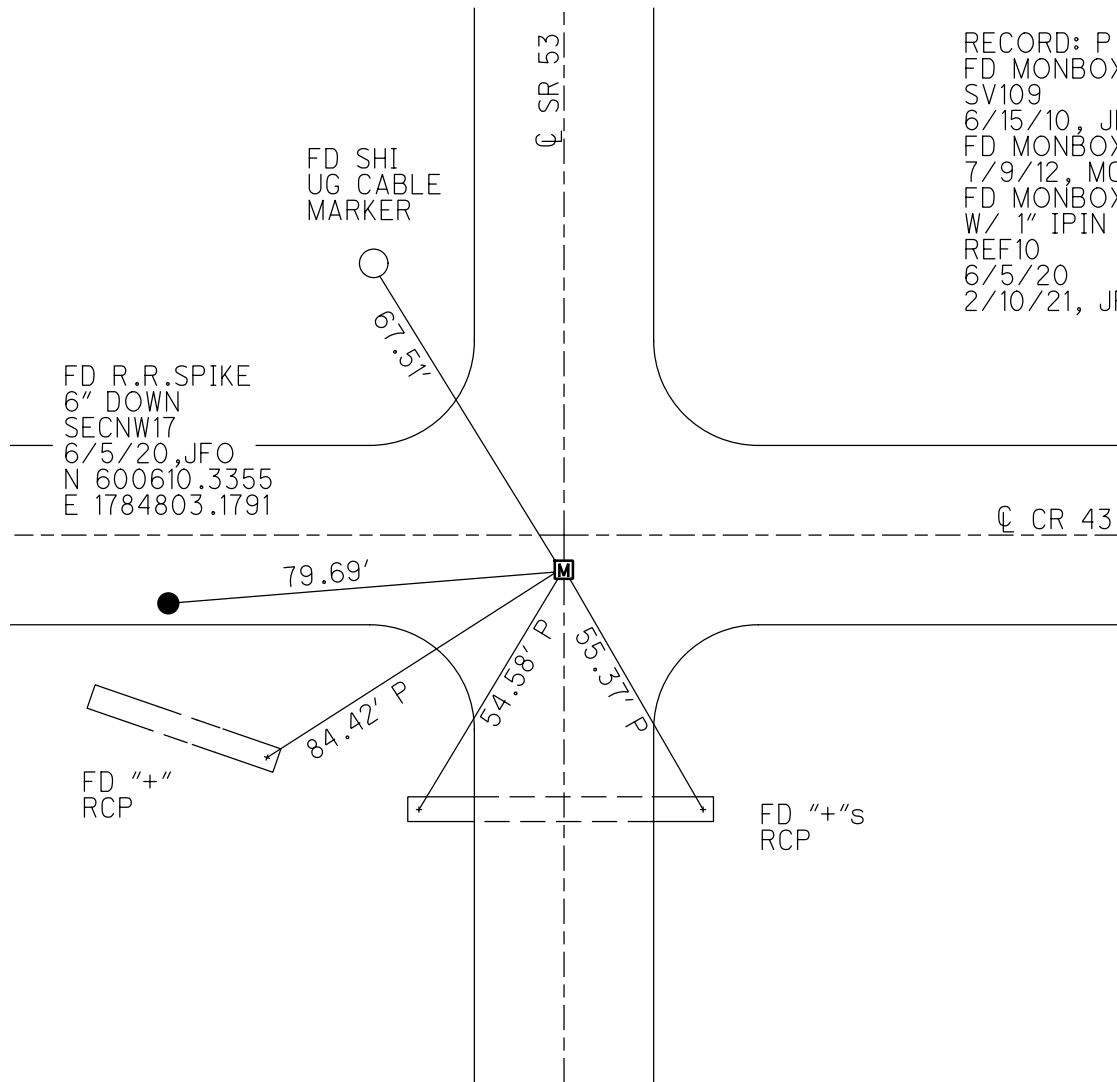


O.D.O.T. DISTRICT 2 SURVEY OFFICE (USE ONLY)

PERSONNEL _____ REFERENCE NO. 11 SHEET 13 OF 25
NOTES RHOADES DATE 6/5/20 ROUTE SR 53
H.C. O'DONNELL WEATHER SUNNY COUNTY SANDUSKY
R.C. LEU TEMP. 79° TOWNSHIP BALLVILLE
SECTION 8
DWG BY O'DONNELL PID 101277 T 4 N R 5 E

TYPE MONUMENT MONBOX W/ 1" IPIN
ON SURFACE - ~~BELOW~~ ON
LEFT - Q PAV'T - RIGHT ON
11.4' TO LT EDGE PAVEMENT
STATION: 239+67.39

HORIZ.DATUM: NAD83 (2011) GEOID: 2012A
GRID: NORTHING: 603255.640 EASTING: 1784942.145

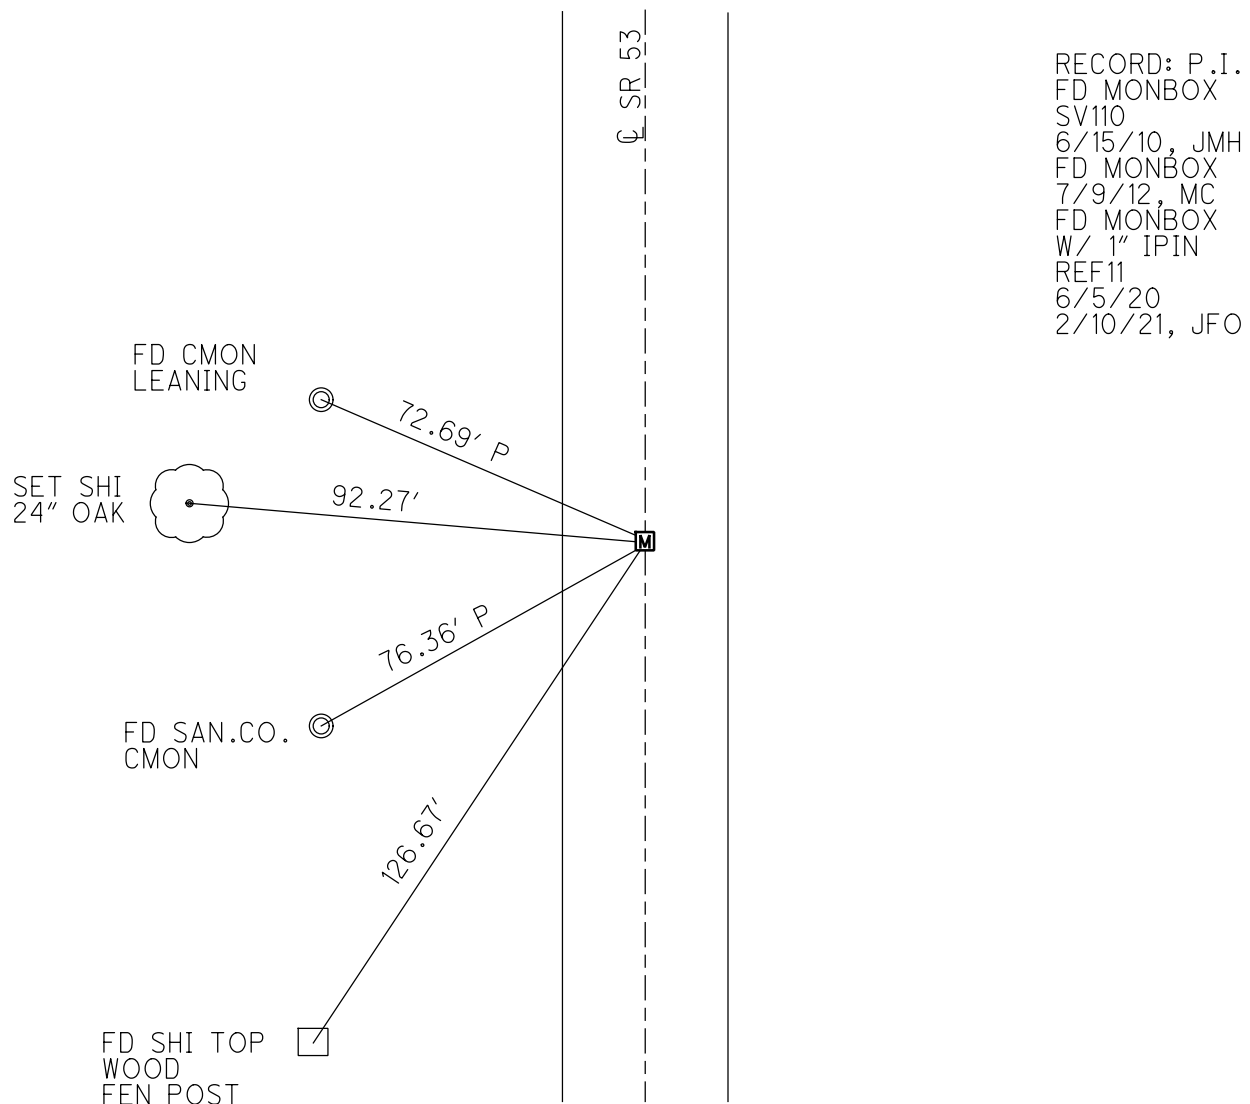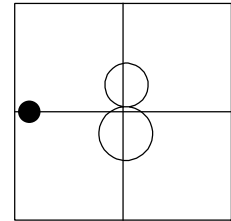

O.D.O.T. DISTRICT 2 SURVEY OFFICE (USE ONLY)

PERSONNEL

REFERENCE NO. 12

SHEET 14 OF 25

NOTES CANTERBURY

DATE 7/9/12

ROUTE SR 53

H.C. HUSS

WEATHER SUNNY

COUNTY SANDUSKY

R.C. COUTCHER

TEMP. 82°

TOWNSHIP BALLVILLE

HARBAUGH

SECTION 6

T 4 N R 5 E

TYPE MONUMENT MON.BOX


ON SURFACE - ~~BELOW~~ ON

LEFT - ℄ PAV'T - RIGHT ON


- TO - EDGE PAVEMENT

S.L.M. 318+05.32

Grid: Northing: 611090.198 Easting: 1785156.211

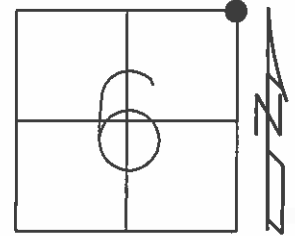

RECORD: P.I.
FD MON.BOX
GPS, SV111
6/25/10, JMH

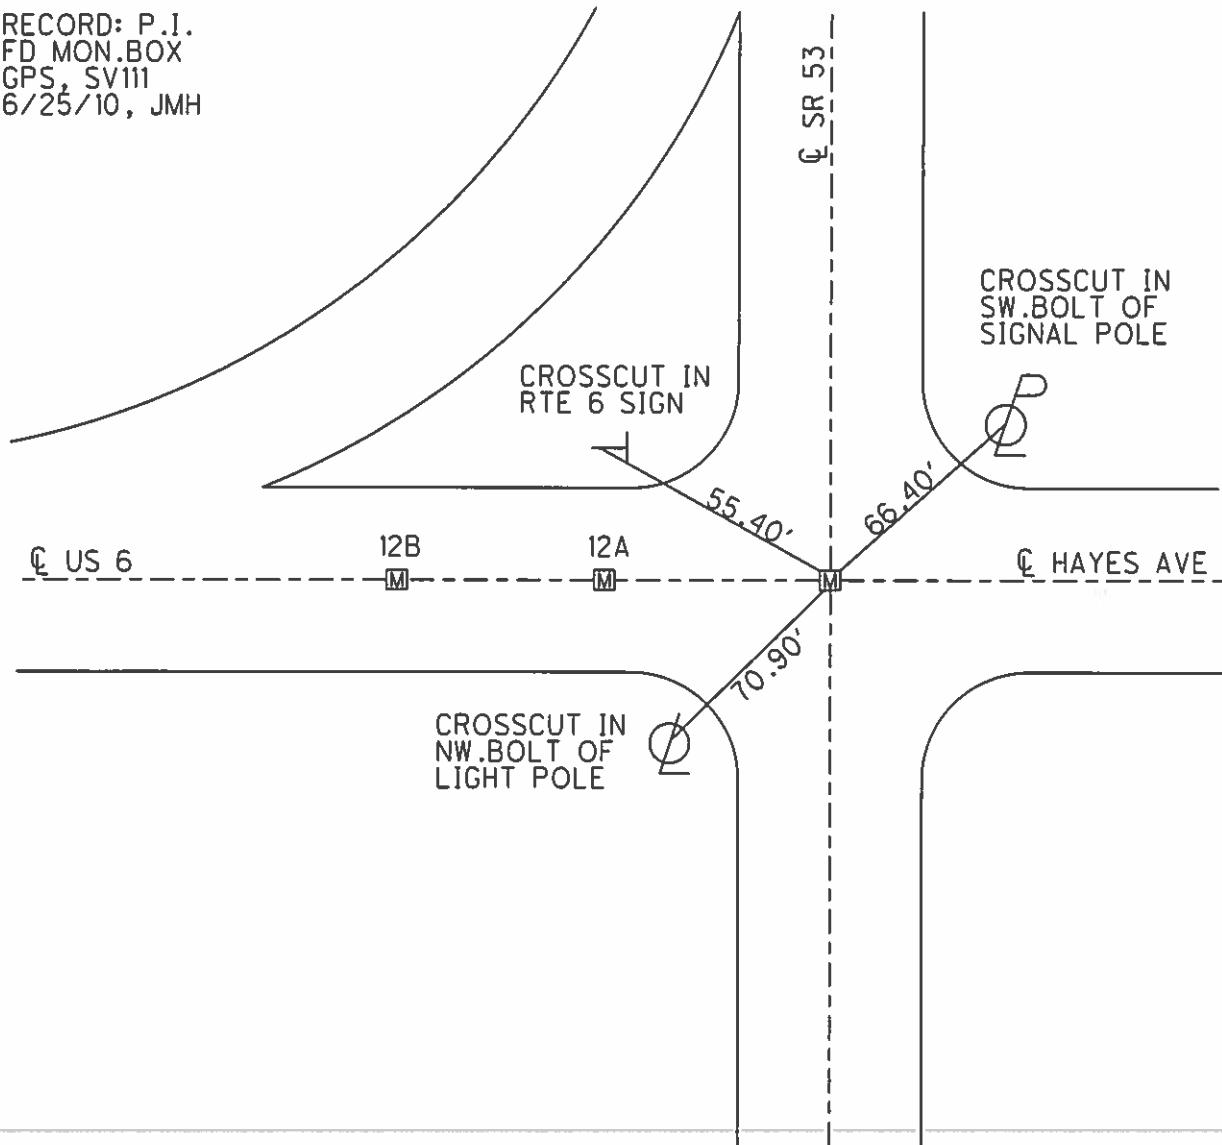

O.D.O.T. DISTRICT 2 SURVEY OFFICE (USE ONLY)

PERSONNEL

REFERENCE NO.

12 A

SHEET

15

OF 25

NOTES

CANTERBURY

DATE

7/9/12

ROUTE

SR 53

H.C.

HUSS

WEATHER

SUNNY

COUNTY

SANDUSKY

R.C.

COUTCHER

TEMP.

82°

TOWNSHIP

BALLVILLE

HARBAUGH

SECTION

6

T 4 N

R 5 E

TYPE MONUMENT

MON.BOX

ON SURFACE - ~~BELOW~~

ON



LEFT - $\odot$ PAV'T - RIGHT -

- TO - EDGE PAVEMENT

S.L.M. 318+05.32

Grid: Northing: 611090.632

Easting: 1785100.386

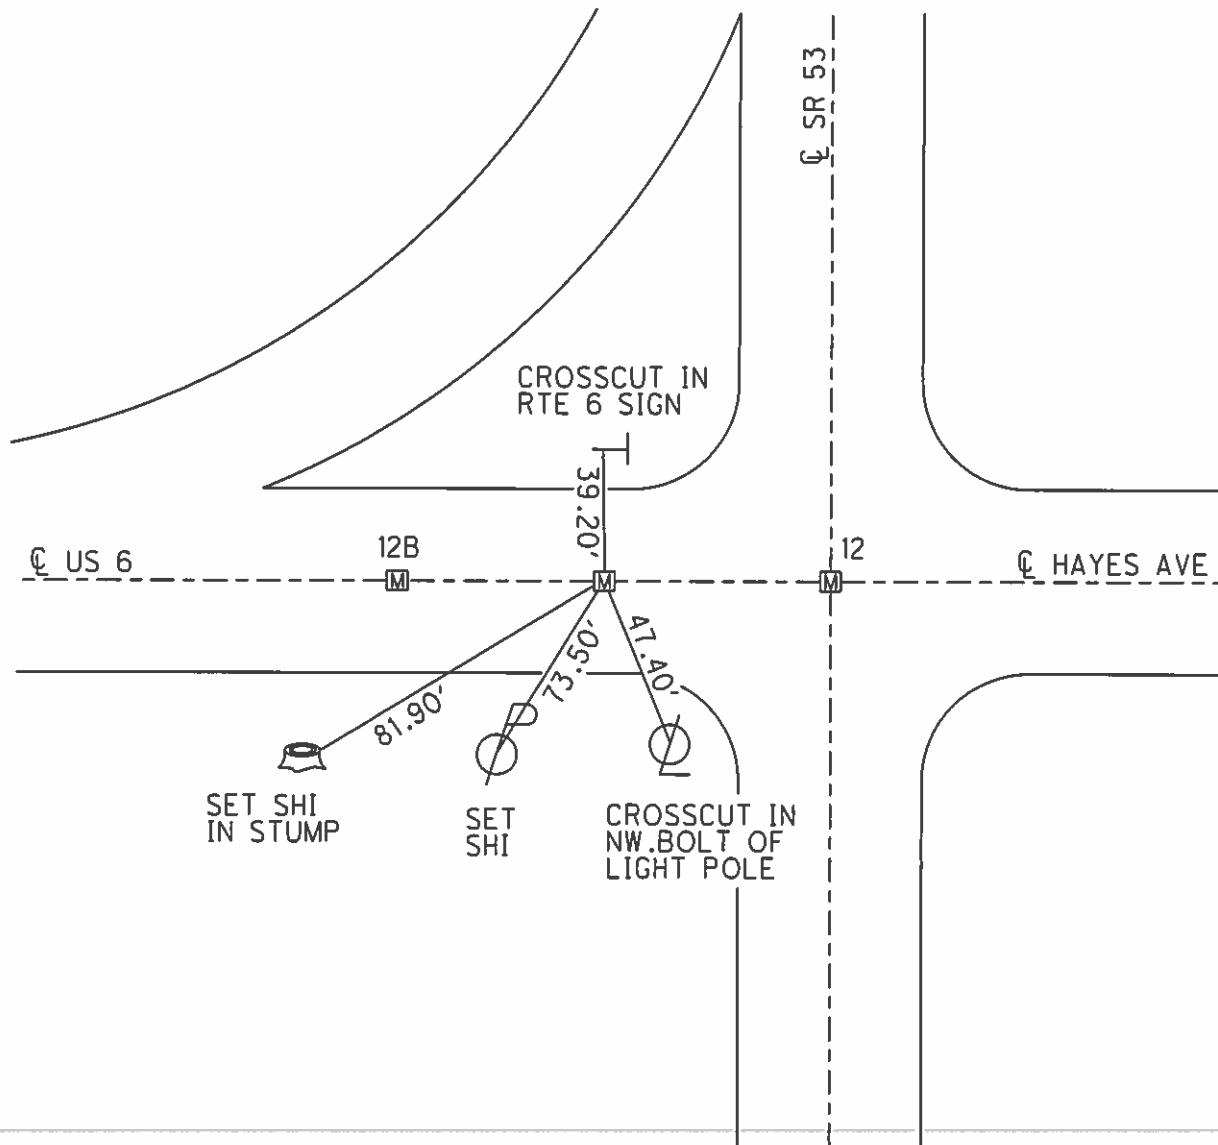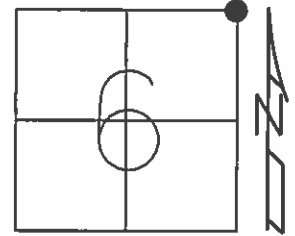

O.D.O.T. DISTRICT 2 SURVEY OFFICE (USE ONLY)

PERSONNEL

REFERENCE NO.

12 B

SHEET

16

OF 25

NOTES CANTERBURY

DATE

7/9/12

ROUTE

SR 53

H.C. HUSS

WEATHER

SUNNY

COUNTY

SANDUSKY

R.C. COUTCHER

TEMP.

82°

TOWNSHIP

BALLVILLE

HARBAUGH

SECTION

6

T 4 N R 5 E

TYPE MONUMENT MON.BOX



ON SURFACE - ~~BELOW~~ ON

LEFT - CL PAV'T - RIGHT -

- TO - EDGE PAVEMENT

S.L.M. 318+05.32

Grid: Northing: 611091.276 Easting: 1785066.210

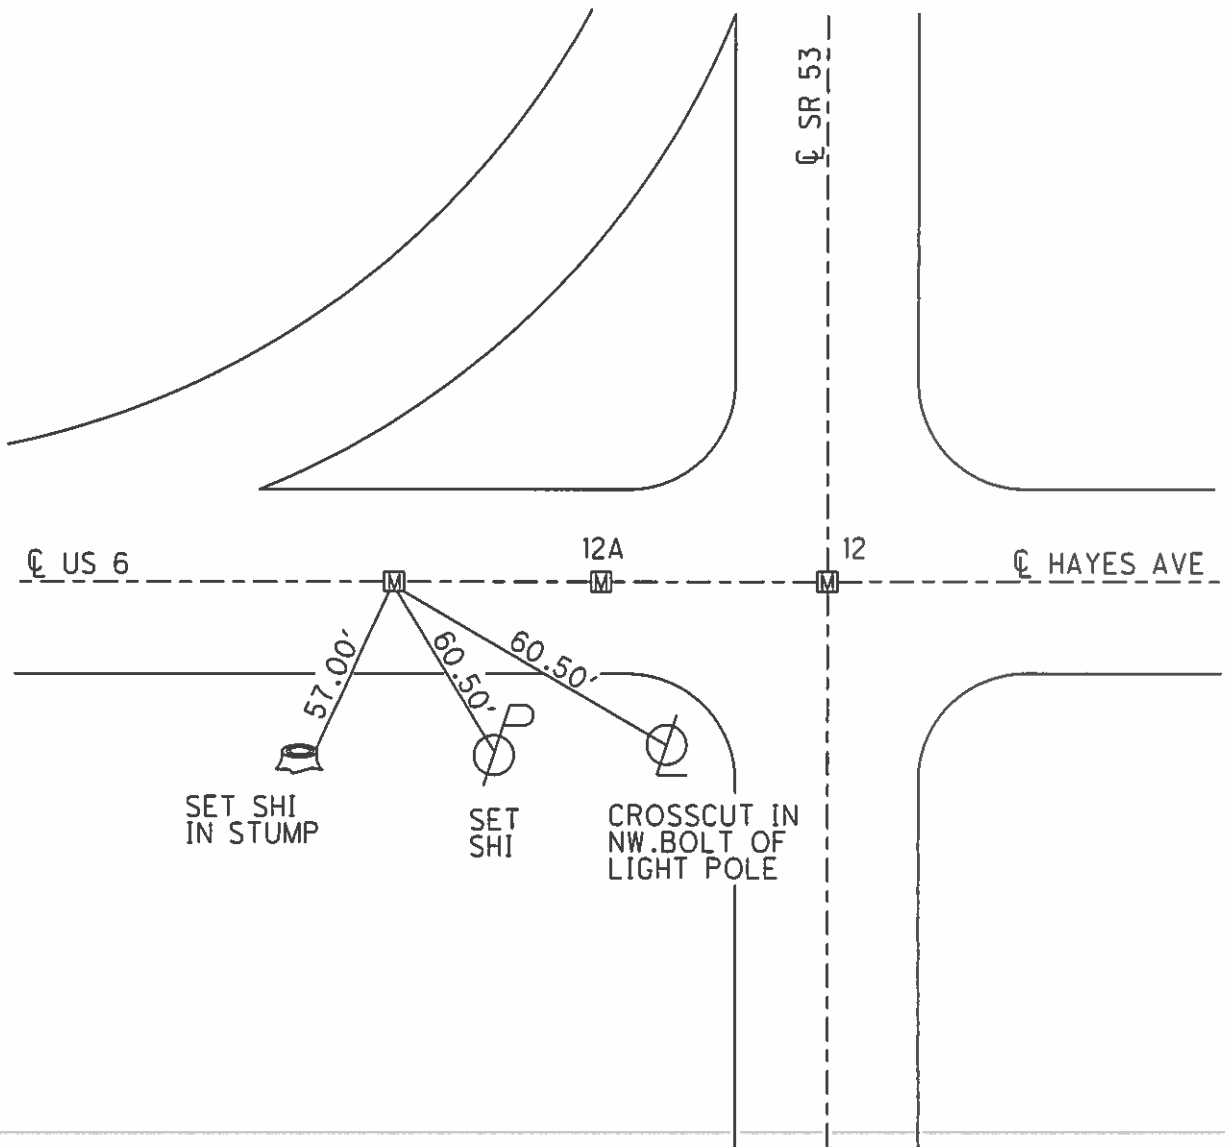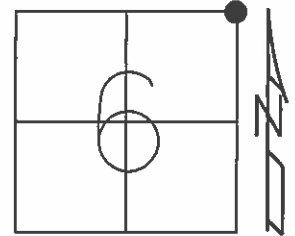

O.D.O.T. DISTRICT 2 SURVEY OFFICE (USE ONLY)

PERSONNEL

REFERENCE NO.

13

SHEET 17 OF 25

NOTES CANTERBURY

DATE

7/12/12

ROUTE SR 53

H.C. HUSS

WEATHER

SUNNY

COUNTY SANDUSKY

R.C. COUTCHER

TEMP.

75°

TOWNSHIP SANDUSKY

HARBAUGH

SECTION 31

T 5 N R 15 E

TYPE MONUMENT MAG/WASHER


ON SURFACE - ~~BELOW~~ ON

LEFT - Q PAV'T - ~~RIGHT~~ 1.3'

10.8' TO LT EDGE PAVEMENT


S.L.M. 328+09.60

Grid: Northing: 612090.424 Easting: 1785237.882

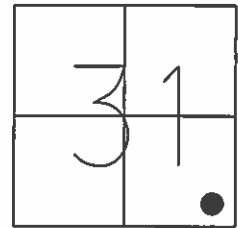

RECORD: P.O.C.
FD MAG/WASHER
ON SURFACE
GPS, SV120
7/29/10, KPM

FD
IPINS

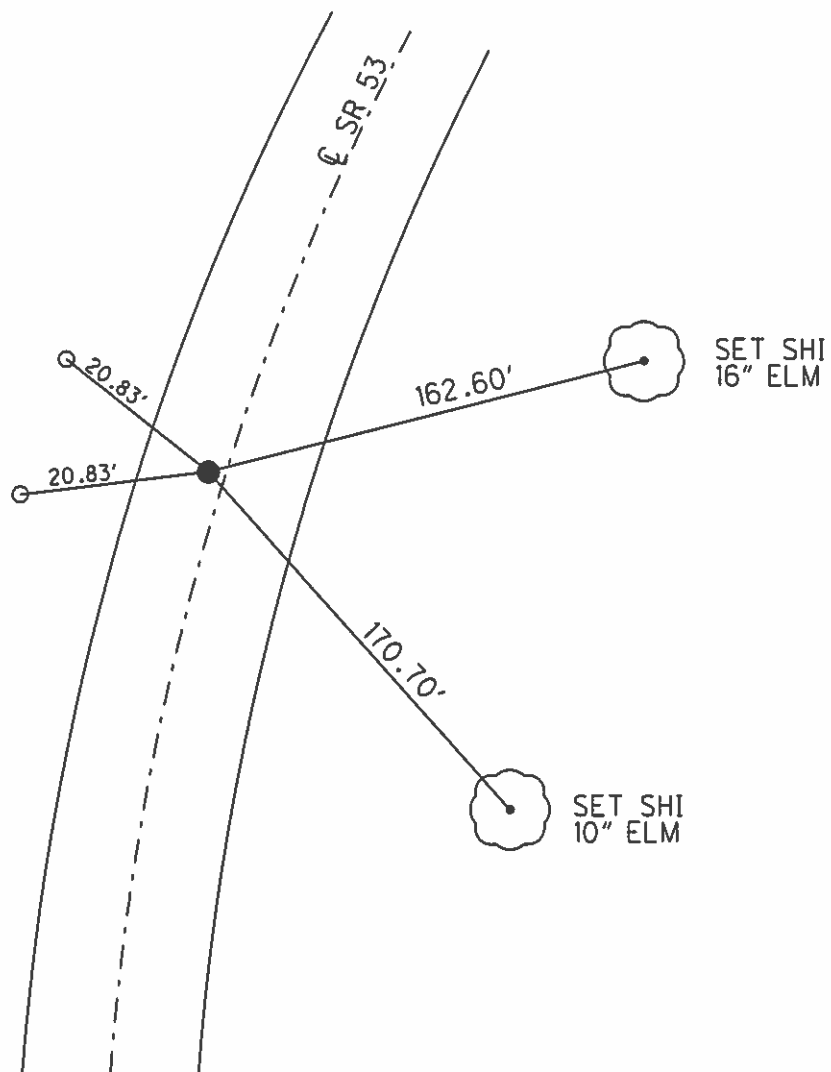

O.D.O.T. DISTRICT 2 SURVEY OFFICE (USE ONLY)

PERSONNEL

REFERENCE NO.

14

SHEET 18 OF 25

18

25

NOTES CANTERBURY

DATE _____

7/12/12

ROUTE

SR 53

H.C. HUSS

WEATHER

SUNNY

COUNTY

SANDUSKY

R.C. COUTCHER

TEMP.

75°

TOWNSHIP

P SANDUSKY

SECTION

31

T_5_N R_15_E

R 15 E

TYPE MONUMENT MAG/WASHER

MAG/WASHER

ON SURFACE - ~~BELOW~~ ON

~~BELOW~~ ON

LEFT - C PAV'T - RIGHT__ON

HT ON

12.6' TO LT EDGE PAVEMENT

S.L.M. 334+55.75

$$334 + 55.75$$

Grid: Northing: 612694.239 Easting: 1785467.936

Easting: 1785467.936


1785467.936

RECORD: S.T.
FD MAG/WASHER
ON SURFACE
GPS, SV119
7/29/10, KPM



FD IPINS BENT
TIP, CLOSE END

SET SHI
TWIN
12" ELM

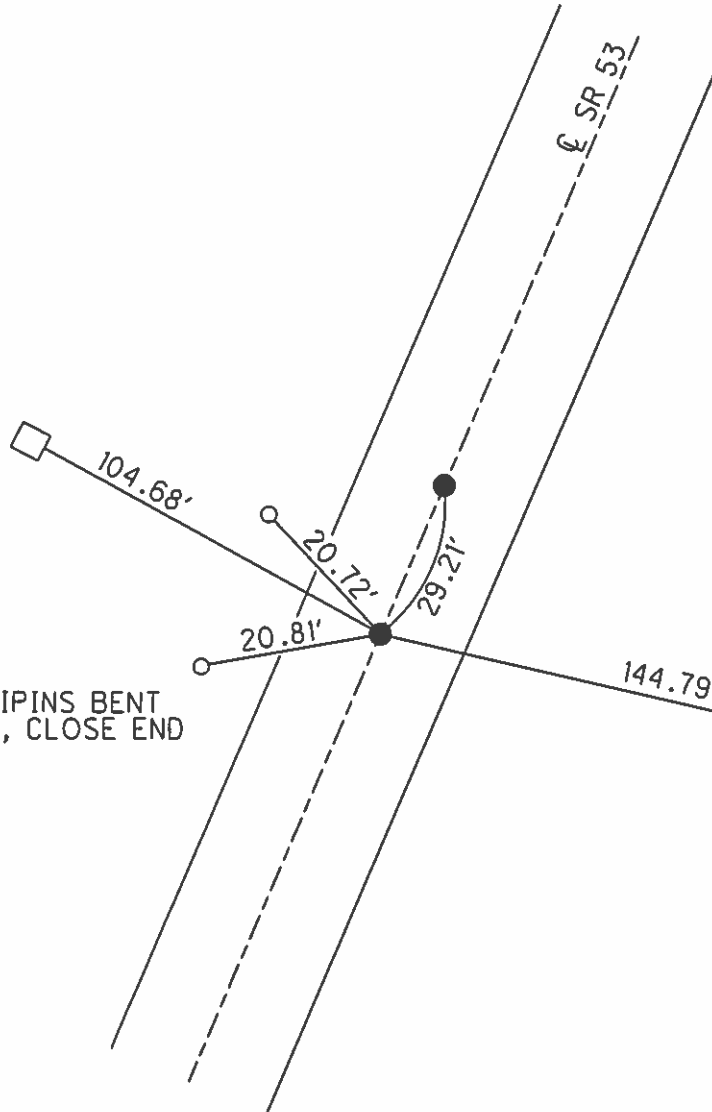

O.D.O.T. DISTRICT 2 SURVEY OFFICE (USE ONLY)

PERSONNEL

REFERENCE NO. 15

SHEET 19 OF 25

NOTES CANTERBURY

DATE 7/12/12

ROUTE SR 53

H.C. HUSS

WEATHER SUNNY

COUNTY SANDUSKY

R.C. COUTCHER

TEMP. 75°

TOWNSHIP SANDUSKY

HARBAUGH

SECTION 31

T 5 N R 15 E

TYPE MONUMENT MAG NAIL


ON SURFACE - ~~BELOW~~ ON

LEFT - Q PAV'T - RIGHT ON

12.6' TO LT EDGE PAVEMENT

S.L.M. 334+84.96


Grid: Northing: 6112720.679 Easting: 1785480.354

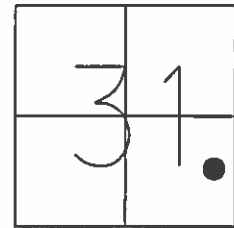

RECORD: T.S.
FD MAG NAIL
ON SURFACE
GPS, SV118
7/29/10, KPM

SET SHI TOP
OF WOOD
FENCE POST

FD IPINS BENT
TIP, CLOSE END


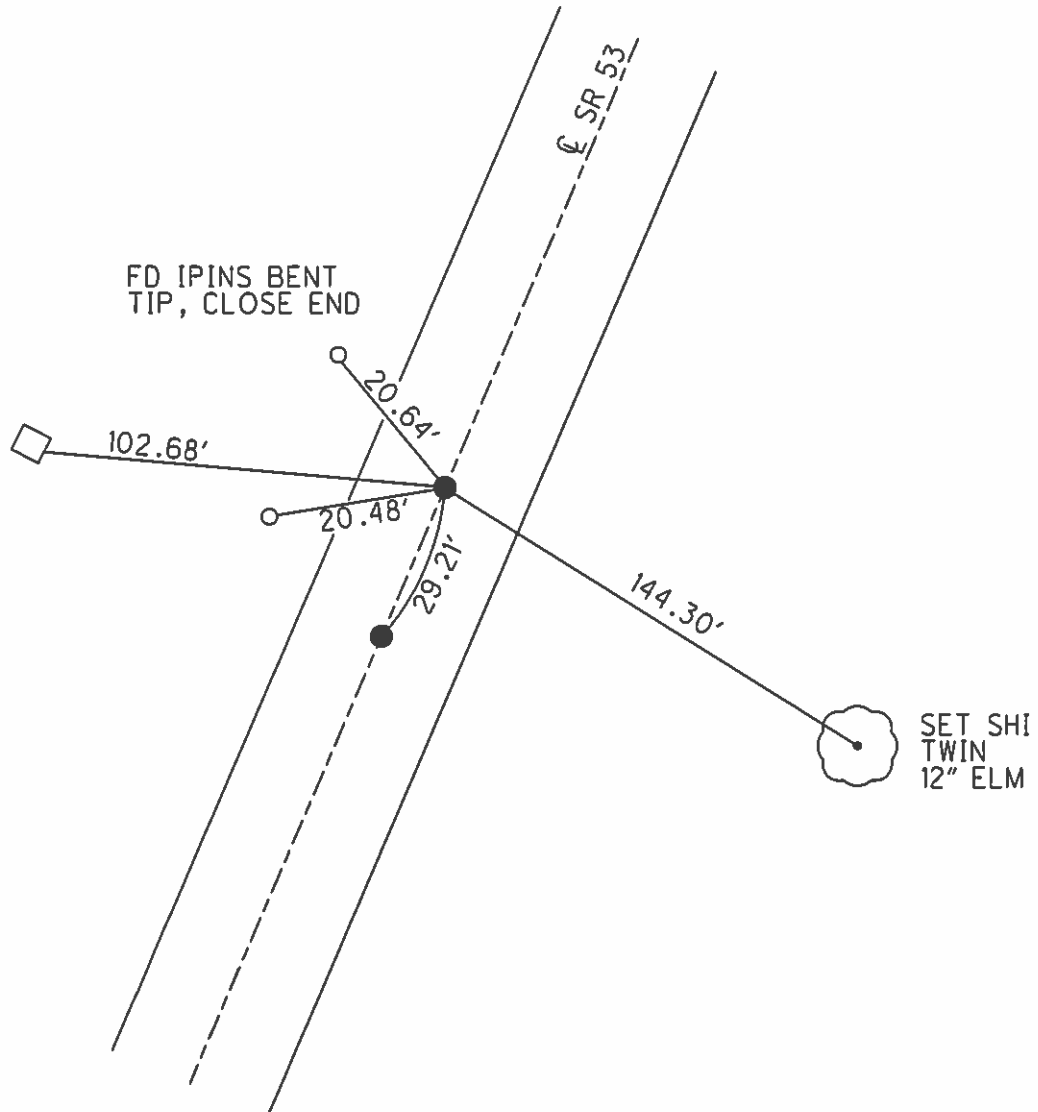


O.D.O.T. DISTRICT 2 SURVEY OFFICE (USE ONLY)

PERSONNEL _____ REFERENCE NO. 16 SHEET 20 OF 25
NOTES WESTFALL DATE 10/9/14 ROUTE SR 53
H.C. HOMAN WEATHER FAIR COUNTY SANDUSKY
R.C. WESTFALL TEMP. 54° TOWNSHIP SANDUSKY
SECTION 31
T 5 N R 15 E

TYPE MONUMENT MAG/WASHER
ON SURFACE - ~~BELOW~~ ON
LEFT - CL PAV'T - RIGHT ON
11.5' TO LT EDGE PAVEMENT
S.L.M. 469+00.48

Grid: Northing: 614978.273 Easting: 1785798.495

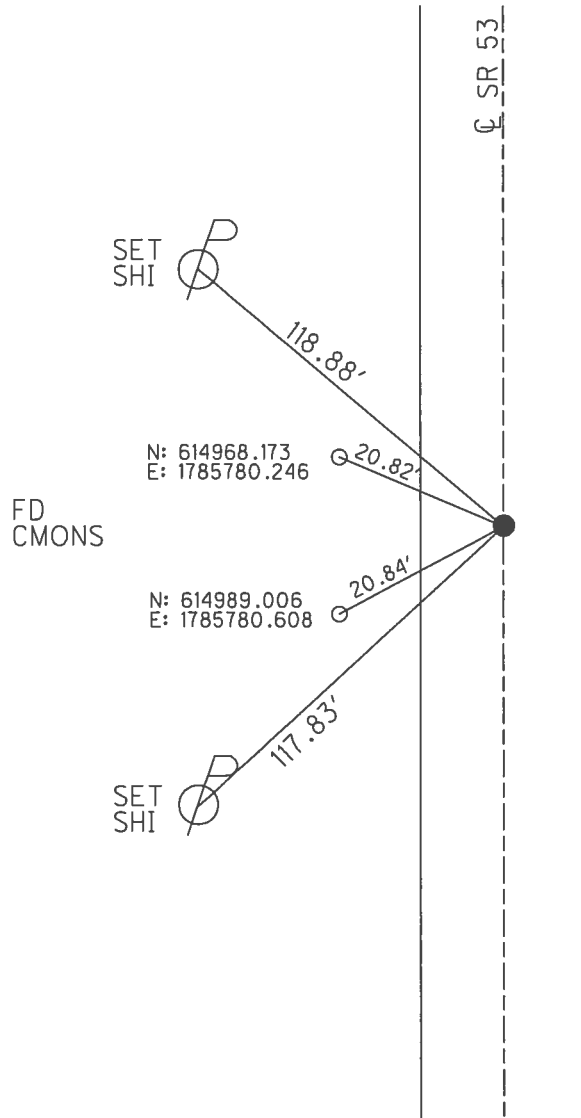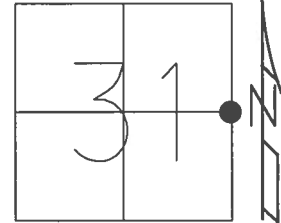

RECORD: P.O.T.
FD P.K.SHANK
SET MAG/WASHER
7/15/12
GPS, SV117
7/29/10, KPM
SET MAG/WASHER
CKREF16
10/9/14, DCH
SET MAG/WASHER
REF16
9/7/17, JLL

O.D.O.T. DISTRICT 2 SURVEY OFFICE (USE ONLY)

PERSONNEL

REFERENCE NO. 16A

SHEET OF

NOTES MILLER
H.C. MILLER
R.C. BARRIERE
BLUBAUGH

DATE 8/9/24
WEATHER SUNNY
TEMP. 66

ROUTE SR 53
COUNTY SANDUSKY
TOWNSHIP SANDUSKY
SECTION 31

DWG BY MILLER PID 114849

T 5 N R 15 E

TYPE MONUMENT MAG NAIL

ON SURFACE - BELOW ON

OFFSET Q PAVEMENT ON LT : RT

 TO EDGE PAVEMENT

STATION: 473+21.74

HORIZ.DATUM: NAD83 (11)


GEOID: 18

GRID: NORTHING: 615399.639


EASTING: 1785805.306

LDP: NORTHING: 311291.155

EASTING: 146066.962

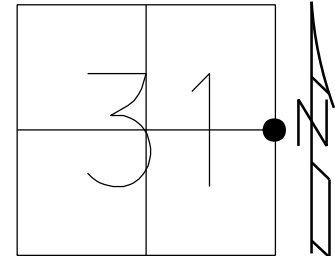

RECORD: P.O.T.
Q US 6 & SR 53
STA.473+21.74
Q PROPOSED STREET
STA.100+00.00
FD MAG NAIL
CKDK01
9/7/17, JLL
REF16A
12/20/23, JAM
8/9/24, JAM

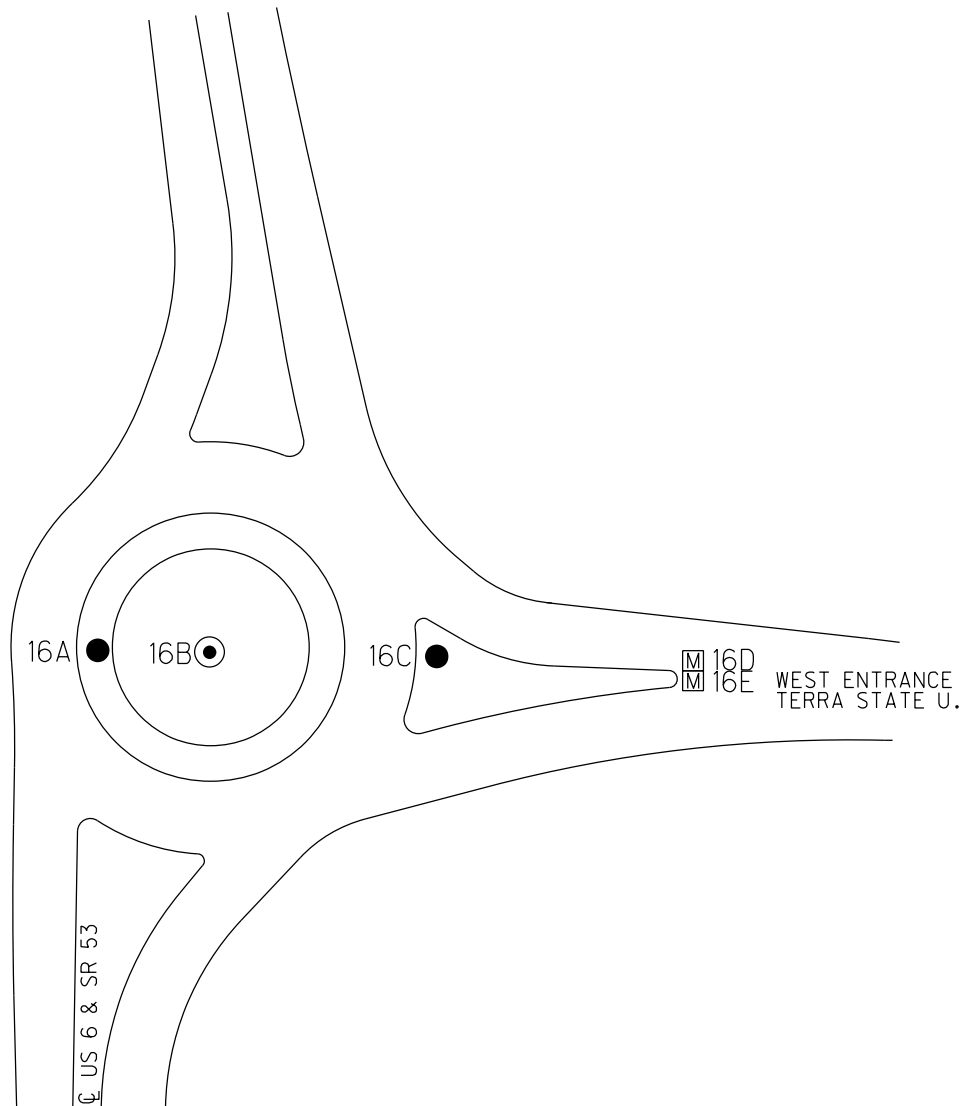

O.D.O.T. DISTRICT 2 SURVEY OFFICE (USE ONLY)

PERSONNEL

REFERENCE NO. 16B

SHEET OF

NOTES MILLER

DATE 8/9/24

ROUTE SR 53

H.C. MILLER

WEATHER SUNNY

COUNTY SANDUSKY

R.C. BARRIERE

TEMP. 66

TOWNSHIP SANDUSKY

BLUBAUGH

SECTION 31

DWG BY MILLER

PID 114849

T 5 N R 15 E

TYPE MONUMENT CMON W/ 2" ODOT DISK

ON SURFACE - BELOW ON

OFFSET $\varnothing$ PAVEMENT 48.23' ~~LF~~ : RT

 TO EDGE PAVEMENT

STATION: 473+20.75

HORIZ.DATUM: NAD83 (11)


GEOID: 18

GRID: NORTHING: 615397.839


EASTING: 1785853.492

LDP: NORTHING: 311289.686

EASTING: 146115.162

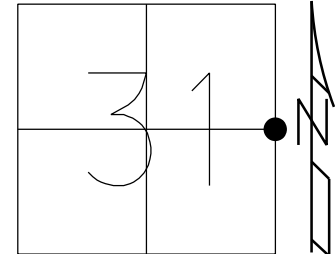

RECORD:
C CONST. US 6 & SR 53
STA. 473+20.75
C PROPOSED STREET
STA. 100+48.24
FD CMON W/ DISK
CL1
9/7/17, JLL
REF16B
12/20/23, JAM
8/9/24, JAM

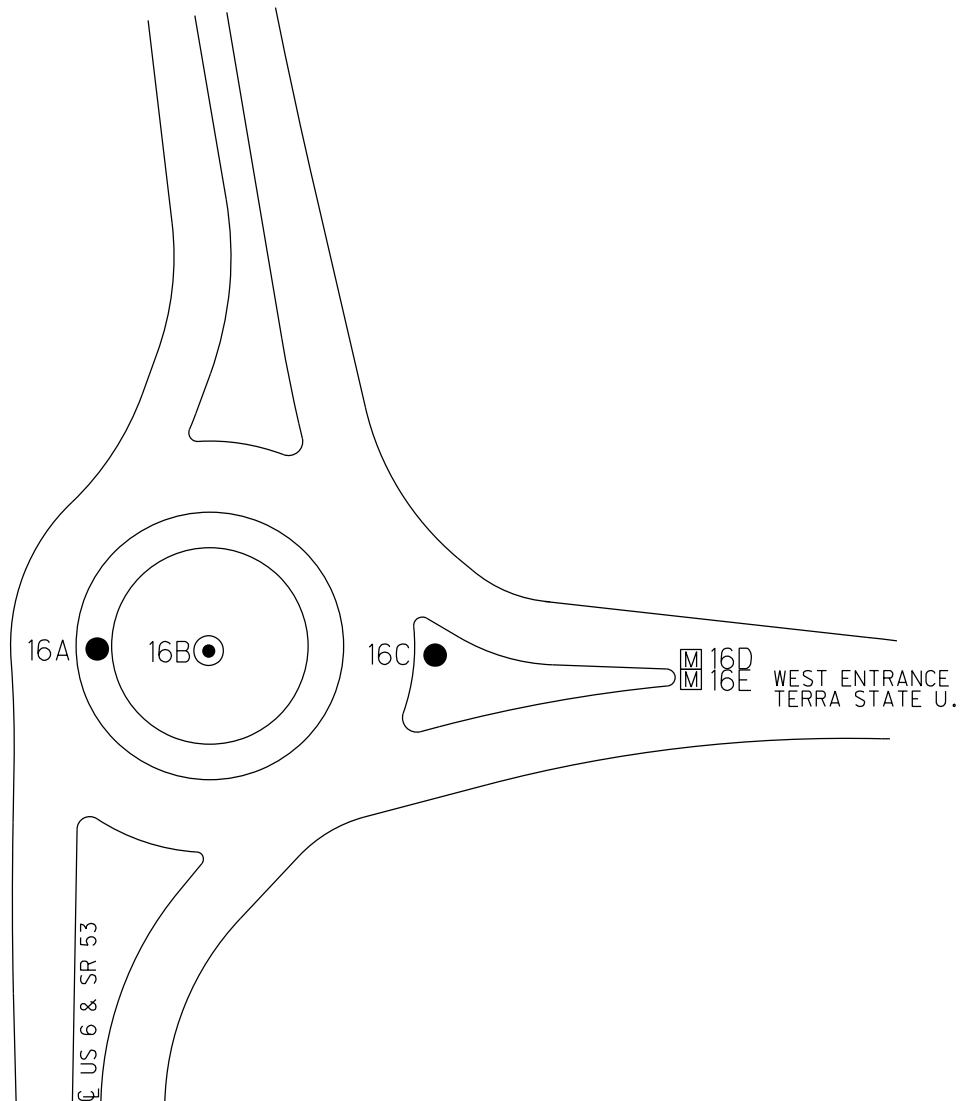

O.D.O.T. DISTRICT 2 SURVEY OFFICE (USE ONLY)

PERSONNEL

REFERENCE NO. 16C

SHEET OF

NOTES MILLER
H.C. MILLER
R.C. BARRIERE
BLUBAUGH

DATE 8/9/24
WEATHER SUNNY
TEMP. 66

ROUTE SR 53
COUNTY SANDUSKY
TOWNSHIP SANDUSKY
SECTION 32

DWG BY MILLER PID 114849

T 5 N R 15 E

TYPE MONUMENT MAG NAIL

ON SURFACE - BELOW ON

OFFSET $\varnothing$ PAVEMENT 130' ~~LT~~ : RT

 TO EDGE PAVEMENT

STATION: 473+19.07

HORIZ.DATUM: NAD83 (11)


GEOID: 18

GRID: NORTHING: 615390.905


EASTING: 1785939.035

LDP: NORTHING: 311283.340

EASTING: 146200.757

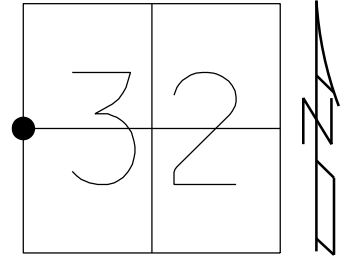

RECORD:
STA.473+19.07
SET MAG NAIL
PRW51
9/7/17, JLL
FD MAG NAIL
REF16C
12/20/23, JAM
8/9/24, JAM

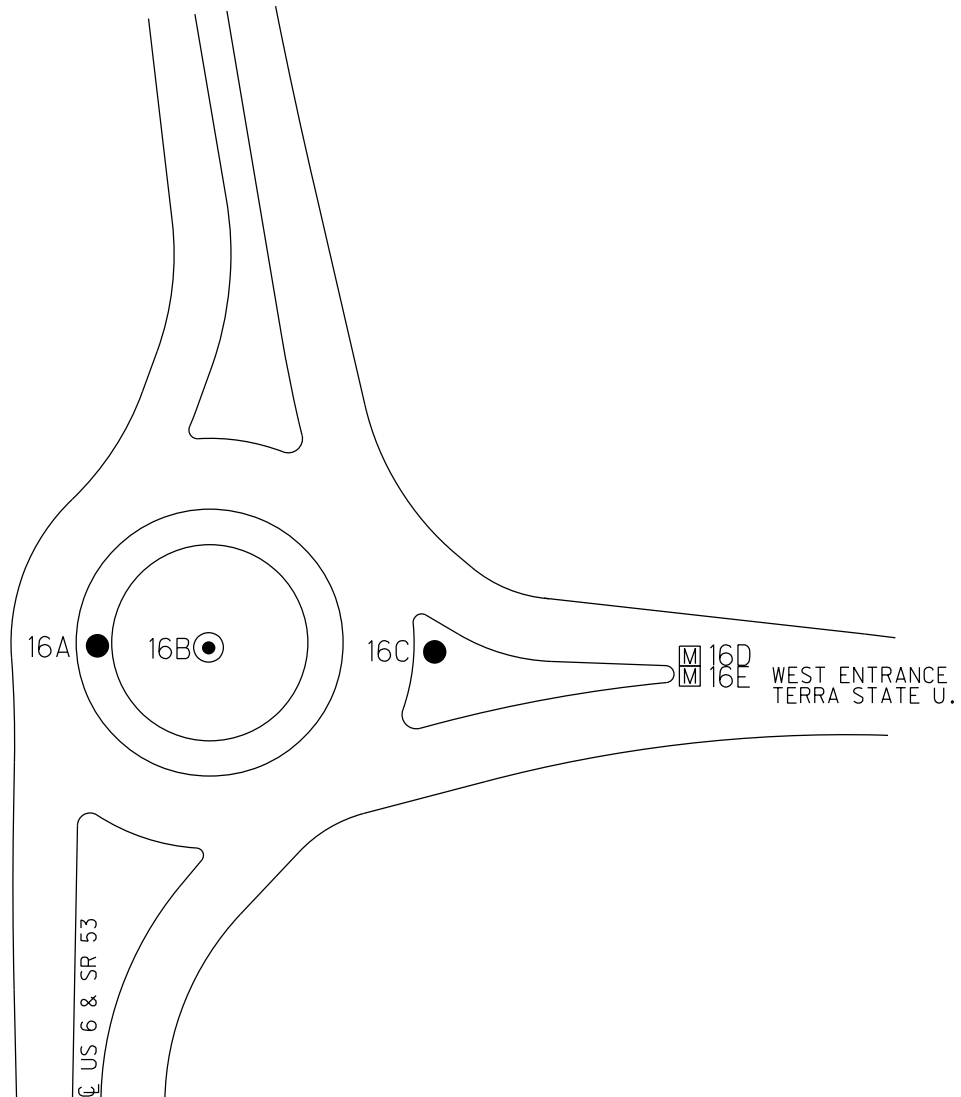

O.D.O.T. DISTRICT 2 SURVEY OFFICE (USE ONLY)

PERSONNEL

REFERENCE NO. 16D

SHEET OF

NOTES MILLER
H.C. MILLER
R.C. BARRIERE
BLUBAUGH

DATE 8/9/24
WEATHER SUNNY
TEMP. 66

ROUTE SR 53
COUNTY SANDUSKY
TOWNSHIP SANDUSKY
SECTION 32
T 5 N R 15 E

DWG BY MILLER PID 114849

TYPE MONUMENT MONBOX W/ 1" IPIN

ON SURFACE - BELOW ON

OFFSET $\odot$ PAVEMENT 218.68' ~~LT~~ : RT

 TO EDGE PAVEMENT

STATION: 473+17.25

HORIZ.DATUM: NAD83 (11)


GEOID: 18

GRID: NORTHING: 615391.510


EASTING: 1786023.887

LDP: NORTHING: 311284.528

EASTING: 146285.610

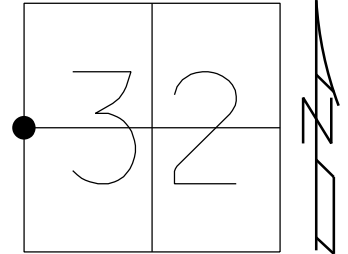

RECORD:
STA.473+17.25
P.C. PROPOSED STREET
STA.102+18.73
0.00' RT
FD MONBOX W/1" IPIN
CKDK02
9/7/17, JLL
REF16D
12/20/23, JAM
8/9/24, JAM

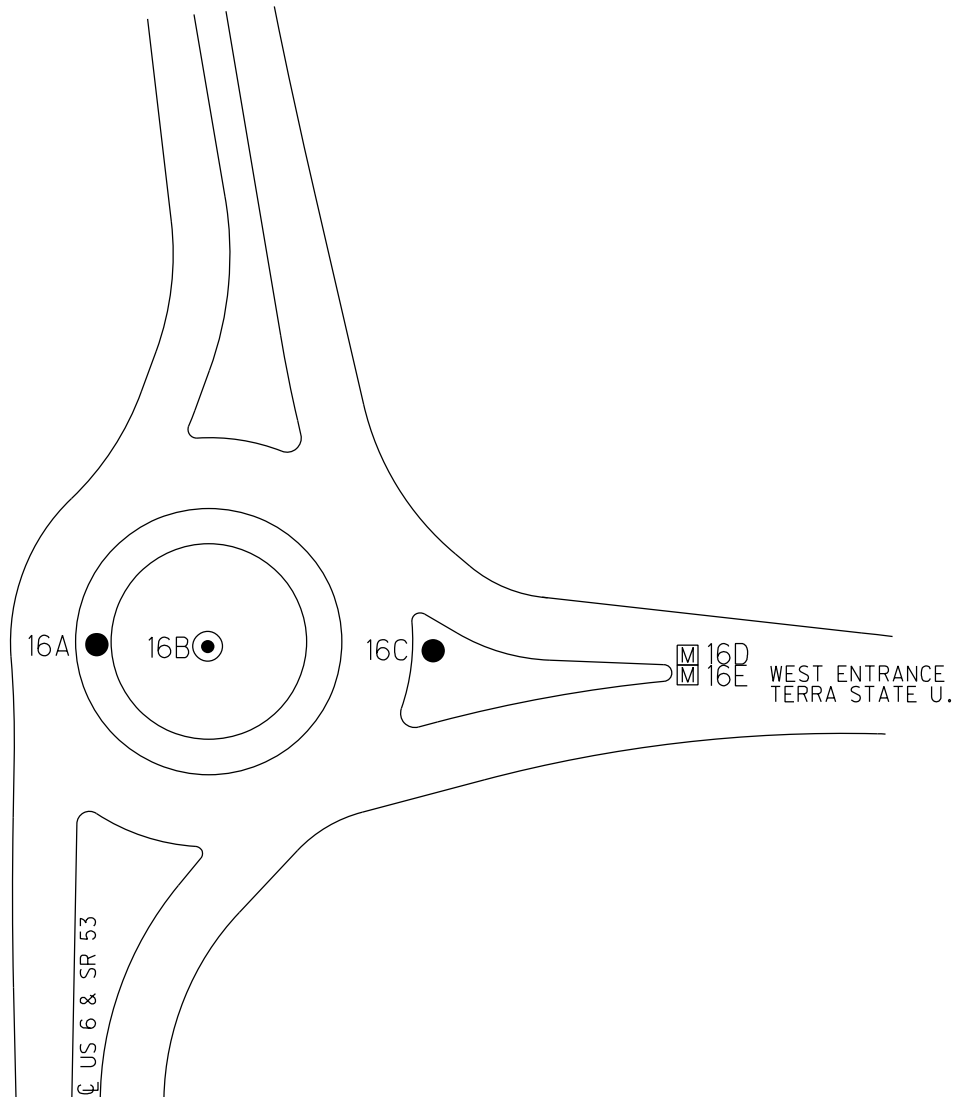

O.D.O.T. DISTRICT 2 SURVEY OFFICE (USE ONLY)

PERSONNEL

REFERENCE NO. 16E

SHEET OF

NOTES MILLER

DATE 8/9/24

ROUTE SR 53

H.C. MILLER

WEATHER SUNNY

COUNTY SANDUSKY

R.C. BARRIERE

TEMP. 66

TOWNSHIP SANDUSKY

BLUBAUGH

SECTION 32

DWG BY MILLER

PID 114849

T 5 N R 15 E

TYPE MONUMENT MONBOX W/ 1" IPIN

ON SURFACE - BELOW ON

OFFSET $\odot$ PAVEMENT 218.68' ~~LT~~ : RT

 TO EDGE PAVEMENT

STATION: 473+17.25

HORZ.DATUM: NAD83 (11)


GEOID: 18

GRID: NORTHING: 615385.439


EASTING: 1786023.644

LDP: NORTHING: 311278.455

EASTING: 146285.409

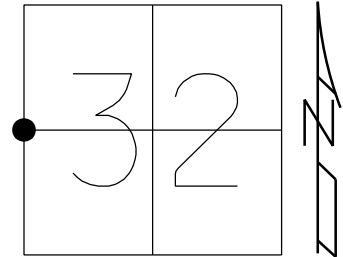

RECORD:
UNKNOWN ORIGIN
FD MONBOX W/1" IPIN
REF16E
12/20/23, JAM
8/9/24, JAM

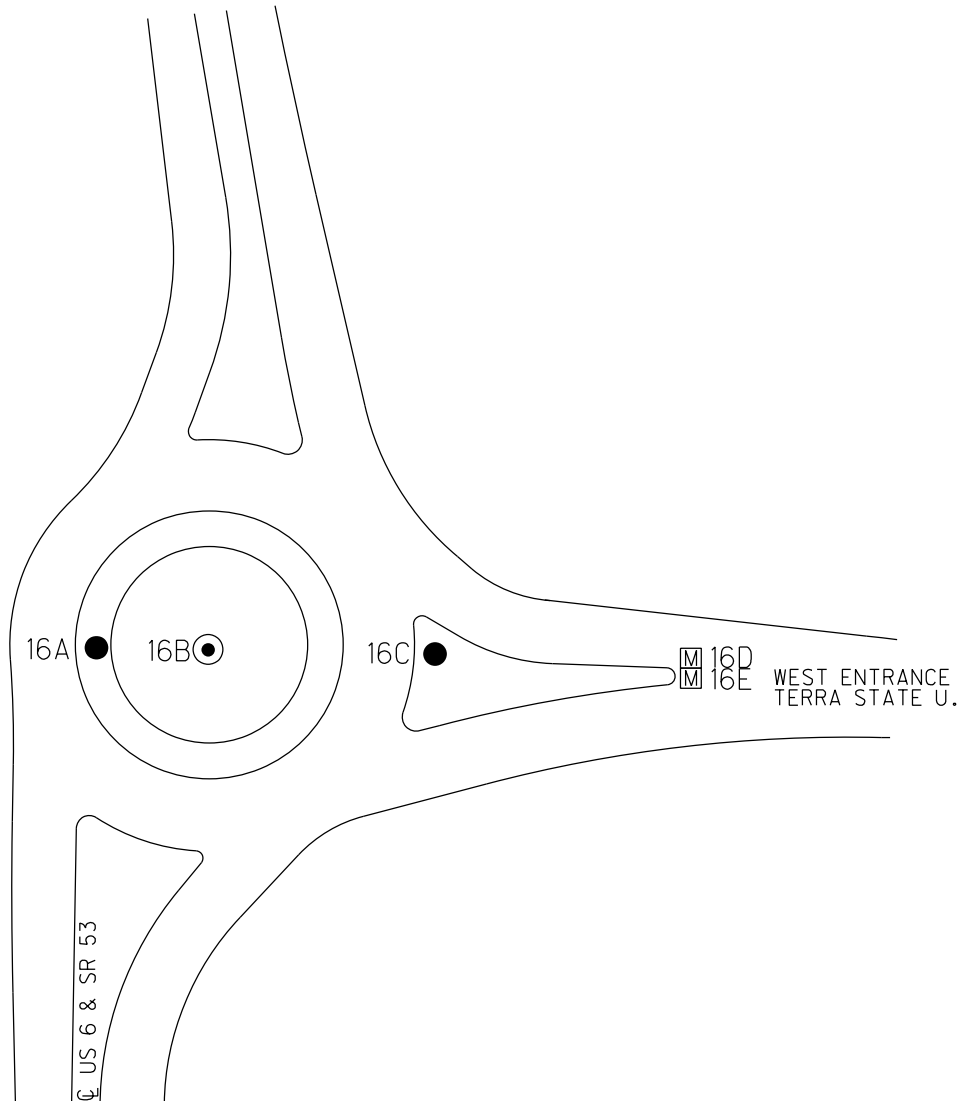

O.D.O.T. DISTRICT 2 SURVEY OFFICE (USE ONLY)

PERSONNEL

REFERENCE NO. 17

SHEET 25 OF 30

NOTES WESTFALL

DATE 10/9/14

ROUTE SR 53

H.C. HOMAN

WEATHER FAIR

COUNTY SANDUSKY

R.C. WESTFALL

TEMP. 54°

TOWNSHIP SANDUSKY

SECTION 31

DWG BY RHOADES

PID 111020

T 5 N R 15 E

TYPE MONUMENT MAG/WASHER

ON SURFACE - ~~BELOW~~ ON

OFFSET Q PAVEMENT 0.3' LT : ~~RT~~

11.6' TO RT EDGE PAVEMENT


STATION: 479+00.36

HORZ.DATUM: NAD83 2011

GEOID: NAVD88 2012A

GRID: NORTHING: 615978.064

EASTING: 1785815.100

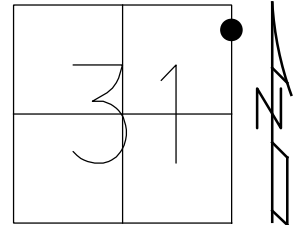

SET
SHI

132.52'

Q SR 53

FD 1 1/4" IPIN
1.3' DOWN
N: 615988.708
E: 1785797.299

Q 20.73'

FD CMON W/1" IPIN
1.3' DOWN
N: 615967.967
E: 1785796.913

Q 20.80'

135.68'

SET
SHI

RECORD: P.O.T.
SET MAG/WASHER
7/15/12
GPS, SV116
7/29/10, KPM
SET MAG/WASHER
CKREF17
10/9/14, DCH
SET MAG/WASHER
REF17
9/15/17, JLL

O.D.O.T. DISTRICT 2 SURVEY OFFICE (USE ONLY)

PERSONNEL

REFERENCE NO. 18

SHEET 26 OF 30

NOTES AUBLE

DATE 6/3/22

ROUTE SR 53

H.C. NIESE

WEATHER FAIR

COUNTY SANDUSKY

R.C. WHITAKER

TEMP. 63°

TOWNSHIP SANDUSKY

SECTION 30

DWG BY RHOADES

PID 111020

T 5 N R 15 E

TYPE MONUMENT MAG/WASHER

ON SURFACE - ~~BELOW~~ ON

OFFSET Q PAVEMENT 0.3' LT : ~~RT~~

11.6' TO LT EDGE PAVEMENT


STATION: 488+22.7

HORZ.DATUM: NAD83 2011

GEOID: NAVD88 2018

GRID: NORTHING: 616900.212

EASTING: 1785830.408

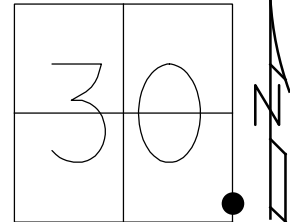

RECORD: T.S.

SV115

7/29/10, KPM

SET MAG/WASHER

7/19/12

SET MAG/WASHER

CKREF18

10/9/14, DCH


SET MAG/WASHER

REF18

6-2-22, TDN

FD MAG/WASHER

1-4-23, TDN

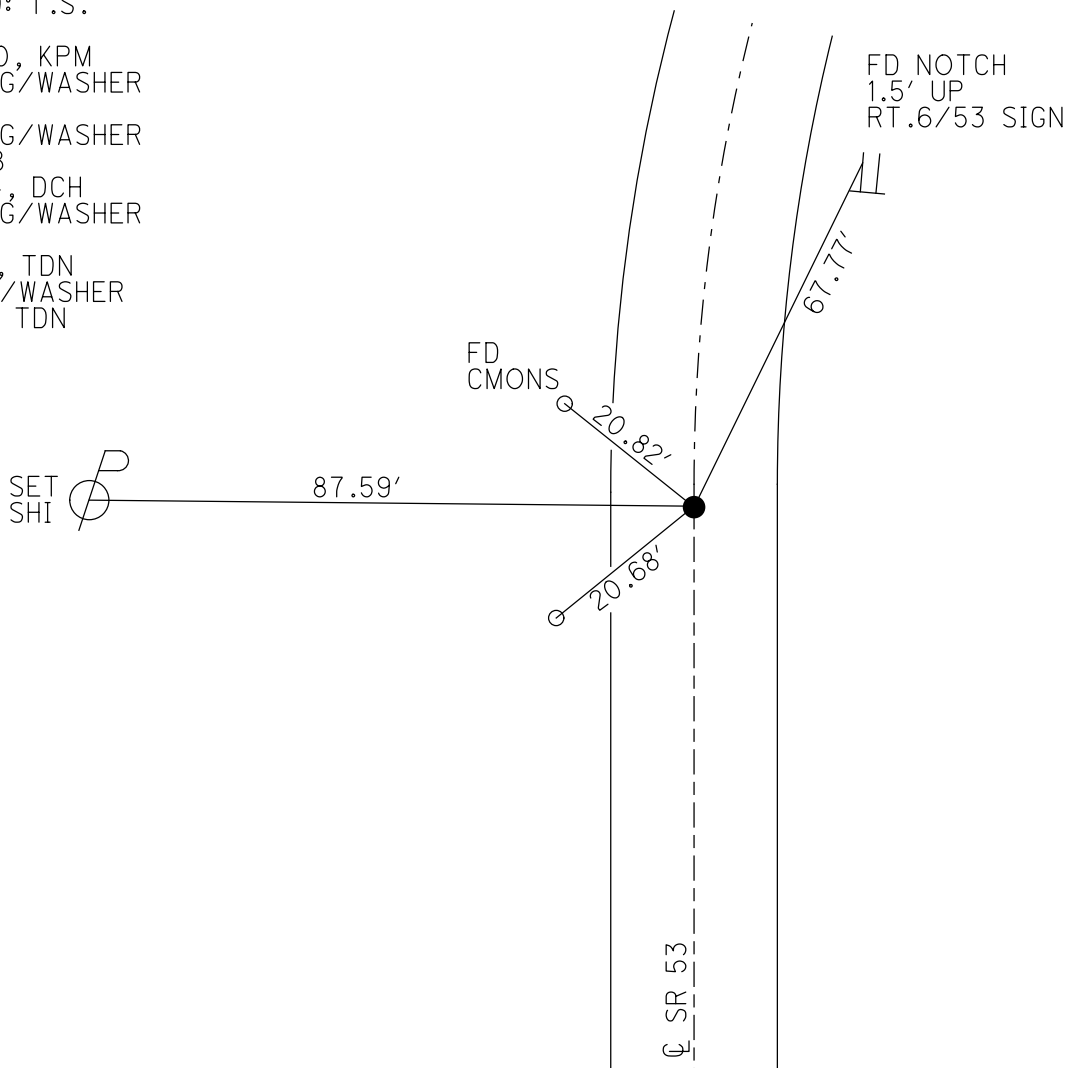

O.D.O.T. DISTRICT 2 SURVEY OFFICE (USE ONLY)

PERSONNEL

REFERENCE NO. 19

SHEET 27 OF 30

NOTES AUBLE

DATE 6/3/22

ROUTE SR 53

H.C. NIESE

WEATHER FAIR

COUNTY SANDUSKY

R.C. WHITAKER

TEMP. 63°

TOWNSHIP SANDUSKY

DWG BY RHOADES PID 111020

SECTION 29

T 5 N R 15 E

TYPE MONUMENT MAG/WASHER

ON SURFACE - ~~BELOW~~ ON

OFFSET Q PAVEMENT 1.2' LT : ~~RT~~

10.8' TO LT EDGE PAVEMENT


STATION: 384+87.28

HORZ.DATUM: NAD83 2011


GEOID: NAVD88 2018

GRID: NORTHING: 617669.596

EASTING: 1785918.592

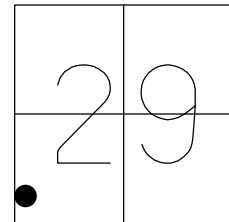

RECORD: P.O.C.
STA. 496+00
1956
SV114
7/29/10, KPM
SET MAG/WASHER
7/19/12
SET MAG/WASHER
REF19
6-3-22, TDN
FD MAG/WASHER
1-4-23, TDN

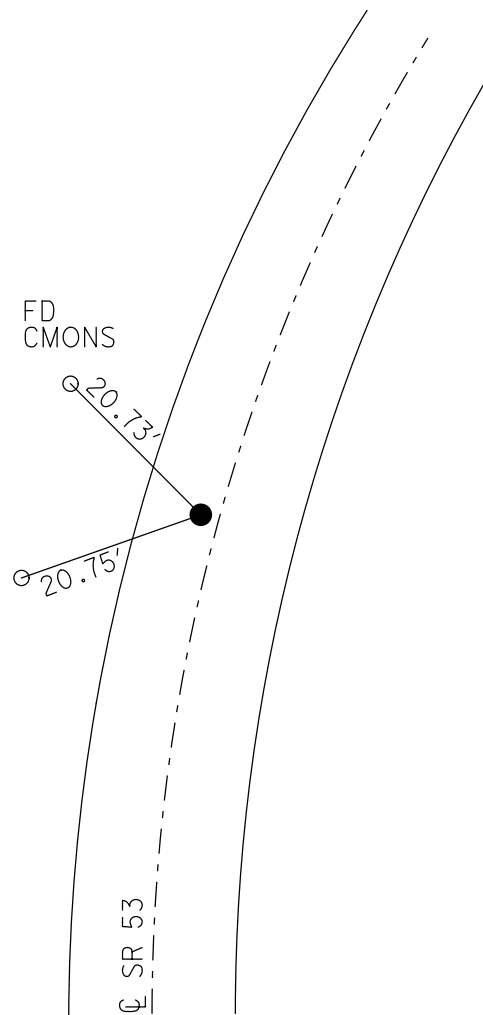

O.D.O.T. DISTRICT 2 SURVEY OFFICE (USE ONLY)

PERSONNEL

REFERENCE NO. 20

SHEET 28 OF 30

NOTES AUBLE

DATE 6/2/22

ROUTE SR 53

H.C. NIESE

WEATHER BREEZY

COUNTY SANDUSKY

R.C. WHITAKER

TEMP. 70°

TOWNSHIP SANDUSKY

DWG BY RHOADES PID 111020

SECTION 29

T 5 N R 15 E

TYPE MONUMENT MAG/WASHER

ON SURFACE - ~~BELOW~~ ON

OFFSET ℄ PAVEMENT ON LT : RT

11.8' TO LT EDGE PAVEMENT


STATION: 392+36.41

HORZ.DATUM: NAD83 2011


GEOID: NAVD88 2018

GRID: NORTHING: 618354.406

EASTING: 1786221.920

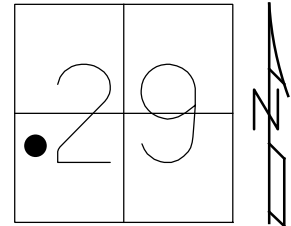

RECORD: S.T.
STA.503+52.02
1956
SV113
7/29/10, KPM
SET MAG/WASHER
7/19/12
SET MAG/WASHER
1-4-22, TDN
FD MAG/WASHER
REF20
6-2-22, TDN

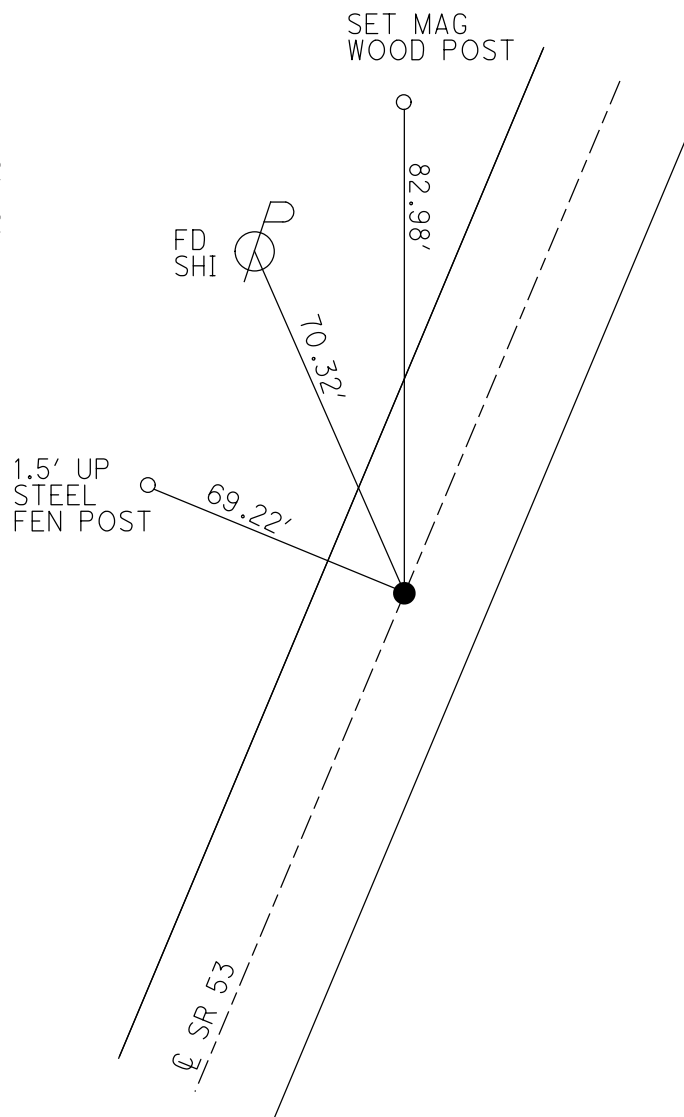

O.D.O.T. DISTRICT 2 SURVEY OFFICE (USE ONLY)

PERSONNEL

REFERENCE NO. 21

SHEET 29 OF 30

NOTES AUBLE

DATE 6/2/23

ROUTE SR 53

H.C. NIESE

WEATHER BREEZY

COUNTY SANDUSKY

R.C. WHITAKER

TEMP. 70°

TOWNSHIP SANDUSKY

DWG BY RHOADES PID 111020

SECTION 29

T 5 N R 15 E

TYPE MONUMENT MAG/WASHER

ON SURFACE - ~~BELOW~~ ON

OFFSET Q PAVEMENT 0.3' LT : ~~RT~~

11.5' TO LT EDGE PAVEMENT



STATION: 398+84.42

HORIZ.DATUM: NAD83 2011

GEOID: NAVD88 2018

GRID: NORTHING: 618920.056

EASTING: 1786538.139

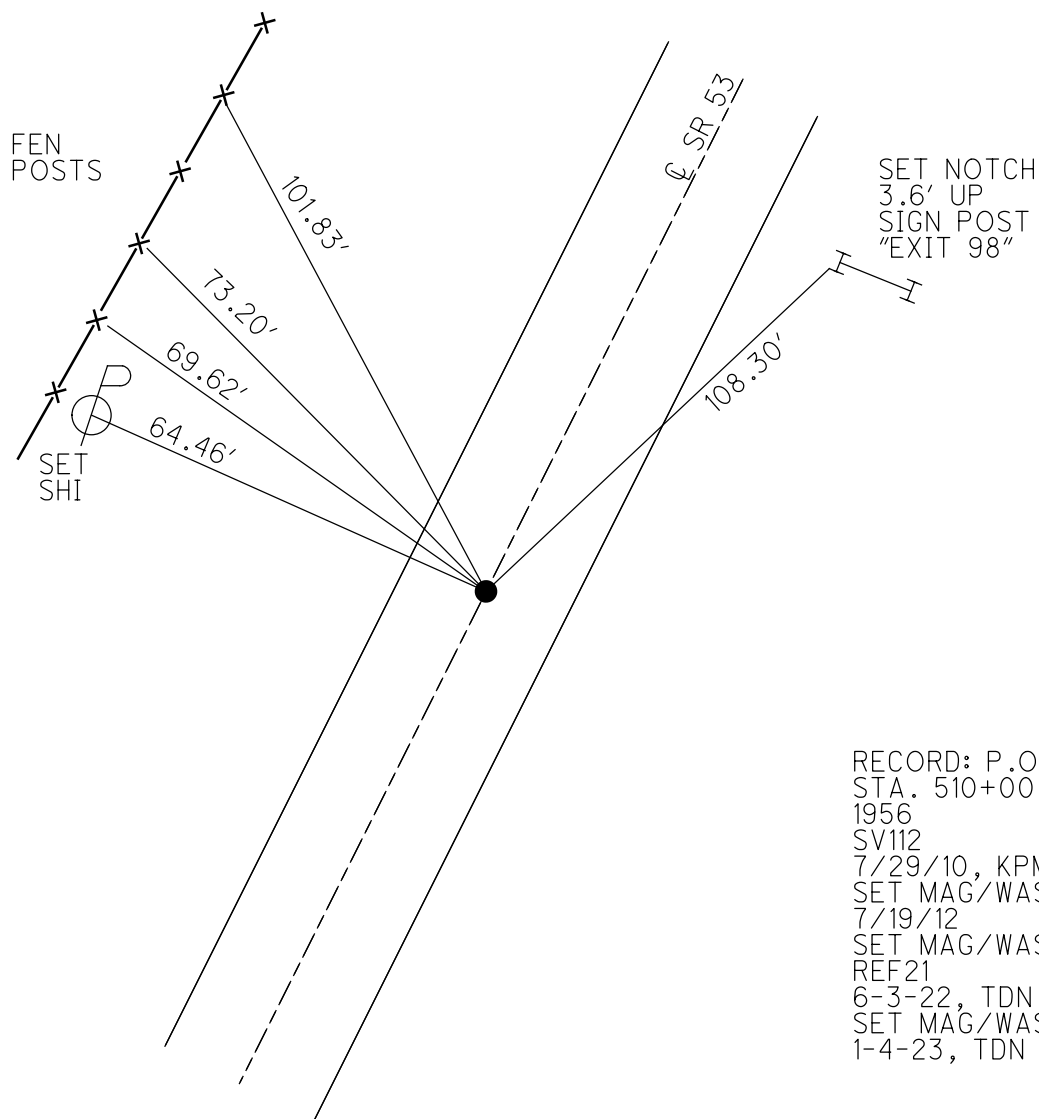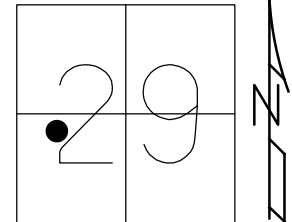

O.D.O.T. DISTRICT 2 SURVEY OFFICE (USE ONLY)

PERSONNEL

REFERENCE NO. 21 A

SHEET 30 OF 30

NOTES NIESE

DATE 6/3/22

ROUTE SR 53

H.C.

WEATHER SUNNY

COUNTY SANDUSKY

R.C.

TEMP. 70°

TOWNSHIP SANDUSKY

SECTION 29

DWG BY ASTON

PID 111020

T 5 N R 15 E

TYPE MONUMENT CNPT

ON SURFACE - BELOW

OFFSET Q PAVEMENT LT : RT

 TO EDGE PAVEMENT


STATION: 405+34

HORIZ.DATUM: NAD83 2011

GEOID: NAVD88 2018

GRID: NORTHING: 619487.526


EASTING: 1786855.113

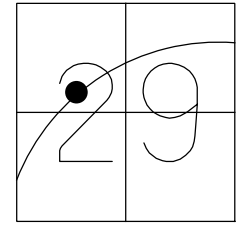

CALC COORDS.
WHERE REC DIST.
CROSS

RECORD: P.O.T
STA 516+50
FD CMON CP531
FD IPIN CP532
5/19/22
CP531: IPIN IN CMON
6" DOWN
N: 619505.279
E: 1786844.312
CP532: 1" IPIN, 12" DOWN
BENT SOUTHEASTERLY
N: 619487.165
E: 1786834.336
POINT WAS NOT ESTABLISHED
REF. MONS LOCATED
INFO FROM SAN-53-5.02(1956)

NOTE:
ALL DIST. REC
FROM PLANS
UNLESS NOTED

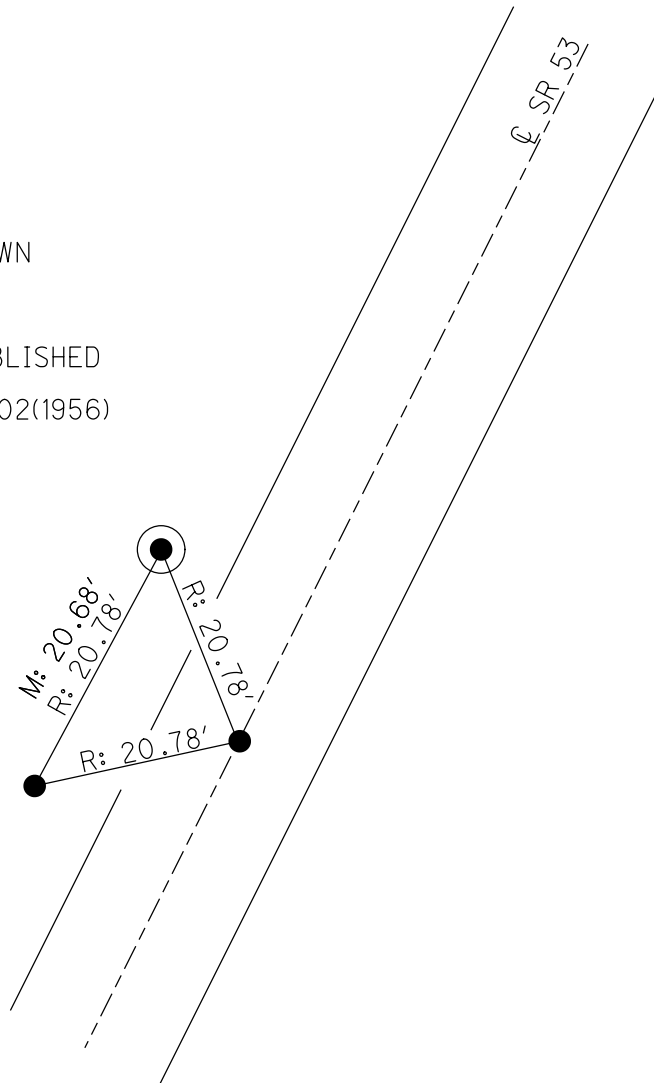

O.D.O.T. DISTRICT 2 SURVEY OFFICE (USE ONLY)

PERSONNEL

REFERENCE NO. 22

SHEET 1 OF 11

NOTES LEU

DATE 8/28/17

ROUTE SR 53

H.C. LEU

WEATHER FAIR

COUNTY SANDUSKY

R.C. FARKAS

TEMP. 69°

TOWNSHIP SANDUSKY

SECTION 27

DWG BY RHOADES

PID 101292

T 5 N R 15 E

TYPE MONUMENT MAG NAIL

ON SURFACE - ~~BELOW~~ ON

OFFSET CL PAVEMENT - LT : RT

- TO - EDGE PAVEMENT


STATION: 414+86.39

HORZ.DATUM: NAD83 2011


GEOID: NAVD88 2012A

GRID: NORTHING: 618013.530

EASTING: 1799007.443

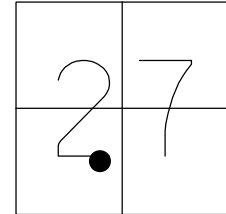

RECORD:
SET MAG NAIL
NW CONSULTANTS
6/15/17, O.M.
FD MAG NAIL
REF100
8/28/17, JLL

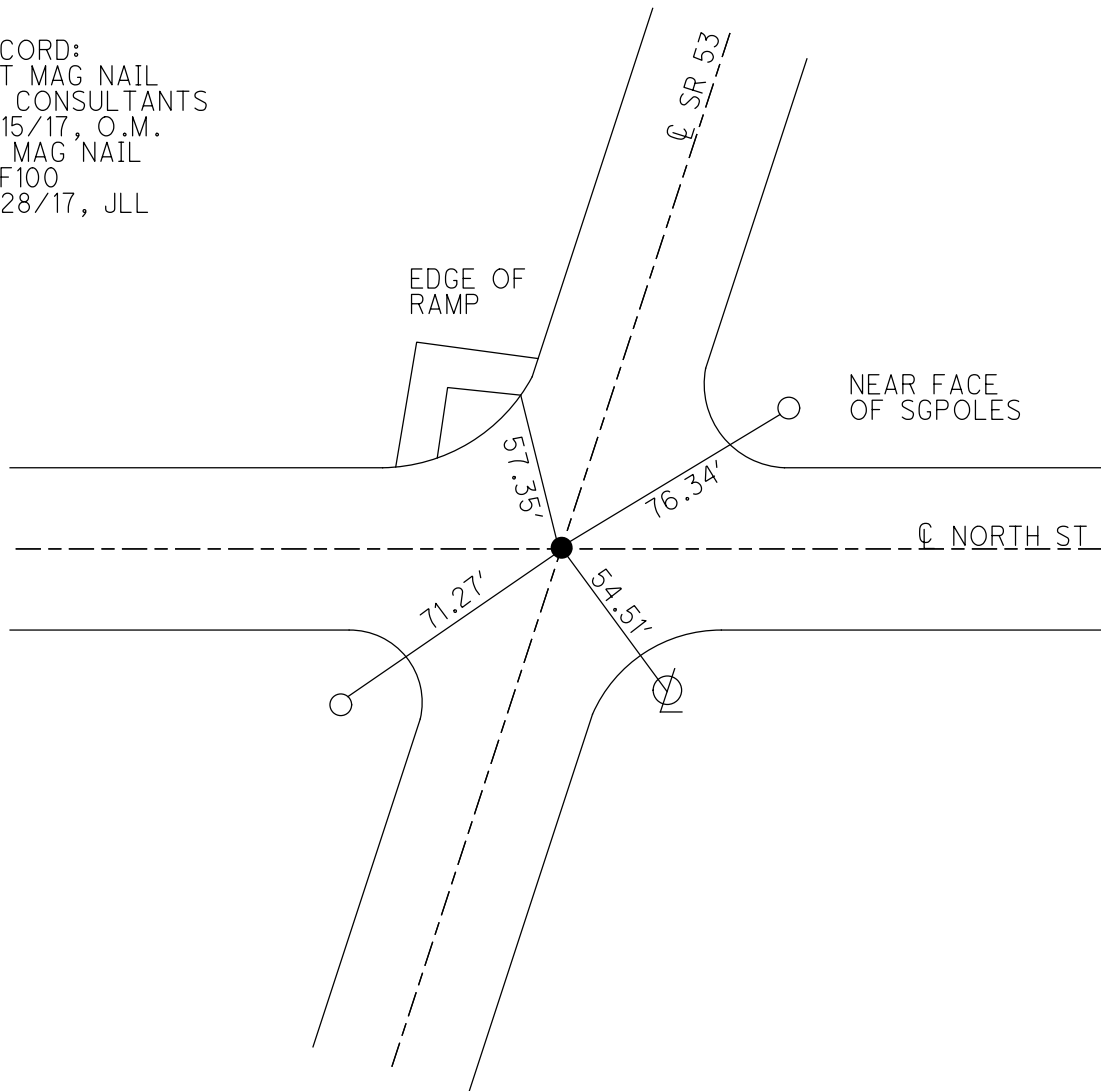

PERSONNEL

REFERENCE NO. 23

SHEET 2 OF 11

NOTES _____ LEU _____

DATE 8/28/17ROUTE SR 53

H.C. LEU

WEATHER FAIR

COUNTY SANDUSKY

R.C. FARKAS

TEMP. 69°

TOWNSHIP SANDUSKY
SECTION 25SECTION 27

DWG BY RHOADES PID 101292

T⁵ N R¹⁵ F

TYPE MONUMENT MAG NAIL

ON SURFACE - ~~BELOW~~ ON

OFFSET @ PAVEMENT _____ LT : RT

TO - EDGE PAVEMENT


STATION: 415+86.39

HORIZ DATUM: NAD83 2011


GEOID: NAVD88 2012A

GRID: NORTHING: 618117.820

EASTING: 1799035.349

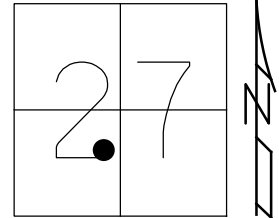

RECORD: P.C.
SET MAG NAIL
NW CONSULTANTS
6/15/17, O.M.
FD MAG NAIL
REF101
8/28/17, JLL

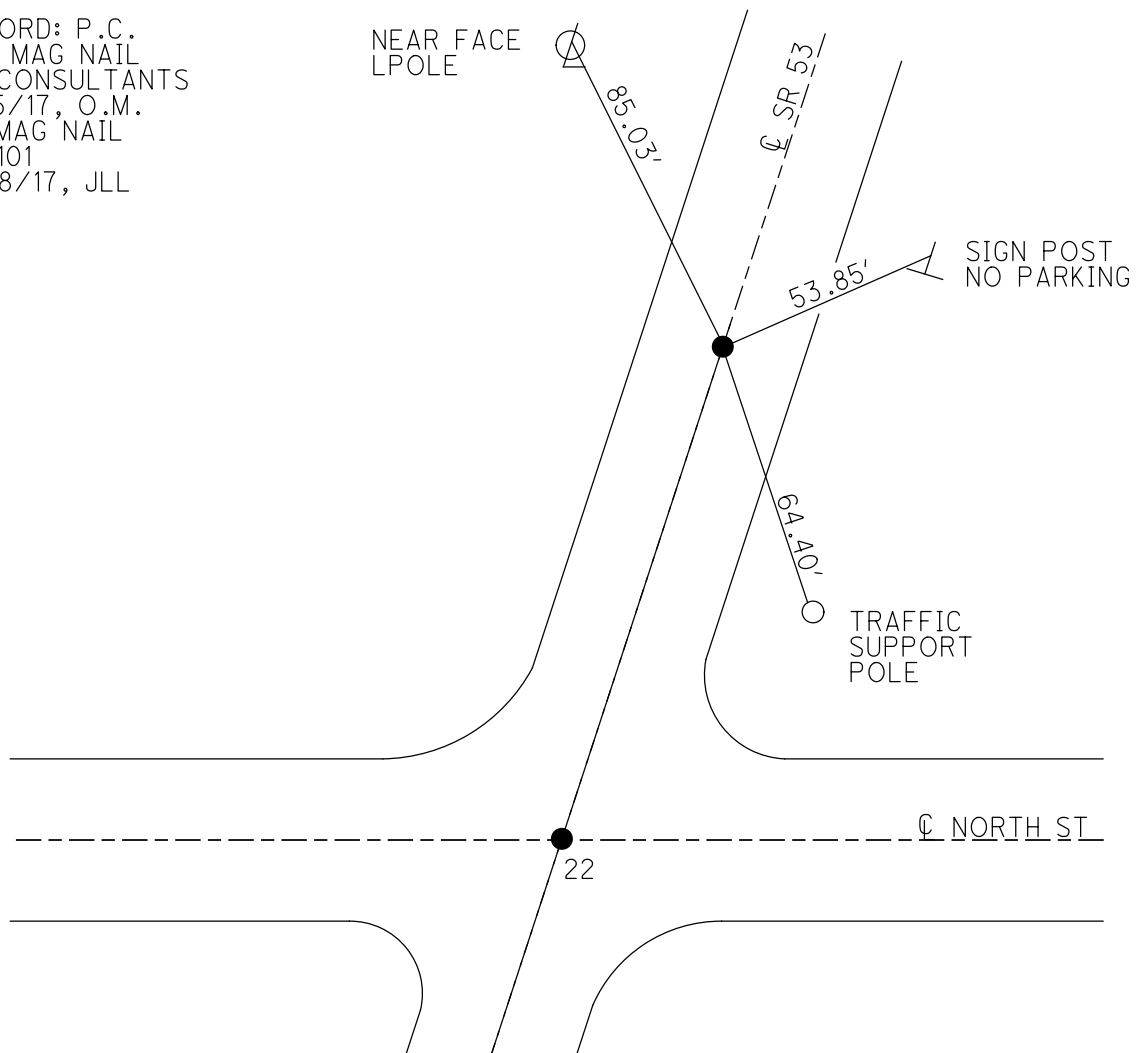NEAR FACE
LPOLE

O.D.O.T. DISTRICT 2 SURVEY OFFICE (USE ONLY)

PERSONNEL

REFERENCE NO. 23 A

SHEET 3 OF 11

NOTES LEU

DATE 8/28/17

ROUTE SR 53

H.C. LEU

WEATHER FAIR

COUNTY SANDUSKY

R.C. FARKAS

TEMP. 69°

TOWNSHIP SANDUSKY

SECTION 27

DWG BY RHOADES

PID 101292

T 5 N R 15 E

TYPE MONUMENT MAG NAIL

ON SURFACE - ~~BELOW~~ ON

OFFSET CL PAVEMENT - LT : RT

13.58' TO RT EDGE PAVEMENT


STATION: 419+75.06

HORIZ.DATUM: NAD83 2011


GEOID: NAVD88 2012A

GRID: NORTHING: 618496.100

EASTING: 1799136.766

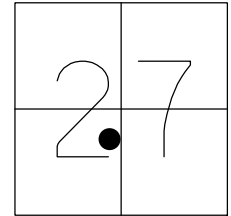

RECORD: P.I.
SET MAG NAIL
NW CONSULTANTS
6/15/17, O.M.
FD MAG NAIL
REF102
8/28/17, JLL

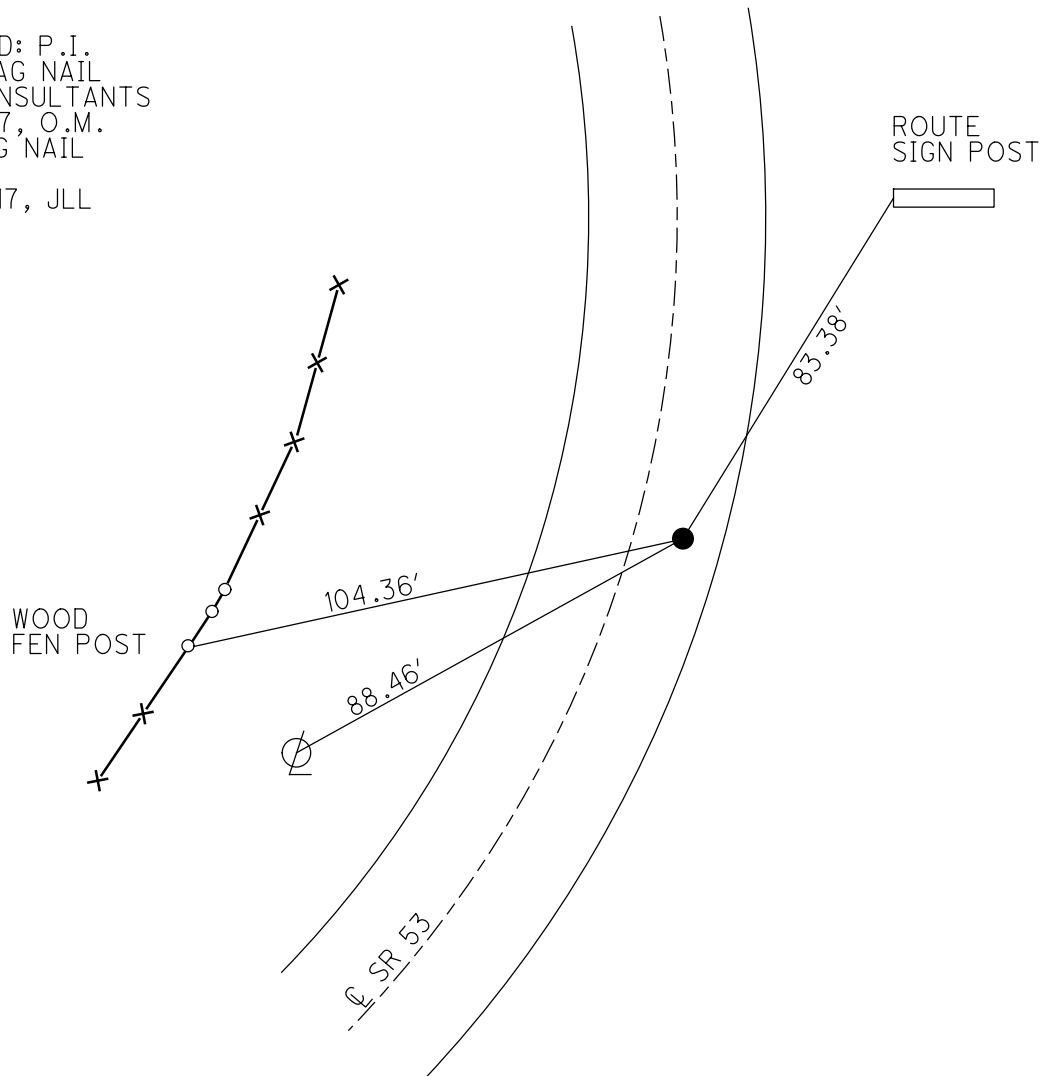

O.D.O.T. DISTRICT 2 SURVEY OFFICE (USE ONLY)

PERSONNEL

REFERENCE NO. 24

SHEET 4 OF 11

NOTES LEU

DATE 8/28/17

ROUTE SR 53

H.C. LEU

WEATHER FAIR

COUNTY SANDUSKY

R.C. FARKAS

TEMP. 69°

TOWNSHIP SANDUSKY

SECTION 27

DWG BY RHOADES

PID 101292

T 5 N R 15 E

TYPE MONUMENT MAG/WASHER

ON SURFACE - ~~BELOW~~ ON

OFFSET Q PAVEMENT - LT : RT

- TO - EDGE PAVEMENT


STATION: 423+58.70

HORZ.DATUM: NAD83 2011

GEOID: NAVD88 2012A

GRID: NORTHING: 618880.940

EASTING: 1799139.448

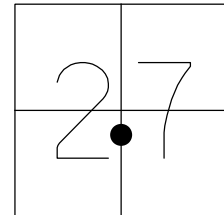


RECORD: P.T.
SET MAG NAIL
NW CONSULTANTS
6/15/17, O.M.
FD MAG/WASHER
REF103
8/28/17, JLL

WOOD
FEN
POSTS

Q SR 53

DESTINATION
SIGN POST

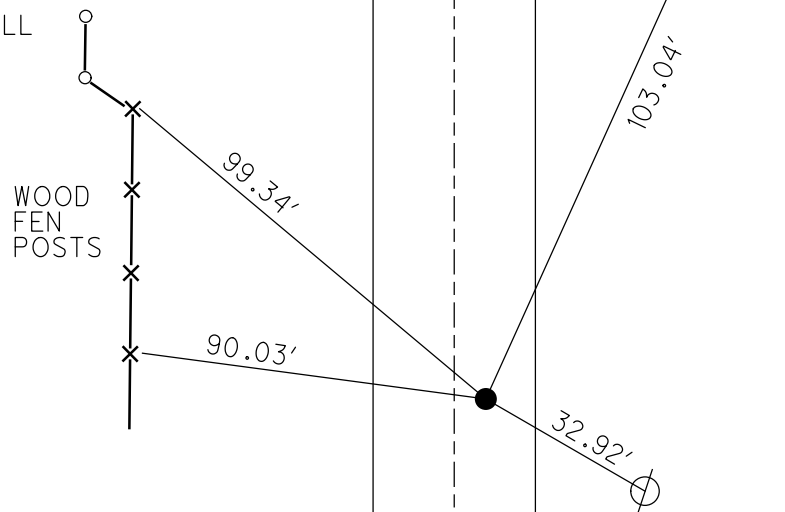

O.D.O.T. DISTRICT 2 SURVEY OFFICE (USE ONLY)

PERSONNEL

REFERENCE NO. 25

SHEET 5 OF 11

NOTES LEU
H.C. LEU
R.C. FARKAS

DATE 8/28/17
WEATHER FAIR
TEMP. 69°

ROUTE SR 53
COUNTY SANDUSKY
TOWNSHIP SANDUSKY
SECTION 22
T 5 N R 15 E

DWG BY RHOADES PID 101292

TYPE MONUMENT MAG NAIL

ON SURFACE - ~~BELOW~~ ON

OFFSET Q PAVEMENT - ± : RT

25.50' TO RT EDGE PAVEMENT


STATION: 479+62.12

HORZ.DATUM: NAD83 2011

GEOID: NAVD88 2012A

GRID: NORTHING: 624484.243

EASTING: 1799177.217

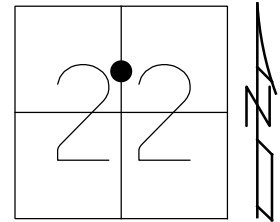

RECORD: P.C.
SET MAG NAIL
NW CONSULTANTS
6/15/17, O.M.
FD MAG NAIL
REF104
8/28/17, JLL

FREMONT
ANIMAL
HOSPITAL

DIRECTIONAL
SIGN POST

IPIN
3' FR/EB

65.52'

57.60'

Q SR 53

72.29'

SL 50
SIGN POST

O.D.O.T. DISTRICT 2 SURVEY OFFICE (USE ONLY)

PERSONNEL

REFERENCE NO. 25 A

SHEET 6 OF 11

NOTES LEU

DATE 8/28/17

ROUTE SR 53

H.C. LEU

WEATHER FAIR

COUNTY SANDUSKY

R.C. FARKAS

TEMP. 69°

TOWNSHIP SANDUSKY

SECTION 22

DWG BY RHOADES

PID 101292

T 5 N R 15 E

TYPE MONUMENT MAG NAIL

ON SURFACE - ~~BELOW~~ ON

OFFSET Q PAVEMENT - LT : ~~RT~~

3.86' TO LT EDGE PAVEMENT


STATION: 485+06.15

HORZ.DATUM: NAD83 2011


GEOID: NAVD88 2012A

GRID: NORTHING: 625034.314

EASTING: 1799180.946

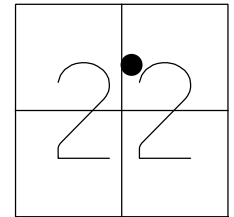

RECORD: P.I.
SET MAG NAIL
NW CONSULTANTS
6/15/17, O.M.
FD MAG NAIL
REF105
8/28/17, JLL

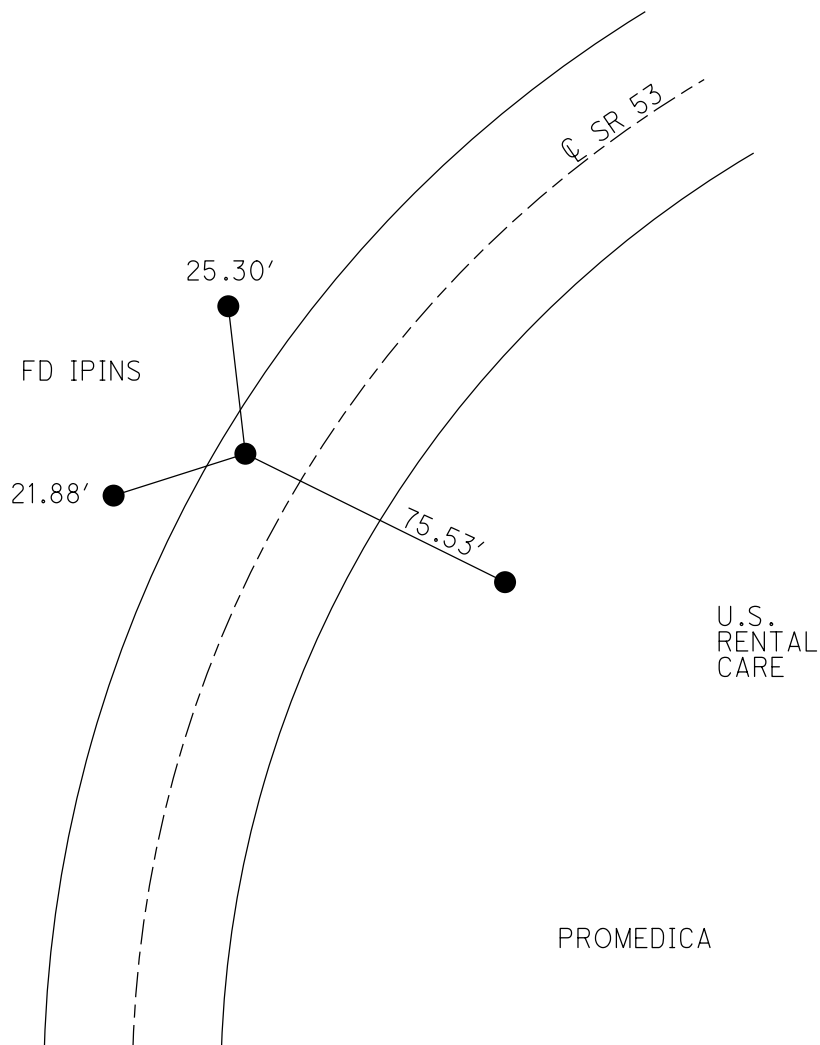

O.D.O.T. DISTRICT 2 SURVEY OFFICE (USE ONLY)

PERSONNEL

REFERENCE NO. 25 B

SHEET 7 OF 11

NOTES LEU

DATE 8/28/17

ROUTE SR 53

H.C. LEU

WEATHER FAIR

COUNTY SANDUSKY

R.C. FARKAS

TEMP. 69°

TOWNSHIP SANDUSKY

SECTION 22

DWG BY RHOADES

PID 101292

T 5 N R 15 E

TYPE MONUMENT MAG NAIL

ON SURFACE - ~~BELOW~~ ON

OFFSET 0 PAVEMENT - LT : RT

 TO EDGE PAVEMENT


STATION: 490+50.17

HORZ.DATUM: NAD83 2011


GEOID: NAVD88 2012A

GRID: NORTHING: 625547.370

EASTING: 1799379.531

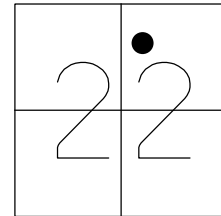

RECORD: P.T.
SET MAG NAIL
NW CONSULTANTS
6/15/17, O.M.
FD MAG NAIL
REF106
8/28/17, JLL

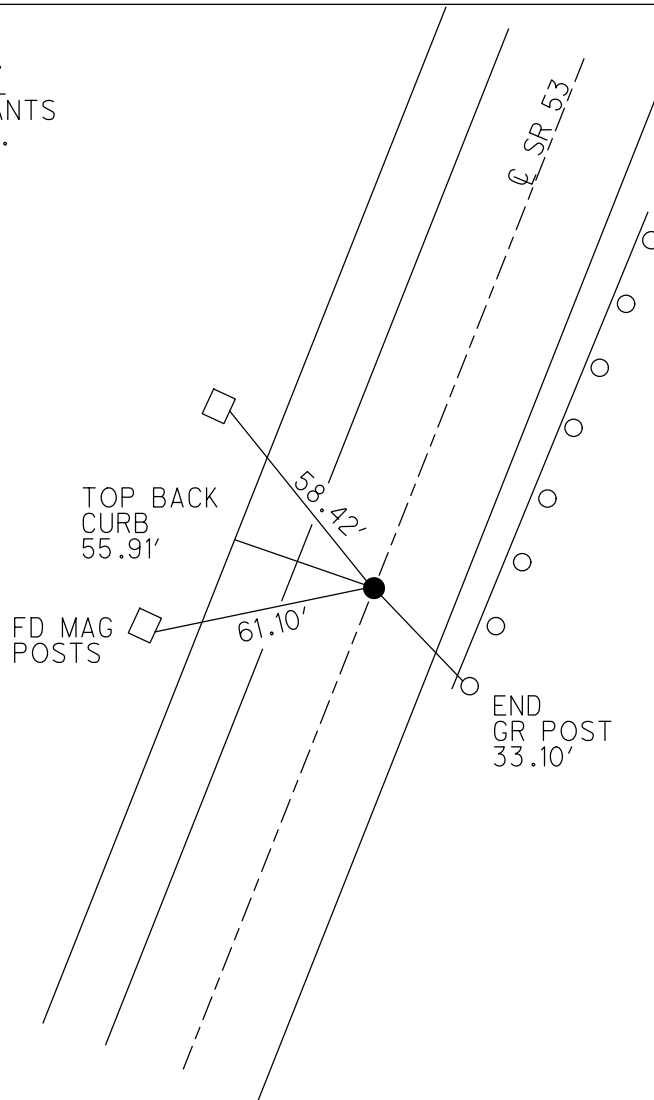

O.D.O.T. DISTRICT 2 SURVEY OFFICE (USE ONLY)

PERSONNEL

REFERENCE NO. 25 C

SHEET 8 OF 11

NOTES AUBLE

DATE 12/15/23

ROUTE SR 53

H.C. AUBLE

WEATHER CLOUDY

COUNTY SANDUSKY

R.C. NIESE

TEMP. 28°

TOWNSHIP SANDUSKY

ASTON

SECTION 15

DWG BY RHOADES

PID 95760

T 5 N R 15 E

TYPE MONUMENT MAG NAIL

ON SURFACE - ~~BELOW~~ ON

OFFSET CL PAVEMENT - LT : RT

26.29' TO RT EDGE PAVEMENT


STATION: 539+52.27

HORIZ.DATUM: NAD83 2011

GEOID: NAVD88 2018


GRID: NORTHING: 630118.594

EASTING: 1801149.532

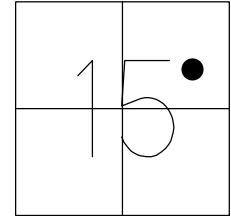

RECORD: P.C.
SET MAG NAIL
NW CONSULTANTS
6/15/17, O.M.
FD MAG NAIL
REF107
8/28/17, JLL
FD MAG NAIL
REF25C
12/15/23, DSA

FD SHI'S
GR POSTS

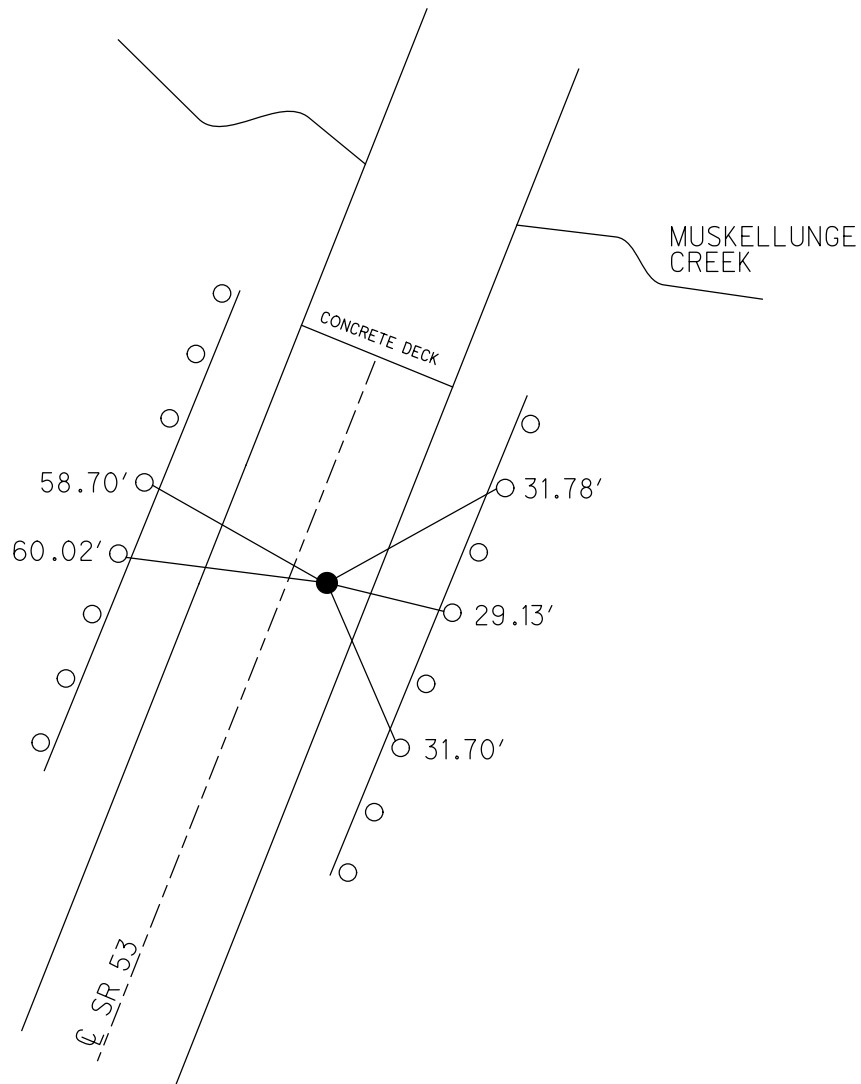

O.D.O.T. DISTRICT 2 SURVEY OFFICE (USE ONLY)

PERSONNEL

REFERENCE NO. 26

SHEET 9 OF 11

NOTES AUBLE

DATE 12/15/23

ROUTE SR 53

H.C. AUBLE

WEATHER CLOUDY

COUNTY SANDUSKY

R.C. NIESE

TEMP. 28°

TOWNSHIP SANDUSKY

ASTON

SECTION 15

DWG BY RHOADES

PID 95760

T 5 N R 15 E

TYPE MONUMENT MAG NAIL

ON SURFACE - ~~BELOW~~ ON

OFFSET Q PAVEMENT - LT : RT

- TO EDGE PAVEMENT



STATION: 543+58.06

HORIZ.DATUM: NAD83 2011

GEOID: NAVD88 2018

GRID: NORTHING: 630499.339

EASTING: 1801296.928

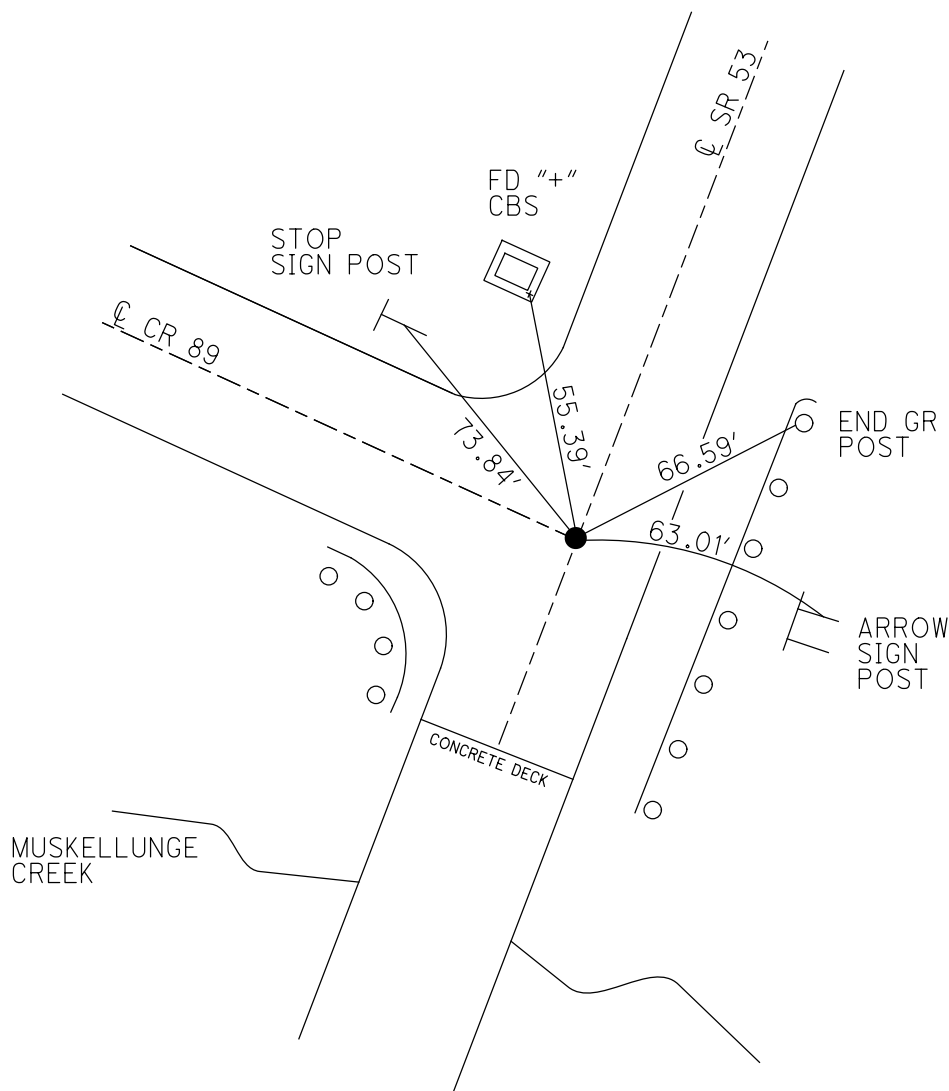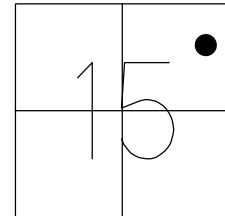

RECORD: P.I.
SET MAG NAIL
NW CONSULTANTS
6/15/17, O.M.
FD MAG NAIL
REF108
8/28/17, JLL
FD MAG NAIL
REF26
12/15/23, DSA

O.D.O.T. DISTRICT 2 SURVEY OFFICE (USE ONLY)

PERSONNEL

REFERENCE NO. 26 A

SHEET 10 OF 11

NOTES RHOADES

DATE 11/22/23

ROUTE SR 53

H.C. AUBLE

WEATHER OVERCAST

COUNTY SANDUSKY

R.C. MILLER

TEMP. 39°

TOWNSHIP SANDUSKY

NIESE, ASTON

SECTION 15

DWG BY RHOADES

PID 95760

T 5 N R 15 E

TYPE MONUMENT MAG NAIL

ON SURFACE - ~~BELOW~~ ON

OFFSET 0 PAVEMENT - LT : RT

34.95' TO RT EDGE PAVEMENT



STATION: 547+63.85

HORIZ.DATUM: NAD83 2011

GEOID: NAVD88 2018

GRID: NORTHING: 630826.858

EASTING: 1801540.803

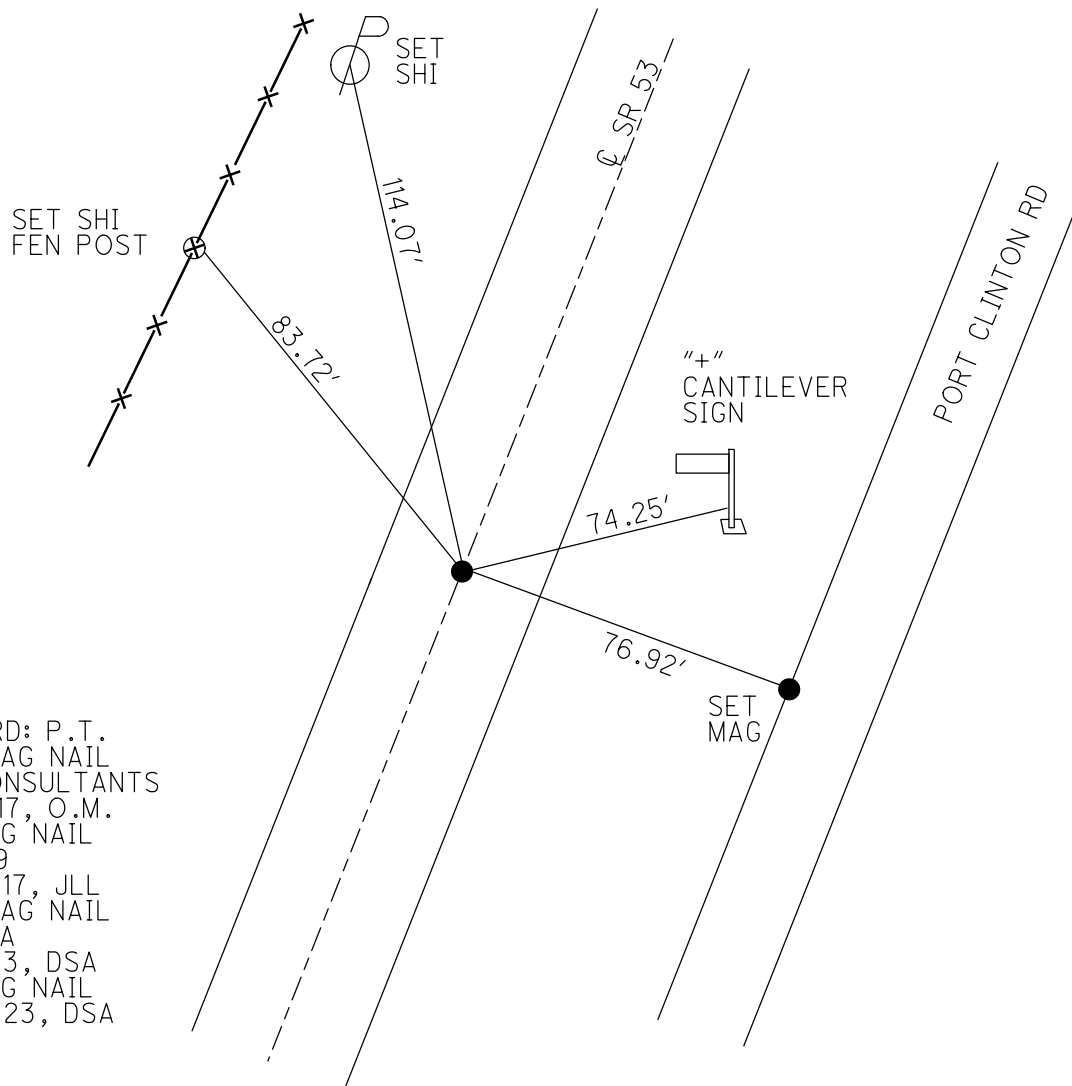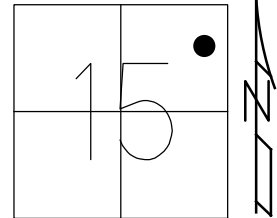

RECORD: P.T.
SET MAG NAIL
NW CONSULTANTS
6/15/17, O.M.
FD MAG NAIL
REF109
8/28/17, JLL
SET MAG NAIL
REF26A
8/3/23, DSA
FD MAG NAIL
11/22/23, DSA

PORT CLINTON RD

O.D.O.T. DISTRICT 2 SURVEY OFFICE (USE ONLY)

PERSONNEL	REFERENCE NO. <u>27</u>	SHEET <u>1</u> OF <u>19</u>	
NOTES	BARNHISEL	DATE	3/20/03
H.C.	BARNHISEL	WEATHER	SUNNY
R.C.	HOMAN	TEMP.	50°
	RYALL		
	GLASS		
		ROUTE	SR 53
		COUNTY	SANDUSKY
		TOWNSHIP	SANDUSKY
		SECTION	15
		T <u>5</u> N R <u>15</u> E	

TYPE MONUMENT P.K. NAIL/WASHER


ON SURFACE - ~~BELOW~~ ON

~~LEFT~~ CL PAV'T ~~RIGHT~~ ON


42.3' TO RT EDGE PAVEMENT

S.L.M. 677+88

Grid: Northing: - Easting: -

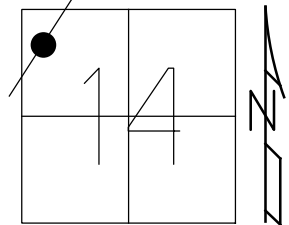

RECORD:
P.C. 553+85.29
RESET MAG/WASHER
8/19/03, MDB

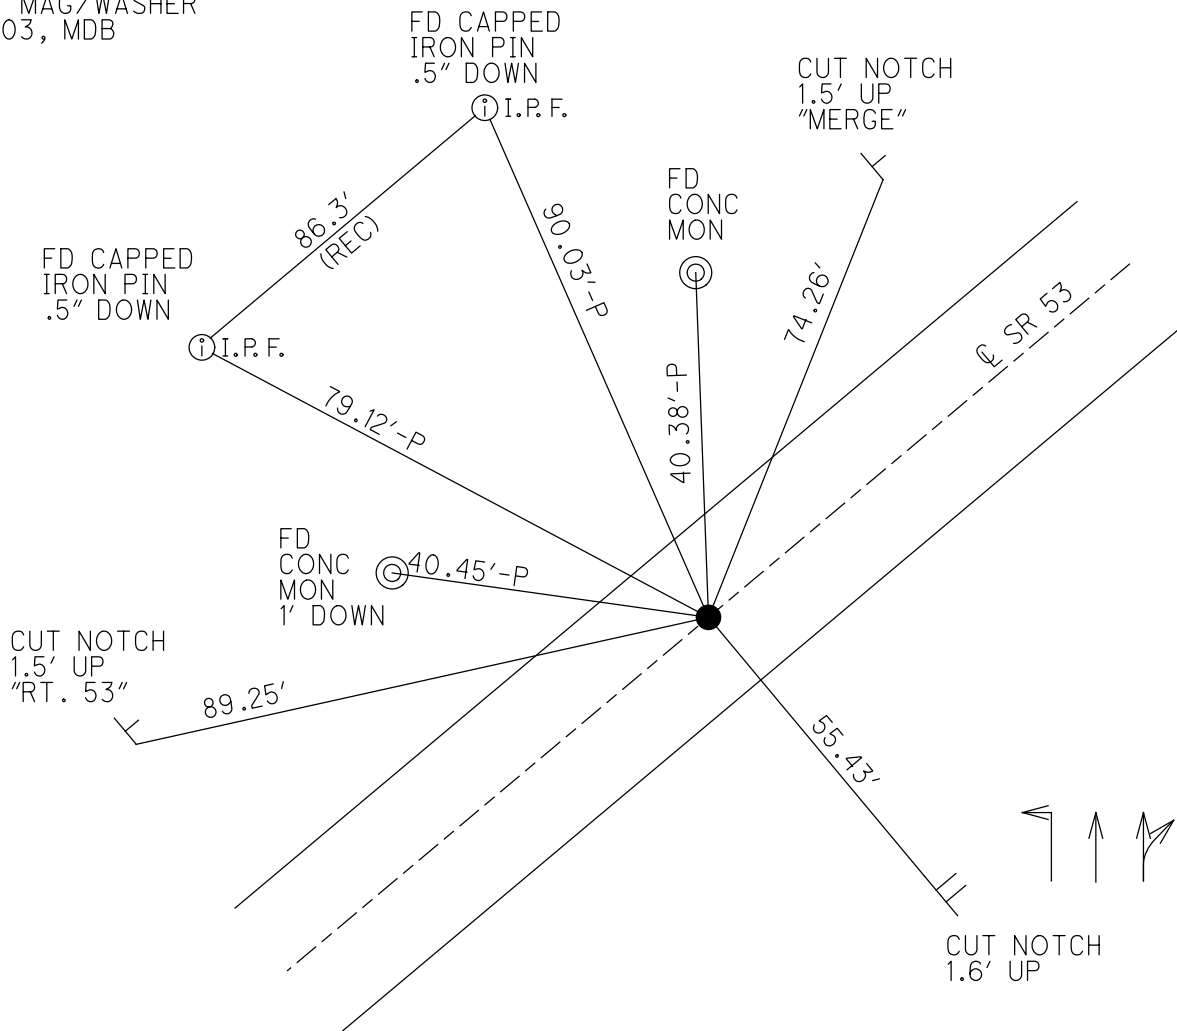

O.D.O.T. DISTRICT 2 SURVEY OFFICE (USE ONLY)

PERSONNEL		REFERENCE NO.	<u>28</u>	SHEET	<u>2</u>	OF	<u>19</u>
NOTES	<u>BARNHISEL</u>	DATE	<u>3/20/03</u>	ROUTE	<u>SR 53</u>		
H.C.	<u>BARNHISEL</u>	WEATHER	<u>SUNNY</u>	COUNTY	<u>SANDUSKY</u>		
R.C.	<u>HOMAN</u>	TEMP.	<u>50°</u>	TOWNSHIP	<u>SANDUSKY</u>		
	<u>RYALL</u>			SECTION	<u>15</u>		
	<u>GLASS</u>			T <u>5</u> N R <u>15</u> E			

TYPE MONUMENT "X" CUT CONC MEDIAN


ON SURFACE - ~~BELOW~~ ON

~~LEFT~~ Q PAV'T ~~RIGHT~~ ON


25.9' TO RT EDGE PAVEMENT

S.L.M. 682+38

Grid: Northing: - Easting: -

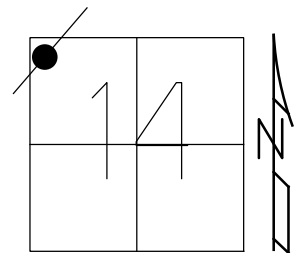

RECORD:
P.T. 558+35.29

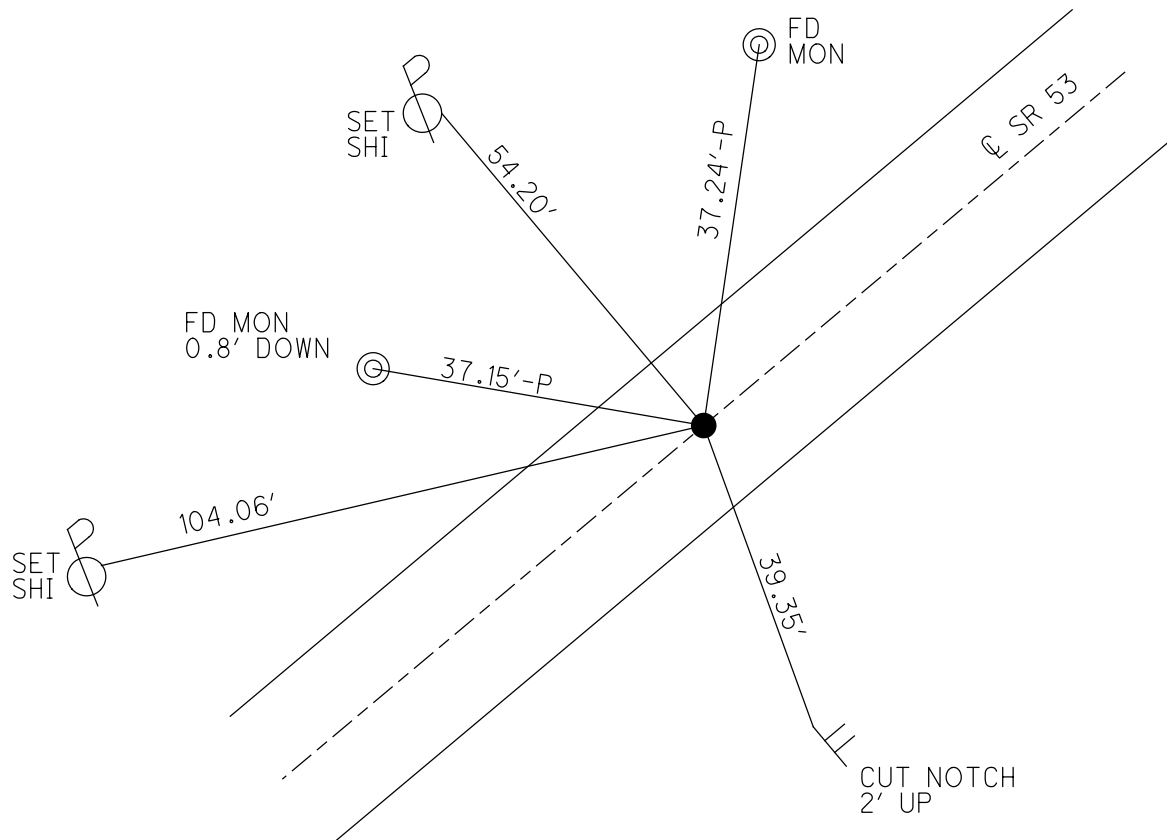

O.D.O.T. DISTRICT 2 SURVEY OFFICE (USE ONLY)

PERSONNEL

REFERENCE NO. 29

SHEET 3 OF 19

NOTES AUBLE

DATE 12/14/23

ROUTE SR 53

H.C. AUBLE

WEATHER SUNNY

COUNTY SANDUSKY

R.C. NIESE

TEMP. 32°

TOWNSHIP SANDUSKY

SECTION 14

DWG BY RHOADES

PID 95760

T 5 N R 15 E

TYPE MONUMENT MAG/WASHER

ON SURFACE - BELOW ON

OFFSET CL PAVEMENT ON LT : RT

26.1' TO RT EDGE PAVEMENT


STATION: 684+60

HORIZ.DATUM: _____


GEOID: _____

GRID: NORTHING: _____

EASTING: _____

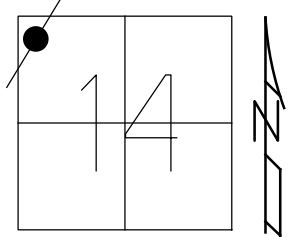

RECORD: P.O.T.
STA. 560+57.97
CENTER TURNPIKE
UNDER BRIDGE
SET MAG/WASHER
W/1990 TIES
12/14/23, DSA

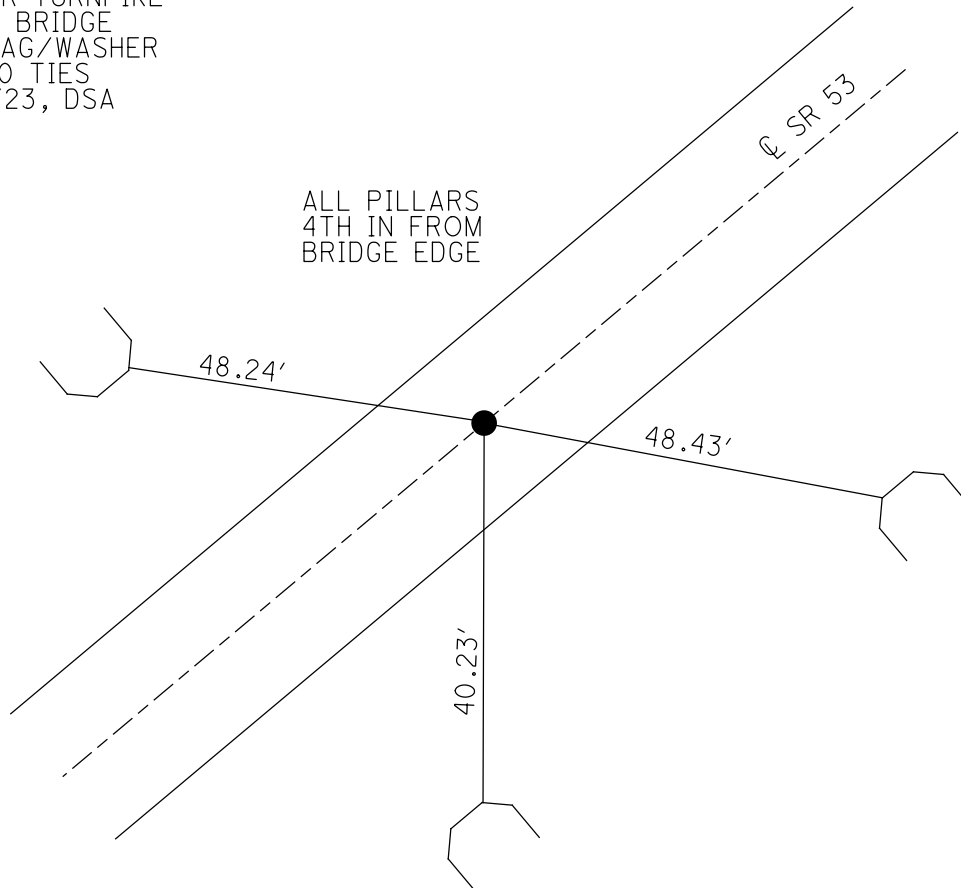

O.D.O.T. DISTRICT 2 SURVEY OFFICE (USE ONLY)

PERSONNEL

REFERENCE NO. 30

SHEET 4 OF 19

NOTES RHOADES

DATE 11/22/23

ROUTE SR 53

H.C. AUBLE

WEATHER OVERCAST

COUNTY SANDUSKY

R.C. MILLER

TEMP. 39°

TOWNSHIP RICE

NIESE, ASTON

SECTION 11

DWG BY RHOADES PID 95760

T 5 N R 15 E

TYPE MONUMENT MAG/WASHER

ON SURFACE - ~~BELOW~~ ON

OFFSET 2.1' LT : RT

15.9' TO LT EDGE PAVEMENT


STATION: 708+10

HORZ.DATUM: NAD83 2011


GEOID: NAVD88 2018

GRID: NORTHING: 633877.749

EASTING: 1803510.482

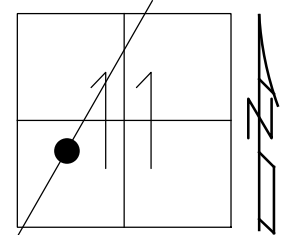

RECORD: P.I.
 $\Delta = 02^\circ 39' \text{ LT}$
STA. 582+56.60
FD P.K./WASHER
3/20/03
SET MAG/WASHER
8/19/03, MDB
FD MAG/WASHER
REF30
6/1/21, TDN
4/7/22, JFO
FD MAG/WASHER
REF30
8/3/23, DSA
SET MAG/WASHER
11/22/23, DSA

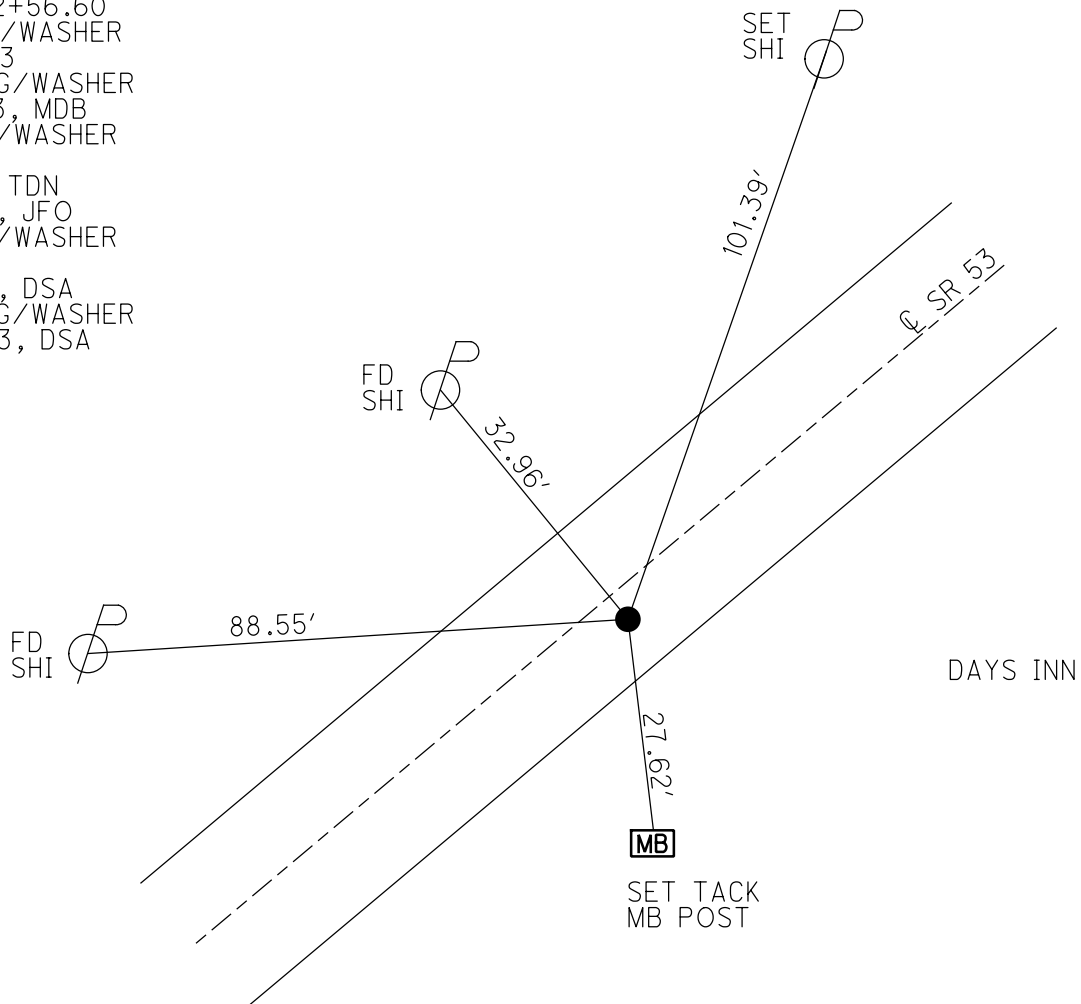

O.D.O.T. DISTRICT 2 SURVEY OFFICE (USE ONLY)

PERSONNEL

REFERENCE NO. 31

SHEET 5 OF 19

NOTES RHOADES
H.C. AUBLE
R.C. MILLER
NIESE, ASTON

DATE 11/22/23
WEATHER OVERCAST
TEMP. 39°

ROUTE SR 53
COUNTY SANDUSKY
TOWNSHIP RICE
SECTION 11
T 5 N R 15 E

DWG BY RHOADES PID 95760

TYPE MONUMENT MAG/WASHER

ON SURFACE - ~~BELOW~~ ON

OFFSET CL PAVEMENT 5.6' ~~LT~~ : RT

17.9' TO LT EDGE PAVEMENT


STATION: 716+19

HORIZ.DATUM: NAD83 2011


GEOID: NAVD88 2018

GRID: NORTHING: 634593.893

EASTING: 1803882.091

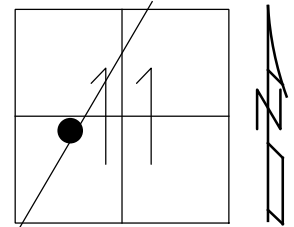

RECORD: P.I.
 $\Delta=05^{\circ} 10'$ LT
FD R.R.SPIKE
3/20/03
SET P.K. NAIL
SET MAG/WASHER
8/19/03, MDB
FD MAG/WASHER
REF31
6/1/21, TDN
4/7/22, JFO
FD MAG/WASHER
REF31
8/3/23, DSA
SET MAG/WASHER
11/22/23, DSA

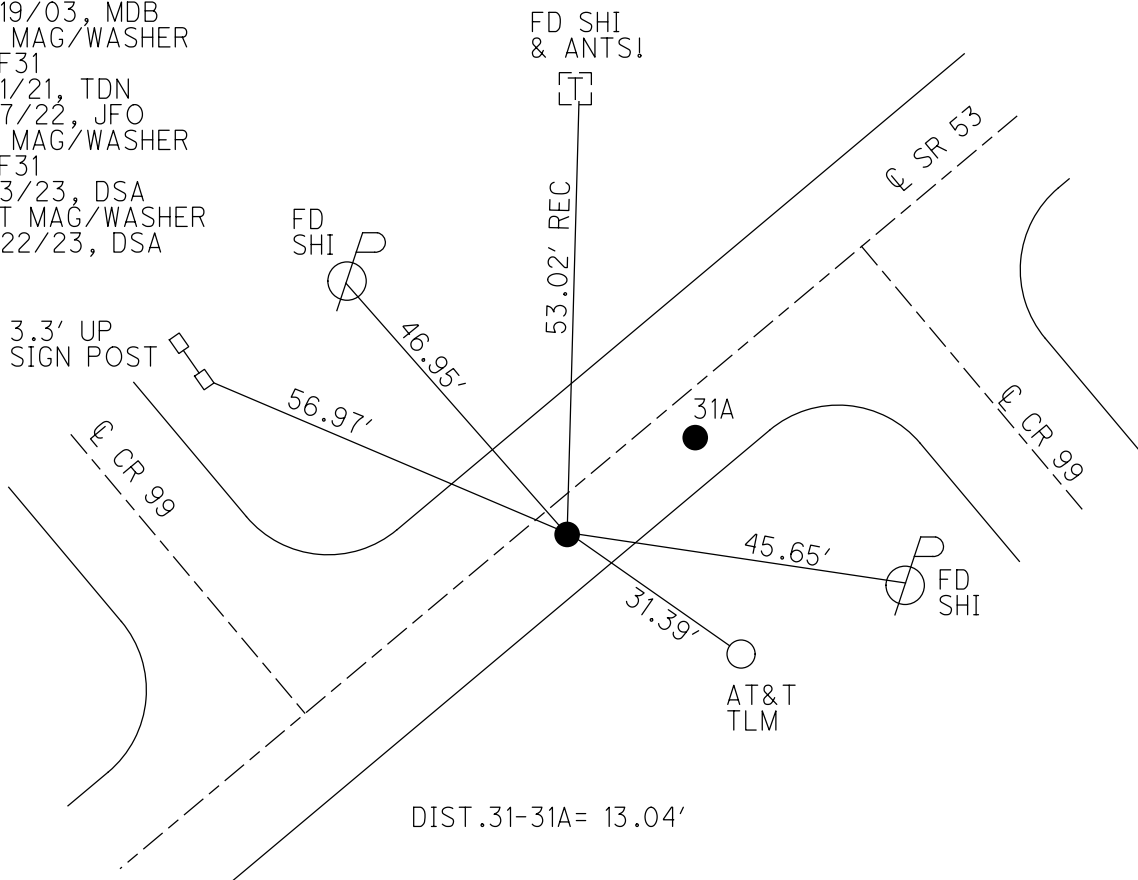

O.D.O.T. DISTRICT 2 SURVEY OFFICE (USE ONLY)

PERSONNEL

REFERENCE NO. 31 A

SHEET 6 OF 19

NOTES RHOADES
H.C. AUBLE
R.C. MILLER
NIESE, ASTON

DATE 11/22/23
WEATHER OVERCAST
TEMP. 39°

ROUTE SR 53
COUNTY SANDUSKY
TOWNSHIP RICE
SECTION 11
T 5 N R 15 E

DWG BY RHOADES PID 95760

TYPE MONUMENT MAG/WASHER

ON SURFACE - ~~BELOW~~ ON

OFFSET Q PAVEMENT 5.1' LT : RT

17.5' TO LT EDGE PAVEMENT


STATION: 716+19

HORZ.DATUM: NAD83 2011

GEOID: NAVD88 2018


GRID: NORTHING: 634605.955

EASTING: 1803887.027

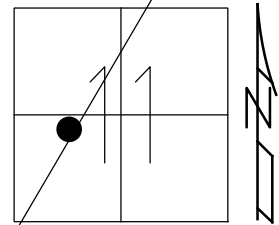

RECORD:

FD P.K./WASHER
2" DOWN
3/20/03, MDB
SET MAG/WASHER
8/19/03, MDB
FD MAG/WASHER
REF31
6/1/21, TDN
4/7/22, JFO
FD MAG/WASHER
REF31A
8/3/23, DSA
SET MAG/WASHER
11/22/23, DSA

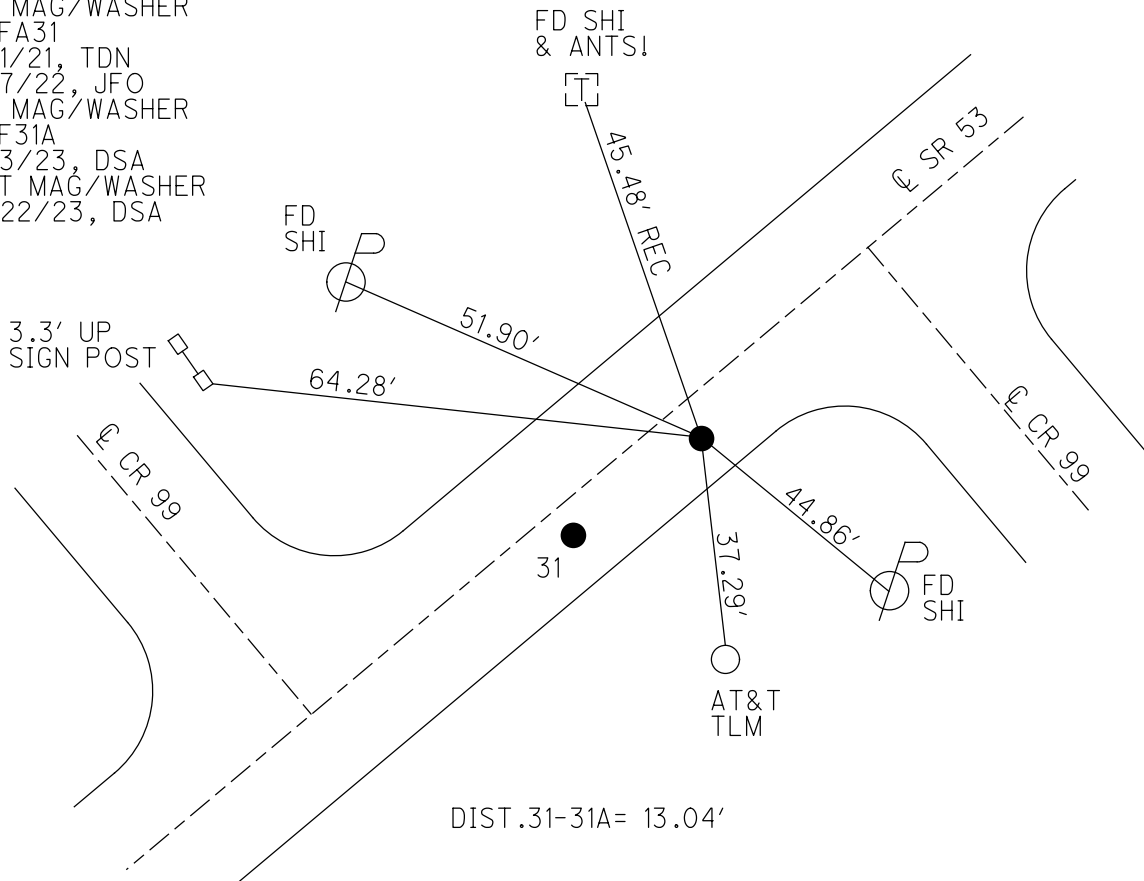

O.D.O.T. DISTRICT 2 SURVEY OFFICE (USE ONLY)

PERSONNEL

REFERENCE NO. 32

SHEET 7 OF 19

NOTES RHOADES

DATE 11/22/23

ROUTE SR 53

H.C. AUBLE

WEATHER OVERCAST

COUNTY SANDUSKY

R.C. MILLER

TEMP. 39°

TOWNSHIP RICE

NIESE, ASTON

SECTION 11

DWG BY RHOADES

PID 95760

T 5 N R 15 E

TYPE MONUMENT P.K./WASHER

ON SURFACE - ~~BELOW~~ ON

OFFSET 11.1' LT : ~~RT~~

1.4' TO LT EDGE PAVEMENT


STATION: 732+74

HORZ.DATUM: NAD83 2011


GEOID: NAVD88 2018

GRID: NORTHING: 636120.630

EASTING: 1804507.059

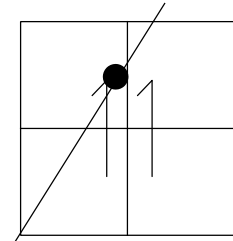

RECORD: P.I.
STA.607+12.82
FD P.K./WASHER
3/20/03, MDB
SET MAG/WASHER
8/19/03, MDB
FD MAG/WASHER
REF32
5/27/21, TDN
4/7/22, JFO
FD MAG/WASHER
REF32
8/3/23, DSA
SET MAG/WASHER
11/22/23, DSA

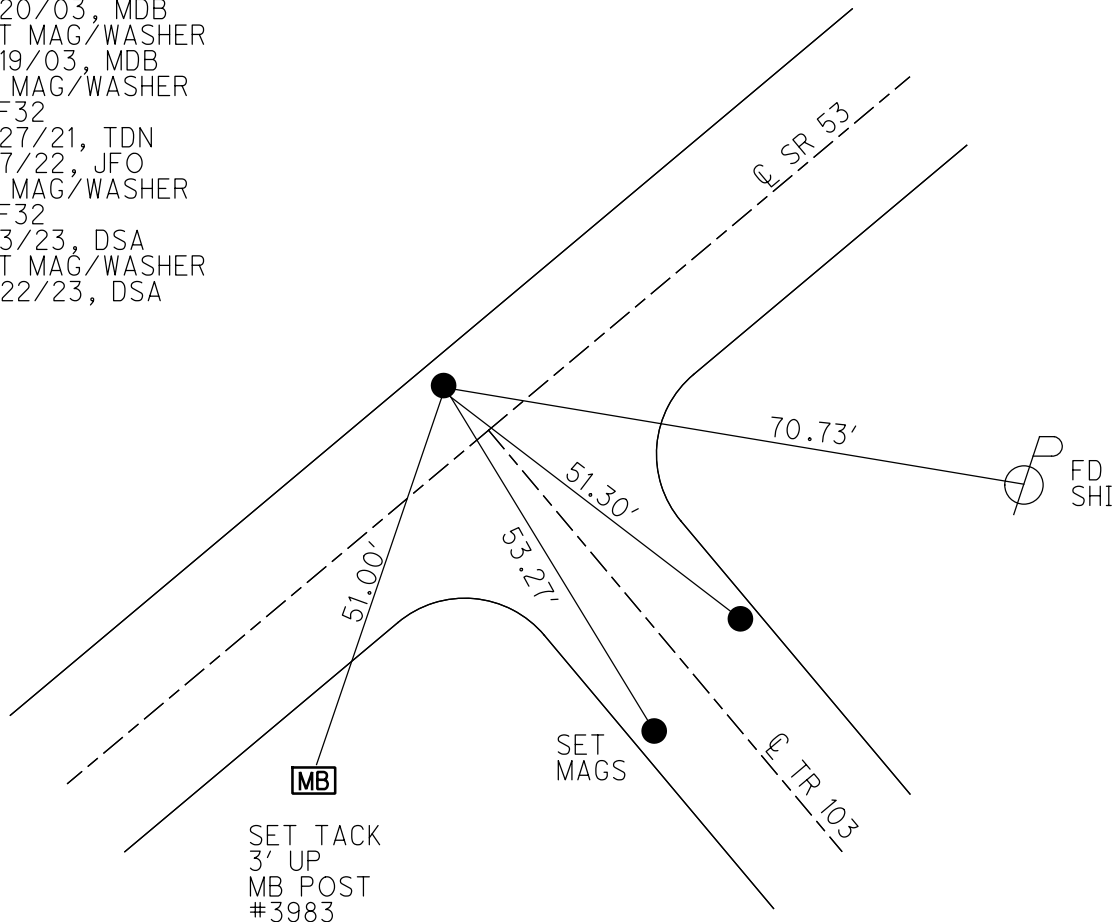

O.D.O.T. DISTRICT 2 SURVEY OFFICE (USE ONLY)

PERSONNEL

REFERENCE NO. 33

SHEET 8 OF 19

NOTES RHOADES

DATE 11/22/23

ROUTE SR 53

H.C. AUBLE

WEATHER OVERCAST

COUNTY SANDUSKY

R.C. MILLER

TEMP. 39°

TOWNSHIP RICE

NIESE, ASTON

SECTION 11

DWG BY RHOADES

PID 95760

T 5 N R 15 E

TYPE MONUMENT MAG/WASHER

ON SURFACE - ~~BELOW~~ ON

OFFSET CL PAVEMENT 2.7' LT : RT

8.7' TO LT EDGE PAVEMENT


STATION: 738+00

HORZ.DATUM: NAD83 2011


GEOID: NAVD88 2018

GRID: NORTHING: 636557.199

EASTING: 1804797.453

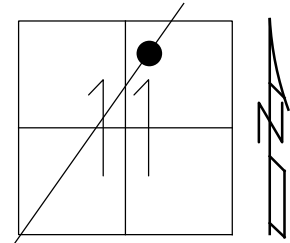

RECORD: P.I.
 $\Delta = 06^{\circ} 23' RT$
STA. 612+36.14
FD P.K./WASHER
3/20/03
SET MAG/WASHER
8/19/03, MDB
FD MAG/WASHER
REF33
5/27/21, TDN
4/7/22, JFO
FD MAG/WASHER
REF33
8/3/23, DSA
SET MAG/WASHER
11/22/23, DSA

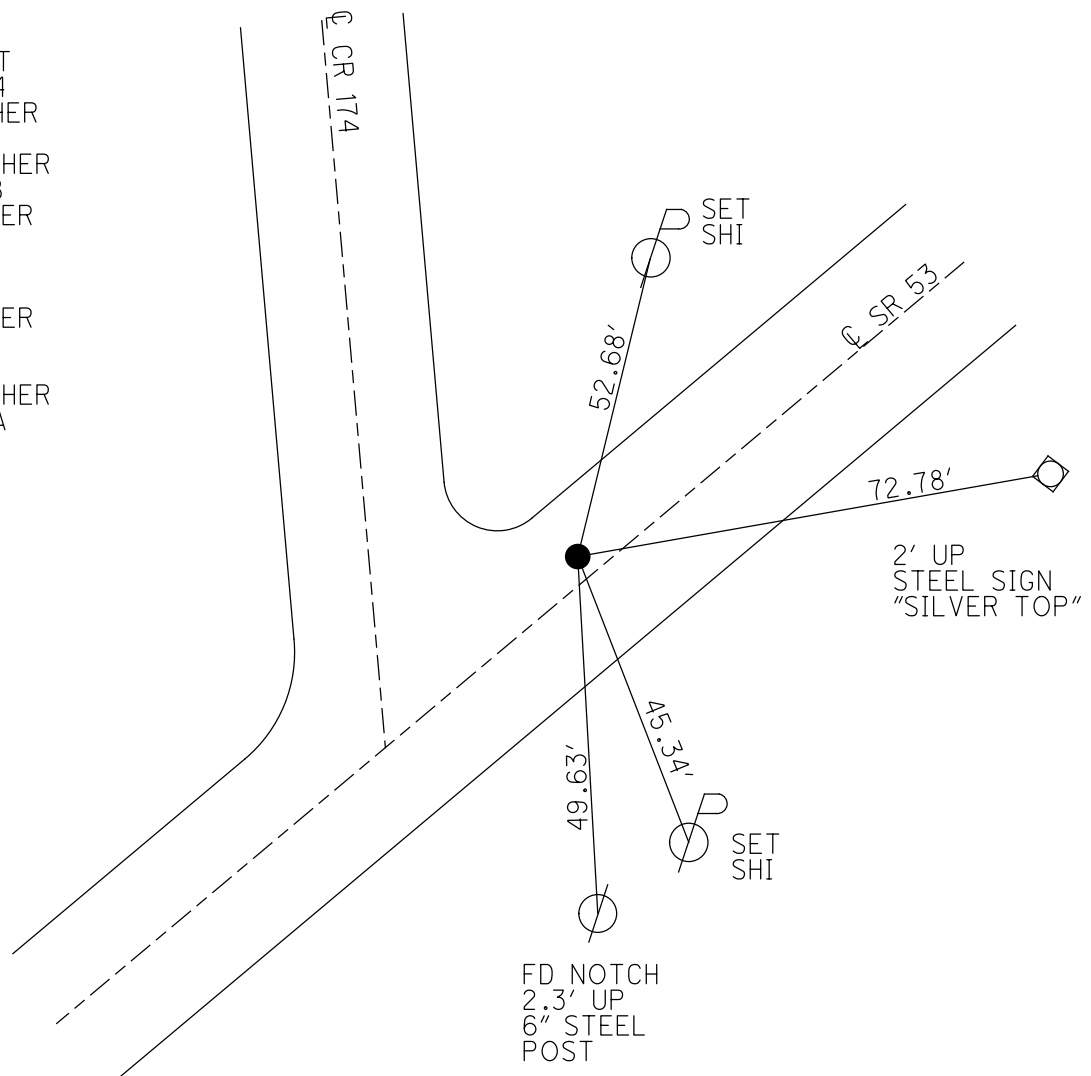

O.D.O.T. DISTRICT 2 SURVEY OFFICE (USE ONLY)

PERSONNEL

REFERENCE NO. 34

SHEET 9 OF 19

NOTES RHOADES

DATE 11/22/23

ROUTE SR 53

H.C. AUBLE

WEATHER CLOUDY

COUNTY SANDUSKY

R.C. MILLER

TEMP. 43°

TOWNSHIP RICE

NIESE, ASTON

SECTION 11

DWG BY RHOADES PID 95760

T 5 N R 15 E

TYPE MONUMENT P.K./WASHER

ON SURFACE - ~~BELOW~~ ON

OFFSET 0.3' ~~LT~~ : RT

11.6' TO RT EDGE PAVEMENT


STATION: 746+43

HORIZ.DATUM: NAD83 2011


GEOID: NAVD88 2018

GRID: NORTHING: 637201.375

EASTING: 1805338.345

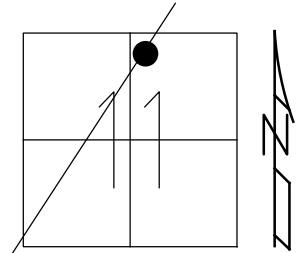

RECORD: P.I.
STA. 620+78.11
 $\Delta = 00^\circ 13' \text{ LT}$
SET MAG/WASHER
8/19/03, MDB
FD RUSTY HOLE
REF34
8/8/23, DSA
SET MAG/WASHER
11/22/23, DSA

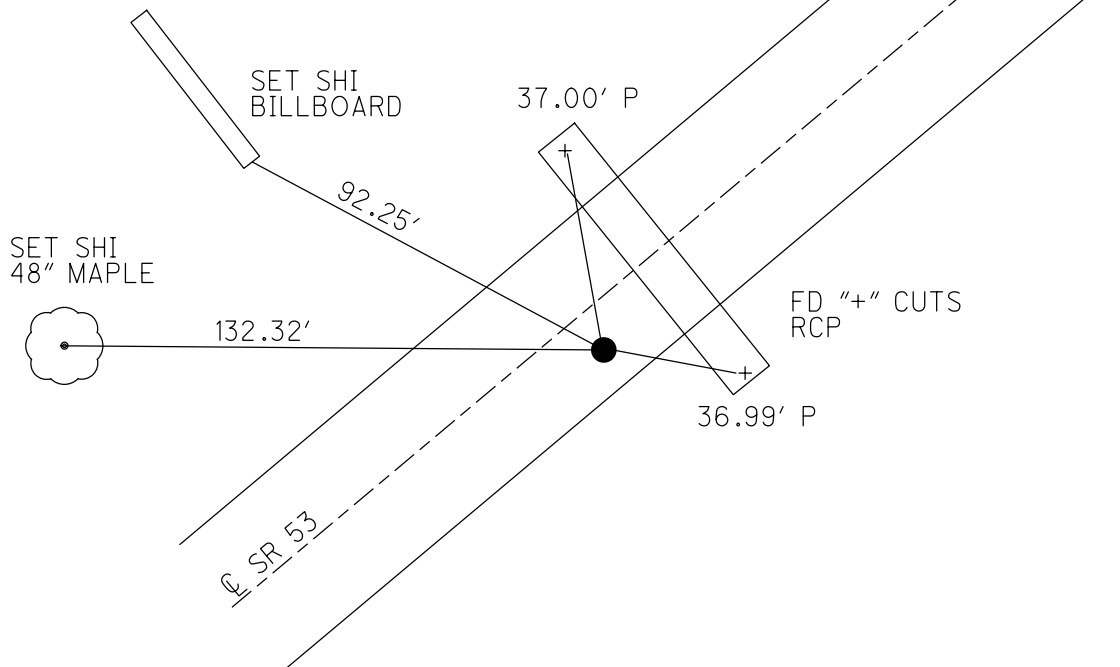

O.D.O.T. DISTRICT 2 SURVEY OFFICE (USE ONLY)

PERSONNEL

REFERENCE NO. 34 A

SHEET 10 OF 19

NOTES RHOADES

DATE 11/22/23

ROUTE SR 53

H.C. AUBLE

WEATHER CLOUDY

COUNTY SANDUSKY

R.C. MILLER

TEMP. 43°

TOWNSHIP RICE

NIESE, ASTON

SECTION 2

DWG BY RHOADES

PID 95760

T 5 N R 15 E

TYPE MONUMENT MAG/WASHER

ON SURFACE - ~~BELOW~~ ON

OFFSET Q PAVEMENT 1' LT : ~~RT~~

10.7' TO LT EDGE PAVEMENT


STATION: 755+37

HORZ.DATUM: NAD83 2011


GEOID: NAVD88 2018

GRID: NORTHING: 637891.546

EASTING: 1805906.529

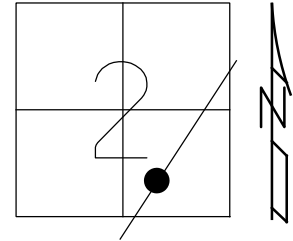

RECORD: P.I.
 $\Delta = 01^{\circ} 17' \text{ RT}$
STA. 629+71.94
FD P.K./WASHER
3/20/03, MDB
SET MAG/WASHER
8/19/03, MDB
FD MAG/WASHER
REFA34
5/27/21, TDN
4/7/22, JFO
FD MAG/WASHER
REF34A
8/8/23, DSA
SET MAG/WASHER
11/22/23, DSA

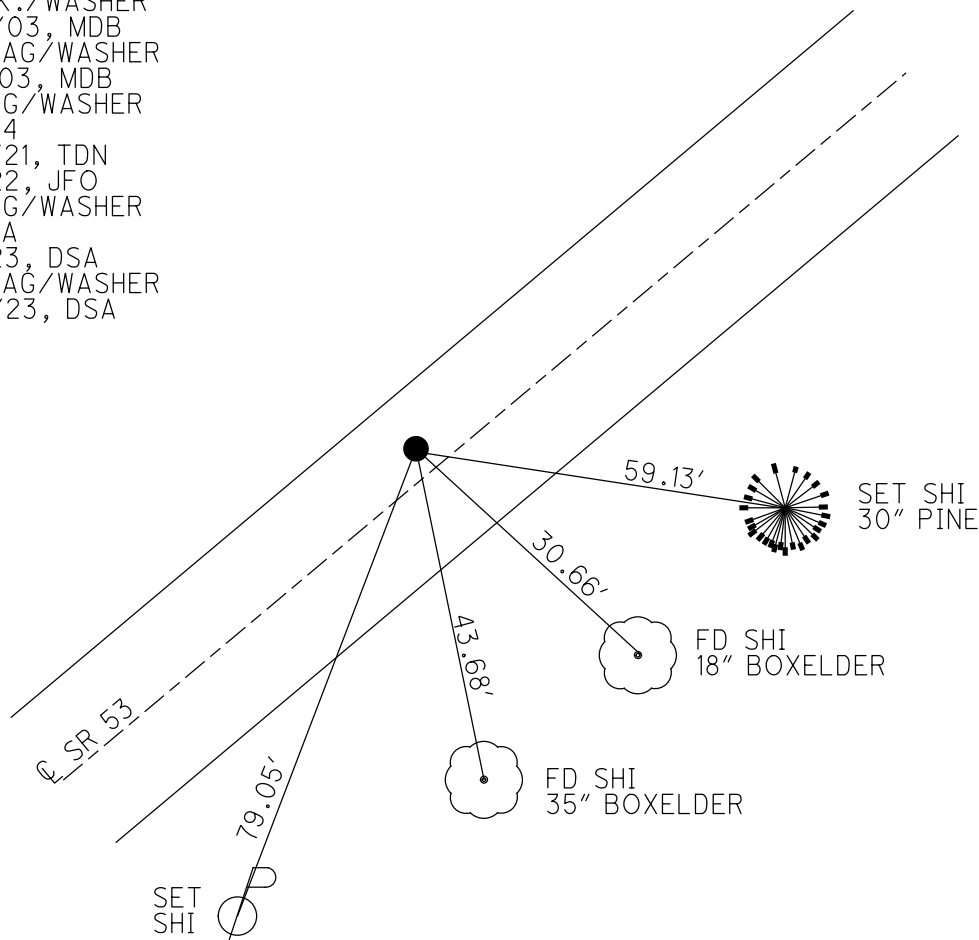

O.D.O.T. DISTRICT 2 SURVEY OFFICE (USE ONLY)

PERSONNEL

REFERENCE NO. 35

SHEET 11 OF 19

NOTES RHOADES

DATE 11/22/23

ROUTE SR 53

H.C. AUBLE

WEATHER CLOUDY

COUNTY SANDUSKY

R.C. MILLER
NIESE, ASTON

TEMP. 43°

TOWNSHIP RICE

DWG BY RHOADES

PID 95760

SECTION 1

T 5 N R 15 E

TYPE MONUMENT SM.SPIKE

ON SURFACE - ~~BELOW~~ ON

OFFSET Q PAVEMENT ON LT : RT

11.6' TO RT EDGE PAVEMENT


STATION: 786+95

HORIZ.DATUM: NAD83 2011


GEOID: NAVD88 2018

GRID: NORTHING: 640284.623

EASTING: 1807967.053

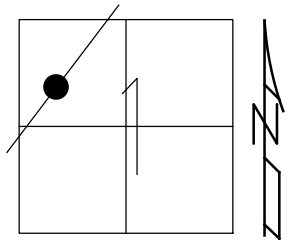

RECORD: P.I.
 $\Delta = 00^\circ 10' \text{ RT}$
STA.661+29.75
FD P.K./WASHER
3/20/03, MDB
SET MAG/WASHER
6/02/03, MDB
FD MAG/WASHER
REF35
5/27/21, TDN
FD MAG/WASHER
REF35
8/8/23, DSA
SET SM.SPIKE
11/22/23, DSA

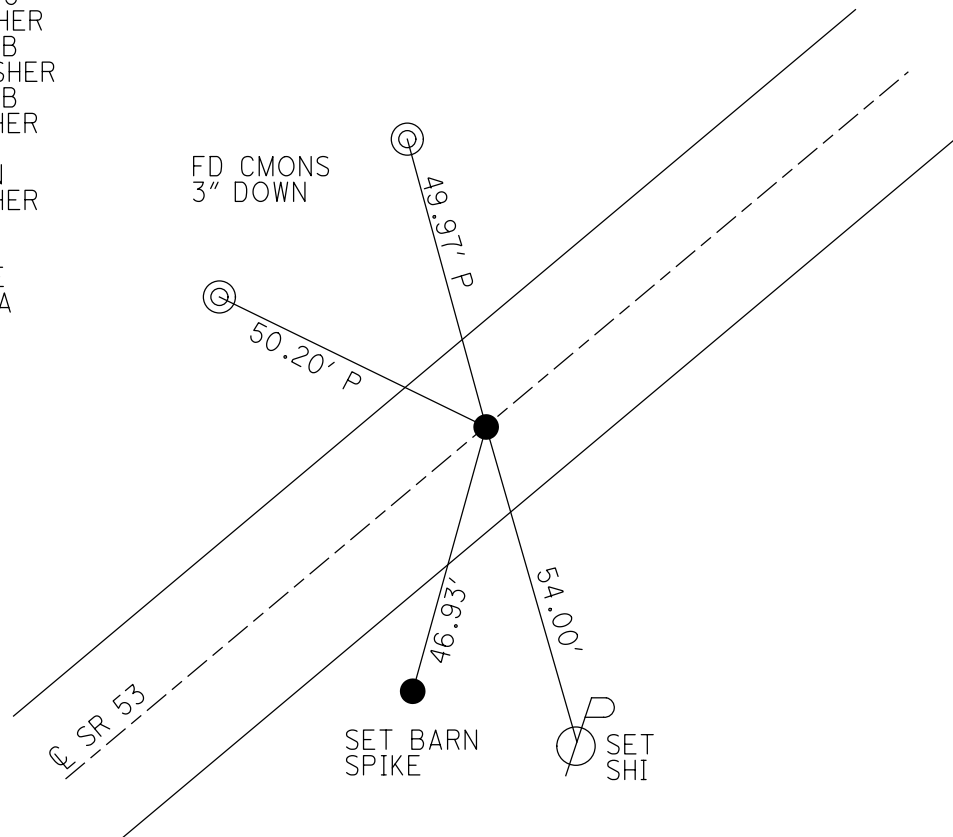

O.D.O.T. DISTRICT 2 SURVEY OFFICE (USE ONLY)

PERSONNEL

REFERENCE NO. 35 A

SHEET 12 OF 19

NOTES RHOADES

DATE 11/28/23

ROUTE SR 53

H.C. AUBLE

WEATHER CLOUDY

COUNTY SANDUSKY

R.C. NIESE

TEMP. 22°

TOWNSHIP RICE

ASTON

SECTION 36

DWG BY RHOADES PID 95760

T 5 N R 15 E

TYPE MONUMENT MAG/WASHER

ON SURFACE - ~~BELOW~~ ON

OFFSET CL PAVEMENT 1' LT : RT

11.3' TO RT EDGE PAVEMENT



STATION: 821+45

HORZ.DATUM: NAD83 2011

GEOID: NAVD88 2018

GRID: NORTHING: 642898.367

EASTING: 1810219.647

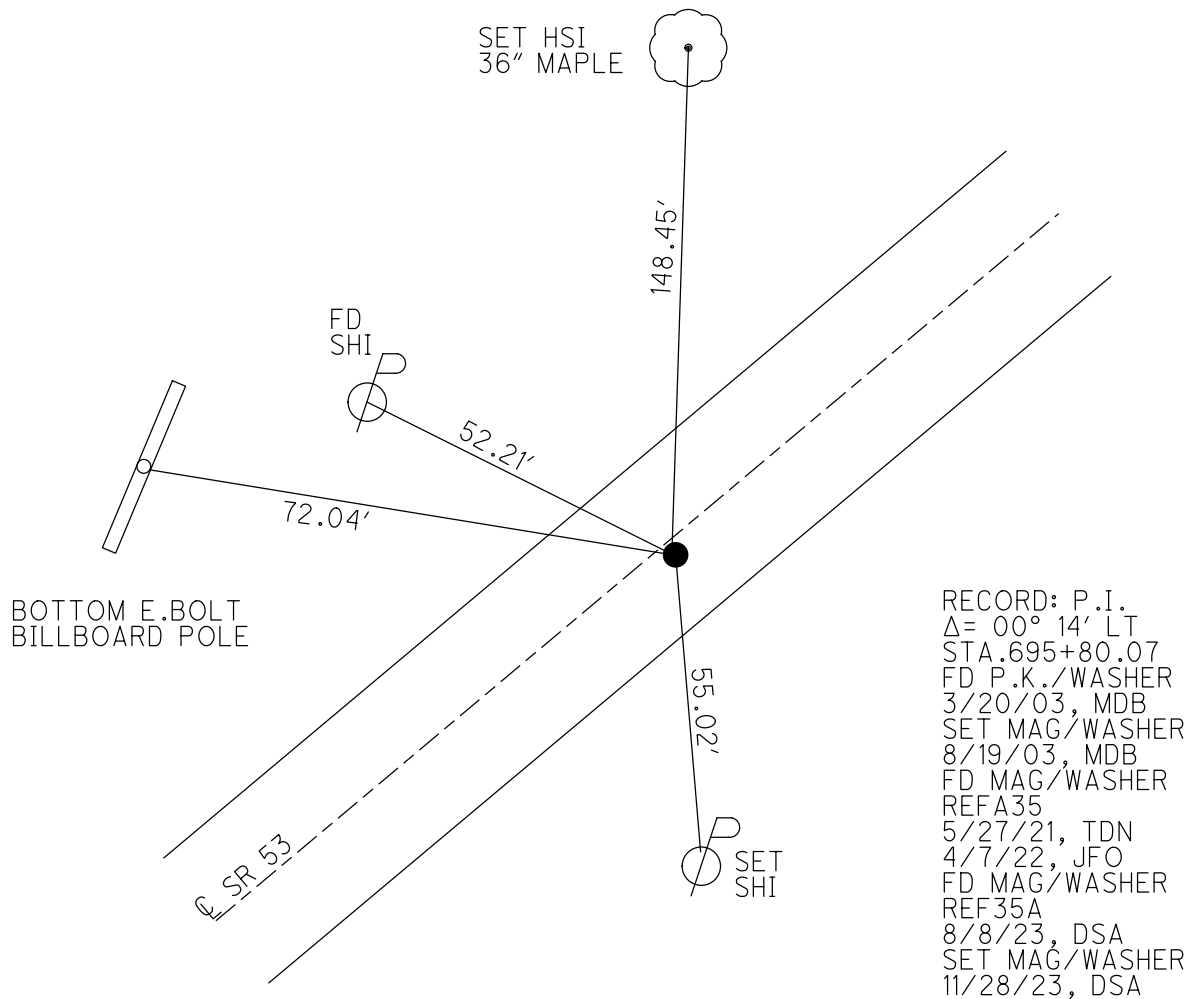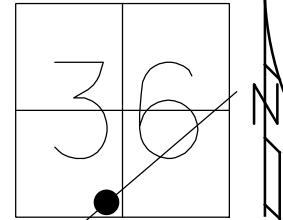

O.D.O.T. DISTRICT 2 SURVEY OFFICE (USE ONLY)

PERSONNEL

REFERENCE NO. 36

SHEET 13 OF 19

NOTES RHOADESDATE 11/28/23ROUTE SR 53

H.C. AUBLE

WEATHER CLOUDY

COUNTY SANDUSKY

R.C. NIESE

TEMP. 22°

TOWNSHIP RICE

ASTON

DWG BY RHOADES

PID 95760

T_5_N R_15_E

TYPE MONUMENT MAG/WASHER

ON SURFACE - ~~BELOW~~ _____ ON

OFFSET C PAVEMENT ON LT : RT



12.2' TO LT EDGE PAVEMENT

STATION: 862+04

HORZ.DATUM: NAD83 2011

GEOID: NAVD88 2018

GRID: NORTHING: 645983.725

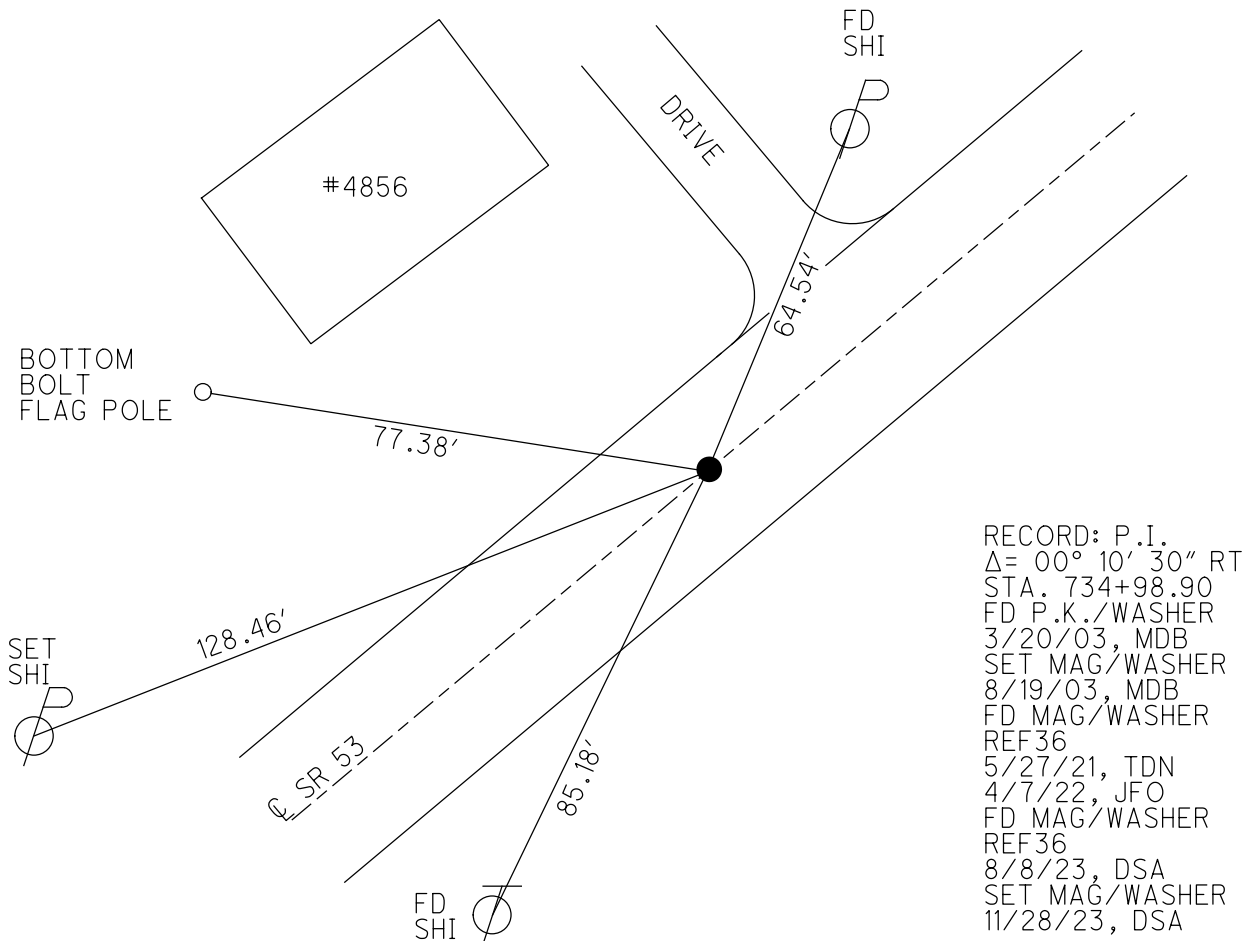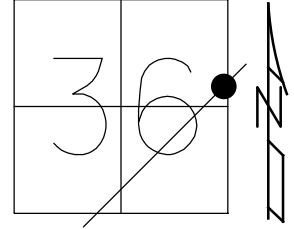EASTING: 1812852.932

RECORD: P.I.
Δ= 00° 10' 30" RT
STA. 734+98.90
FD P.K./WASHER
3/20/03, MDB
SET MAG/WASHER
8/19/03, MDB
FD MAG/WASHER
REF36
5/27/21, TDN
4/7/22, JFO
FD MAG/WASHER
REF36
8/8/23, DSA
SET MAG/WASHER
11/28/23, DSA

O.D.O.T. DISTRICT 2 SURVEY OFFICE (USE ONLY)

PERSONNEL

REFERENCE NO. 36 A

SHEET 14 OF 19

NOTES RHOADES

DATE 11/28/23

ROUTE SR 53

H.C. AUBLE

WEATHER SUNNY

COUNTY SANDUSKY

R.C. NIESE

TEMP. 22°

TOWNSHIP RICE

ASTON

SECTION 31

DWG BY RHOADES

PID 95760

T 5 N R 16 E

TYPE MONUMENT MAG/WASHER

ON SURFACE - ~~BELOW~~ ON

OFFSET Q PAVEMENT 0.5' LT : RT

11.4' TO RT EDGE PAVEMENT


STATION: 882+60

HORIZ.DATUM: NAD83 2011


GEOID: NAVD88 2018

GRID: NORTHING: 647543.397

EASTING: 1814192.659

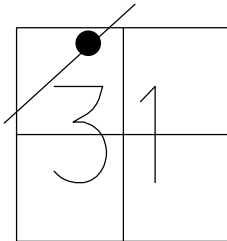

RECORD:
FD P.K./WASHER
3/20/02, MDB
SET MAG/WASHER
8/19/03, MDB
FD MAG/WASHER
REF A36
5/27/21, TDN
4/7/22, JFO
FD MAG/WASHER
REF 36A
8/8/23, DSA
SET MAG/WASHER
11/28/23, DSA

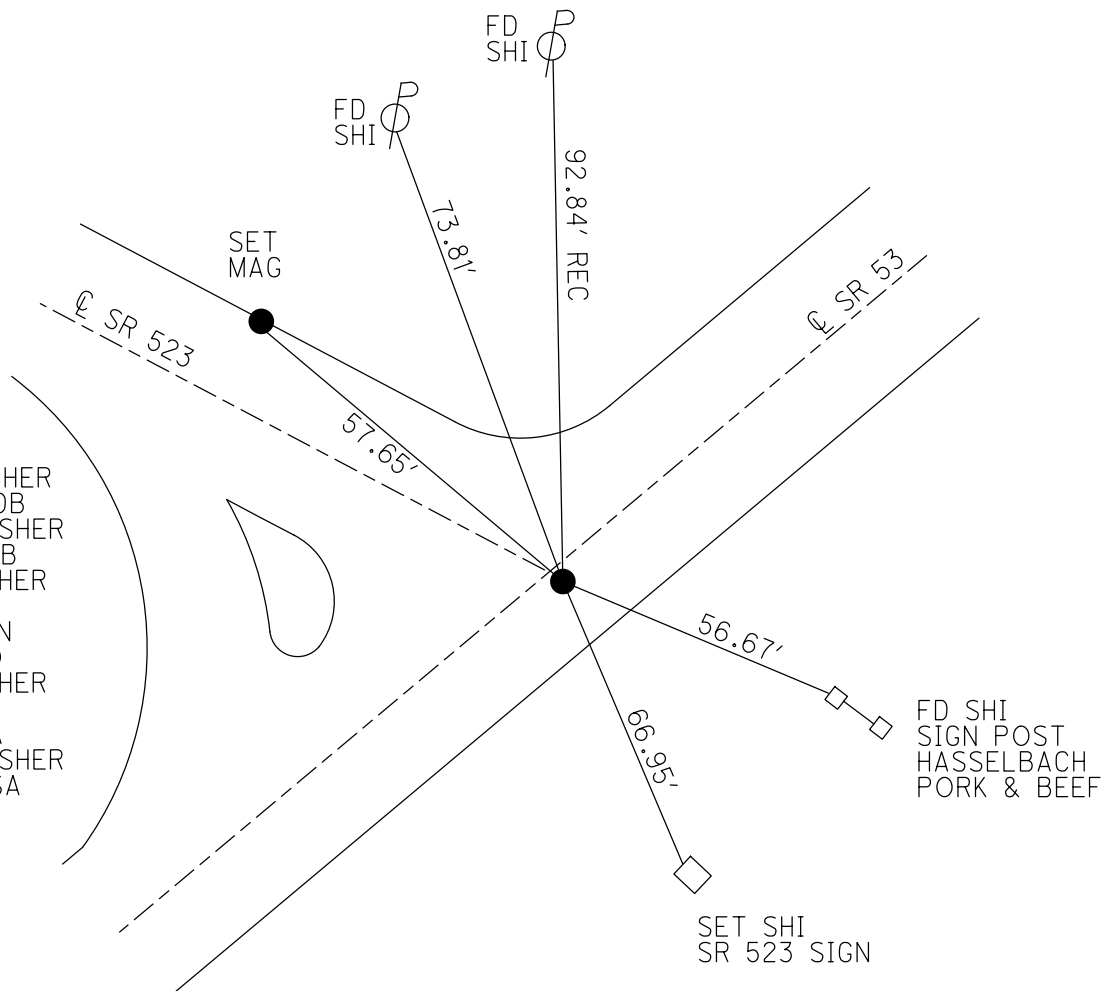

O.D.O.T. DISTRICT 2 SURVEY OFFICE (USE ONLY)

PERSONNEL

REFERENCE NO. 36 B

SHEET 15 OF 19

NOTES RHOADES

DATE 11/28/23

ROUTE SR 53

H.C. AUBLE

WEATHER SUNNY

COUNTY SANDUSKY

R.C. NIESE

TEMP. 22°

TOWNSHIP RICE

ASTON

SECTION 30

DWG BY RHOADES

PID 95760

T 5 N R 16 E

TYPE MONUMENT MAG/WASHER

ON SURFACE - ~~BELOW~~ ON

OFFSET Q PAVEMENT 0.5' ~~LT~~ : RT

12.5' TO LT EDGE PAVEMENT


STATION: 885+44

HORIZ.DATUM: NAD83 2011


GEOID: NAVD88 2018

GRID: NORTHING: 647757.666

EASTING: 1814376.516

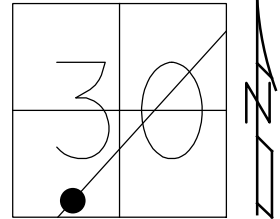

RECORD:
FD P.K.NAIL
3/20/03, MDB
SET MAG/WASHER
8/19/03, MDB
FD MAG/WASHER
REFB36
5/27/21, TDN
4/7/22, JFO
FD MAG/WASHER
REF36B
8/8/23, DSA
SET MAG/WASHER
11/28/23, DSA

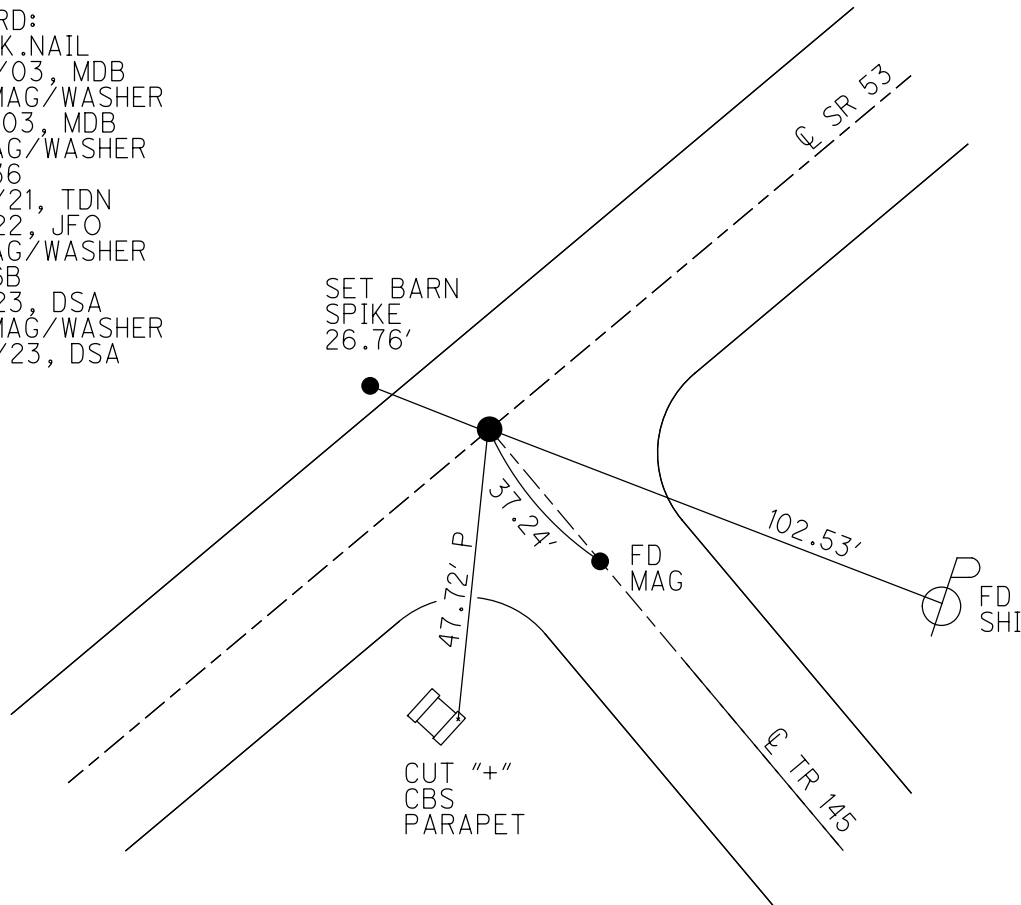

O.D.O.T. DISTRICT 2 SURVEY OFFICE (USE ONLY)

PERSONNEL

REFERENCE NO. 37

SHEET 16 OF 19

NOTES RHOADES

DATE 11/28/23

ROUTE SR 53

H.C. AUBLE

WEATHER SUNNY

COUNTY SANDUSKYR.C. NIESE

TEMP. 22°

TOWNSHIP RICE

ASTON

SECTION 30DWG BY RHOADESPID 95760T₅N R₁₆E

TYPE MONUMENT MAG/WASHER

ON SURFACE - ~~BELOW~~ ON

OFFSET @ PAVEMENT 0.5' ~~LT~~ : RT


11.3' TO RT EDGE PAVEMENT

STATION: 888+28


HORZ.DATUM: NAD83 2011

GEOID: NAVD88 2018

GRID: NORTHING: 647976.898

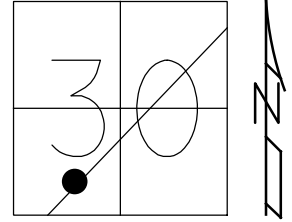EASTING: 1814564.943

RECORD: P.1.
Δ= 00°02 RT
STA.762+63.75
FD P.K.NAIL
3/20/03, MDB
SET MAG/WASHER
8/19/03, MDB
FD MAG/WASHER
REF37
5/27/21, TDN
4/7/22, JFO
FD RUSTY HOLE
REF37
8/8/23, DSA
SET MAG/WASHER
11/28/23, DSA

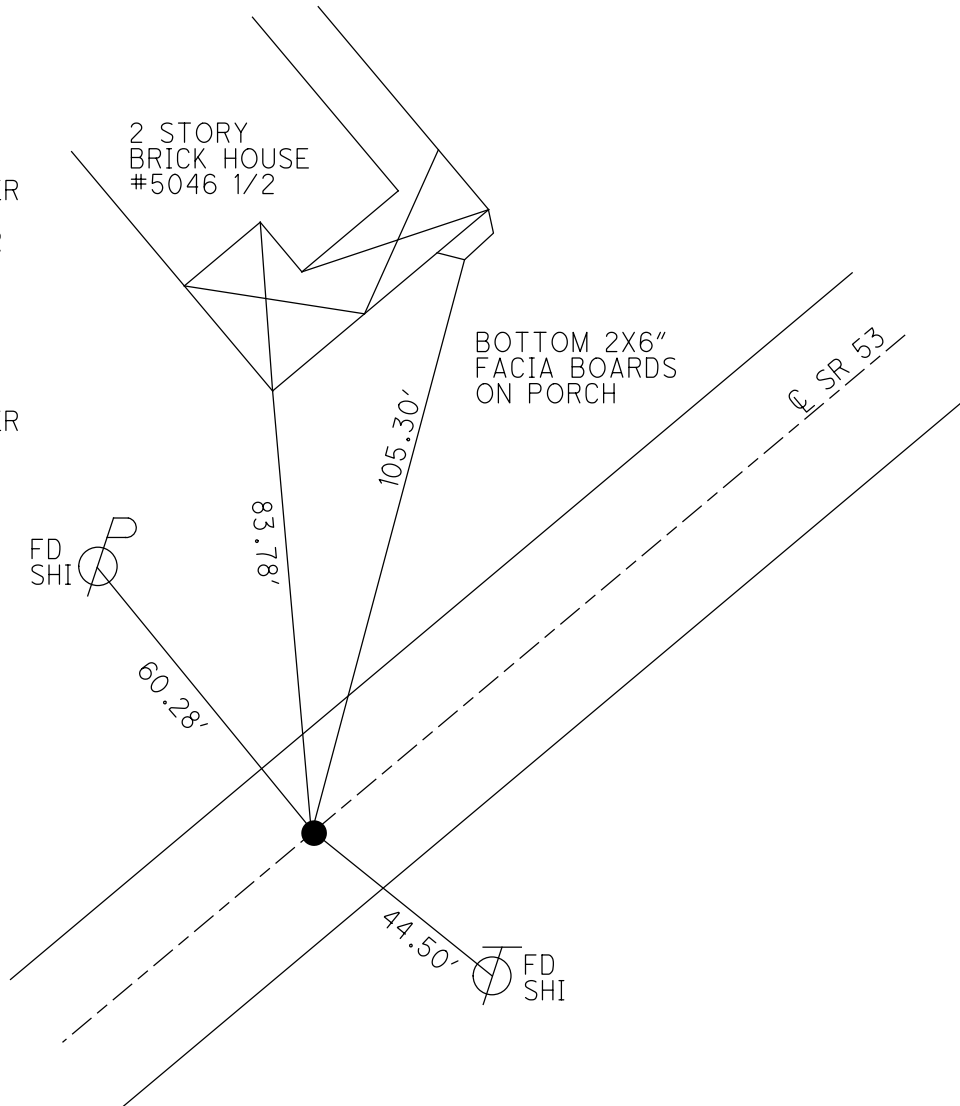

O.D.O.T. DISTRICT 2 SURVEY OFFICE (USE ONLY)

PERSONNEL

REFERENCE NO. 38

SHEET 17 OF 19

NOTES RHOADES

DATE 11/28/23

ROUTE SR 53

H.C. AUBLE

WEATHER SUNNY

COUNTY SANDUSKY

R.C. NIESE

TEMP. 22°

TOWNSHIP RICE

ASTON

SECTION 30

DWG BY RHOADES

PID 95760

T 5 N R 16 E

TYPE MONUMENT MAG/WASHER

ON SURFACE - ~~BELOW~~ ON

OFFSET Q PAVEMENT 5.0' ~~LT~~ : RT

7.2' TO RT EDGE PAVEMENT


STATION: 906+72

HORIZ.DATUM: NAD83 2011


GEOID: NAVD88 2018

GRID: NORTHING: 649366.211

EASTING: 1815750.085

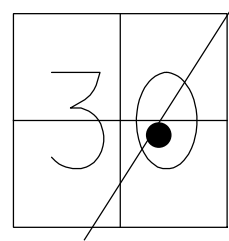

RECORD:
PI. SURVEY CURVE
TS. OF CONST. CURVE
SET MAG/WASHER
6/02/03, MDB
FD MAG/WASHER
REF38
8/8/23, DSA
SET MAG/WASHER
11/28/23, DSA

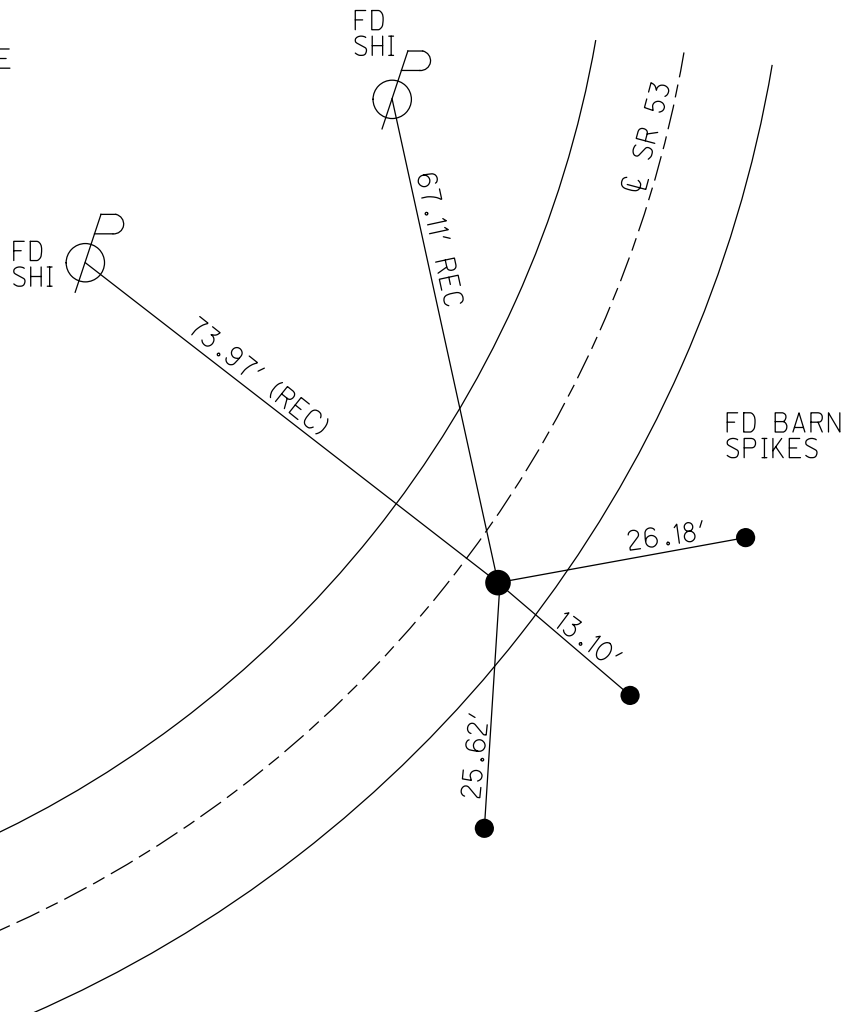

O.D.O.T. DISTRICT 2 SURVEY OFFICE (USE ONLY)

PERSONNEL

REFERENCE NO. 39

SHEET 18 OF 19

NOTES RHOADES

DATE 11/28/23

ROUTE SR 53

H.C. AUBLE

WEATHER SUNNY

COUNTY SANDUSKY

R.C. NIESE

TEMP. 22°

TOWNSHIP RICE

ASTON

SECTION 30

DWG BY RHOADES

PID 95760

T 5 N R 16 E

TYPE MONUMENT MAG/WASHER

ON SURFACE - ~~BELOW~~ ON

OFFSET Q PAVEMENT 9.5' LT : ~~RT~~

2.7' TO LT EDGE PAVEMENT


STATION: 928+78

HORZ.DATUM: NAD83 2011

GEOID: NAVD88 2018


GRID: NORTHING: 651407.266

EASTING: 1816543.519

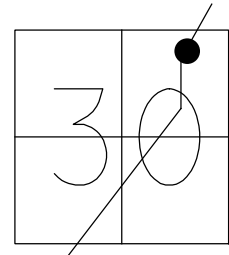

RECORD:

FD P.K./WASHER
3/27/03, MDB
SET MAG/WASHER
8/19/03, MDB
FD MAG SHANK
REF39
5/27/21, JMR
D.N.F
4/7/22
SET MAG/WASHER
NEWREF39
7/22/22, TDN
FD MAG/WASHER
REF39
8/8/23, DSA
SET MAG/WASHER
11/28/23, DSA

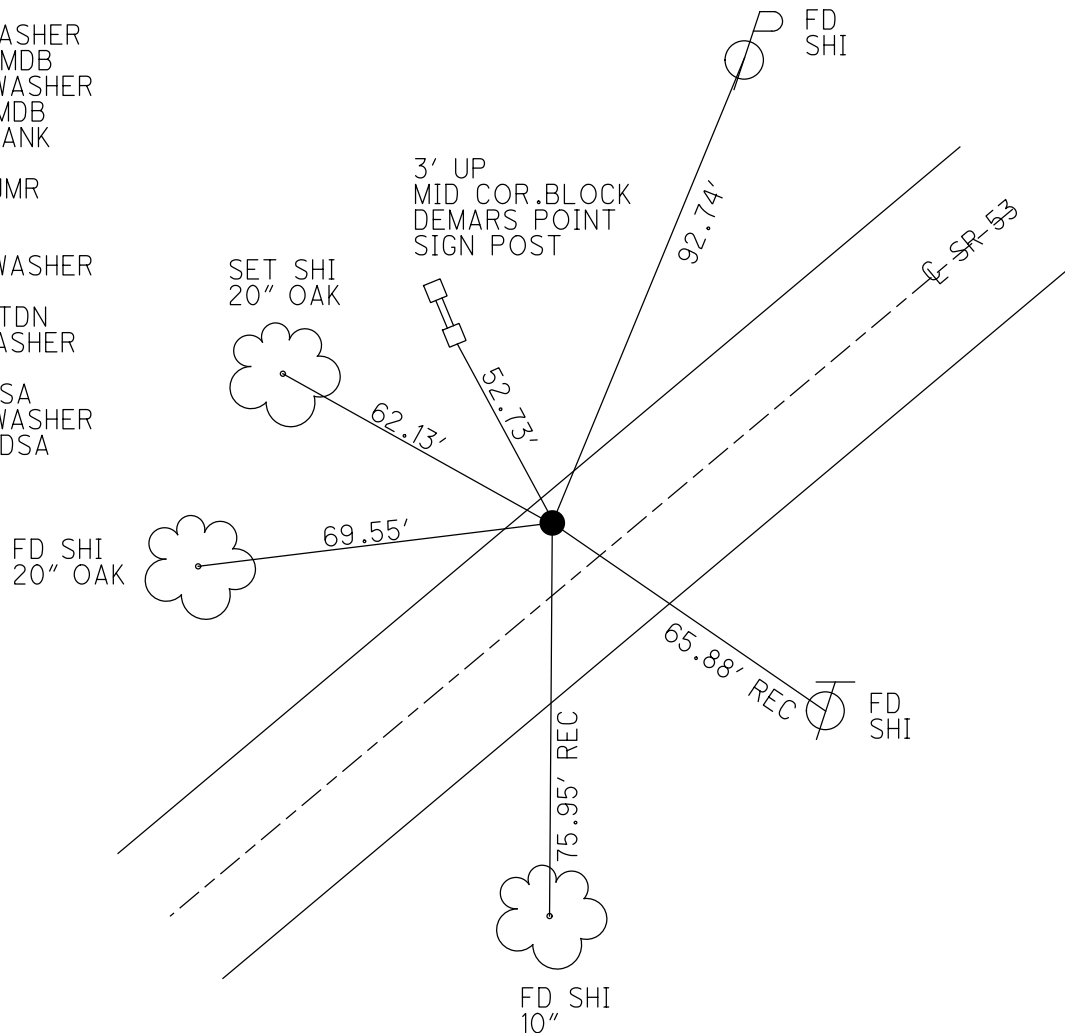

O.D.O.T. DISTRICT 2 SURVEY OFFICE (USE ONLY)

PERSONNEL

REFERENCE NO. 40

SHEET 19 OF 19

NOTES RHOADES

DATE 11/28/23

ROUTE SR 53

H.C. AUBLE

WEATHER SUNNY

COUNTY SANDUSKY

R.C. NIESE

TEMP. 22°

TOWNSHIP RICE

ASTON

SECTION 30

DWG BY RHOADES PID 95760

T 5 N R 16 E

TYPE MONUMENT MAG/WASHER

~~ON SURFACE~~ - BELOW 1"

OFFSET Q PAVEMENT ON LT : RT

11' TO RT EDGE PAVEMENT


STATION: 945+19

HORZ.DATUM: NAD83 (2011)

GEOID: NAVD88 2018

GRID: NORTHING: 652879.790

EASTING: 1817266.110

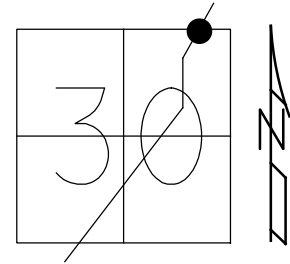

RECORD: P.I.

$\Delta = 0^\circ 36' \text{ LT}$

STA.819+87.42

SET PK/WASHER

ATOP R.R. SPIKE

12-5-84

SET PK/WASHER

8-5-93, JLR

FD PK/WASHER

5-30-00, BC

SET PK/WASHER

7-26-00, SAH

FD P.K./WASHER

3/27/03, MDB

FD PK/WASHER

REF1

6-22-15, JFO

FD PK/WASHER

3-23-17, DCH

SET MAG/WASHER

REF1

5-8-18, JLL

FD MAG/WASHER

REF40

8/8/23, DSA

SET MAG/WASHER

1" DOWN

11/28/23, DSA

