



O.D.O.T. DISTRICT 2 SURVEY OFFICE (USE ONLY)

PERSONNEL		REFERENCE NO. <u>1A</u>	SHEET <u>2</u> OF <u>11</u>
NOTES <u>MILLER</u>	DATE <u>8/7/24</u>	ROUTE <u>SR 101</u>	
H.C. <u>MILLER</u>	WEATHER <u>SUNNY</u>	COUNTY <u>SANDUSKY</u>	
R.C. <u>BARRIERE</u>	TEMP. <u>70</u>	TOWNSHIP <u>GREEN CREEK</u>	
<u>BLUBAUGH, ASTON, PRESTON-COLVIN</u>		SECTION <u>35</u>	
DWG BY <u>BLUBAUGH</u>	PID <u>114849</u>	T <u>4</u> N R <u>16</u> E	
TYPE MONUMENT <u>LG R.R.SPIKE</u>			
ON SURFACE - BELOW <u>9"</u>			
OFFSET <u>Q</u> PAVEMENT <u>0.5'</u> LT : RT			
<u>TO</u> EDGE PAVEMENT			
STATION: <u>6+50</u>			
HORZ.DATUM: <u>NAD83 2011</u>		GEOID: <u>NAVD88-2018</u>	
GRID: NORTHING: <u>579668.064</u>		EASTING: <u>1837257.967</u>	
LDP: NORTHING: <u>275911.745</u>		EASTING: <u>197768.385</u>	

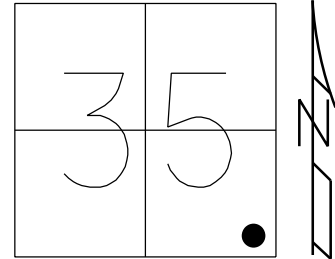

RECORD:
 STA. 6+49.78
 P.K./WASHER
 ATOP IPIN
 SET P.K./WASHER
 10/1/92
 FD IPIN
 6" DOWN
 SET MAG/WASHER
 6/26/08, DCH
 FD LG.R.R.SPIKE
 9" DOWN
 REF1
 6/16/16, JFO
 FD HOLE
 W/R.R.SPIKE
 9/12/17, JMR
 FD LG.R.R.SPIKE
 9" DOWN
 REF1A
 12/11/23, JAM
 FD TONE. DID NOT
 UNCOVER. PAINTED
 8/7/24, JAM


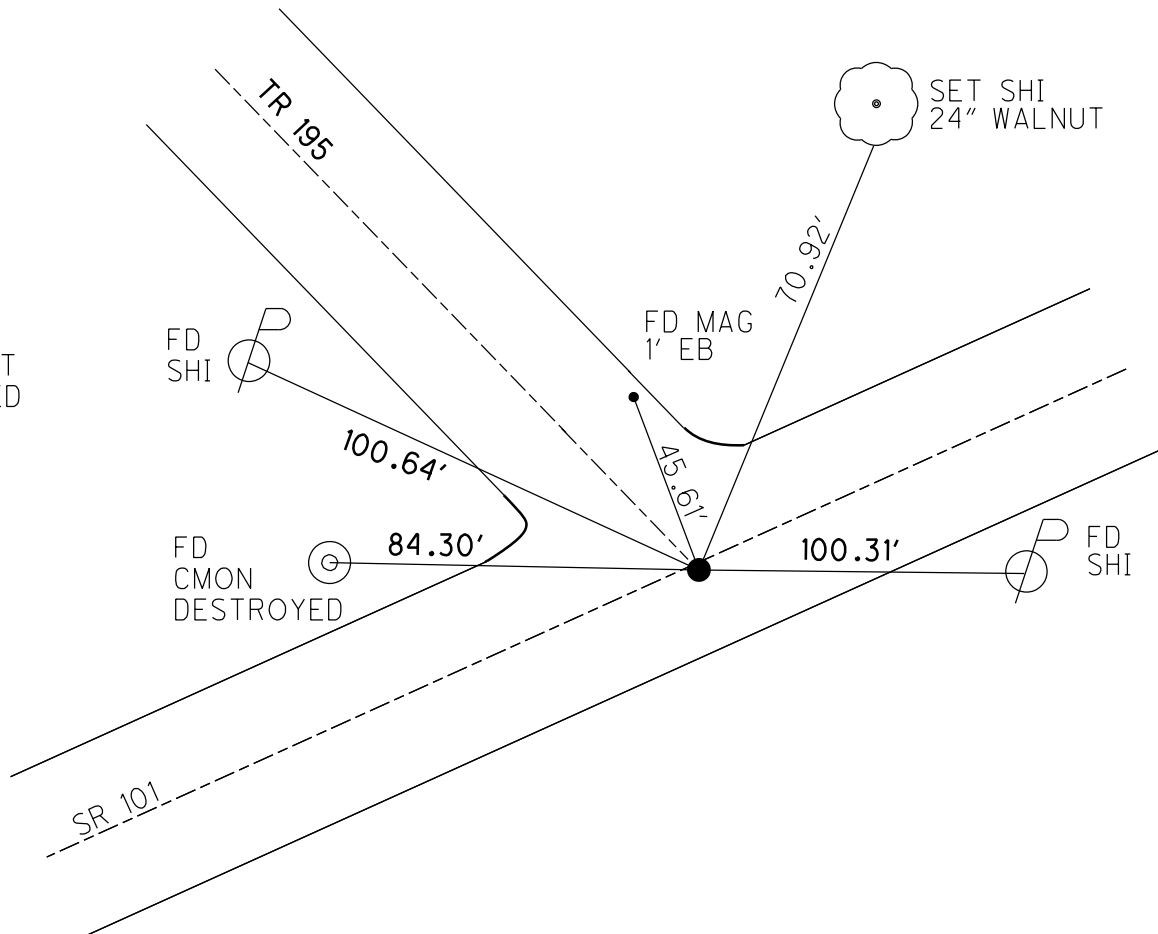


O.D.O.T. DISTRICT 2 SURVEY OFFICE (USE ONLY)

PERSONNEL	REFERENCE NO. <u>1A</u>	SHEET <u>2</u> OF <u>11</u>	
NOTES	RHOADES	DATE <u>3/28/17</u>	ROUTE <u>SR 101</u>
H.C.	O'DONNELL	WEATHER <u>CLOUDY</u>	COUNTY <u>SANDUSKY</u>
R.C.	HELDMAN	TEMP. <u>43°</u>	TOWNSHIP <u>GREEN CREEK</u>
			SECTION <u>35</u>
			T <u>4</u> N R <u>16</u> E

TYPE MONUMENT R.R.SPIKE
 ON SURFACE - ~~BELOW~~ 9"
~~LEFT~~ - Q PAV'T - RIGHT 0.5'
- TO - EDGE PAVEMENT
 S.L.M. 6+50

GRID: NORTHING: 579668.064 EASTING: 1837257.967

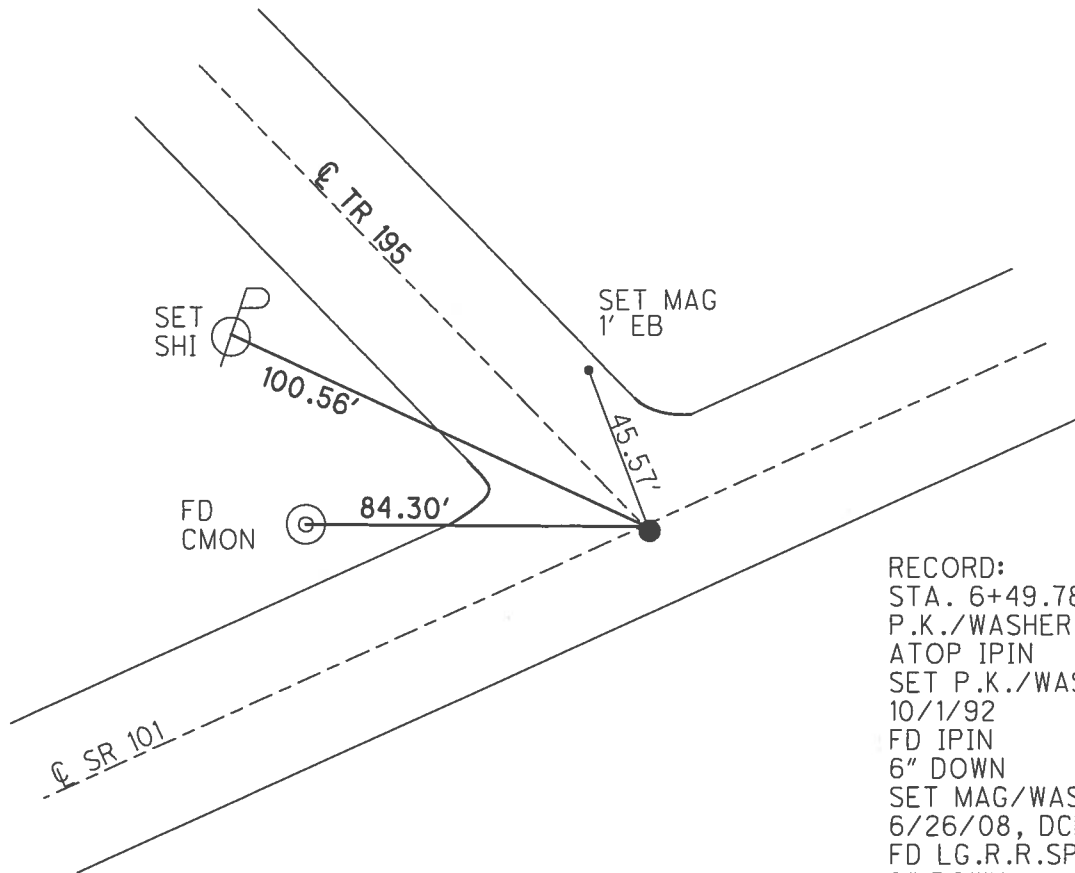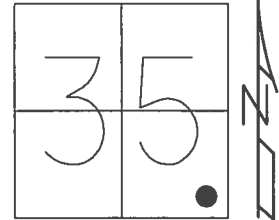

RECORD:
 STA. 6+49.78
 P.K./WASHER
 ATOP IPIN
 SET P.K./WASHER
 10/1/92
 FD IPIN
 6" DOWN
 SET MAG/WASHER
 6/26/08, DCH
 FD LG.R.R.SPIKE
 9" DOWN
 REF1
 6/16/16, JFO
 FD HOLE
 W/R.R.SPIKE
 9/12/17, JMR

O.D.O.T. DISTRICT 2 SURVEY OFFICE (USE ONLY)

PERSONNEL

REFERENCE NO. 1A

SHEET 2 OF 10

NOTES

HOMAN

DATE

6-26-2008

ROUTE

SR 101

H.C.

ROUSOS

WEATHER

CLOUDY

COUNTY

SANDUSKY

R.C.

HOMAN

TEMP.

85°

TOWNSHIP

GREEN CREEK

SECTION

35

T 4 N R 16 E

TYPE MONUMENT

IPIN

ON SURFACE - ~~BELOW~~


6"

~~LEFT~~ - Q PAV'T - RIGHT 0.5'

- TO - EDGE PAVEMENT

S.L.M. 6+50

GRID: NORTHING: 579668.070 EASTING: 1837257.953

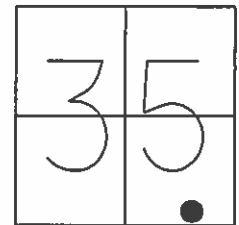

RECORD:

STA. 6+49.78

P.K./WASHER


ATOP IPIN

SET P.K./WASHER

10/1/92

SET MAG/WASHER

6/26/08

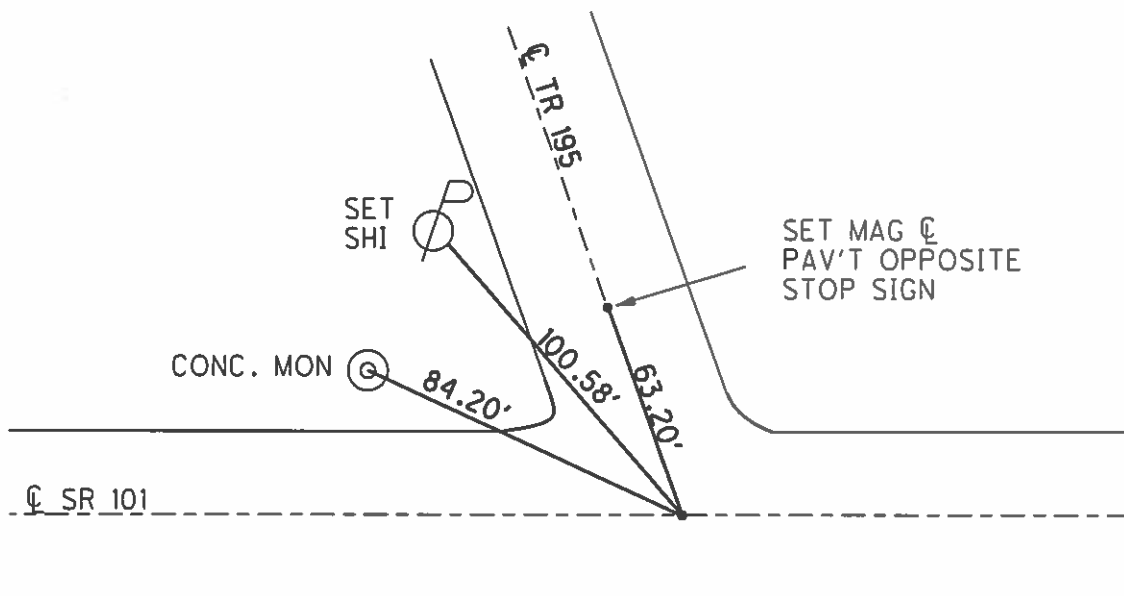

O.D.O.T. DISTRICT 2 SURVEY OFFICE

PERSONNEL

REFERENCE NO. 1-A

SHEET 2 OF 10

NOTES Cheney

H.C. RIPPLE

R.C. BARBOUR

DATE 10-1-92

WEATHER SUNNY

TEMP. 65°

ROUTE SR#101

COUNTY SANDUSKY

TOWNSHIP GREEN CREEK

SECTION 35

T 4 N R 16 E

TYPE MONUMENT P.K. & washer

ON SURFACE - BELOW YES


LEFT - & PAW'T. - RIGHT 0.5'

TO EDGE PAVEMENT


S.L.M. 6+50

Re-set
P.K. / washer
10-1-92

(1A)

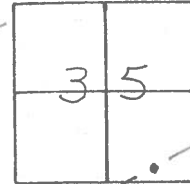

Record: 6+49.78
PK & washer ATOP
IRON ROD

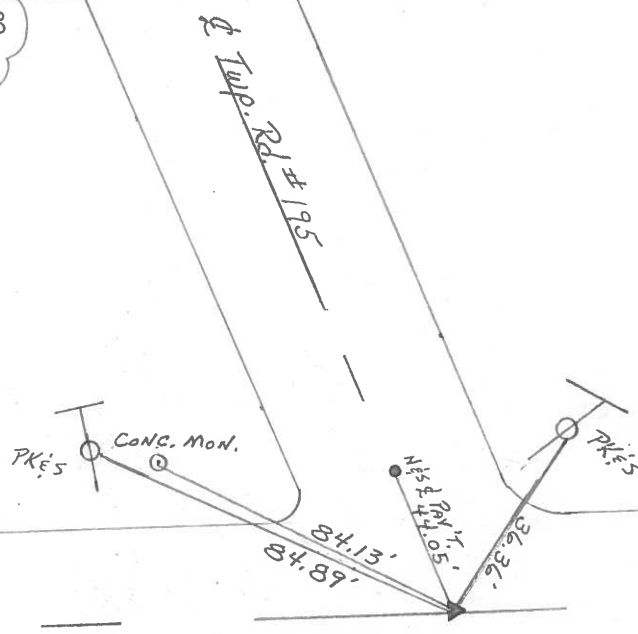

QD.O.T. DISTRICT 2 SURVEY OFFICE

SHEET 2 OF 10

County Sandusky S.R. 101

Township Green Creek

Section 35

T 4 N, R 16 E

Personnel Cronin

Ripke


Geyman

Barbour


Date 11/17/83

Weather overcast

Temp. 34°

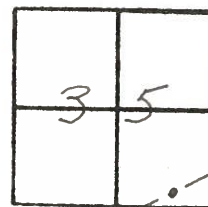

#1-A

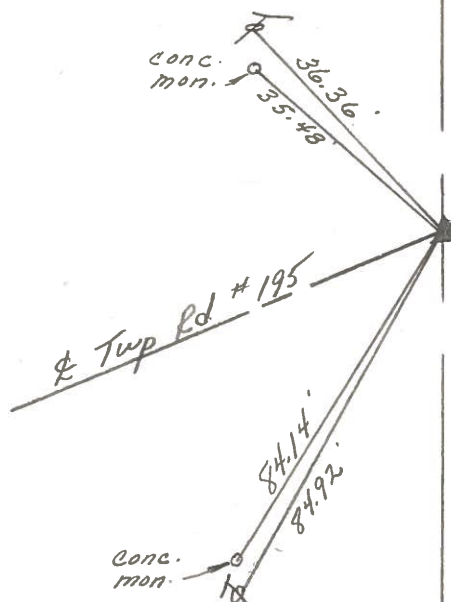

6+49.78

P.K. & washer at top

iron rod

S.R. #101

PERSONNEL TITLE PERSONNEL TITLE

Schneider

COUNTY Sandusky

DATE Feb. 29, 1968

Mosser

S. R. # 101

WEATHER Cloudy - SNOW

Borbor

Potts

SEC. Sen-San. Co. line North TEMP. 25'


DESCRIPTION Ties for Control Points

JOB NO.

LEFT

CENTER LINE

RIGHT

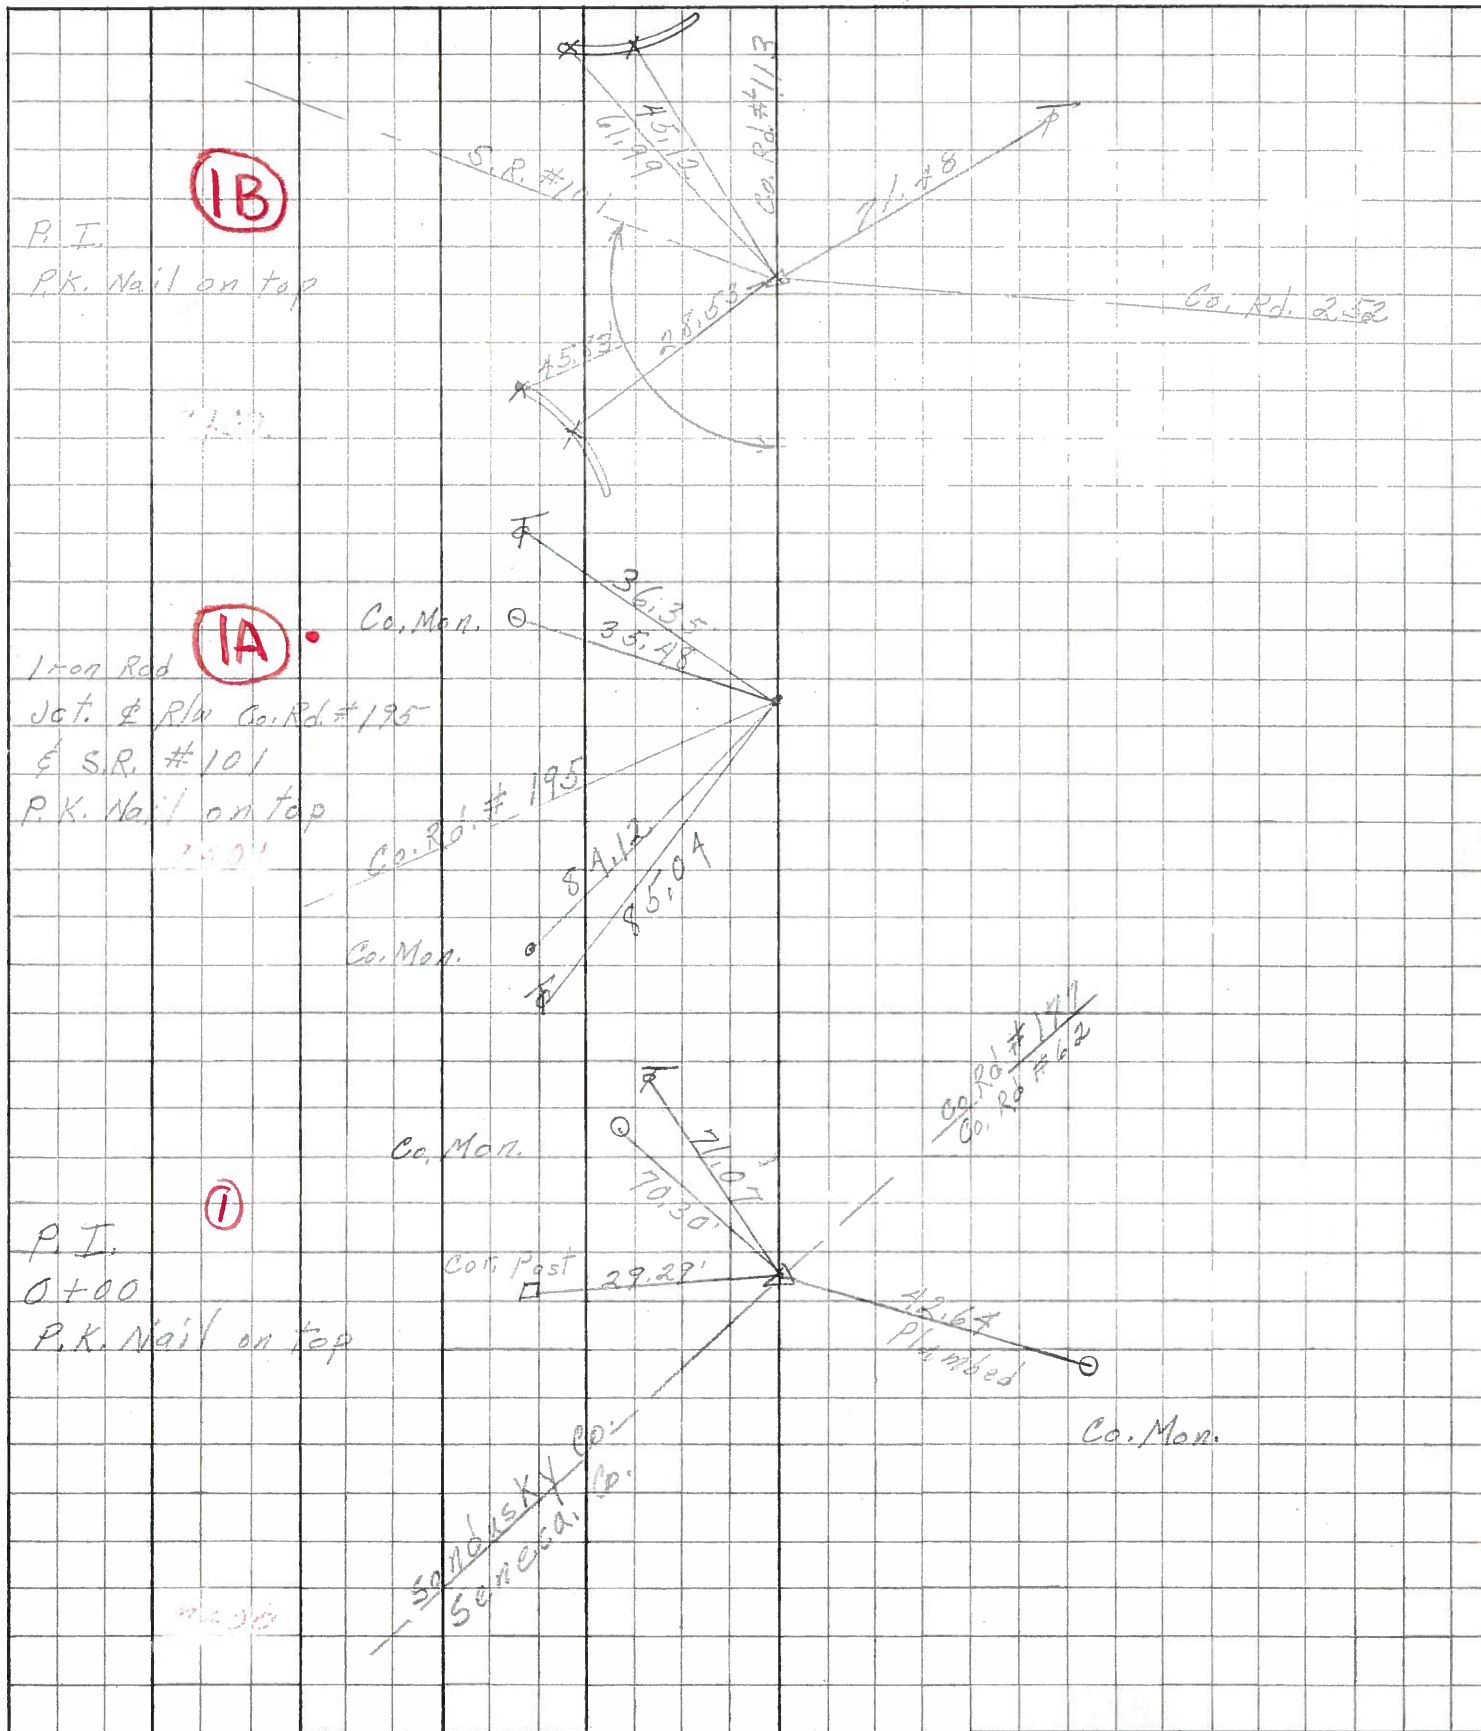

PERSONNEL

TITLE

PERSONNEL

TITLE

COUNTY SanduskyDATE 3-4-64Krobill
Kowaleski
BruggemanS. R. 101

WEATHER

SEC.

TEMP.

DESCRIPTION Seneca Co Line to N.P. & St. L. RR

JOB NO.

LEFT

CENTER LINE

RIGHT

0+00

P.I. $\Delta = 12^\circ 50' R$

Iron pin

(1)

old sta 272+14

old $\Delta = 13^\circ 10' R$

New sta 0+00

New $\Delta = 12^\circ 50' R$ PK nail over
stone on Co Line

(1A)

6+49.78

Pot

R.R. spike

(1B)

12+81.85

P.I. $\Delta = 14^\circ 19' 30'' L$

R.R. spike

S.R. 101

Sand Co Rd #252

