



O.D.O.T. DISTRICT 2 SURVEY OFFICE (USE ONLY)


PERSONNEL		REFERENCE NO. <u>1B</u>	SHEET <u>3</u> OF <u>11</u>
NOTES	<u>MILLER</u>	DATE <u>8/7/24</u>	ROUTE <u>SR 101</u>
H.C.	<u>MILLER</u>	WEATHER <u>CLOUDY</u>	COUNTY <u>SANDUSKY</u>
R.C.	<u>BARRIERE</u>	TEMP. <u>70</u>	TOWNSHIP <u>GREEN CREEK</u>
<u>BLUBAUGH, ASTON. PRESTON-COLVIN</u>		SECTION <u>35</u>	
DWG BY <u>BLUBAUGH</u>	PID <u>114849</u>	T <u>4</u> N R <u>16</u> E	
TYPE MONUMENT <u>LG R.R.SPIKE</u>			
ON SURFACE - BELOW <u>1.5"</u>			
OFFSET <u>Q</u> PAVEMENT <u>ON</u> LT : RT			
<u>TO</u> EDGE PAVEMENT			
STATION: <u>12+83</u>			
HORZ.DATUM: <u>NAD83 2011</u>		GEOID: <u>NAVD88-2018</u>	
GRID: NORTHING: <u>579921.197</u>		EASTING: <u>1837837.660</u>	
LDP: NORTHING: <u>276168.841</u>		EASTING: <u>198346.353</u>	

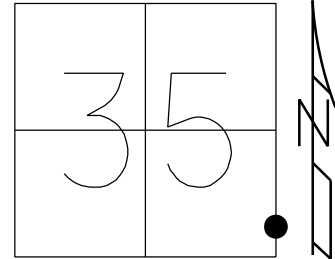

RECORD:
 P.I. 12+81.05
 FD P.K./WASHER
 AT SURFACE
 SET P.K./WASHER
 10/1/92
 FD P.K./WASHER
 6/30/08, DCH
 SET MAG/WASHER
 10/16/08
 FD LG.R.R.SPIKE
 REFB1
 6/16/16, JFO
 UNCOVERED
 9/12/17, JMR
 FD LG R.R.SPIKE
 1" DOWN
 REF1B
 12/11/23, JAM
 FD TONE. DID NOT
 UNCOVER. PAINTED
 8/7/24, JAM

FD TACK, REFC1
 3/28/17, JFO
 N: 580696.355
 E: 1837847.158
 DIST. 1B-1C = 775

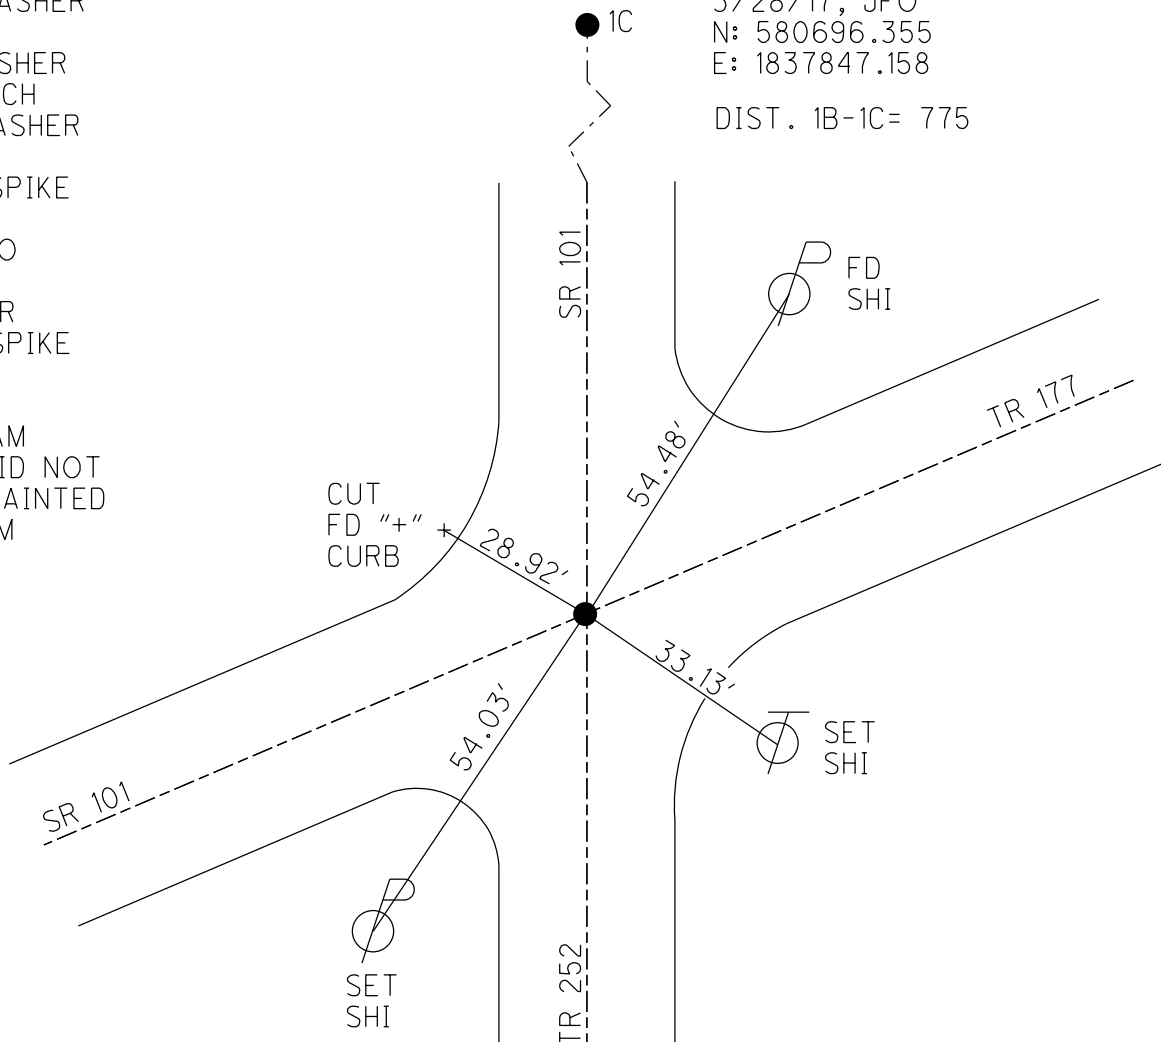

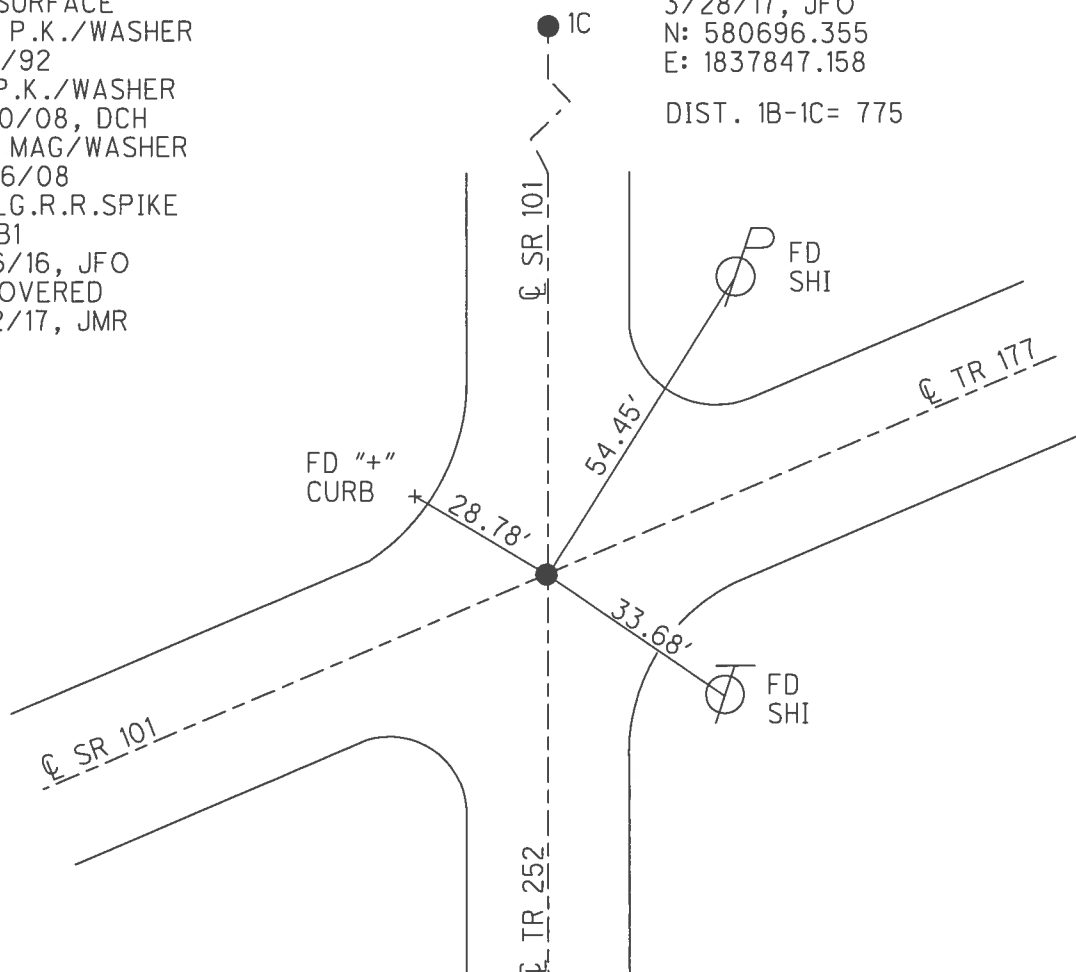

O.D.O.T. DISTRICT 2 SURVEY OFFICE (USE ONLY)

PERSONNEL _____ REFERENCE NO. 1 B SHEET 3 OF 10

NOTES HOMAN DATE 6-30-2008 ROUTE SR 101
H.C. ROUSOS WEATHER CLOUDY/RAIN COUNTY SANDUSKY
R.C. HOMAN TEMP. 70° TOWNSHIP GREEN CREEK
SECTION 35
T 4 N R 16 E

TYPE MONUMENT P.K./WASHER


~~ON SURFACE~~ - BELOW 1"

LEFT - ℄ PAV'T - RIGHT ON

- TO - EDGE PAVEMENT

S.L.M. 12+83

GRID: NORTHING: 579921.216 EASTING: 1837837.463

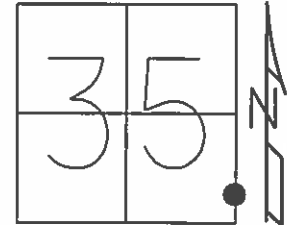


RECORD:

P.I. 12+81.05
FD P.K./WASHER
AT SURFACE

SET P.K./WASHER
10/1/92

SET MAG/WASHER
10/16/08

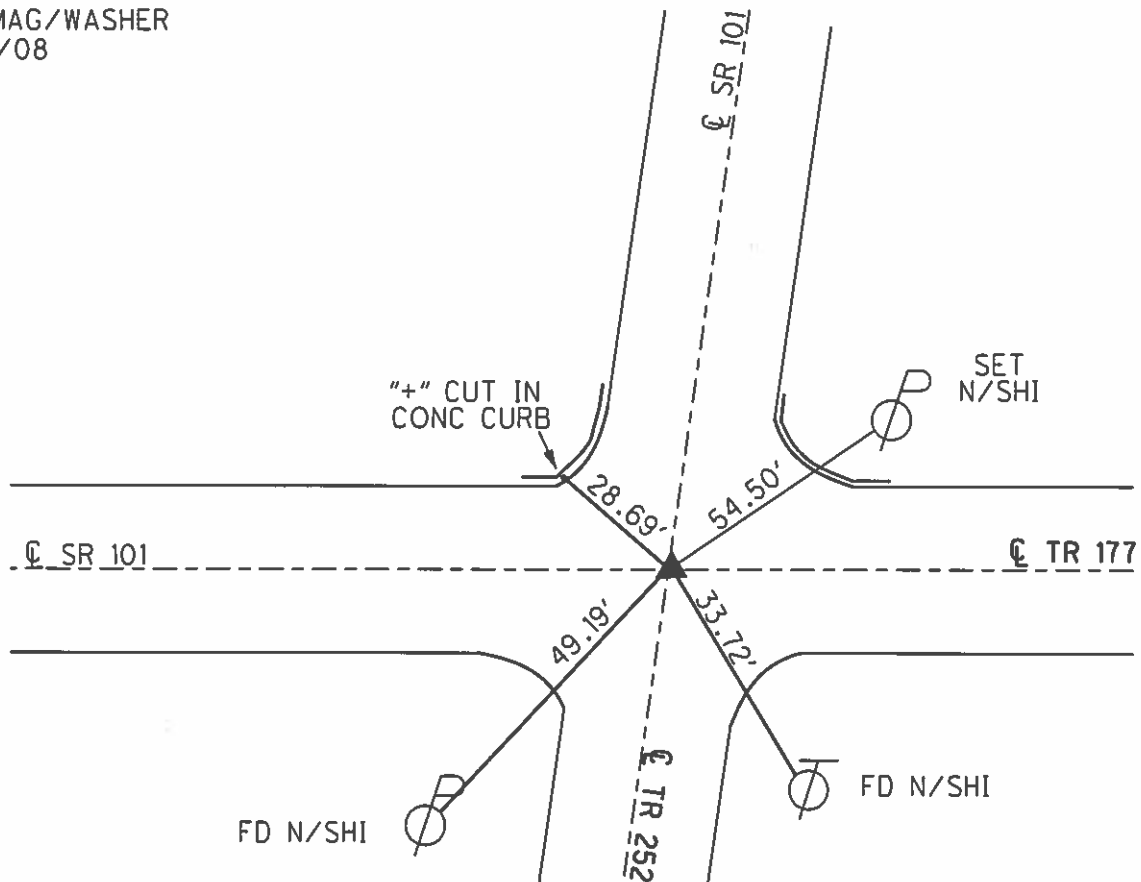

O.D.O.T. DISTRICT 2 SURVEY OFFICE

PERSONNEL

REFERENCE NO. 1-B

SHEET 3 OF 10

NOTES Cheney

H.C. RIPPLE

R.C. BARBOUR

DATE 10-1-92

WEATHER SUNNY

TEMP. 65°

ROUTE SR#101

COUNTY SANDUSKY

TOWNSHIP GREEN CREEK

SECTION 35

T4 N R 16 E

TYPE MONUMENT P.K. & WASHER


ON SURFACE - BELOW yes

LEFT - & PAV'T. - RIGHT yes


TO EDGE PAVEMENT

S.L.M. 12+83

Reset.
PK/washer
10-1-92


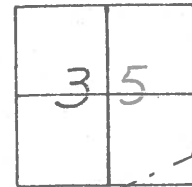


Record! P.I. 12+81.05
Fd PK & washer at surface

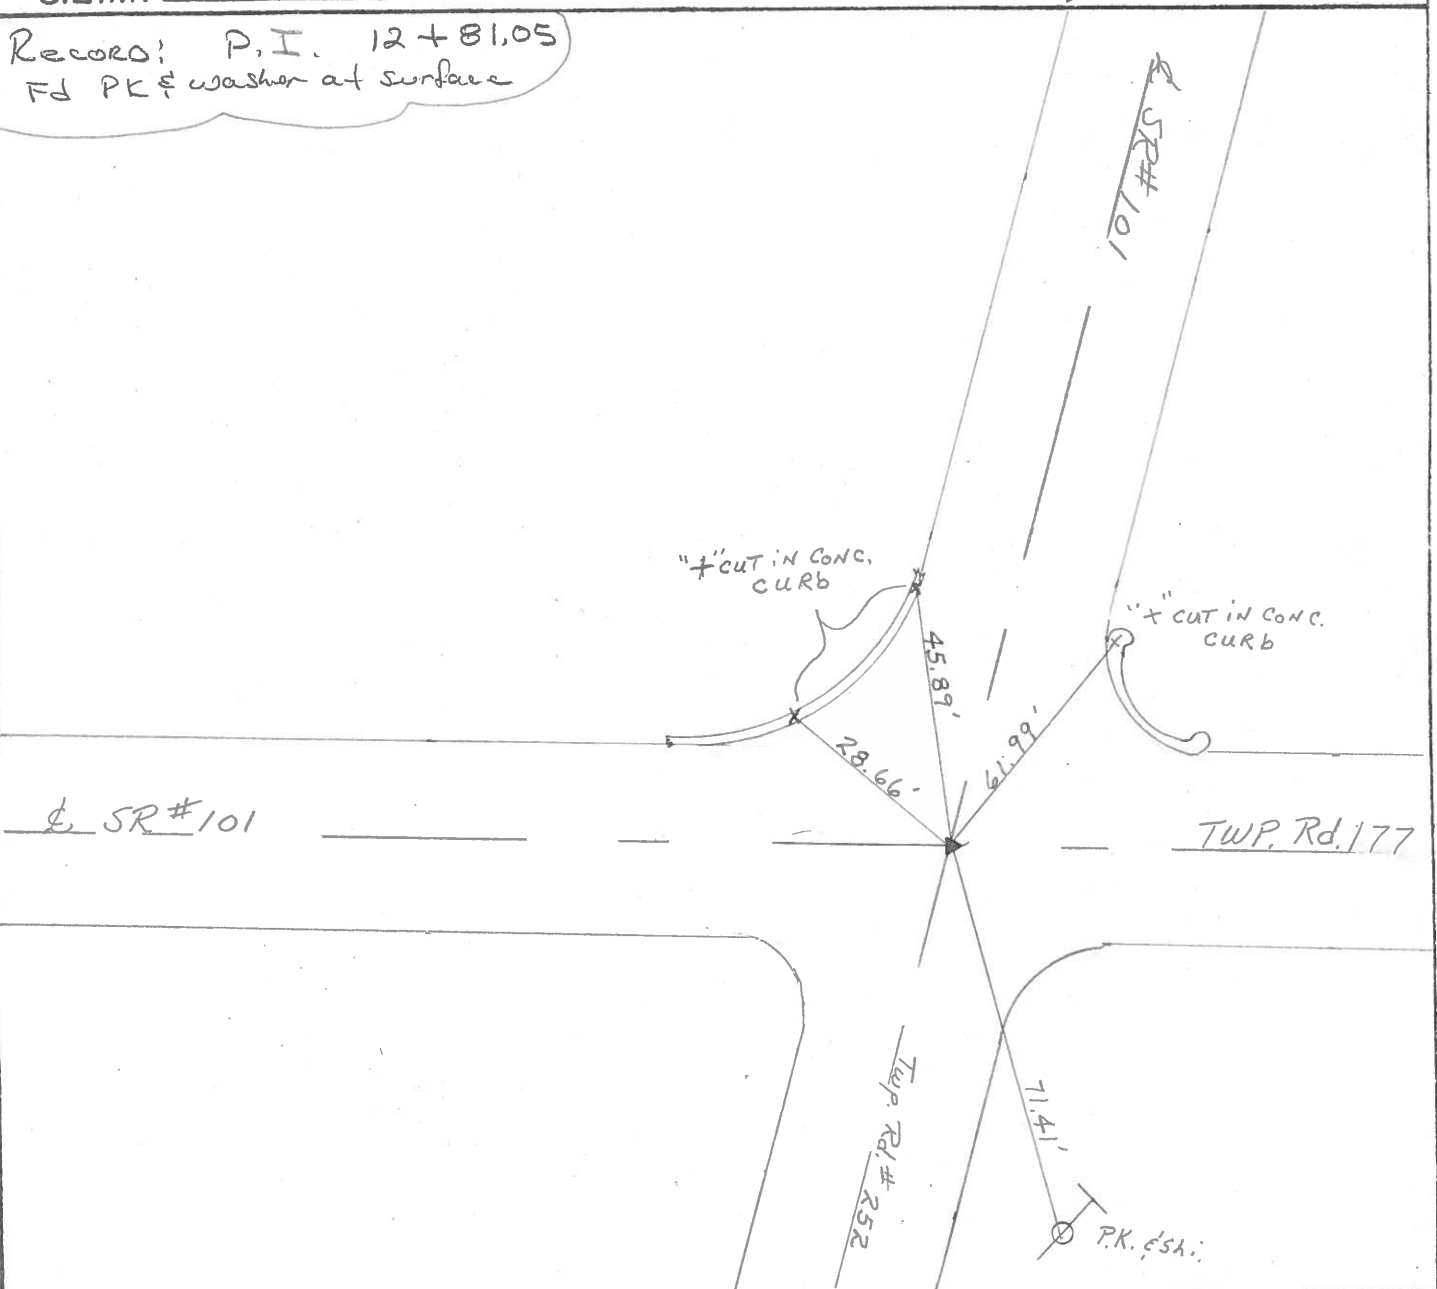

County Sandusky S.R. #101Township Green CreekSection #35T 4 N, R 16 EPersonnel CroninRippleGeymanBarbour

#1-B

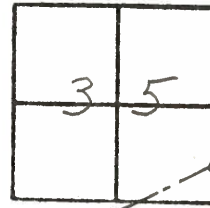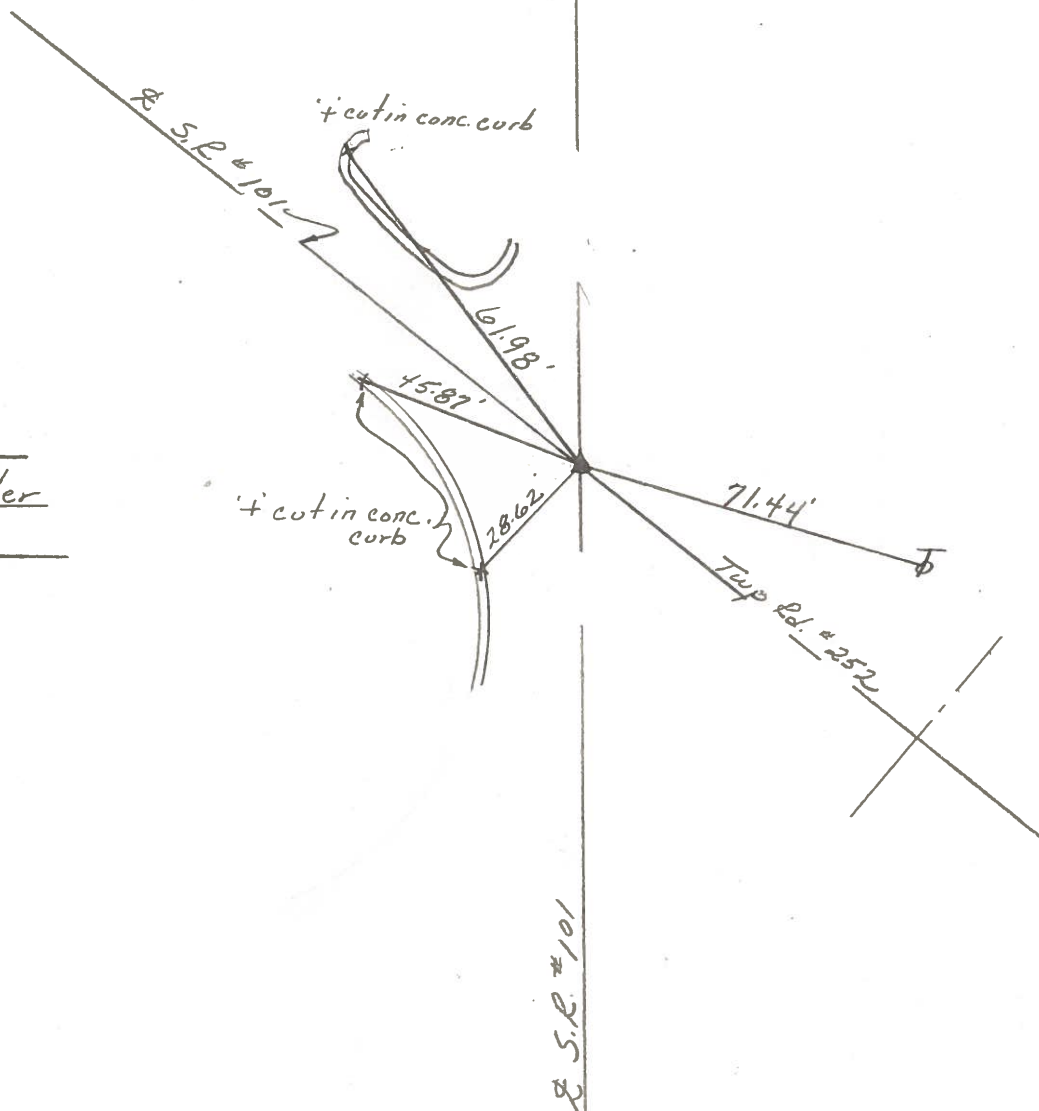Date 11/17/83Weather overcastTemp. 34°P.I.12+81.05Fd. P.K. and washeron surface


PERSONNEL	TITLE	PERSONNEL	TITLE
Schneider			
Mosser			
Barbour			
Potts			

COUNTY Sandusky DATE Feb. 29, 1968

S. R. # 101 WEATHER Cloudy - snow

SEC. Sen-San. Co. Line North TEMP. 25'

DESCRIPTION Ties for Control Points JOB NO. _____

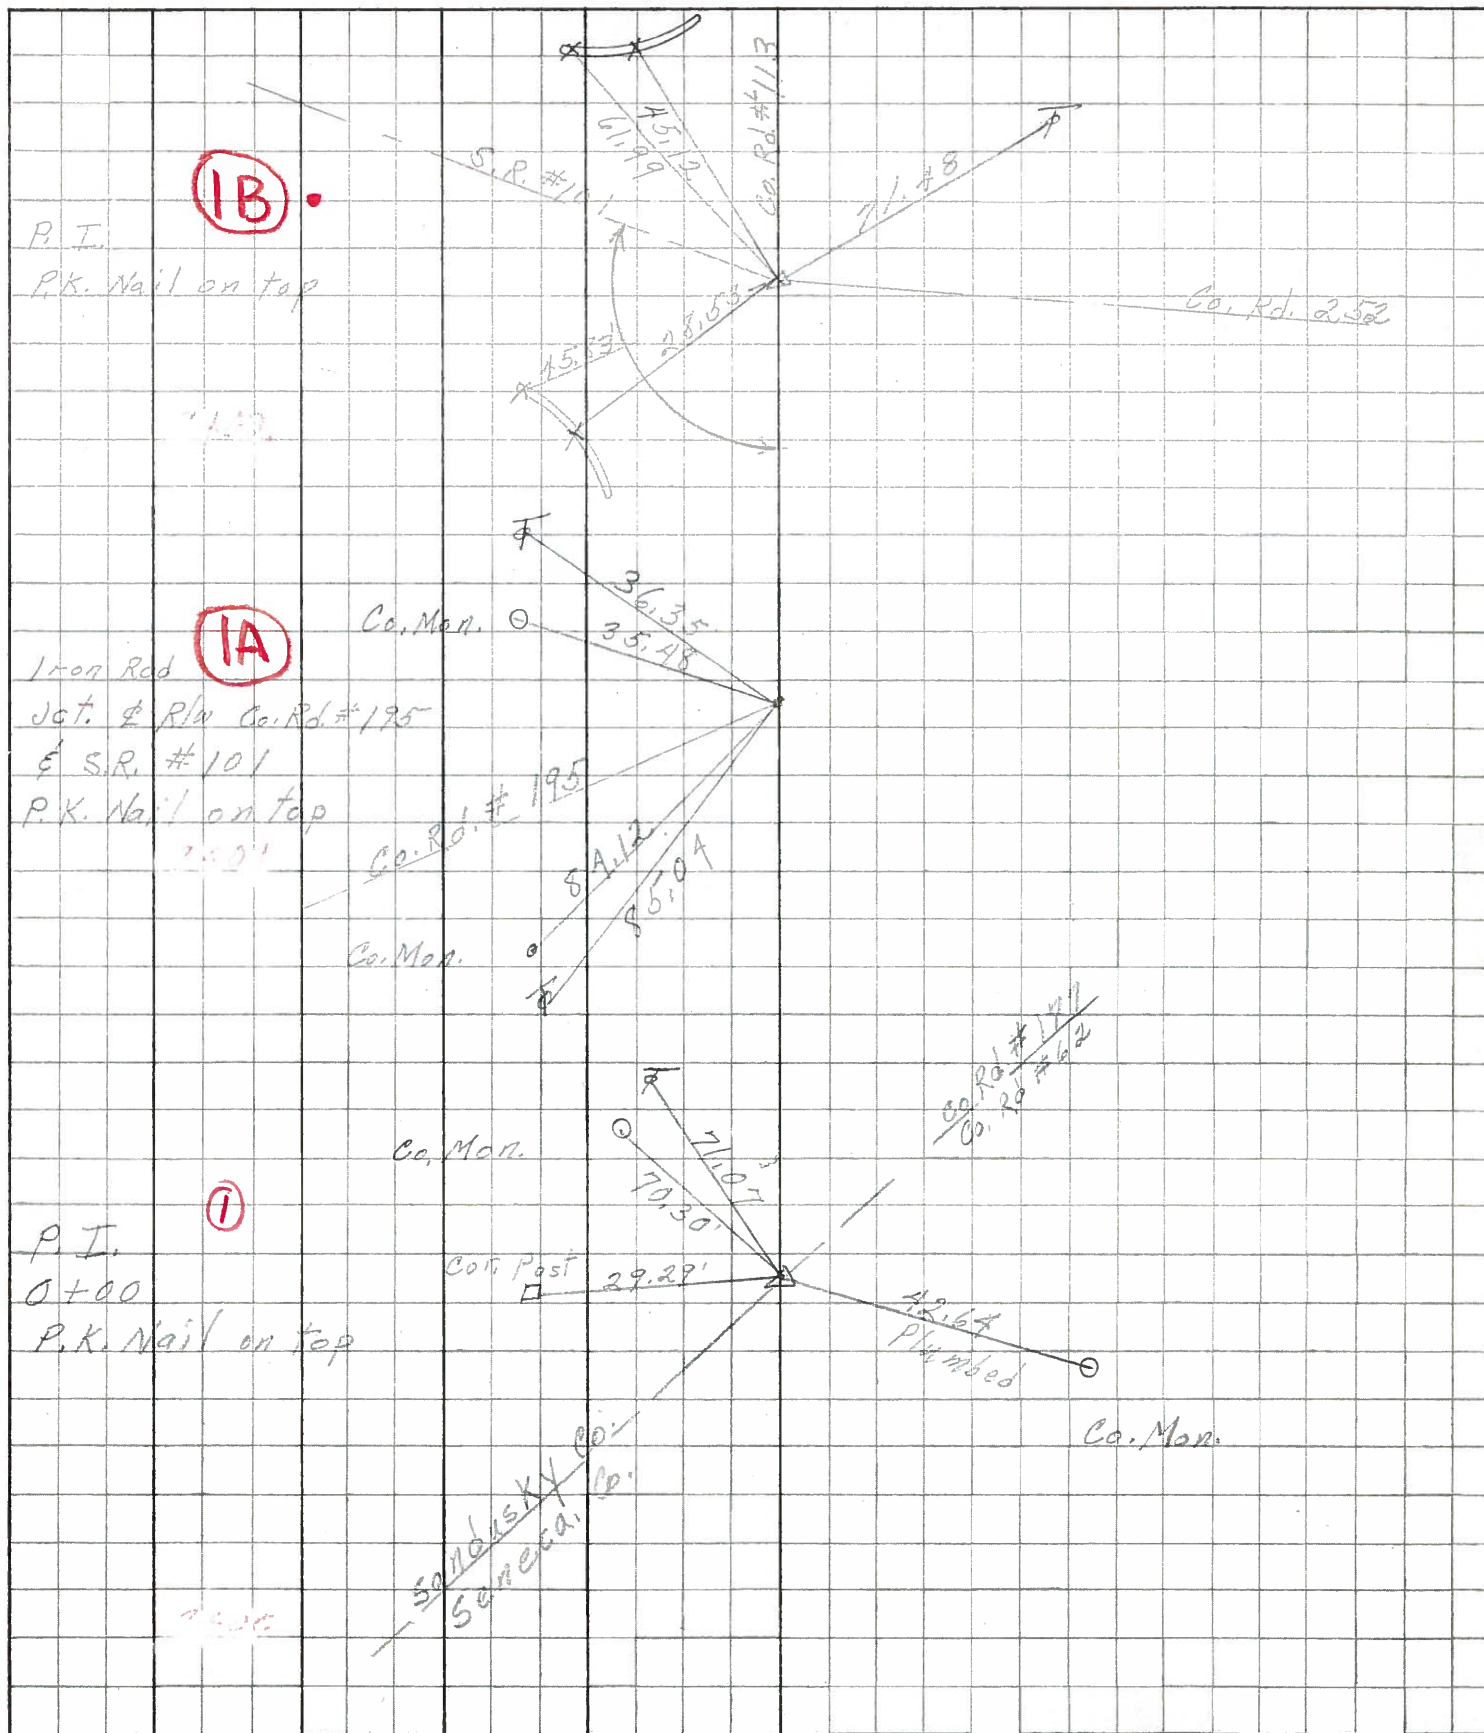

PERSONNEL

TITLE

PERSONNEL

TITLE

COUNTY Sandusky

DATE 3-4-64

Kuo bill
Kowalski
Bruggeman

S. R. 101

WEATHER

SEC.

TEMP.

DESCRIPTION Seneca Co Line To N.P. & St. L. RR

JOB NO.

LEFT

CENTER LINE

RIGHT

0+00

P.I. $\Delta = 12^\circ 50' RT$

Iron pin

(1)

old sta 272+14

old $\Delta = 13^\circ 10' R$

New sta 0+00

New $\Delta = 12^\circ 50' R$ PK nail over
stone on Co Line

(1A)

6+49.78

Pot

R.R. spike

C

18" spruce

77.70

Sandusky Co Rd #195

95.05

(1B)

12+81.85

P.I. $\Delta = 14^\circ 19' 30" LT$

R.R. spike

SR 101

D

99.20

99.27

96.68

96.15

96.15

Sand Co Rd #113

71.48

71.48

Sand Co Rd #252