

O.D.O.T. DISTRICT 2 SURVEY OFFICE (USE ONLY)

PERSONNEL

REFERENCE NO. 2

SHEET 4 OF 11

NOTES MILLER

DATE 8/7/24

ROUTE SR 101

H.C. MILLER

WEATHER SUNNY

COUNTY SANDUSKY

R.C. BARRIERE

TEMP. 70

TOWNSHIP GREEN CREEK

BLUBAUGH, ASTON. PRESTON-COLVIN

SECTION 35

DWG BY BLUBAUGH

PID 114849

T 4 N R 16 E

TYPE MONUMENT SM R.R.SPIKE

~~ON SURFACE~~ - BELOW 1.5"

OFFSET 0.4' Q PAVEMENT - ~~LT~~ : RT

TO RT EDGE PAVEMENT

STATION: 34+01

HORIZ.DATUM: NAD83 2011


GEOID: NAVD88-2018

GRID: NORTHING: 579921.197

EASTING: 1837837.660

LDP: NORTHING: 278295.818


EASTING: 198358.458

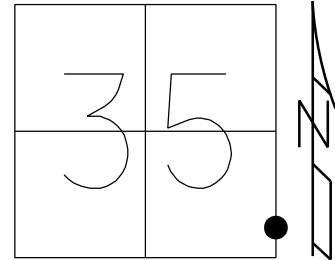

RECORD:
FD IPIN
6" BELOW
SET P.K./WASHER
10/1/92
FD P.K./WASHER
6/30/08, DCH
SET SM R.R.SPIKE
10/16/08
FD SM.R.R.SPIKE
1" DOWN
REF2
6/16/16, JFO
UNCOVERED
9/12/17, JMR
FD SM R.R.SPIKE
REF2
12/11/23, JAM
FD TONE. DID NOT
UNCOVER. PAINTED
8/7/24, JAM

FD '+' CUT IN NEAR BOLT
SE CORNER TRAIN SIGNAL

FD '+' CUT IN NEAR BOLT
SW CORNER TRAIN SIGNAL

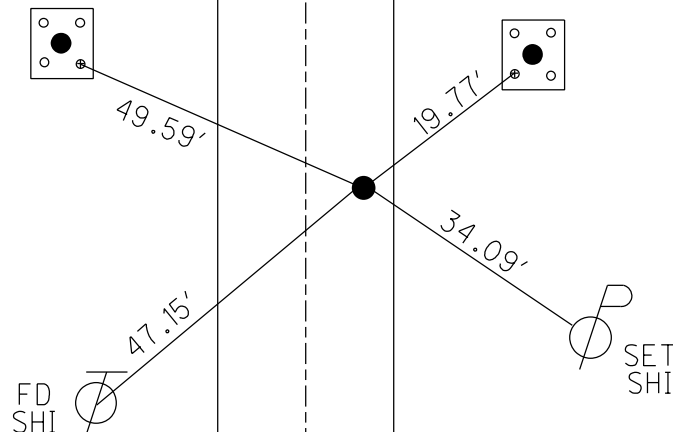

O.D.O.T. DISTRICT 2 SURVEY OFFICE (USE ONLY)

PERSONNEL _____ REFERENCE NO. 2 SHEET 4 OF 11
NOTES RHOADES DATE 3/28/17 ROUTE SR 101
H.C. O'DONNELL WEATHER MIST COUNTY SANDUSKY
R.C. HELDMAN TEMP. 43° TOWNSHIP GREEN CREEK
SECTION 35
T 4 N R 16 E

TYPE MONUMENT SM.R.R.SPIKE


~~ON SURFACE~~ - BELOW 1"

~~LEFT~~ - Q PAV'T - RIGHT -

1' TO RT EDGE PAVEMENT

S.L.M. 34+01

GRID: NORTHING: 582047.816 EASTING: 1837864.360

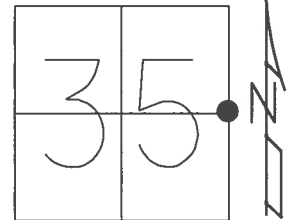

RECORD:

FD IPIN

6" BELOW

SET P.K./WASHER

10/1/92

FD P.K./WASHER

6/30/08, DCH

SET SM R.R.SPIKE

10/16/08

FD SM.R.R.SPIKE

1" DOWN

REF2


6/16/16, JFO

UNCOVERED

9/12/17, JMR

FD '+' CUT IN NEAR BOLT
SE CORNER TRAIN SIGNAL

FD '+' CUT IN NEAR BOLT
SW CORNER TRAIN SIGNAL

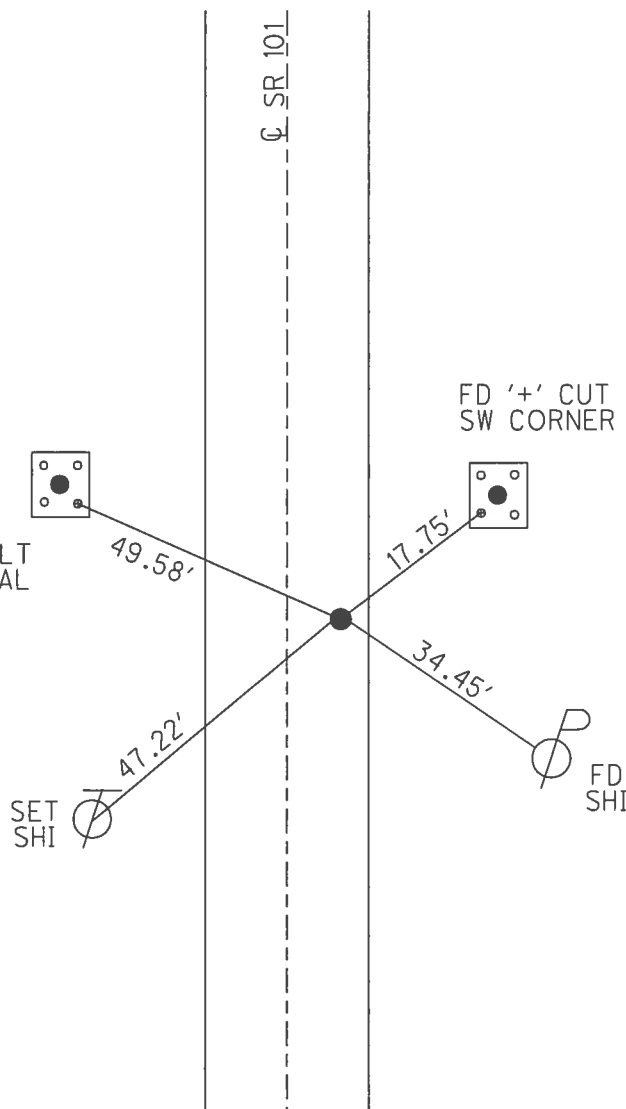

O.D.O.T. DISTRICT 2 SURVEY OFFICE (USE ONLY)

PERSONNEL		REFERENCE NO.	<u>2</u>	SHEET	<u>4</u> OF <u>10</u>
NOTES	<u>HOMAN</u>	DATE	<u>6-30-2008</u>	ROUTE	<u>SR 101</u>
H.C.	<u>ROUSOS</u>	WEATHER	<u>CLOUDY/RAIN</u>	COUNTY	<u>SANDUSKY</u>
R.C.	<u>HOMAN</u>	TEMP.	<u>70°</u>	TOWNSHIP	<u>GREEN CREEK</u>
				SECTION	<u>35, 36</u>
				T <u>4</u> N R <u>16</u> E	

TYPE MONUMENT PK/WASHER


~~ON SURFACE~~ - BELOW 6"

~~LEFT~~ - CL PAV'T - RIGHT -

1' TO RT EDGE PAVEMENT

S.L.M. 34+01

GRID: NORTHING: 582047.842 EASTING: 1837864.253

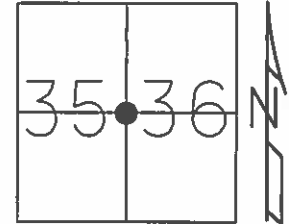

RECORD:
FD IPIN 6" BELOW
1' E.OF RT EP

SET P.K./WASHER
10/1/92

SET SM R.R.SPIKE
10/16/08

'+' CUT IN NEAR BOLT
SE CORNER TRAIN SIGNAL



47.53'

47.17'

17.77'

34.06'

'+' CUT IN NEAR BOLT
SW CORNER TRAIN SIGNAL



SET
N/SHI



FD.
N/SHI



O.D.O.T. DISTRICT 2 SURVEY OFFICE

PERSONNEL

REFERENCE NO. #2

SHEET 4 OF 10

NOTES Cheney

H.C. RIPPLE

R.C. BARBOUR

DATE 10-1-92

WEATHER SUNNY

TEMP. 70°

ROUTE SR#101

COUNTY SANDUSKY

TOWNSHIP GREEN CREEK

SECTION 35 E 36

T4 NR 16 E

TYPE MONUMENT P.K. NAIL & WASHER

ON SURFACE - BELOW 4"


LEFT - C PAV'T. - RIGHT

1' TO E. EDGE PAVEMENT

S.L.M. 34+01

Set
PK/washer
10-1-92

2

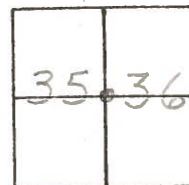

RECORD: F&I PIN 6" below
1' E. of Rt. Edge Pavt.

"+" CUT NEAR BOLT
SE. TRAIN SIG



49.48'

"+" CUT IN NEAR BOLT
SW. TRAIN SIGNAL




17.83'

33.98'




Q SR#101

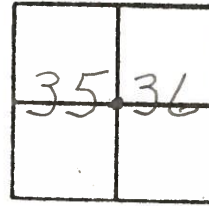County Sandusky S. R. 10.1Township Green CreekSection E $\frac{1}{4}$ Post Sec. 35 - W $\frac{1}{4}$ Post Sec. 36T 4 N, R 16 EPersonnel CroninRippleGeymanBarbourDate 11/14/83Weather sunny - windyTemp. 42°

#2



Ed. I. Pin 6" below
surface. Set P.K. #
washer on surface
1 E. Rt. E. Point

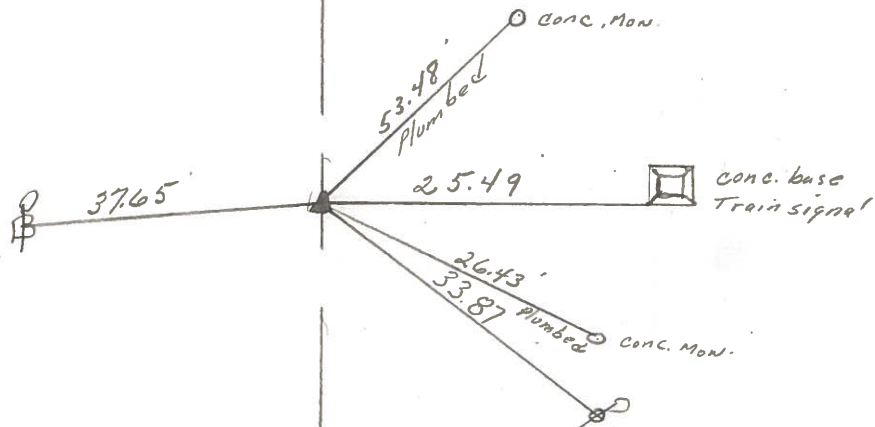

S. R. 10.1

PERSONNEL	TITLE	PERSONNEL	TITLE	COUNTY	DATE	S. R.	WEATHER	SEC.	TEMP.	DESCRIPTION	JOB NO.
Krabi				Sandusky	3-4-64	101				Source Coting to N.P. & S.T.L. RR	
Kawakoshi											
Bongemann											

