

O.D.O.T. DISTRICT 2 SURVEY OFFICE (USE ONLY)

PERSONNEL

REFERENCE NO. 4

SHEET 7 OF 11

NOTES MILLER
H.C. MILLER
R.C. BARRIERE

DATE 8/7/24
WEATHER SUNNY
TEMP. 70

ROUTE SR 101
COUNTY SANDUSKY
TOWNSHIP GREEN CREEK
SECTION 26

BARRIERE, ASTON, PRESTON-COLVIN
DWG BY MILLER PID 114849

T 4 N R 16 E

TYPE MONUMENT MAG NAIL

~~ON SURFACE~~ - BELOW 0.5"

OFFSET Q PAVEMENT 1' ~~LT~~ : RT

- TO - EDGE PAVEMENT

STATION: 91+83

HORZ.DATUM: NAD83 2011


GEOID: NAD88 2018

GRID: NORTHING: 587826.566

EASTING: 1838921.440


LDP: NORTHING: 284075.195

EASTING: 198375.670

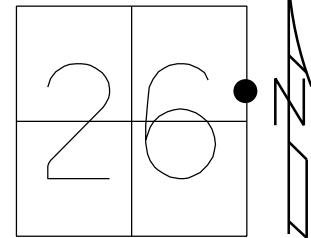

RECORD:
FD R.R.SPIKE
1"± BELOW
SET PK/WASHER
11/14/83
FD P.K./WASHER
7/1/08, DCH
SET MAG/WASHER
9/29/08
FD MAG/WASHER
REF4
6/16/16, JFO
UNCOVERED
9/12/17, JMR
FD MAG NAIL
REF4
12/11/23, JAM
FD TONE. DID NOT
UNCOVER, PAINTED.
8/7/24, JAM

NOTE: ORIGIN OF POINTS UNKNOWN
MAY OR MAY NOT BE ON Q OF
SR 101 &/OR Q SEC. LINE

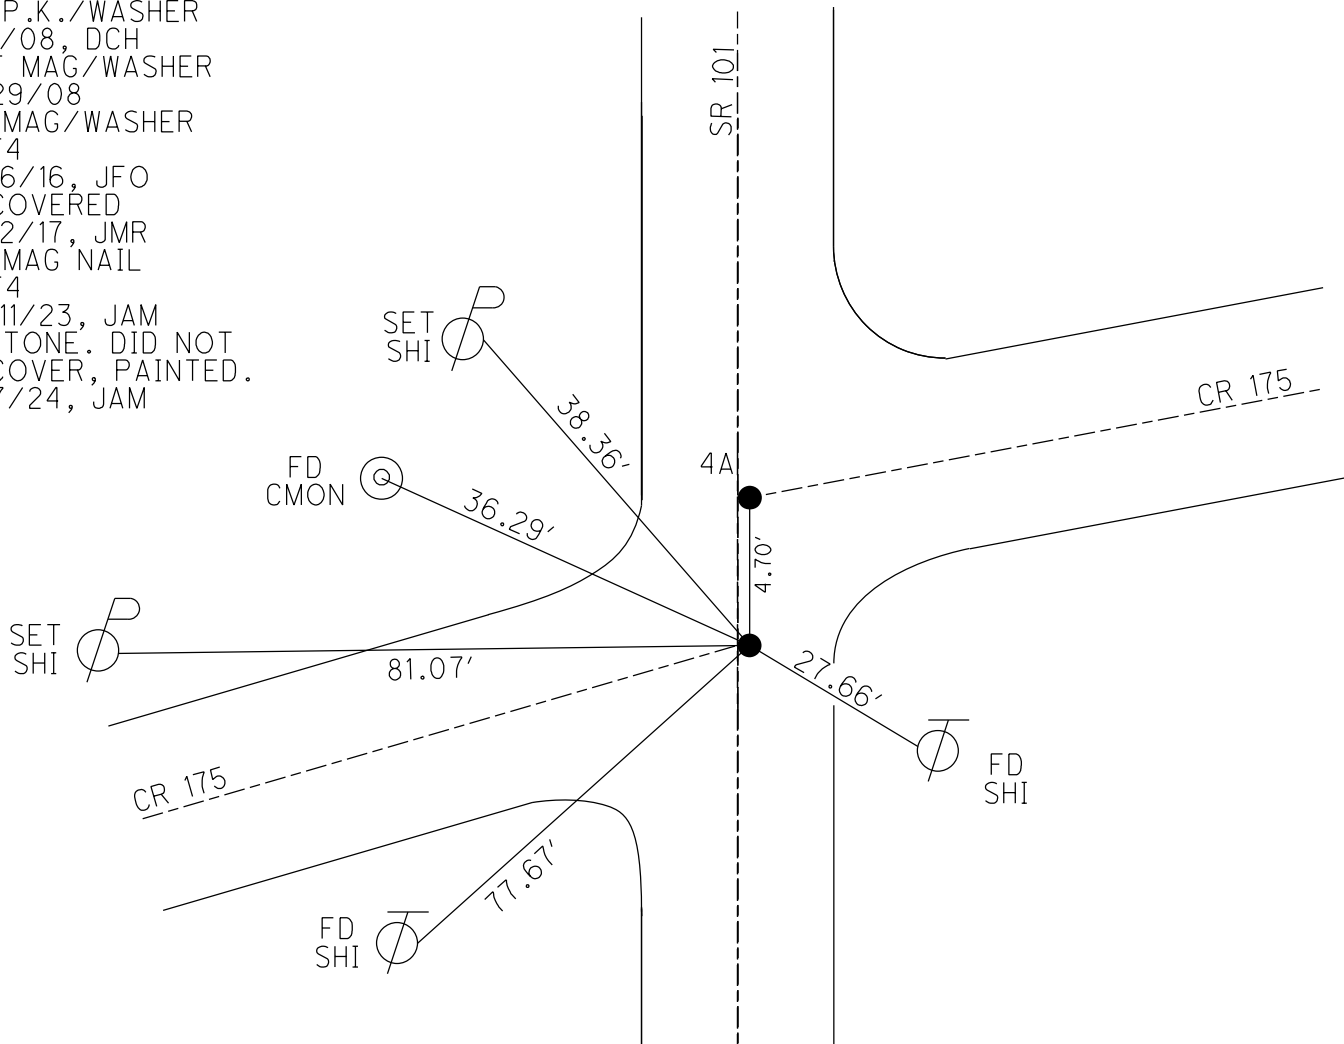


O.D.O.T. DISTRICT 2 SURVEY OFFICE (USE ONLY)

PERSONNEL	REFERENCE NO.	4	SHEET	7	OF	11
NOTES	HOMAN	DATE	7/1/08	ROUTE	SR 101	
H.C.	ROUSOS	WEATHER	SUNNY	COUNTY	SANDUSKY	
R.C.	HOMAN	TEMP.	70° F	TOWNSHIP	GREEN CREEK	
				SECTION	26	
				T	4	N
				R	16	E


TYPE MONUMENT PK/WASHER
 ON SURFACE - ~~BELOW~~ ON
~~LEFT~~ - ℄ PAV'T - RIGHT 1.0'
TO - EDGE PAVEMENT
 S.L.M. 91+83

GRID: NORTHING: 587826.566 EASTING: 1837921.440

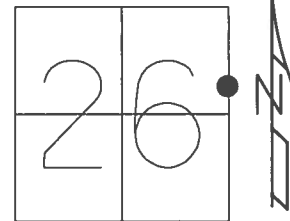

RECORD:
 FD R.R.SPIKE
 1"± BELOW
 SET PK/WASHER
 11/14/83
 FD P.K./WASHER
 7/1/08, DCH
 SET MAG/WASHER
 9/29/08
 FD MAG/WASHER
 REF4
 6/16/16, JFO
 UNCOVERED
 9/12/17, JMR

NOTE: ORIGIN OF POINTS UNKNOWN
 MAY OR MAY NOT BE ON ℄ OF
 SR 101 &/OR ℄ SEC. LINE

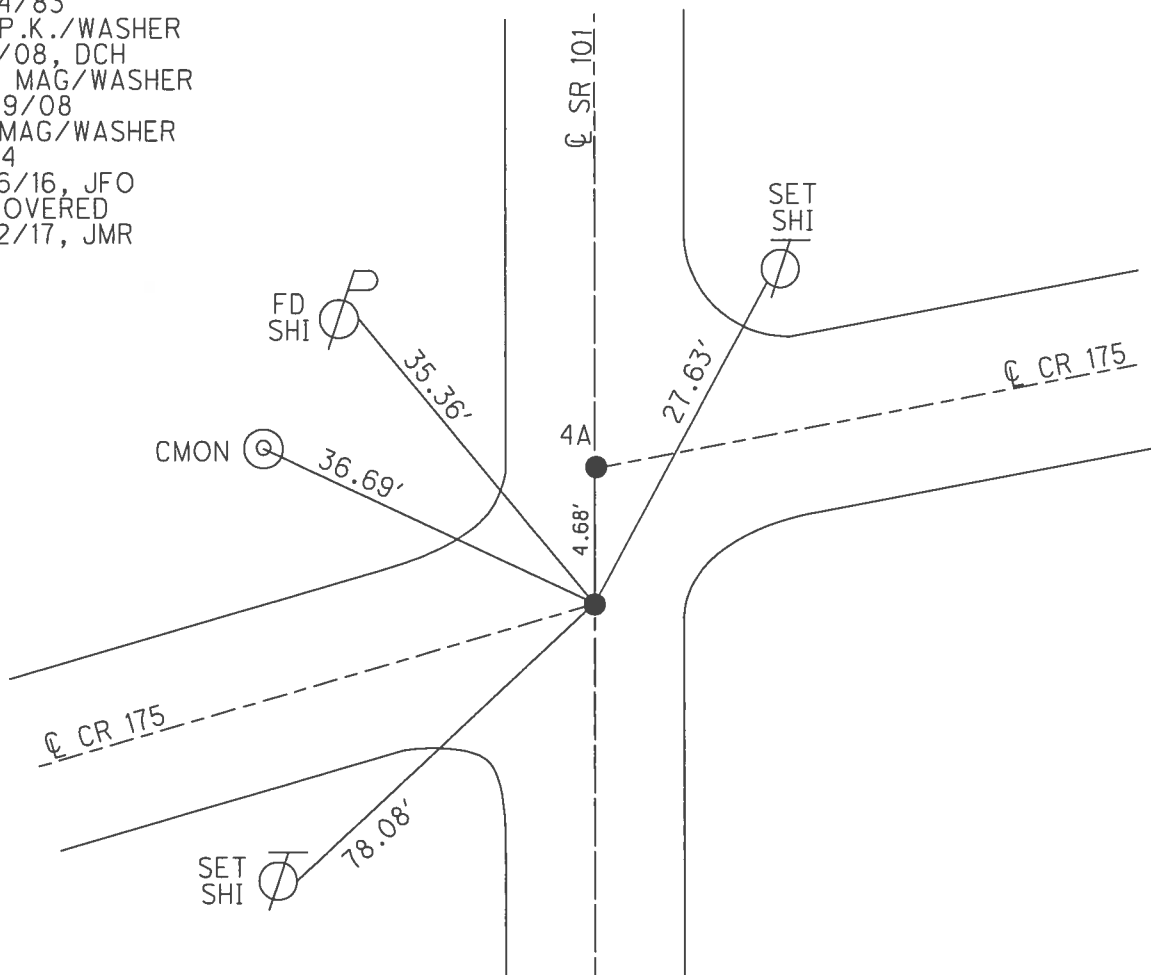

O.D.O.T. DISTRICT 2 SURVEY OFFICE (USE ONLY)

PERSONNEL

REFERENCE NO.

SHEET

7 OF 10

NOTES

HOMAN

DATE

7-1-2008

ROUTE

SR 101

H.C.

ROUSOS

WEATHER

SUNNY

COUNTY

SANDUSKY

R.C.

HOMAN

TEMP.

70° F

TOWNSHIP

GREEN CREEK

SECTION

24, 25

T_4_N

R 16 E

TYPE MONUMENT

PK/WASHER

ON SURFACE - ~~BELOW~~

ON

~~LEFT~~ - C PAV'T - RIGHT 1.0'

1.0'

____-____TO____-____EDGE PAVEMENT

S.L.M. 91+83

GRID: NORTHING: 587826+771

EASTING: 1837921.417

RECORD:

NOTE: ORIGIN OF POINTS UNKNOWN

MAY OR MAY NOT BE ON Q OF

SR 101 &/OR C SEC. LINE


FD. RR SPK 1"± BELOW SURFACE

SET PK/WASHER ON SURFACE

1' RT C OF PAV'T 11/14/1983

RESET MAG/WASHER

9/29/2008

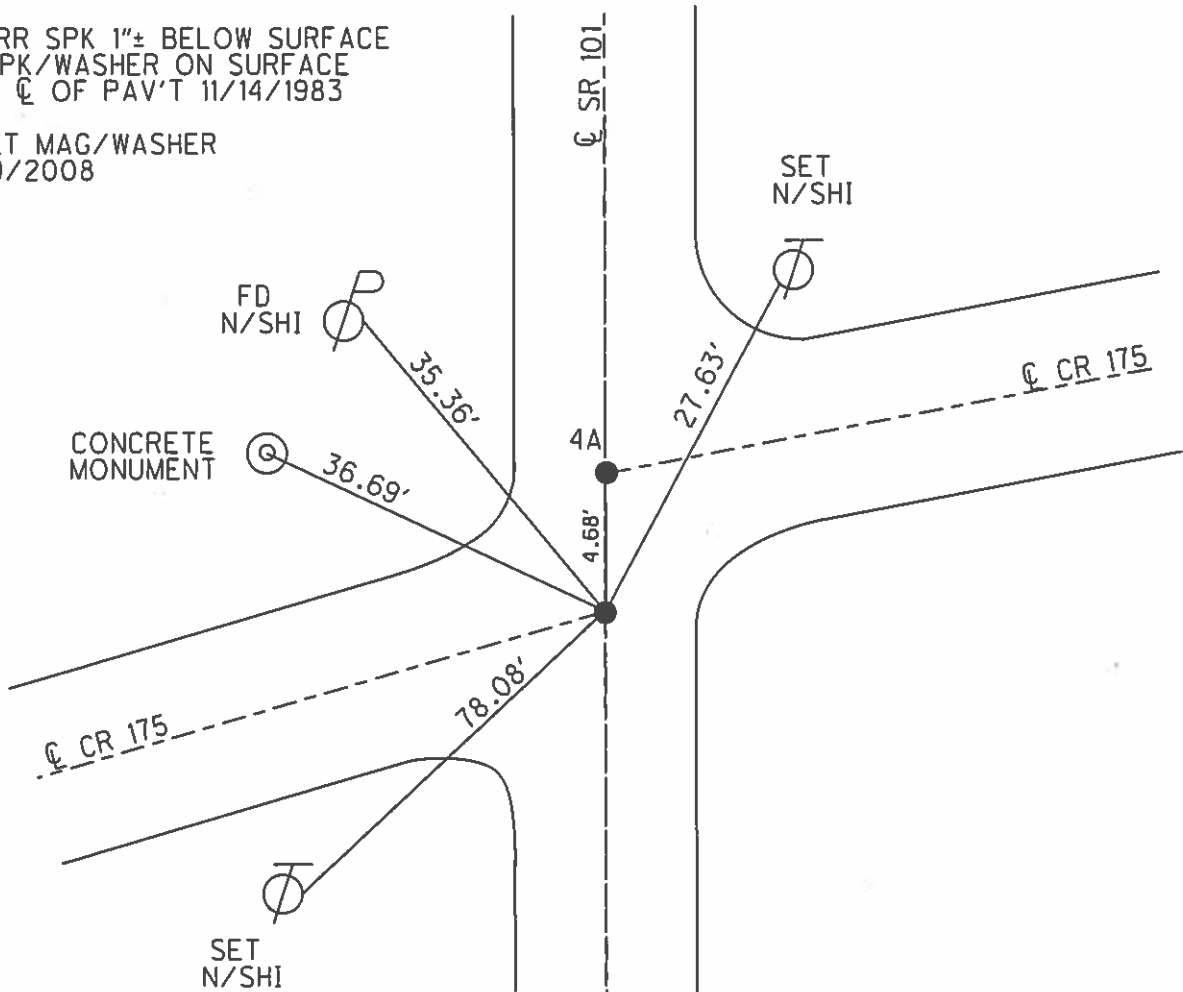

O.D.O.T. DISTRICT 2 SURVEY OFFICE

PERSONNEL

REFERENCE NO. #4

SHEET 7 OF 10

NOTES Cheney

H.C. RIPPLE

R.C. BARBOUR

DATE 10-1-92

WEATHER _____

TEMP. _____

ROUTE SR#101

COUNTY SANDUSKY

TOWNSHIP GREEN CREEK

SECTION 24 & 25

T 4 N R 16 E

"A"

"B"


TYPE MONUMENT P.K./washer P.K./washer

ON SURFACE - BELOW yes yes

~~LEFT~~ - 1.0' 1.5'

TO EDGE PAVEMENT


S.L.M. 91+83 TO SOUTH POINT "A"

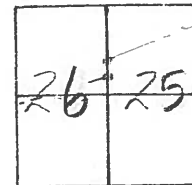

Note: Origin of points unknown
MAY OR MAYNOT be ON E of SR#101
E or Sec. Line

Fd. RR. Spk. 1" + below surface
Set P.K. & washer on surface
1.5 RT. & Pavm't. 11-14-83
Record

Re-Set P.K./washer at
Both Points 10-1-92

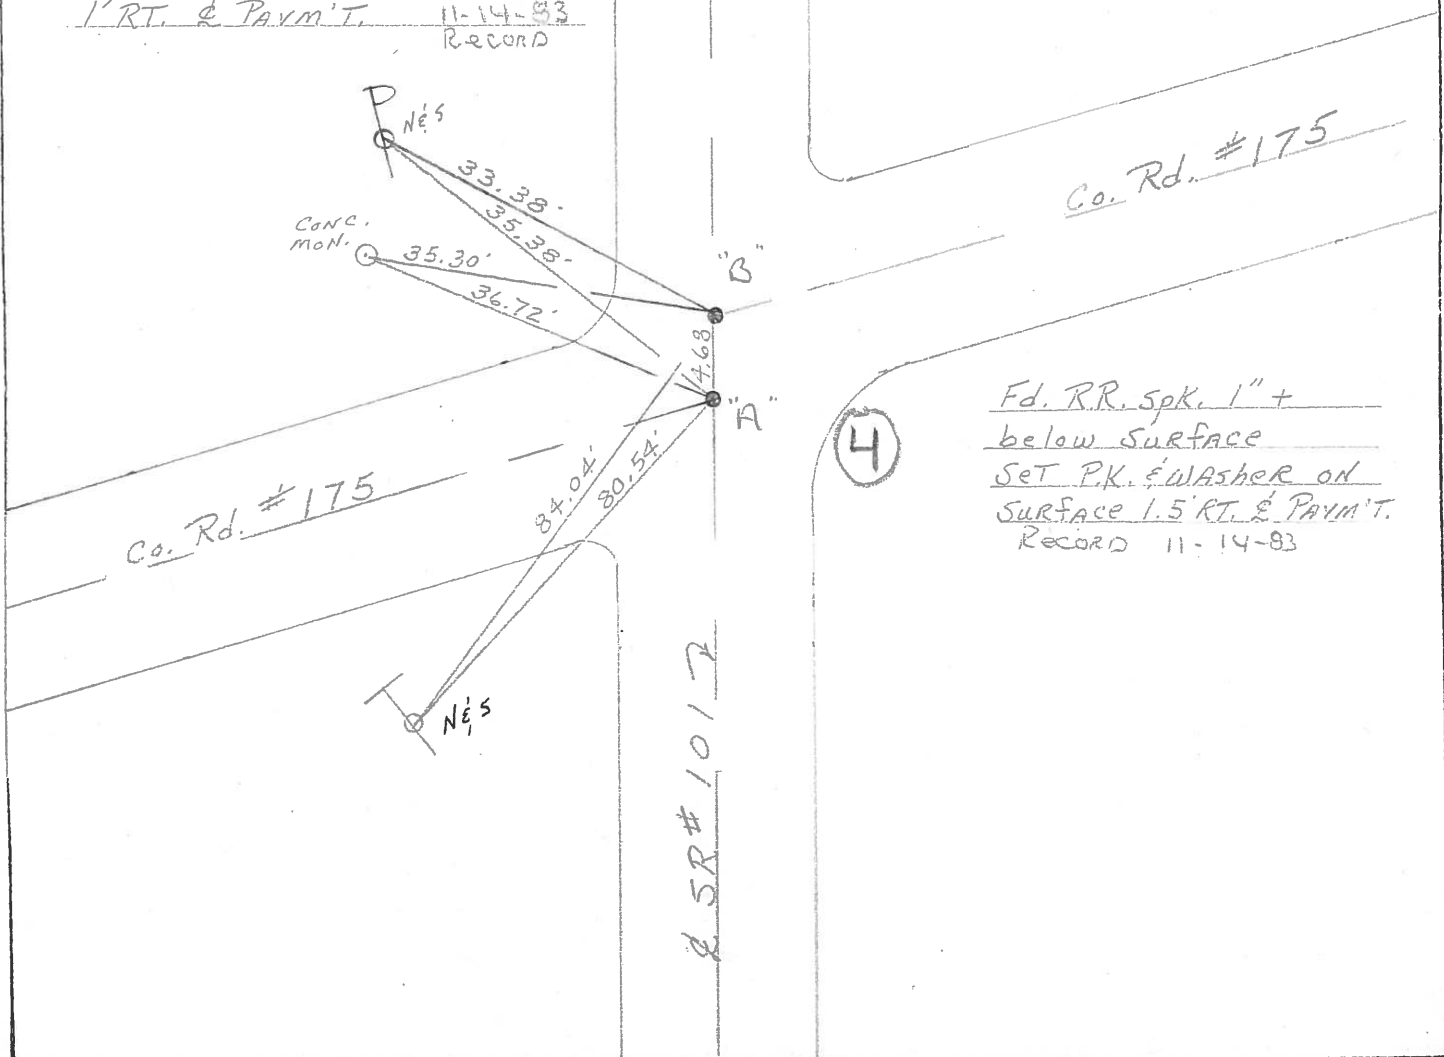

QD.O.T. DISTRICT 2 SURVEY OFFICE

SHEET 7 OF 10

County Sandusky S.R. # 101

Township Green Creek

Section 24 & 25

T₁N, R₁₆E

Personnel Cronin

Ripple

Geyman


Barbour

#4

Date 11/14/82

Weather sunny - windy


Temp. 42°

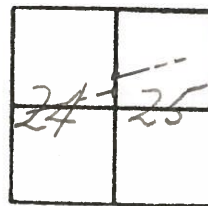

Note: Origin of points unknown
May or May not be on E of S.R. #101
E or Section Line



Fd. R.R. spike 1" below surface. Set
P.K. & washer on surface. 1 Rt. & Point.

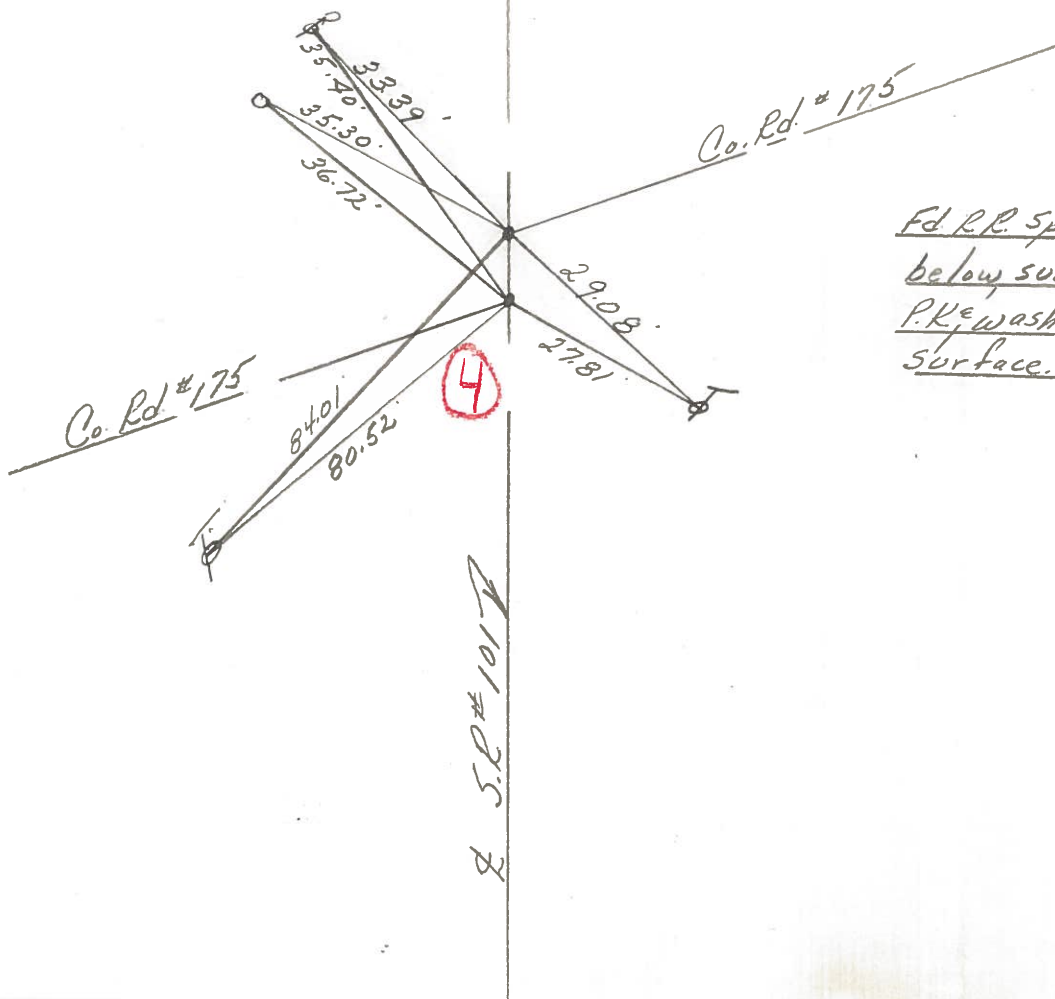

Fd R.R. Spike 1" below surface. Set
P.K. & washer on surface. 1.5 Rt. & Point.