

O.D.O.T. DISTRICT 2 SURVEY OFFICE (USE ONLY)

PERSONNEL

REFERENCE NO. 5

SHEET 9 OF 11

NOTES MILLER

DATE 8/7/24

ROUTE SR 101

H.C. MILLER

WEATHER SUNNY

COUNTY SANDUSKY

R.C. BARRIERE

TEMP. 70

TOWNSHIP GREEN CREEK

BARRIERE, ASTON, PRESTON-COLVIN

SECTION 26

DWG BY MILLER

PID 114849

T 4 N R 16 E

TYPE MONUMENT PK/WASHER

~~ON SURFACE~~ - BELOW 0.5"

OFFSET Q PAVEMENT ON LT : RT

- TO - EDGE PAVEMENT

STATION: 113+58

HORZ.DATUM: NAD83 2011


GEOID: NAD88 2018

GRID: NORTHING: 590000.610


EASTING: 1837936.482

LDP: NORTHING: 286249.494

EASTING: 198375.847

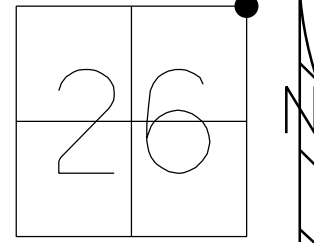

RECORD: P.O.T.
FD P.K. ATOP
R.R.SPIKE
2 1/2" DOWN
SET P.K./WASHER
10/1/92
FD P.K./WASHER
7/1/08, DCH
SET MAG/WASHER
9/29/08
FD MAG/WASHER
CL205
8/24/10, KPM
REF5
6/16/16, JFO
9/12/17, JMR
FD PK/WASHER
REF5
12/11/23, JAM
FD TONE. DID NOT
UNCOVER, PAINTED.
8/7/24, JAM

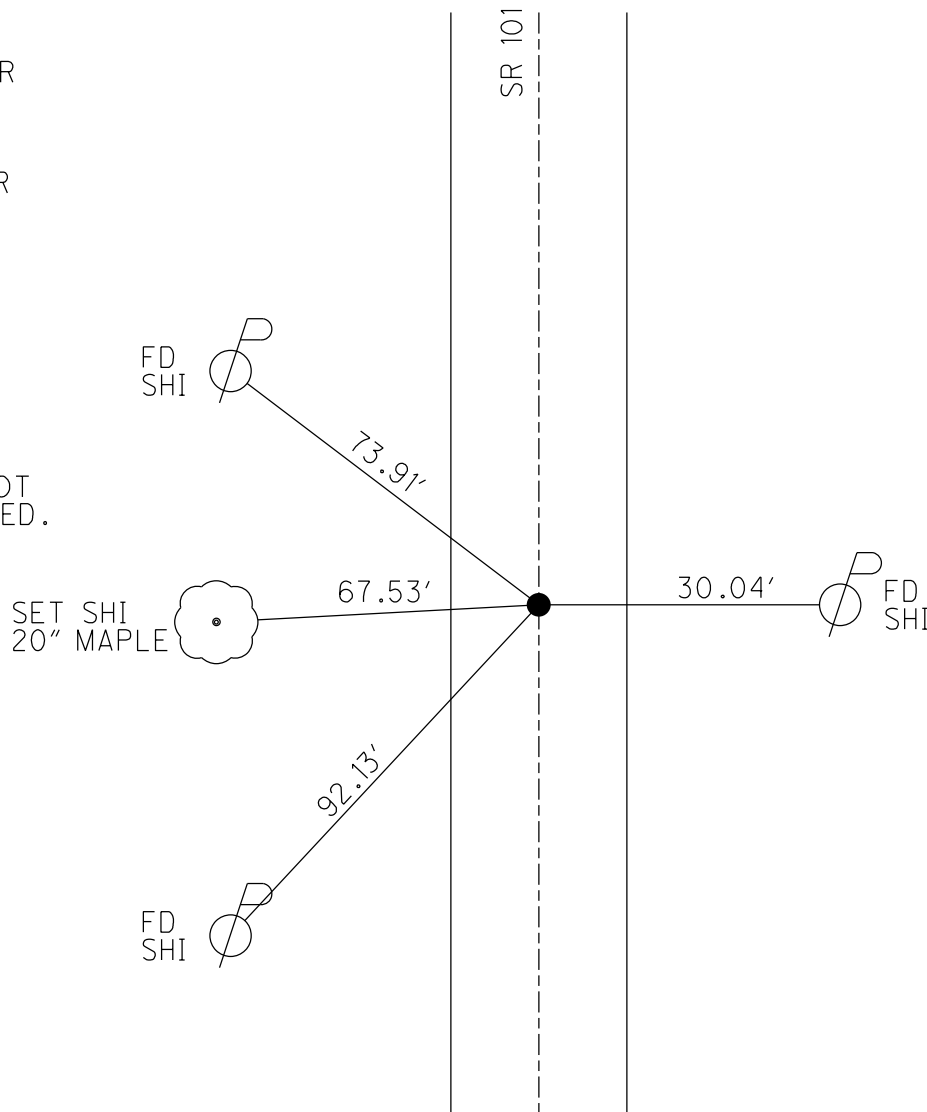

O.D.O.T. DISTRICT 2 SURVEY OFFICE (USE ONLY)

PERSONNEL

REFERENCE NO. 5

SHEET 9 OF 13

NOTES HARBAUGH

DATE 8/24/10

ROUTE SR 101

H.C. MOSER

WEATHER FAIR

COUNTY SANDUSKY

R.C. FINGER

TEMP. 72°

TOWNSHIP GREEN CREEK

SECTION 26

DWG BY NIESE

PID 85272

T 4 N R 16 E

TYPE MONUMENT P.K./WASHER

ON SURFACE - ~~BELOW~~ ON

OFFSET CL PAVEMENT ON LT : RT

- TO - EDGE PAVEMENT


STATION: 113+58

HORIZ.DATUM: NAD83 OH N 3401

GEOID: NAVD88 2007

GRID: NORTHING: 590000.610

EASTING: 1837936.482

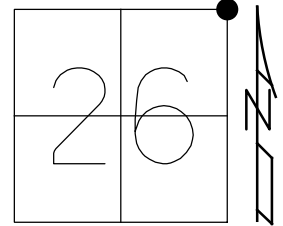

RECORD: P.O.T.
FD P.K. ATOP
R.R.SPIKE
2 1/2" DOWN
SET P.K./WASHER
10/1/92
FD P.K./WASHER
7/1/08, DCH
SET MAG/WASHER
9/29/08
FD MAG/WASHER
CL205
8/24/10, KPM
REF5
6/16/16, JFO
9/12/17, JMR

FD
SHI



73.90'

FD
SHI



92.13'

CL SR 101

30.05'




FD
SHI

O.D.O.T. DISTRICT 2 SURVEY OFFICE (USE ONLY)


PERSONNEL _____ REFERENCE NO. 5 SHEET 9 OF 11
NOTES HOMAN DATE 7/1/08 ROUTE SR 101
H.C. ROUSOS WEATHER SUNNY COUNTY SANDUSKY
R.C. HOMAN TEMP. 75° TOWNSHIP GREEN CREEK
SECTION 26
T 4 N R 16 E

TYPE MONUMENT PK/WASHER
ON SURFACE - ~~BELOW~~ ON
LEFT - ℄ PAV'T - RIGHT ON
- TO - EDGE PAVEMENT
S.L.M. 113+58

GRID: NORTHING: 590000.589 EASTING: 1837936.565

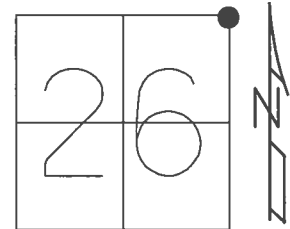

RECORD:
FD P.K. ATOP
R.R. SPIKE
1992
SET P.K./WASHER
10/1/92
FD P.K./WASHER
7/1/08, DCH
SET MAG/WASHER
9/29/08
FD MAG/WASHER
REF5
6/16/16, JFO
UNCOVERED
9/12/17, JMR

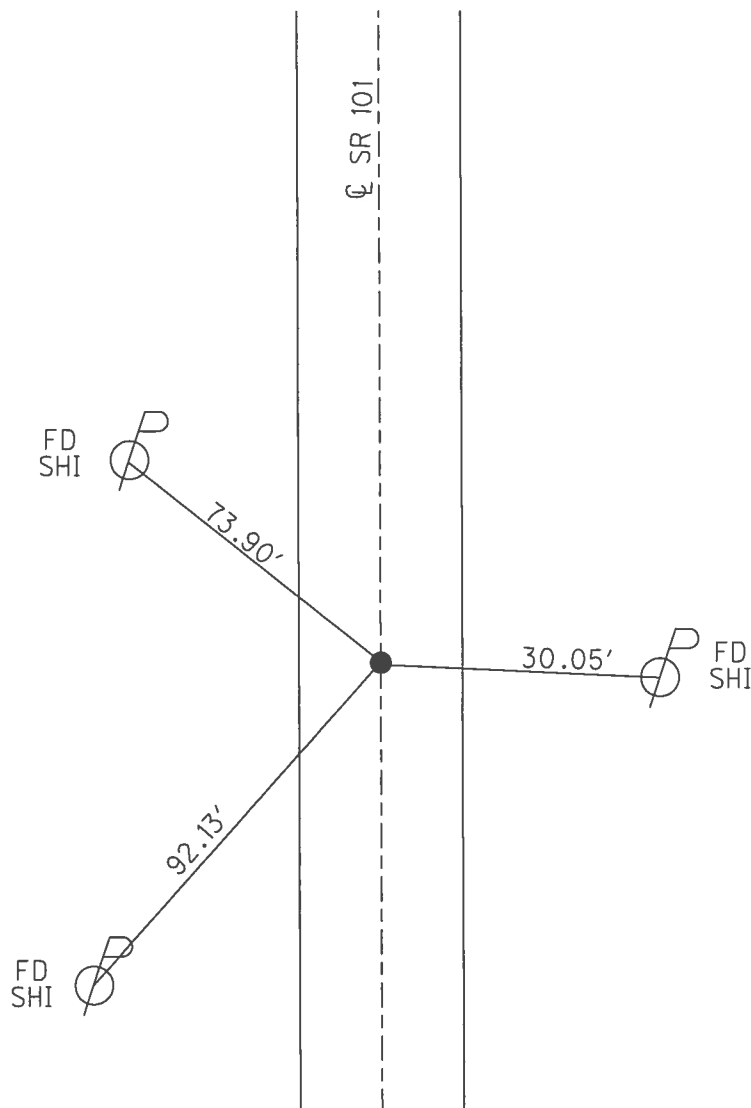

O.D.O.T. DISTRICT 2 SURVEY OFFICE (USE ONLY)


PERSONNEL _____ REFERENCE NO. 5 SHEET 9 OF 10
 NOTES HOMAN DATE 7-1-2008 ROUTE SR 101
 H.C. ROUSOS WEATHER SUNNY COUNTY SANDUSKY
 R.C. HOMAN TEMP. 75° TOWNSHIP GREEN CREEK
 SECTION 23,24,25,26
 T 4 N R 16 E

TYPE MONUMENT _____ PK/WASHER _____
 ON SURFACE - ~~BELOW~~ _____ ON _____
 LEFT - ℄ PAV'T - RIGHT _____ ON _____
 - _____ TO _____ EDGE PAVEMENT
 S.L.M. 113+58
 GRID: NORTHING: 590005.101 EASTING: 1837936.475

23	24
26	25



RECORD:
 FD P.K. OVER R.R. SPIKE.
 1992
 SET P.K./WASHER
 10/1/92
 SET MAG/WASHER
 9/29/08

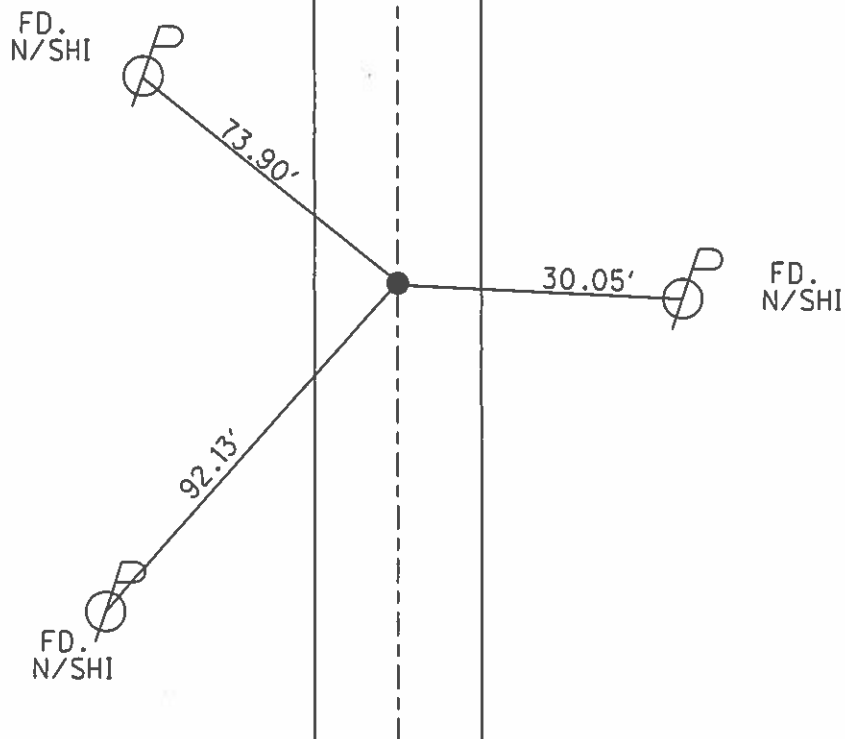

O.D.O.T. DISTRICT 2 SURVEY OFFICE

PERSONNEL

REFERENCE NO. # 5

SHEET 8 OF 10

NOTES Cheney

H.C. RIPPLE

R.C. BARBOUR

DATE 10-1-92

WEATHER SUNNY

TEMP. 70°

ROUTE SR#101

COUNTY SANDUSKY

TOWNSHIP GREEN CREEK

SECTION 23, 24, 25, & 26

T 4 N R 16 E

TYPE MONUMENT R.R. SPK.

~~ON SURFACE~~ - BELOW 2 1/2"

~~LEFT - & PAV'T. - RIGHT~~ yes


TO EDGE PAVEMENT

S.L.M. 113+58

Re-set
P.K./washer
10-1-92

5

23	24
26	25

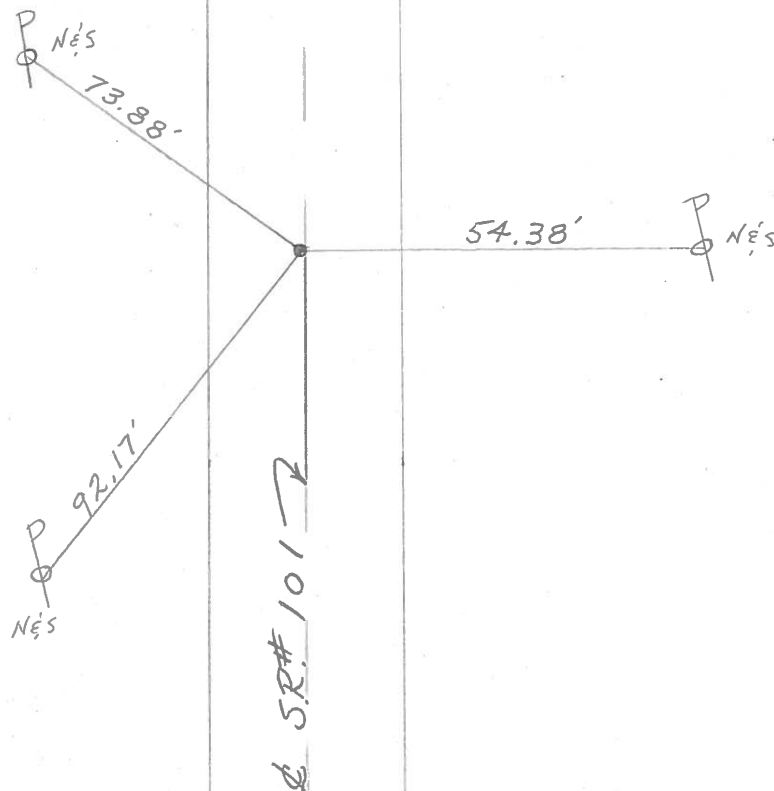

County Sandusky S.R. #101Township Green CreekSection 23, 24, 25 & 26T 4 N, R 16 EPersonnel CroninRippleGeymanBarbourDate 11/17/83Weather overcastTemp. 34°

23	24
26	25



#5

Fd. R.R. spike 2 1/2"
below surface