


O.D.O.T. DISTRICT 2 SURVEY OFFICE (USE ONLY)


PERSONNEL	REFERENCE NO.	9	SHEET	6	OF	39
NOTES	LEU	DATE	12/11/17	ROUTE	SR 101	
H.C.	LEU	WEATHER	CLOUDY	COUNTY	SANDUSKY	
R.C.	FARKAS	TEMP.	31°	TOWNSHIP	GREEN CREEK	
				SECTION	12	
				T	4	N
				R	16	E

TYPE MONUMENT MAG/WASHER
ON SURFACE - ~~BELOW~~ ON
LEFT - CL PAV'T - ~~RIGHT~~ 0.6'
- TO - EDGE PAVEMENT
S.L.M. 234+24.29

Grid: Northing: 600955.936 Easting: 1840750.333

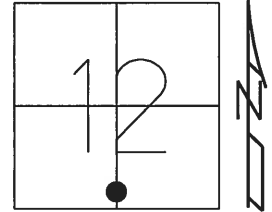

RECORD:
CLYDE CITY LIMITS
STA. 234+05
FD P.K./WASHER
6/9/86, RIPPLE
FD P.K.NAIL
REF9
11/12/14, EBW
SET MAG/WASHER
BY COORDINATES
12/11/17, JLL

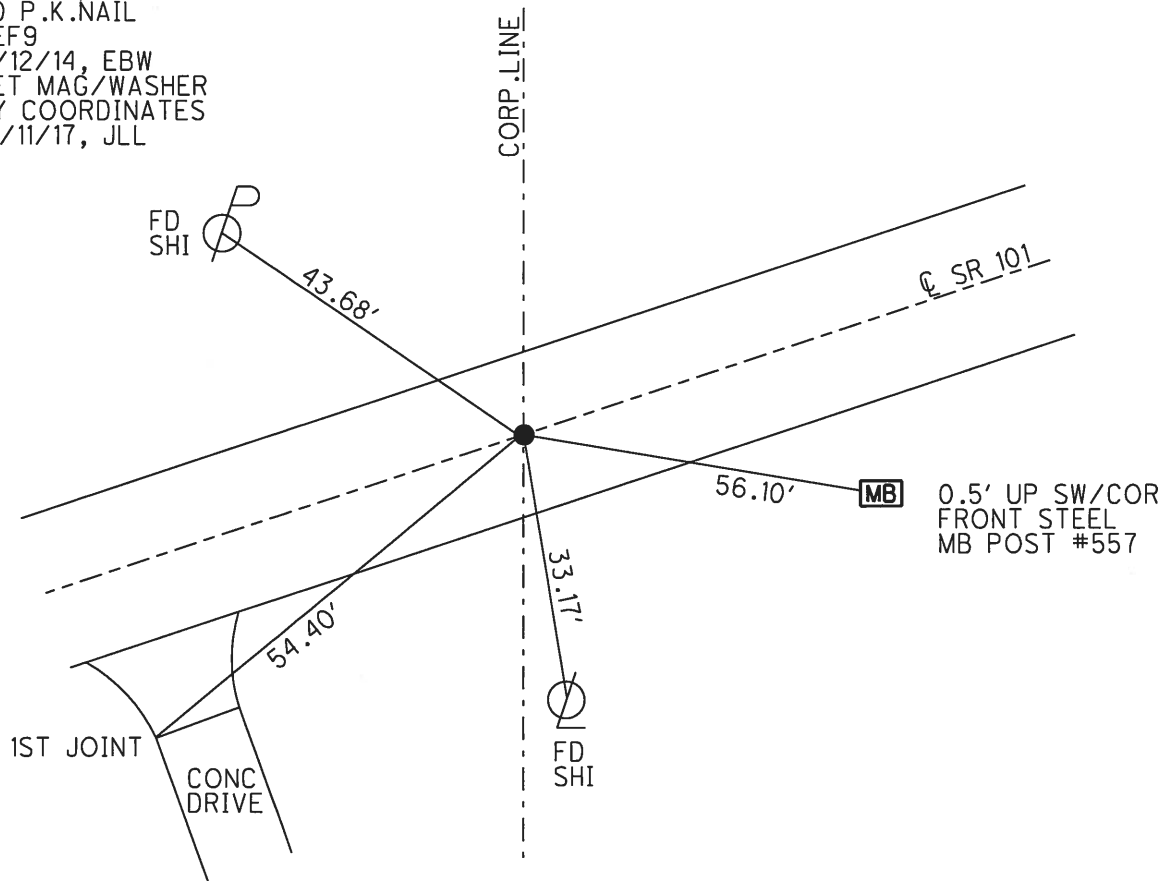

O.D.O.T. DISTRICT 2 SURVEY OFFICE

PERSONNEL _____

REFERENCE NO. _____

SHEET 1 OF _____

NOTES Cronin

H.C. Ripple

R.C. Geyman

DATE 10/14/87

WEATHER sunny

TEMP. 52°

ROUTE #101

COUNTY Sandusky

TOWNSHIP Green Creek

SECTION 12

T. 4 N. R. 16 E



TYPE MONUMENT P.K. washer

ON SURFACE - BELOW on surface

LEFT- & PAV'T. - RIGHT & Pavt

____ TO ____ EDGE PAVEMENT

S.L.M. old Sta 291.23 ±

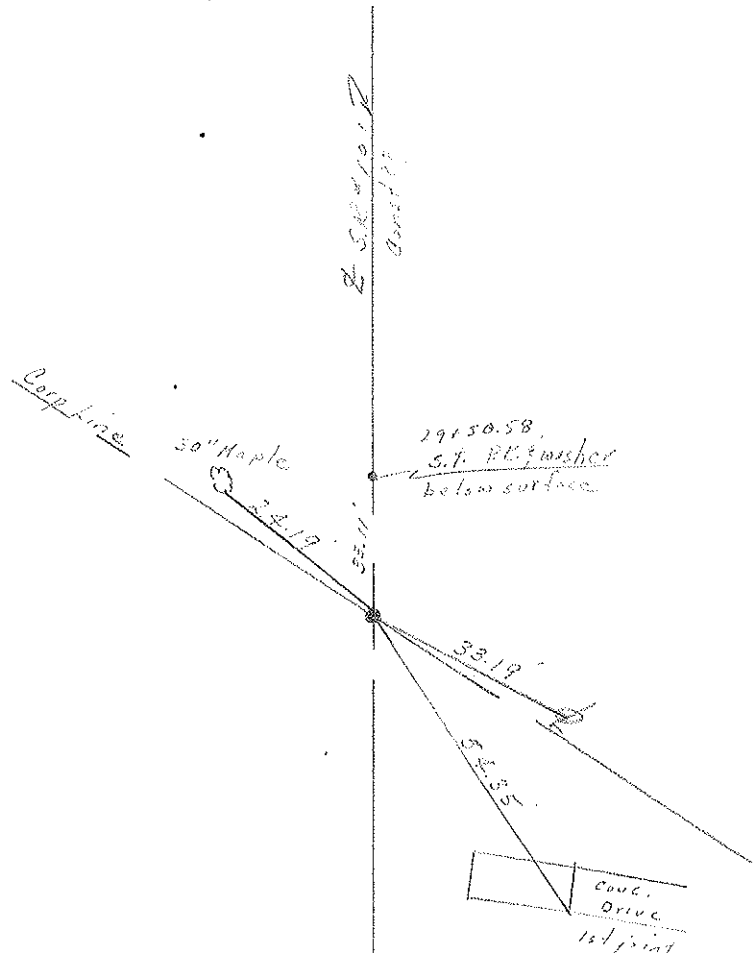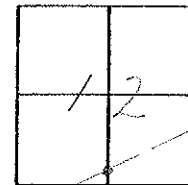

COUNTY SANDUSKY DATE 6/9/86

GEUMAN _____ S. R. 101 _____ WEATHER SUNNY

S. R. 101 WEATHER SUNNY

SEC. N.E. of Clyde TEMP. 68°

DESCRIPTION Ties for Control Points JOB NO. 101119-220



25" maple

24.18-

11.3.20

Cor.	Can.	De
------	------	----