


O.D.O.T. DISTRICT 2 SURVEY OFFICE (USE ONLY)

PERSONNEL _____ REFERENCE NO. 10 C SHEET 10 OF 39
NOTES LEU DATE 12/12/17 ROUTE SR 101
H.C. LEU WEATHER CLOUDY COUNTY SANDUSKY
R.C. FARKAS TEMP. 31° TOWNSHIP GREEN CREEK
SECTION 12
T 4 N R 16 E


TYPE MONUMENT P.K.NAIL
ON SURFACE - ~~BELOW~~ ON
~~LEFT~~ - CL PAV'T - RIGHT 0.4'
9.7' TO RT EDGE PAVEMENT
S.L.M. 247+76.87

Grid: Northing: 601508.159 Easting: 1841985.007

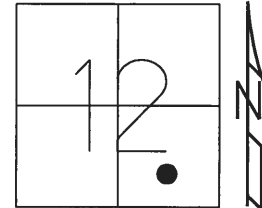

RECORD:
UNKNOWN ORIGIN
FD P.K./WASHER
8/11/97, SAH
SET P.K./WASHER
8/21/97, SAH
FD P.K.NAIL
REFC10
11/12/14, EBW
SET MAG/WASHER
12/12/17, JLL

DIST.
10A-10B= 4.94'
10B-10C= 92.36'

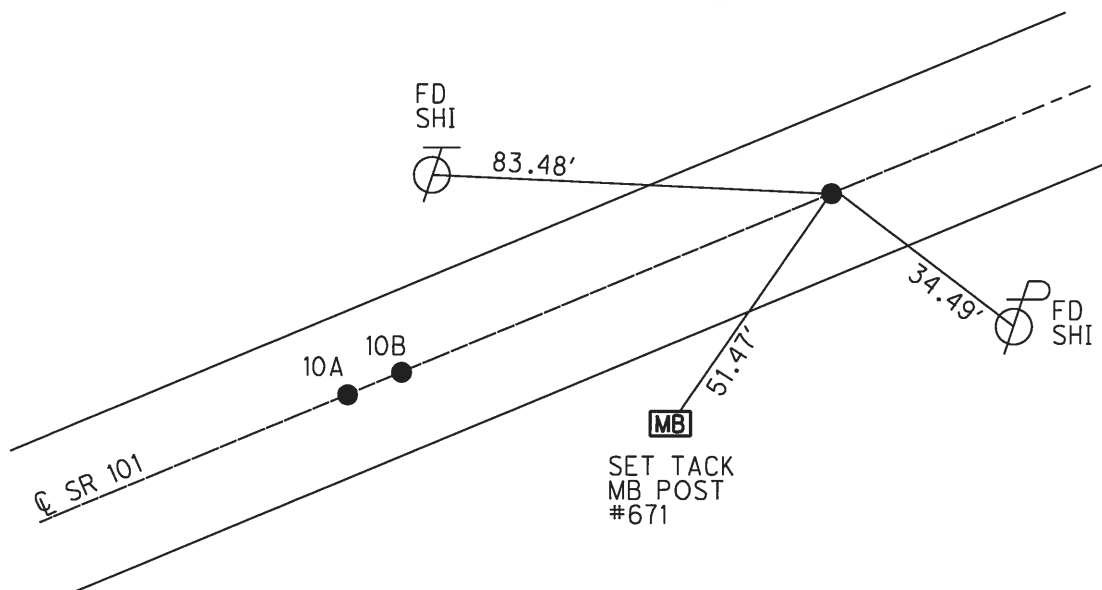

O.D.O.T. DISTRICT 2 SURVEY OFFICE

PERSONNEL

REFERENCE NO. _____

SHEET 2 OF 4

NOTES Huss

H.C. Van Dusen

R.C. Mogor

DATE 8-11-97

WEATHER Cldy - Fair

TEMP. + 72° F

ROUTE 101

COUNTY Sandwich

TOWNSHIP Green Creek

SECTION 12

T4 NR 17 E


TYPE MONUMENT (A) - PK/W (B) Lg. R.R. Spk. (C) PK/W

ON SURFACE - BELOW (A) Surface (B) .2' below (C) Surface

LEFT - C PAV'T. - RIGHT (A) .3' R+ C (B) .4' R+ C (C) .4' R+ C

(A) 9.8' TO RT. EDGE PAVEMENT (B) 9.8' to RT EOP (C) 9.7' to EOP

SI K. (A) = 7+534 (B) = 7+539 (C) = 7+564

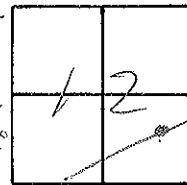

Set PK/W at

Pt. A-B-C

8-21-97 5^{PM}

ALL POINTS - UNKNOWN. ORIGINAL

