

O.D.O.T. DISTRICT 2 SURVEY OFFICE (USE ONLY)

PERSONNEL

REFERENCE NO. 22

SHEET 5 OF 13

NOTES RHOADES

DATE 9/25/12

ROUTE SR 101

H.C. CODER

WEATHER CLDY. FAIR

COUNTY SANDUSKY

R.C. RHOADES

TEMP. 66°

TOWNSHIP TOWNSEND

SECTION 35

T 5 N R 17 E

TYPE MONUMENT P.K./WASHER


ON SURFACE - ~~BELOW~~ ON

~~LEFT~~ - C PAV'T - RIGHT 5.7'

4.6' TO RT EDGE PAVEMENT

S.L.M. 530+72.80

Grid: Northing: 616170.225 Easting: 1865968.758

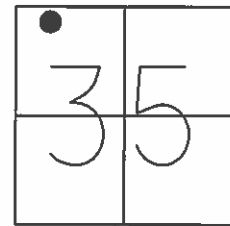

RECORD: P.I.

325+34.10

$\Delta = 03^{\circ} 27' 00''$ LT

P.K./WASHER

R.R.SPIKE BELOW SURFACE

SET P.K./WASHER

8/12/97, SAH

FD P.K.SHANK


GPS, REF22

8/4/11, SAH

SET MAG/WASHER

GPS, FINREF22

3/21/13, SDC

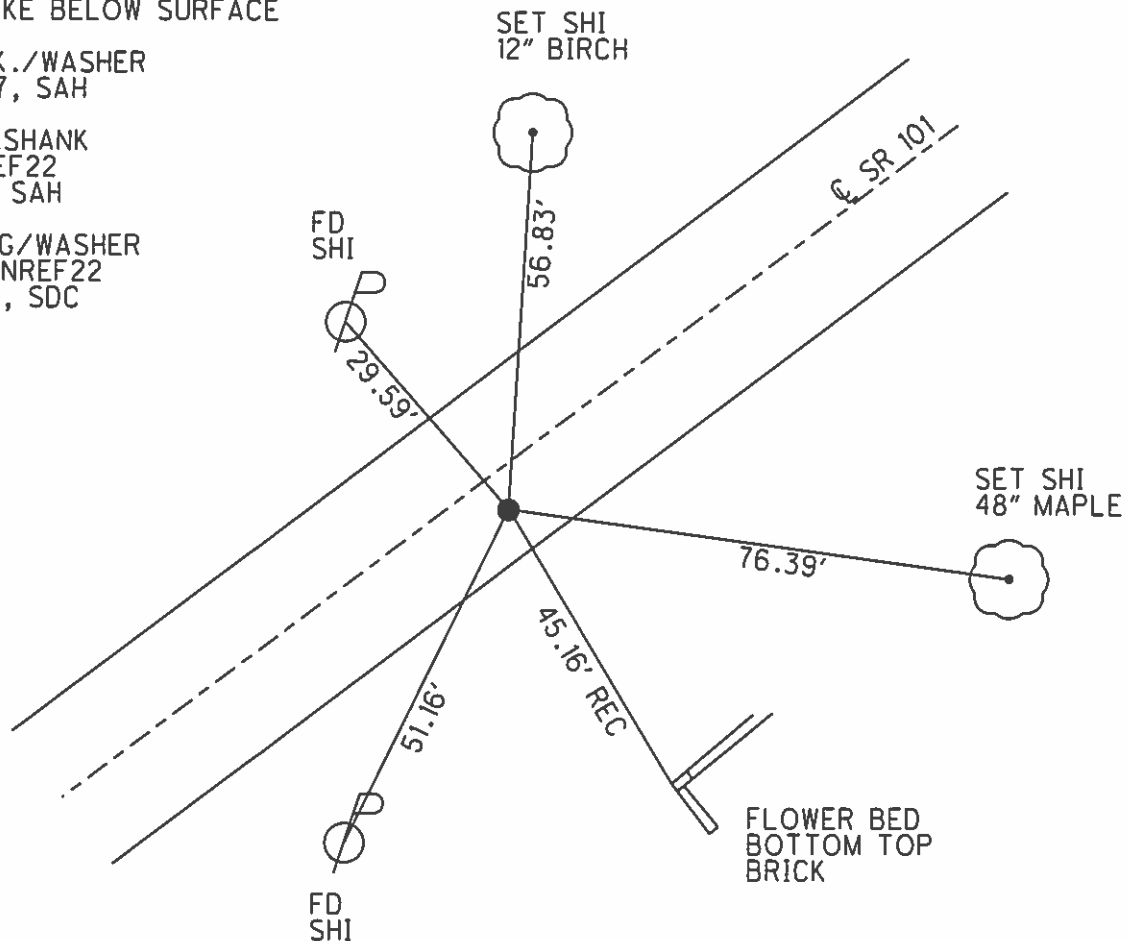

O.D.O.T. DISTRICT 2 SURVEY OFFICE

PERSONNEL

REFERENCE NO. _____

SHEET 30 OF 37

NOTES Huss

H.C. VanDusen

R.C. Moser

DATE 8-4-97

WEATHER Cldy - Fair

TEMP. +80°F

ROUTE 101

COUNTY Sandusky

TOWNSHIP Townsend

SECTION 35

T. 5 N. R. 17 E.

TYPE MONUMENT P.K./WASHER


ON SURFACE - BELOW YES

~~NORTH PLANT~~ - RIGHT 5.4 Rt.

4.6 TO Rt EDGE PAVEMENT


S.L.M. 16 + 209 SCK

22

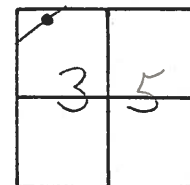

RECORD: 325 + 34.10
P.I. $\Delta = 03^\circ - 27' - 00''$ LT.
P.K./washer
R.R. SPIKE Below Surface

Set PK/W
8-12-97 SAH

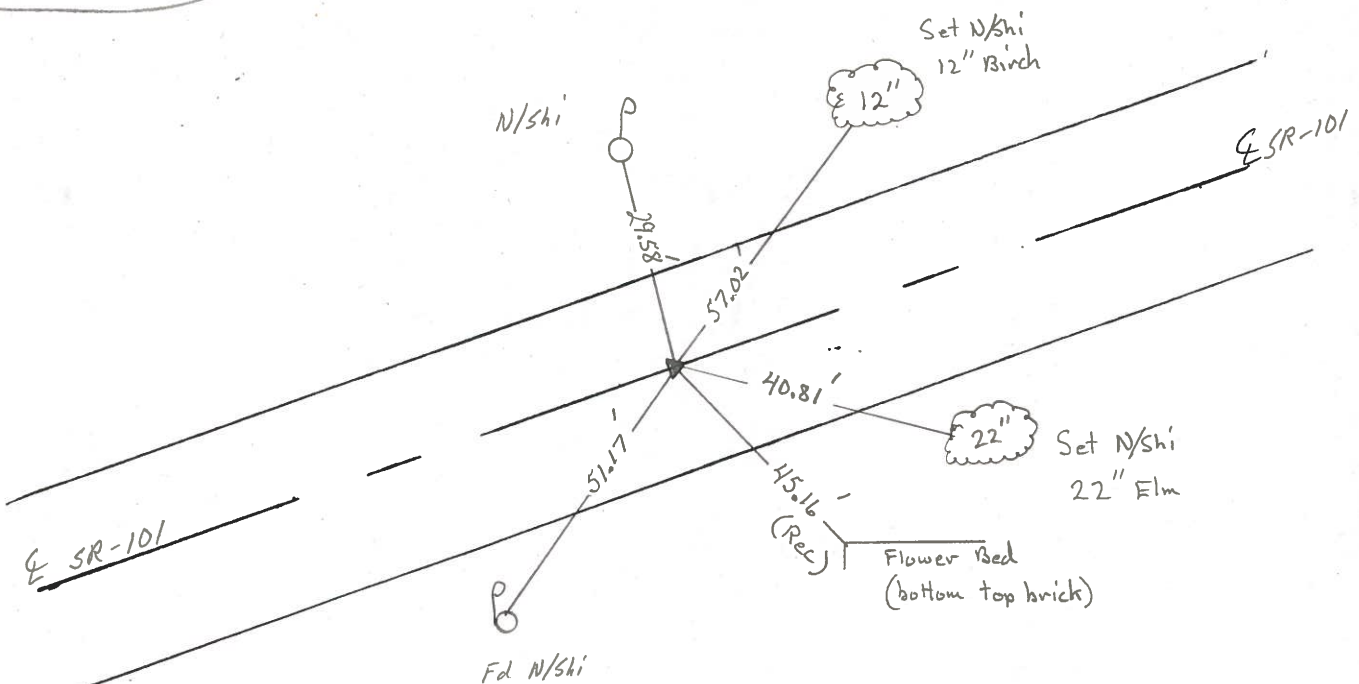

O.D.O.T. DISTRICT 2 SURVEY OFFICE

PERSONNEL _____

REFERENCE NO. _____

SHEET 24 OF _____

NOTES Cromin

H.C. Ripple

R.C. Barbour

DATE 10/28/87

WEATHER sunny

TEMP. 52°

ROUTE #101

COUNTY Sandusky

TOWNSHIP Townsend

SECTION 35

T 5 N R 17 E

TYPE MONUMENT PK & washer


ON SURFACE - BELOW on surface

LEFT - & PAW'T. - RIGHT 5' ± R. & Post

TO _____ EDGE PAVEMENT

S.L.M. old Sta. 325+34.10


22

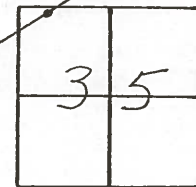

P.I. - Δ = 03°27'00" Lt. Rec.

PK & washer & R.R.

spike below surface

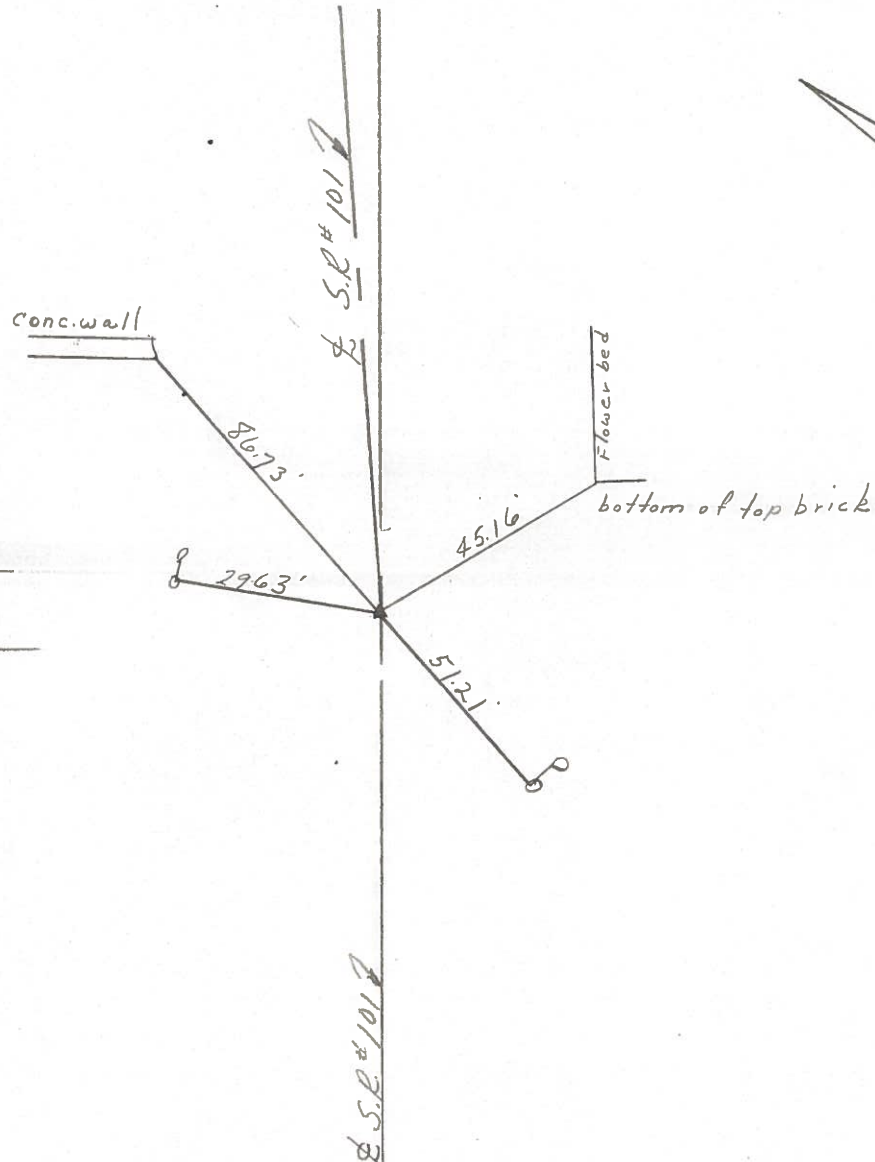

PERSONNEL

TITLE

PERSONNEL

TITLE

Cronin

COUNTY Sandusky

DATE 3/14/77

Ripple

S. R. #101

WEATHER overcast

Geyman

SEC. San. 101-(3.88-11.90)

TEMP. 50°

DESCRIPTION

Ties for Control Points

JOB NO.

LEFT

CENTER LINE

Survey

RIGHT

Townsend Twp.

(22)


 $\Delta = 3^{\circ} 27' 24''$ (Plan)

P.I.

325+34.10

Fd. R.R. spike on surface


conc. wall

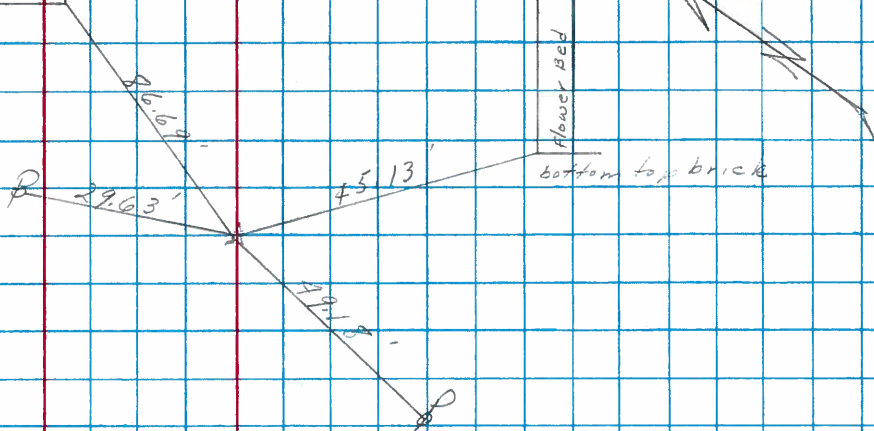

(21)

P.O.T

311+52 ±

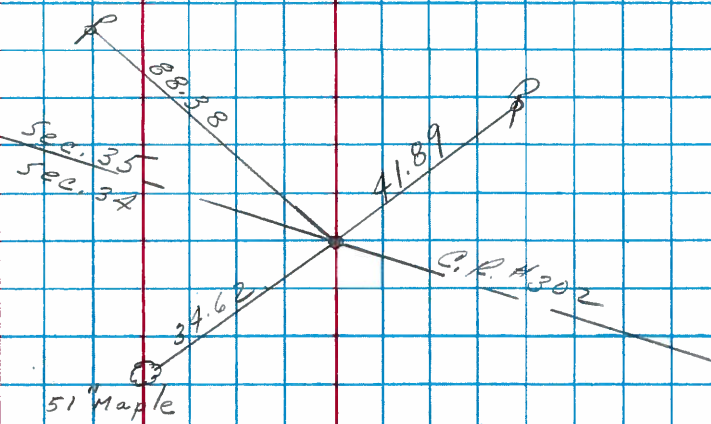
Fd. R.R. spike
on surface - not on
N-S section line $\Delta = 10^{\circ} 48' 48''$ (Plan)

P.I.

295+05.65


Fd. R.R. spike
on surface

(20A)

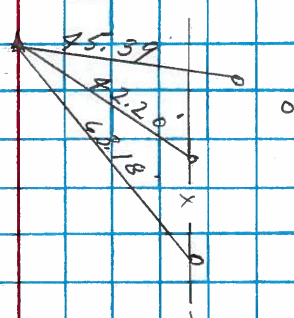


PERSONNEL	TITLE	PERSONNEL	TITLE	COUNTY	DATE	WEATHER	TEMP.
Schneider		Potts		Sandusky	4-16-68	Fair	55°
Mosser				S. R. 101			
Borbnur				SEC. N.E. of Clyde			
Redding							

DESCRIPTION Ties for Control Points JOB NO. _____

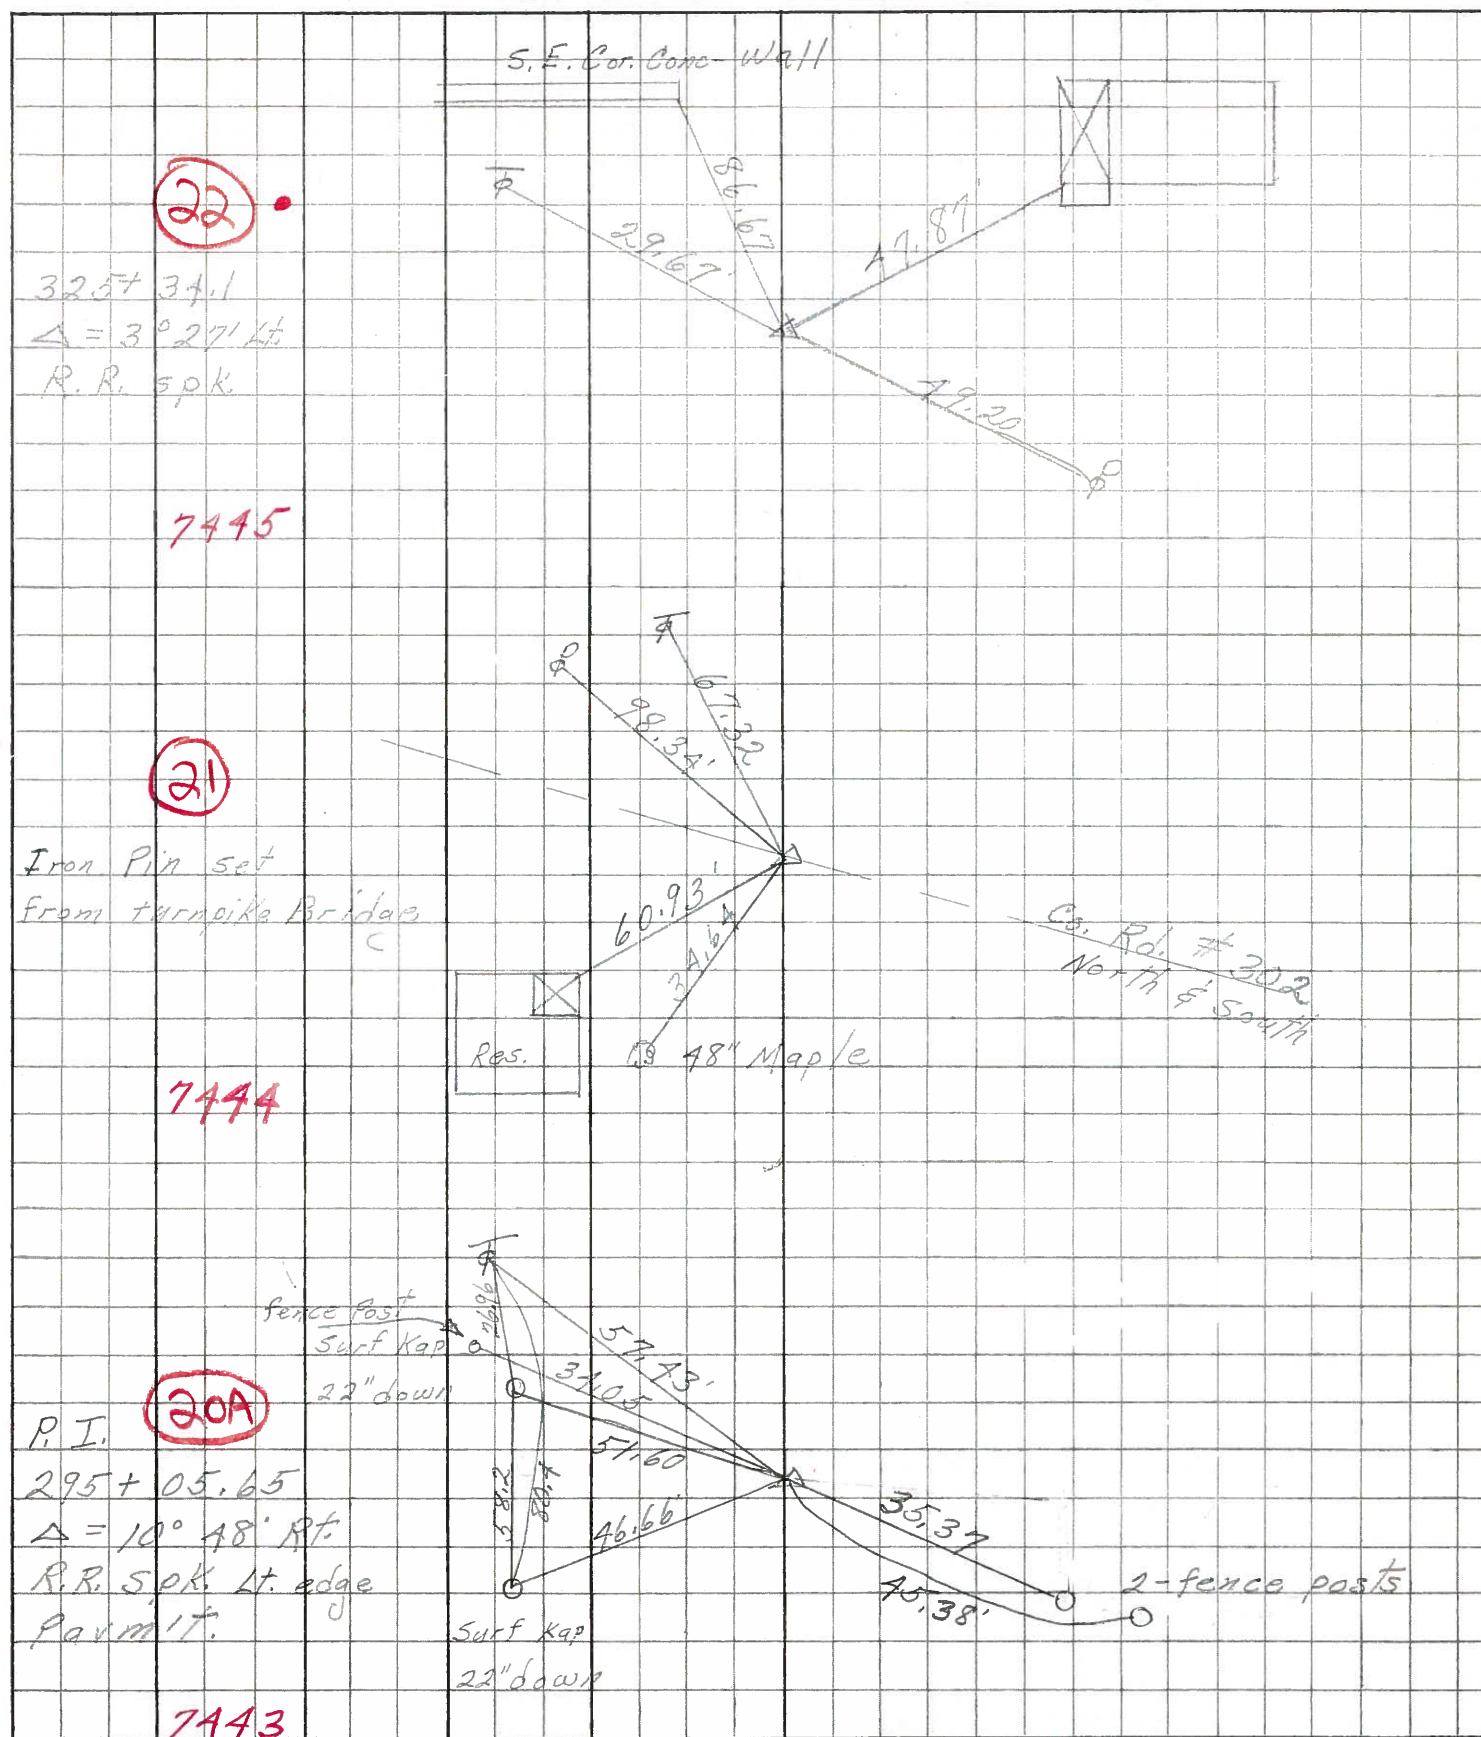

PERSONNEL	TITLE	PERSONNEL	TITLE	COUNTY	DATE	WEATHER	TEMP.
KraBill				Sandusky	Feb. 5, 1964		
Kowaleski				S. R. #101			
Geyman							
Bruggeman							

DESCRIPTION From U.S. 20 North to Erie Co. Line JOB NO. _____

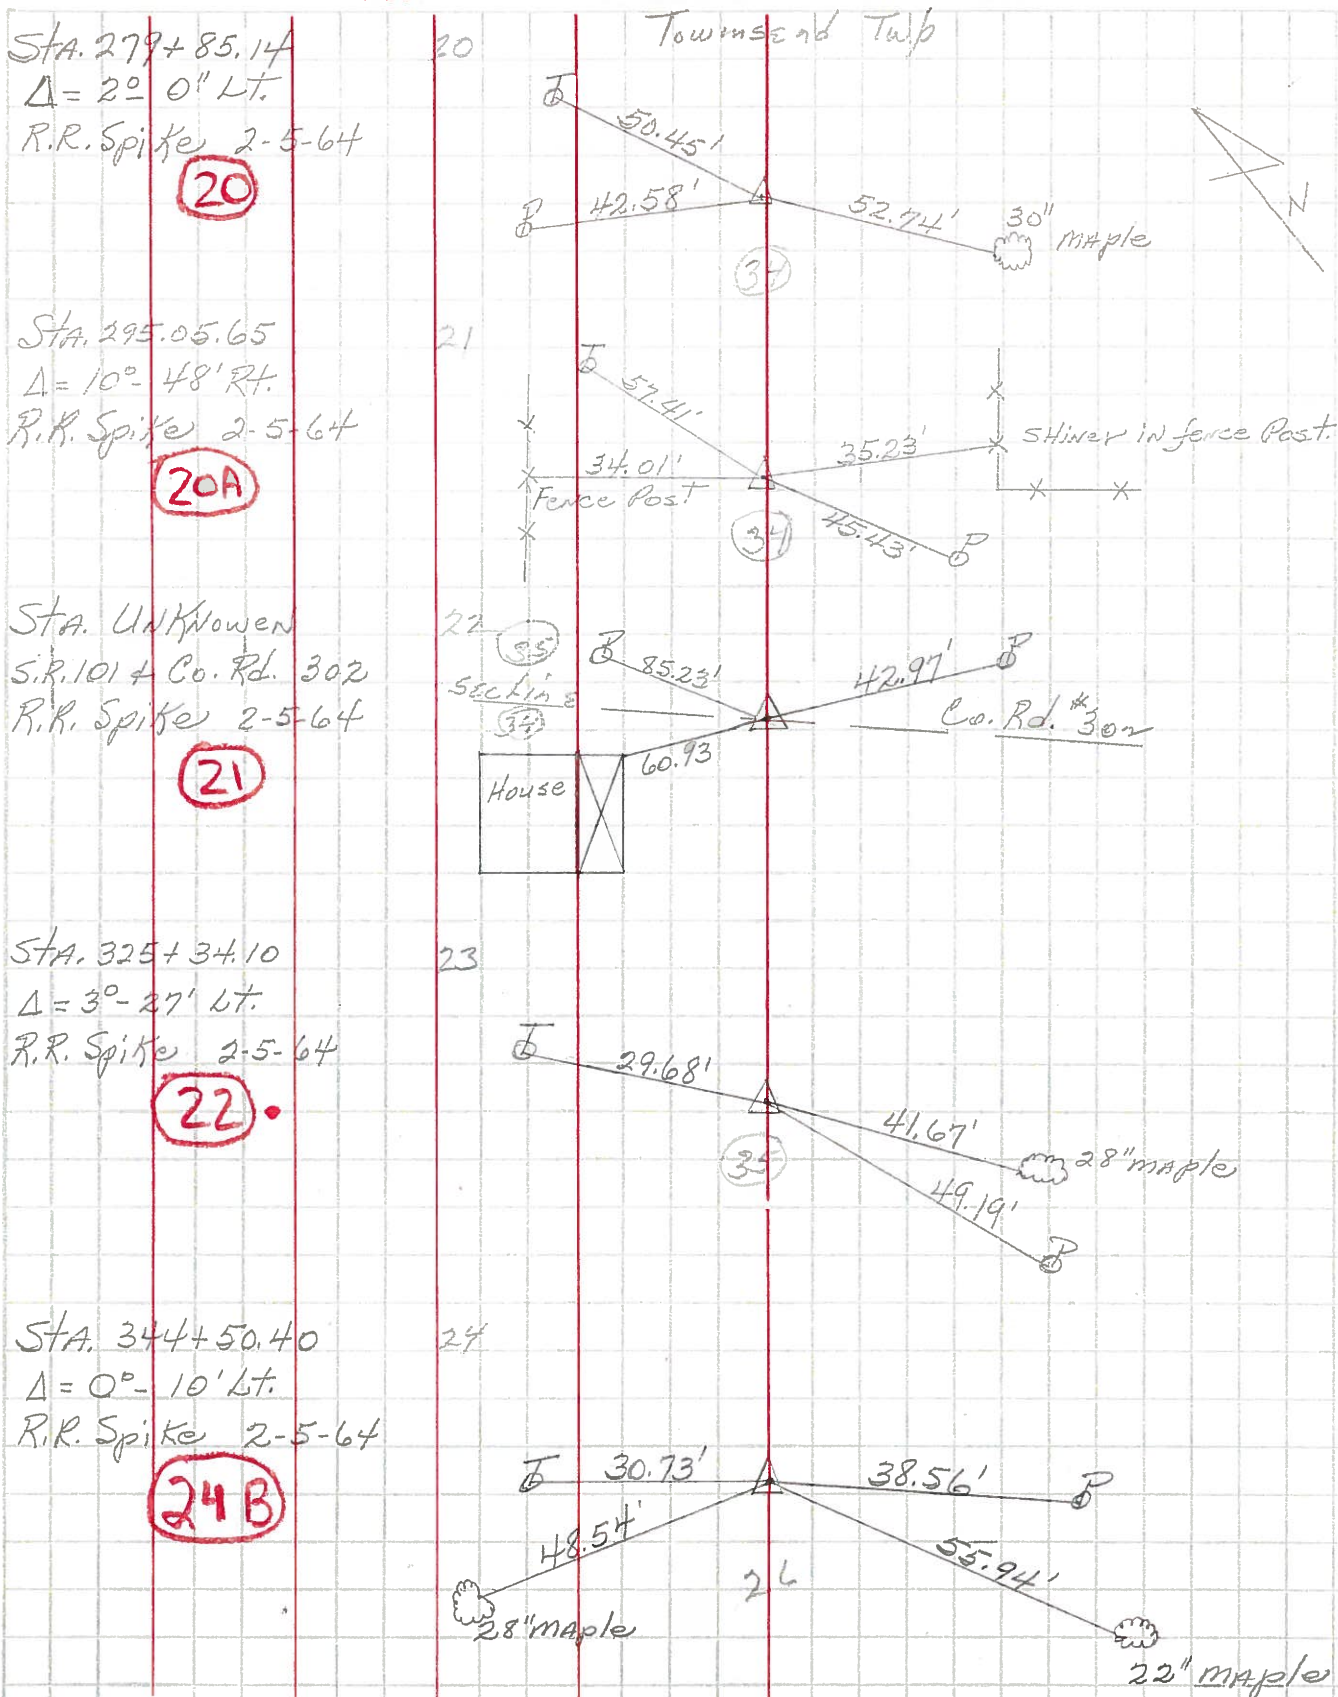

O.D.O.T. DISTRICT 2 SURVEY OFFICE

PERSONNEL

REFERENCE NO. 24-A

SHEET 31 OF 37

NOTES Huss

H.C. Van Dusen

R.C. Moser

DATE 8-5-97

WEATHER Pt Cldy - Fair

TEMP. +78 °F

ROUTE SR- 101

COUNTY Sandusky

TOWNSHIP Townsend

SECTION 35

T 5 N R 17 E


TYPE MONUMENT SMALL R.R. SPIKE (BENT OVER)

ON SURFACE - ~~BELOW~~ yes

(LEFT) - ~~PAV'T~~ - RIGHT 5.9 Lt.

3.7 TO *Lt* EDGE PAVEMENT

S.L.M. 16 + 289 SLK

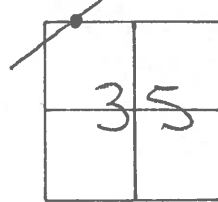

Record:

CORNER STONE
Below Surface

AT Packhurst Cemetery

{ Set PK/W 8-12-77 SAH

