

O.D.O.T. DISTRICT 2 SURVEY OFFICE (USE ONLY)

PERSONNEL

REFERENCE NO. 24 B

SHEET 7 OF 13

NOTES RHOADES

DATE 9/25/12

ROUTE SR 101

H.C. CODER

WEATHER CLDY. FAIR

COUNTY SANDUSKY

R.C. RHOADES

TEMP. 66°

TOWNSHIP TOWNSEND

SECTION 26

T 5 N R 17 E

TYPE MONUMENT P.K./WASHER


ON SURFACE - ~~BELOW~~ ON

~~LEFT~~ - C PAV'T - RIGHT 0.5'

9.5' TO RT EDGE PAVEMENT

S.L.M. 549+89.18

Grid: Northing: 617334.142 Easting: 1867491.178

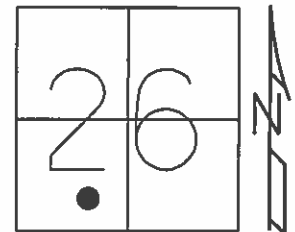


RECORD: P.I.
325+34.10
 $\Delta = 03^{\circ} 27' 00''$ LT
P.K./WASHER
R.R.SPIKE BELOW SURFACE

SET P.K./WASHER
8/12/97, SAH

FD P.K.SHANK
GPS, REF22
8/4/11, SAH

SET MAG/WASHER
GPS, FINREF22
3/21/13, SDC

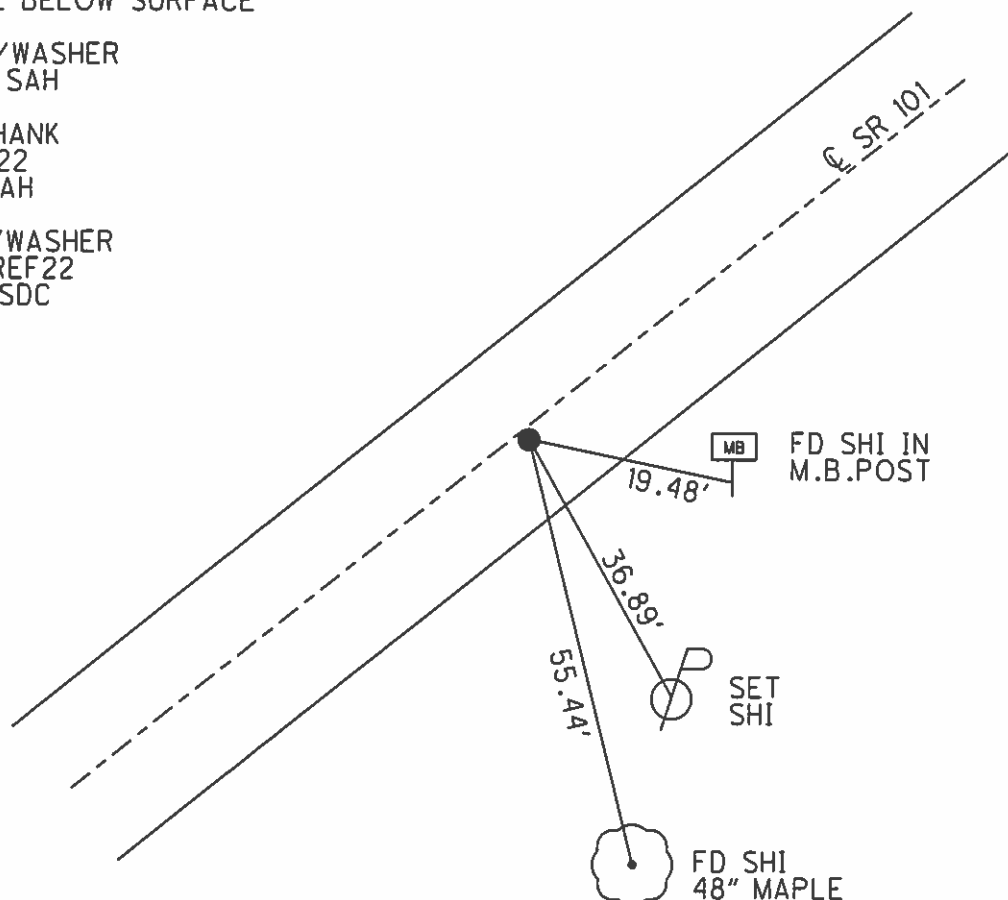

O.D.O.T. DISTRICT 2 SURVEY OFFICE

PERSONNEL

REFERENCE NO. _____

SHEET 32 OF 37

NOTES Huss

H.C. Van Dusen

R.C. Moser

DATE 8-4-97

WEATHER Cldy - Fair

TEMP. +80°F

ROUTE SR-101

COUNTY Sandusky

TOWNSHIP Townsend

SECTION 26

T 5 N R 17 E

TYPE MONUMENT P.K. / WASHER


ON SURFACE - BELOW yes

~~LEFT & PAINT~~ - (RIGHT) .5 Rt

9.5 TO Rt EDGE PAVEMENT


S.L.M. 16 + 795.5 SLK

243

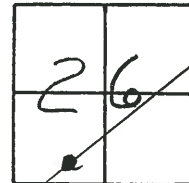

Record: 344 + 50.40
P.I. Δ = 00° - 10' - 00" Lt
P.K. # WASHER
R.R. spike below surface

Set PK/W
8-11-97 SAH

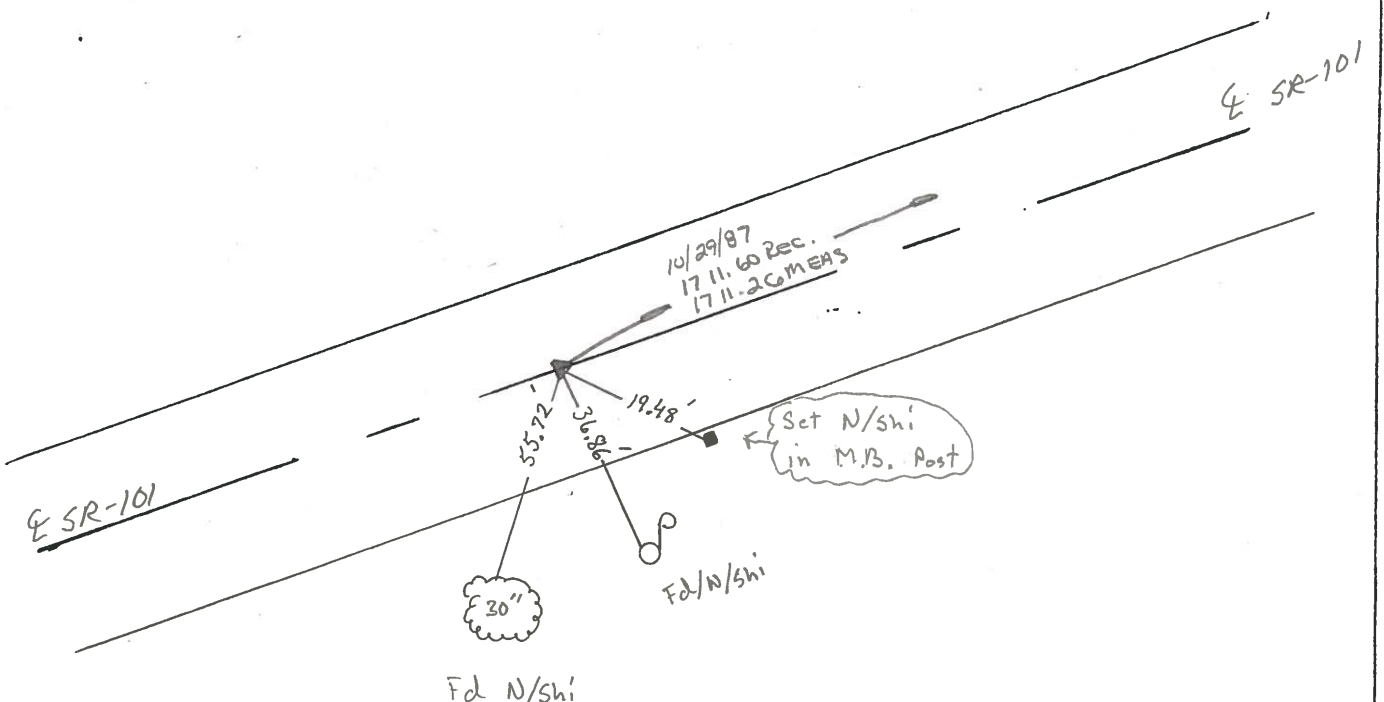

O.D.O.T. DISTRICT 2 SURVEY OFFICE

PERSONNEL _____

REFERENCE NO. _____

SHEET 25 OF _____

NOTES Cronin

H.C. Ripple

R.C. Barbour

DATE 10/29/87

WEATHER Sunny

TEMP. _____

ROUTE #101

COUNTY Sandusky

TOWNSHIP Townsend

SECTION 26

T 5 N R 17 E

TYPE MONUMENT P.K. & washer


ON SURFACE - BELOW on surface

LEFT - & PAW'T. - RIGHT & Pavt


TO _____ EDGE PAVEMENT

S.L.M. old Sta. 344+50.40

24B

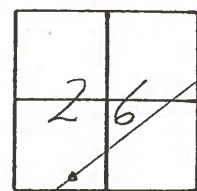

PI A=00°10'00"24 Rec.
P.K. & washer & R.R.
spike below surface

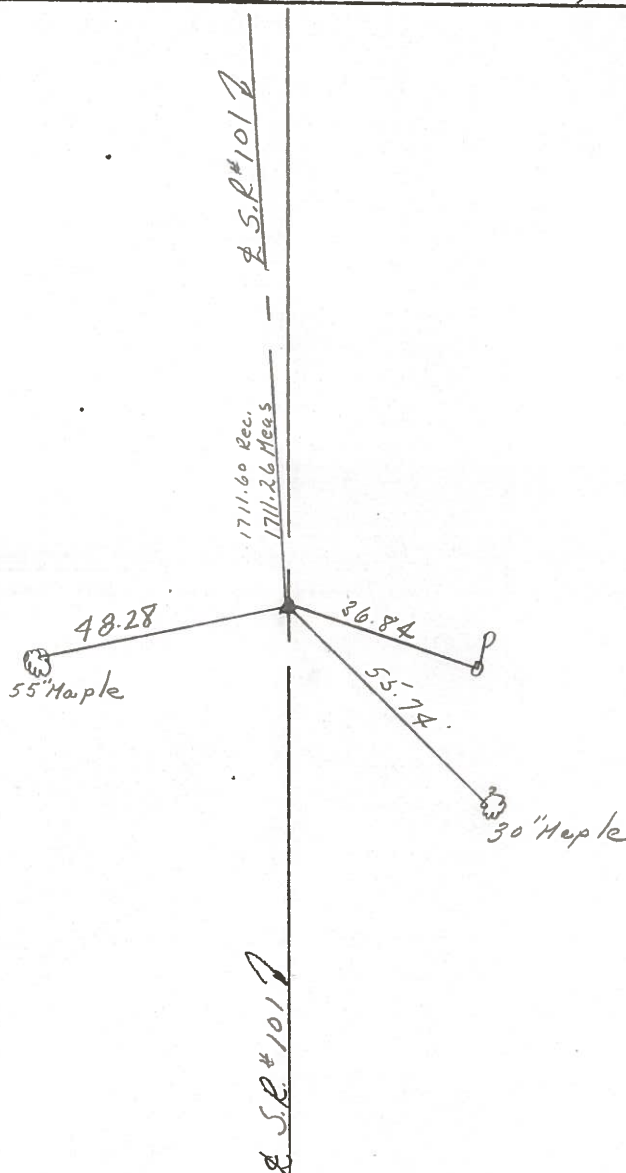

PERSONNEL

TITLE

PERSONNEL

TITLE

COUNTY

County

DATE

3/14/77

S. R.

#101

WEATHER

overcast

SEC.

San. 101-(3.88-11.90)

TEMP.

50

DESCRIPTION

Ties for Control Points


JOB NO.

LEFT


CENTER LINE

Survey

RIGHT

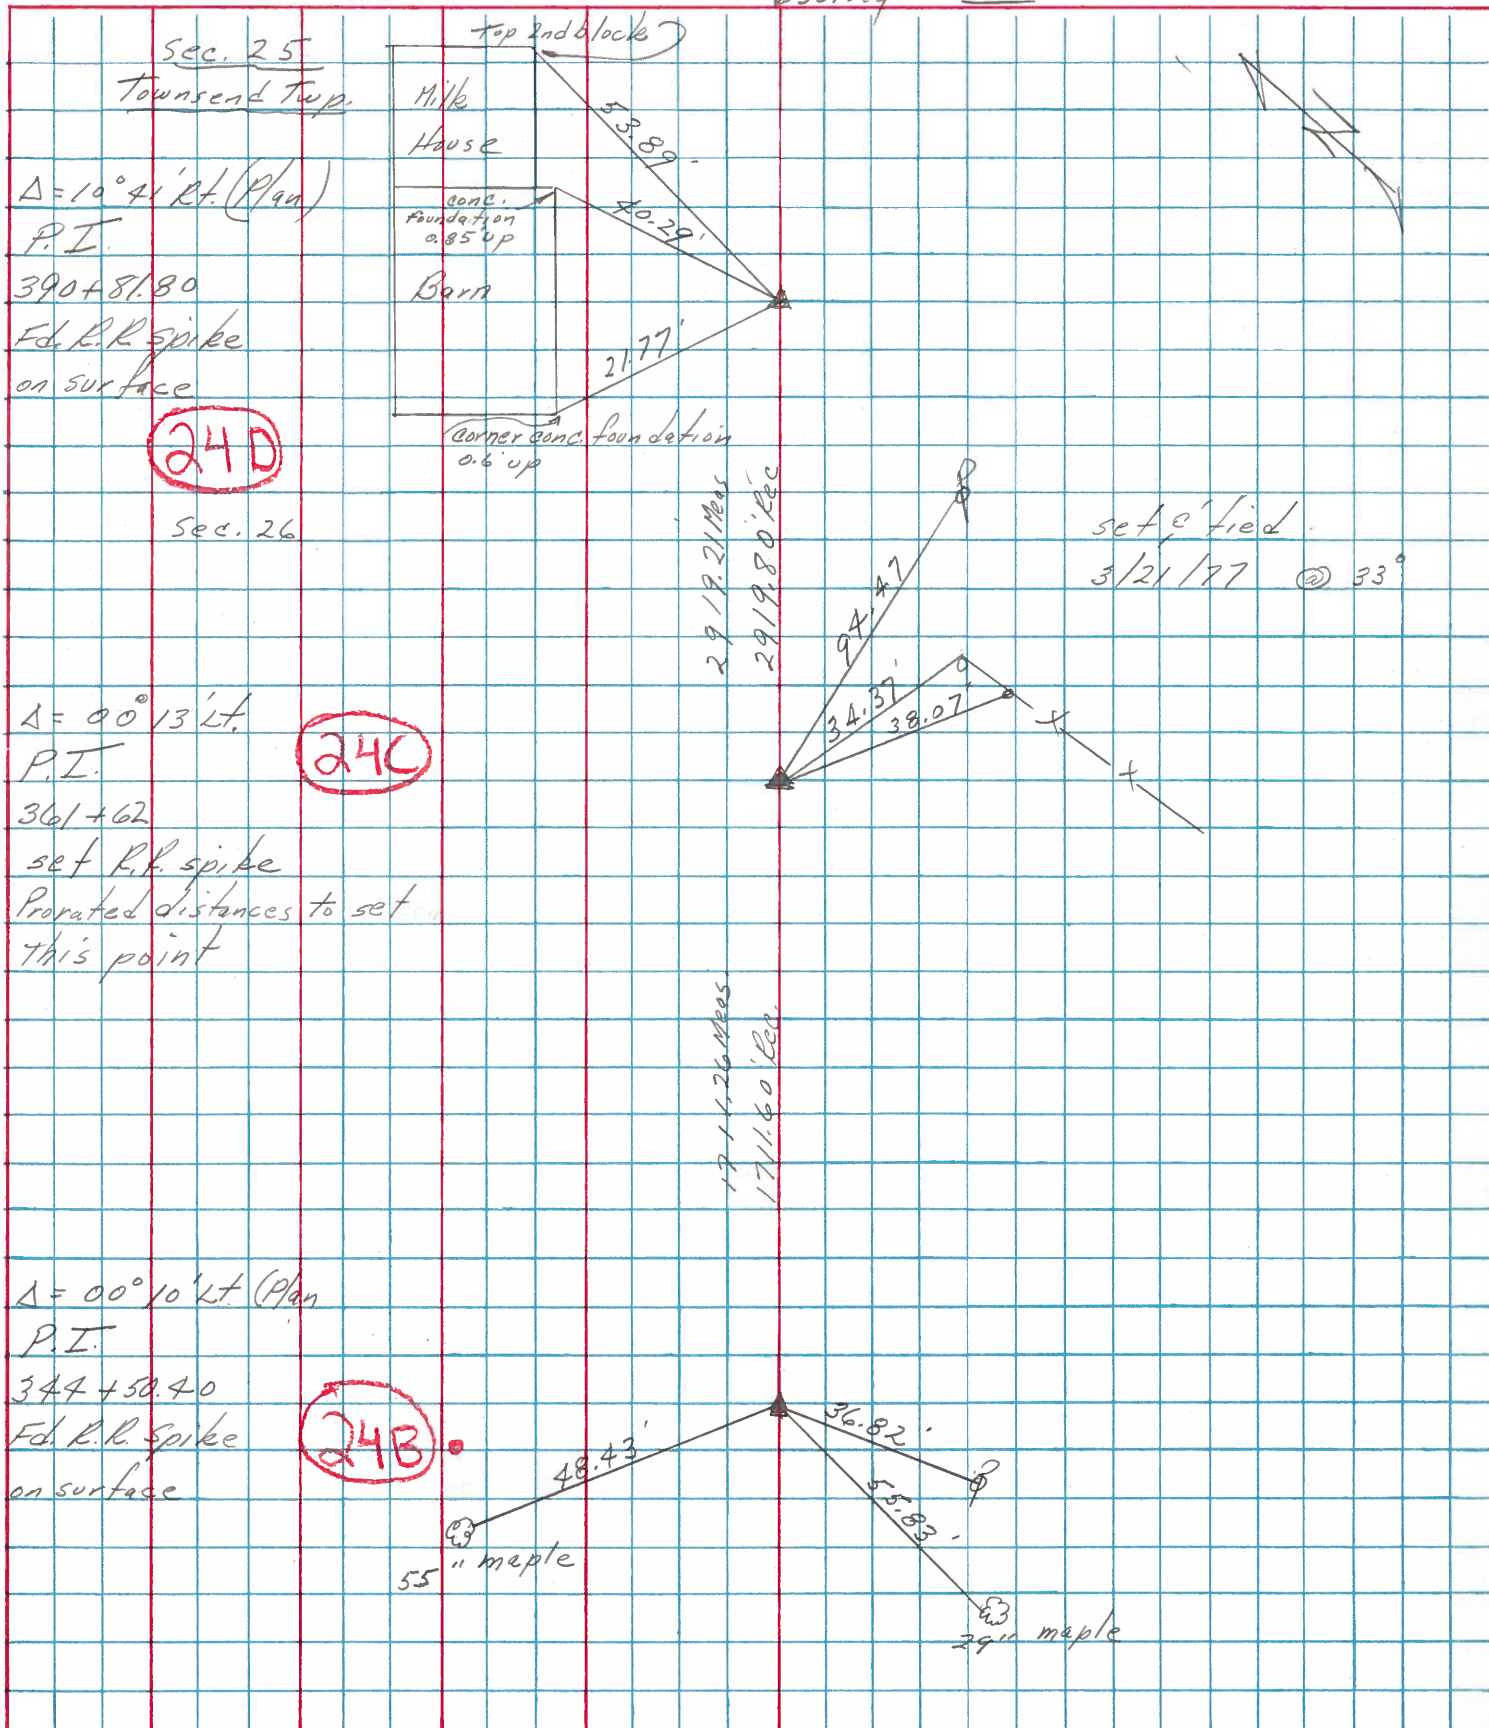

PERSONNEL	TITLE	PERSONNEL	TITLE	COUNTY	DATE	S. R.	WEATHER	TEMP.	DESCRIPTION
Schneider		Potts		Sandusky	4-16-68	101	Fair	60°	Ties f c + 0 nt.
Mosser									
Barbour									
Redding									

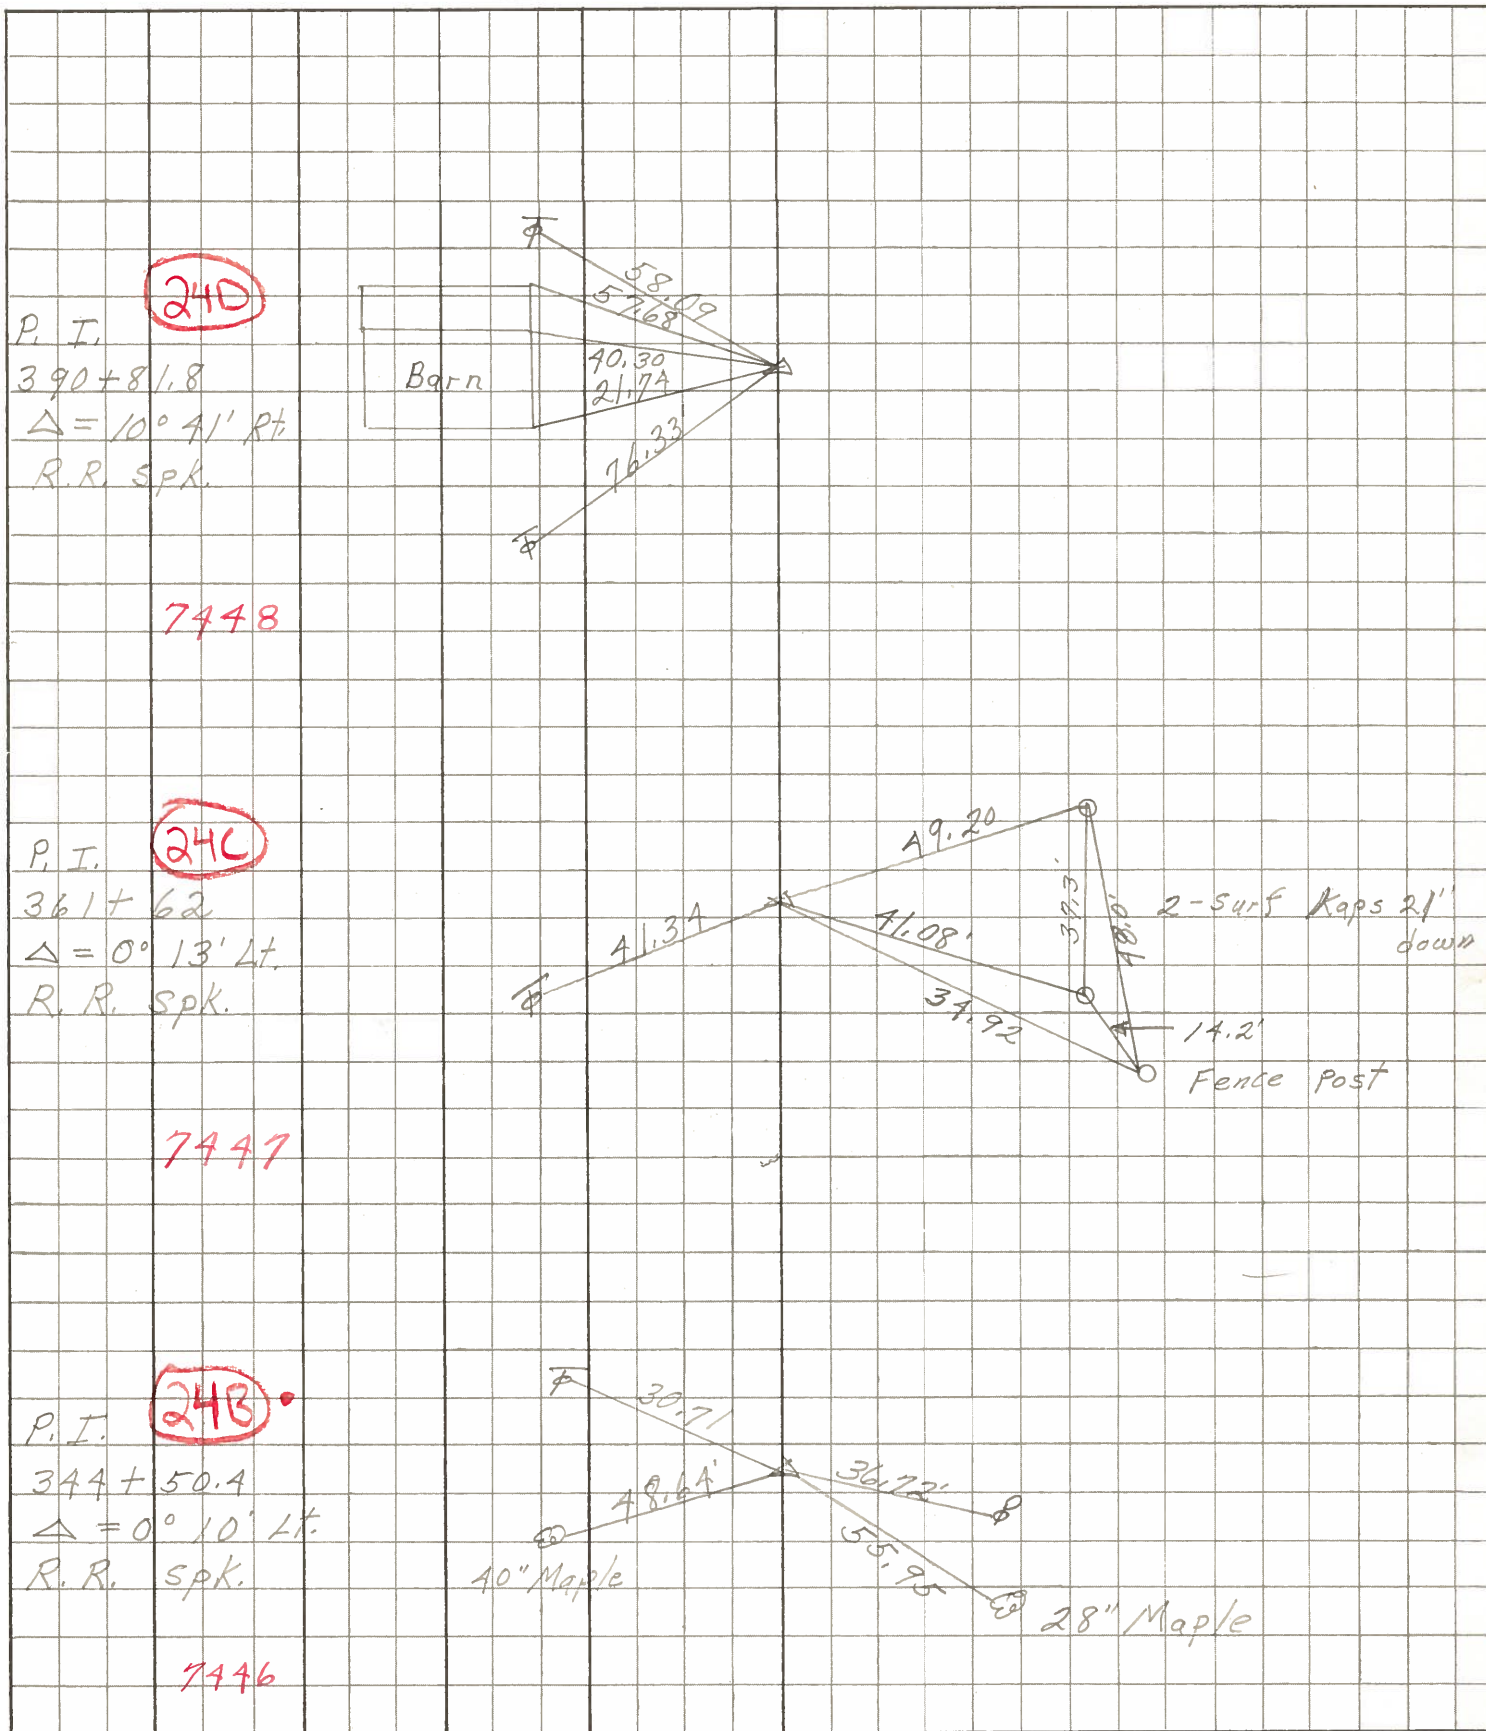

PERSONNEL	TITLE	PERSONNEL	TITLE	COUNTY	DATE	WEATHER	TEMP.
Krabbill				Sandusky	Feb. 5, 1964		
Kowaleski				S. R. #101			
Geyman							
Bruggeman							
DESCRIPTION: From U.S. 20 North to Erie Co. Line				JOB NO.			

