

O.D.O.T. DISTRICT 2 SURVEY OFFICE (USE ONLY)

PERSONNEL

REFERENCE NO. BUS39 D

SHEET 4 OF 4

NOTES LEU

DATE 5/21/20

ROUTE BUS 20

H.C. LEU

WEATHER CLOUDY

COUNTY SANDUSKY

R.C. AUBLE

TEMP. 61°

TOWNSHIP GREEN CREEK

SECTION 6

DWG BY NIESE

PID 102898

T 4 N R 16 E

TYPE MONUMENT MAG NAIL

ON SURFACE - ~~BELOW~~ ON

OFFSET Q PAVEMENT 10.8' ~~LT~~ : RT

1.8' TO RT EDGE PAVEMENT


STATION: 29+18.71

HORIZ.DATUM: NAD83 (2011)

GEOID: NAVD88 2012A

GRID: NORTHING: 607873.233

EASTING: 1814622.256

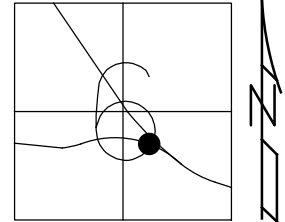

RECORD:

SET MAG NAIL

6/29/06, DCH


FD MAG NAIL

STA29

8/24/18, JFO

SET MAG/WASHER

4/19/21, DSA

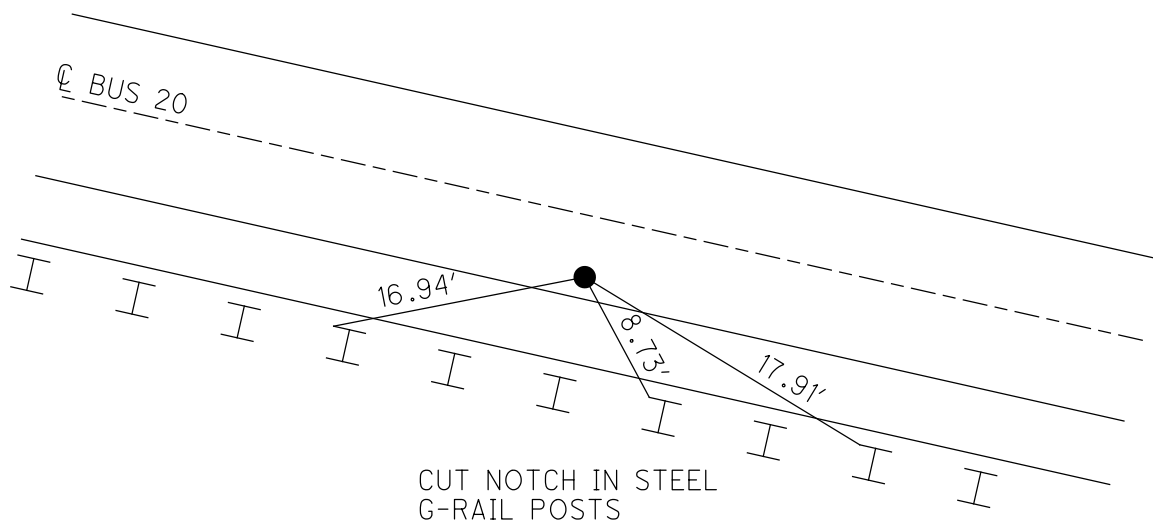

O.D.O.T. DISTRICT 2 SURVEY OFFICE (USE ONLY)

PERSONNEL

REFERENCE NO. _____

SHEET 4 OF 4

NOTES CORDES

DATE 6/29/06

ROUTE BUS 20

H.C. HOMAN

WEATHER SUN

COUNTY SANDUSKY

R.C. VIETH

TEMP. 75°

TOWNSHIP GREEN CREEK

SECTION 6

T 4 N R 16 E

TYPE MONUMENT MAG NAIL SET



ON SURFACE - ~~BELOW~~ ON

LEFT - ℄ PAV'T - RIGHT _____

10.8' TO RT EDGE PAVEMENT

S.L.M. 29+18.71

GRID: NORTHING: _____ EASTING: _____

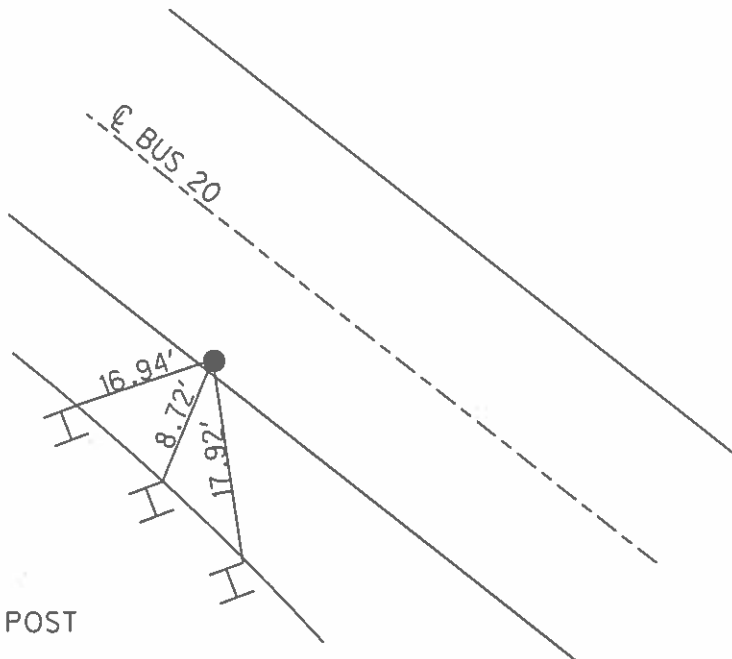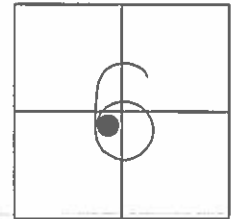

CUT NOTCH IN
STEEL G-RAIL POST