

O.D.O.T. DISTRICT 2 SURVEY OFFICE (USE ONLY)

PERSONNEL

REFERENCE NO. 1

SHEET 1 OF 22

NOTES HOMAN

DATE 8/12/09

ROUTE SR 300

H.C. HOMAN

WEATHER CLOUDY

COUNTY SANDUSKY

R.C. ROUSOS

TEMP. 75°

TOWNSHIP MADISON

SECTION 35

T 5 N R 13 E

TYPE MONUMENT SM.R.R.SPIKE


ON SURFACE - ~~BELOW~~ ON

~~LEFT~~ - Q PAV'T - RIGHT 1.0', (US 6=ON)

12.2' TO RT EDGE PAVEMENT


S.L.M. 0+00, (US 6= 265+66 REC)

Grid: Northing: _____ Easting: _____

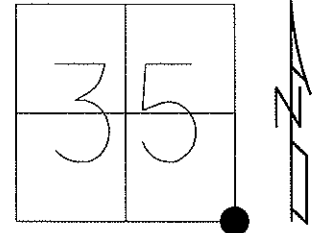

NOTE: 11/5/73
MADISON TWP. THIS POINT
WAS SET ON A PRIVATE SURVEY
IN THE SW'LY PORTION OF
SECTION 36. IT WAS SET ON A
STRAIGHT LINE FROM THE N.W.
COR. OF SEC.36 TO THE S.W. COR.
OF SEC.36, 2.43' TO THE WEST OF
SAID STRAIGHT LINE. FD P.K.NAIL
ATOP R.R.SPIKE.

0+00 FD P.K.NAIL ON SURFACE
TRON BOLT SHOULD BE BELOW.

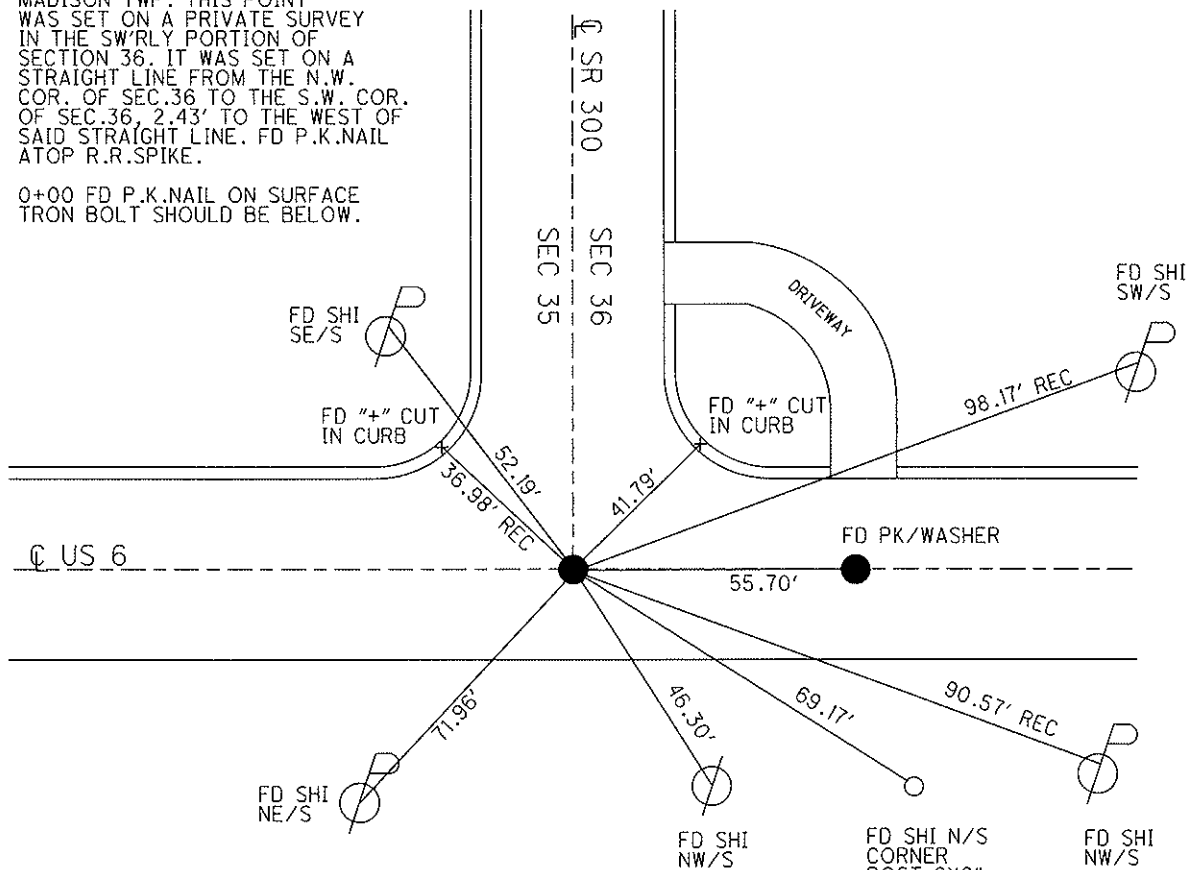

FD P.K./WASHER
4/16/93 MB

RESET SM.R.R.SPIKE
5/7/93 MB

FD SM.R.R.SPIKE
5/10/00, MAINTENANCE

O.D.O.T. DISTRICT 2 SURVEY OFFICE (USE ONLY)

PERSONNEL

REFERENCE NO.

1 A

SHEET

2

OF 22

NOTES

MILLER

DATE

9/3/24

ROUTE

SR 300

H.C.

MILLER

WEATHER

SUNNY

COUNTY

SANDUSKY

R.C.

BARRIERE

TEMP.

56°

TOWNSHIP

MADISON

SECTION

35

T 5 N R 13 E

TYPE MONUMENT

MAG/WASHER

ON SURFACE - ~~BELOW~~

ON

LEFT - ~~C PAV'T~~ - RIGHT

5.0'


4.2' TO LT EDGE PAVEMENT

S.L.M.

13+21

GRID: NORTHING: 612406.556

EASTING: 1743122.051

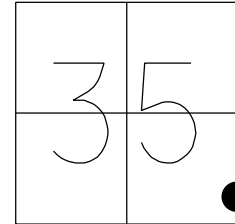

NOTE: POINT IS BELIEVED TO
BE 1.09' E. OF C. OF R/W. SEE
PREVIOUS REF. TIE
DATED 11/5/73

RE-SET P.K./WASHER
9/16/94, MC

FD P.K./WASHER
5/10/00 KPM


GPS AND TIED
1-7-11 JMH

SET MAG/WASHER
GPS, FINREF A1
6/3/13, SDC

FD MAG/WASHER
REF1A
9/3/24, JAM

FD MAG/WASHER
10/3/24, JAM


FD WHITE PLASTIC
FENCE POST.
NOTCH, 1' UP

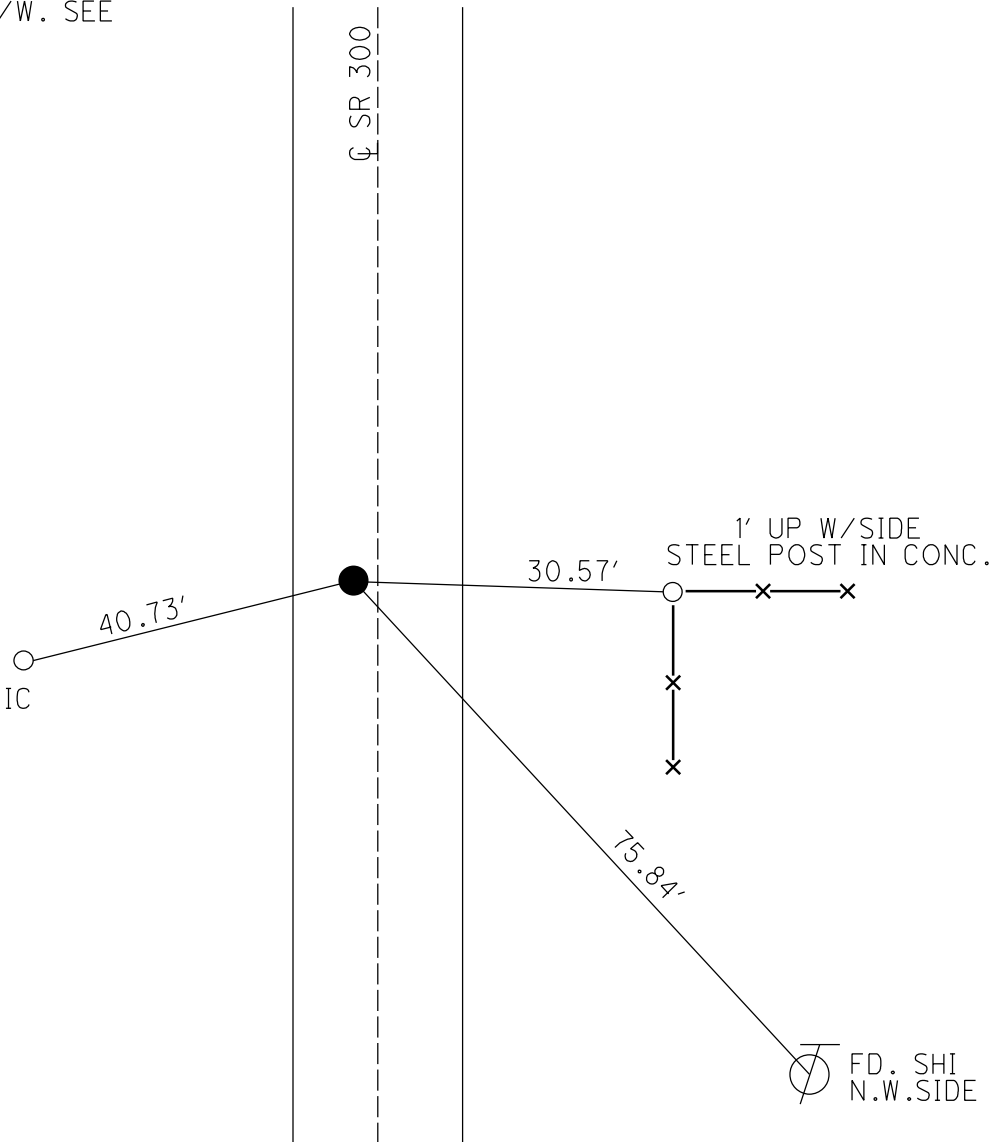

O.D.O.T. DISTRICT 2 SURVEY OFFICE (USE ONLY)

PERSONNEL	REFERENCE NO. <u>2</u>	SHEET <u>3</u> OF <u>22</u>
NOTES	DATE <u>9/3/24</u>	ROUTE <u>SR 300</u>
H.C. <u>MILLER</u>	WEATHER <u>SUNNY</u>	COUNTY <u>SANDUSKY</u>
R.C. <u>BARRIERE</u>	TEMP. <u>57°</u>	TOWNSHIP <u>MADISON</u>
		SECTION <u>35</u>
		T <u>5</u> N R <u>13</u> E

TYPE MONUMENT MAG/WASHER
 ON SURFACE - ~~BELOW~~ ON
 LEFT - ~~C PAV'T - RIGHT~~ 7.5'
2.5' TO LT EDGE PAVEMENT
 S.L.M. 26+41

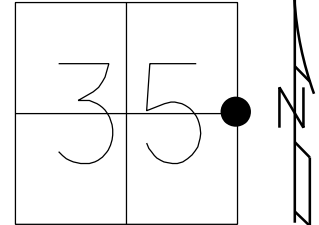

GRID: NORTHING: 613724.450 EASTING: 1743126.853

RECORD: 7/27/73
 WEST-1 POST SEC. 36 FD STONE
 WITH DRILL HOLE 19" BELOW
 SURFACE. 10X10X14" SANDSTONE
 SET 1" X 18" IRON PIPE ON
 TOP OF STONE TO SURFACE.

RESET P.K./WASHER
 9/16/94, MC

FD P.K./WASHER
 5/10/00 KPM

GPS & TIED
 1-7-11 JMH

SET MAG/WASHER
 GPS, FINREF2
 6/6/13, SDC

FD MAG/WASHER
 REF2
 9/3/24, JAM

FD MAG/WASHER UPRIGHT TRACK RAIL
 10/3/24, JAM FD. CHISEL MARK 2.6'
 UP FROM GROUND



20.68'

Q SR 300



57.58'



FD SHI W/SIDE
 30" TREE

23.80'



USED W/SIDE FACE
 M. BOX 1.5' UP
 RES #355

89.76'



FD SHI
 N/W SIDE

O.D.O.T. DISTRICT 2 SURVEY OFFICE (USE ONLY)

PERSONNEL

REFERENCE NO. 3

SHEET 4 OF 22

NOTES

MILLER

DATE

9/3/24

ROUTE

SR 300

H.C.

MILLER

WEATHER

SUNNY

COUNTY

SANDUSKY

R.C.

BARRIERE

TEMP.

57°

TOWNSHIP

MADISON

SECTION

25

T 5 N R 13 E

TYPE MONUMENT MAG/WASHER


ON SURFACE - ~~BELOW~~ ON

~~LEFT~~ - Q PAV'T - ~~RIGHT~~ ON

- TO - EDGE PAVEMENT

S.L.M. 52+93 1.0' SOUTH OF Q T.R.55

GRID: NORTHING: 616370.533 EASTING: 1743143.846

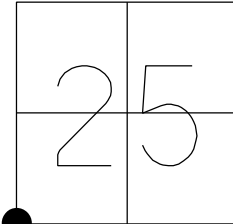

RESET P.K./WASHER
9/16/94, MC


FD P.K./WASHER
5/10/00 KPM

GPS & TIED
1-7-11 JMH

SET MAG/WASHER
GPS, FINREF3
6/3/13, SDC

FD MAG/WASHER
REF3
9/3/24, JAM

FD MAG/WASHER
10/3/24, JAM

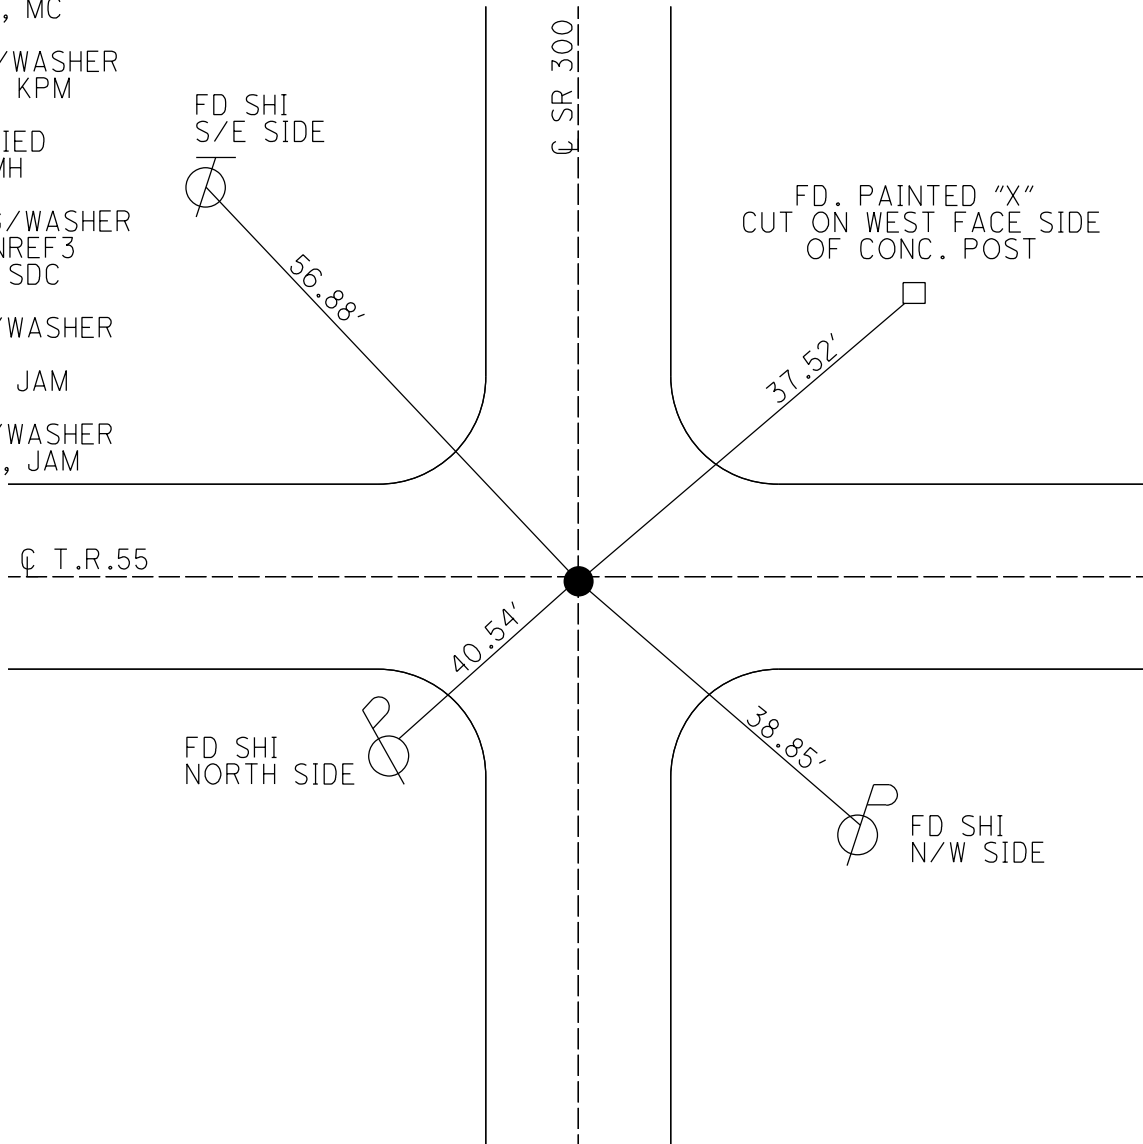

O.D.O.T. DISTRICT 2 SURVEY OFFICE (USE ONLY)

PERSONNEL

REFERENCE NO. 4

SHEET 5 OF 22

NOTES RHOADES

DATE 4/16/13

ROUTE SR 300

H.C. CODER

WEATHER RAIN

COUNTY SANDUSKY

R.C. RHOADES

TEMP. 51°

TOWNSHIP MADISON

SECTION 25

T 5 N R 13 E

TYPE MONUMENT P.K./WASHER


ON SURFACE - ~~BELOW~~ ON

~~LEFT - C PAV'T~~ - RIGHT 3.1'

7.3' TO RT EDGE PAVEMENT

S.L.M. 79+35

Grid: Northing: 619005.703 Easting: 1743196.328

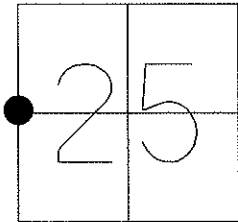


RESET P.K./WASHER
9/16/94, MC

FD P.K./WASHER
5/10/00 KPM

GPS & TIED
1-7-11 JMH

SET MAG/WASHER
GPS, FINREF4
6/4/13, SDC

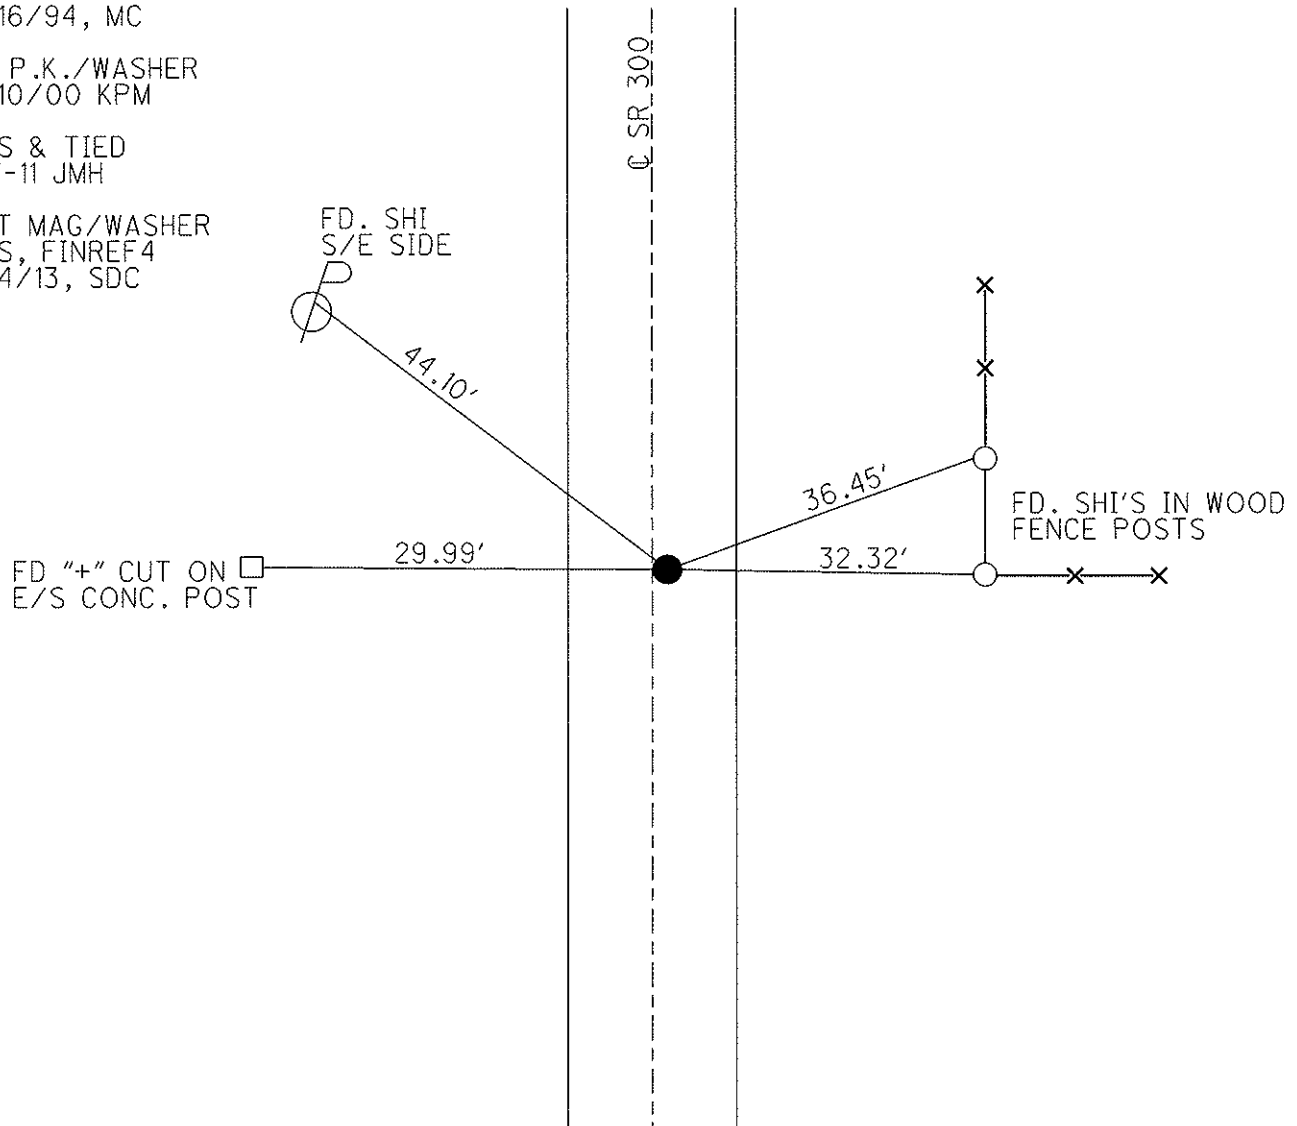

O.D.O.T. DISTRICT 2 SURVEY OFFICE (USE ONLY)

PERSONNEL

REFERENCE NO. 5

SHEET 6 OF 22

NOTES RHOADES

DATE 4/16/13

ROUTE SR 300

H.C. CODER

WEATHER RAIN

COUNTY SANDUSKY

R.C. RHOADES

TEMP. 51°

TOWNSHIP MADISON

SECTION 25

T 5 N R 13 E

TYPE MONUMENT PK/WASHER



ON SURFACE - BELOW ON

LEFT - C PAV'T - RIGHT 2.4'

- TO - EDGE PAVEMENT

S.L.M. 106+07.24

Grid: Northing: 621645.757 Easting: 1743248.120

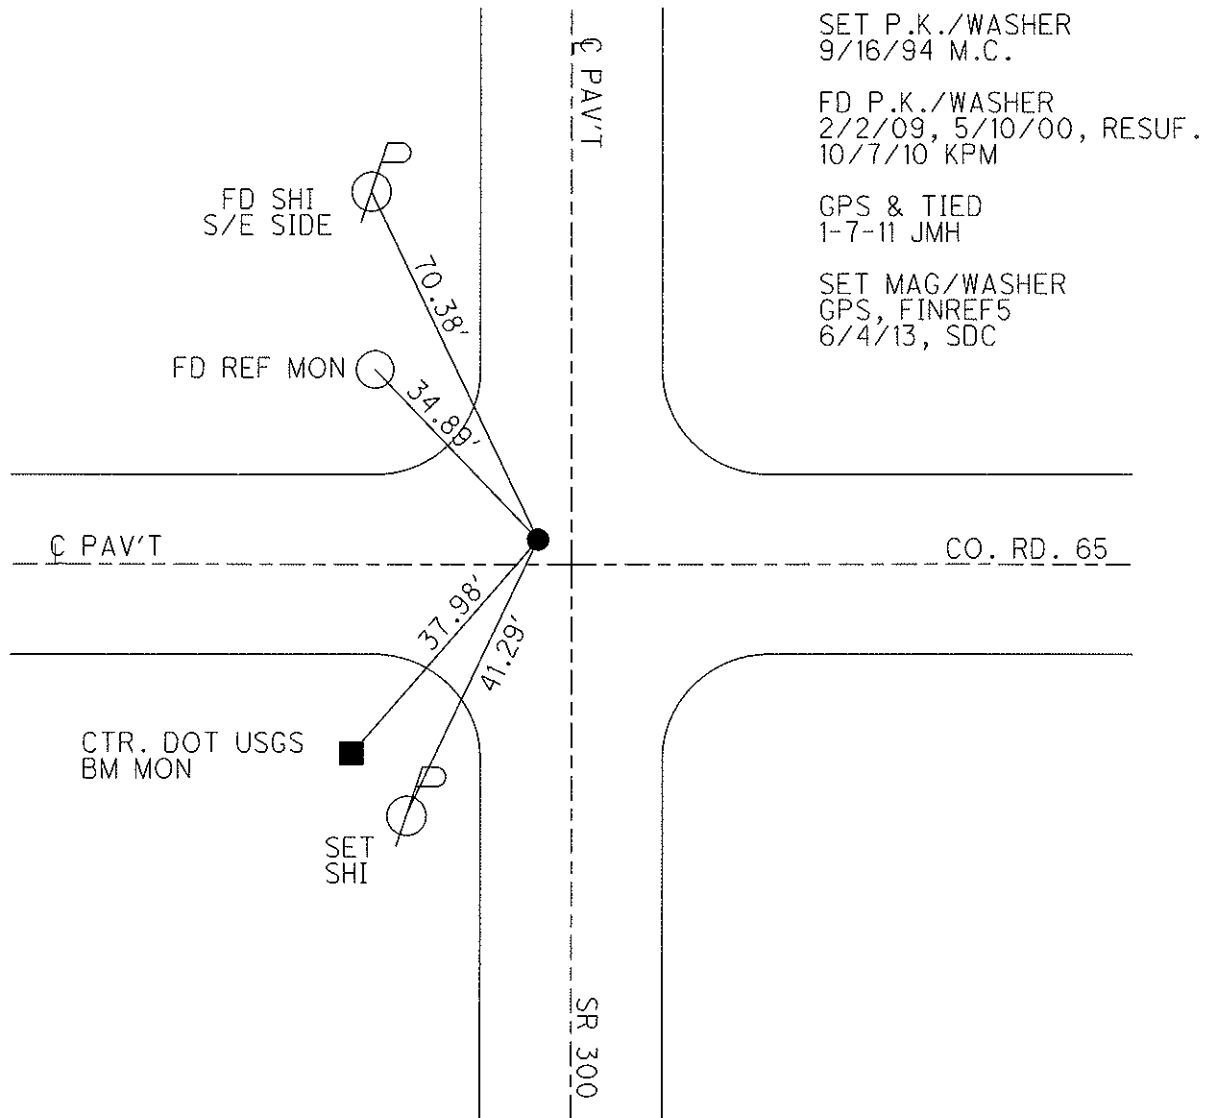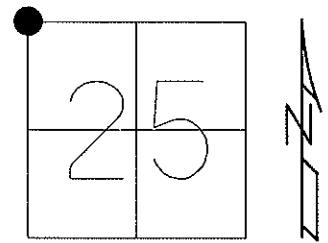

O.D.O.T. DISTRICT 2 SURVEY OFFICE (USE ONLY)

PERSONNEL

REFERENCE NO. 5 A

SHEET 7 OF 22

NOTES RHOADES

DATE 4/16/13

ROUTE SR 300

H.C. CODER

WEATHER RAIN

COUNTY SANDUSKY

R.C. RHOADES

TEMP. 51°

TOWNSHIP MADISON

SECTION 23

T 5 N R 13 E

TYPE MONUMENT FD P.K./WASHER


~~ON SURFACE~~ - BELOW 2.5"

~~LEFT~~ - Q PAV'T - ~~RIGHT~~ ON

10.2 TO LT EDGE PAVEMENT

S.L.M. 115+41

Grid: Northing: 622603.748 Easting: 1743290.752

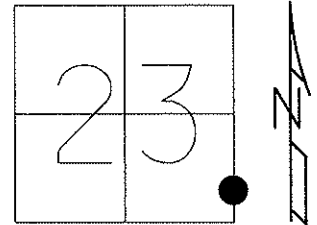


SET NAIL/SHI
9/16/94 M.C.

FD P.K./WASHER
2/3/09, 5/10/00, RESUF.
10/7/10 KPM

GPS & TIED
3/2/11 KPM

SET MAG/WASHER
GPS, FINREF A5
6/4/13, SDC

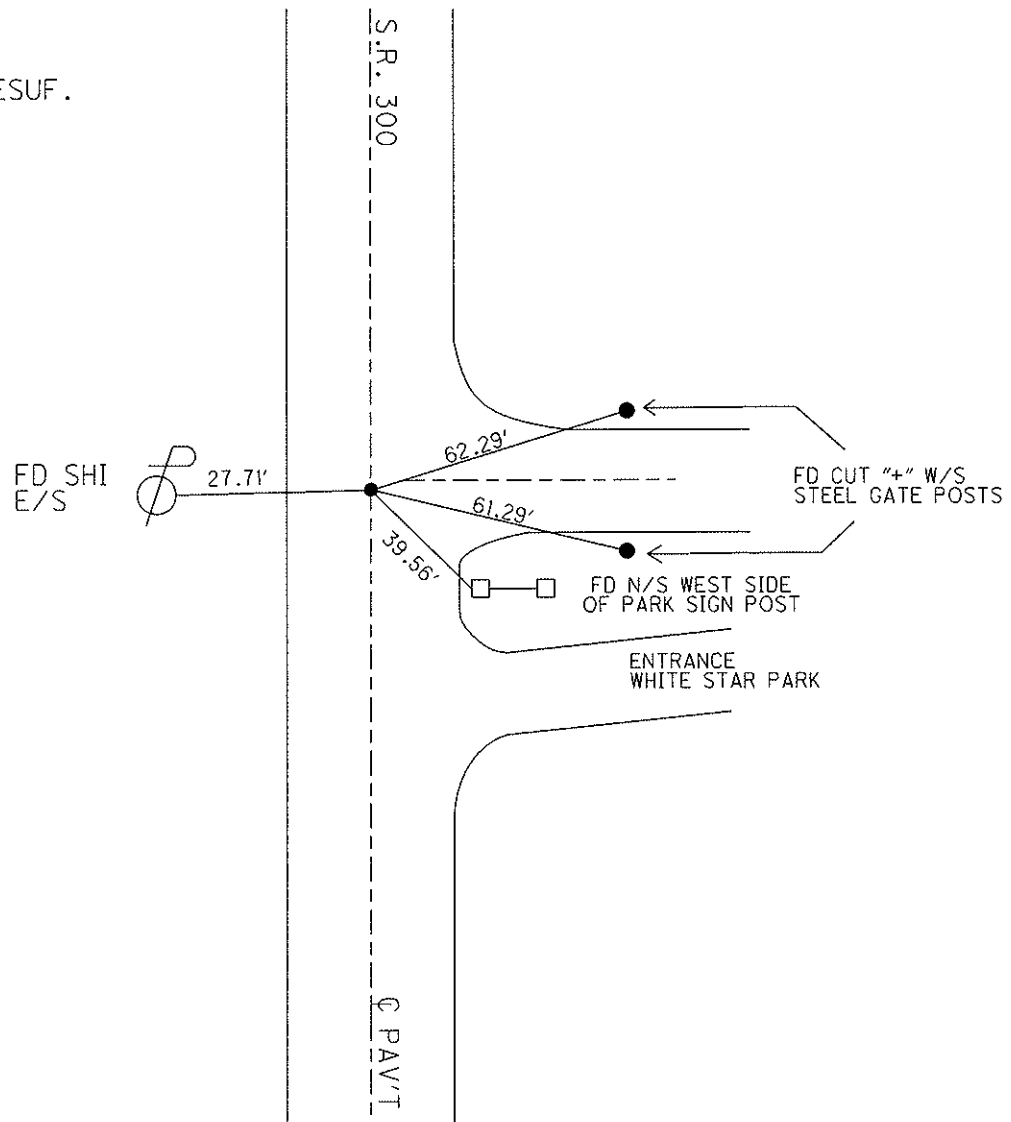


O.D.O.T. DISTRICT 2 SURVEY OFFICE (USE ONLY)

PERSONNEL _____ REFERENCE NO. 5 B SHEET 8 OF 22

NOTES RHOADES _____ DATE 7/20/17 ROUTE SR 300
H.C. O'DONNELL _____ WEATHER SUNNY COUNTY SANDUSKY
R.C. POORE _____ TEMP. 78° TOWNSHIP MADISON


SECTION 23
T 5 N R 13 E

TYPE MONUMENT MAG/WASHER
ON SURFACE - ~~BELOW~~ ON _____
LEFT - ℄ PAV'T - ~~RIGHT~~ 0.6'
10.3 TO RT EDGE PAVEMENT
S.L.M. 124+84.10

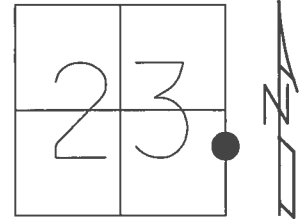

GRID: NORTHING: 623520.572 EASTING: 1743331.545

RECORD:
SET P.K.NAIL
9/16/94, M.C.
FD P.K.NAIL
5/10/00, 2/2/09
FD P.K.NAIL
5/19/10 KPM
SET MAG/WASHER
10/07/10 KPM
FD MAG/WASHER
REFB5
7/20/17, JFO
UNCOVERED
11/15/17, JFO


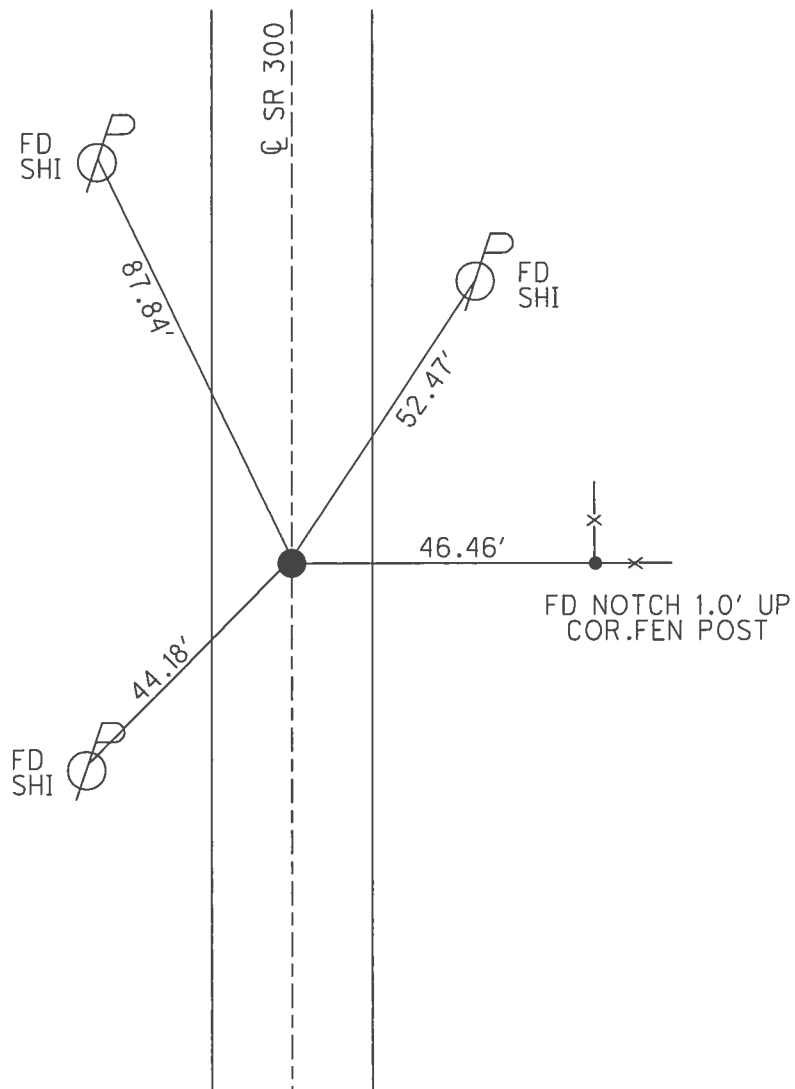


O.D.O.T. DISTRICT 2 SURVEY OFFICE (USE ONLY)

PERSONNEL	REFERENCE NO.	<u>6</u>	SHEET	<u>9</u>	OF	<u>22</u>
NOTES	RHOADES	DATE	<u>7/20/17</u>	ROUTE	<u>SR 300</u>	
H.C.	O'DONNELL	WEATHER	<u>SUNNY</u>	COUNTY	<u>SANDUSKY</u>	
R.C.	POORE	TEMP.	<u>78°</u>	TOWNSHIP	<u>MADISON</u>	
				SECTION	<u>23</u>	
				T	<u>5</u>	N
				R	<u>13</u>	E

TYPE MONUMENT MAG/WASHER
 ON SURFACE - ~~BELOW~~ ON
 LEFT - ℄ PAV'T - RIGHT ON
10.2 TO LT EDGE PAVEMENT
 S.L.M. 132+46.87


GRID: NORTHING: 624282.715 EASTING: 1743365.473

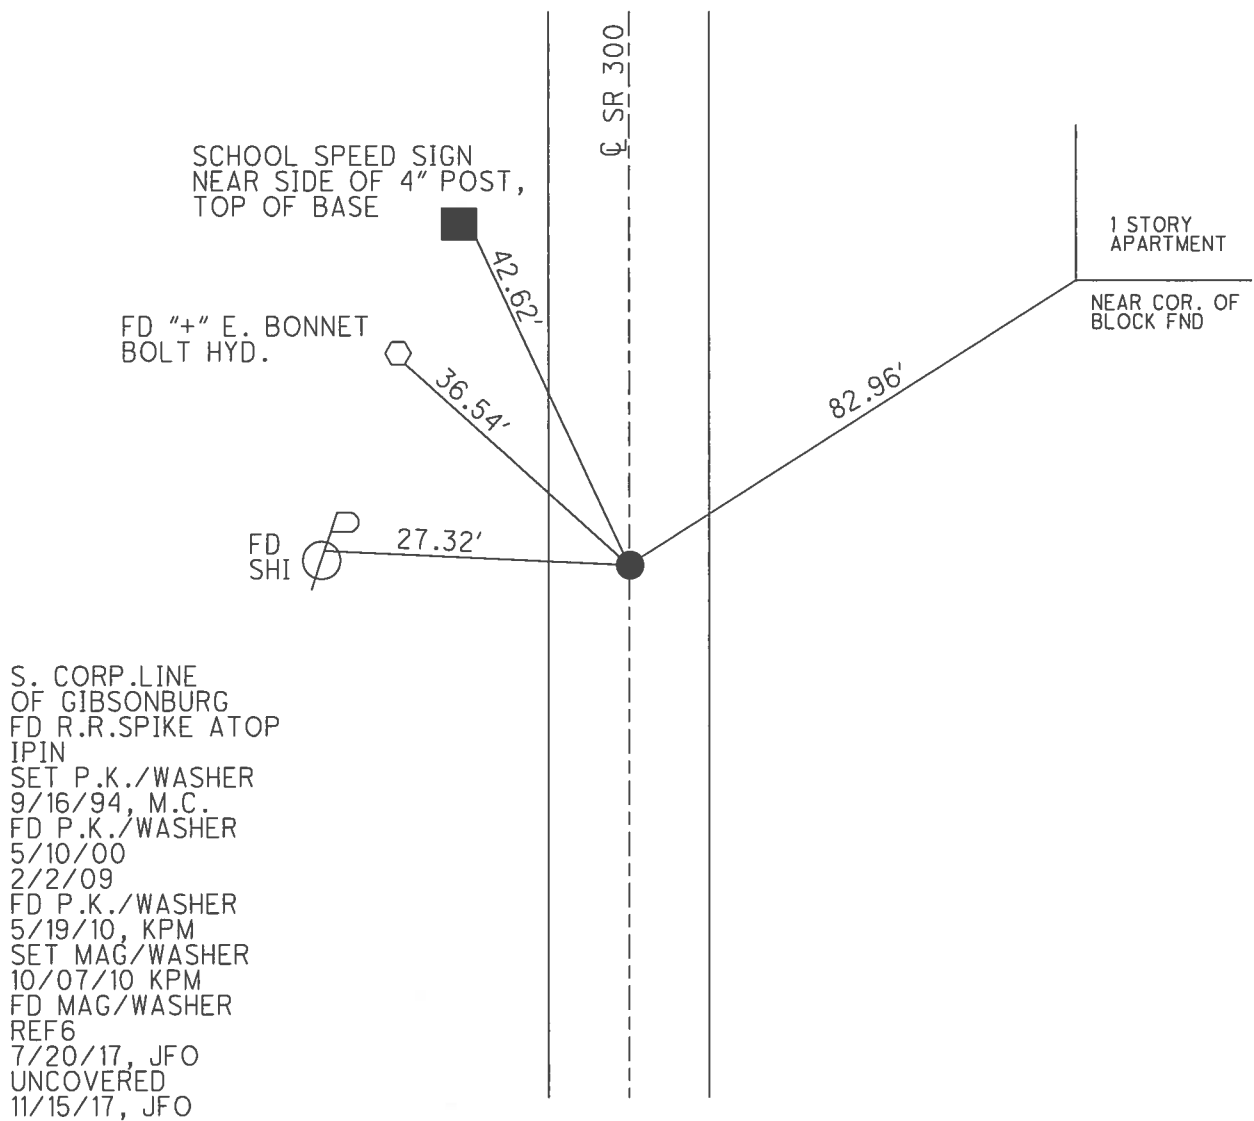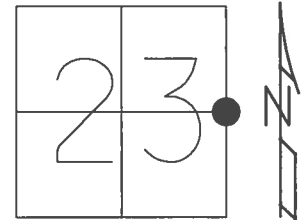

O.D.O.T. DISTRICT 2 SURVEY OFFICE (USE ONLY)

PERSONNEL	REFERENCE NO. <u>7</u>	SHEET <u>10</u> OF <u>22</u>
NOTES	DATE <u>7/20/17</u>	ROUTE <u>SR 300</u>
H.C. <u>RHOADES</u>	WEATHER <u>SUNNY</u>	COUNTY <u>SANDUSKY</u>
R.C. <u>POORE</u>	TEMP. <u>78°</u>	TOWNSHIP <u>MADISON</u>
		SECTION <u>23</u>
		T <u>5</u> N R <u>13</u> E


TYPE MONUMENT MAG/WASHER
 ON SURFACE - ~~BELOW~~ ON _____
 LEFT - CL PAV'T - RIGHT ON _____
10.2 TO LT EDGE PAVEMENT
 S.L.M. 158+92.8

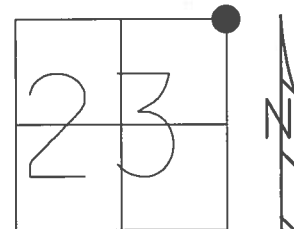

GRID: NORTHING: 626926.206 EASTING: 1743480.517

NOTE:
REF 13 SR 600

RECORD:
 SET P.K./WASHER
 9/16/94 M.C.
 FD P.K./WASHER
 5/10/00
 2/2/09
 FD P.K./WASHER
 5/19/10, KPM
 SET MAG/WASHER
 10/07/10, KPM
 FD MAG/WASHER
 REF7
 7/20/17, JFO

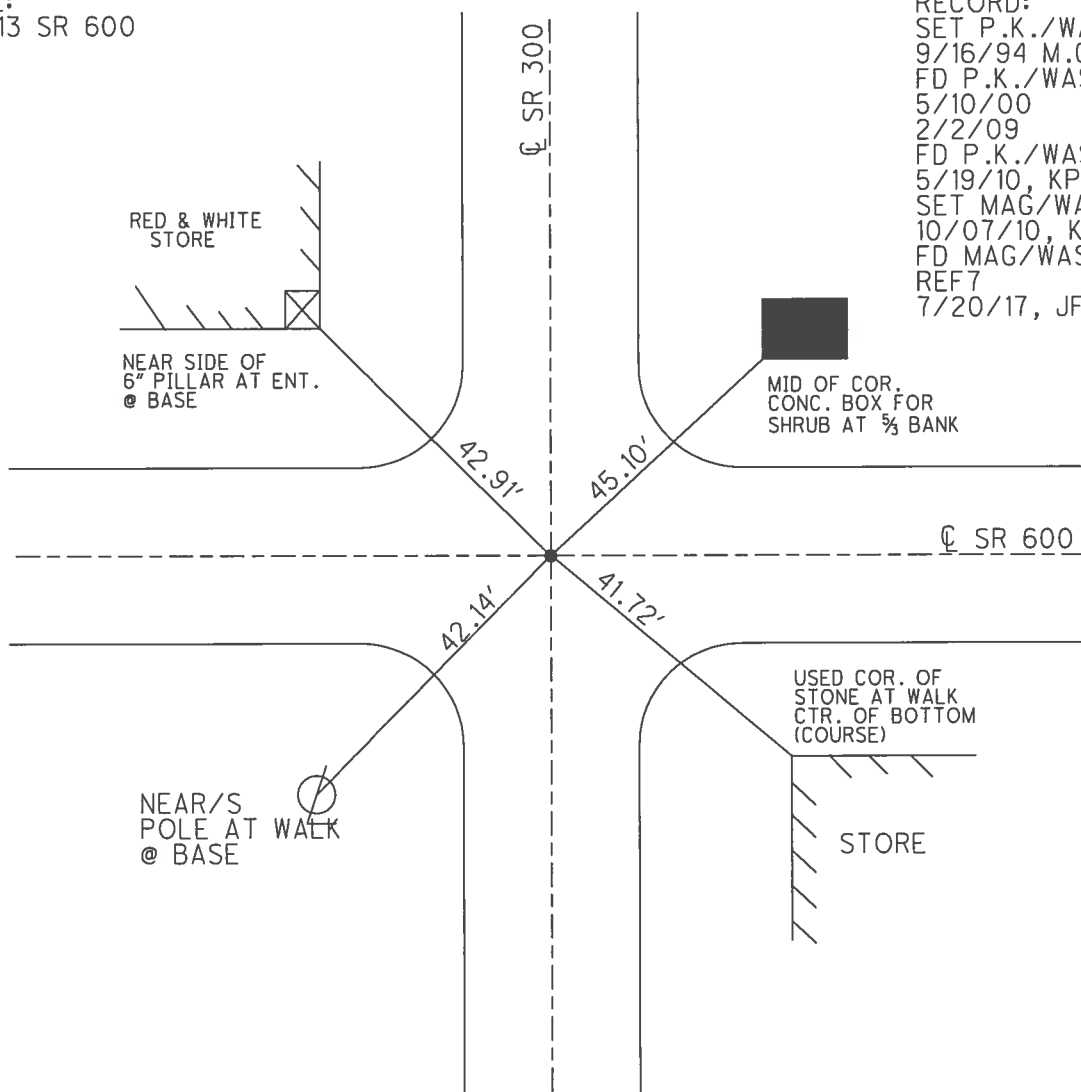

O.D.O.T. DISTRICT 2 SURVEY OFFICE (USE ONLY)

PERSONNEL

REFERENCE NO. 8

SHEET 11 OF 22

NOTES RHOADES DATE 7/20/22
H.C. RHOADES WEATHER WINDY
R.C. WHITAKER TEMP. 86°

ROUTE SR 300
COUNTY SANDUSKY
TOWNSHIP MADISON
SECTION 14
T 5 N R 13 E

DWG BY WHITAKER PID PVTRN

TYPE MONUMENT MAG/WASHER

ON SURFACE - BELOW ON

OFFSET Q PAVEMENT ON LT : RT

11.5' TO LT EDGE PAVEMENT


STATION: 185+20.73

HORZ.DATUM: NAD83 (2011)

GEOID: 2012A

GRID: NORTHING: 629552.565

EASTING: 1743566.538

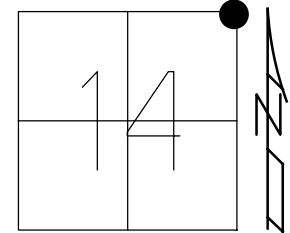

RECORD:
FD IPIPE
3" DOWN
END OF BRICK SEC.
1973
SET P.K./WASHER
9/16/94, M.C.
FD P.K./WASHER
5/10/00
2/2/09
FD P.K./WASHER
5/19/10, KPM
SET MAG/WASHER
10/07/10, KPM
FD MAG/WASHER
REF8
7/20/17, JFO
11/15/17, JFO
FD MAG/WASHER
REF8
4/22/21, DSA
SET MAG/WASHER
REF8
7/20/22, JMR

FD SHI
18" PINE
DEAD

DIST. 8-8AA = 19.36'

CEDAR ST.

FD SHI
GR.POST

Q SR 300

8AA

FD
SHI

26.76'

FD
SHI

20.09'

43.45'

46.96'

O.D.O.T. DISTRICT 2 SURVEY OFFICE (USE ONLY)

PERSONNEL

REFERENCE NO. 8 AA

SHEET 12 OF 22

NOTES NIESE

DATE 4/22/21

ROUTE SR 300

H.C. AUBLE

WEATHER SUNNY

COUNTY SANDUSKY

R.C. NIESE

TEMP. 37°

TOWNSHIP MADISON

SECTION 14

DWG BY NIESE

PID CHIP SEAL

T 5 N R 13 E

TYPE MONUMENT MAG/WASHER

ON SURFACE - ~~BELOW~~ ON

OFFSET Q PAVEMENT ON LT : RT
10.7' TO LT EDGE PAVEMENT


STATION: 185+40.03

HORIZ.DATUM: NAD83(2011)


GEOID: 2018

GRID: NORTHING: 629571.890

EASTING: 1743567.629

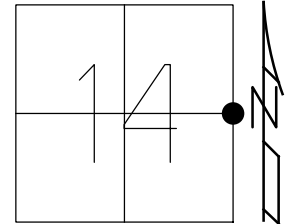

RECORD: 1973
N.CORP LINE
GIBBSONBURG
FD R.R.SPIKE ATOP
IPIN BELOW
SET P.K./WASHER
9/16/94, M.C.
FD P.K./WASHER
5/10/00
2/2/09
FD P.K./WASHER
5/19/10, KPM
SET MAG/WASHER
10/07/10, KPM
FD MAG/WASHER
REFAA8
7/20/17,
11/15/17, JFO
FD MAG/WASHER
REFAA8
4/22/21, DSA
10/6/21, JFO

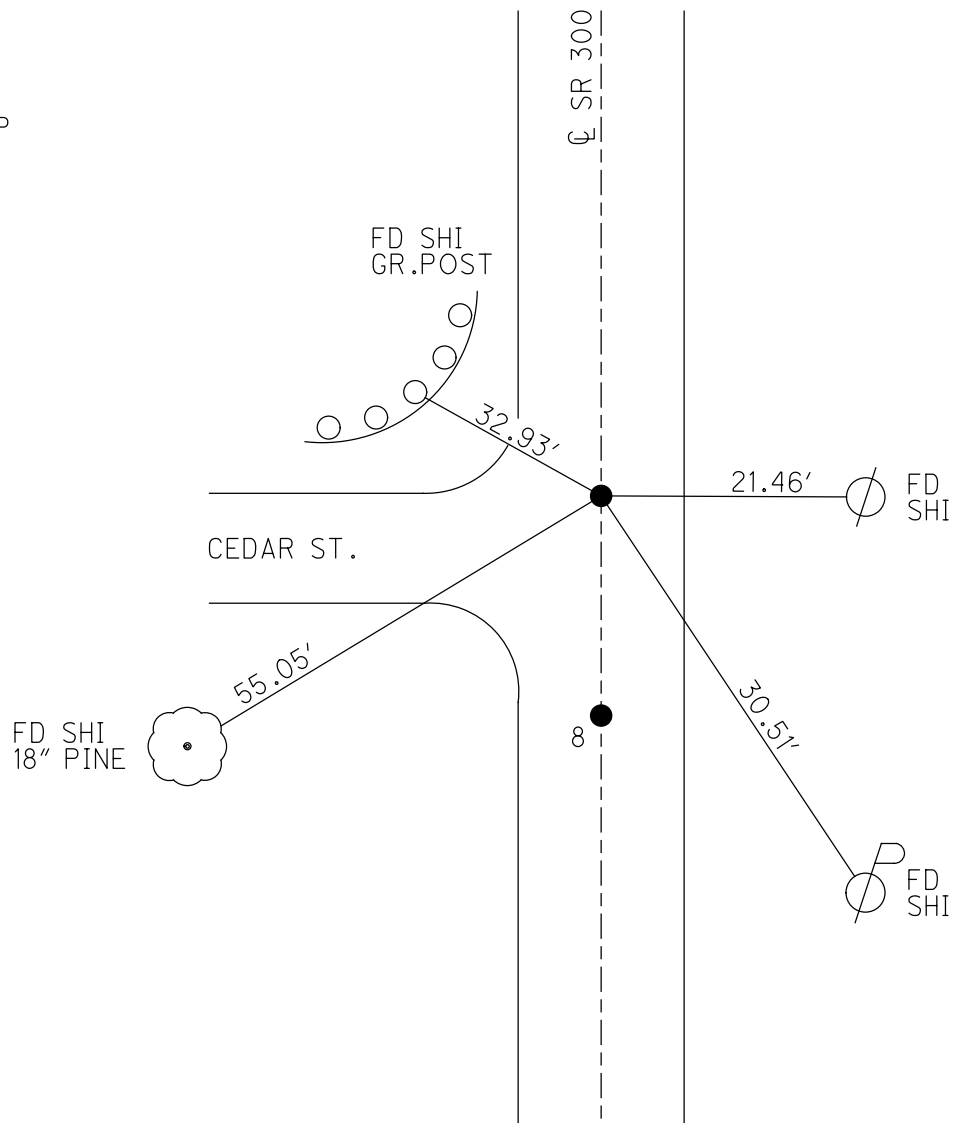

O.D.O.T. DISTRICT 2 SURVEY OFFICE (USE ONLY)

PERSONNEL

REFERENCE NO. 8 AC

SHEET 13 OF 22

NOTES NIESE

DATE 4/22/21

ROUTE SR 300

H.C. AUBLE

WEATHER SUNNY

COUNTY SANDUSKY

R.C. NIESE

TEMP. 37°

TOWNSHIP MADISON

SECTION 14

DWG BY NIESE PID CHIP SEAL

T 5 N R 13 E

TYPE MONUMENT MAG/WASHER

ON SURFACE - ~~BELOW~~ ON

OFFSET Q PAVEMENT ON LT : RT

11.5' TO LT EDGE PAVEMENT


STATION: 189+91.50

HORZ.DATUM: NAD83(2011)

GEOID: 2018

GRID: NORTHING: 630010.329

EASTING: 1743582.075

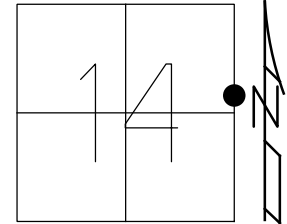

RECORD:
SET P.K./WASHER
9/16/94, M.C.
FD P.K./WASHER
2/2/09
5/10/00
5/19/10, KPM
3/2/11, KPM
FD P.K. NAIL
4/16/13, SDC
SET MAG/WASHER
6/4/13, SDC
FD MAG/WASHER
REFAC8
4/22/21, DSA
10/6/21, JFO

FD
SHI

81.34'

8A

75.93'

FD
SHI

83.95'

FD
SHI

Q TR 79

51.21'

SET MAG
2.0' OFF EPS

DIST. 8AC-8A = 14.11'

Q SR 300

O.D.O.T. DISTRICT 2 SURVEY OFFICE (USE ONLY)

PERSONNEL

REFERENCE NO. 8 A

SHEET 14 OF 22

NOTES NIESE

DATE 4/22/21

ROUTE SR 300

H.C. AUBLE

WEATHER SUNNY

COUNTY SANDUSKY

R.C. NIESE

TEMP. 37°

TOWNSHIP MADISON

DWG BY NIESE

PID CHIP SEAL

T 5 N R 13 E

TYPE MONUMENT MAG/WASHER

ON SURFACE - ~~BELOW~~ ON

OFFSET Q PAVEMENT ON LT : RT

11.5' TO LT EDGE PAVEMENT


STATION: 190+05.61

HORIZ.DATUM: NAD83(2011)


GEOID: 2018

GRID: NORTHING: 630024.376

EASTING: 1743582.626

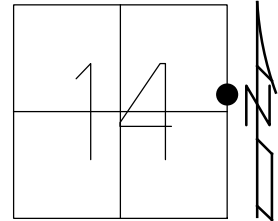

RECORD:
SET P.K./WASHER
9/16/94, M.C.
FD P.K./WASHER
2/2/09
5/10/00
5/19/10, KPM
3/2/11, KPM
FD P.K. NAIL
4/16/13, SDC
SET MAG/WASHER
6/4/13, SDC
FD MAG/WASHER
REFA8
4/22/21, DSA
10/6/21, JFO

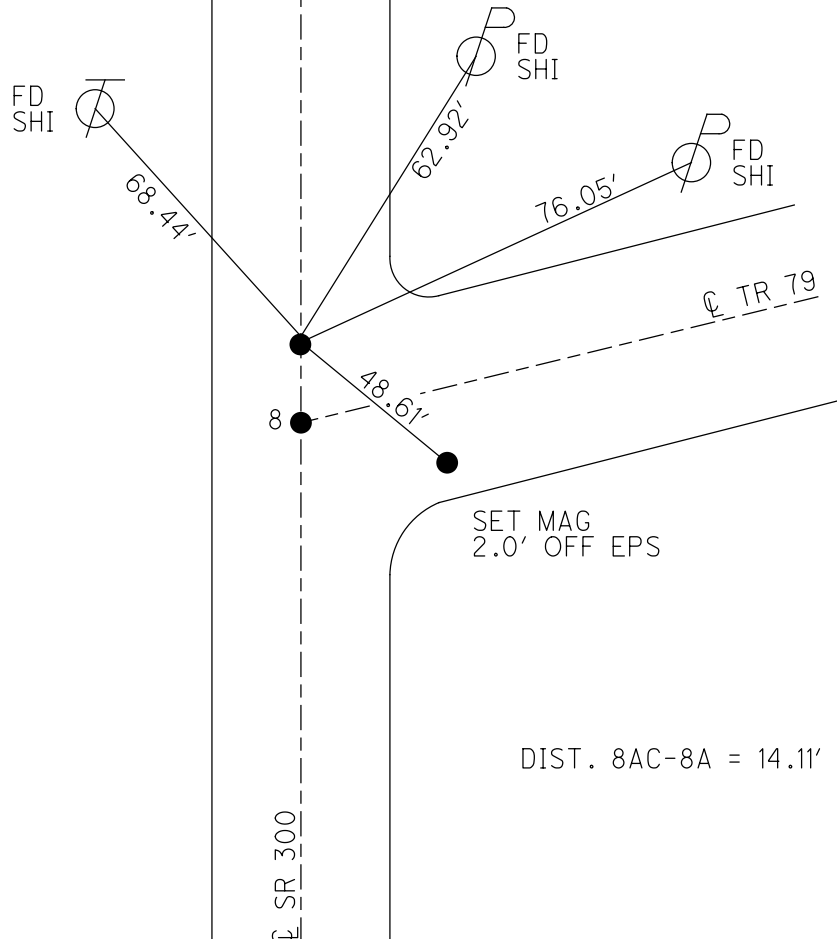

DIST. 8AC-8A = 14.11'

O.D.O.T. DISTRICT 2 SURVEY OFFICE (USE ONLY)

PERSONNEL

REFERENCE NO. 8 B

SHEET 15 OF 22

NOTES NIESE

DATE 4/22/21

ROUTE SR 300

H.C. AUBLE

WEATHER SUNNY

COUNTY SANDUSKY

R.C. NIESE

TEMP. 37°

TOWNSHIP MADISON

SECTION 14

DWG BY NIESE

PID CHIP SEAL

T 5 N R 13 E

TYPE MONUMENT MAG/WASHER

ON SURFACE - ~~BELOW~~ ON

OFFSET Q PAVEMENT 1.2' LT : ~~RT~~

9.7' TO LT EDGE PAVEMENT


STATION: 197+75

HORIZ.DATUM: NAD83(2011)


GEOID: 2018

GRID: NORTHING: 630805.650

EASTING: 1743608.632

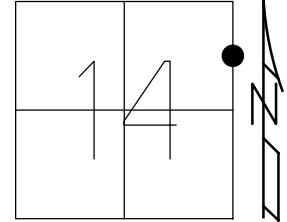

RECORD:
SET P.K./WASHER
9/16/94 CAL
FD P.K./WASHER
5/10/00, KPM
3/2/11, KPM
4/16/13, SDC
SET MAG/WASHER
6/4/13, SDC
FD MAG/WASHER
REFB8
4/22/21, DSA
10/6/21, JFO

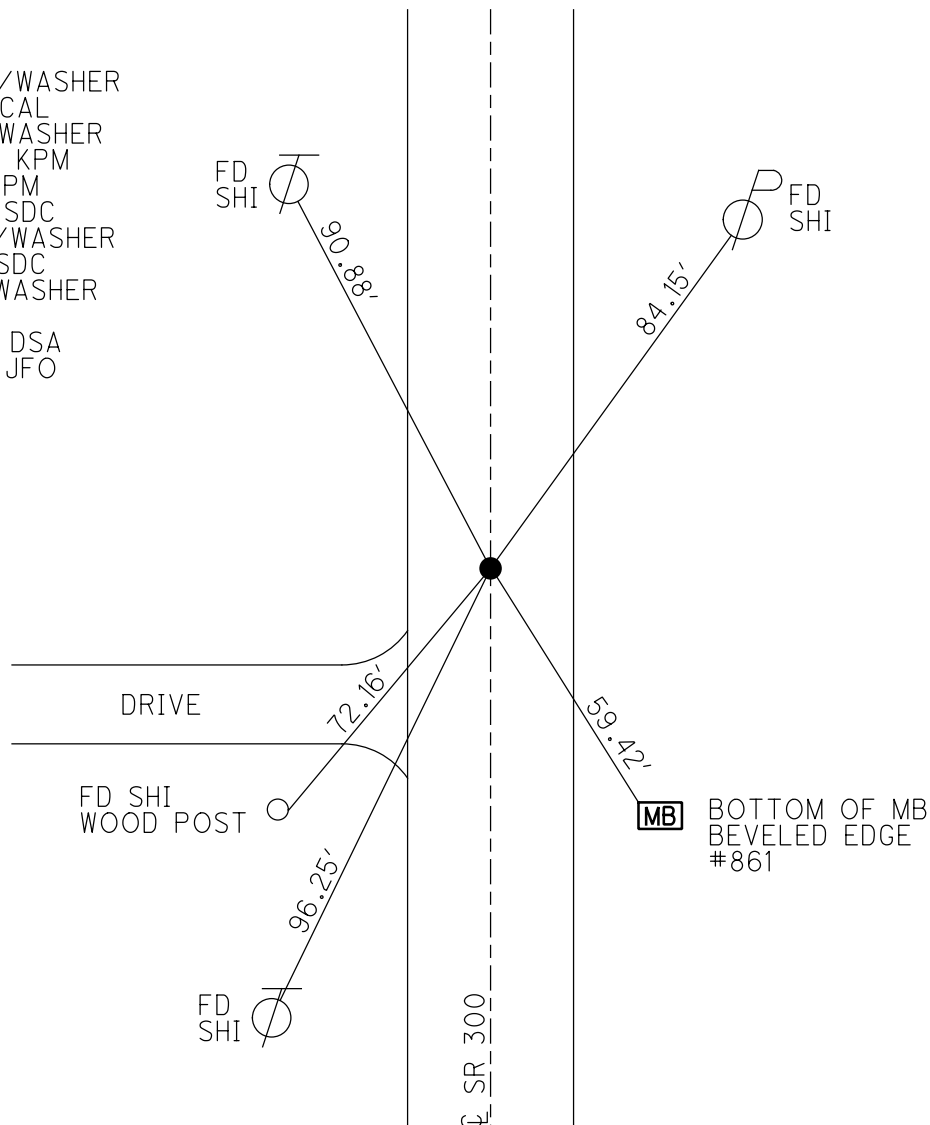

O.D.O.T. DISTRICT 2 SURVEY OFFICE (USE ONLY)

PERSONNEL

REFERENCE NO. 9

SHEET 16 OF 22

NOTES NIESE

DATE 4/22/21

ROUTE SR 300

H.C. AUBLE

WEATHER CLOUDY/WINDY

COUNTY SANDUSKY

R.C. NIESE

TEMP. 37°

TOWNSHIP MADISON

SECTION 11

DWG BY NIESE PID CHIP SEAL

T 5 N R 13 E

TYPE MONUMENT MAG/WASHER

ON SURFACE - ~~BELOW~~ ON

OFFSET CL PAVEMENT 1.7' LT : ~~RT~~

- TO - EDGE PAVEMENT


STATION: 211+91

HORIZ.DATUM: NAD83(2011)


GEOID: 2018

GRID: NORTHING: 632218.440

EASTING: 1743655.404

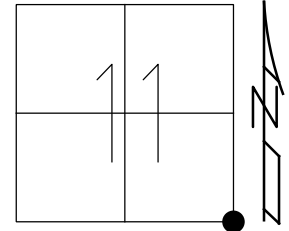

RECORD:
SET P.K./WASHER
9/16/94, CAL
FD P.K./WASHER
5/10/00
3/2/11, KPM
4/16/13, SDC
SET MAG/WASHER
6/4/13, SDC
FD MAG/WASHER
REF9
4/22/21, DSA
10/6/21, JFO

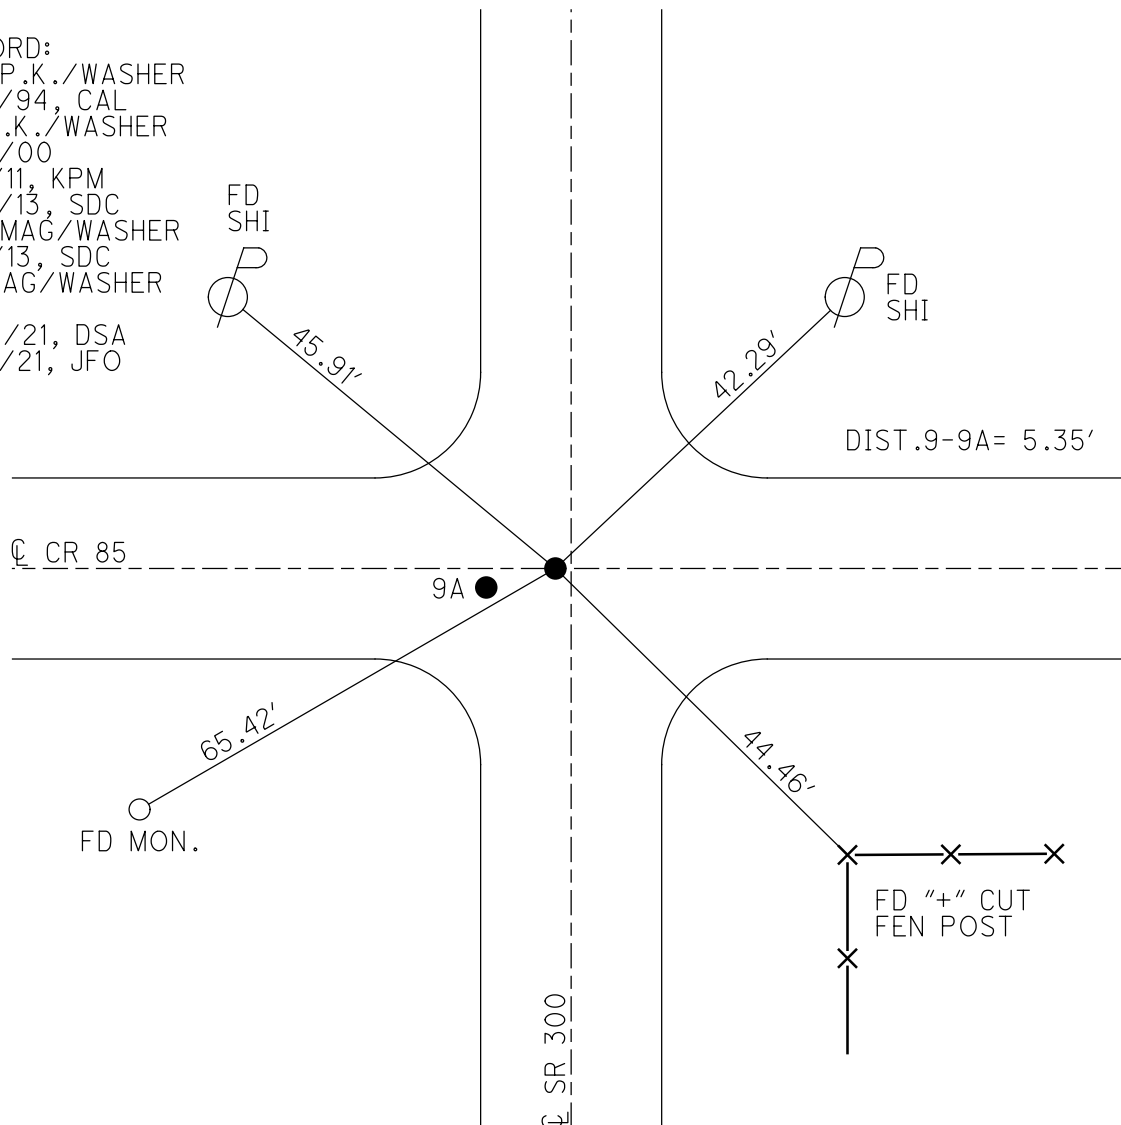

O.D.O.T. DISTRICT 2 SURVEY OFFICE (USE ONLY)

PERSONNEL

REFERENCE NO. 9 A

SHEET 17 OF 22

NOTES NIESE

DATE 4/22/21

ROUTE SR 300

H.C. AUBLE

WEATHER CLOUDY/WINDY

COUNTY SANDUSKY

R.C. NIESE

TEMP. 37°

TOWNSHIP MADISON

SECTION 11

DWG BY NIESE PID CHIP SEAL

T 5 N R 13 E

TYPE MONUMENT MAG/WASHER

ON SURFACE - ~~BELOW~~ ON

OFFSET CL PAVEMENT 7.0' LT : ~~RT~~

- TO - EDGE PAVEMENT


STATION: 211+93.35

HORIZ.DATUM: NAD83(2011)


GEOID: 2018

GRID: NORTHING: 632217.592

EASTING: 1743650.128

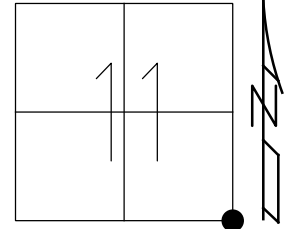

RECORD:
FD P.K./WASHER
5/10/00
3/2/11, KPM
FD P.K./WASHER
4/16/13, SDC
SET MAG/WASHER
6/4/13, SDC
FD MAG/WASHER
REFA9
4/22/21, DSA
10/6/21, JFO

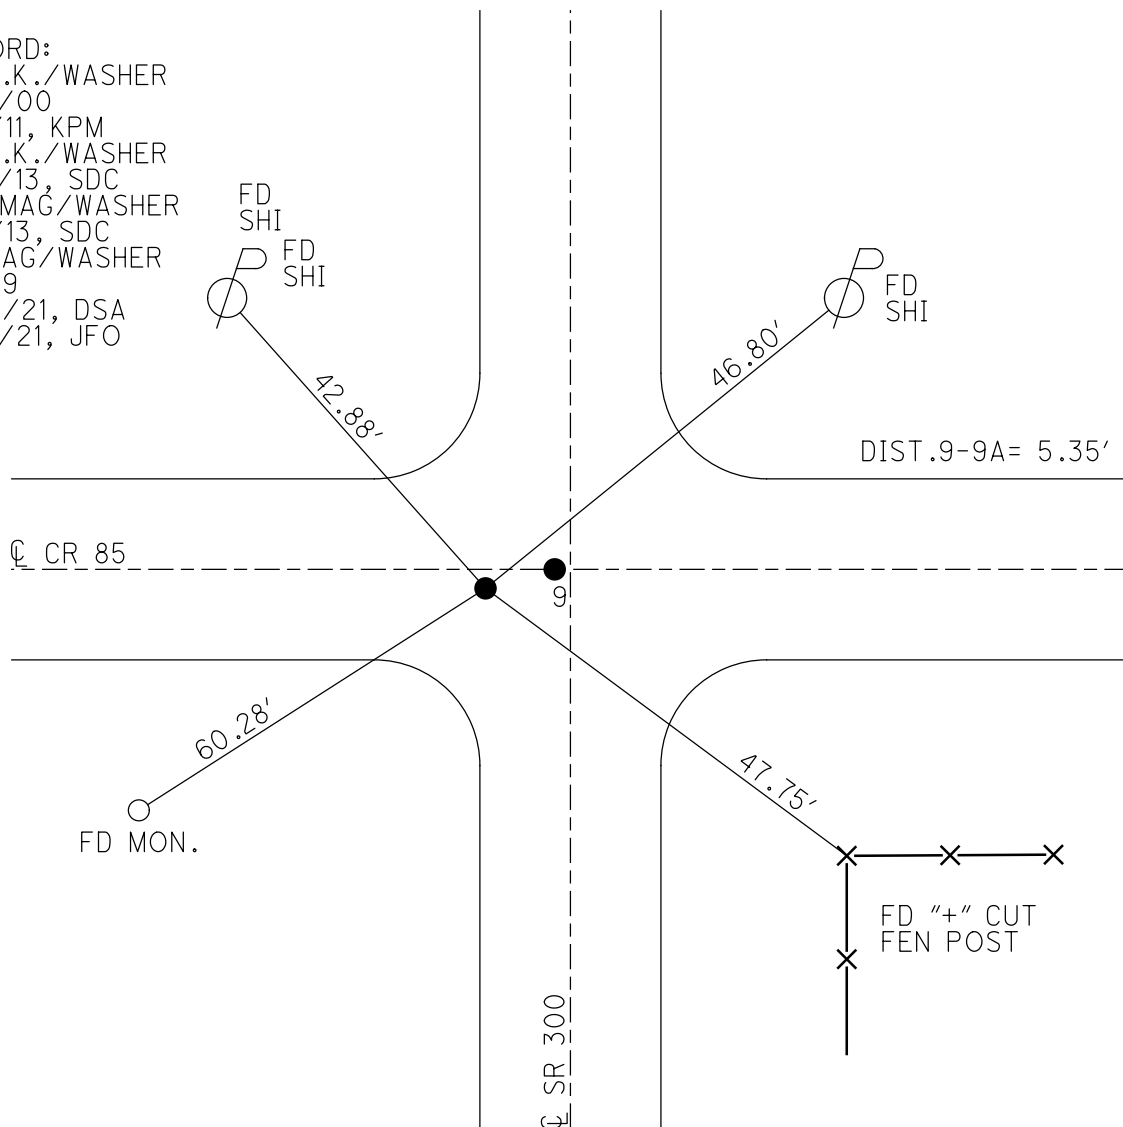

O.D.O.T. DISTRICT 2 SURVEY OFFICE (USE ONLY)

PERSONNEL

REFERENCE NO. 10

SHEET 18 OF 22

NOTES NIESE

DATE 4/22/21

ROUTE SR 300

H.C. AUBLE

WEATHER CLOUDY/WINDY

COUNTY SANDUSKY

R.C. NIESE

TEMP. 42°

TOWNSHIP WOODVILLE

SECTION 11

DWG BY NIESE PID CHIP SEAL

T 5 N R 13 E

TYPE MONUMENT MAG/WASHER

ON SURFACE - ~~BELOW~~ ON

OFFSET Q PAVEMENT 7.3' LT : ~~RT~~

3.8' TO LT EDGE PAVEMENT


STATION: 238+37.5

HORZ.DATUM: NAD83(2011)

GEOID: 2018

GRID: NORTHING: 634857.014


EASTING: 1743734.402

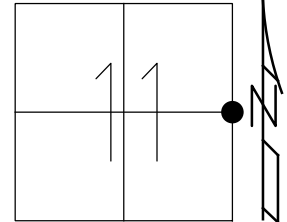

RECORD:
W 1/4 POST SEC. 12
E 1/4 POST SEC. 11
FD STONE 23 " BELOW
SET 1" X 23' IPIPE
OVER STONE
1973 / 1984
FD P.K./WASHER
5/10/00
3/2/11, KPM
4/16/13, SDC
SET MAG/WASHER
6/4/13, SDC
FD MAG/WASHER
REF10
4/22/21, DSA
10/6/21, JFO

WOODVILLE TWP

MADISON TWP

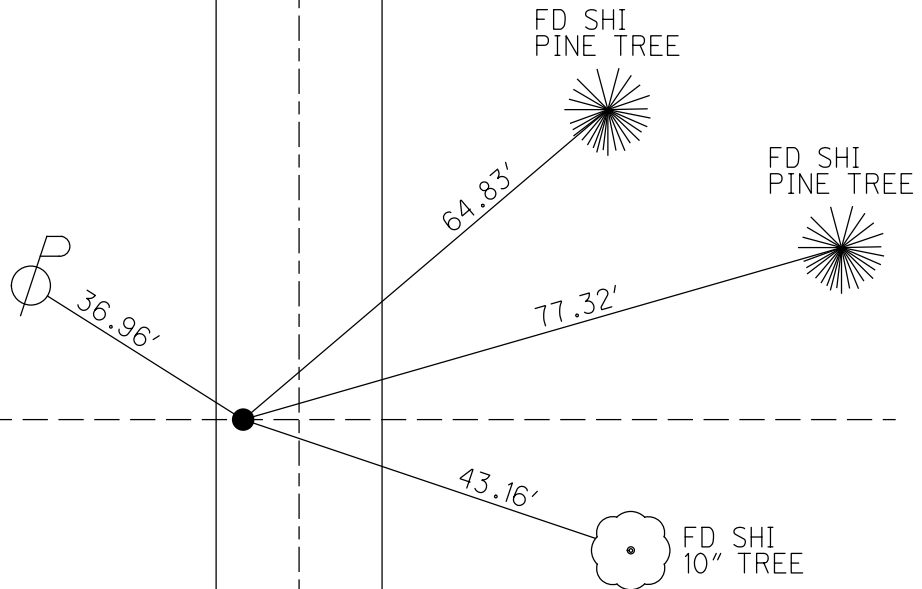

Q SR 300

O.D.O.T. DISTRICT 2 SURVEY OFFICE (USE ONLY)

PERSONNEL

REFERENCE NO. 11

SHEET 19 OF 22

NOTES NIESE

DATE 4/22/21

ROUTE SR 300

H.C. AUBLE

WEATHER CLOUDY, WINDY

COUNTY SANDUSKY

R.C. NIESE

TEMP. 42°

TOWNSHIP WOODVILLE

SECTION 11

DWG BY RHOADES PID CHIP SEAL

T 5 N R 13 E

TYPE MONUMENT MONBOX W/1" IPIN

ON SURFACE - ~~BELOW~~ ON

OFFSET CL PAVEMENT 7.7' LT : ~~RT~~

3.0' TO LT EDGE PAVEMENT



STATION: 264+76

HORZ.DATUM: NAD83 2011

GEOID: NAVD88 2018

GRID: NORTHING: 637487.728

EASTING: 1743814.342

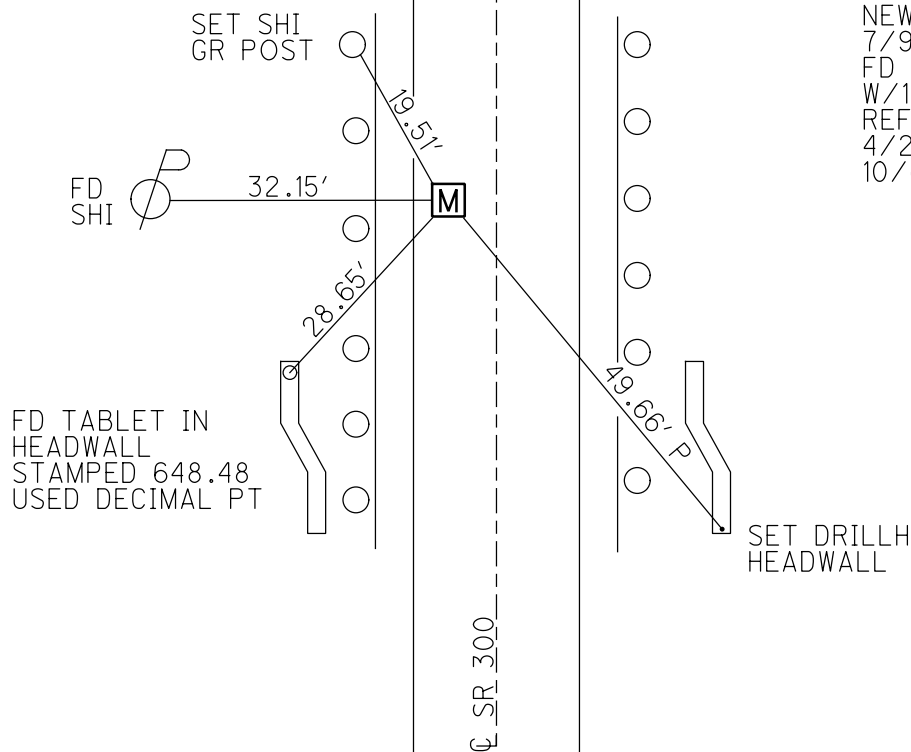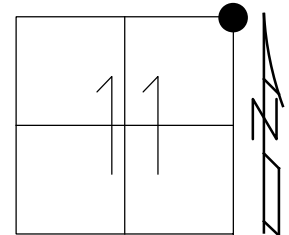

RECORD: 1984
 $\Delta = 0^{\circ} 22' 00''$ RT
FD STONE 23" DOWN
1973
FD MONBOX
5/10/00
3-2-11, KPM
FD MONBOX
4/16/13, SDC
SET MAG/WASHER
FINREF11
6/4/13, SDC
MONBOX RESET
NEWREF11
7/9/13, SDC
FD MONBOX
W/1" IPIN
REF11
4/22/21, DSA
10/6/21, JFO

O.D.O.T. DISTRICT 2 SURVEY OFFICE (USE ONLY)

PERSONNEL

REFERENCE NO. 12

SHEET 20 OF 22

NOTES _____ NIESH

DATE 4/22/21ROUTE SR 300

H.C. AUBLE

WEATHER CLOUDY, WINDY

COUNTY SUNDUSKYR.C. NIESH

TEMP. 42°

TOWNSHIP WOODVILLESECTION 1

T_5_N R_13_E

DWG BY RHOADES

PID CHIP SEAL

TYPE MONUMENT MAG/WASHER

ON SURFACE - ~~BELOW~~ _____ ON

OFFSET C PAVEMENT 5.5' LT : ~~RT~~



15.0' TO RT EDGE PAVEMENT

STATION: 291+25

HORZ.DATUM: NAD83 2011

GEOID: NAVD88 2018

GRID: NORTHING: 640127.055

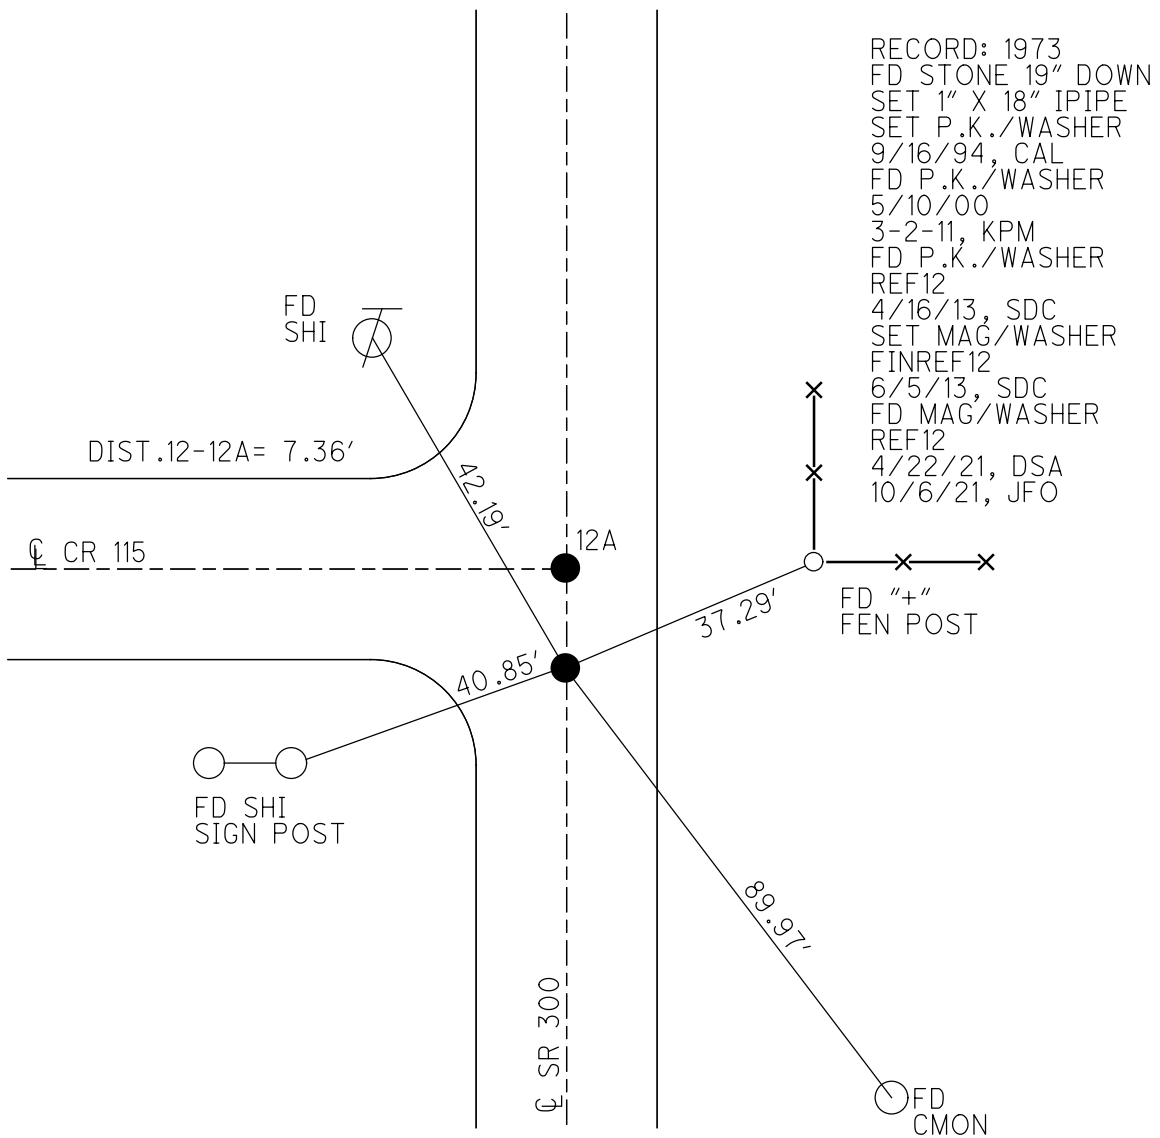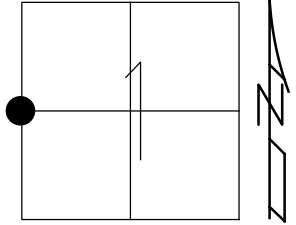EASTING: 1743911.651

O.D.O.T. DISTRICT 2 SURVEY OFFICE (USE ONLY)

PERSONNEL

REFERENCE NO. 12 A

SHEET 21 OF 22

NOTES NIESH

DATE 4/22/21

ROUTE SR 300

H.C. AUBLE

WEATHER CLOUDY, WINDY

COUNTY SANDUSKY

R.C. NIESE

TEMP. 42°

TOWNSHIP WOODVILLE

SECTION 1

DWG BY RHOADES

PID CHIP SEAL

T 5 N R 13 E

TYPE MONUMENT MAG/WASHER

ON SURFACE - ~~BELOW~~ ON

OFFSET CL PAVEMENT ON LT : RT

10.5' TO RT EDGE PAVEMENT


STATION: 291+32

HORZ.DATUM: NAD83 2011


GEOID: NAVD88 2018

GRID: NORTHING: 640131.732

EASTING: 1743917.333

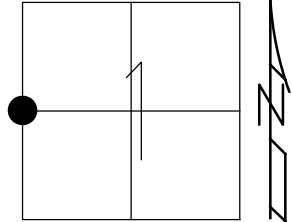

RECORD:
FD P.K./WASHER
5/10/00
3-2-11, KPM
FD LG.R.R.SPIKE
3" DOWN
4/16/13, SDC
SET MAG/WASHER
FINREF A12
6/5/13, SDC
FD MAG/WASHER
REF A12
4/22/21, DSA
10/6/21, JFO

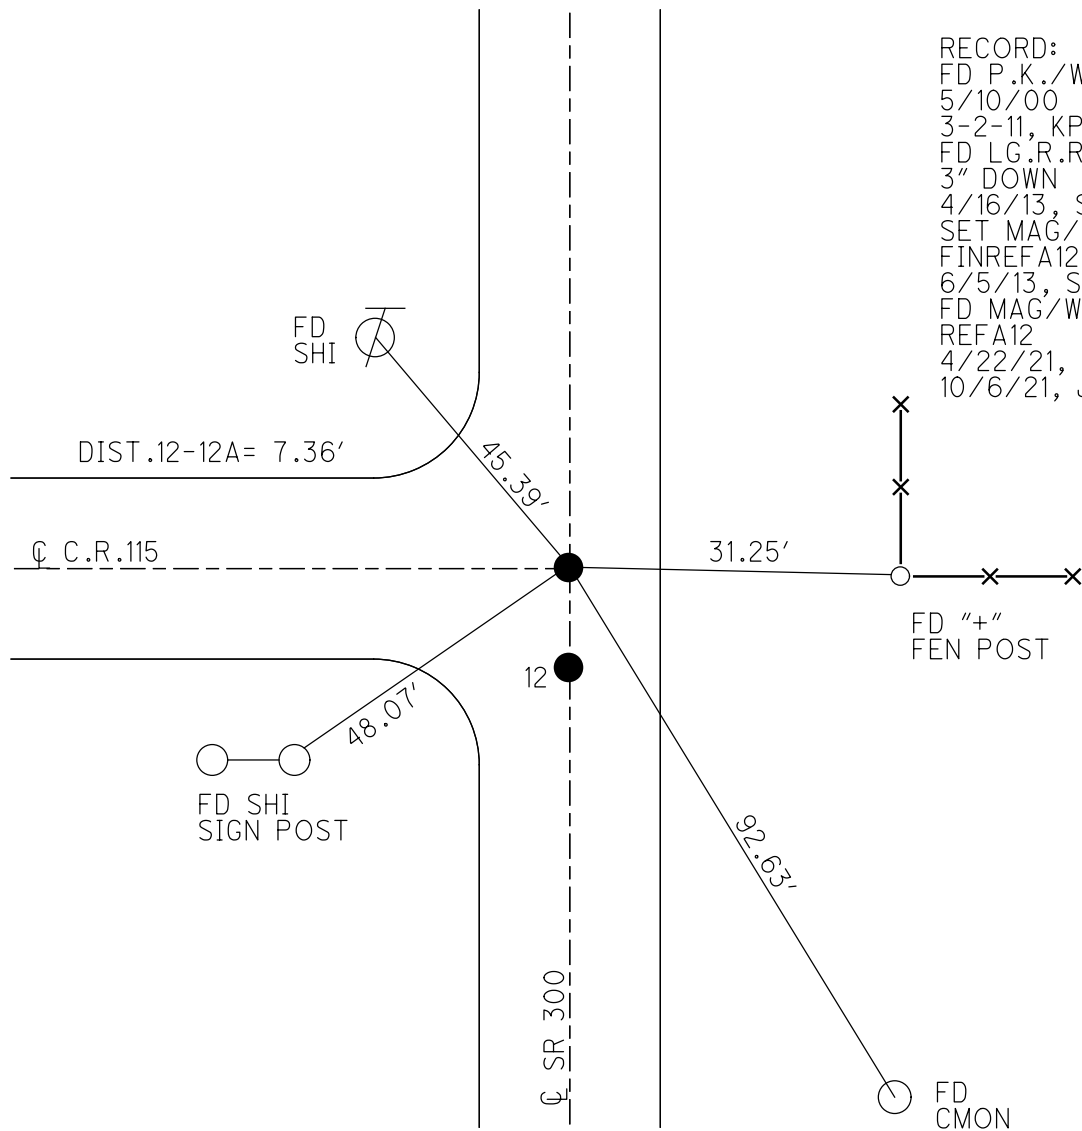

O.D.O.T. DISTRICT 2 SURVEY OFFICE (USE ONLY)

PERSONNEL

REFERENCE NO. 14

SHEET 22 OF 22

NOTES HARBAUGH

H.C. MOSER

R.C. FINGER

DATE 7/6/11

WEATHER CLOUDY

TEMP. 89°

ROUTE SR 300

COUNTY SANDUSKY

TOWNSHIP WOODVILLE

SECTION 35

T 5 N R 13 E

TYPE MONUMENT MON.BOX



ON SURFACE - ~~BELOW~~ ON

~~LEFT~~ - Q PAV'T - RIGHT 8.8', WB LANE

- TO - EDGE PAVEMENT

S.L.M. (334+22.4)

Grid: Northing: 644416.204 Easting: 1744048.091

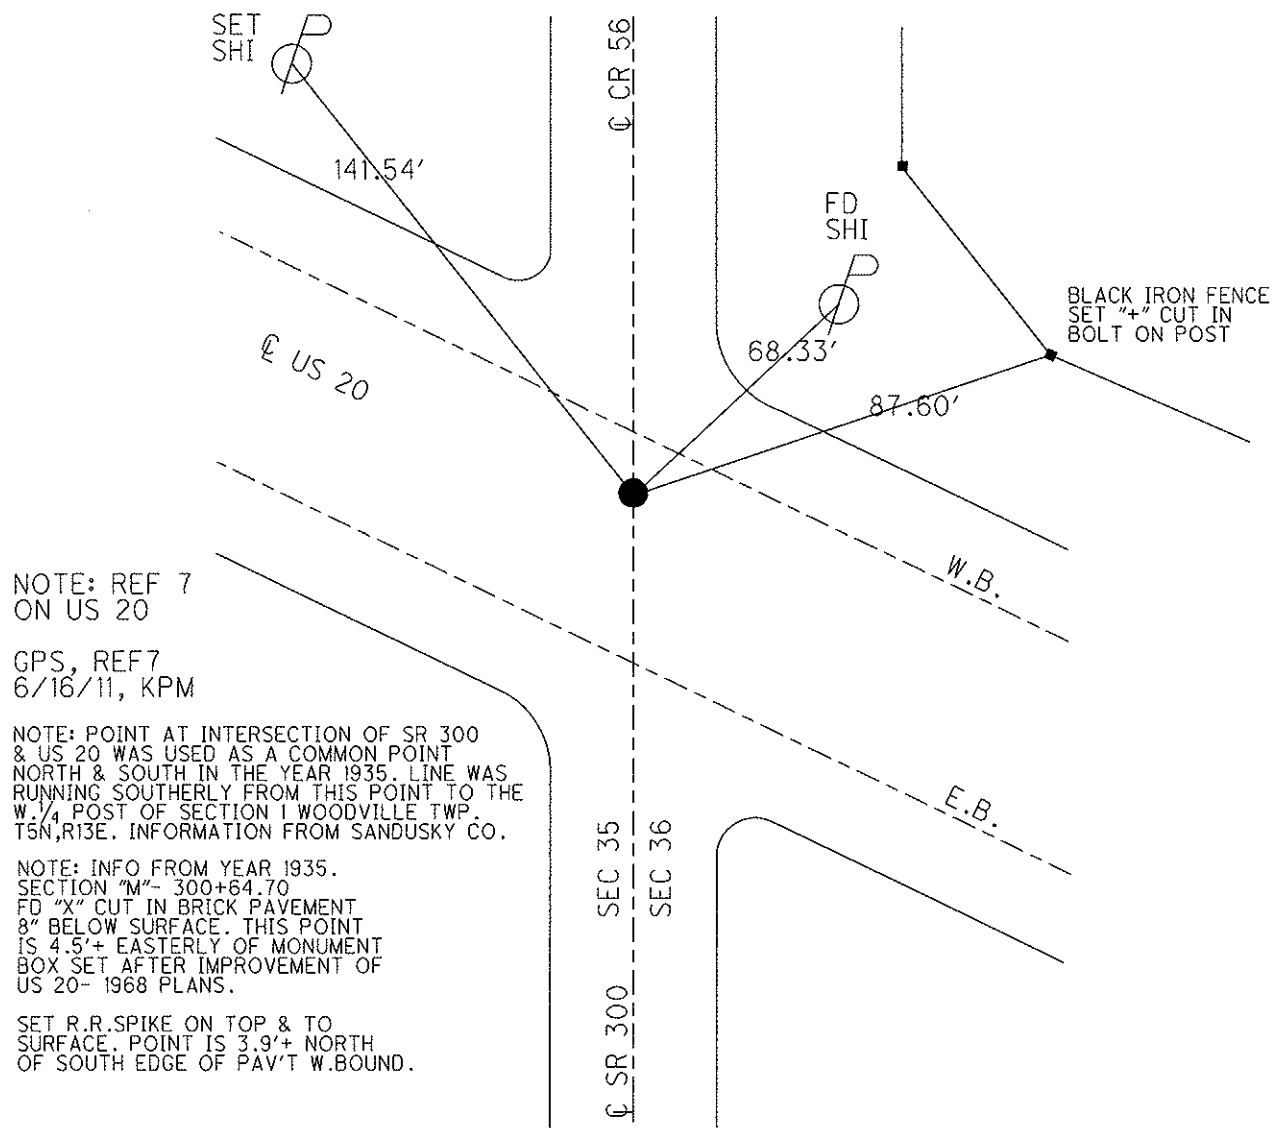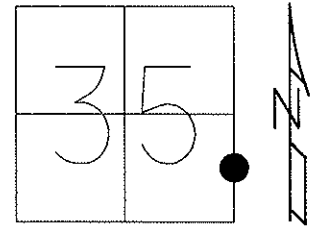

NOTE: REF 7
ON US 20

GPS, REF7
6/16/11, KPM

NOTE: POINT AT INTERSECTION OF SR 300
& US 20 WAS USED AS A COMMON POINT
NORTH & SOUTH IN THE YEAR 1935. LINE WAS
RUNNING SOUTHERLY FROM THIS POINT TO THE
W 1/4 POST OF SECTION 1 WOODVILLE TWP.
T5N,R13E. INFORMATION FROM SANDUSKY CO.

NOTE: INFO FROM YEAR 1935.
SECTION "M"- 300+64.70
FD "X" CUT IN BRICK PAVEMENT
8" BELOW SURFACE. THIS POINT
IS 4.5'+ EASTERLY OF MONUMENT
BOX SET AFTER IMPROVEMENT OF
US 20- 1968 PLANS.

SET R.R.SPIKE ON TOP & TO
SURFACE. POINT IS 3.9'+ NORTH
OF SOUTH EDGE OF PAV'T W.BOUND.