

O.D.O.T. DISTRICT 2 SURVEY OFFICE (USE ONLY)

PERSONNEL

REFERENCE NO. 0

SHEET 1 OF 33

NOTES LEU

DATE 09-22-14

ROUTE SR 412

H.C. HOMAN

WEATHER CLOUDY

COUNTY SANDUSKY

R.C. LEU

TEMP. 55° F

TOWNSHIP SANDUSKY

SECTION 36

T 5 N R 15 E

TYPE MONUMENT P.K.NAIL


ON SURFACE - ~~BELOW~~ ON

~~LEFT~~ - Q PAV'T - ~~RIGHT~~ ON

- TO - EDGE PAVEMENT


S.L.M. 0+00

Grid: Northing: 615888.6062 Easting: 1809346.4850

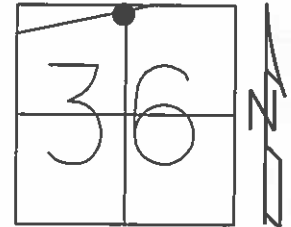

SET MAG/WASHER
GPS, NEWREFO
6-29-2015 DCH

SANDUSKY COUNTY OFFICE COMPLEX

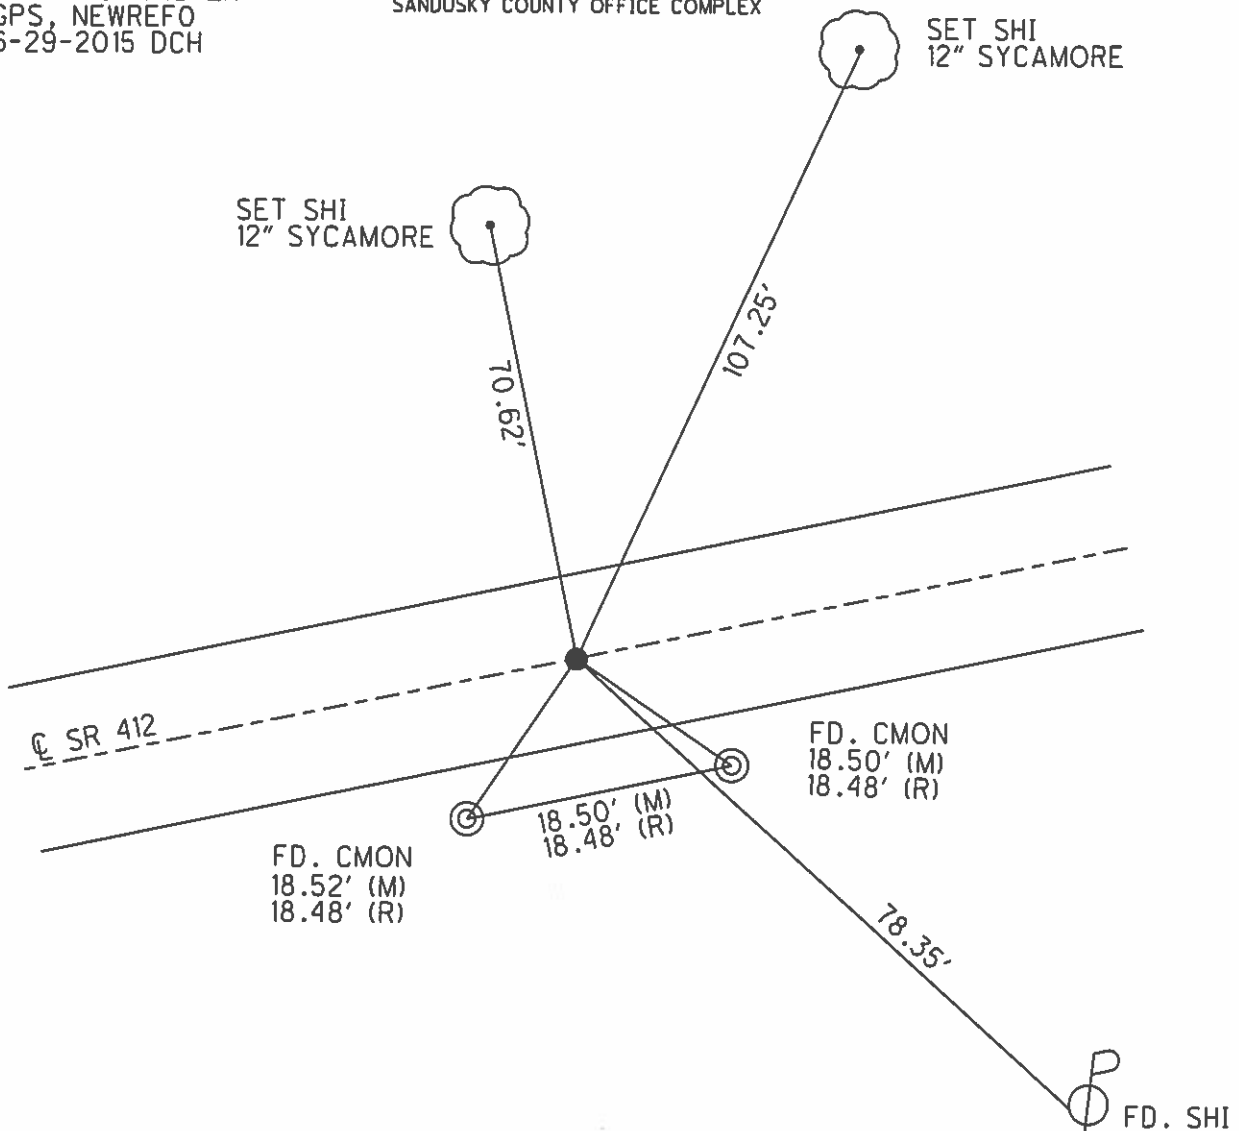

O.D.O.T. DISTRICT 2 SURVEY OFFICE (USE ONLY)

PERSONNEL

REFERENCE NO. 0 A

SHEET 2 OF 33

NOTES RHOADES

DATE 1/9/13

ROUTE SR 412

H.C. CANTERBURY

WEATHER CLOUDY

COUNTY SANDUSKY

R.C. RHOADES

TEMP. 36°

TOWNSHIP SANDUSKY

SECTION 25

T 5 N R 15 E

TYPE MONUMENT P.K.NAIL


ON SURFACE - ~~BELOW~~ ON

LEFT - Q PAV'T - RIGHT ON

- TO - EDGE PAVEMENT


S.L.M. 8+05.92


Grid: Northing: 615958.132 Easting: 1809683.700

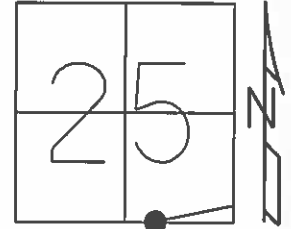

FD P.K.NAIL
GPS, SV2304
1/9/13, MC

DID NOT PUT BACK
POINT, 7-24-2015

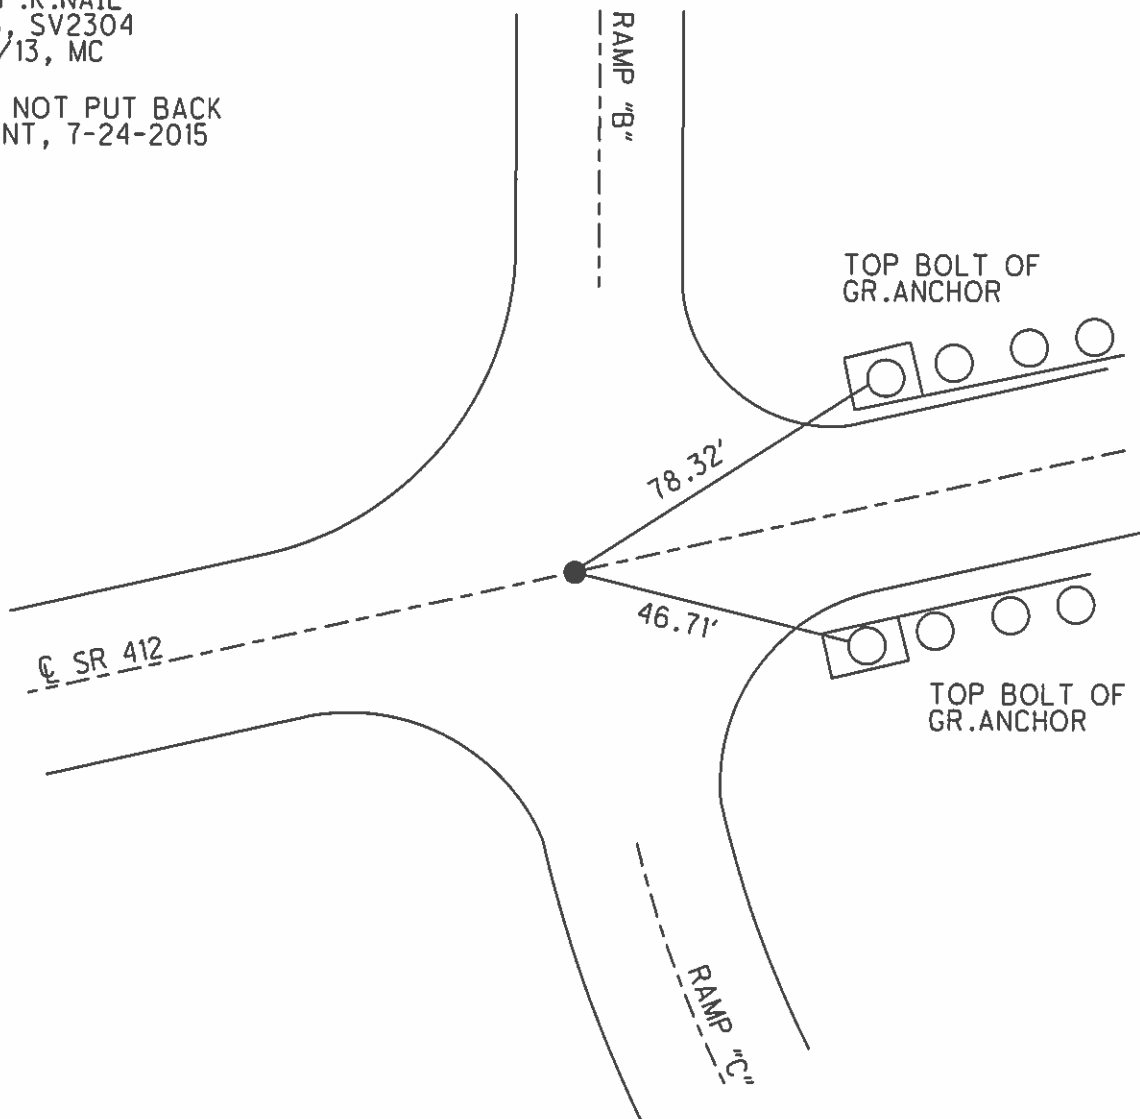

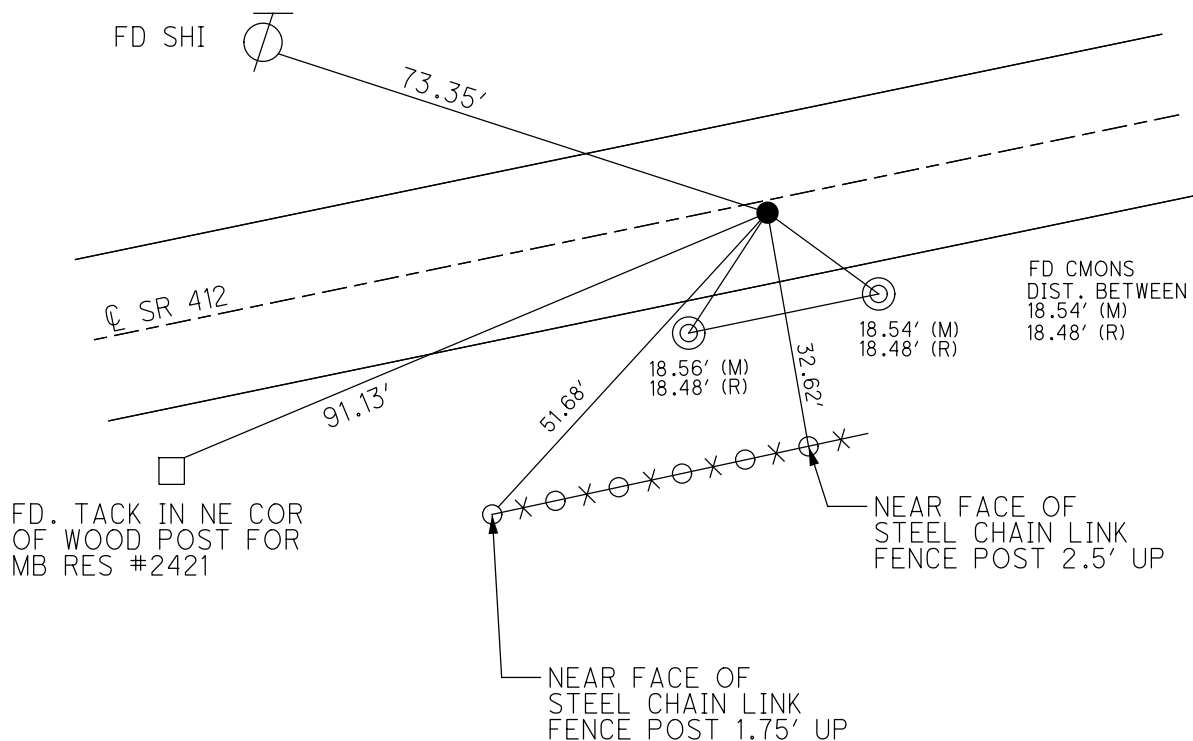

O.D.O.T. DISTRICT 2 SURVEY OFFICE (USE ONLY)

PERSONNEL

REFERENCE NO. 0 C

SHEET 4 OF 33

NOTES RHOADES

DATE 7/20/22

ROUTE SR 412

H.C. RHOADES

WEATHER CLOUDY

COUNTY SANDUSKY

R.C. WHITAKER

TEMP. 82°

TOWNSHIP SANDUSKY

SECTION 25

DWG BY RHOADES PID PAVETRAIN

T 5 N R 16 E

TYPE MONUMENT MAG/WASHER

ON SURFACE - ~~BELOW~~ ON

OFFSET CL PAVEMENT 1.8' LT : RT

9' TO RT EDGE PAVEMENT


STATION: 34+81.4

HORZ.DATUM: NAD83 2011


GEOID: NAVD88 2018

GRID: NORTHING: 616501.764

EASTING: 1812303.445

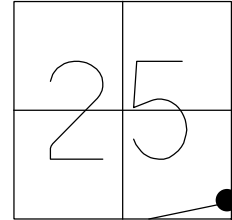

RECORD:
COUNTY FD P.K.NAIL
SET BY OTHERS
FD MAG NAIL
REF A1
12/5/12, SDC
1/9/13, MC
9/22/14, DCH
SET MAG/WASHER
NEW REF A1
6/29/15, DCH
FD MAG/WASHER
REF C0
7/20/22,
1/20/23, JMR

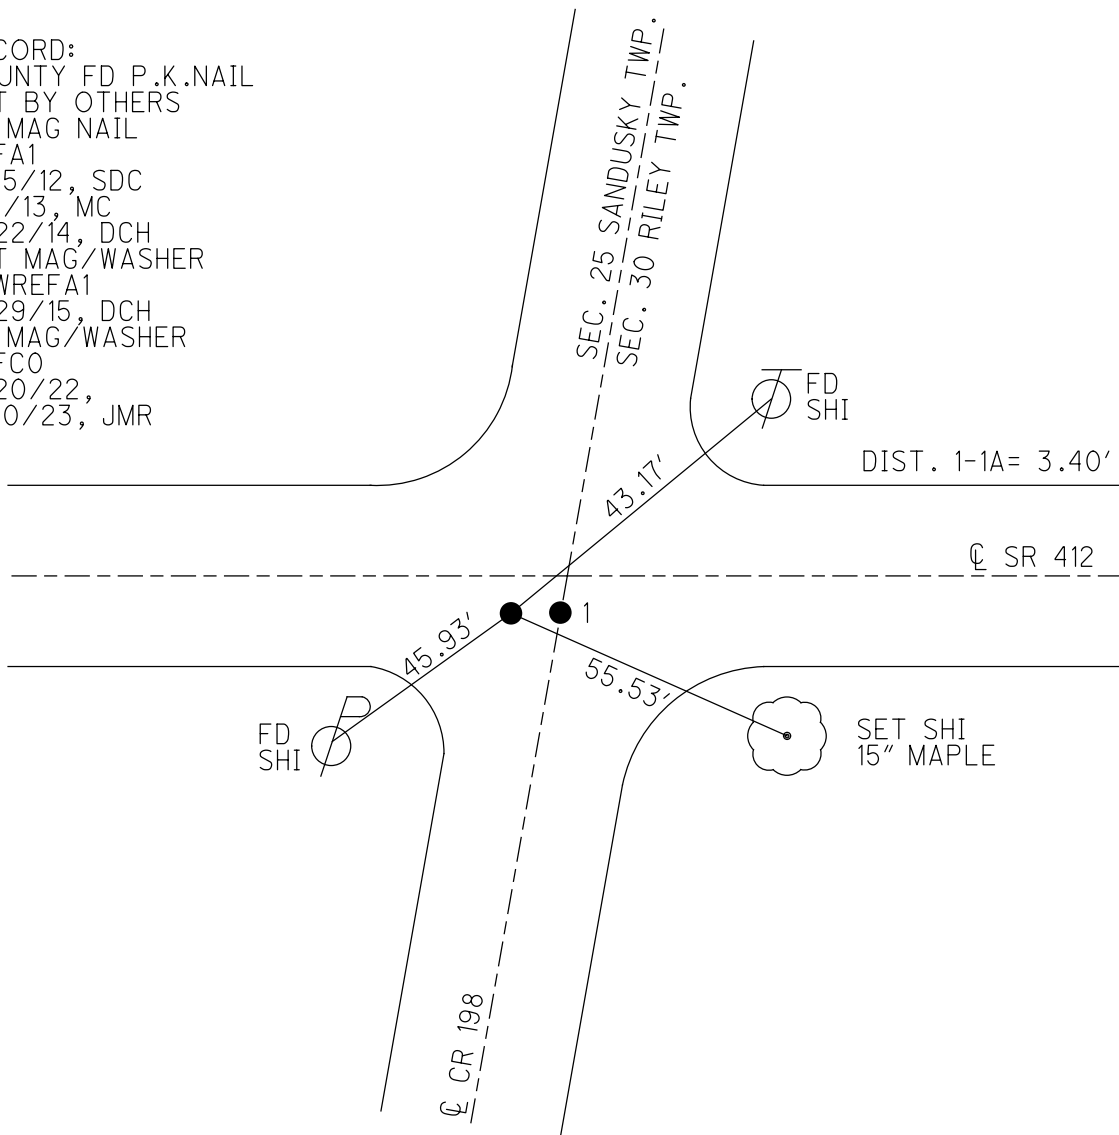

O.D.O.T. DISTRICT 2 SURVEY OFFICE (USE ONLY)

PERSONNEL

REFERENCE NO. 1

SHEET 5 OF 33

NOTES RHOADES

DATE 7/20/22

ROUTE SR 412

H.C. RHOADES

WEATHER CLOUDY

COUNTY SANDUSKY

R.C. WHITAKER

TEMP. 82°

TOWNSHIP RILEY

DWG BY RHOADES

PID PAVETRAIN

SECTION 30

T 5 N R 16 E

TYPE MONUMENT LG.R.R.SPIKE

~~ON SURFACE~~ - BELOW 4"

OFFSET CL PAVEMENT 1.8' ~~LT~~ : RT

9' TO RT EDGE PAVEMENT


STATION: 34+84.8

HORZ.DATUM: NAD83 2011


GEOID: NAVD88 2018

GRID: NORTHING: 616502.438

EASTING: 1812306.771

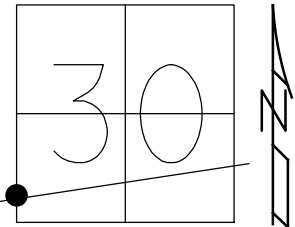

RECORD: P.I.
 $\Delta=00^{\circ}04'$ RT
STA 0+00
SET P.K./WASHER
ATOP R.R.SPIKE
1.5' LT OF CL
FIELD BOOK 52
9/27/84
SET P.K./WASHER
8/2/93, JLR
FD R.R.SPIKE
REF1
12/5/12, SDC
1/9/13, MC
9/22/14, DCH
FD R.R.SPIKE
4" DOWN
NEWREF1
6/29/15, DCH
FD LG.R.R.SPIKE
4" DOWN
REF1
7/20/22,
1/20/23, JMR

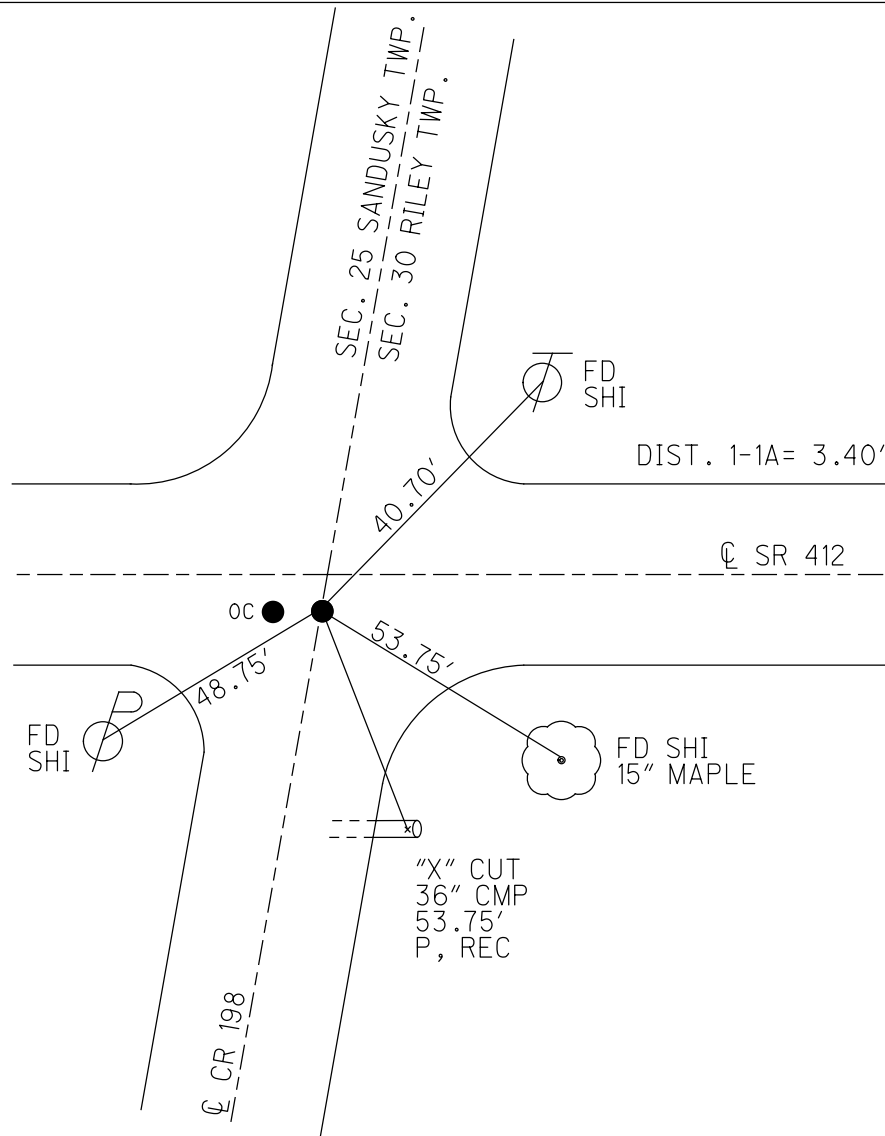

O.D.O.T. DISTRICT 2 SURVEY OFFICE (USE ONLY)

PERSONNEL

REFERENCE NO.

1 A SHEET 6 OF 33

NOTES LEU

DATE 09-22-14

ROUTE SR 412

H.C. HOMAN

WEATHER CLOUDY

COUNTY SANDUSKY

R.C. LEU

TEMP. 55°

TOWNSHIP RILEY

SECTION 30

T_5_N R_16_E

TYPE MONUMENT P.K./WASHER


ON SURFACE - ~~BELOW~~ ON

~~LEFT~~ - @ PAV'T - RIGHT 5.5'

4' TO RT. EDGE PAVEMENT

S.L.M. 54+81.72

Grid: Northing: 616907.027 Easting: 1814262.199

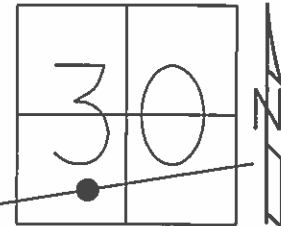

RECORD: 9/27/84

P.O.T.

STA 19+96

SET P.K./WASHER

ATOP 3/4" IPIPE

ATOP IPIN
E E A B T O E

5.5' RT OF C
FIELD ROCK

FIELD BOOK 52

SET P.K./WASHER

8/2/93, JLR

FD P.K.NAIL


GPS, REF2

12/5/12, SDC

SET MAG/WASHER

NEWREFB1

6/30/15, DCH

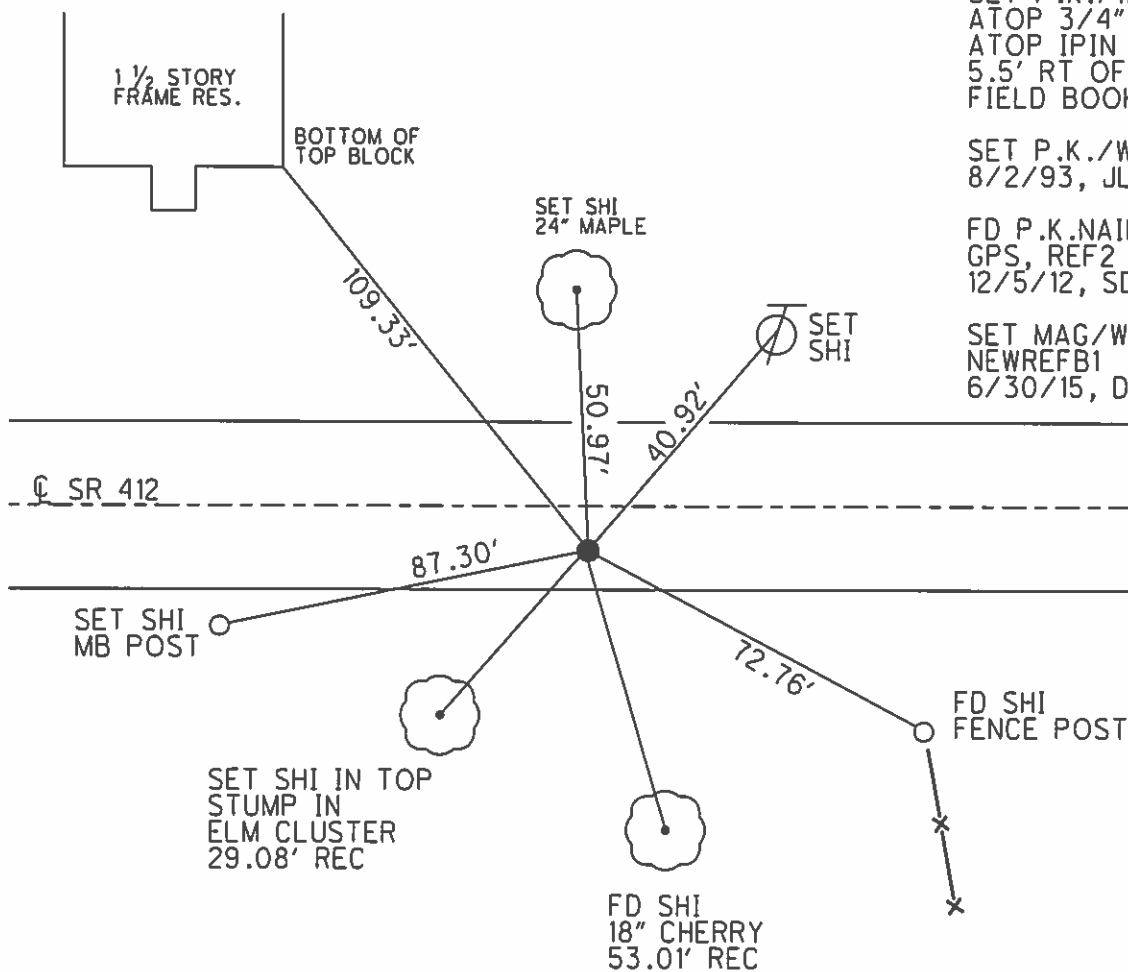

O.D.O.T. DISTRICT 2 SURVEY OFFICE (USE ONLY)

PERSONNEL

REFERENCE NO. 2

SHEET 7 OF 33

NOTES LEU

DATE 09-22-14

ROUTE SR 412

H.C. HOMAN

WEATHER SUNNY

COUNTY SANDUSKY

R.C. LEU

TEMP. 60°

TOWNSHIP RILEY

SECTION 30

T 5 N R 16 E

TYPE MONUMENT P.K.NAIL


ON SURFACE - ~~BELOW~~ ON

LEFT - Q PAV'T - ~~RIGHT~~ 0.5'

10' TO RT EDGE PAVEMENT

S.L.M. 58+81.4

Grid: Northing: 616987.931 Easting: 1814653.608

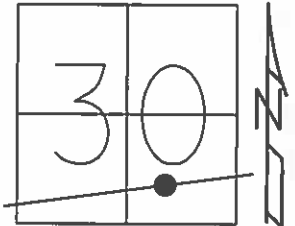


RECORD: 8/23/1974
POINT IS ON N-S 1/2
SEC 30 LINE
FIELD BOOK 52

SET P.K./WASHER
10/2/93, JLR

FD P.K.NAIL
GPS, REF3
12/5/12, SDC

SET MAG/WASHER
NEWREF2
6/30/15, DCH

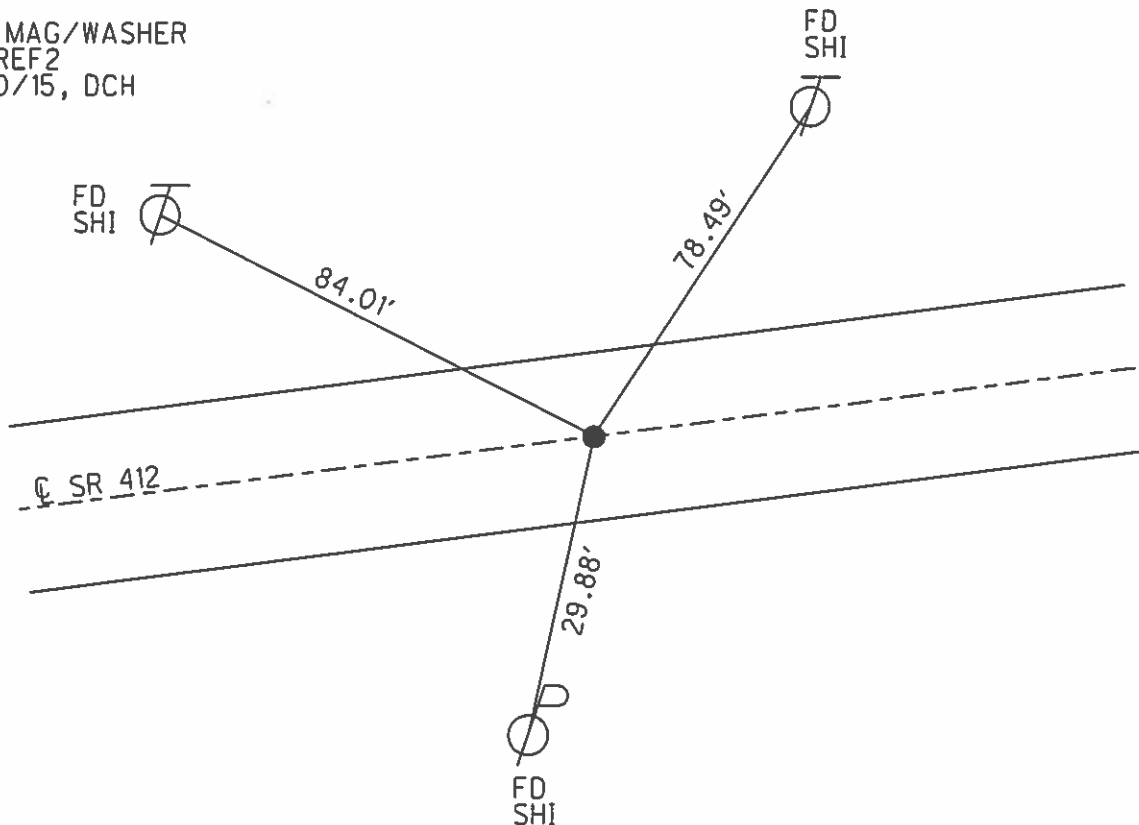

O.D.O.T. DISTRICT 2 SURVEY OFFICE (USE ONLY)

PERSONNEL	REFERENCE NO. <u>2 A</u>	SHEET <u>8</u> OF <u>33</u>	
NOTES <u>LEU</u>	DATE <u>09-22-14</u>	ROUTE <u>SR 412</u>	
H.C. <u>HOMAN</u>	WEATHER <u>SUNNY</u>	COUNTY <u>SANDUSKY</u>	
R.C. <u>LEU</u>	TEMP. <u>62°</u>	TOWNSHIP <u>RILEY</u>	
		SECTION <u>30</u>	
		T <u>5</u> N R <u>16</u> E	

TYPE MONUMENT 3/4" IPIPE, LEANING SWLY


~~ON SURFACE~~ - BELOW 11"

~~LEFT~~ - ℄ PAV'T - RIGHT 11.2'

1' RT TO RT. EDGE PAVEMENT

S.L.M. 61+52.81

Grid: Northing: 617038.052 Easting: 1814920.351

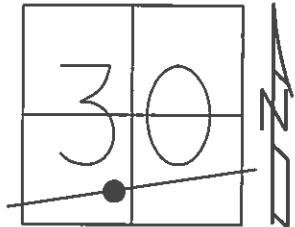


RECORD: 9/27/1984
P.I. STA. 27+04.6
SET P.K./WASHER
ATOP R.R.SPIKE
11'± RT ℄
FIELD BOOK 52

SET P.K./WASHER
10/2/93, JLR

FD P.K.NAIL
GPS, REF4
12/5/12, SDC

SET MAG/WASHER
NEWREFA2
6/30/15, DCH

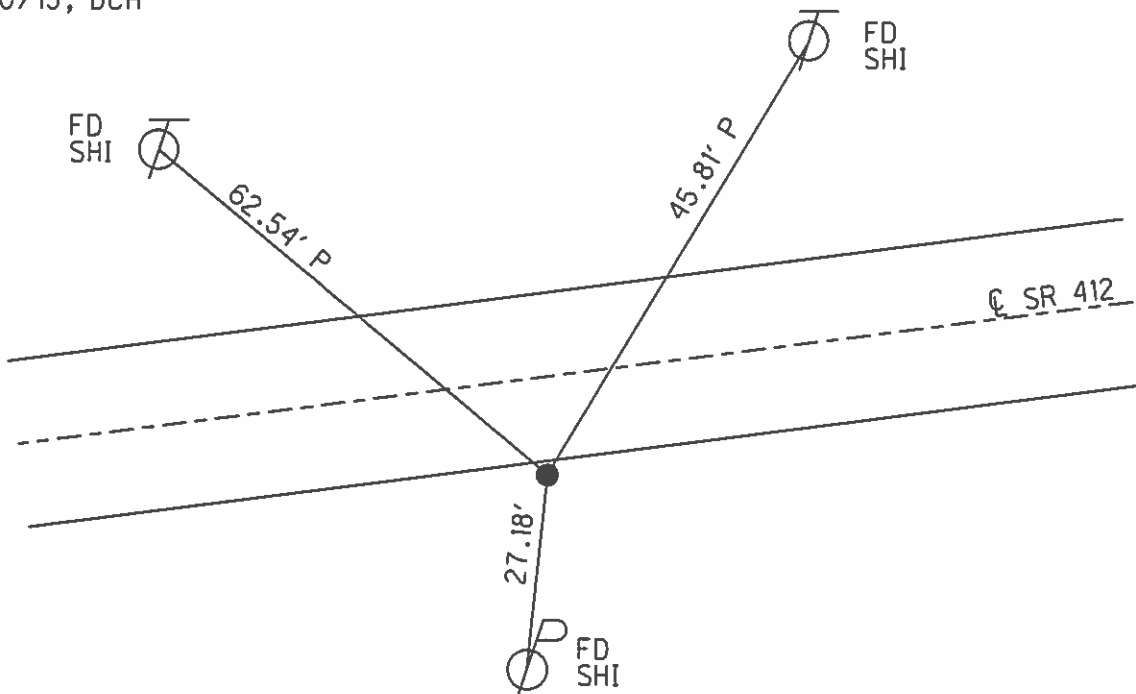

O.D.O.T. DISTRICT 2 SURVEY OFFICE (USE ONLY)

PERSONNEL

REFERENCE NO.

2 B

SHEET

9

OF 33

NOTES LEU

DATE

09-22-2014

ROUTE

SR 412

H.C. HOMAN

WEATHER

SUNNY

COUNTY

SANDUSKY

R.C. LEU

TEMP.

64°

TOWNSHIP

RILEY

SECTION

30

T 5 N

R 16 E

TYPE MONUMENT 5/8" PIN IN MONBOX


ON SURFACE - ~~BELOW~~ ON

~~LEFT~~ - CL PAV'T - RIGHT 1' RT.

10' TO RT. EDGE PAVEMENT

S.L.M. 66+27.97

Grid: Northings 17233.604 Easting: 1815353.401

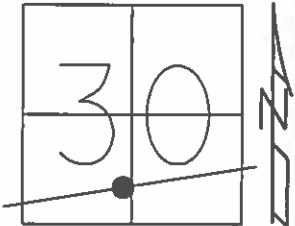


RECORD:

FD MONBOX
8/2/93, JLR

FD MONBOX
GPS, REF5
12/5/12, SDC

FD 3/4" IPIN
IN MONBOX
NEWREFB2
6/30/15, DCH

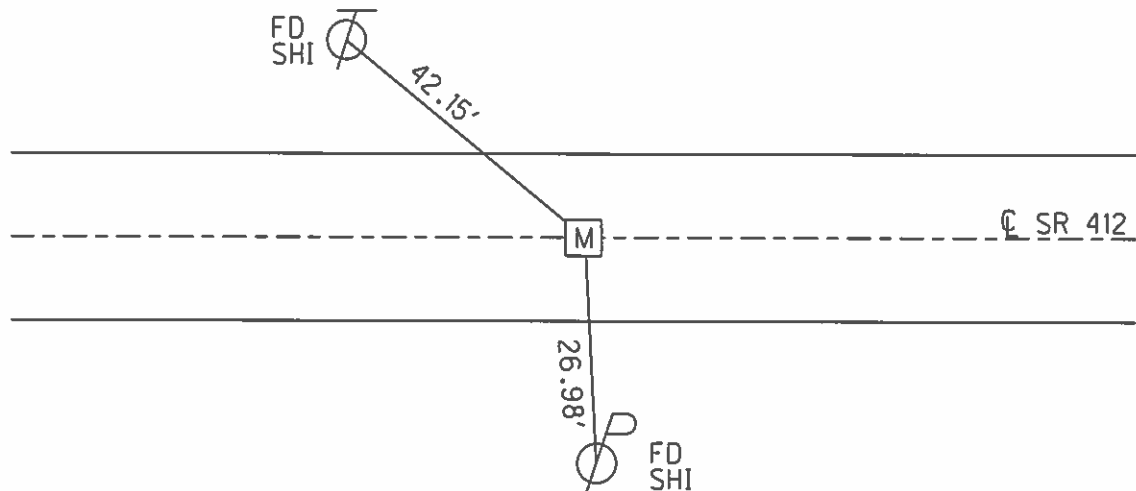


O.D.O.T. DISTRICT 2 SURVEY OFFICE (USE ONLY)

PERSONNEL	REFERENCE NO. <u>2 C</u>	SHEET <u>10</u> OF <u>33</u>
NOTES <u>CHENEY</u>	DATE <u>04-27-1993</u>	ROUTE <u>SR 412</u>
H.C. <u>RIPPLE</u>	WEATHER <u>SUNNY</u>	COUNTY <u>SANDUSKY</u>
R.C. <u>BARBOUR</u>	TEMP. <u>55°</u>	TOWNSHIP <u>RILEY</u>
<u>GEYMAN</u>		SECTION <u>30</u>
		T <u>5</u> N R <u>16</u> E

TYPE MONUMENT CMON IN TILE
~~ON SURFACE~~ - BELOW 1"
 LEFT - ℄ PAV'T - ~~RIGHT~~ 37.6'
27.6' TO LT. EDGE PAVEMENT
 S.L.M. 70+61.77


Grid: Northing: 617410.595 Easting: 1815749.452

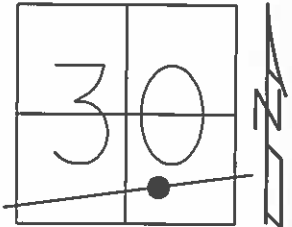

RECORD: 9/27/1984
 P.I. STA. 742+02.5
 1933 PLANS
 35+6750, OLD R/W PLANS
 MONBOX BELOW SURFACE
 FIELD BOOK 52

FD CMON IN TILE
 4/27/93, JLR

FD CMON, 1" DOWN
 GPS, REF6
 12/5/12, SDC

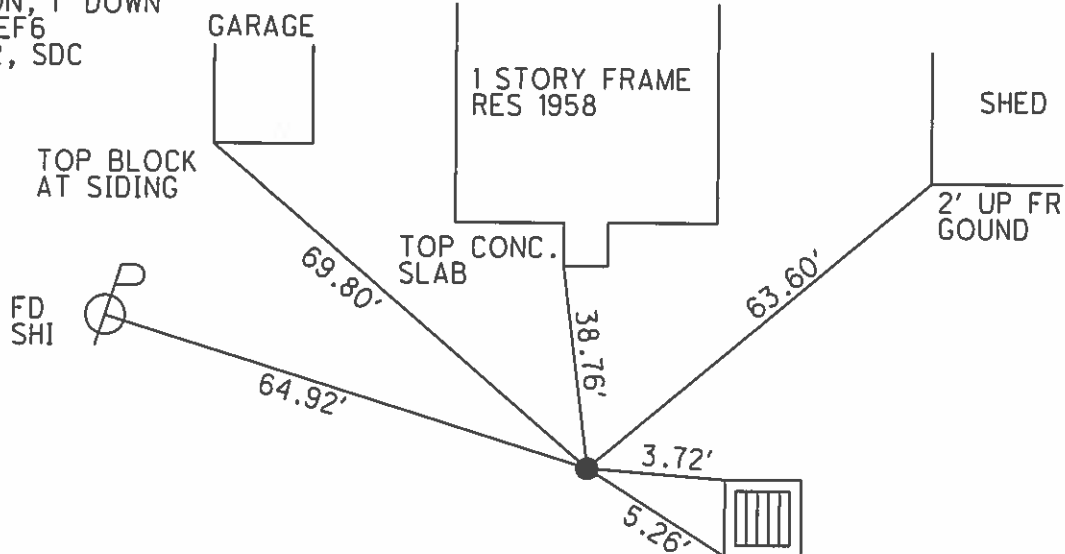


O.D.O.T. DISTRICT 2 SURVEY OFFICE (USE ONLY)

PERSONNEL _____ REFERENCE NO. 2 D SHEET 11 OF 33
 NOTES LEU DATE 09-23-2014 ROUTE SR 412
 H.C. HOMAN WEATHER SUNNY COUNTY SANDUSKY
 R.C. LEU TEMP. 60° TOWNSHIP RILEY
 SECTION 30
 T 5 N R 16 E

TYPE MONUMENT 5/8" IPIN IN MONBOX
 ON SURFACE - ~~BELOW~~ ON _____
~~LEFT~~ - C PAV'T - ~~RIGHT~~ ON _____
10' TO RT. EDGE PAVEMENT
 S.L.M. 74+90.55


Grid: Northing: 617369.744 Easting: 1816176.279

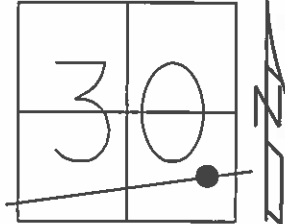

RECORD:
 FD MONBOX
 8/2/93, JLR

FD MONBOX
 GPS, REF7
 12/6/12, SDC

FD 3/4" IPIN
 IN MONBOX
 NEWREFD2
 6/30/15, DCH

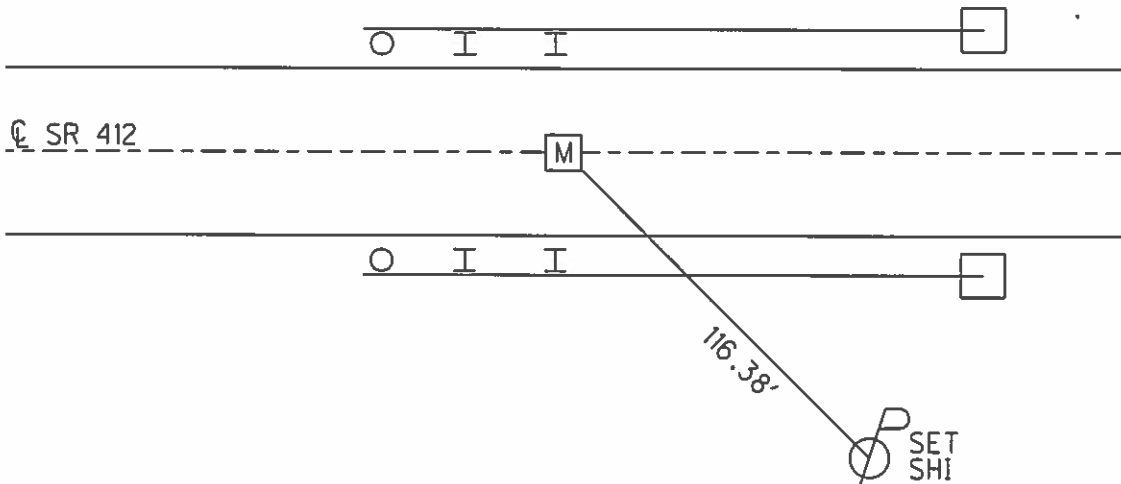


O.D.O.T. DISTRICT 2 SURVEY OFFICE (USE ONLY)

PERSONNEL	REFERENCE NO. <u>2E</u>	SHEET <u>12</u> OF <u>33</u>
NOTES <u>LEU</u>	DATE <u>09-23-2014</u>	ROUTE <u>SR 412</u>
H.C. <u>HOMAN</u>	WEATHER <u>SUNNY</u>	COUNTY <u>SANDUSKY</u>
R.C. <u>LEU</u>	TEMP. <u>60°</u>	TOWNSHIP <u>RILEY</u>
		SECTION <u>30</u>
		T <u>5</u> N R <u>16</u> E

TYPE MONUMENT MONBOX, 3/4" I. PIN
 ON SURFACE - ~~BELOW~~ ON
~~LEFT~~ - CL PAV'T - RIGHT 2.8'
8' TO RT. EDGE PAVEMENT
 S.L.M. 78+19.55

Grid: Northing: 617336.556 Easting: 1816503.602

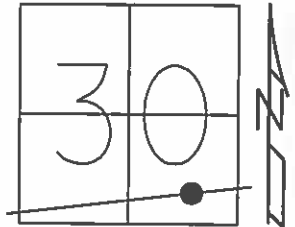


RECORD: 9/27/1984
 P.I. STA. 749+51.80
 1933 PLANS
 MONBOX ON SURFACE
 2' RT. CL FIELD BOOK 52

FD MONBOX
 7/24/00

FD MONBOX
 GPS, REF8
 12/6/12, SDC


FD 3/4" IPIN
 IN MONBOX
 NEWREFE2
 6/30/15, DCH

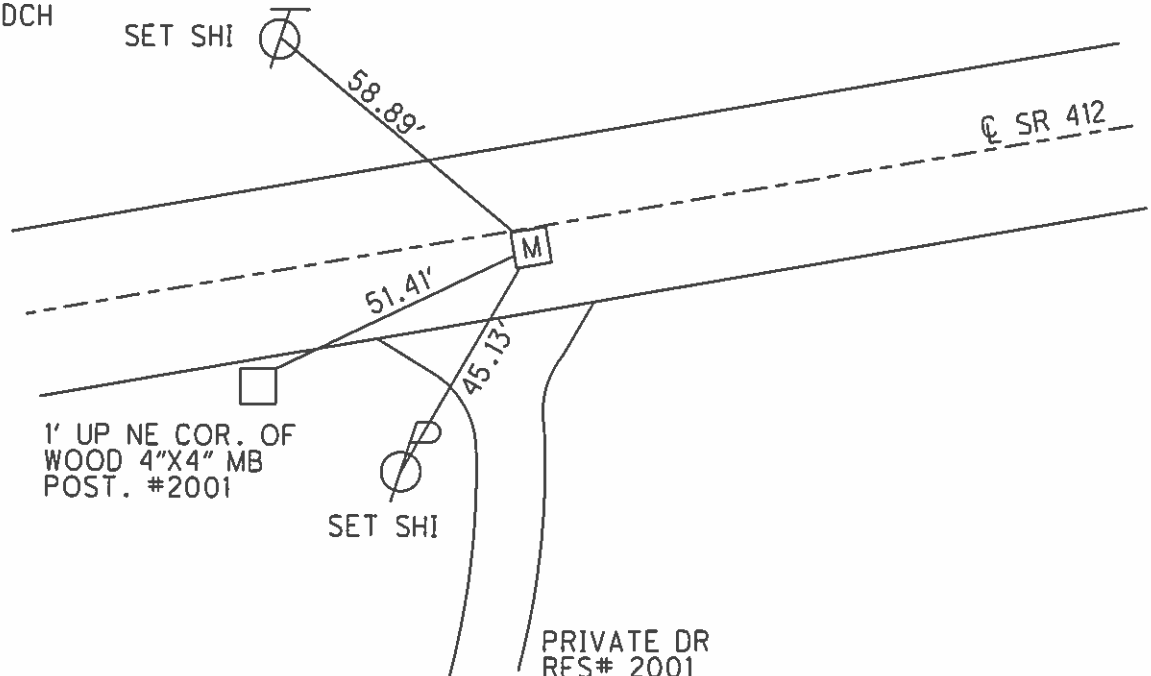

O.D.O.T. DISTRICT 2 SURVEY OFFICE (USE ONLY)

PERSONNEL	REFERENCE NO.	2 F	SHEET	13	OF	33
NOTES	DATE	09-23-2014	ROUTE	SR 412		
H.C. HOMAN	WEATHER	SUNNY	COUNTY	SANDUSKY		
R.C. LEU	TEMP.	60°	TOWNSHIP	RILEY		
			SECTION	30		
			T	5	N	R 16 E

TYPE MONUMENT MAG/WASHER
 ON SURFACE - ~~BELOW~~ ON
~~LEFT~~ - C PAV'T - RIGHT 14'
1' TO RT. EDGE PAVEMENT
 S.L.M. 86+00.73

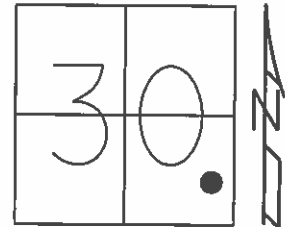

Grid: Northing: 617294.943 Easting: 1817283.675


RECORD: 9/27/1984
 STA.85+09
 757+32.60, 1933 PLANS
 SET P.K./WASHER
 ATOP IPIN
 14' RT. C FIELD BOOK 52

DIST. 2F-3= 16.67'

SET P.K./WASHER
 8/2/93, JLR

FD P.K./WASHER
 GPS, REF9
 12/6/12, SDC

SET MAG/WASHER
 NEWREFF2
 6/30/15, DCH

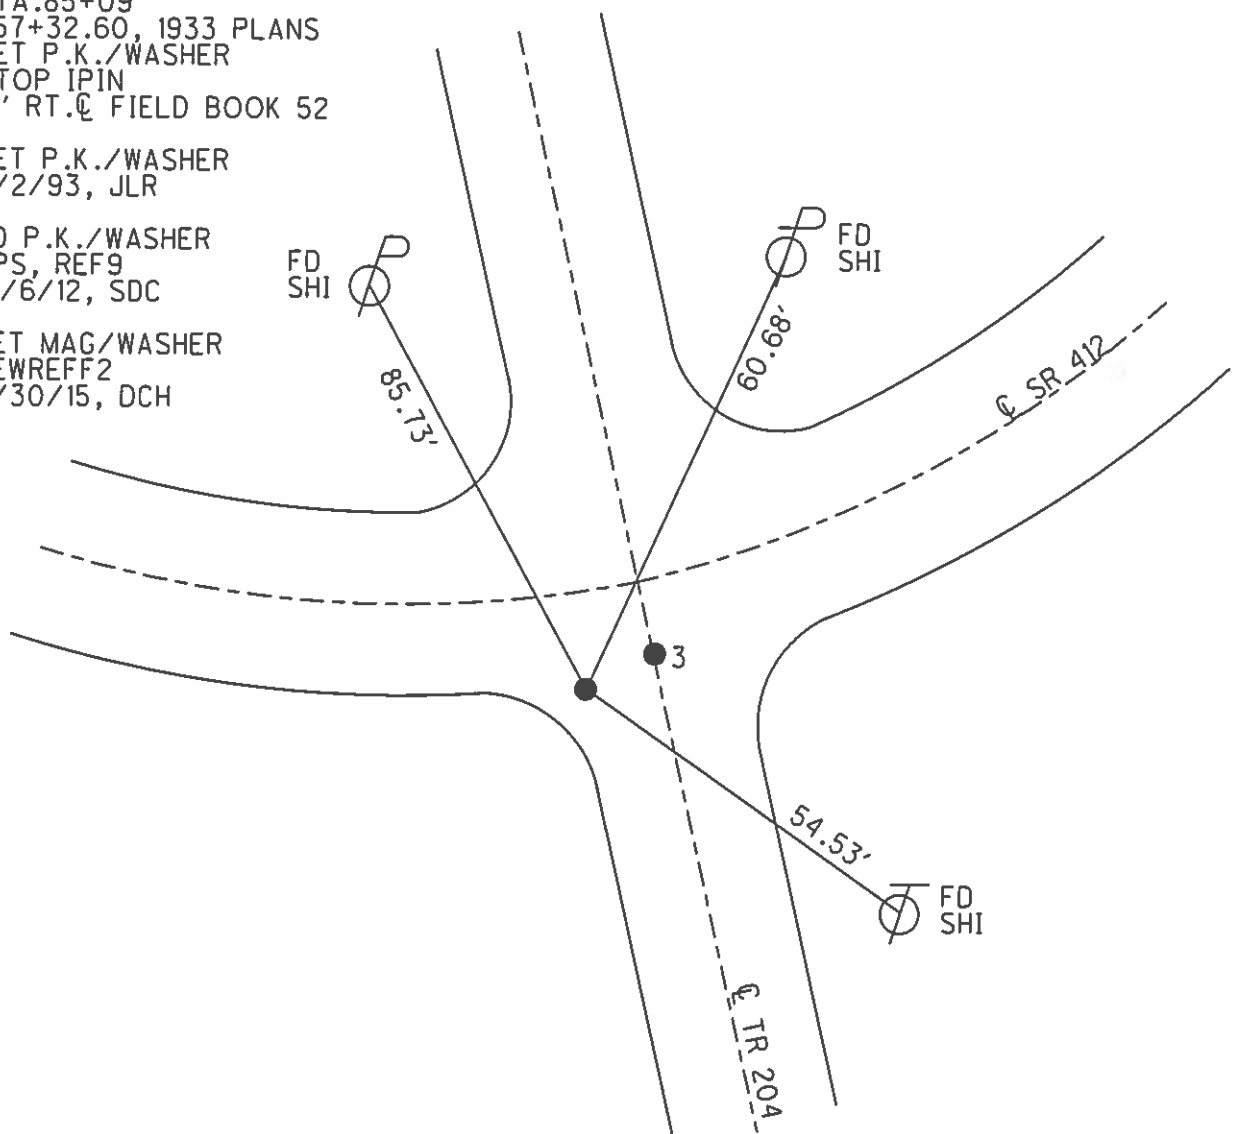

O.D.O.T. DISTRICT 2 SURVEY OFFICE (USE ONLY)

PERSONNEL

REFERENCE NO. 3

SHEET 14 OF 33

NOTES LEU

DATE 09-23-2014

ROUTE SR 412

H.C. HOMAN

WEATHER SUNNY

COUNTY SANDUSKY

R.C. LEU

TEMP. 60°

TOWNSHIP RILEY

SECTION 30

T 5 N R 16 E

TYPE MONUMENT MAG/WASHER


ON SURFACE - ~~BELOW~~ ON

~~LEFT~~ - C PAV'T - RIGHT 11'

- TO - EDGE PAVEMENT

S.L.M. 86+17.44

Grid: Northing: 617299.232 Easting: 1817299.829

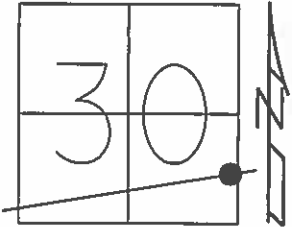


RECORD: 9/27/1984
SET P.K./WASHER
ATOP IPIPE
ATOP IPIN
11' RT. C FIELD BOOK 52
POINT APPEARS TO BE ON
N-S SEC LINE

DIST. 2F-3= 16.67'

SET P.K./WASHER
8/2/93, JLR

FD P.K./WASHER
GPS, REF10
12/6/12, SDC


SET MAG/WASHER
NEWREF3
6/30/15, DCH

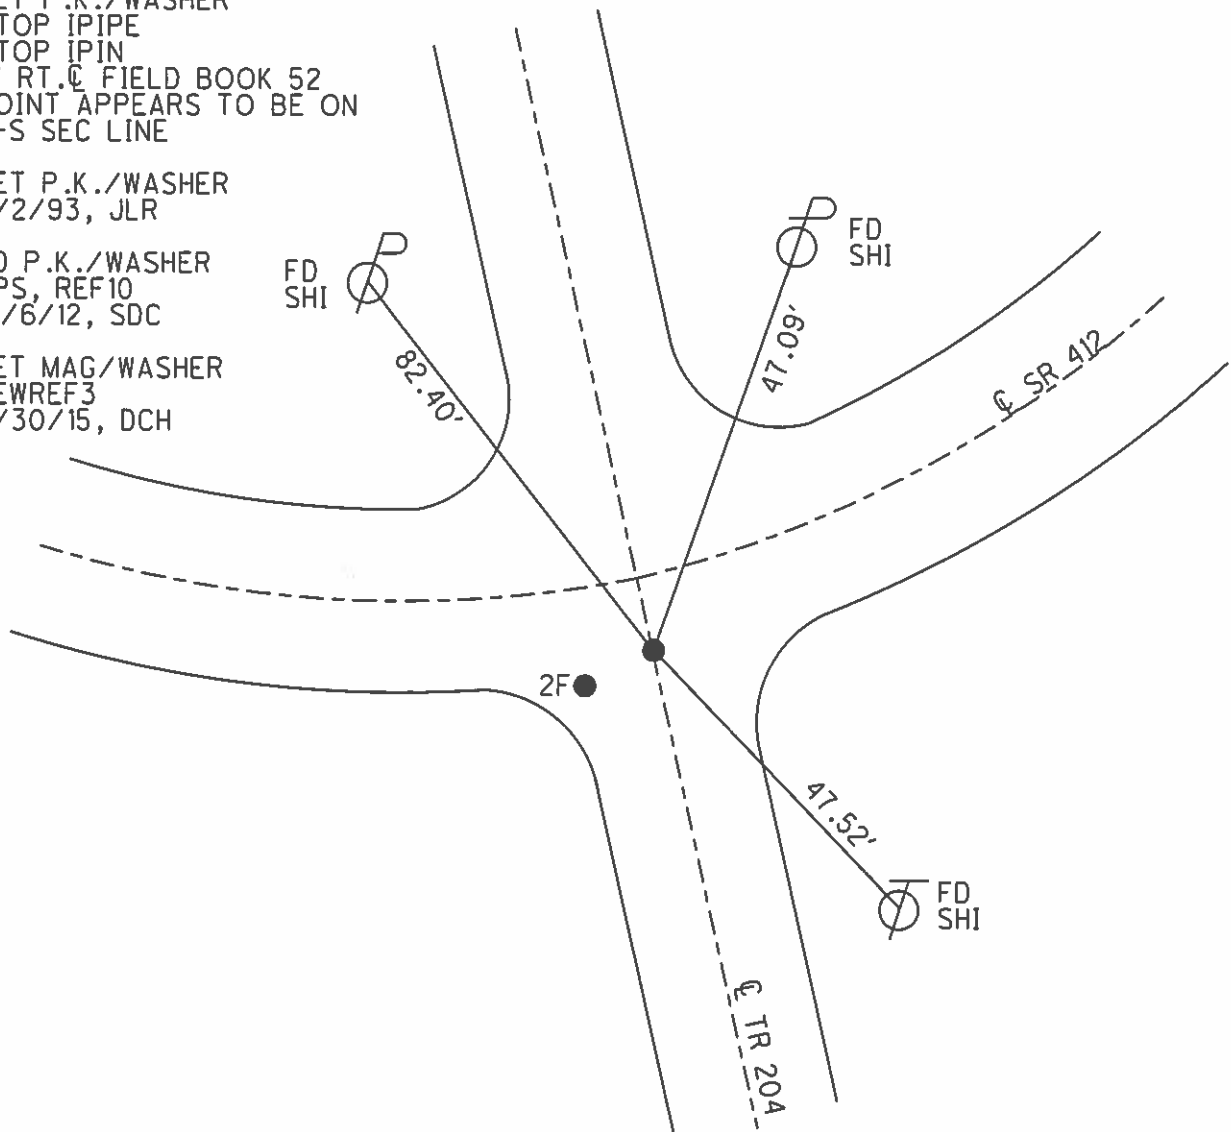

O.D.O.T. DISTRICT 2 SURVEY OFFICE (USE ONLY)

PERSONNEL	REFERENCE NO. <u>3 A</u>	SHEET <u>15</u> OF <u>33</u>	
NOTES <u>LEU</u>	DATE <u>09-23-2014</u>	ROUTE <u>SR 412</u>	
H.C. <u>HOMAN</u>	WEATHER <u>SUNNY</u>	COUNTY <u>SANDUSKY</u>	
R.C. <u>LEU</u>	TEMP. <u>63</u>	TOWNSHIP <u>RILEY</u>	
		SECTION <u>29</u>	
		T <u>5</u> N R <u>16</u> E	

TYPE MONUMENT P.K./WASHER
 ON SURFACE - ~~BELOW~~ ON
~~LEFT - C~~ PAV'T - ~~RIGHT~~ ON
9.5' TO RT. EDGE PAVEMENT
 S.L.M. 89+85.87

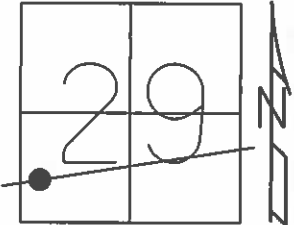

Grid: Northing: 617393.474 Easting: 1817655.998


RECORD: 9/27/1984
 STA. 761+15.30
 1933 PLANS
 2" IPIPE, 2" BELOW SURFACE
 ATOP IPIN

SET P.K./WASHER
 8/2/93, JLR

FD P.K./WASHER
 7/24/00

FD P.K./WASHER
 GPS, REF11
 12/6/12, SDC

SET MAG/WASHER
 NEWREFFA3
 6/30/15, DCH

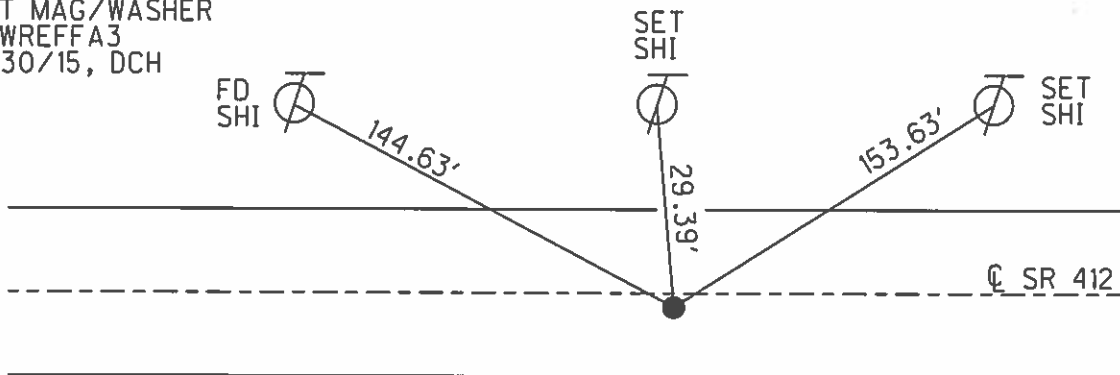

O.D.O.T. DISTRICT 2 SURVEY OFFICE (USE ONLY)

PERSONNEL

REFERENCE NO. 4

SHEET 16 OF 33

NOTES LEU

DATE 09-23-2014

ROUTE SR 412

H.C. HOMAN

WEATHER SUNNY

COUNTY SANDUSKY

R.C. LEU

TEMP. 65°

TOWNSHIP RILEY

SECTION 29

T 5 N R 16 E

TYPE MONUMENT P.K.NAIL


ON SURFACE - ~~BELOW~~ ON

LEFT - ℄ PAV'T - ~~RIGHT~~ 4.4'

6.5' TO LT. EDGE PAVEMENT

S.L.M. 113+52.65

Grid: Northing: 617998.360 Easting: 1819944.182

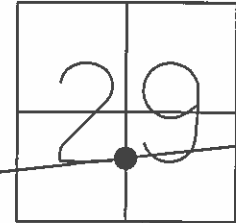

RECORD: 9/27/1984
1/2 MI.± ELY OF TR 204
POINT WAS SET BY OTHERS.
SET P.K./WASHER
ATOP R.R.SPIKE
4' LT.℄

SET P.K./WASHER
8/2/93, JLR

FD P.K./WASHER
GPS, REF12
12/6/12, SDC

SET MAG/WASHER
NEWREF4
6/30/15, DCH

FD
SHI

135.82'

120.71' REC

FD
SHI

℄ SR 412

166.96'


N-S 1/2 SEC. LINE

SET SHI
NW/FACE
6" WOOD
FECE POST

O.D.O.T. DISTRICT 2 SURVEY OFFICE (USE ONLY)

PERSONNEL	REFERENCE NO. <u>4 A</u>	SHEET <u>17</u> OF <u>33</u>
NOTES <u>LEU</u>	DATE <u>09-23-2014</u>	ROUTE <u>SR 412</u>
H.C. <u>HOMAN</u>	WEATHER <u>SUNNY</u>	COUNTY <u>SANDUSKY</u>
R.C. <u>LEU</u>	TEMP. <u>65°</u>	TOWNSHIP <u>RILEY</u>
		SECTION <u>29</u>
		T <u>5</u> N R <u>16</u> E

TYPE MONUMENT P.K./WASHER
 ON SURFACE - ~~BELOW~~ ON
~~LEFT - C~~ PAV'T - ~~RIGHT~~ ON
10' TO RT EDGE PAVEMENT
 S.L.M. 136+16.81

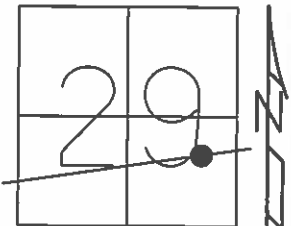

Grid: Northing: 618577.215 Easting: 1822133.098


RECORD: 9/27/1984
 100+36.70. 1932 PLAN
 SET P.K./WASHER
 ATOP IPIN
 ATOP IPIN

SET P.K./WASHER
 8/2/93, JLR

FD P.K./WASHER
 7/24/00

FD P.K./WASHER
 GPS, REF13
 12/6/12, SDC

SET MAG/WASHER
 NEWREFA4
 6/30/15, DCH

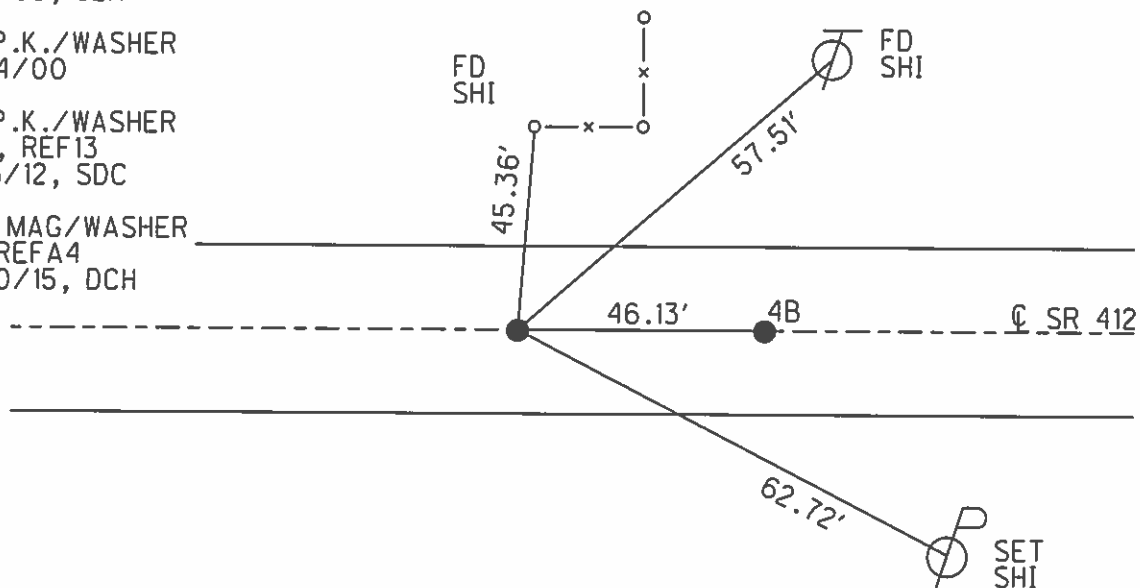

O.D.O.T. DISTRICT 2 SURVEY OFFICE (USE ONLY)

PERSONNEL

REFERENCE NO.

4 B

SHEET

18

OF 33

NOTES LEU

DATE

09-23-2014

ROUTE

SR 412

H.C. HOMAN

WEATHER

SUNNY

COUNTY

SANDUSKY

R.C. LEU

TEMP.

65°

TOWNSHIP

RILEY

SECTION

29

T 5 N R 16 E

TYPE MONUMENT P.K./WASHER


ON SURFACE - ~~BELOW~~ ON

~~LEFT~~ - CL PAV'T - ~~RIGHT~~ ON

10' TO RT EDGE PAVEMENT

S.L.M. 136+62.92

Grid: Northing: 618585.384 Easting: 1822178.476

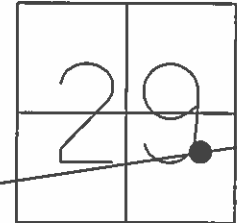


RECORD:

SET P.K./WASHER
8/2/93, JLR

SET P.K./WASHER
7/24/00

FD P.K./WASHER
GPS, REF14
12/6/12, SDC


SET MAG/WASHER
NEWREFB4
6/30/15, DCH

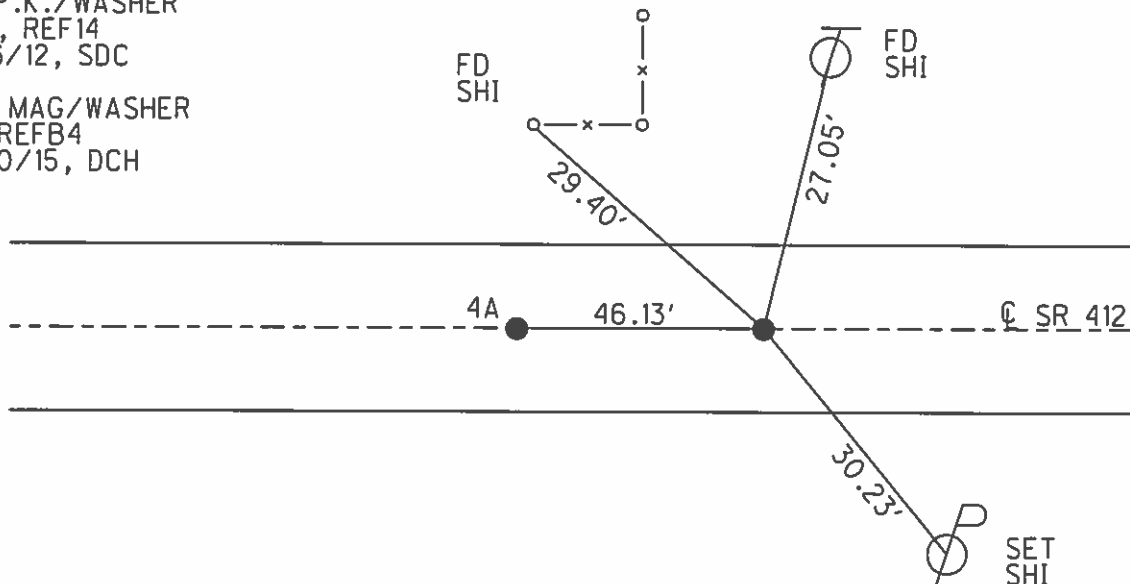

O.D.O.T. DISTRICT 2 SURVEY OFFICE (USE ONLY)

PERSONNEL _____ REFERENCE NO. 5 SHEET 19 OF 33
 NOTES LEU DATE 09-23-2014 ROUTE SR 412
 H.C. HOMAN WEATHER SUNNY COUNTY SANDUSKY
 R.C. LEU TEMP. 72° TOWNSHIP RILEY
 SECTION 29
 T 5 N R 16 E

TYPE MONUMENT MAG NAIL
 ON SURFACE - ~~BELOW~~ ON _____
~~LEFT~~ - ℄ PAV'T - RIGHT 3.6'
7.5' TO RT EDGE PAVEMENT
 S.L.M. 141+13.82
 Grid: Northing: _____ Easting: _____

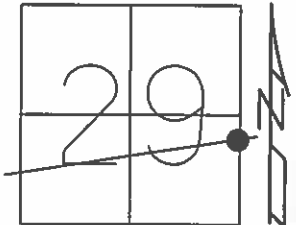


RECORD: 10/11/1984
 POINT ON N-S SEC. LINE
 FR/PRIVATE SURVEY MAY
 BE ON ARC OF CURVE.
 SET P.K./WASHER
 3' RT OF ℄

SET P.K./WASHER
 8/2/93, JLR

FD P.K./WASHER
 7/24/00

FD MAG NAIL
 REF5
 9/23/14, DCH

SET MAG/WASHER
 NEWREF5
 6/30/15, DCH

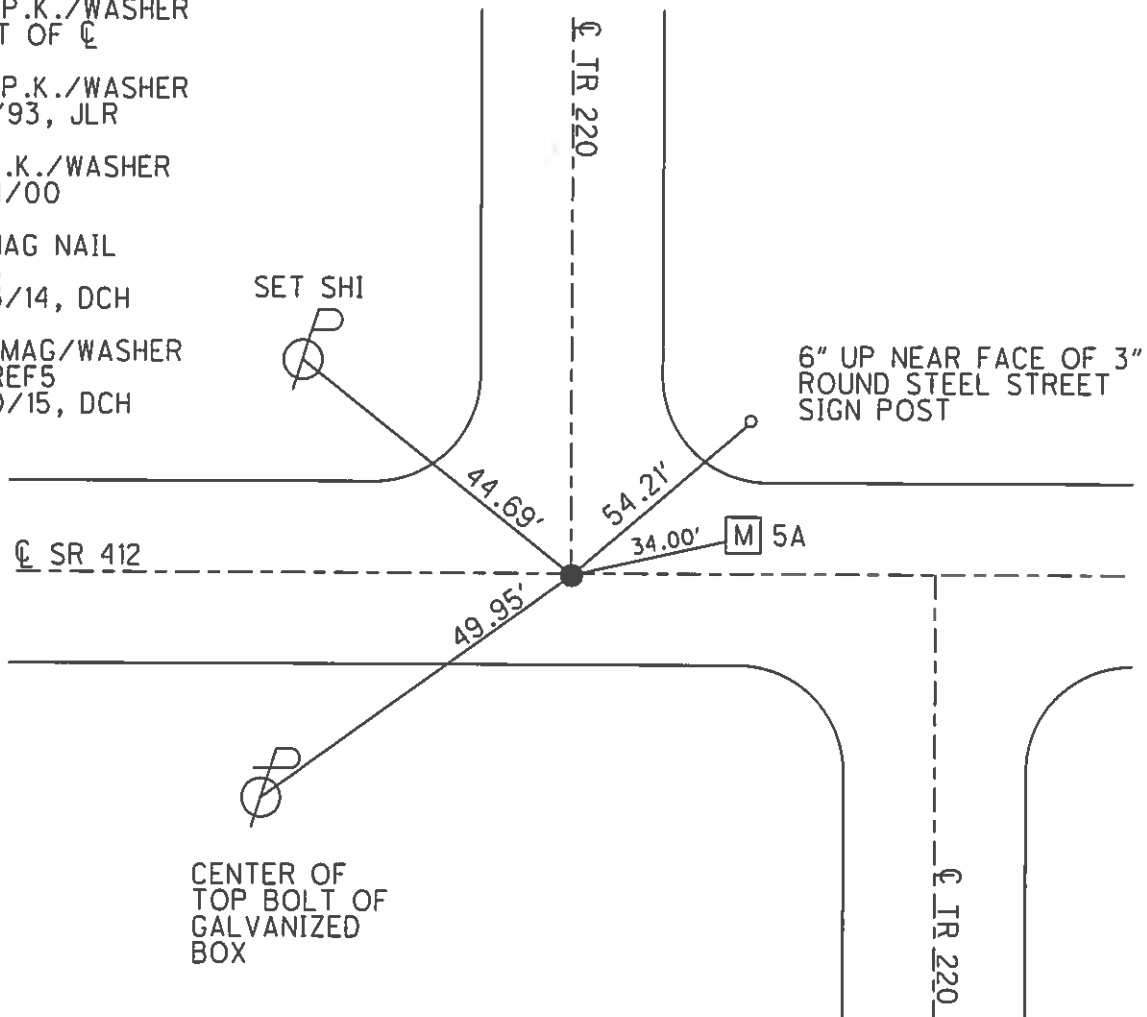


O.D.O.T. DISTRICT 2 SURVEY OFFICE (USE ONLY)

PERSONNEL	REFERENCE NO. <u>5 A</u>	SHEET <u>20</u> OF <u>33</u>
NOTES <u>LEU</u>	DATE <u>09-23-2014</u>	ROUTE <u>SR 412</u>
H.C. <u>HOMAN</u>	WEATHER <u>SUNNY</u>	COUNTY <u>SANDUSKY</u>
R.C. <u>LEU</u>	TEMP. <u>72°</u>	TOWNSHIP <u>RILEY</u>
		SECTION <u>28</u>
		T <u>5</u> N R <u>16</u> E

TYPE MONUMENT MONBOX, 1" I. PIN
 ON SURFACE - ~~BELOW~~ ON
 LEFT - ☑ PAV'T - ~~RIGHT~~ 6'
3.5' TO LT. EDGE PAVEMENT
 S.L.M. 141+13.82

Grid: Northing: 618707.753 Easting: 1822612.448

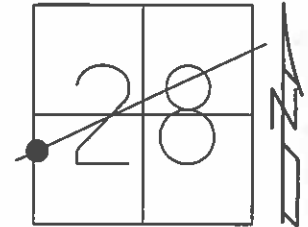


RECORD: 10-11-1984
 105+33.70 (S.H. 281 SEC. T, BR.)
 (1932) SET PK & WASHER ATOP
 BOAT SPIKE 7.0± LT. ☑ PAVEMENT

SET P.K./WASHER
 8/2/93, JLR

FD MONBOX
 REF15
 12/6/12, SDC

FD MONBOX
 W/ 3/4" IPIN
 NEWREFA5
 6/30/15, DCH

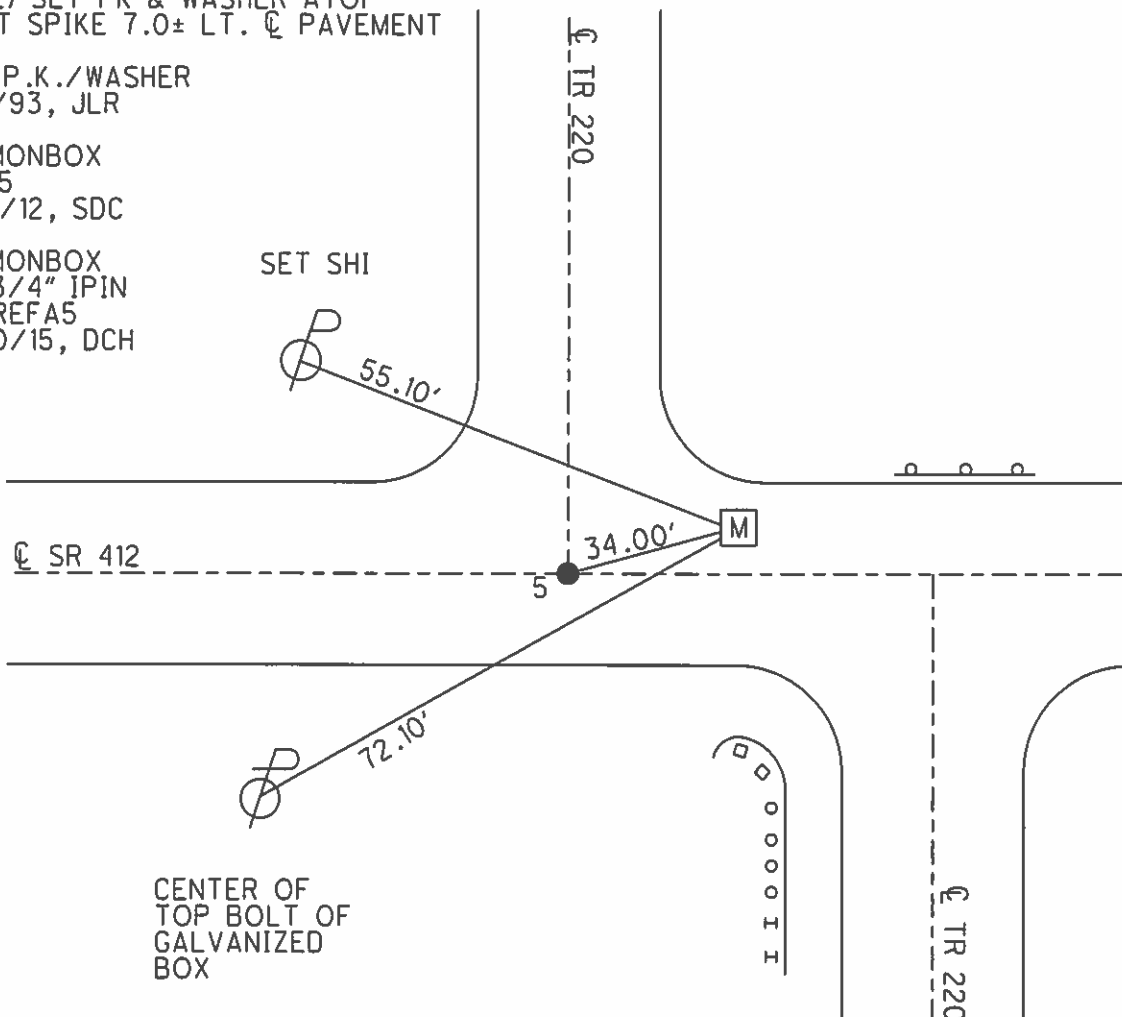

O.D.O.T. DISTRICT 2 SURVEY OFFICE (USE ONLY)

PERSONNEL

REFERENCE NO.

5 B

SHEET 21 OF 33

NOTES LEU

DATE 7/1/15

ROUTE SR 412

H.C. HOMAN

WEATHER SUNNY

COUNTY SANDUSKY

R.C. LEU

TEMP. 70°

TOWNSHIP RILEY

SECTION 28

T 5 N R 16 E

TYPE MONUMENT MAG/WASHER


ON SURFACE - ~~BELOW~~ ON

LEFT - ~~Q~~ PAV'T - ~~RIGHT~~ ON


- TO - EDGE PAVEMENT

S.L.M. 142+08.16

Grid: Northing: - Easting: -

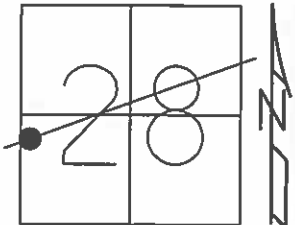

SET MAG/WASHER
NEWREFB5
7/1/15, DCH

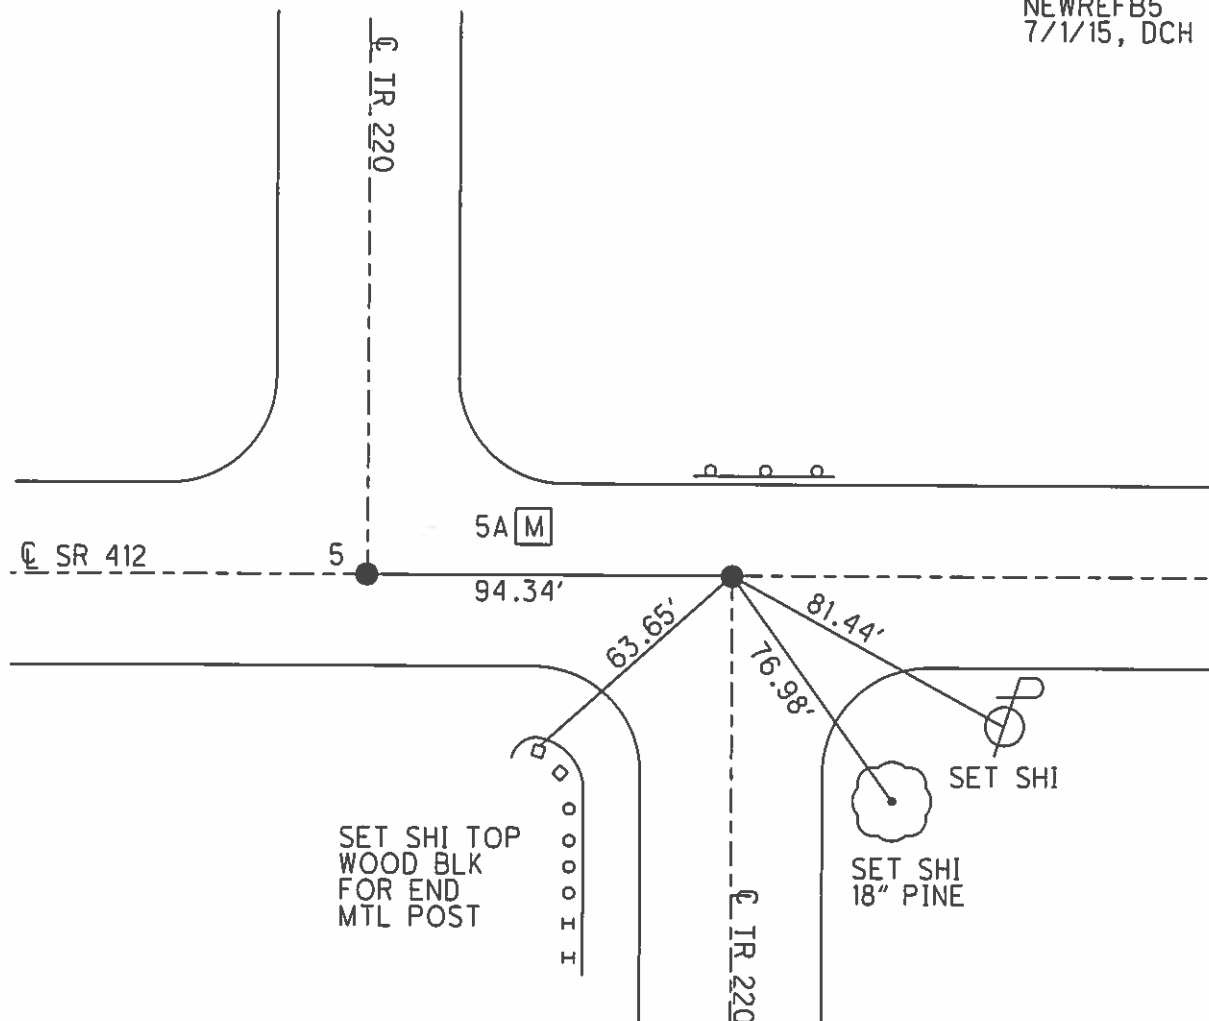

O.D.O.T. DISTRICT 2 SURVEY OFFICE (USE ONLY)

PERSONNEL

REFERENCE NO. 6

SHEET 22 OF 33

NOTES MILLER
H.C. MILLER
R.C. BARRIERE

DATE 9/3/24
WEATHER SUNNY
TEMP. 70°

ROUTE SR 412
COUNTY SANDUSKY
TOWNSHIP RILEY
SECTION 28
T 5 N R 16 E

DWG BY PRESTON-COLVIN PID PAVING TRAIN

TYPE MONUMENT MAG/WASHER

ON SURFACE - BELOW ON

OFFSET Q PAVEMENT ON LT : RT
9' TO RT EDGE PAVEMENT

STATION: 145+10.60

HORIZ.DATUM: NAD83 (2011)


GEOID: 18

GRID: NORTHING: 618757.593

EASTING: 1823006.085

LDP: NORTHING: 314905.1623

EASTING: 183246.6206

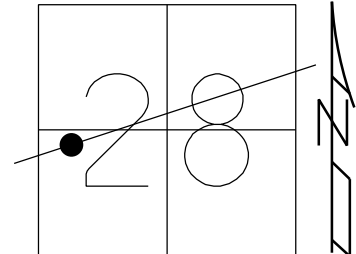

RECORD: 10-11-1984
109+29.60 (S.H. 281 SEC. T. BR.)
1932 SET PK & WASHER ATOP
GALVINIZED BOLT ATOP I. PIN

SET P.K./WASHER
8/2/93, JLR

FD P.K./WASHER
REF16
12/11/12, JMR

SET MAG/WASHER
NEWREF6
7/1/15, DCH

FD MAG/WASHER
REF6
9/3/24, JAM


FD MAG/WASHER
10/3/24, JAM

RESET SAWCUT
@ FND. "X" CUT

SET SHI
8" MAPLE

SET SHI
12" OAK

FND. SHI

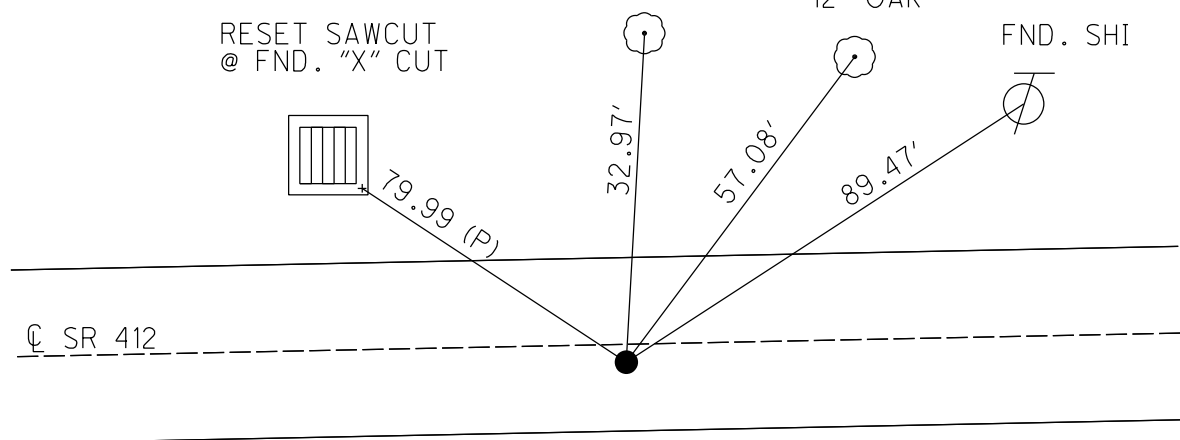

O.D.O.T. DISTRICT 2 SURVEY OFFICE (USE ONLY)

PERSONNEL

REFERENCE NO. 6A

SHEET 23 OF 33

NOTES MILLER

DATE 10/11/24

ROUTE SR 412

H.C. MILLER

WEATHER SUNNY

COUNTY SANDUSKY

R.C. BARRIERE

TEMP. 70°

TOWNSHIP RILEY

NEISE

SECTION 28

DWG BY PRESTON-COLVIN PID PAVING TRAIN

T 5 N R 16 E

TYPE MONUMENT MAG/WASHER

ON SURFACE - ~~BELOW~~ ON

OFFSET Q PAVEMENT 10' ~~LT~~ : RT

0' TO RT EDGE PAVEMENT

STATION: 181+05.26

HORIZ.DATUM: NAD83 (2011)


GEOID: 18

GRID: NORTHING: 619196.360

EASTING: 1826574.018

LDP: NORTHING: 315368.4529

EASTING: 186811.7762

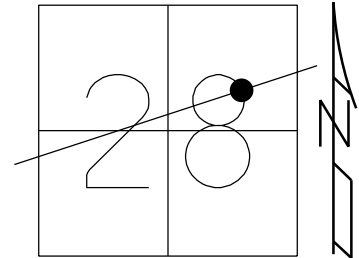

RECORD: 02-04-1975
P.O.T. ROUND 2 RR SPK.S ON N/E R
SPIKE TO SOUTH ON Q 1.17 APART


SET P.K./WASHER
8/2/93, JLR


FD P.K./WASHER
REF17
12/11/12, JMR

SET MAG/WASHER
NEWREFA6
7/1/15, DCH

FD MAG/WASHER
REF6A
9/3/24, JAM

SET MAG
10/11/24, JAM

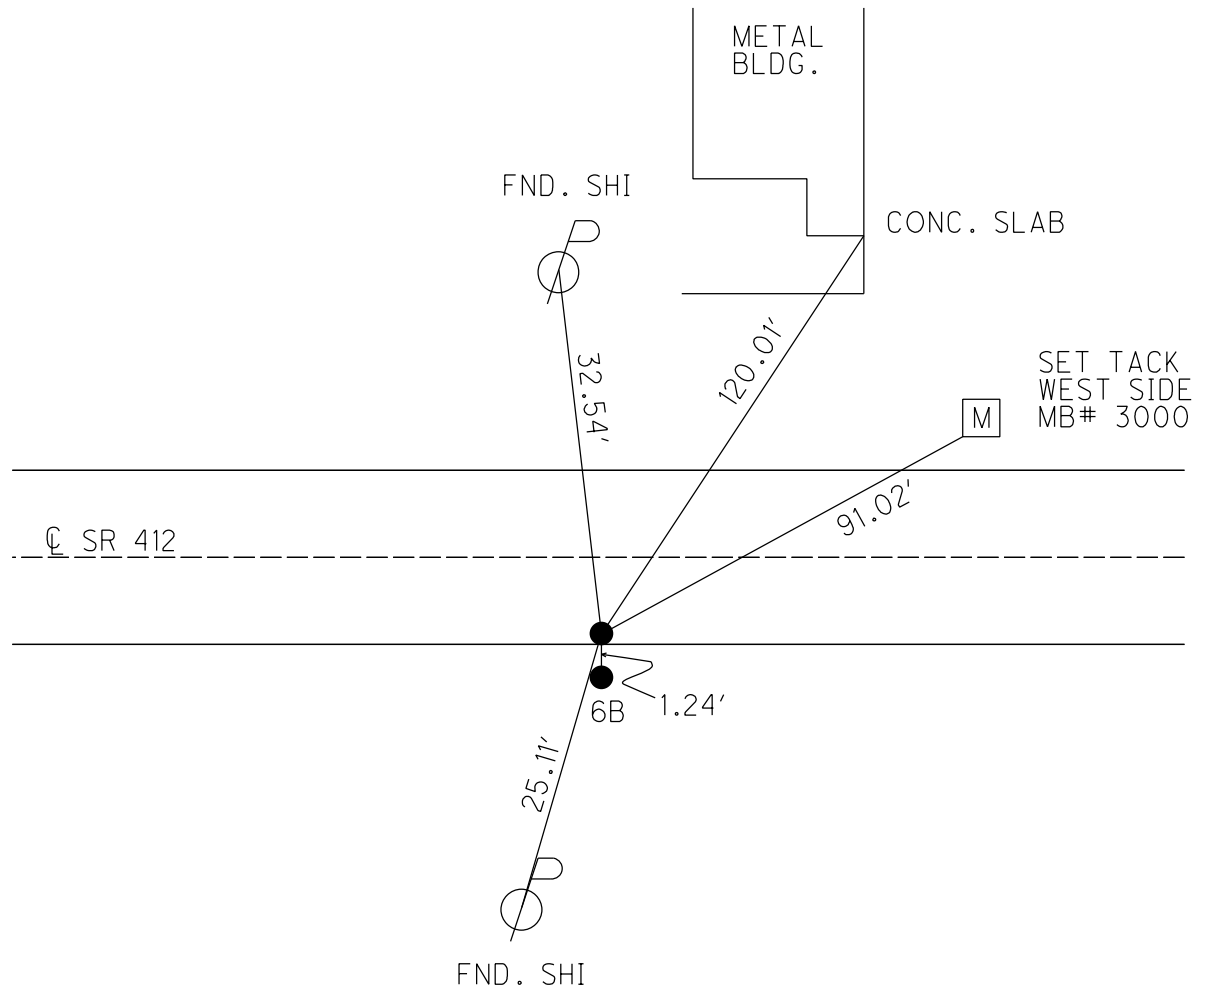

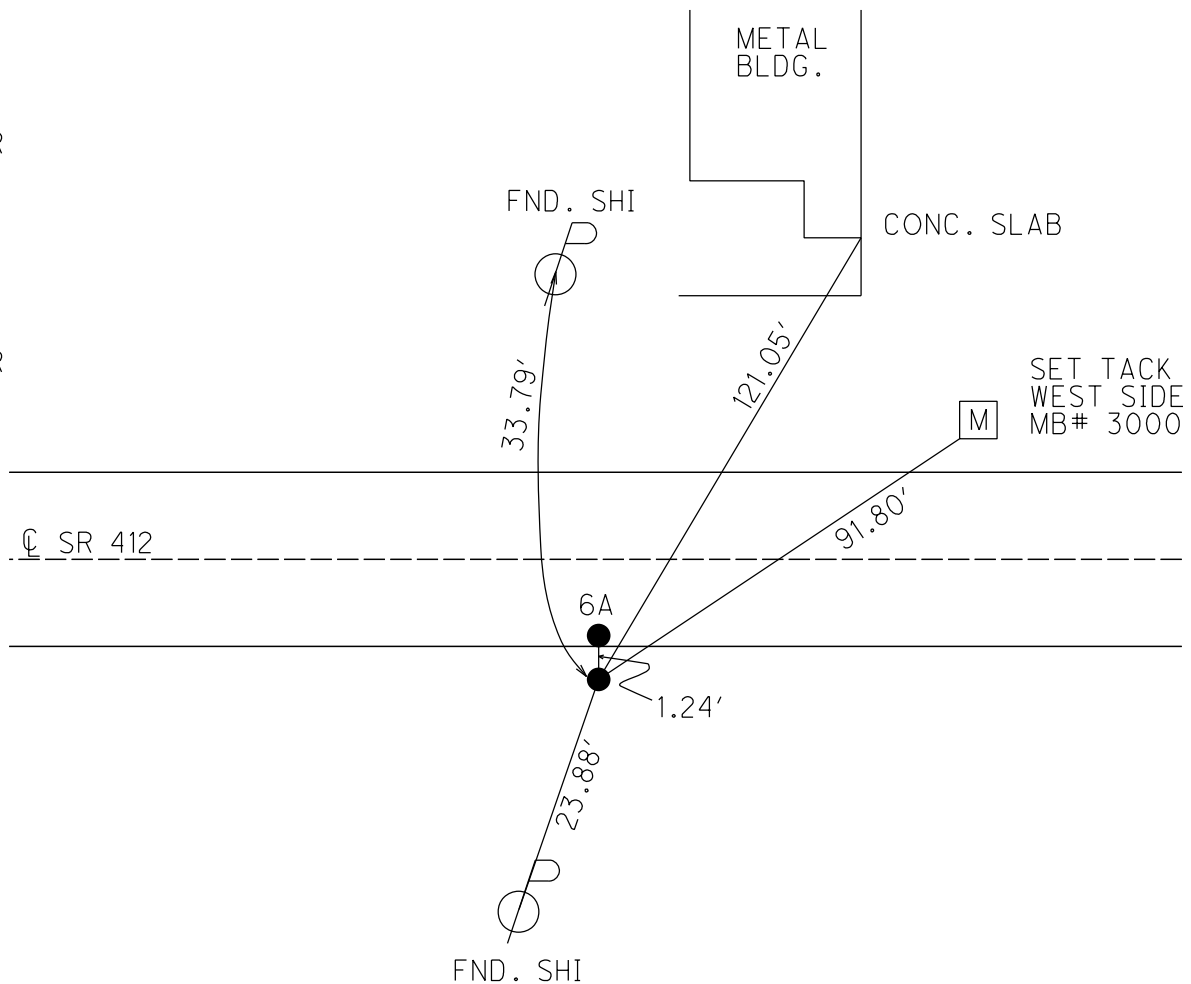

O.D.O.T. DISTRICT 2 SURVEY OFFICE (USE ONLY)

PERSONNEL

REFERENCE NO. 7

SHEET 25 OF 33

NOTES MILLER
H.C. MILLER
R.C. BARRIERE

DATE 9/3/24
WEATHER SUNNY
TEMP. 65°

ROUTE SR 412
COUNTY SANDUSKY
TOWNSHIP RILEY
SECTION 28

T 5 N R 16 E

DWG BY PRESTON-COLVIN PID PAVING TRAIN

TYPE MONUMENT MAG/SHANK

ON SURFACE - ~~BELOW~~ ON

OFFSET $\varnothing$ PAVEMENT 3.5' ~~LT~~ : RT

6.5' TO LT EDGE PAVEMENT

STATION: 181+05.26

HORIZ.DATUM: NAD83 (2011)


GEOID: 18

GRID: NORTHING: 619358.120

EASTING: 1827902.789

LDP: NORTHING: 315539.5217

EASTING: 188139.4004

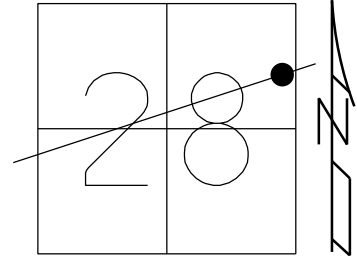

RECORD: 10-11-1984
P.I.
SET P.K./WASHER
ATOP IPIN, ATOP IPIPE
3.5' LT OF $\varnothing$


SET P.K./WASHER
8/2/93, JLR

FD P.K.NAIL
REF19
12/11/12, JMR

SET MAG/WASHER
NEWREF7
7/1/15, DCH

FD MAG SHANK
REF7
9/3/24, JAM

FD MAG SHANK
10/3/24, JAM

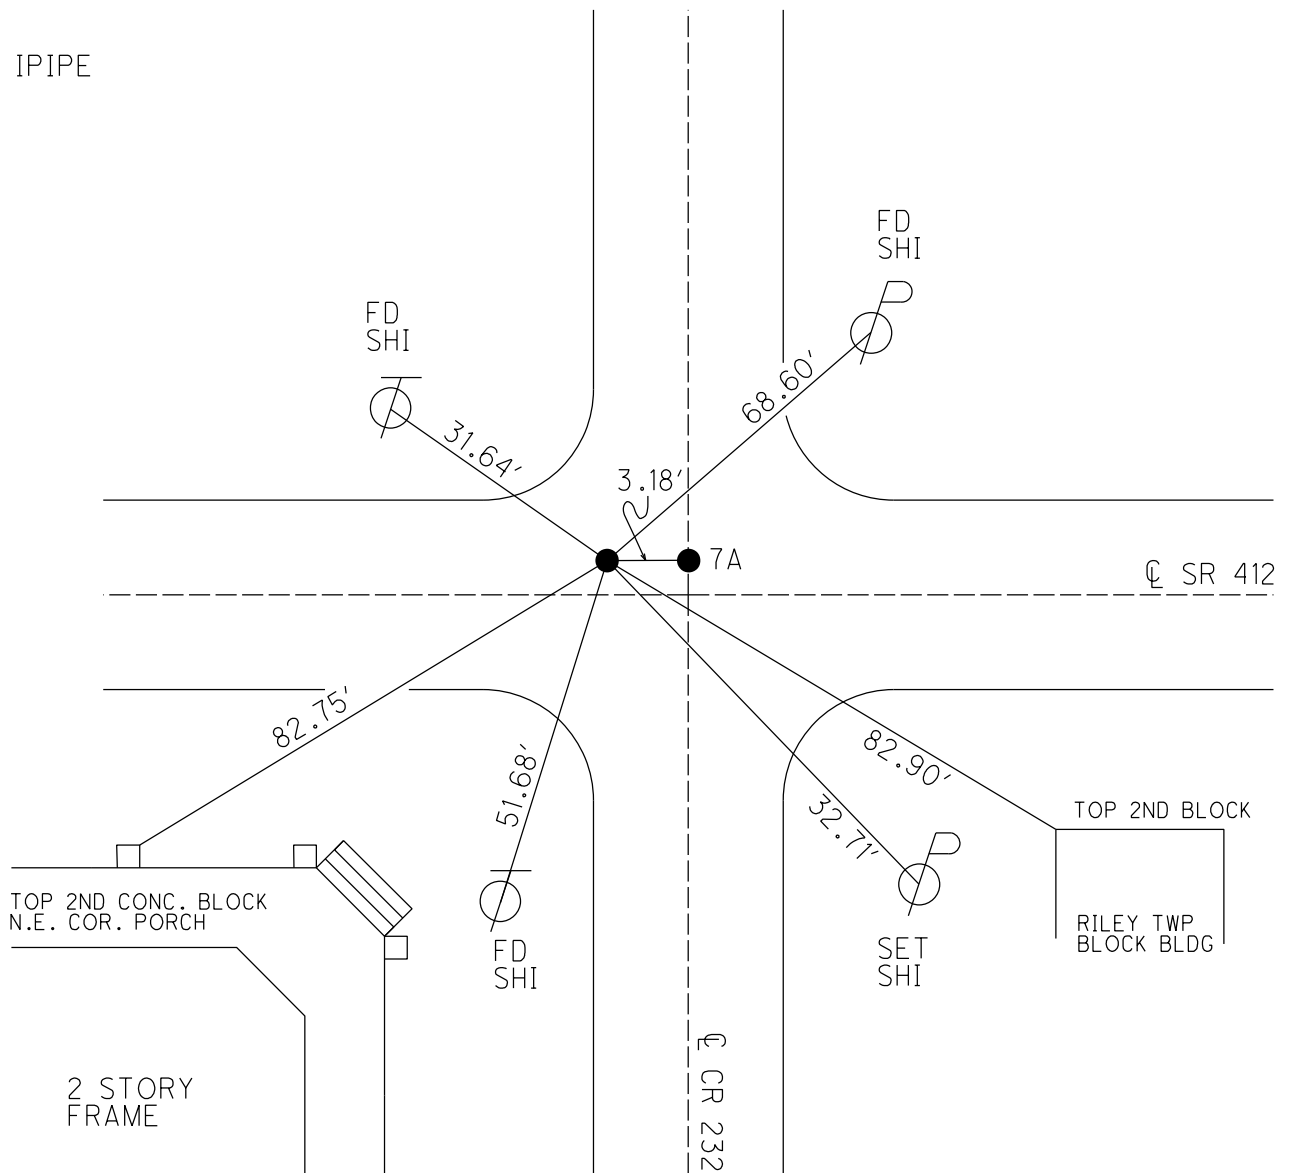

O.D.O.T. DISTRICT 2 SURVEY OFFICE (USE ONLY)

PERSONNEL

REFERENCE NO. 7A

SHEET 26 OF 33

NOTES MILLER
H.C. MILLER
R.C. BARRIERE

DATE 9/3/24
WEATHER SUNNY
TEMP. 65°

ROUTE SR 412
COUNTY SANDUSKY
TOWNSHIP RILEY
SECTION 28

T 5 N R 16 E

DWG BY PRESTON-COLVIN PID PAVING TRAIN

TYPE MONUMENT MAG NAIL

ON SURFACE - ~~BELOW~~ ON

OFFSET ϕ PAVEMENT 3.5' LT : ~~RT~~

6.5' TO LT EDGE PAVEMENT

STATION: 181+05.26

HORIZ.DATUM: NAD83 (2011)


GEOID: 18

GRID: NORTHING: 619358.814

EASTING: 1827905.896

LDP: NORTHING: 315540.2046

EASTING: 188142.5459

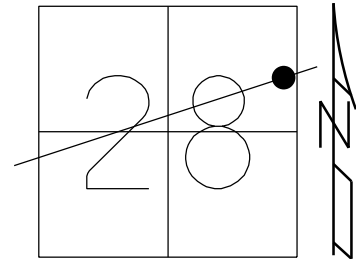

RECORD: 10-11-1984
ON SEC. LINE SET PK & WASHER
ATOP R.R. SPK. FROM COUNTY
REFERENCES APPEARS TO BE ON
BACK TANG OF SR 412 PRODUCED
EASTERLY 3.5'± LT. OF ϕ OF PAVM'T


SET P.K./WASHER
8/2/93, JLR

FD P.K./WASHER
REF20
12/11/12, JMR

SET MAG WASHER
NEWREFA7
7/1/15, DCH

FD MAG/WASHER
REF7A
9/3/24, JAM

FD MAG/WASHER
10/3/24, JAM

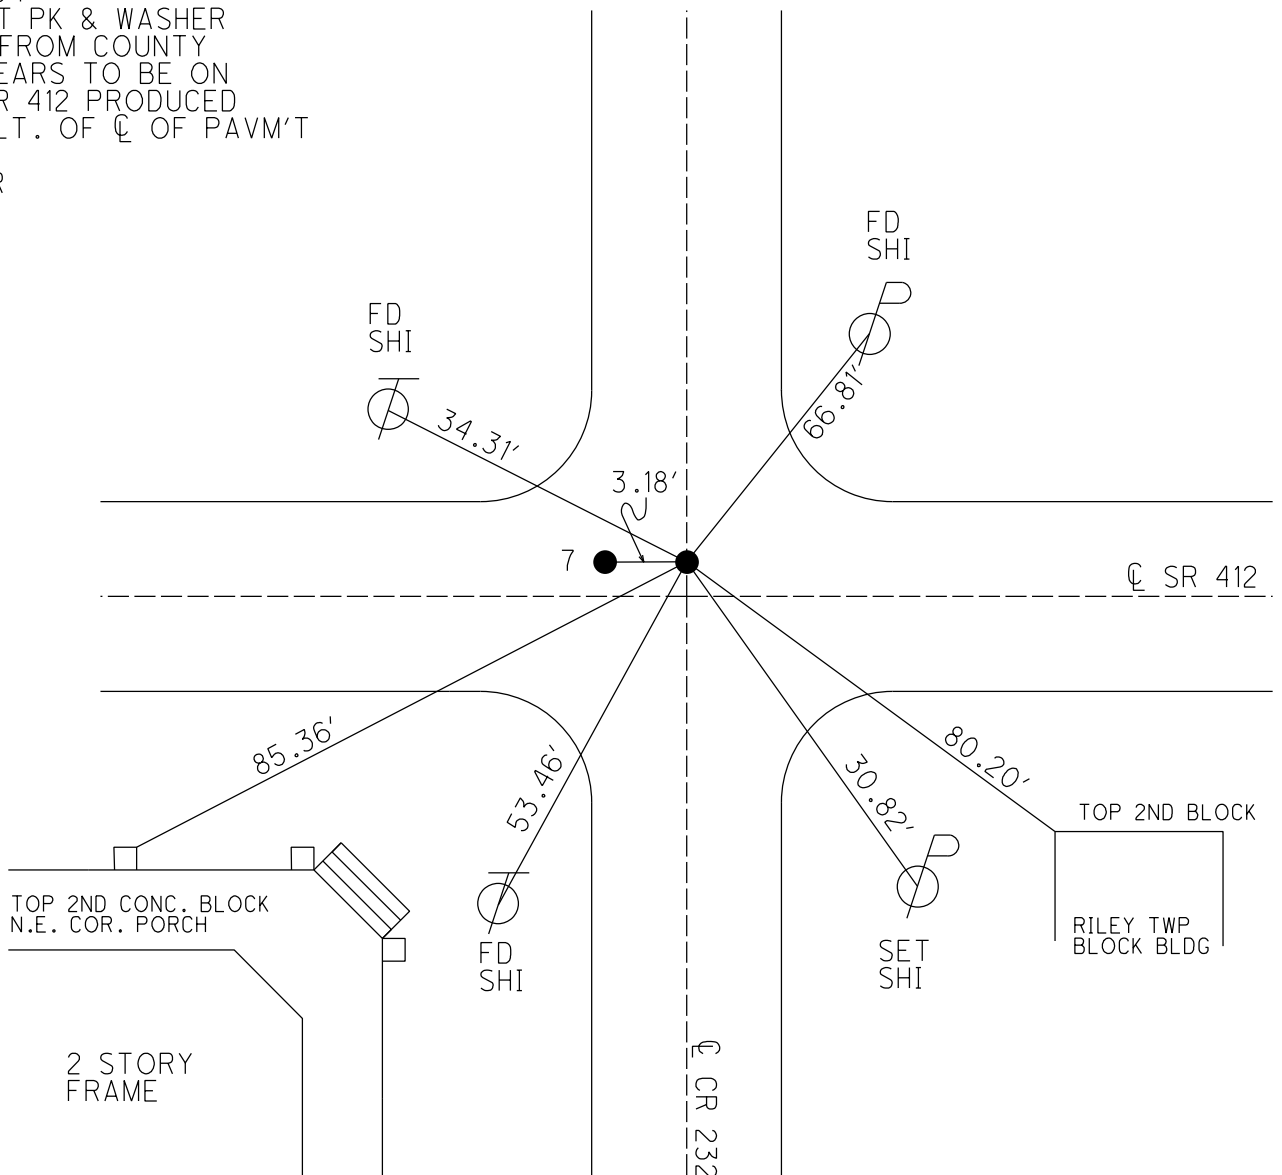

O.D.O.T. DISTRICT 2 SURVEY OFFICE (USE ONLY)

PERSONNEL

REFERENCE NO. 8

SHEET 27 OF 33

NOTES MILLER
H.C. MILLER
R.C. BARRIERE

DATE 9/3/24
WEATHER SUNNY
TEMP. 57°

ROUTE SR 412
COUNTY SANDUSKY
TOWNSHIP RILEY
SECTION 27

DWG BY PRESTON-COLVIN PID PAVING TRAIN

T 5 N R 16 E

TYPE MONUMENT MAG NAIL

ON SURFACE - ~~BELOW~~ ON

OFFSET CL PAVEMENT 1.6' ~~LT~~ : RT

8' TO RT EDGE PAVEMENT

STATION: 221+15.03

HORIZ.DATUM: NAD83 (2011)


GEOID: 18

GRID: NORTHING: 619677.843

EASTING: 1830554.613

LDP: NORTHING: 315876.2524

EASTING: 190788.6178

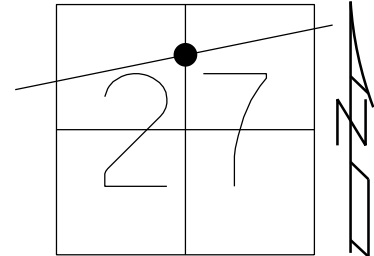

RECORD: 02-04-1975
FND IRON PIN BELOW SURFACE
SET IRON PIPE ATOP & TO THE
SURFACE 2'± RT. OF CL

FD IPIPE W/P.K. IN CTR
4/28/93, CHENEY


SET P.K./WASHER
8/2/93, JLR

FD MAG NAIL
REF21
12/11/12, JMR

SET MAG/WASHER
NEWREF8
7/1/15, DCH

FD MAG SHANK
REF8
9/3/24, JAM

SET MAG NAIL
10/3/24, JAM

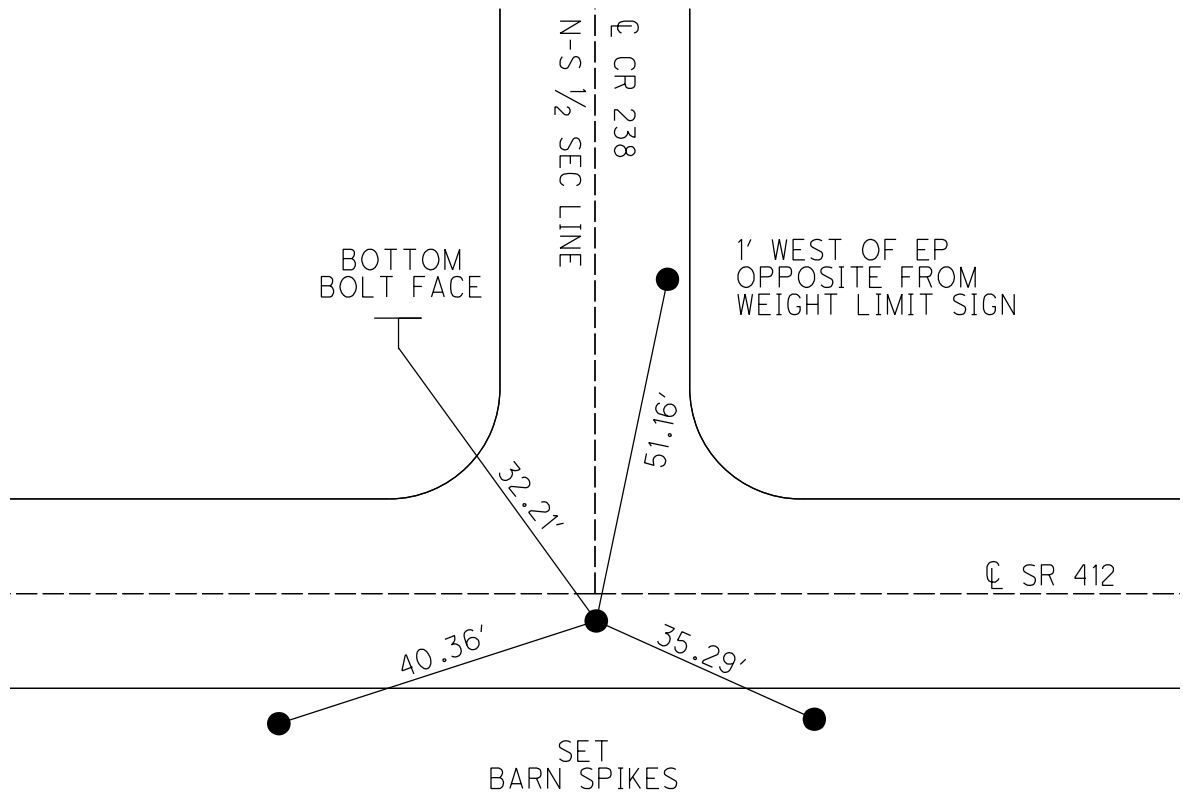

O.D.O.T. DISTRICT 2 SURVEY OFFICE (USE ONLY)

PERSONNEL

REFERENCE NO. 8A

SHEET 28 OF 33


NOTES HOMAN
H.C. WESTFALL
R.C. RHOADES
LEU

DATE 10-09-2014
WEATHER CLOUDY
TEMP. 55°

ROUTE SR 412
COUNTY SANDUSKY
TOWNSHIP RILEY
SECTION 27
T 5 N R 16 E

TYPE MONUMENT P.K.NAIL
ON SURFACE - ~~BELOW~~ ON
LEFT - CL PAV'T - ~~RIGHT~~ 0.8'
10' TO RT EDGE PAVEMENT
S.L.M. 231+37.62

Grid: Northing: 619794.658 Easting: 1831570.510

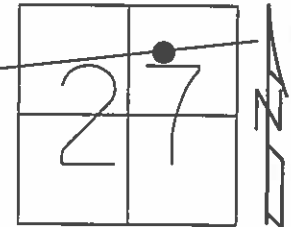



RECORD: 02-04-1975
SET IRON PIPE ATOP OF
OLD POINT TO THE
SURFACE 0.2'
EAST OF CR 238

FD PIPE
2" DOWN
4/28/93, CHENEY

SET P.K./WASHER
8/2/93, JLR

FD P.K.NAIL
REF22
12/11/12, JMR

SET MAG/WASHER
NEWREFA8
7/1/15, DCH

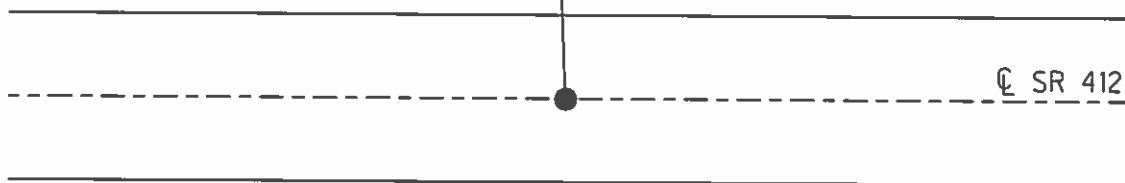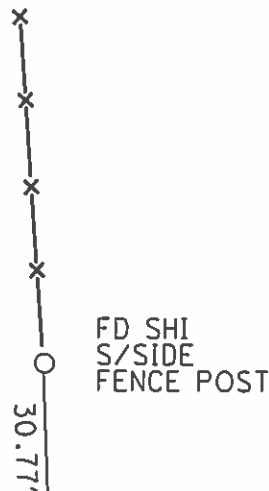

O.D.O.T. DISTRICT 2 SURVEY OFFICE (USE ONLY)

PERSONNEL

REFERENCE NO.

8 B

SHEET

29

OF 33

NOTES HOMAN

H.C. LEU

R.C. WESTFALL

RHOADES

DATE

10-09-2014

WEATHER

SUNNY

TEMP.

55°

ROUTE

SR 412

COUNTY

SANDUSKY

TOWNSHIP

RILEY

SECTION

27

T 5 N

R 16 E

TYPE MONUMENT P.K./WASHER


ON SURFACE - ~~BELOW~~ ON

LEFT - C PAV'T - ~~RIGHT~~ 1'

10' TO RT EDGE PAVEMENT

S.L.M. 235+80.21

Grid: Northing: 619845.711 Easting: 1832010.138

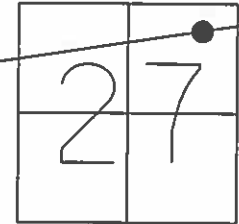


RECORD: 02-04-1995
4+42 FD IPIPE 5" BELOW SURFACE.
SET GALVANIZED BOLT
ATOP & TO THE SURFACE. POINT
IS 100'± EAST OF RACCOON CREEK
BRIDGE. THIS IS 4+42 AS SHOWN
ON SH 281 SEC T BRIDGE 1929 PLANS

FD P.K.NAIL
REF23
12/11/12, JMR

SET MAG/WASHER
NEWREFB8
7/1/15, DCH

ODOT DISK
ON HEADWALL

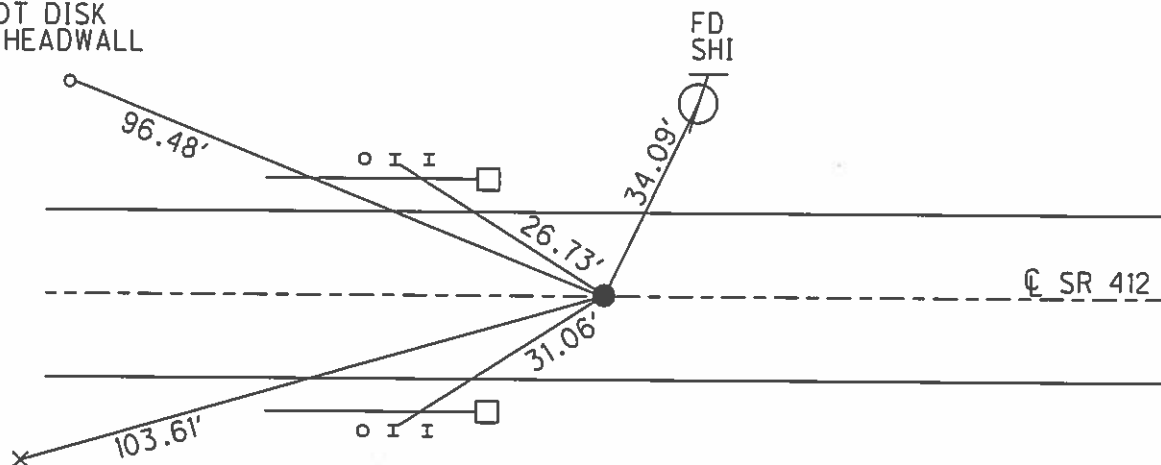

CHISLED "X"
ON WINGWALL

NOTE: USED NEAR
COR'S STEEL
GR POST

O.D.O.T. DISTRICT 2 SURVEY OFFICE (USE ONLY)

PERSONNEL

REFERENCE NO. 9

SHEET 30 OF 33

NOTES HOMAN

DATE 10-09-2014

ROUTE SR 412

H.C. WESTFALL

WEATHER CLOUDY

COUNTY SANDUSKY

R.C. LEU

TEMP. 55°

TOWNSHIP RILEY

RHOADES

SECTION 27

DWG BY NIESE PID 95765

T 5 N R 16 E

TYPE MONUMENT MAG/WASHER

~~ON SURFACE~~ - BELOW 3"

OFFSET CL PAVEMENT ON LT : RT

10' TO RT EDGE PAVEMENT



STATION: 246+86

HORZ.DATUM: NAD83(2011)

GEOID: 2012A

GRID: NORTHING: 619984.562

EASTING: 1833209.508

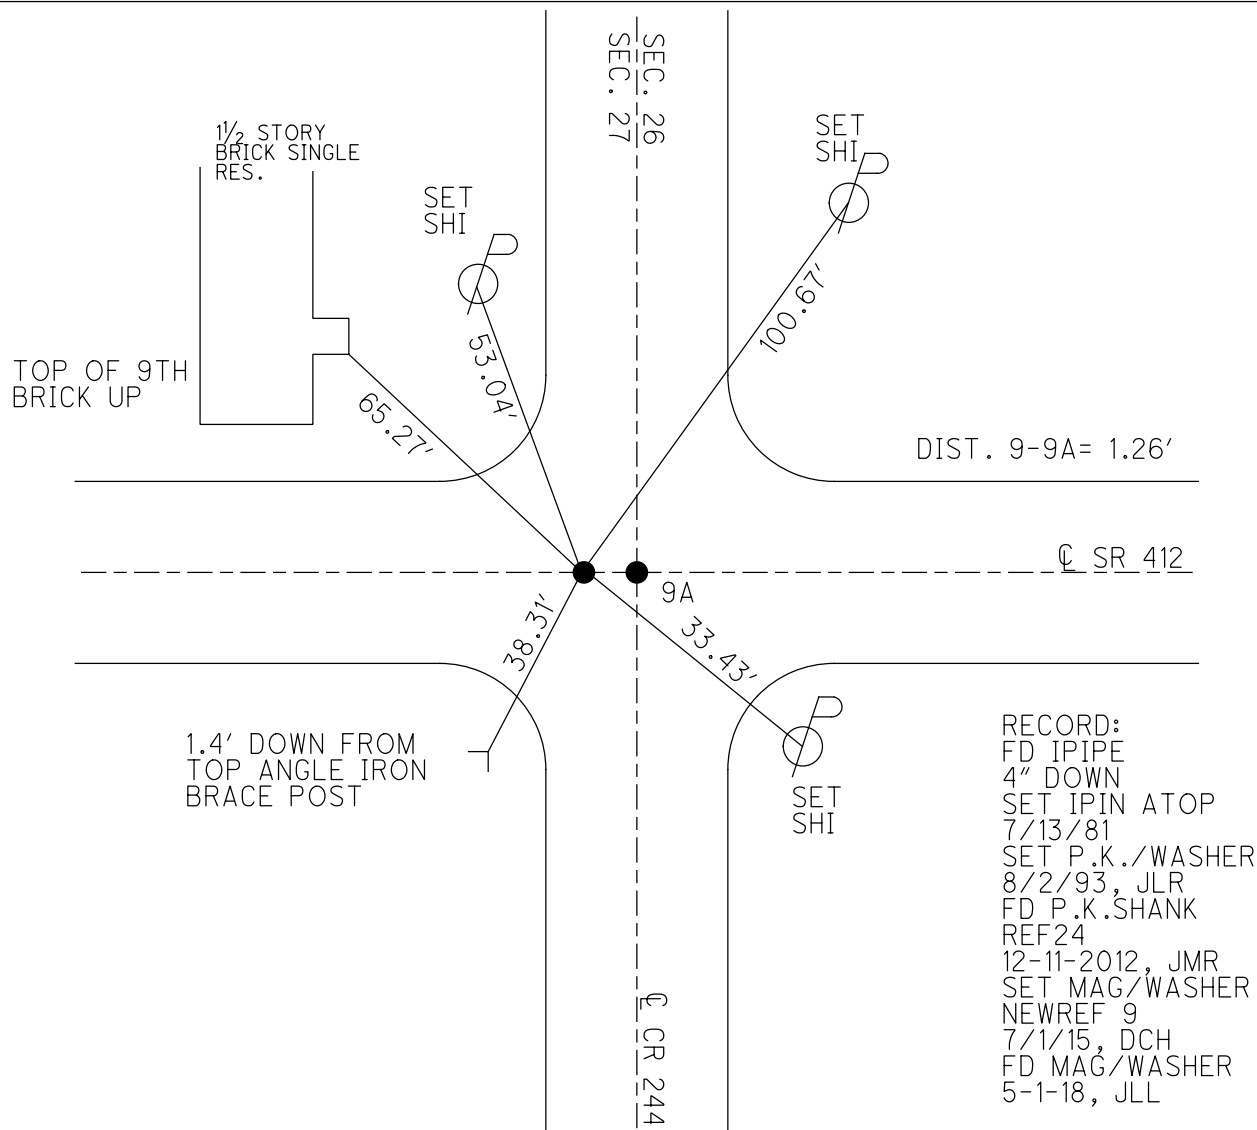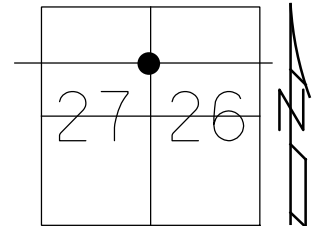

O.D.O.T. DISTRICT 2 SURVEY OFFICE (USE ONLY)

PERSONNEL

REFERENCE NO. 9A

SHEET 31 OF 33

NOTES HOMAN

DATE 10-09-2014

ROUTE SR 412

H.C. WESTFALL

WEATHER CLOUDY

COUNTY SANDUSKY

R.C. LEU

TEMP. 55°

TOWNSHIP RILEY

RHOADES

SECTION 27

DWG BY NIESE

PID 95765

T 5 N R 16 E

TYPE MONUMENT MAG/WASHER

~~ON SURFACE~~ - BELOW ON

OFFSET CL PAVEMENT ON LT : RT

10' TO RT EDGE PAVEMENT



STATION: 246+87

HORZ.DATUM: NAD83(2011)

GEOID: 2012A

GRID: NORTHING: 619984.720

EASTING: 1833210.767

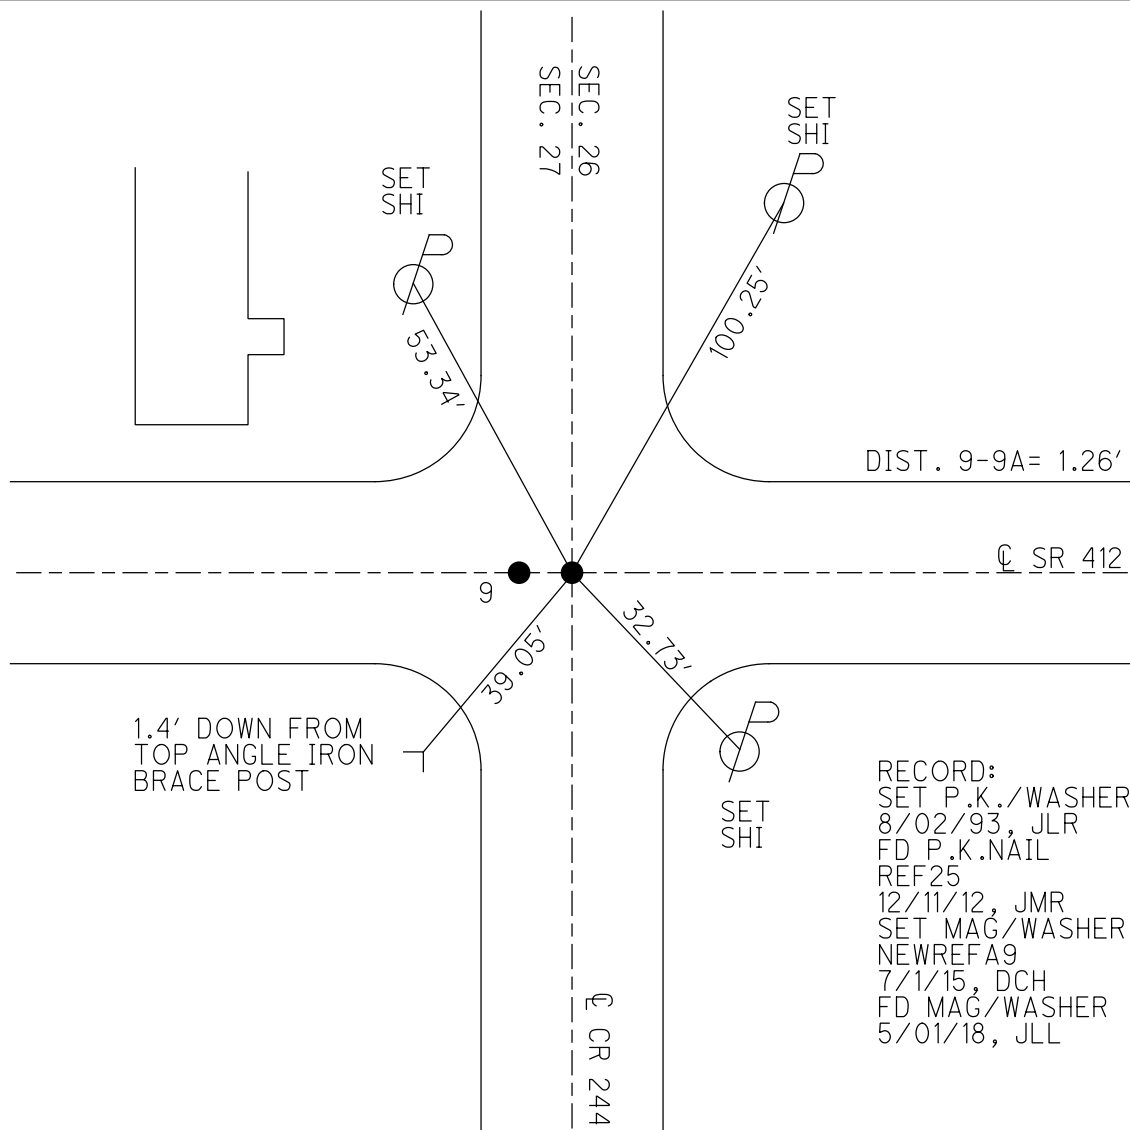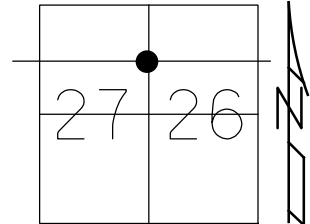

O.D.O.T. DISTRICT 2 SURVEY OFFICE (USE ONLY)

PERSONNEL

REFERENCE NO. 1

SHEET 1 OF 2

NOTES RHOADES

DATE 1/17/13

ROUTE CR 244

H.C. RHOADES

WEATHER PTLY.CLOUDY

COUNTY SANDUSKY

R.C. LAU

TEMP. 35°

TOWNSHIP RILEY

SECTION 26

T 5 N R 16 E

TYPE MONUMENT " IPIN IN 4" IPIPE


~~ON SURFACE~~ - BELOW 3"

LEFT - Q PAV'T - ~~RIGHT~~ 1'


TO EDGE PAVEMENT

S.L.M. N.OF (248+16 SR 412)

GRID: NORTHING: 621639.816 EASTING: 1833243.537

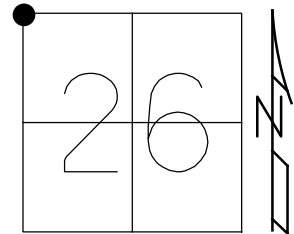

GPS, SV3503

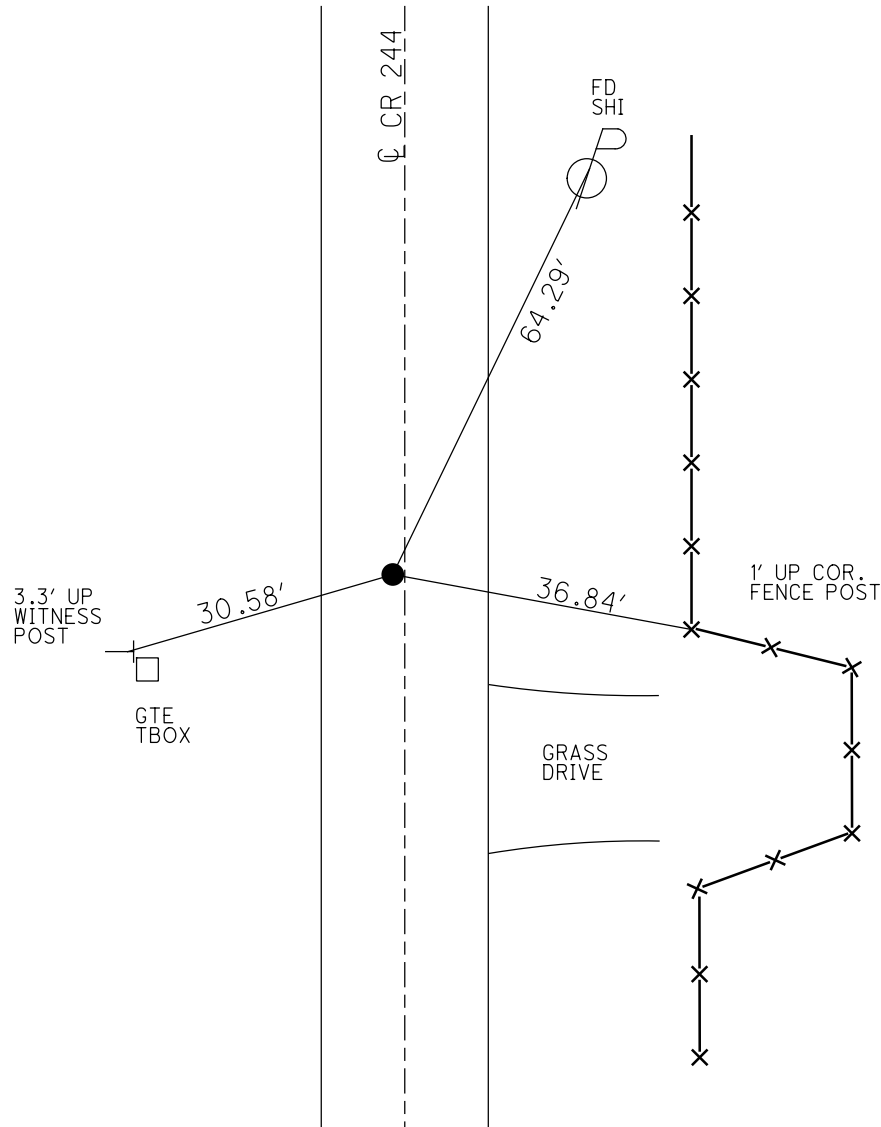

O.D.O.T. DISTRICT 2 SURVEY OFFICE (USE ONLY)

PERSONNEL

REFERENCE NO. 2

SHEET 2 OF 2

NOTES RHOADES

DATE 1/17/13

ROUTE CR 244

H.C. RHOADES

WEATHER PTLY.CLOUDY

COUNTY SANDUSKY

R.C. LAU

TEMP. 35°

TOWNSHIP RILEY

SECTION 26

T 5 N R 16 E

TYPE MONUMENT " IPIN


~~ON SURFACE~~ - BELOW 4"

LEFT - Q PAV'T - ~~RIGHT~~ 1'

5.44' TO LT EDGE PAVEMENT


S.L.M. S.OF (248+16 SR 412)

GRID: NORTHING: 618990.829 EASTING: 1833184.727

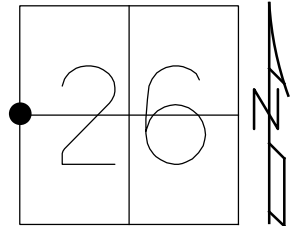

GPS, SV3289

NORTHERNMOST
NEAR CORNERS
OF HEADWALLS

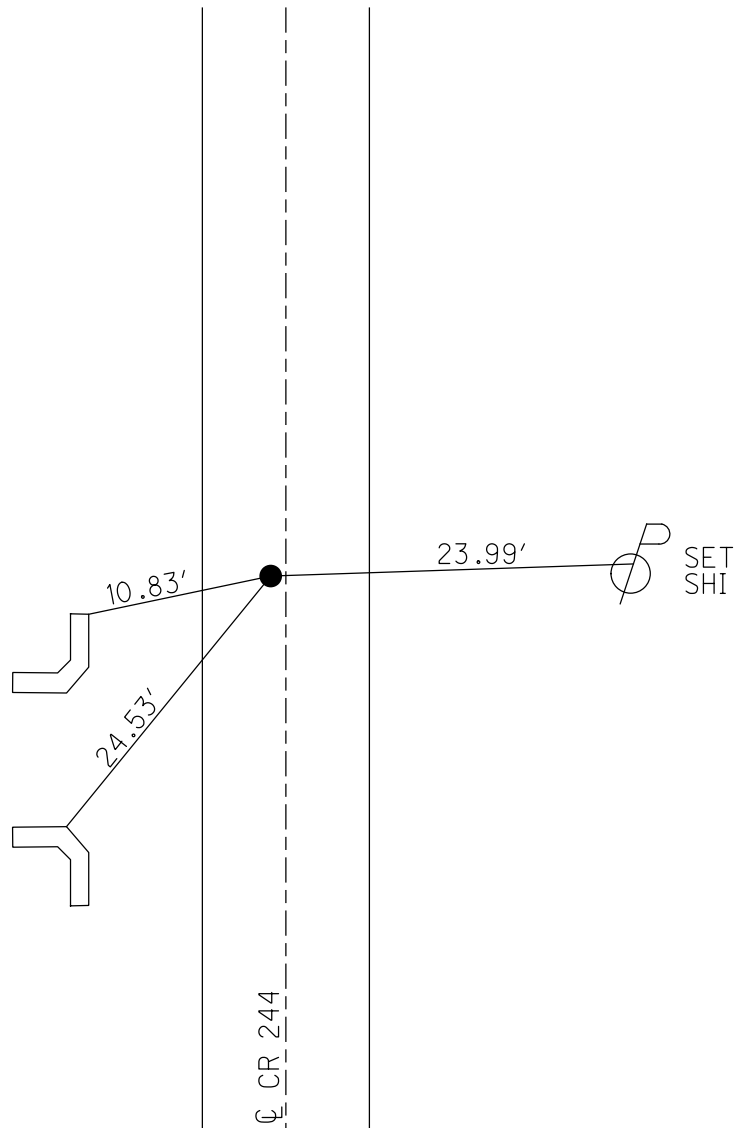

O.D.O.T. DISTRICT 2 SURVEY OFFICE (USE ONLY)

PERSONNEL

REFERENCE NO. 10

SHEET 1 OF 32

NOTES AUBLE

DATE 5/1/18

ROUTE SR 412

H.C. LEU

WEATHER SUNNY, BREEZY

COUNTY SANDUSKY

R.C. AUBLE

TEMP. 66°

TOWNSHIP RILEY

SECTION 26

DWG BY NIESE

PID 95765

T 5 N R 16 E

TYPE MONUMENT P.K./WASHER

ON SURFACE - ~~BELOW~~ ON

OFFSET Q PAVEMENT 0.7' LT : ~~RT~~

8.2' TO LT EDGE PAVEMENT


STATION: 295+13.69

HORZ.DATUM: NAD83(2011)


GEOID: 2012A

GRID: NORTHING: 620128.832

EASTING: 1834428.962

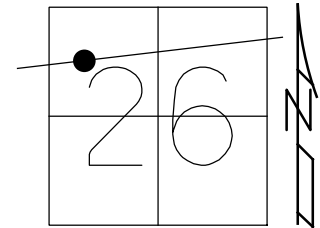

RECORD: P.I.
P.K./WASHER
ATOP BOAT SPIKE/WASHER
FD P.K./WASHER
7/5/01, TMR
SET P.K./WASHER
8/31/01, SAH
FD P.K./WASHER
REF10
12/11/12, JMR
FD P.K./WASHER
REF10
11/29/16, DCH
SET MAG/WASHER
8-21-19, JFO

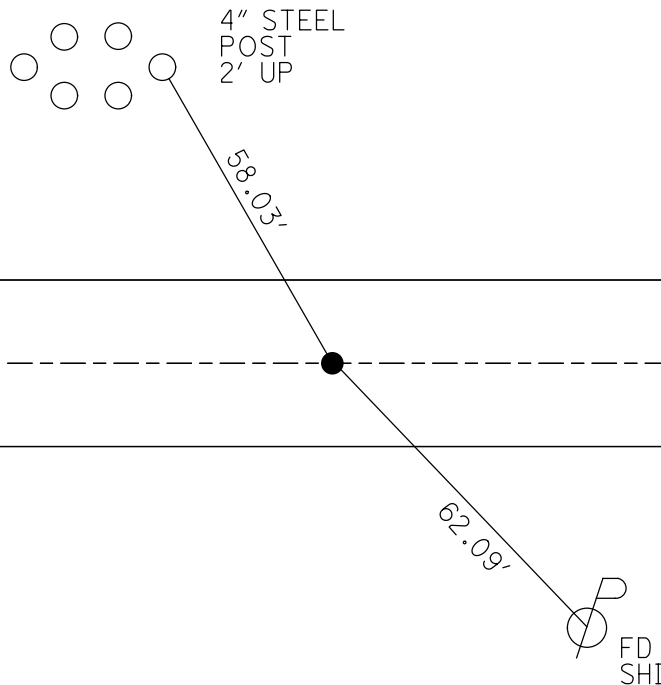

O.D.O.T. DISTRICT 2 SURVEY OFFICE (USE ONLY)

PERSONNEL

REFERENCE NO. 11 A

SHEET 3 OF 32

NOTES AUBLE

DATE 5/1/18

ROUTE SR 412

H.C. LEU

WEATHER SUNNY, BREEZY

COUNTY SANDUSKY

R.C. AUBLE

TEMP. 71°

TOWNSHIP RILEY

SECTION 25

DWG BY NIESE

PID 95765

T 5 N R 16 E

TYPE MONUMENT P.K./WASHER

ON SURFACE - ~~BELOW~~ ON

OFFSET 0.2' LT : ~~RT~~

9.8' TO LT EDGE PAVEMENT


STATION: 313+27.31

HORIZ.DATUM: NAD83(2011)


GEOID: 2012A

GRID: NORTHING: 620746.110

EASTING: 1839807.277

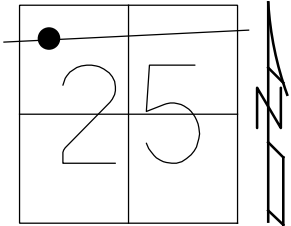

RECORD: P.I.
FD P.K./WASHER
ATOP P.K./WASHER
ATOP IPIPE
ATOP IPIPE
SEC#1 FIELD BOOK #53
SET P.K./WASHER
8-31-01, SAH
FD P.K./WASHER
REFA11
6/23/15
11/29/16, DCH
SET MAG/WASHER
REFA11
8-21-2019, JFO

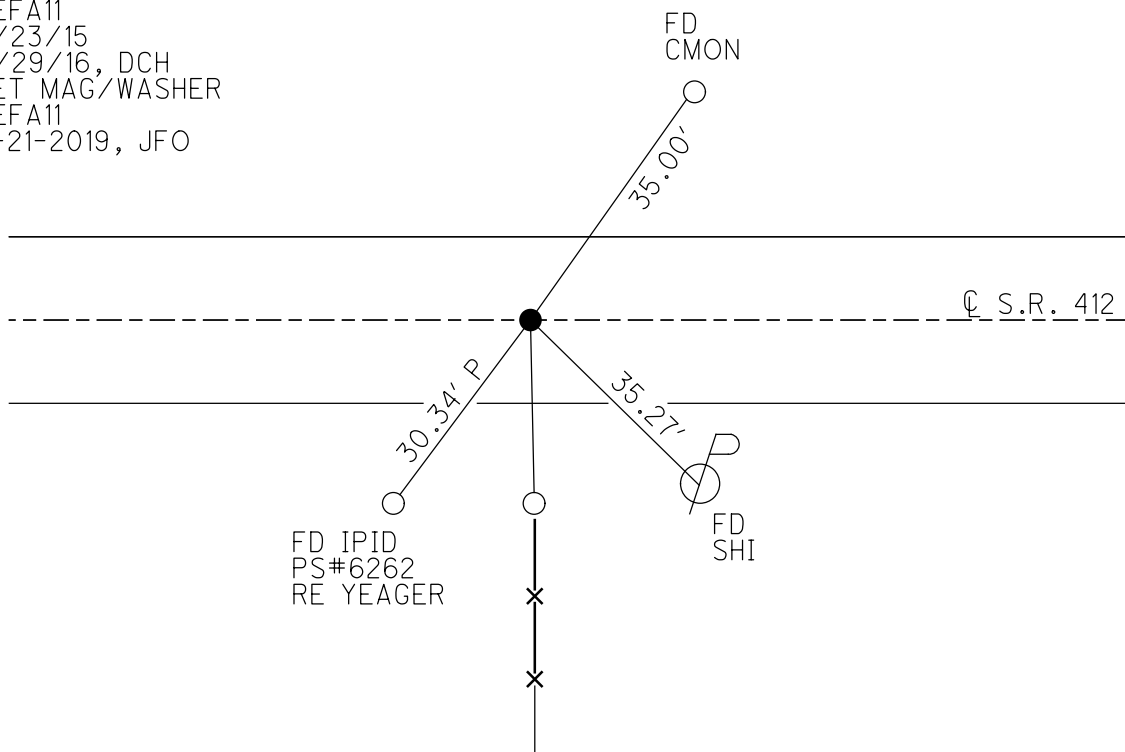

O.D.O.T. DISTRICT 2 SURVEY OFFICE (USE ONLY)

PERSONNEL

REFERENCE NO. 12

SHEET 4 OF 32

NOTES AUBLE

DATE 5/1/18

ROUTE SR 412

H.C. LEU

WEATHER SUNNY, BREEZY

COUNTY SANDUSKY

R.C. AUBLE

TEMP. 71°

TOWNSHIP RILEY

SECTION 25

DWG BY NIESE

PID 95765

T 5 N R 16 E

TYPE MONUMENT P.K./WASHER

ON SURFACE - ~~BELOW~~ ON

OFFSET CL PAVEMENT ON LT : RT

8.8' TO RT EDGE PAVEMENT


STATION: 326+64.86

HORIZ.DATUM: NAD83(2011)

GEOID: 2012A

GRID: NORTHING: 620913.557

EASTING: 1841134.299

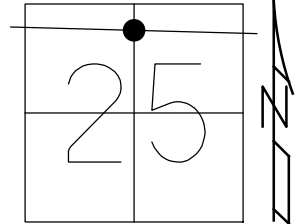


RECORD: P.I.
STA. 26+72.65
FD P.K./WASHER
ATOP P.K./WASHER
ATOP BOAT SPIKE/WASHER
SEC.#1-FIELD BOOK#53
SET P.K./WASHER
8-31-01, SAH
FD P.K./WASHER
UNDER BRIDGE
REF12
6/23/15, DCH
SET PAINT MARK
REF12
8-21-19, JFO

FD '+' CUT
6TH COLUMN
FR/WEST
TURNPIKE BR.



39.22'

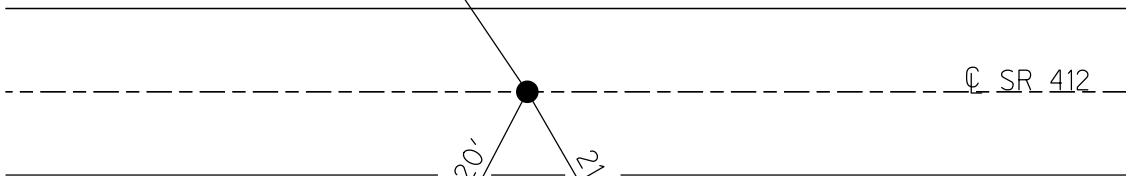

29.20'

21.96'



FD '+' CUT
2ND COLUMN
FR/WEST
TURNPIKE BR.

FD '+' CUT
4TH COLUMN
FR/WEST
TURNPIKE BR.

O.D.O.T. DISTRICT 2 SURVEY OFFICE (USE ONLY)

PERSONNEL

REFERENCE NO. 13

SHEET 5 OF 32

NOTES AUBLE

DATE 5/1/18

ROUTE SR 412

H.C. LEU

WEATHER SUNNY, BREEZY

COUNTY SANDUSKY

R.C. AUBLE

TEMP. 71°

TOWNSHIP RILEY

SECTION 25

DWG BY NIESE

PID 95765

T 5 N R 16 E

TYPE MONUMENT P.K./WASHER

ON SURFACE - ~~BELOW~~ ON

OFFSET CL PAVEMENT 0.6' ~~LT~~ : RT

8.5' TO RT EDGE PAVEMENT


STATION: 340+07.52

HORZ.DATUM: NAD83(2011)


GEOID: 2012A

GRID: NORTHING: 621077.116

EASTING: 1842466.961

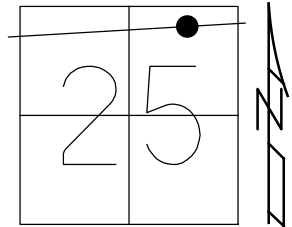

REC: P.I.
STA. 40+07.6±
FD P.K./WASHER
ATOP P.K./WASHER
ATOP BOAT SPIKE
FIELD BOOK # 53
SET P.K./WASHER
8-31-01, SAH
FD P.K./WASHER
6/23/15, DCH
REF13
11/29/16, DCH
SET MAG/WASHER
REF13
8-21-19, JFO

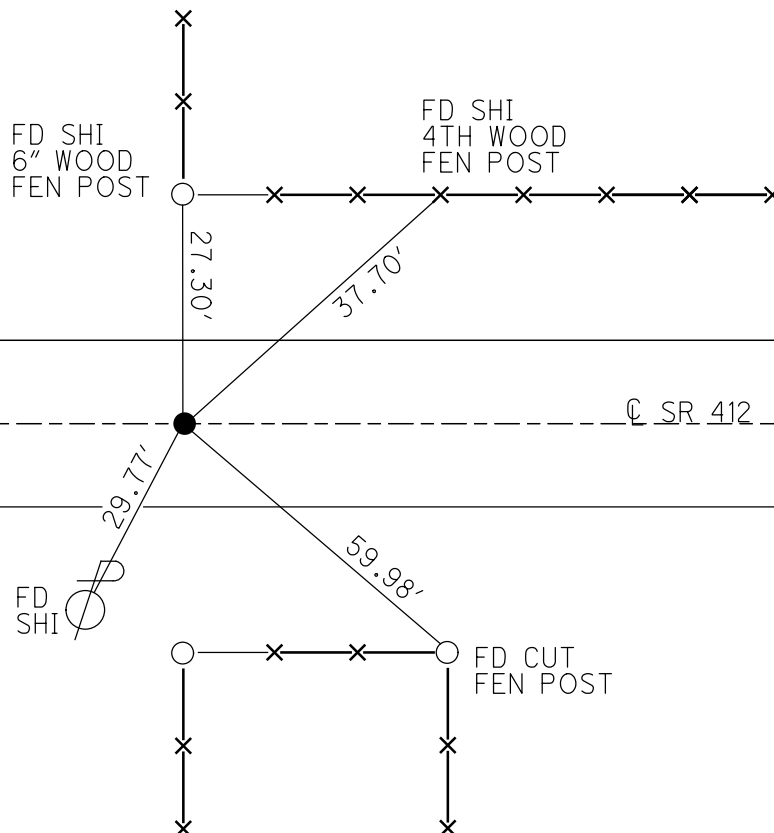

O.D.O.T. DISTRICT 2 SURVEY OFFICE (USE ONLY)

PERSONNEL

REFERENCE NO. 14

SHEET 6 OF 32

NOTES AUBLE

DATE 5/1/18

ROUTE SR 412

H.C. LEU

WEATHER SUNNY, BREEZY

COUNTY SANDUSKY

R.C. AUBLE

TEMP. 73°

TOWNSHIP RILEY

SECTION 25

DWG BY NIESE

PID 95765

T 5 N R 16 E

TYPE MONUMENT R.R. SPIKE

ON SURFACE - ~~BELOW~~ 3"

OFFSET Q PAVEMENT 1.5' LT : ~~RT~~

- TO - EDGE PAVEMENT


STATION: 353+42.69

HORIZ.DATUM: NAD83(2011)


GEOID: 2012A

GRID: NORTHING: 621229.757

EASTING: 1843793.375

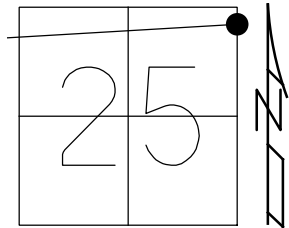

RECORD:
FD P.K./WASHER
ATOP MINE SPIKE
SET P.K./WASHER
7/05/01
FDS R.R.SPIKE
3" DOWN
6/23/15, DCH
REF14
11/29/16,DCH
SET MAG/WASHER
8-21-2019, JFO

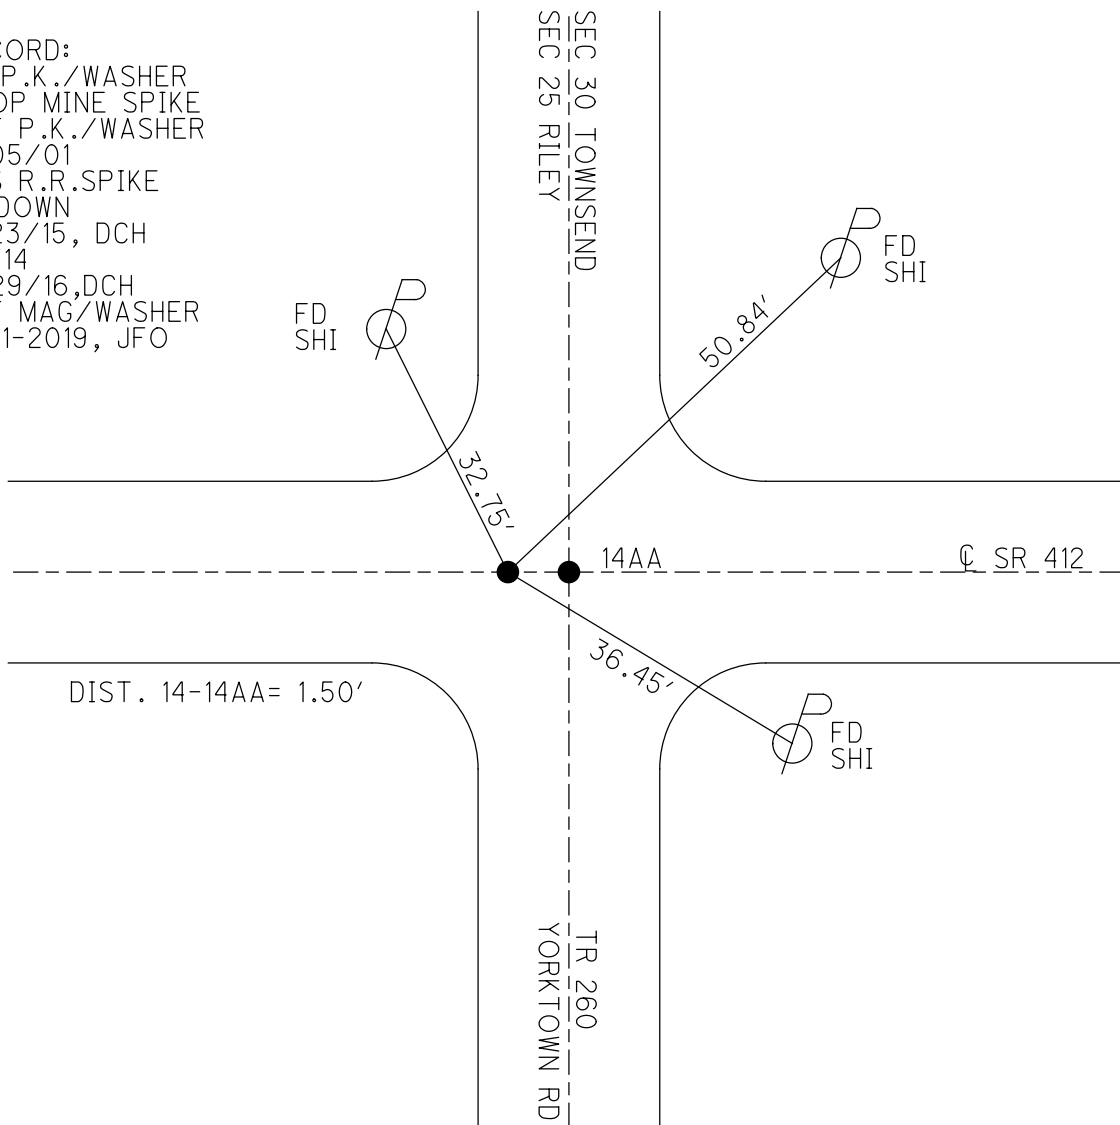

O.D.O.T. DISTRICT 2 SURVEY OFFICE (USE ONLY)

PERSONNEL

REFERENCE NO. 14 AA

SHEET 7 OF 32

NOTES LEU
H.C. LEU
R.C. HOMAN

DATE 6/23/15
WEATHER PTLY CLOUDY
TEMP. 80°

ROUTE SR 412
COUNTY SANDUSKY
TOWNSHIP TOWNSEND
SECTION 30
T 5 N R 17 E

DWG BY NIESE PID 95765

TYPE MONUMENT P.K./WASHER

ON SURFACE - ~~BELOW~~ ON

OFFSET CL PAVEMENT 1.5' LT : RT

- TO - EDGE PAVEMENT


STATION: 353+44.18

HORZ.DATUM: NAD83(2011)


GEOID: 2012A

GRID: NORTHING: 621229.795

EASTING: 1843794.903

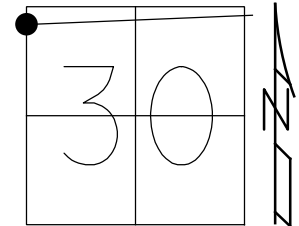

RECORD:
SET P.K./WASHER
7/05/01, SAH
FD P.K./WASHER
6/23/15, DCH
REFAA14
11/29/16, DCH
FD MONBOX
W/ 1" IPIN
NEWREFAA14
8-21-2019, JFO

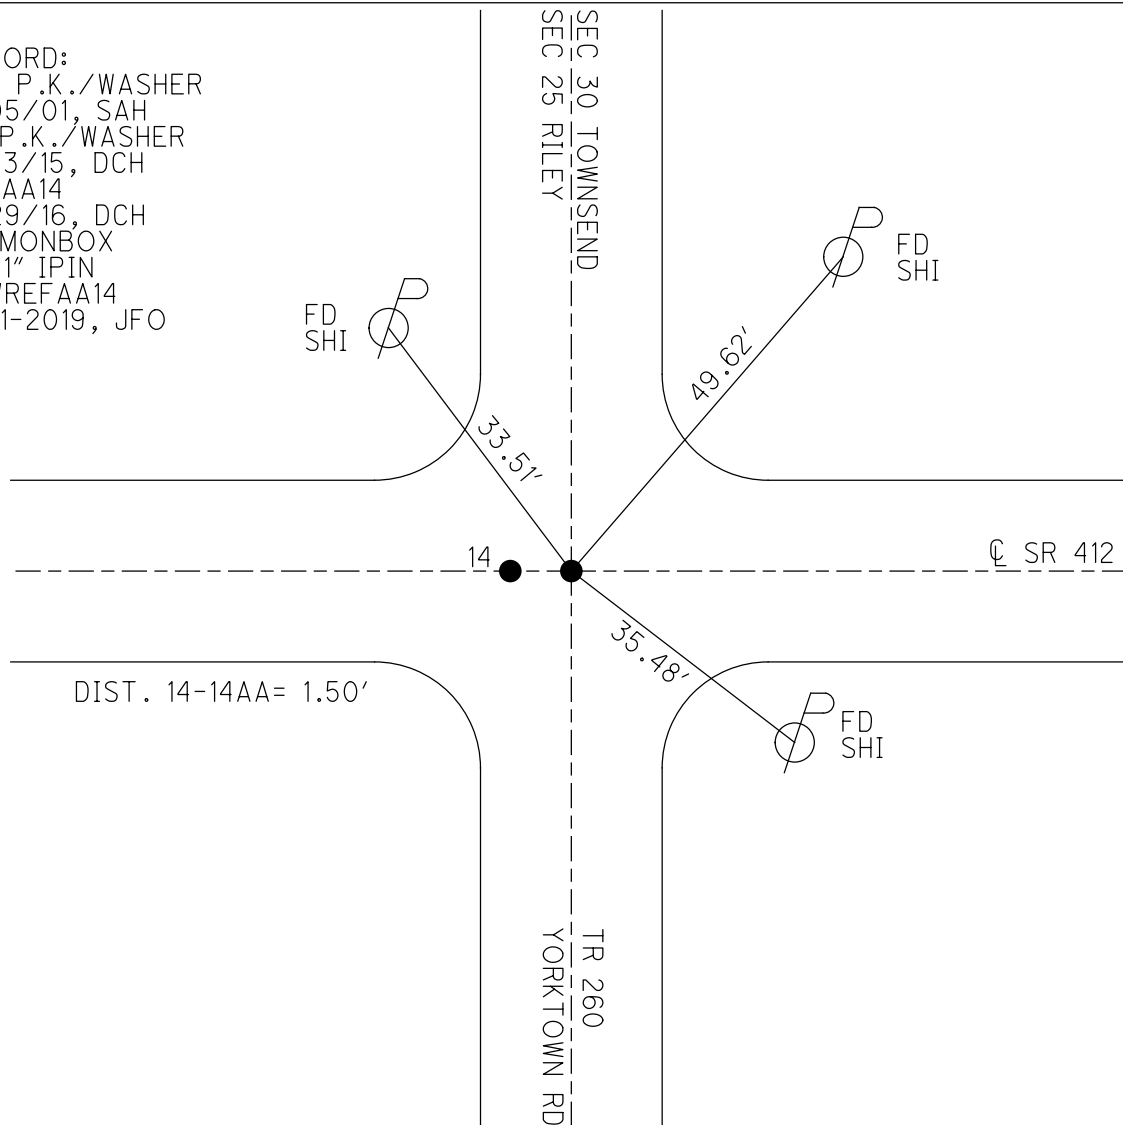

O.D.O.T. DISTRICT 2 SURVEY OFFICE (USE ONLY)

PERSONNEL

REFERENCE NO. 14 A

SHEET 8 OF 32

NOTES LEU

DATE 6/23/15

ROUTE SR 412

H.C. LEU

WEATHER SUNNY

COUNTY SANDUSKY

R.C. HOMAN

TEMP. 80°

TOWNSHIP TOWNSEND

SECTION 30

DWG BY NIESE

PID 95765

T 5 N R 17 E

TYPE MONUMENT P.K. NAIL

ON SURFACE - ~~BELOW~~ ON

OFFSET Q PAVEMENT 3.4' LT : ~~RT~~

6.0' TO LT EDGE PAVEMENT



STATION: 379+83.45

HORZ.DATUM: NAD83(2011)

GEOID: 2012A

GRID: NORTHING: 621564.581

EASTING: 1846412.889

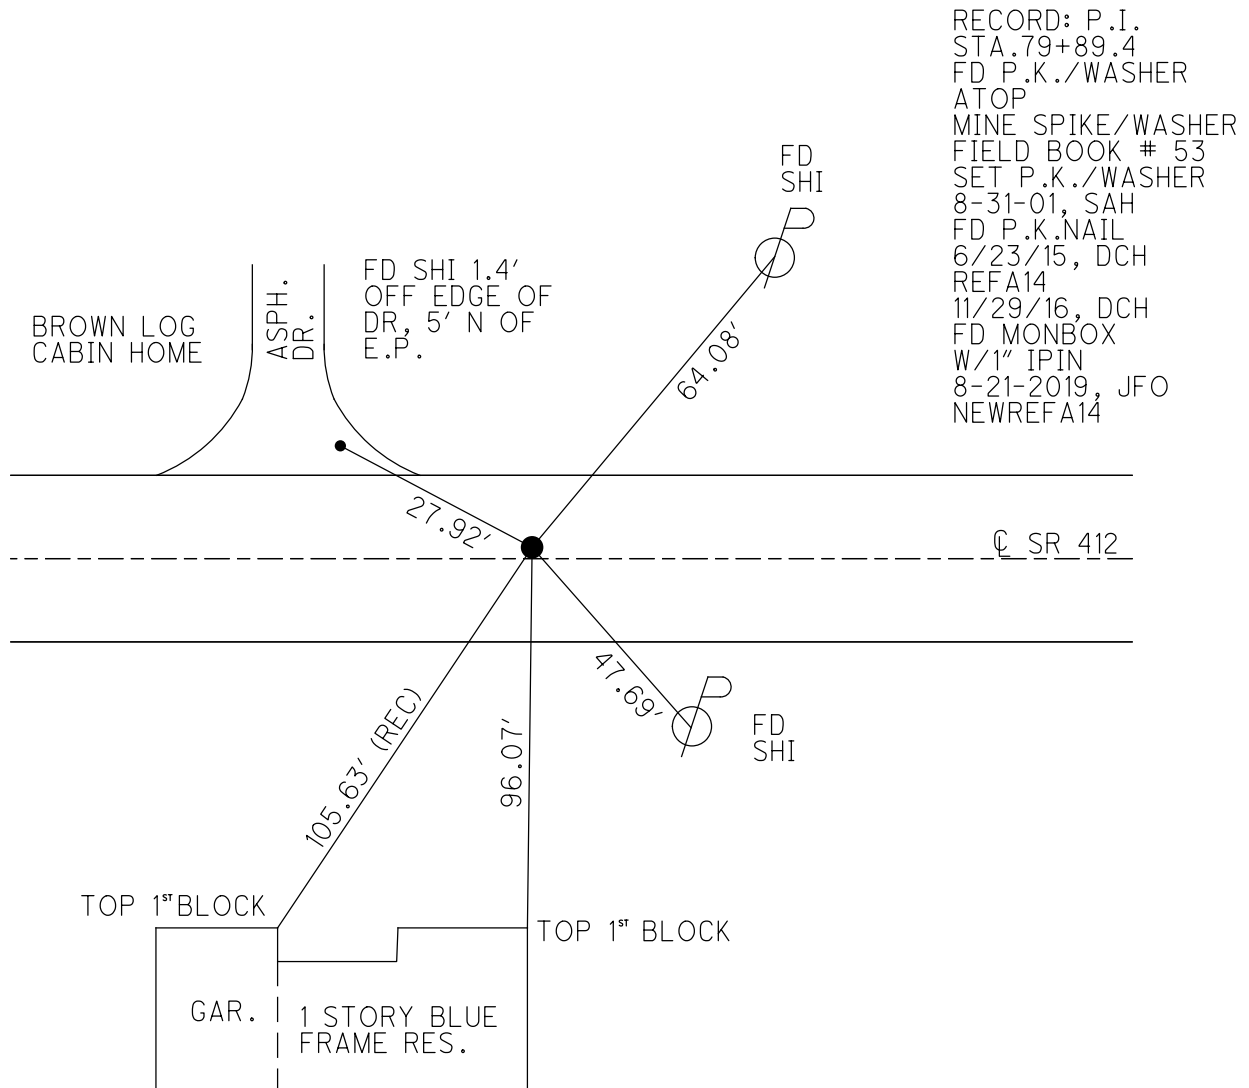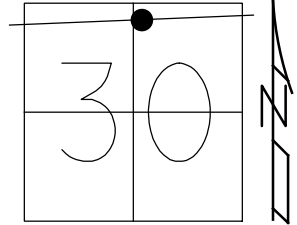

O.D.O.T. DISTRICT 2 SURVEY OFFICE (USE ONLY)

PERSONNEL

REFERENCE NO. 15

SHEET 9 OF 32

NOTES AUBLE

DATE 5/1/18

ROUTE SR 412

H.C. LEU

WEATHER SUNNY, BREEZY

COUNTY SANDUSKY

R.C. AUBLE

TEMP. 74°

TOWNSHIP TOWNSEND

DWG BY NIESE

PID 95765

SECTION 30

T 5 N R 17 E

TYPE MONUMENT P.K./WASHER

ON SURFACE - ~~BELOW~~ ON

OFFSET CL PAVEMENT 3.4' LT : ~~RT~~

9.1' TO LT EDGE PAVEMENT


STATION: 399+04.84

HORZ.DATUM: NAD83(2011)


GEOID: 2012A

GRID: NORTHING: 621786.737

EASTING: 1848321.336

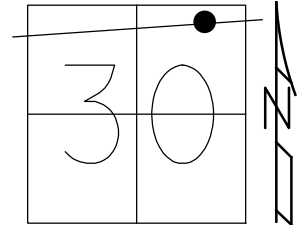

RECORD: P.I.
STA. 99+11±
FD P.K./WASHER
ATOP P.K./WASHER
ATOP BOAT SPIKE
FIELD BOOK # 53
SET P.K./WASHER
8-31-01, SAH
FD P.K./WASHER
6/23/15, DCH
REF15
11/29/16, DCH
SET MAG/WASHER
REF15
8-21-19, JFO

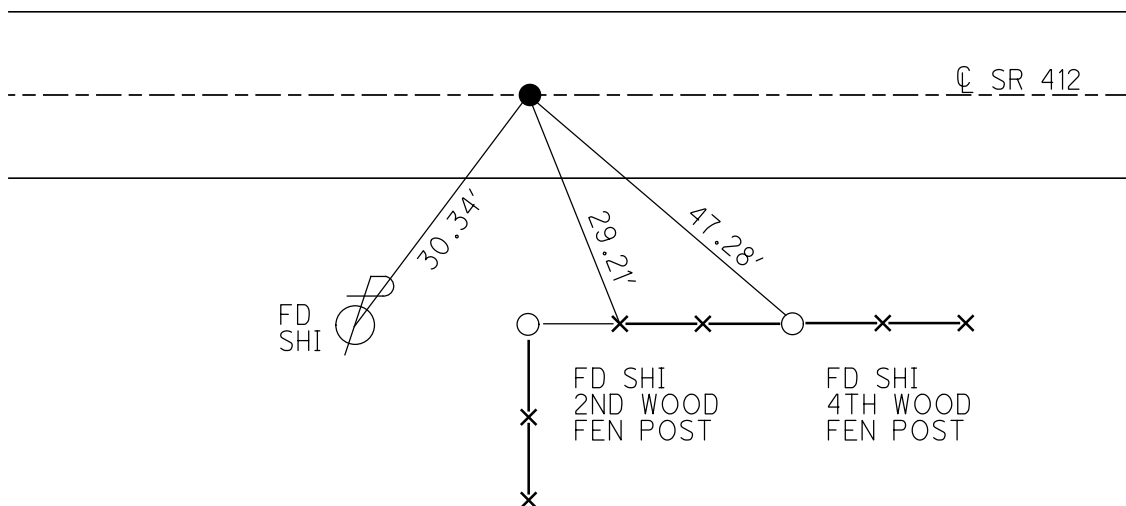

O.D.O.T. DISTRICT 2 SURVEY OFFICE (USE ONLY)

PERSONNEL

REFERENCE NO. 16

SHEET 10 OF 32

NOTES AUBLE

DATE 5/1/18

ROUTE SR 412

H.C. LEU

WEATHER SUNNY, BREEZY

COUNTY SANDUSKY

R.C. AUBLE

TEMP. 74°

TOWNSHIP TOWNSEND

SECTION 20

DWG BY NIESE

PID 95765

T 5 N R 17 E

TYPE MONUMENT MAG/WASHER

ON SURFACE - ~~BELOW~~ ON

OFFSET Q PAVEMENT ON LT : RT

- TO - EDGE PAVEMENT


STATION: 405+48.74

HORZ.DATUM: NAD83(2011)


GEOID: 2012A

GRID: NORTHING: 621867.073

EASTING: 1848960.129

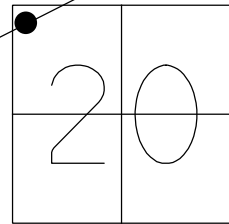

RECORD:
SET P.K./WASHER
8-31-01, SAH
FD MAG/WASHER
6/23/15, DCH
REF16
11/29/16, DCH
SET MAG/WASHER
3" DOWN
NEWREF16
8-20-2019, JFO

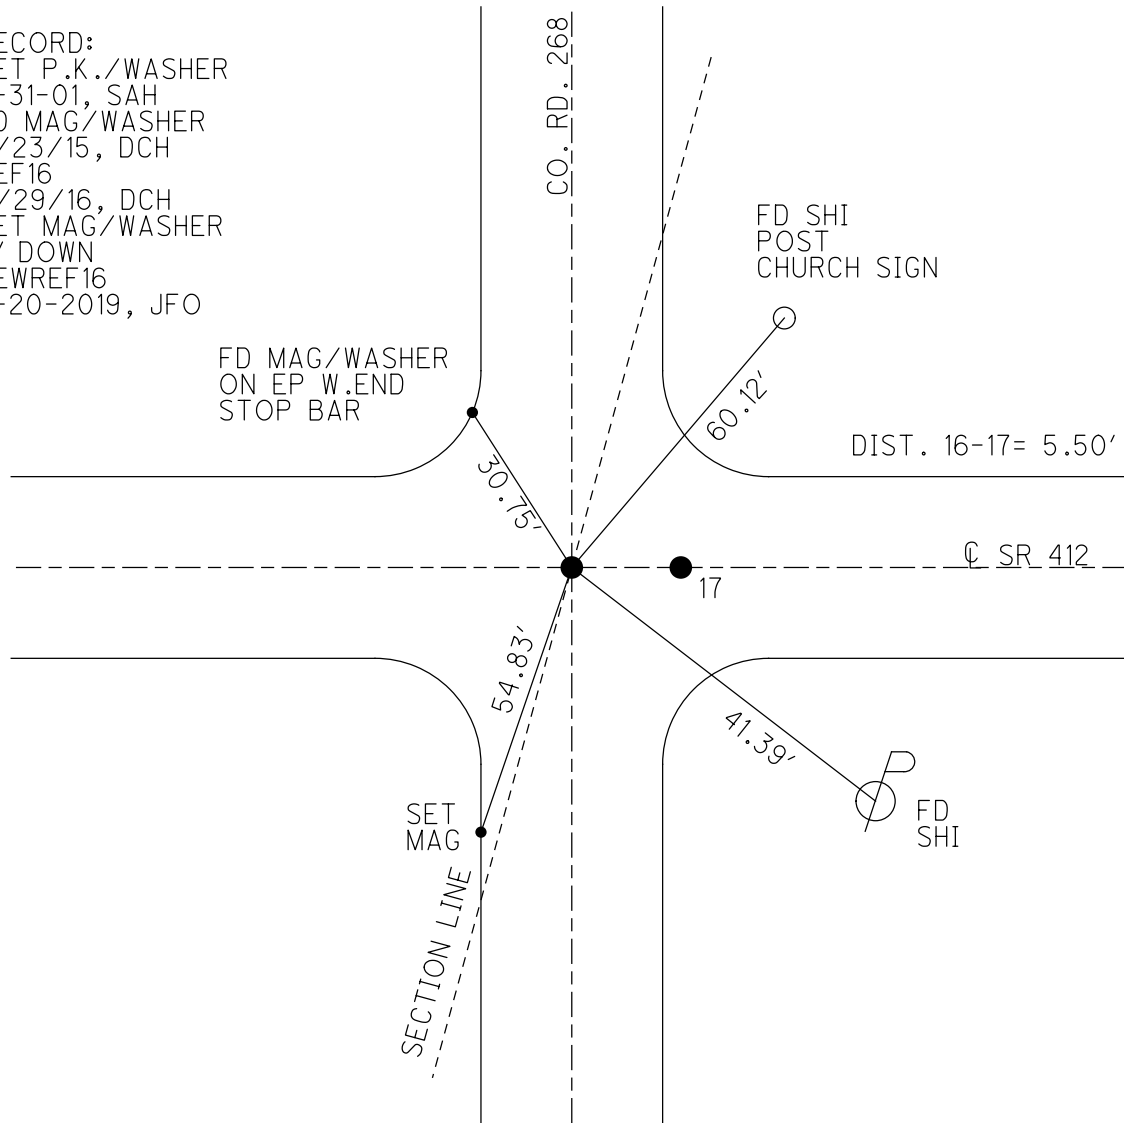

O.D.O.T. DISTRICT 2 SURVEY OFFICE (USE ONLY)

PERSONNEL

REFERENCE NO. 17

SHEET 11 OF 32

NOTES LEU

DATE 6/23/15

ROUTE SR 412

H.C. LEU

WEATHER SUNNY

COUNTY SANDUSKY

R.C. HOMAN

TEMP. 80°

TOWNSHIP TOWNSEND

SECTION 20

DWG BY NIESE

PID 95765

T 5 N R 17 E

TYPE MONUMENT MAG/WASHER

ON SURFACE - ~~BELOW~~ ON

OFFSET Q PAVEMENT ON LT : RT

- TO - EDGE PAVEMENT



STATION: 405+54.21

HORZ.DATUM: NAD83(2011)

GEOID: 2012A

GRID: NORTHING: 621867.721

EASTING: 1848965.611

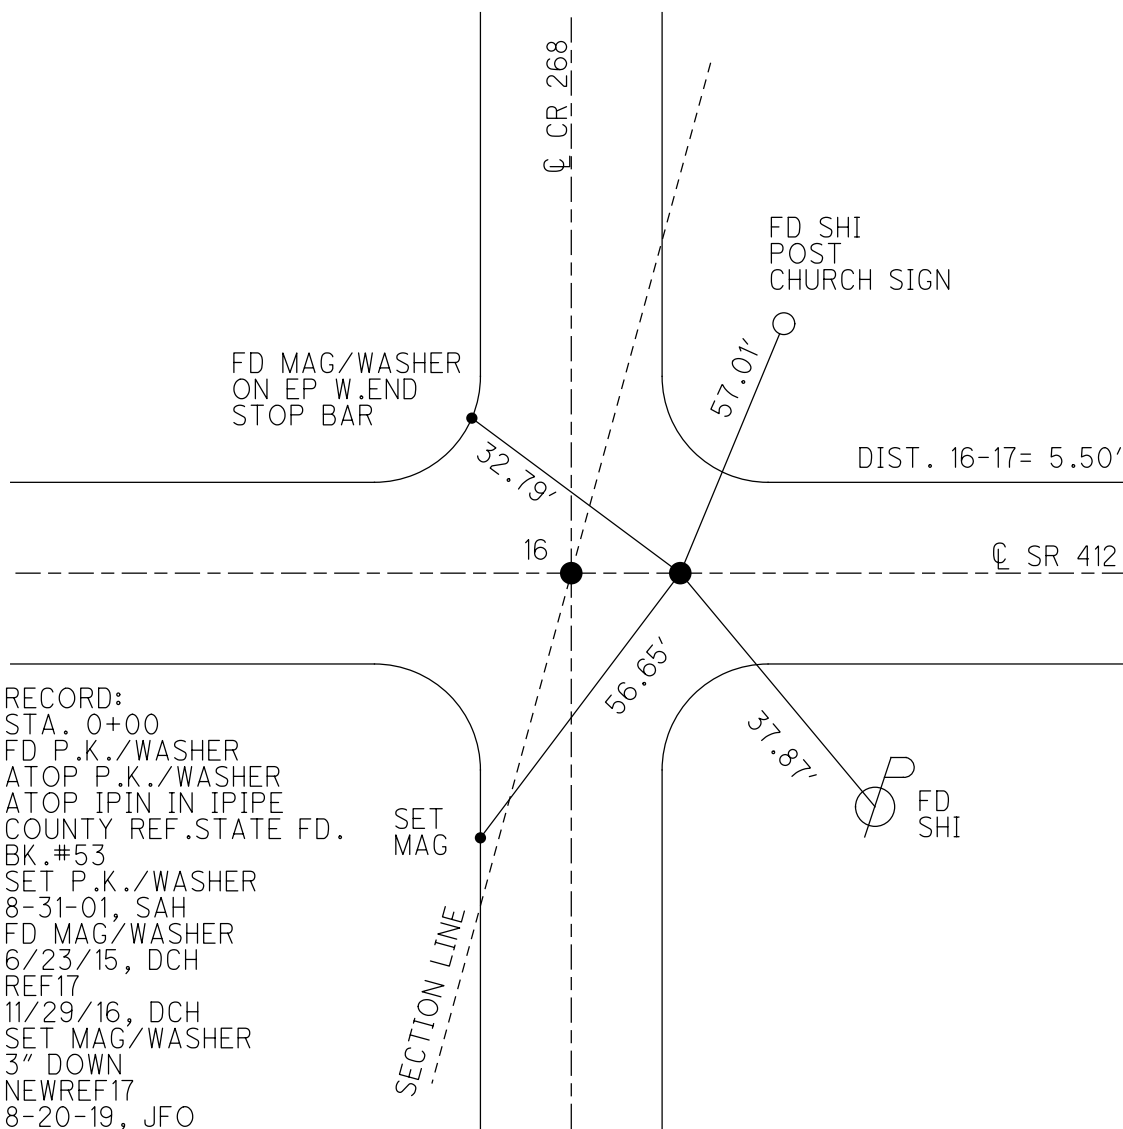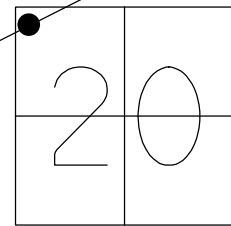

RECORD:
STA. 0+00
FD P.K./WASHER
ATOP P.K./WASHER
ATOP IPIN IN IPIPE
COUNTY REF.STATE FD.
BK.#53
SET P.K./WASHER
8-31-01, SAH
FD MAG/WASHER
6/23/15, DCH
REF17
11/29/16, DCH
SET MAG/WASHER
3" DOWN
NEWREF17
8-20-19, JFO

O.D.O.T. DISTRICT 2 SURVEY OFFICE (USE ONLY)

PERSONNEL

REFERENCE NO. 18

SHEET 12 OF 32

NOTES AUBLE

DATE 5/1/18

ROUTE SR 412

H.C. LEU

WEATHER SUNNY, BREEZY

COUNTY SANDUSKY

R.C. AUBLE

TEMP. 75°

TOWNSHIP TOWNSEND

SECTION 20

DWG BY NIESE

PID 95765

T 5 N R 17 E

TYPE MONUMENT P.K.NAIL

ON SURFACE - ~~BELOW~~ ON

OFFSET CL PAVEMENT 1.0' LT : ~~RT~~

9.3' TO RT EDGE PAVEMENT


STATION: 421+49.60

HORZ.DATUM: NAD83(2011)

GEOID: 2012A

GRID: NORTHING: 622075.069

EASTING: 1850547.488

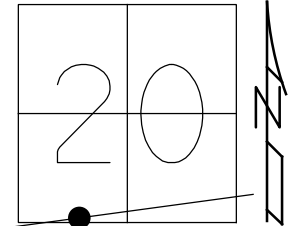

RECORD:

STA.16+01±

FD P.K./WASHER

ATOP P.K./WASHER

ATOP BOAT SPIKE

FIELD BOOK #53

SET P.K./WASHER

8-31-01, SAH

FD P.K.NAIL

6/23/15, DCH

REF18

11/29/16, DCH

SET MAG/WASHER

8-21-19, JFO

CL SR 412

98.00'
SIGN
MP 8
FD
SHI

RES# 5267

O.D.O.T. DISTRICT 2 SURVEY OFFICE (USE ONLY)

PERSONNEL

REFERENCE NO. 19

SHEET 13 OF 32

NOTES AUBLE

DATE 5/1/18

ROUTE SR 412

H.C. LEU

WEATHER SUNNY, BREEZY

COUNTY SANDUSKY

R.C. AUBLE

TEMP. 75°

TOWNSHIP TOWNSEND

SECTION 20

DWG BY NIESE

PID 95765

T 5 N R 17 E

TYPE MONUMENT R.R. SPIKE

~~ON SURFACE~~ - BELOW 9.5"

OFFSET 0.4' ~~LT~~ : RT

9.8' TO LT EDGE PAVEMENT


STATION: 445+77.31

HORIZ.DATUM: NAD83(2011)

GEOID: 2012A

GRID: NORTHING: 622361.306

EASTING: 1852958.335

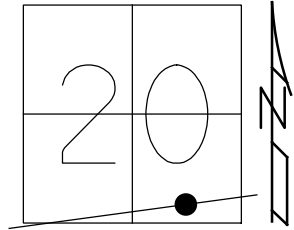

RECORD:

STA.40+22.60±

FD P.K./WASHER

ATOP R.R. SPIKE

CO.FD.BK.R-232,PG.12

SET P.K./WASHER

8-31-01, SAH

FD R.R.SPIKE

9.5" DOWN

6/24/15, DCH


REF19

11/29/16, DCH

SET MAG/WASHER

NEWREF19

8-20-2019, JFO

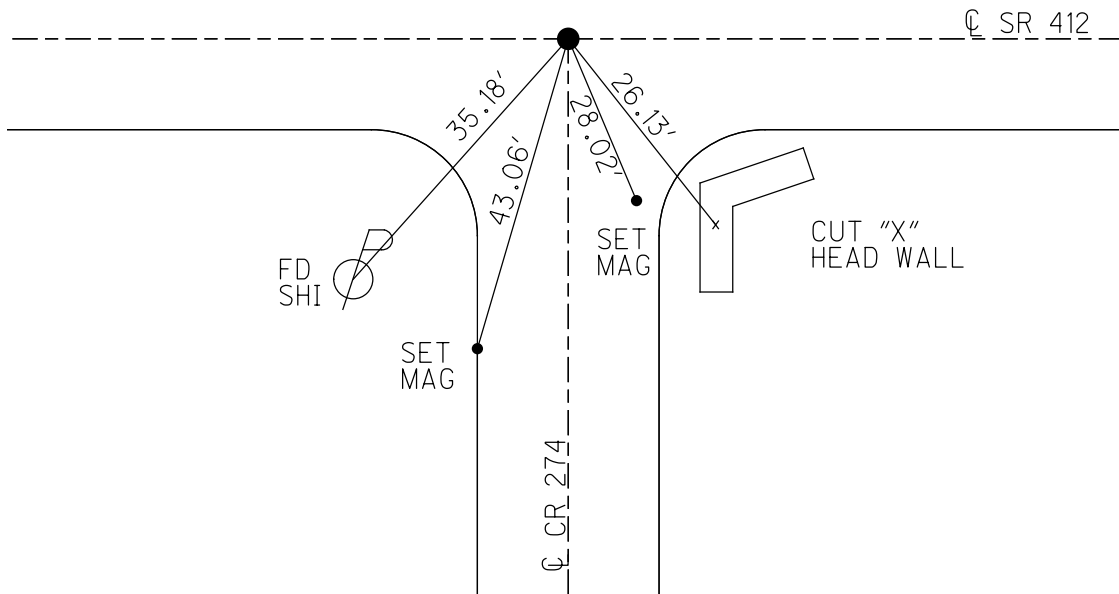

O.D.O.T. DISTRICT 2 SURVEY OFFICE (USE ONLY)

PERSONNEL

REFERENCE NO. 20

SHEET 14 OF 32

NOTES LEU

DATE 5/1/18

ROUTE SR 412

H.C. LEU

WEATHER SUNNY, BREEZY

COUNTY SANDUSKY

R.C. HOMAN

TEMP. 75°

TOWNSHIP TOWNSEND

DWG BY NIESE

PID 95765

SECTION 20 & 21

T 5 N R 17 E

TYPE MONUMENT LG. R.R. SPIKE

~~ON SURFACE~~ - BELOW 3"

OFFSET Q PAVEMENT 1.7' LT : ~~RT~~

8.6' TO LT EDGE PAVEMENT



STATION: 458+96.17

HORZ.DATUM: NAD83(2011)

GEOID: 2012A

GRID: NORTHING: 622523.984

EASTING: 1854267.057

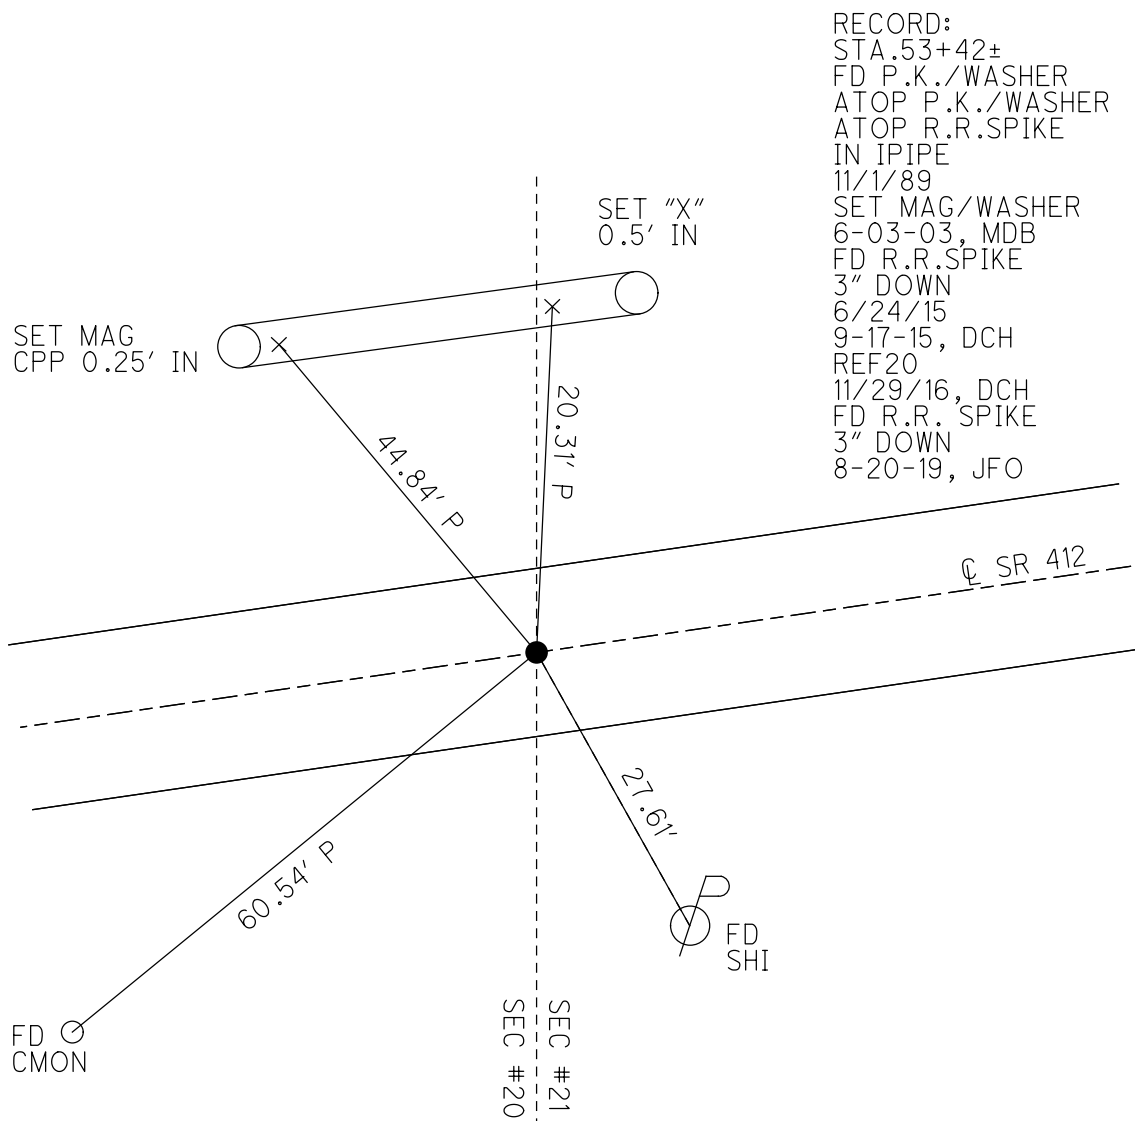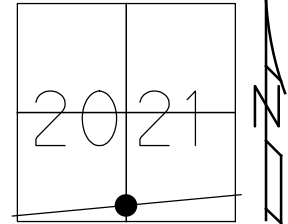

O.D.O.T. DISTRICT 2 SURVEY OFFICE (USE ONLY)

PERSONNEL

REFERENCE NO.

21

SHEET

15

OF

34

NOTES LEU

DATE

06-24-2015

ROUTE

SR 412

H.C. LEU

WEATHER

SUNNY

COUNTY

SANDUSKY

R.C. HOMAN

TEMP.

75°F

TOWNSHIP

TOWNSEND

SECTION

21

T 5 N R 17 E

TYPE MONUMENT MAG & WASHER


ON SURFACE - ~~BELOW~~ ON

~~LEFT~~ - Q PAV'T - RIGHT 3'

- TO - EDGE PAVEMENT

S.L.M. 473+80

Grid: Northing: 622680.835 Easting: 1855591.867

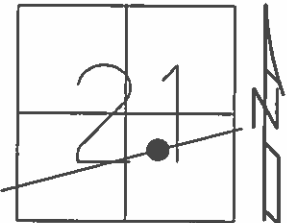


REC: 09-09-1982

STA (1219+00)

FROM 1964 BRIDGE PLAN

RESET MAG & WASHER

06-03-2003 M.D.B.

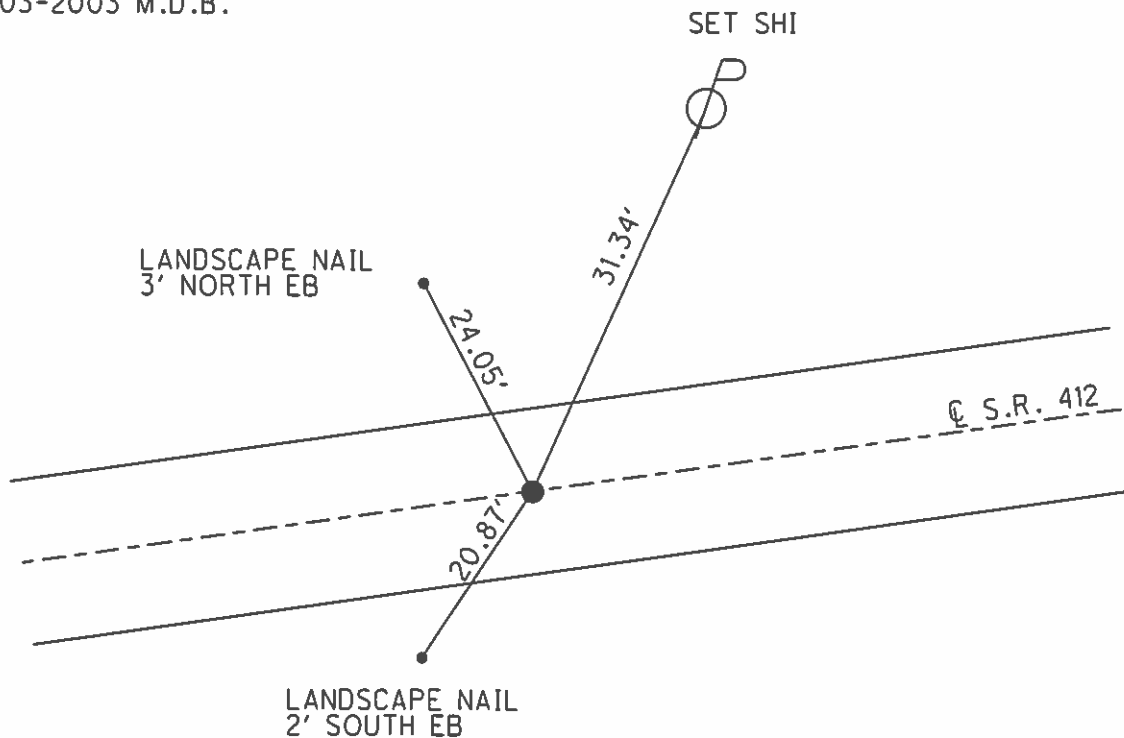

O.D.O.T. DISTRICT 2 SURVEY OFFICE (USE ONLY)

PERSONNEL

REFERENCE NO. 21 AA SHEET 16 OF 34

NOTES LEU

DATE 06-24-2015

ROUTE SR 412

H.C. LEU

WEATHER SUNNY

COUNTY SANDUSKY

R.C. HOMAN

TEMP. 75°F

TOWNSHIP TOWNSEND

SECTION 21

T 5 N R 17 E

TYPE MONUMENT MAG NAIL


ON SURFACE - ~~BELOW~~ ON

LEFT - C PAV'T - ~~RIGHT~~ 0.5'

____ TO ____ EDGE PAVEMENT


S.L.M. 490+77

Grid: Northing: 622892.107 Easting: 1857275.657

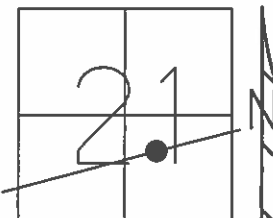

REC: 09-09-1982
STA (1219+00)
FROM 1964 BRIDGE PLAN

RESET MAG & WASHER
06-03-2003 M.D.B.

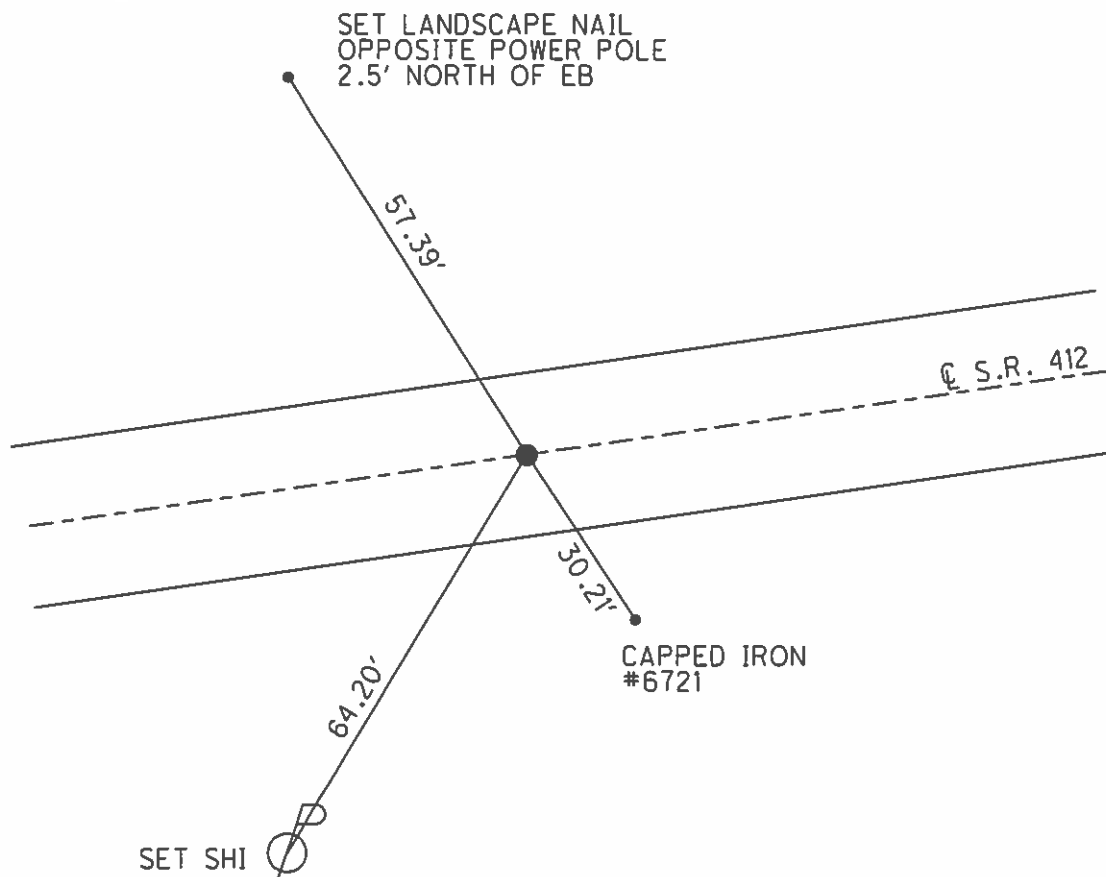

O.D.O.T. DISTRICT 2 SURVEY OFFICE (USE ONLY)

PERSONNEL

REFERENCE NO.

21 A

SHEET

17

OF 34

NOTES LEU

DATE

06-24-2015

ROUTE

SR 412

H.C. LEU

WEATHER

SUNNY

COUNTY

SANDUSKY

R.C. HOMAN

TEMP.

75°F

TOWNSHIP

TOWNSEND

SECTION

21

T 5 N R 17 E

TYPE MONUMENT MAG & WAHSE


ON SURFACE - ~~BELOW~~ ON

~~LEFT~~ - C PAV'T - RIGHT 0.3'

9.9' TO RT EDGE PAVEMENT


S.L.M. 497+68

Grid: Northing: 622975.242 Easting: 1857954.318

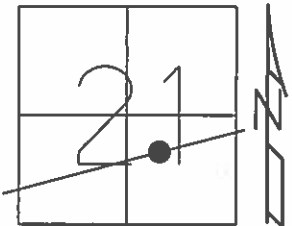

REC: 09-09-1982
STA (1219+00)
FROM 1964 BRIDGE PLAN

RESET MAG & WASHER
06-03-2003 M.D.B.

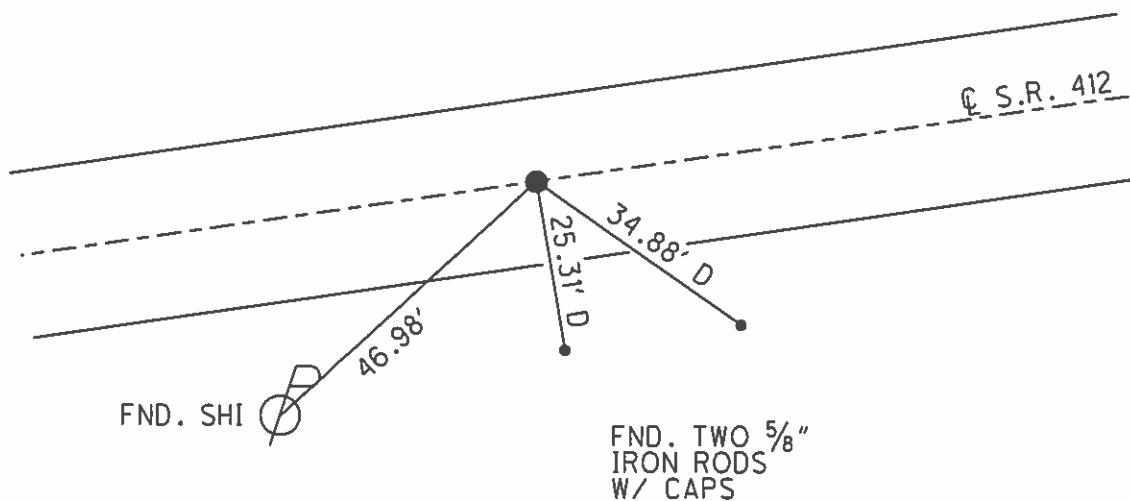

O.D.O.T. DISTRICT 2 SURVEY OFFICE (USE ONLY)

PERSONNEL

REFERENCE NO.

21 B

SHEET

18

OF 34

NOTES LEU

DATE

06-24-2015

ROUTE

SR 412

H.C. LEU

WEATHER

SUNNY

COUNTY

SANDUSKY

R.C. HOMAN

TEMP.

76°F

TOWNSHIP

TOWNSEND

SECTION

21

T 5 N R 17 E

TYPE MONUMENT MAG & WASHER


ON SURFACE - ~~BELOW~~ ON

LEFT - ~~C~~ PAV'T - ~~RIGHT~~ 0.5'

9.8' TO LT EDGE PAVEMENT

S.L.M. 500+61


Grid: Northing: 623010.900 Easting: 1858244.483

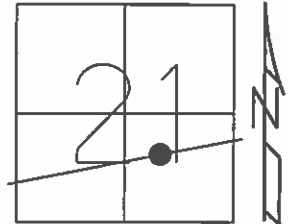

REC: 09-09-1982
STA 1221+92.34
BRIDGE PLAN 1964

RESET MAG & WASHER
06-03-2003 M.D.B.

UNCOV. MAG
09-17-20015 D.C.H.

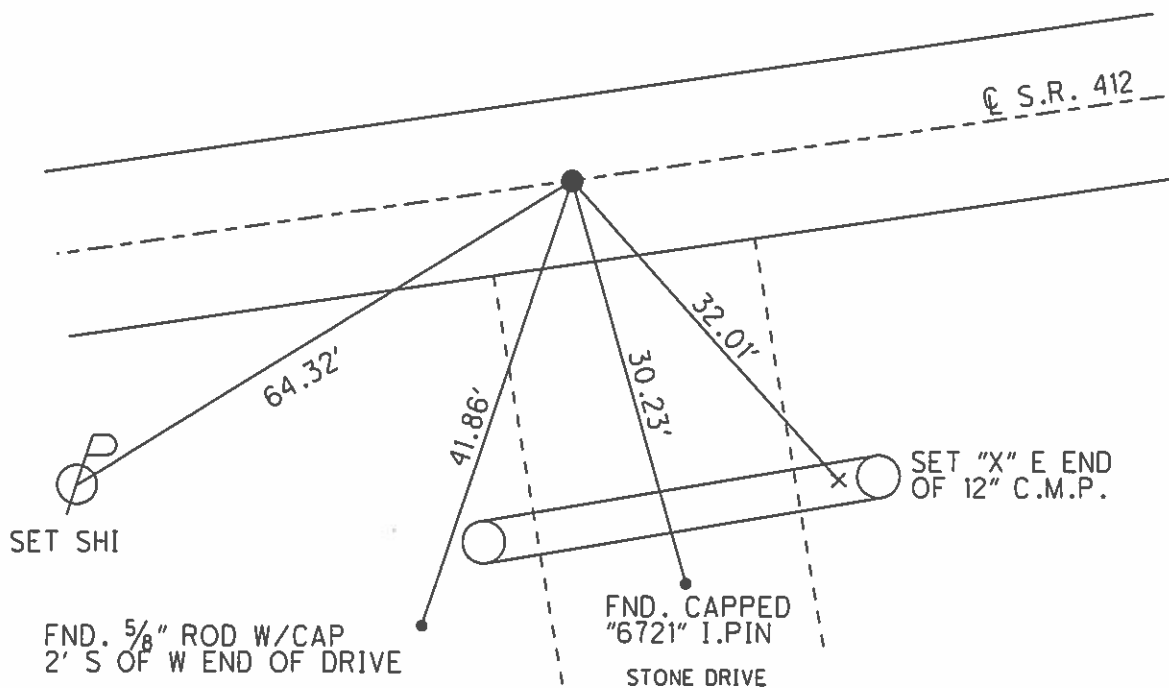

O.D.O.T. DISTRICT 2 SURVEY OFFICE (USE ONLY)

PERSONNEL

REFERENCE NO.

22

SHEET

19

OF 34

NOTES LEU

DATE

06-24-2015

ROUTE

SR 412

H.C. LEU

WEATHER

SUNNY

COUNTY

SANDUSKY

R.C. HOMAN

TEMP.

76°F

TOWNSHIP

TOWNSEND

SECTION

21 & 22

T 5 N

R 17 E

TYPE MONUMENT MAG & WASHER


ON SURFACE - ~~BELOW~~ ON

LEFT - ℄ PAV'T - ~~RIGHT~~ 0.4'

9.8' TO LT EDGE PAVEMENT

S.L.M. 513+92


Grid: Northing: 623173.101 Easting: 1859563.056

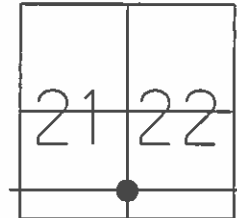

REC: 09-09-1982
STA 1235+20.76
BRIDGE PLAN 1964

RESET MAG & WASHER
06-03-2003 M.D.B.

UNCOVERED MAG & WASHER
09-17-2015 D.C.H.

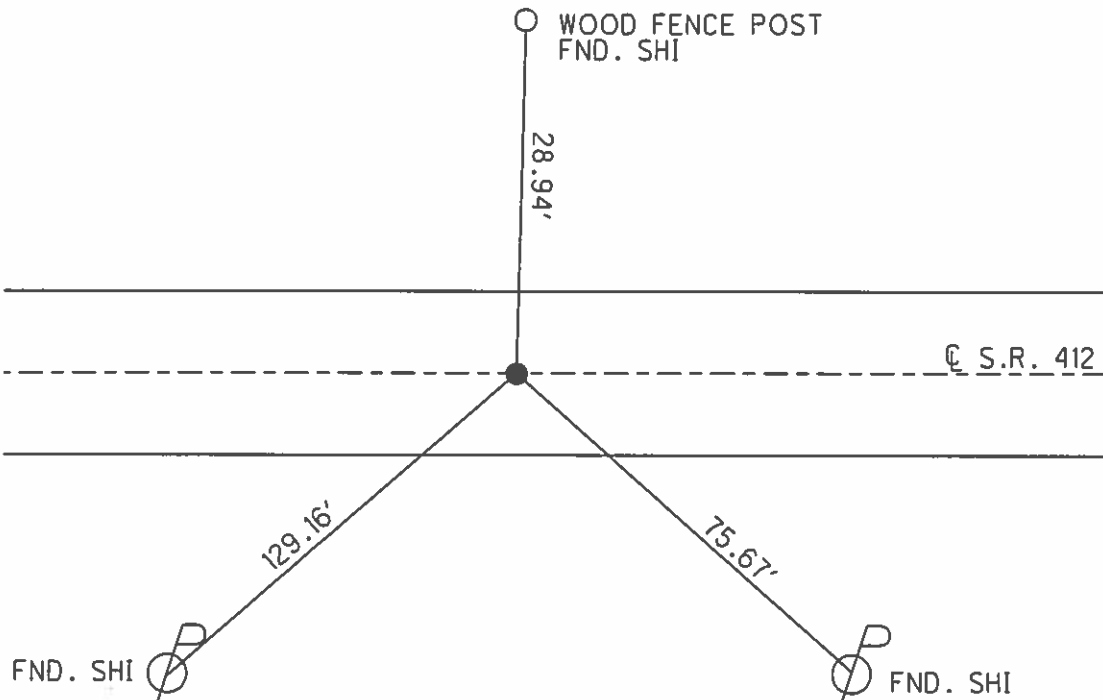

O.D.O.T. DISTRICT 2 SURVEY OFFICE (USE ONLY)

PERSONNEL

REFERENCE NO. 24

SHEET 20 OF 34

NOTES LEU

DATE 06-24-2015

ROUTE SR 412

H.C. LEU

WEATHER SUNNY

COUNTY SANDUSKY

R.C. HOMAN

TEMP. 76°F

TOWNSHIP TOWNSEND

SECTION 22

T 5 N R 17 E

TYPE MONUMENT MAG & WASHER


ON SURFACE - ~~BELOW~~ ON

LEFT - CL PAV'T - ~~RIGHT~~ 3.9'

6.2' TO LT EDGE PAVEMENT

S.L.M. 550+33


Grid: Northing: 623616.884 Easting: 1863170.883

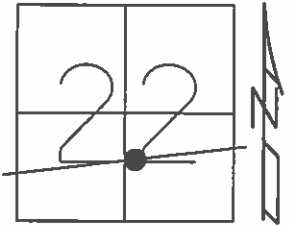

RECORD: 09-09-1982
P.I. - 0.4 MI. E. OF C.R. 294
POINT WAS SET BY SPLITTING
PAV'T FWD. & BACK. NOTHING
ELSE WAS AVAILABLE. RR SPK.
0.1'± BELOW SURFACE
4'± LT CL PAV'T

RESET MAG & WASHER
06-03-2003 M.D.B.

UNCOVERED MAG & WASHER
09-17-2015 D.C.H.

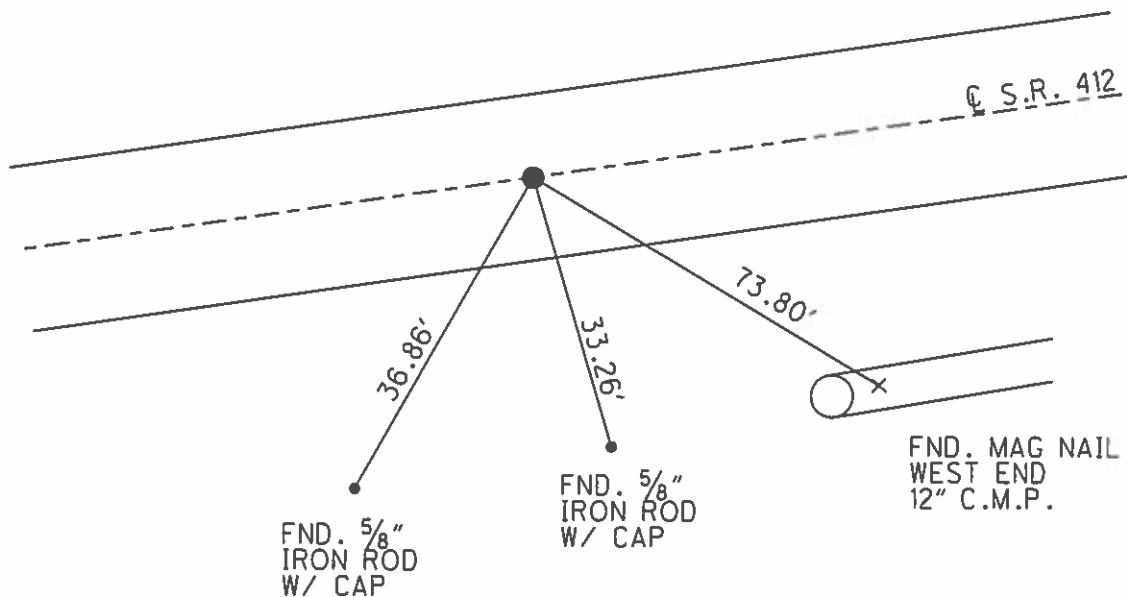


O.D.O.T. DISTRICT 2 SURVEY OFFICE (USE ONLY)

PERSONNEL	REFERENCE NO.	24 A	SHEET	21	OF	34
NOTES	LEU	DATE	06-24-2015	ROUTE	SR 412	
H.C.	LEU	WEATHER	PARTLY CLOUDY	COUNTY	SANDUSKY	
R.C.	HOMAN	TEMP.	76°F	TOWNSHIP	TOWNSEND	
				SECTION	22	
				T	5	N
				R	17	E

TYPE MONUMENT MAG & WASHER
 ON SURFACE - ~~BELOW~~ ON
~~LEFT~~ - Q PAV'T - ~~RIGHT~~ ON
10.1' TO RT EDGE PAVEMENT
 S.L.M. 562+16


Grid: Northing: 623627.806 Easting: 1864352.136

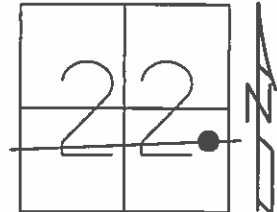

RECORD: 05-02-1989
 P.I.
 0.65± MI. E. OF CR# 294
 0.1± MI. W. OF CR# 302
 POINT SET BY SPLITTING PAV'T
 NOTHING ELSE AVAILABLE

RESET MAG & WASHER
 06-03-2003 M.D.B.

UNCOVERED MAG & WASHER
 09-17-2015 D.C.H.

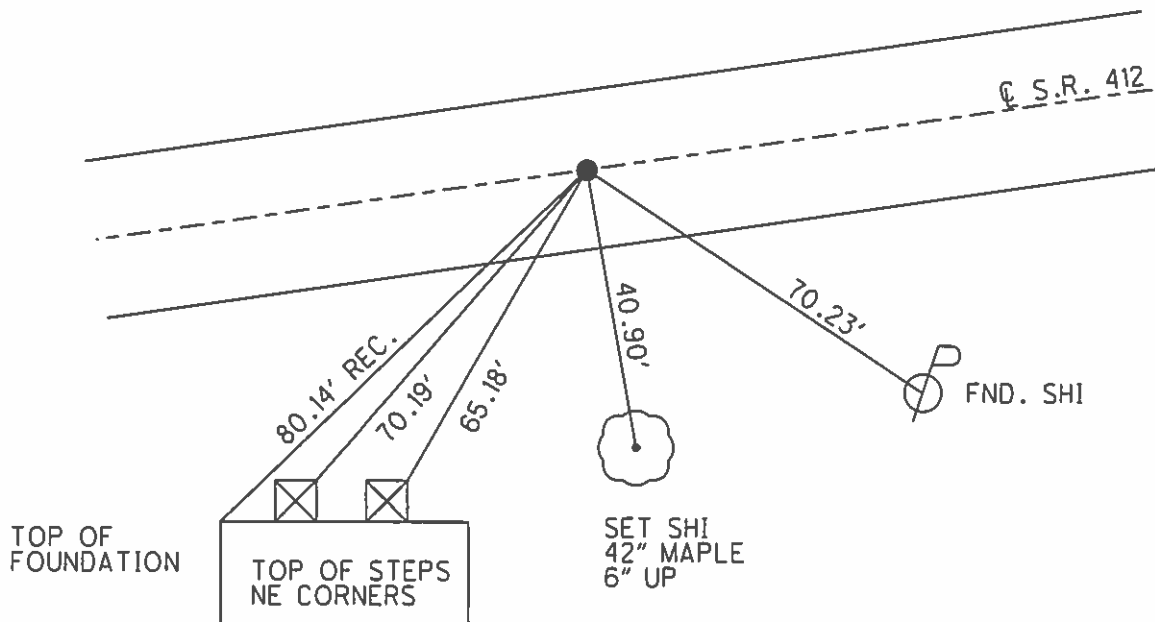

O.D.O.T. DISTRICT 2 SURVEY OFFICE (USE ONLY)

PERSONNEL

REFERENCE NO.

26 A

SHEET

22

OF 34

NOTES HOMAN

DATE

06-25-2015

ROUTE

SR 412

H.C. HOMAN

WEATHER

CLOUDY

COUNTY

SANDUSKY

R.C. LEU

TEMP.

69°F

TOWNSHIP

TOWNSEND

SECTION

23

T 5 N

R 17 E

TYPE MONUMENT MAG & WASHER


ON SURFACE - ~~BELOW~~ ON

~~LEFT~~ - CL PAV'T - ~~RIGHT~~ ON

9.8' TO RT EDGE PAVEMENT

S.L.M. 599+57

Grid: Northing: 623639.340 Easting: 1868083.362

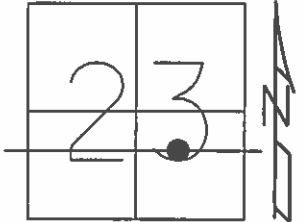

REC: 09-09-1982

P.O.T. 0.6 MI. E. OF CR# 302

POINT WAS SET BY SPLITTING

PAV'T. NOTHING ELSE AVAILABLE.


RR SPK. 0.1'± BELOW SURFACE.

RESET MAG & WASHER

06-03-2003 M.D.B.

UNCOVERED MAG & WASHER

09-17-2015 D.C.H.

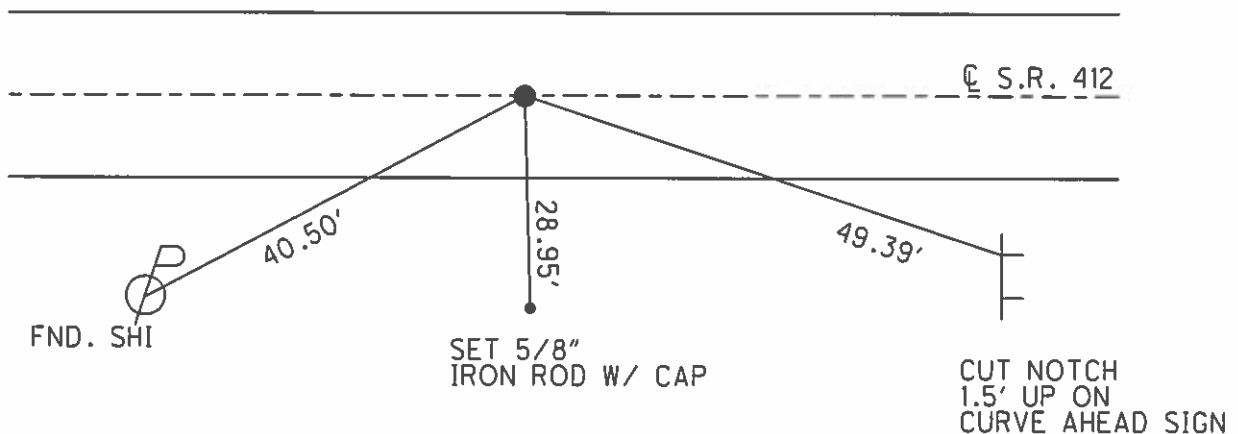

O.D.O.T. DISTRICT 2 SURVEY OFFICE (USE ONLY)

PERSONNEL

REFERENCE NO. 26 B SHEET 23 OF 34

NOTES HOMAN

DATE 06-25-2015

ROUTE SR 412

H.C. HOMAN

WEATHER RAIN

COUNTY SANDUSKY

R.C. LEU

TEMP. 66°F

TOWNSHIP TOWNSEND

SECTION 23

T 5 N R 17 E

TYPE MONUMENT ODOT CAPPED IRON ROD


~~ON SURFACE~~ - BELOW 0.5'

~~LEFT~~ - ℄ PAV'T - RIGHT 12.2'

2.6' TO RT EDGE PAVEMENT


S.L.M. 605+80

Grid: Northing: 623644.850 Easting: 1868704.885

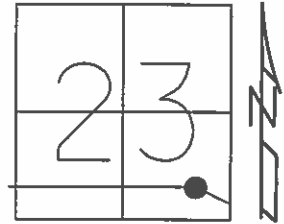

REC: 05-02-1989
P.I. STA. 575+12.75
0.73± MI. E. OF
CR #302 POINT SET
BY SPLITTING PAV'T
FWD. & BK. NOTHING
ELSE WAS AVAILABLE

NOTE: THIS POINT WAS DISTURBED
DURING RESURFACING/ REPLACED
WITH ODOT CAPPED IRON ROD,
WITH PUNCHED HOLE - $\frac{3}{4}$ " X 30"
08-05-1993 RCC OFF PAV'T

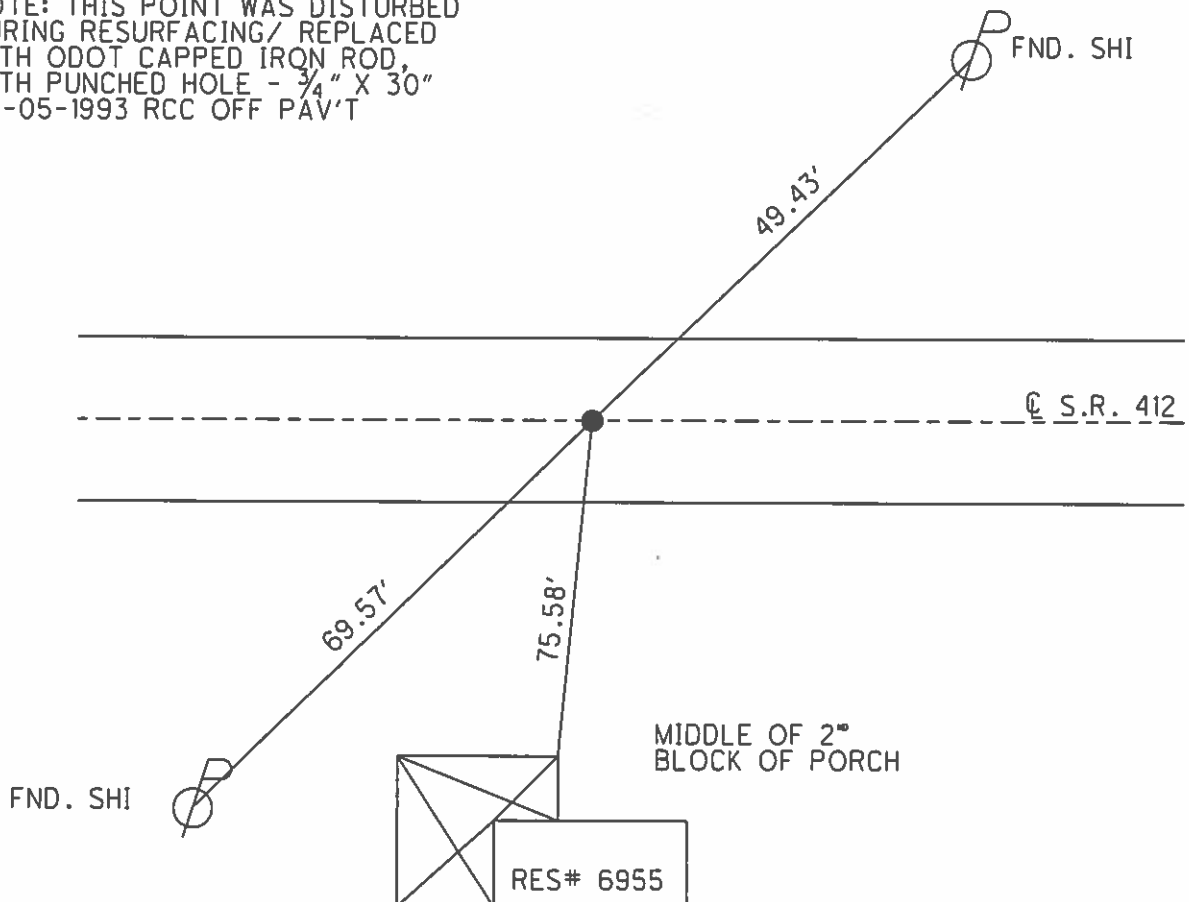

O.D.O.T. DISTRICT 2 SURVEY OFFICE (USE ONLY)


PERSONNEL

REFERENCE NO. 26 B2 SHEET 24 OF 34

NOTES HOMAN DATE 06-25-2015 ROUTE SR 412
H.C. HOMAN WEATHER CLOUDY COUNTY SANDUSKY
R.C. LEU TEMP. 70°F TOWNSHIP TOWNSEND
SECTION 23
T 5 N R 17 E


TYPE MONUMENT MAG & WASHER
ON SURFACE - ~~BELOW~~ ON
LEFT - ℄ PAV'T - RIGHT 4.3'
14.9' TO RT EDGE PAVEMENT
S.L.M. 608+41

Grid: Northing: 623747.498 Easting: 1868948.924

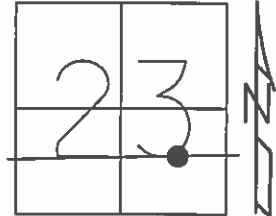

RESET MAG & WASHER
06-03-2003 M.D.B.

UNCOVERED MAG NAIL
09-17-2015 D.C.H.

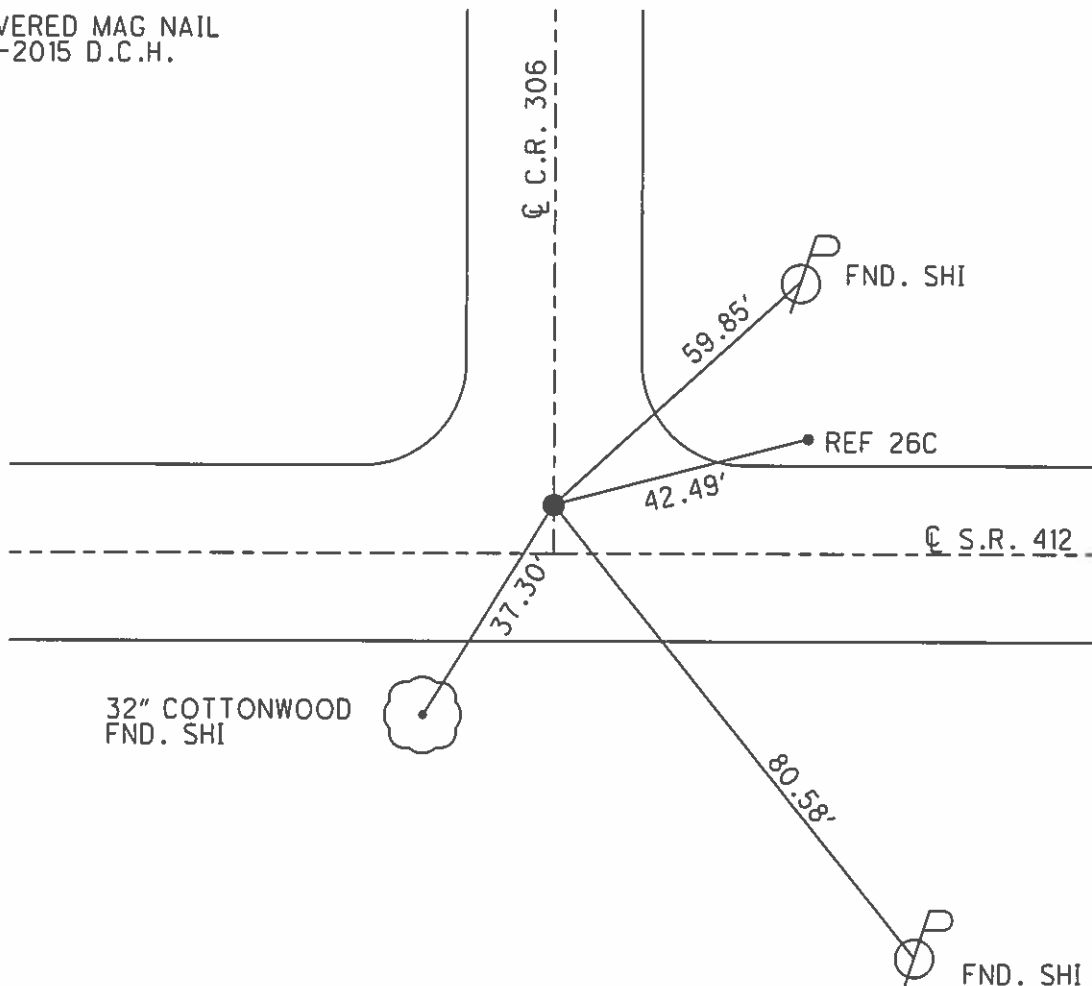

O.D.O.T. DISTRICT 2 SURVEY OFFICE (USE ONLY)

PERSONNEL

REFERENCE NO. 26 C SHEET 25 OF 34

NOTES HOMAN

DATE 04-10-2003

ROUTE SR 412

H.C. HOMAN

WEATHER CLOUDY

COUNTY SANDUSKY

R.C. LEU

TEMP. 35°F

TOWNSHIP TOWNSEND

SECTION 23

T 5 N R 17 E

TYPE MONUMENT PK & WASHER



~~ON SURFACE~~ - BELOW 1.5'

LEFT - Q PAV'T - ~~RIGHT~~ 14.6'

5.2' LT TO LT EDGE PAVEMENT

S.L.M. 608+82

Grid: Northing 623763.871 Easting: 1868988.158

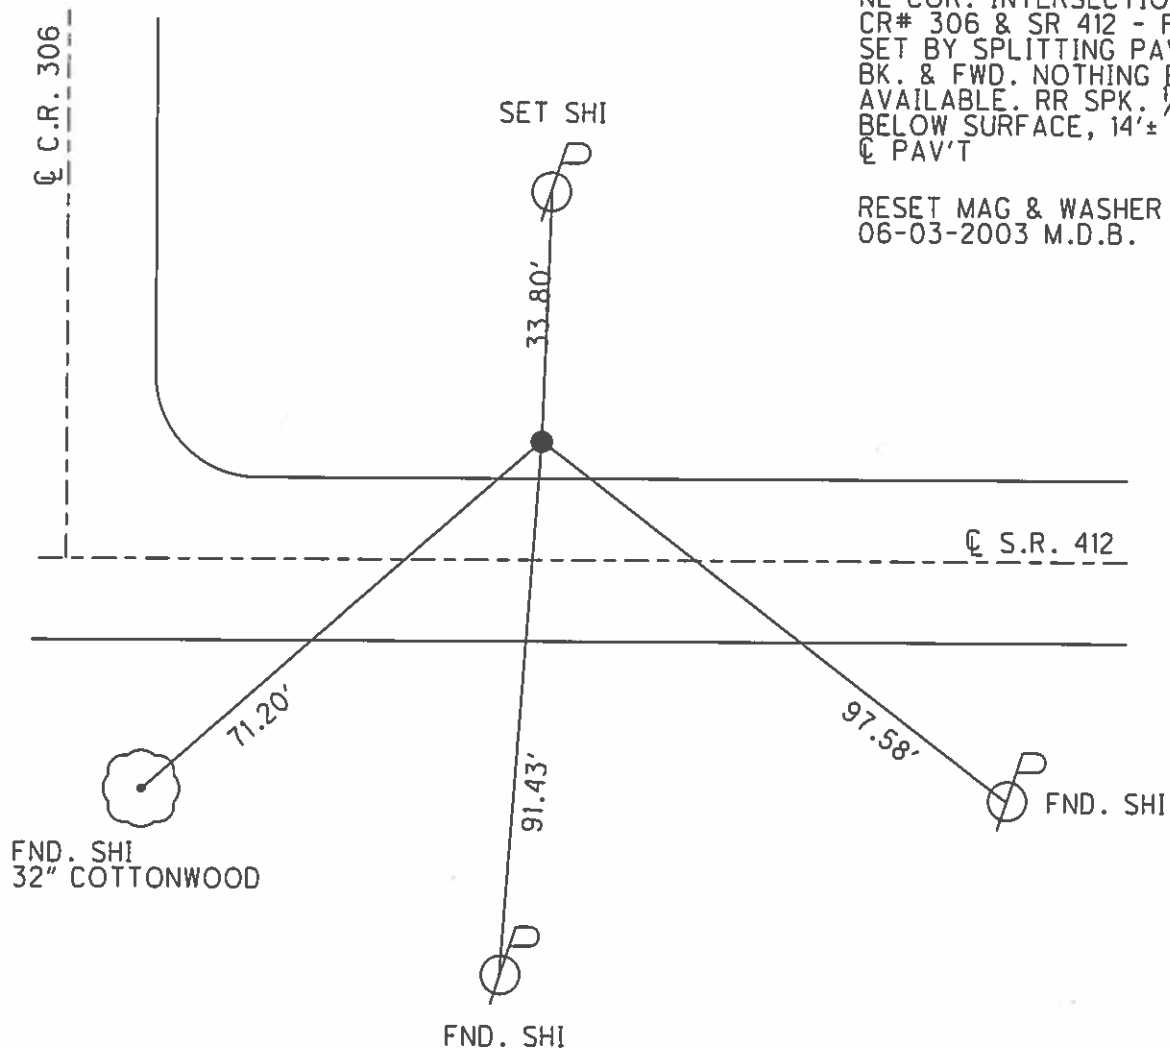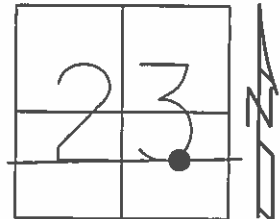

REC: 09-09-1982
P.I. ART.
NE COR. INTERSECTION OF
CR# 306 & SR 412 - POINT
SET BY SPLITTING PAV'T
BK. & FWD. NOTHING ELSE
AVAILABLE. RR SPK. 1/2"
BELOW SURFACE, 14'± LT
Q PAV'T

RESET MAG & WASHER
06-03-2003 M.D.B.

O.D.O.T. DISTRICT 2 SURVEY OFFICE (USE ONLY)

PERSONNEL

REFERENCE NO.

26 D

SHEET

26

OF 34

NOTES HOMAN

DATE

06-26-2015

ROUTE

SR 412

H.C. HOMAN

WEATHER

CLOUDY

COUNTY

SANDUSKY

R.C. LEU

TEMP.

70°F

TOWNSHIP

TOWNSEND

SECTION

23

T 5 N R 17 E

TYPE MONUMENT 1" IPIN


ON SURFACE - BELOW 0.7'

LEFT - C PAV'T - RIGHT 13'

3.3' TO RT EDGE PAVEMENT

S.L.M. 614+48

Grid: Northing: 623630.572 Easting: 1869542.464

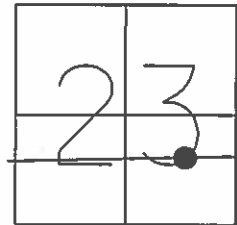

REC: 09-09-1982

P.I. Δ RT

IRON ROD 3' ± LT OF

LT E/P SET BY SPLITTING

PAV'T BACK & USING

CONTROL POINT AHEAD -

0.1 MI. E OF CR# 306

SET SHI
18" CEDAR



103.37'

WOOD FRAME BLDG.

FND. SHI
IN COR.

92.45' (REC)

105.59'




FND. SHI

26.43'

CL S.R. 412

SET LANDSCAPE NAIL
1.5' SOUTH OF EB

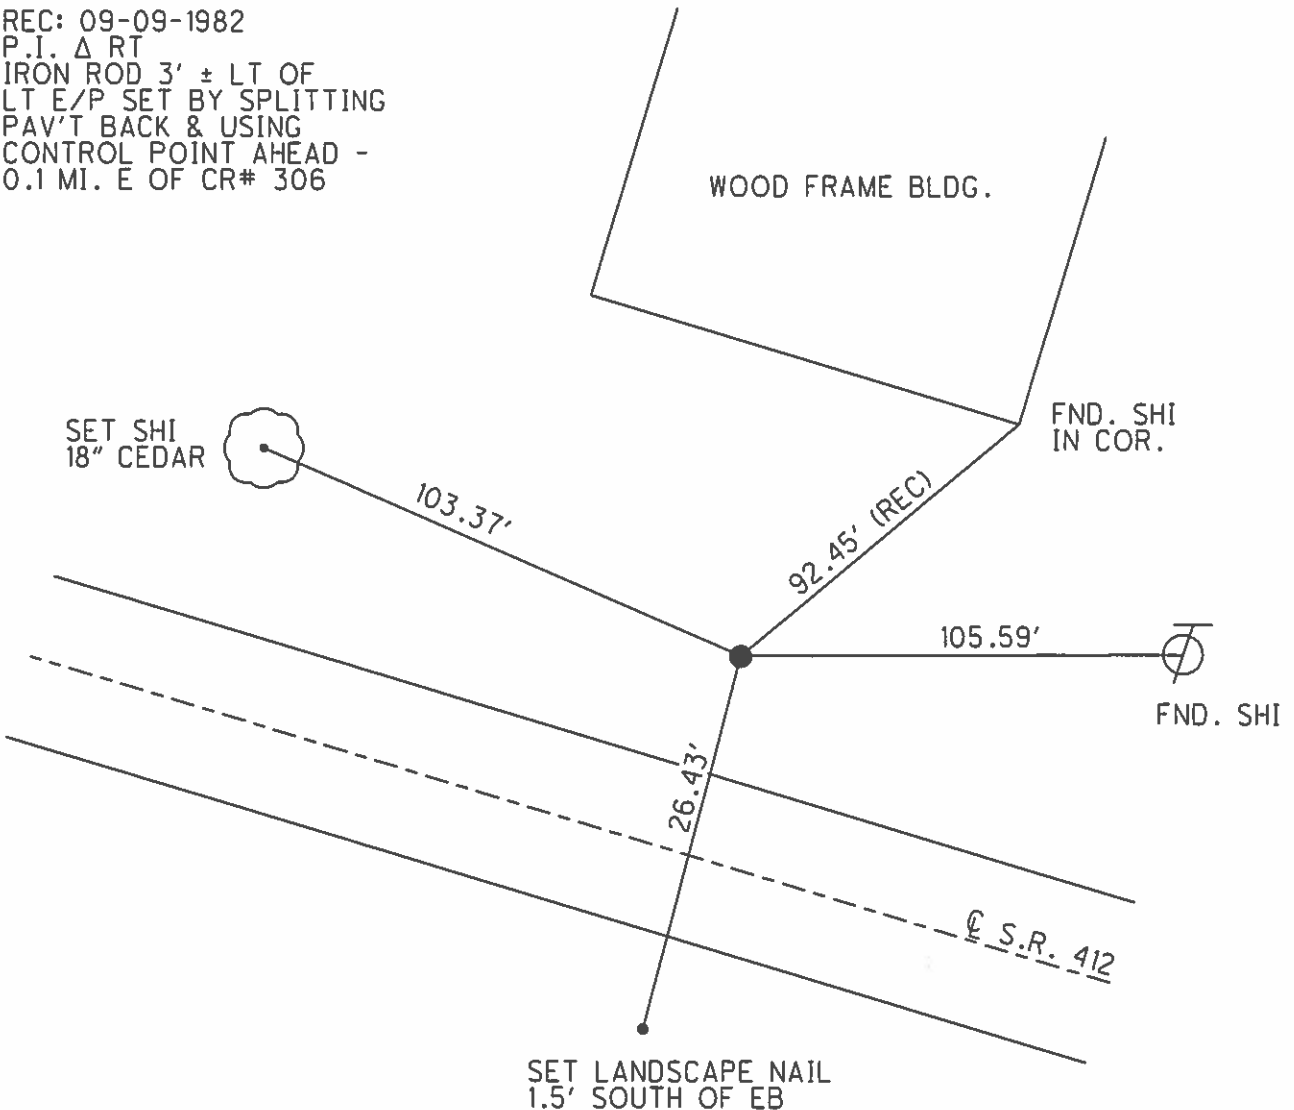

O.D.O.T. DISTRICT 2 SURVEY OFFICE (USE ONLY)

PERSONNEL

REFERENCE NO. 26 E SHEET 27 OF 34

NOTES HOMAN

DATE 06-26-2015

ROUTE SR 412

H.C. HOMAN

WEATHER CLOUDY

COUNTY SANDUSKY

R.C. LEU

TEMP. 70°F

TOWNSHIP TOWNSEND

SECTION 23

T 5 N R 17 E

TYPE MONUMENT MAG & WASHER



ON SURFACE - ~~BELOW~~ ON

~~LEFT~~ - Q PAV'T - RIGHT 3.8'

6' TO RT EDGE PAVEMENT

S.L.M. 618+37

Grid: Northing: 623437.164 Easting: 1869808.013

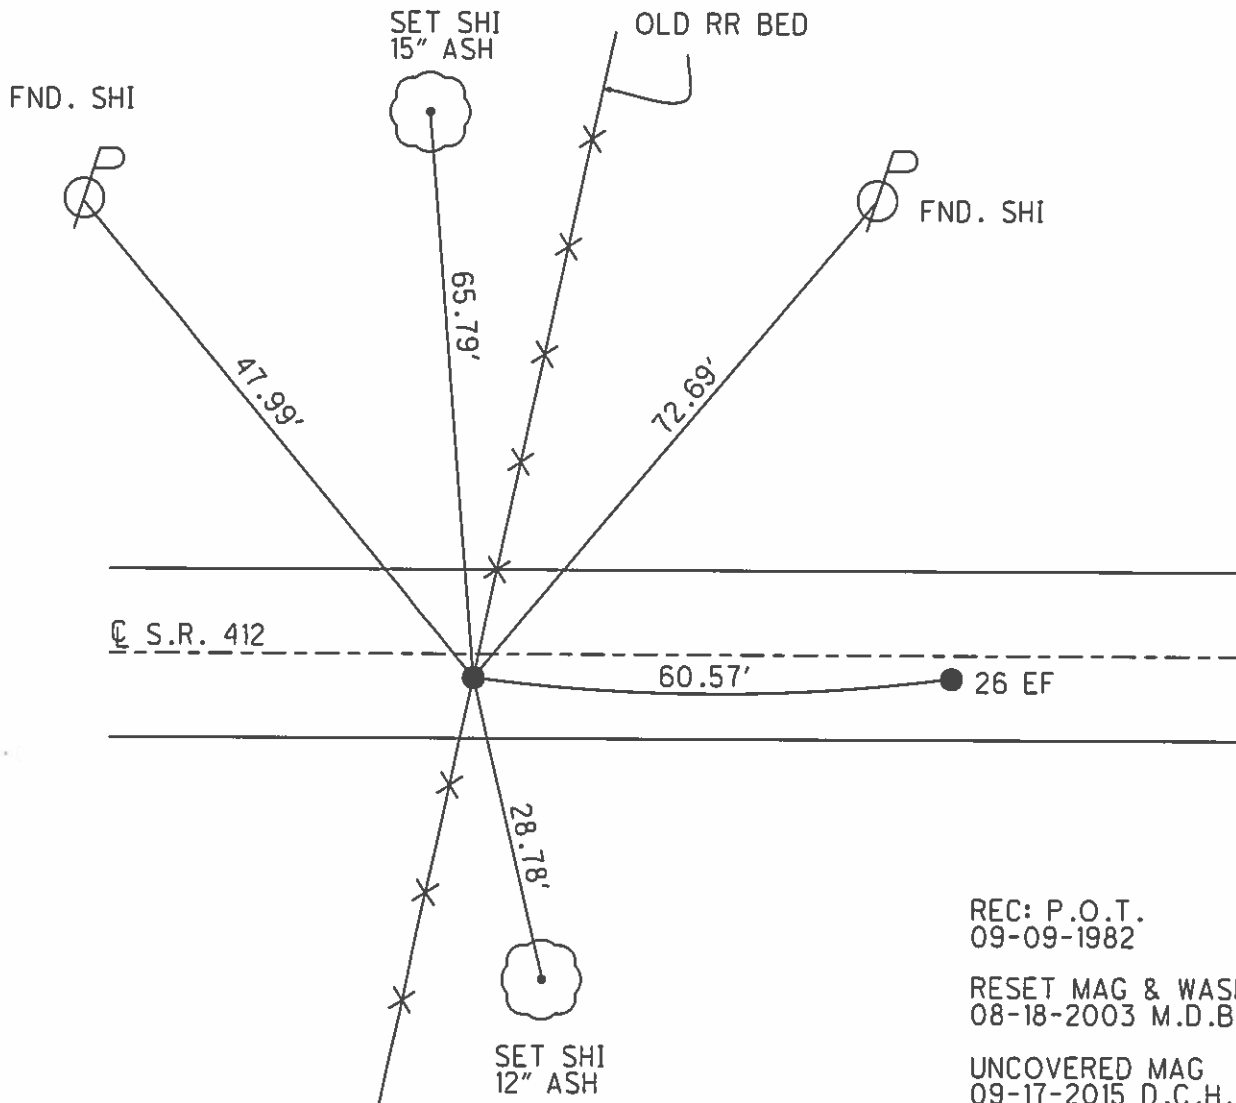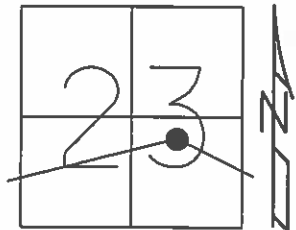

REC: P.O.T.
09-09-1982

RESET MAG & WASHER
08-18-2003 M.D.B.

UNCOVERED MAG
09-17-2015 D.C.H.

O.D.O.T. DISTRICT 2 SURVEY OFFICE (USE ONLY)

PERSONNEL

REFERENCE NO. 26 EF SHEET 28 OF 34

NOTES HOMAN

DATE 06-26-2015

ROUTE SR 412

H.C. HOMAN

WEATHER CLOUDY

COUNTY SANDUSKY

R.C. LEU

TEMP. 70°F

TOWNSHIP TOWNSEND

SECTION 23

T 5 N R 17 E

TYPE MONUMENT MAG & WASHER



ON SURFACE - ~~BELOW~~ ON

~~LEFT~~ - CL PAV'T - RIGHT 3.8'

6' TO RT EDGE PAVEMENT

S.L.M. 618+97.57

Grid: Northing: 623401.539 Easting: 1869856.941

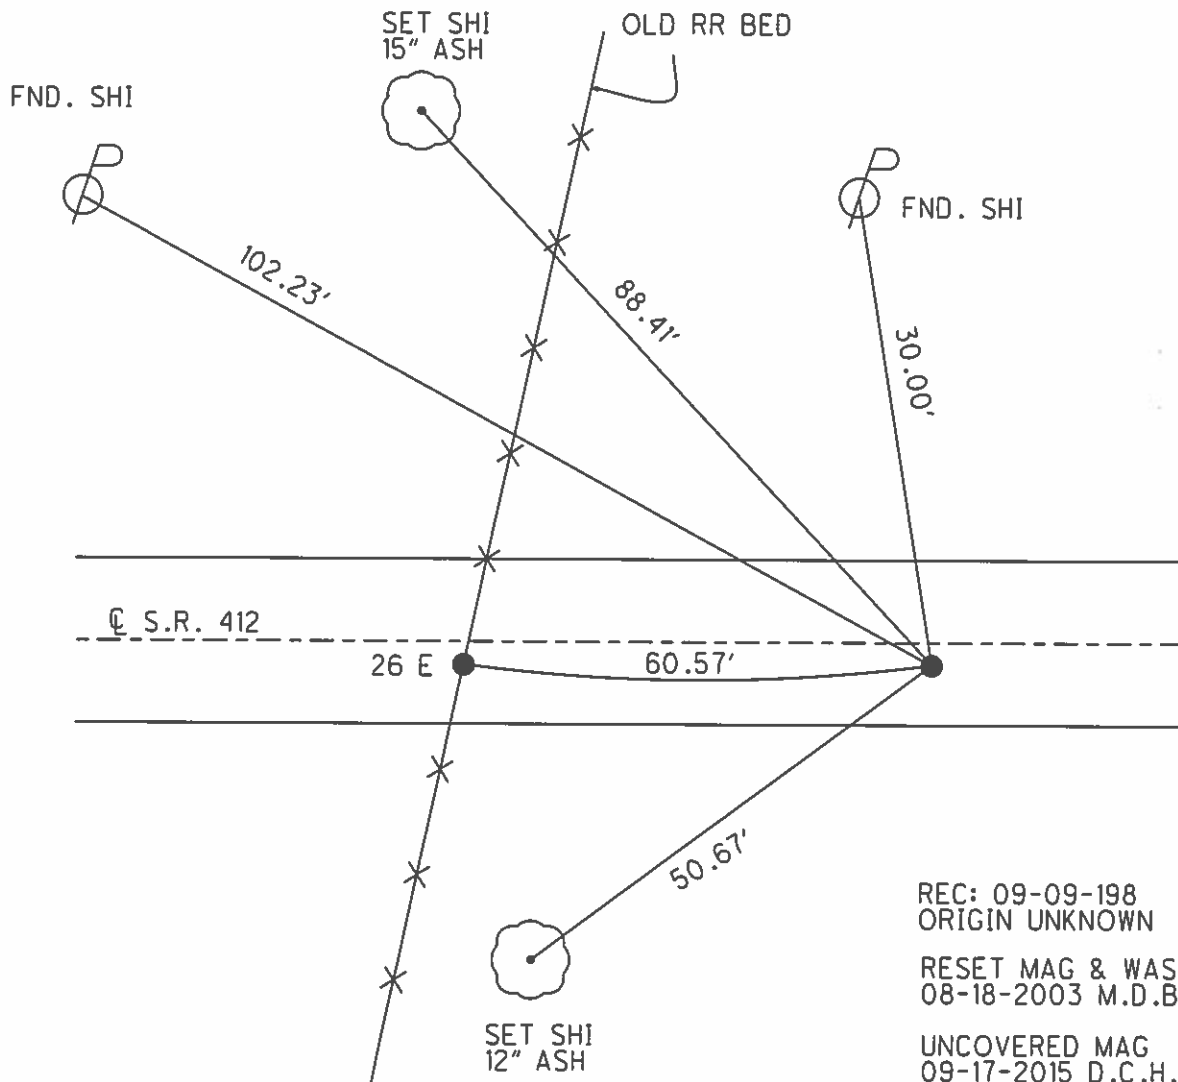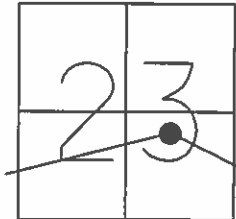

REC: 09-09-198
ORIGIN UNKNOWN

RESET MAG & WASHER
08-18-2003 M.D.B.

UNCOVERED MAG
09-17-2015 D.C.H.

O.D.O.T. DISTRICT 2 SURVEY OFFICE (USE ONLY)

PERSONNEL

REFERENCE NO.

26 F

SHEET

29

OF 34

NOTES HOMAN

DATE

06-26-2015

ROUTE

SR 412

H.C. HOMAN

WEATHER

CLOUDY

COUNTY

SANDUSKY

R.C. LEU

TEMP.

70°F

TOWNSHIP

TOWNSEND

SECTION

23

T 5 N R 17 E

TYPE MONUMENT MAG & WASHER


ON SURFACE - ~~BELOW~~ ON

~~LEFT~~ - ℄ PAV'T - RIGHT 0.4'

9.6' TO RT EDGE PAVEMENT

S.L.M. 631+75

Grid: Northing: 622617.384 Easting: 1870935.580

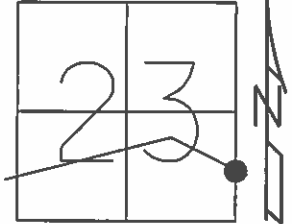


REC: 04-29-2003
NEW POINT ORIGIN
UNKNOWN

RESET MAG & WASHER
06-03-2003

RESET MAG & WASHER
08-18-2003 M.D.B.

UNCOVERED MAG NAIL
09-17-2015 D.C.H.

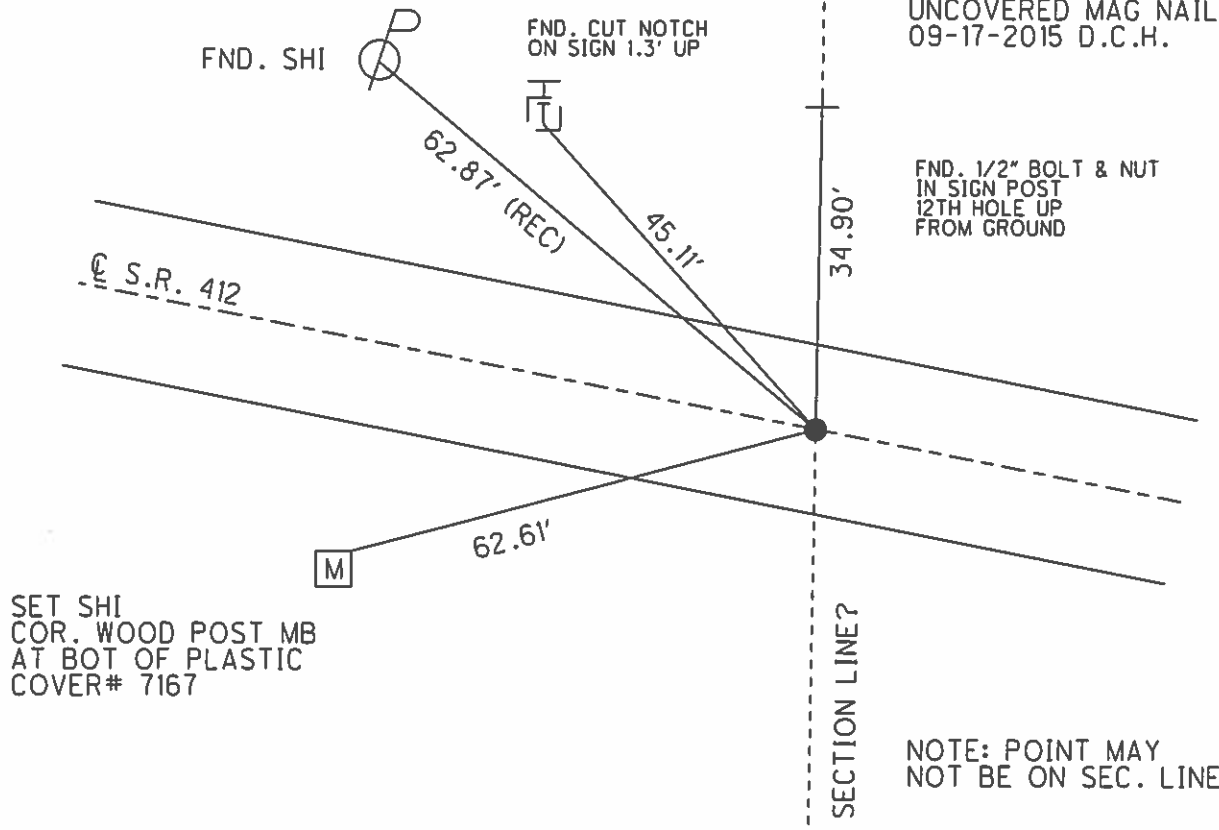

O.D.O.T. DISTRICT 2 SURVEY OFFICE (USE ONLY)

PERSONNEL

REFERENCE NO. 29

SHEET 30 OF 34

NOTES HOMAN

DATE 06-26-2015

ROUTE SR 412

H.C. HOMAN

WEATHER CLOUDY

COUNTY SANDUSKY

R.C. LEU

TEMP. 70°F

TOWNSHIP TOWNSEND

SECTION 24

T 5 N R 17 E

TYPE MONUMENT MAG & WASHER



ON SURFACE - BELOW ON

LEFT - ℄ PAV'T - RIGHT 1.3'

11.6' TO RT EDGE PAVEMENT

S.L.M. 639+85

Grid: Northing: 622141.354 Easting: 1871590.350

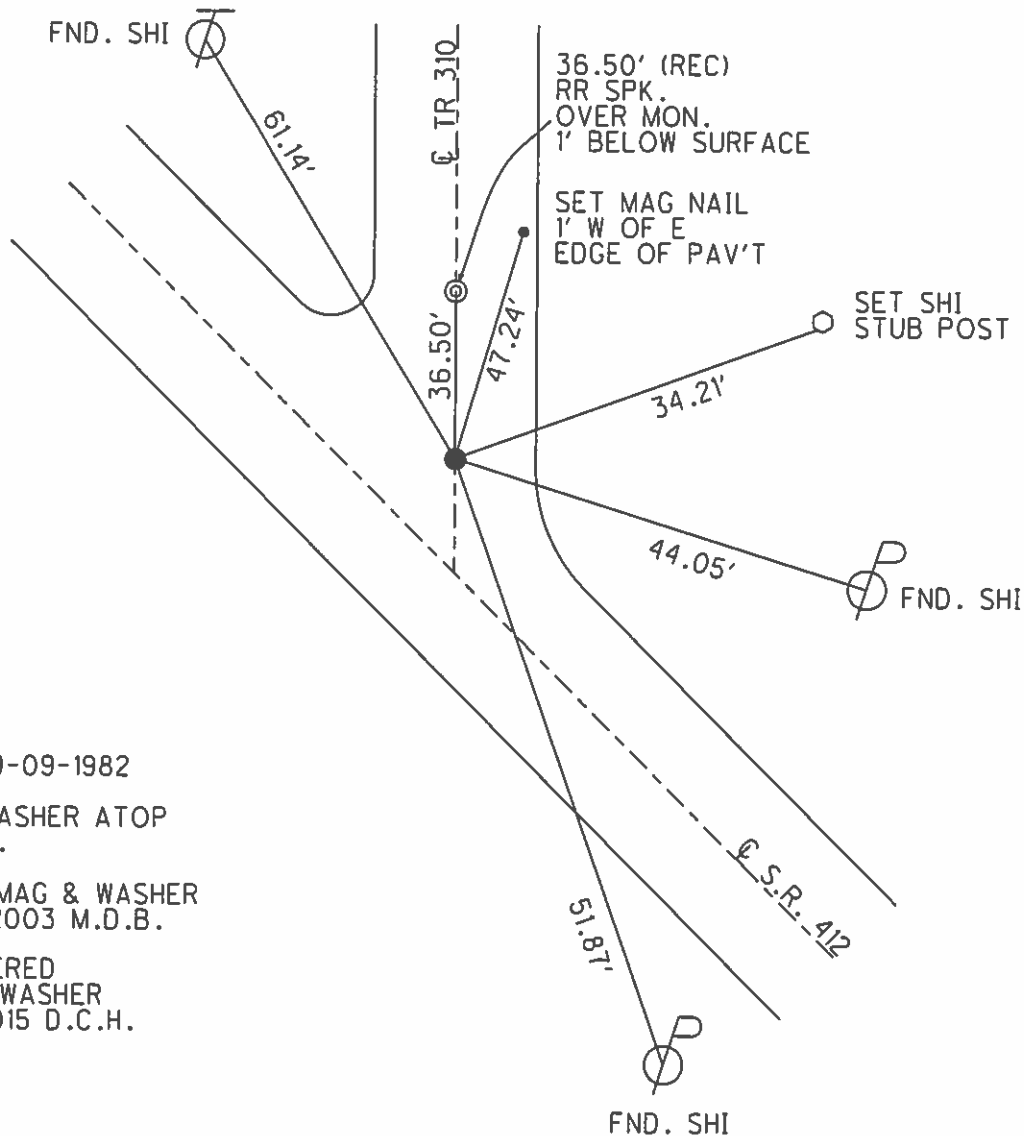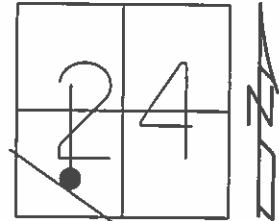

REC: 09-09-1982
P.O.T.
PK & WASHER ATOP
RR SPK.

RESET MAG & WASHER
08-18-2003 M.D.B.

UNCOVERED
MAG & WASHER
9-17-2015 D.C.H.

O.D.O.T. DISTRICT 2 SURVEY OFFICE (USE ONLY)

PERSONNEL

REFERENCE NO. 29A SHEET 31 OF 34

NOTES HOMAN DATE 06-26-2015 ROUTE SR 412

H.C. HOMAN WEATHER CLOUDY COUNTY SANDUSKY

R.C. LEU TEMP. 70°F TOWNSHIP TOWNSEND

SECTION 24

T 5 N R 17 E

TYPE MONUMENT MAG NAIL


ON SURFACE - ~~BELOW~~ ON

LEFT - C PAV'T - ~~RIGHT~~ 7.3'

3.2' TO LT EDGE PAVEMENT

S.L.M. 651+60

Grid: Northing: 621451.984 Easting: 1872538.883

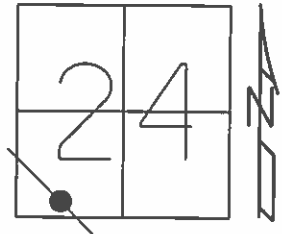

REC: 09-09-1982

P.I.


RR SPK 0.1' BELOW SURFACE

RESET MAG & WASHER

08-18-2003 M.D.B.

UNCOVERED MAG NAIL

09-17-2015 D.C.H.

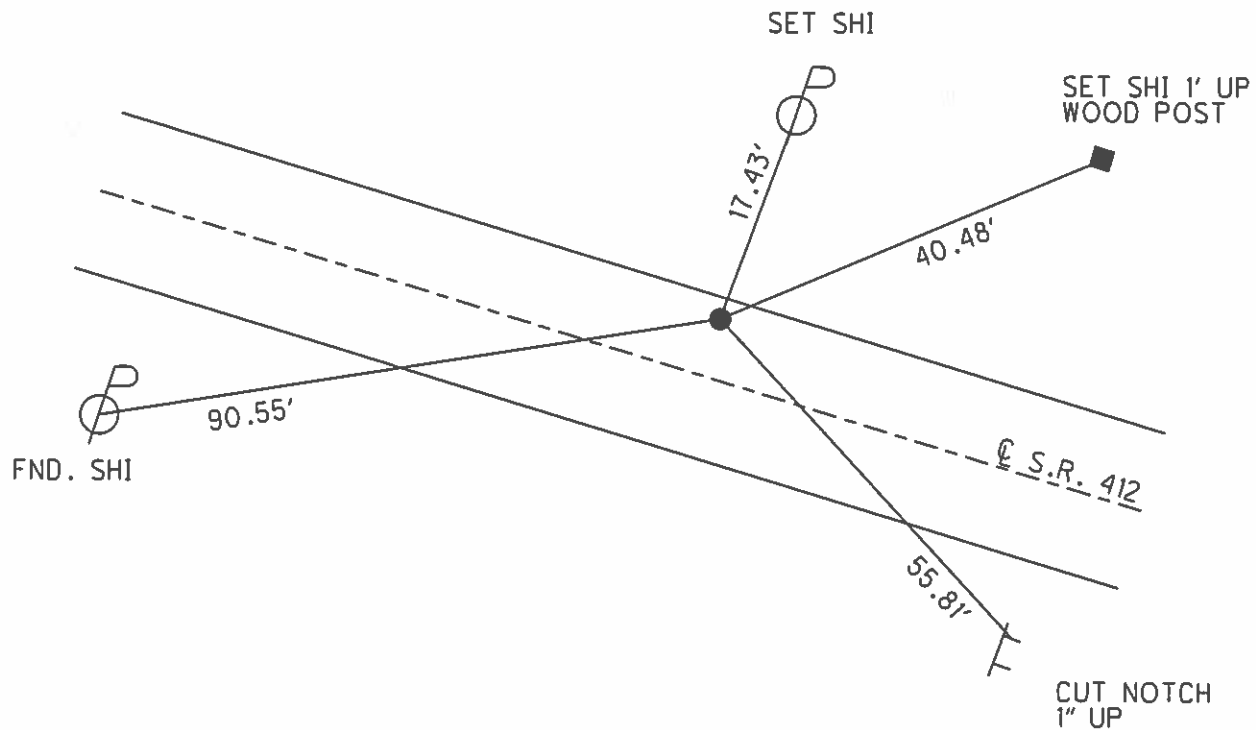

O.D.O.T. DISTRICT 2 SURVEY OFFICE (USE ONLY)

PERSONNEL

REFERENCE NO. 30

SHEET 32 OF 34

NOTES HOMAN

DATE 06-26-2015

ROUTE SR 412

H.C. HOMAN

WEATHER CLOUDY

COUNTY SANDUSKY

R.C. LEU

TEMP. 70°F

TOWNSHIP TOWNSEND

SECTION 24

T 5 N R 17 E

TYPE MONUMENT 1" IPIN



~~ON SURFACE~~ - BELOW 0.1'

LEFT - CL PAV'T - ~~RIGHT~~ 16.4'

6.1' TO LT EDGE PAVEMENT

S.L.M. 653+84

Grid: Northing: 621305.491 Easting: 1872710.071

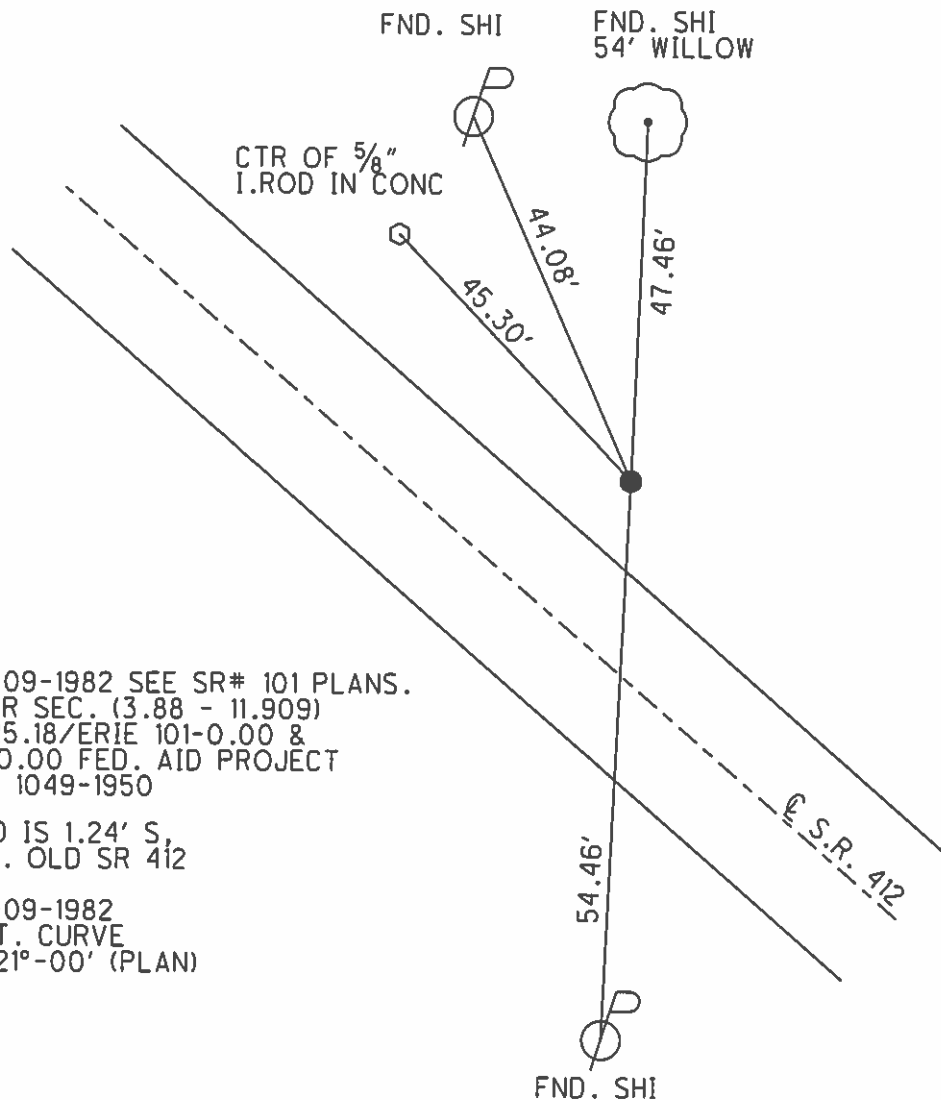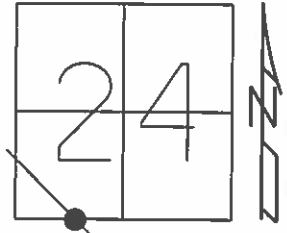

REC: 09-09-1982 SEE SR# 101 PLANS.
POST WAR SEC. (3.88 - 11.909)
SAN-12-25.18/ERIE 101-0.00 &
ERIE-12-0.00 FED. AID PROJECT
S-447 (1) 1049-1950

REC: ROD IS 1.24' S,
FROM CL. OLD SR 412

REC: 09-09-1982
PI CONST. CURVE
DELTA= 21°-00' (PLAN)
(2+44)

PERSONNEL TITLE PERSONNEL TITLE

Schneider

COUNTY Sandusky

DATE 7-9-72

Mosser

S. R. 412

WEATHER Hot

Geyman

SEC. 24

TEMP. 88°

DESCRIPTION


Townsend Twp.

JOB NO.

LEFT

CENTER LINE

RIGHT

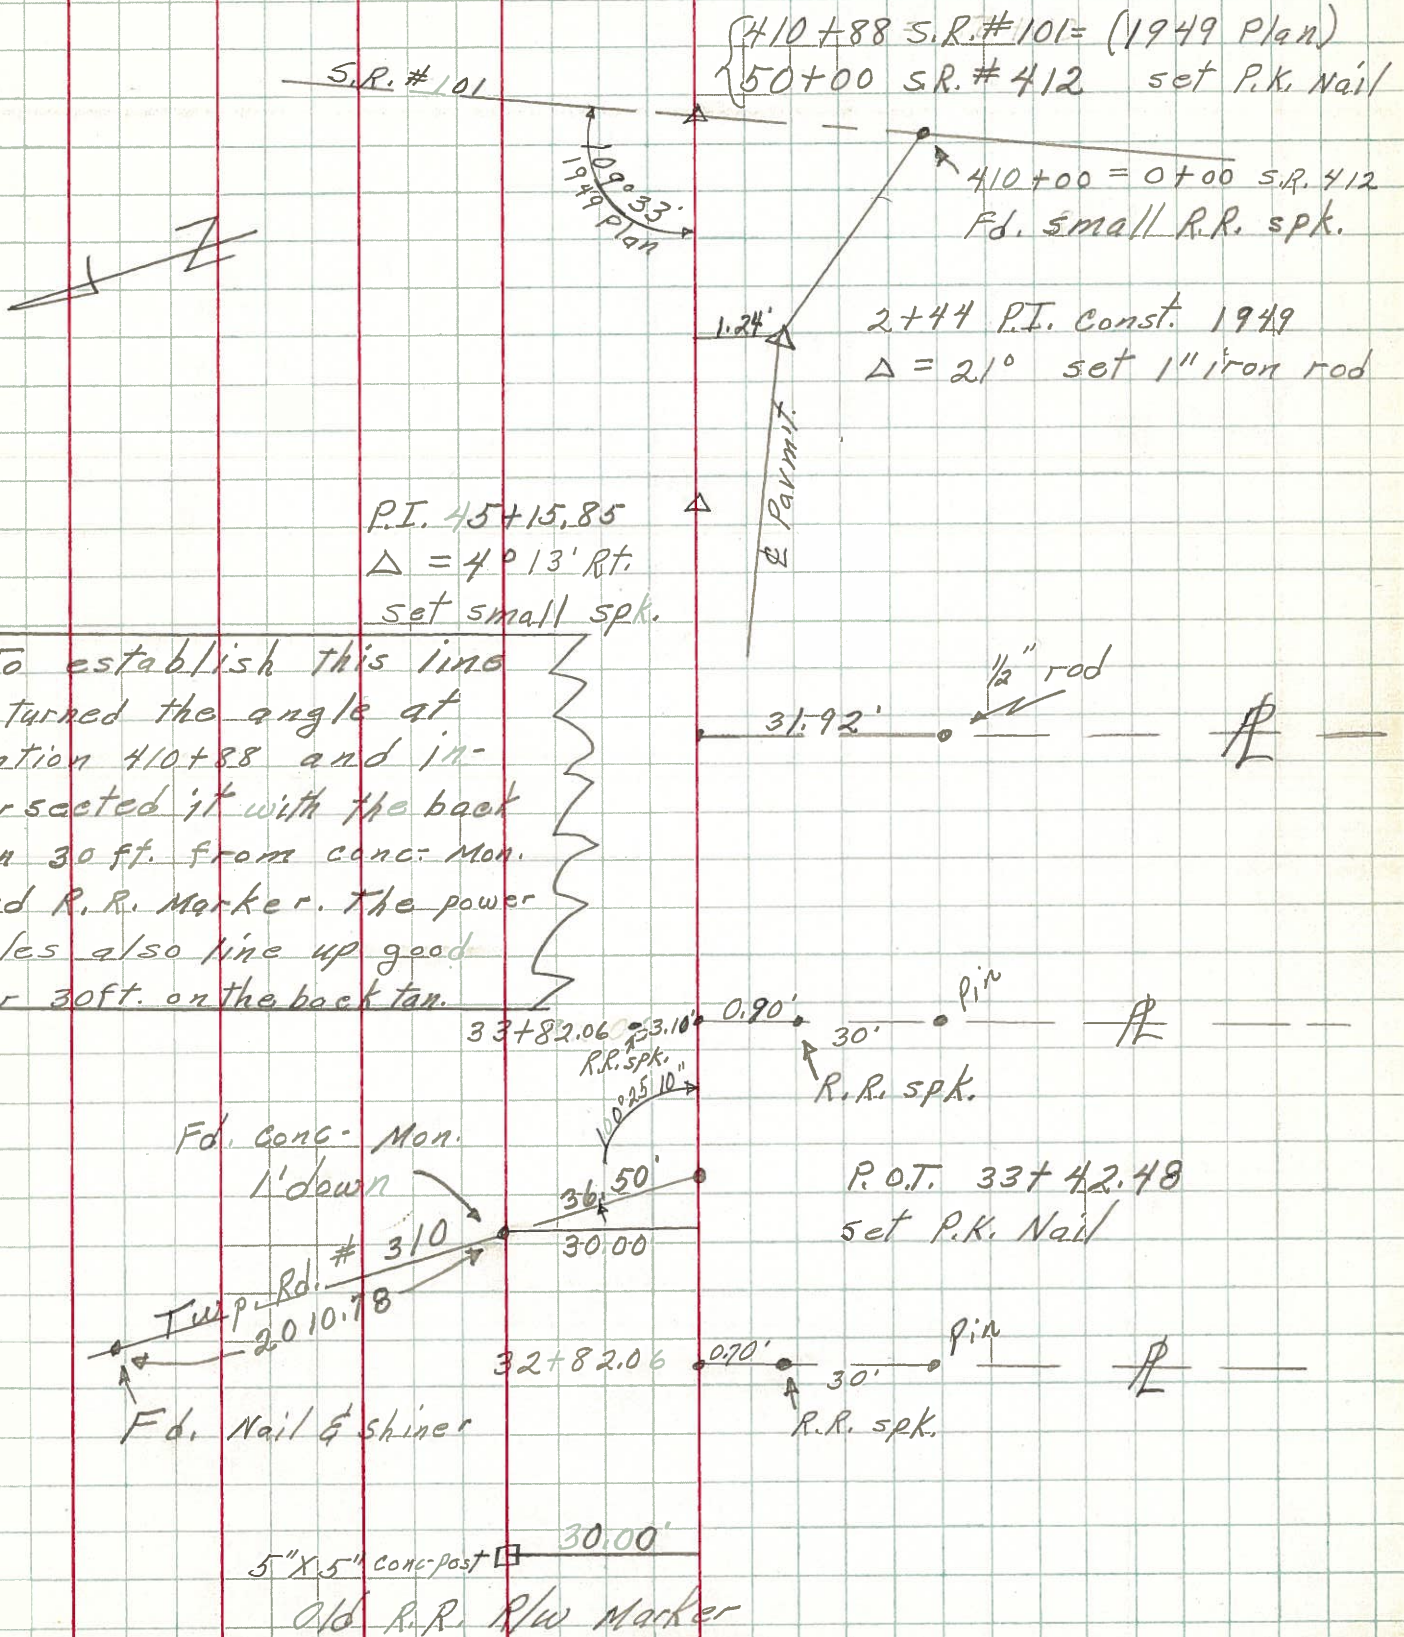

PERSONNEL	TITLE	PERSONNEL	TITLE	COUNTY	DATE	S. R.	WEATHER	TEMP.
Schneider				Sandusky	7-17-72	412	Hot	88°
Barbour								
Geyman						24		

DESCRIPTION Townsend Twp. LEFT CENTER LINE RIGHT JOB NO.

