

O.D.O.T. DISTRICT 2 SURVEY OFFICE (USE ONLY)

PERSONNEL

REFERENCE NO. 6A

SHEET 23 OF 33

NOTES MILLER

DATE 10/11/24

ROUTE SR 412

H.C. MILLER

WEATHER SUNNY

COUNTY SANDUSKY

R.C. BARRIERE

TEMP. 70°

TOWNSHIP RILEY

NEISE

SECTION 28

DWG BY PRESTON-COLVIN PID PAVING TRAIN

T 5 N R 16 E

TYPE MONUMENT MAG/WASHER

ON SURFACE - ~~BELOW~~ ON

OFFSET Q PAVEMENT 10' ~~LT~~ : RT

0' TO RT EDGE PAVEMENT

STATION: 181+05.26

HORIZ.DATUM: NAD83 (2011)


GEOID: 18

GRID: NORTHING: 619196.360

EASTING: 1826574.018

LDP: NORTHING: 315368.4529

EASTING: 186811.7762

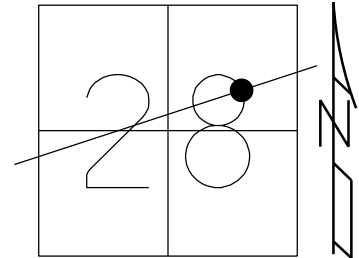

RECORD: 02-04-1975

P.O.T. ROUND 2 RR SPK.S ON N/E R
SPIKE TO SOUTH ON Q 1.17 APART


SET P.K./WASHER
8/2/93, JLR

FD P.K./WASHER
REF17
12/11/12, JMR

SET MAG/WASHER
NEWREFA6
7/1/15, DCH

FD MAG/WASHER
REF6A
9/3/24, JAM

SET MAG
10/11/24, JAM

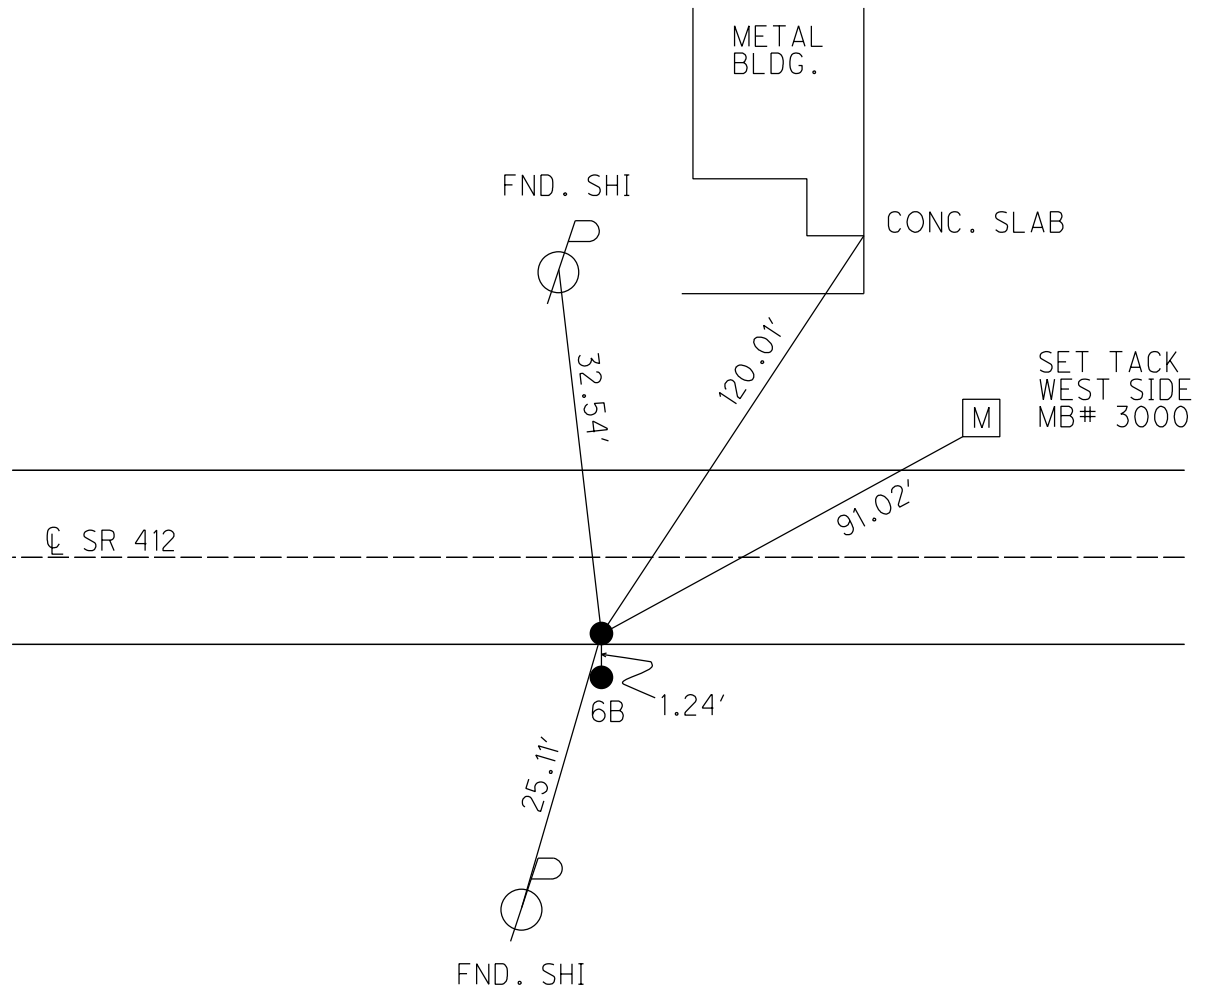

O.D.O.T. DISTRICT 2 SURVEY OFFICE (USE ONLY)

PERSONNEL

REFERENCE NO.

6 A

SHEET 23 OF 33

NOTES HOMAN

DATE

10-09-2014

ROUTE SR 412

H.C. WESTFALL

WEATHER

PARTLY SUNNY

COUNTY SANDUSKY

R.C. RHOADES

TEMP.

55°

TOWNSHIP RILEY

LEU

SECTION 28

T 5 N R 16 E

TYPE MONUMENT MAG/WASHER

ON SURFACE - ~~BELOW~~ ON

~~LEFT~~ - C PAV'T - RIGHT 10'

0' TO RT. EDGE PAVEMENT

S.L.M. 181+05.26

Grid: Northing: 619196.360 Easting: 1826574.018


RECORD: 02-04-1975

P.O.T. ROUND 2 RR SPK.S ON N/E R
SPIKE TO SOUTH ON C 1.17 APART

SET P.K./WASHER
8/2/93, JLR

FD P.K./WASHER
REF17
12/11/12, JMR

SET MAG/WASHER
NEWREFA6
7/1/15, DCH

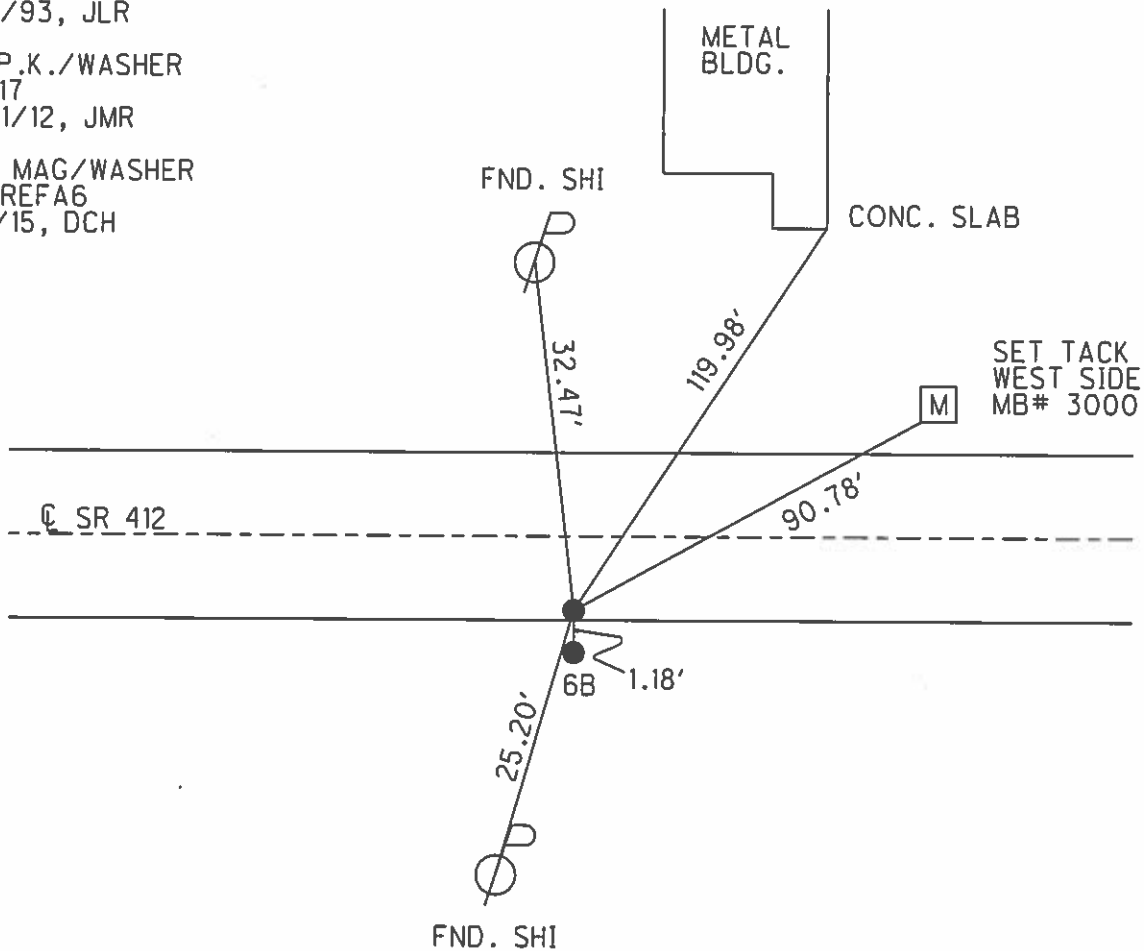

O.D.O.T. DISTRICT 2 SURVEY OFFICE

PERSONNEL

REFERENCE NO. C-A

SHEET 16 OF 21

NOTES CHENEY

H.C. RIPPLE

R.C. BARBOUR

GEYMAN

DATE 4-28-93

WEATHER PART SUNNY

TEMP. 55°

ROUTE SR#412

COUNTY SANDUSKY

TOWNSHIP RILEY

SECTION 28

T5 N R 16 E

TYPE MONUMENT Not Found


ON SURFACE - BELOW

LEFT- & PAW'T. - RIGHT

 TO EDGE PAVEMENT

S.L.M. 180+15

NOTE: Ties Cross
Good!

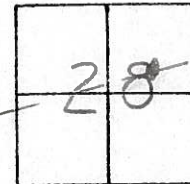

Record: 2-4-75
P.O.T. Found 2 RR Spks. on N&S &
Spike to South on & 1.17 Apart


NOTE: Set P.K. &
WASHERS 8-2-93
J.L.R.

& PAVM'T.

SR #412

NOTE: ON RT. EP.
10' RT &

NOTE: 1.2' RT. RT E/P
11.2' RT. &

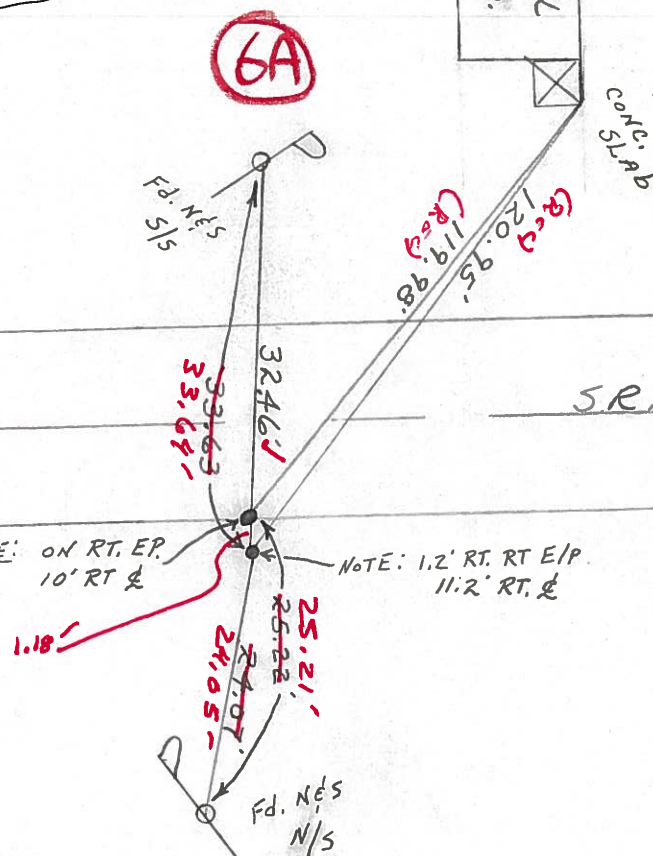

Preventive Maintenance
Microsurfaced 2000
Existing Point Uncovered
Date 7-24-2000

Tied 2/4/75

DATE Drawn 1/30/75

PERSONNEL

TITLE

PERSONNEL

TITLE

Cronin

Schneider

COUNTY Sandusky

Ash

Messer

S. R. # 4/2

WEATHER overcast

Ripple

Barbour S.L.

SEC.

TEMP. 30°

Geyman S.L.

DESCRIPTION Ties for Control Points

JOB NO.

