

O.D.O.T. DISTRICT 2 SURVEY OFFICE (USE ONLY)

PERSONNEL

REFERENCE NO. 6B

SHEET 24 OF 33

NOTES MILLER
H.C. MILLER
R.C. BARRIERE
NEISE

DATE 10/11/24
WEATHER SUNNY
TEMP. 70°

ROUTE SR 412
COUNTY SANDUSKY
TOWNSHIP RILEY
SECTION 28

DWG BY PRESTON-COLVIN PID PAVING TRAIN

T 5 N R 16 E

TYPE MONUMENT MAG/WASHER

ON SURFACE - ~~BELOW~~ ON

OFFSET 11.2' LT : RT

1.2' TO RT EDGE PAVEMENT

STATION: 181+05.26

HORIZ.DATUM: NAD83 (2011)


GEOID: 18

GRID: NORTHING: 619195.198

EASTING: 1826574.013

LDP: NORTHING: 315367.2089

EASTING: 186811.7945

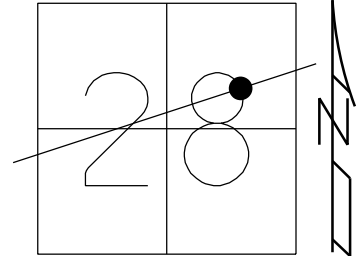

RECORD: 02-04-1975
P.O.T. ROUND 2 RR SPK.S ON N/E $\frac{1}{2}$
SPIKE TO SOUTH ON $\frac{1}{2}$ 1.17' APART


SET P.K./WASHER
8/2/93, JLR

FD P.K./WASHER
REF18
12/11/12, JMR

SET MAG/WASHER
NEWREFB6
7/1/15, DCH

FD MAG/WASHER
REF6B
9/3/24, JAM

SET MAG/WASHER
10/11/24, JAM

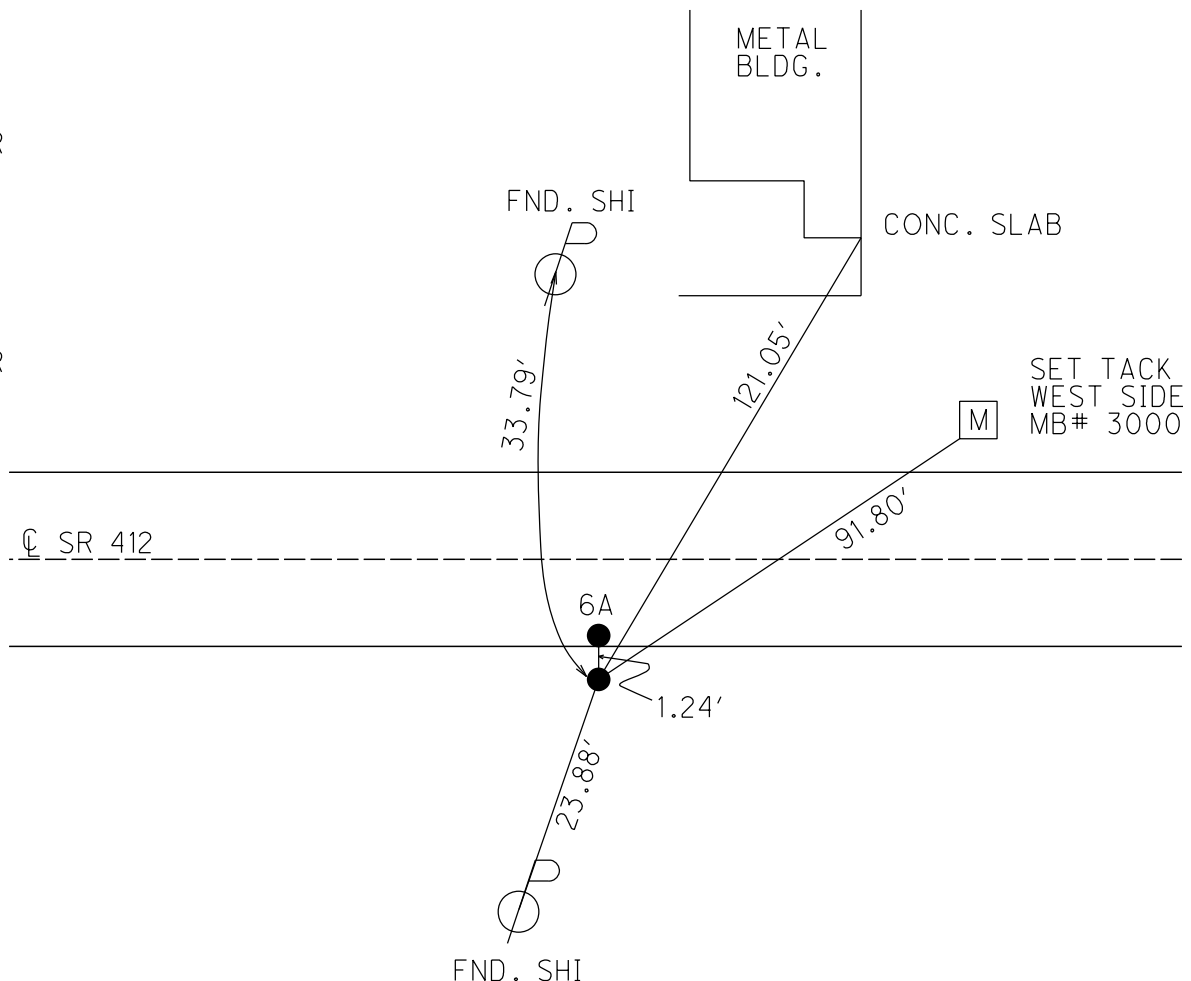

O.D.O.T. DISTRICT 2 SURVEY OFFICE (USE ONLY)

PERSONNEL

REFERENCE NO. 6 B

SHEET 24 OF 33


NOTES HOMAN
H.C. WESTFALL
R.C. RHOADES
LEU

DATE 10-09-2014
WEATHER PARTLY SUNNY
TEMP. 55°

ROUTE SR 412
COUNTY SANDUSKY
TOWNSHIP RILEY
SECTION 28
T 5 N R 16 E

TYPE MONUMENT MAG & WASHER
ON SURFACE - BELOW ON
~~LEFT~~ - CL PAV'T - RIGHT 11.2'
1.2' RT TO RT EDGE PAVEMENT
S.L.M. 180+15

Grid: Northing: 619195.198 Easting: 1826574.013

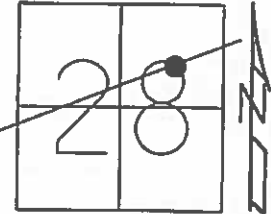


RECORD: 02-04-1975
P.O.T. ROUND 2 RR SPK.5 ON N/E R
SPIKE TO SOUTH ON CL 1.17' APART

SET P.K./WASHER
8/2/93, JLR

FD P.K./WASHER
REF18
12/11/12, JMR

SET MAG/WASHER
NEWREFB6
7/1/15, DCH

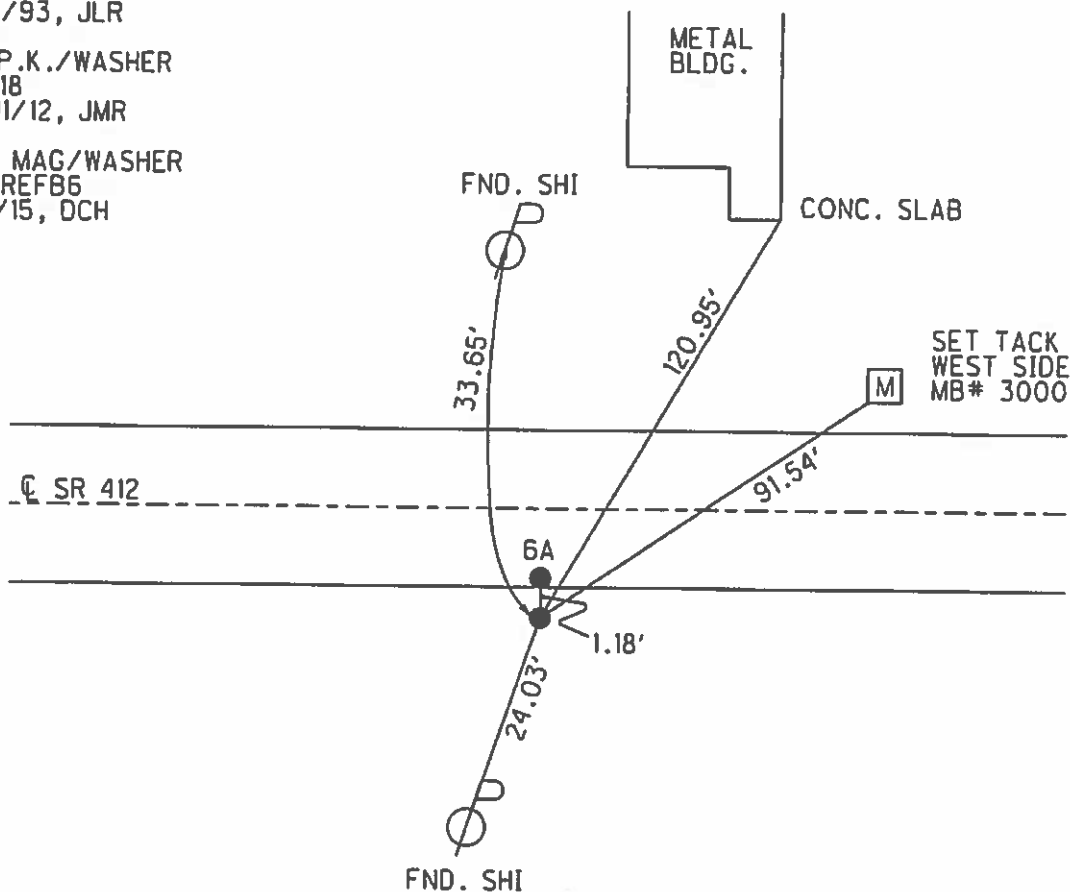

O.D.O.T. DISTRICT 2 SURVEY OFFICE

PERSONNEL

REFERENCE NO. C-A

SHEET 16 OF 21

NOTES CHENEY

H.C. RIPPLE

R.C. BARBOUR

GEYMAN

DATE 4-28-93

WEATHER PART SUNNY

TEMP. 55°

ROUTE SR#412

COUNTY SANDUSKY

TOWNSHIP RILEY

SECTION 28

T5 N R 16 E

TYPE MONUMENT Not Found


ON SURFACE - BELOW

LEFT- & PAV'T. - RIGHT

 TO EDGE PAVEMENT

S.L.M. 180+15


NOTE: Ties Cross Good!

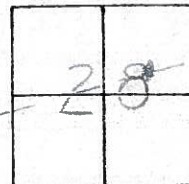

Record: 2-4-75

P.O.T. Found 2 RR Spks. on NE'S & Spike to South on & 1.17 Apart

NOTE: Set P.K. & WARSHERS 8-2-93 J.L.R.

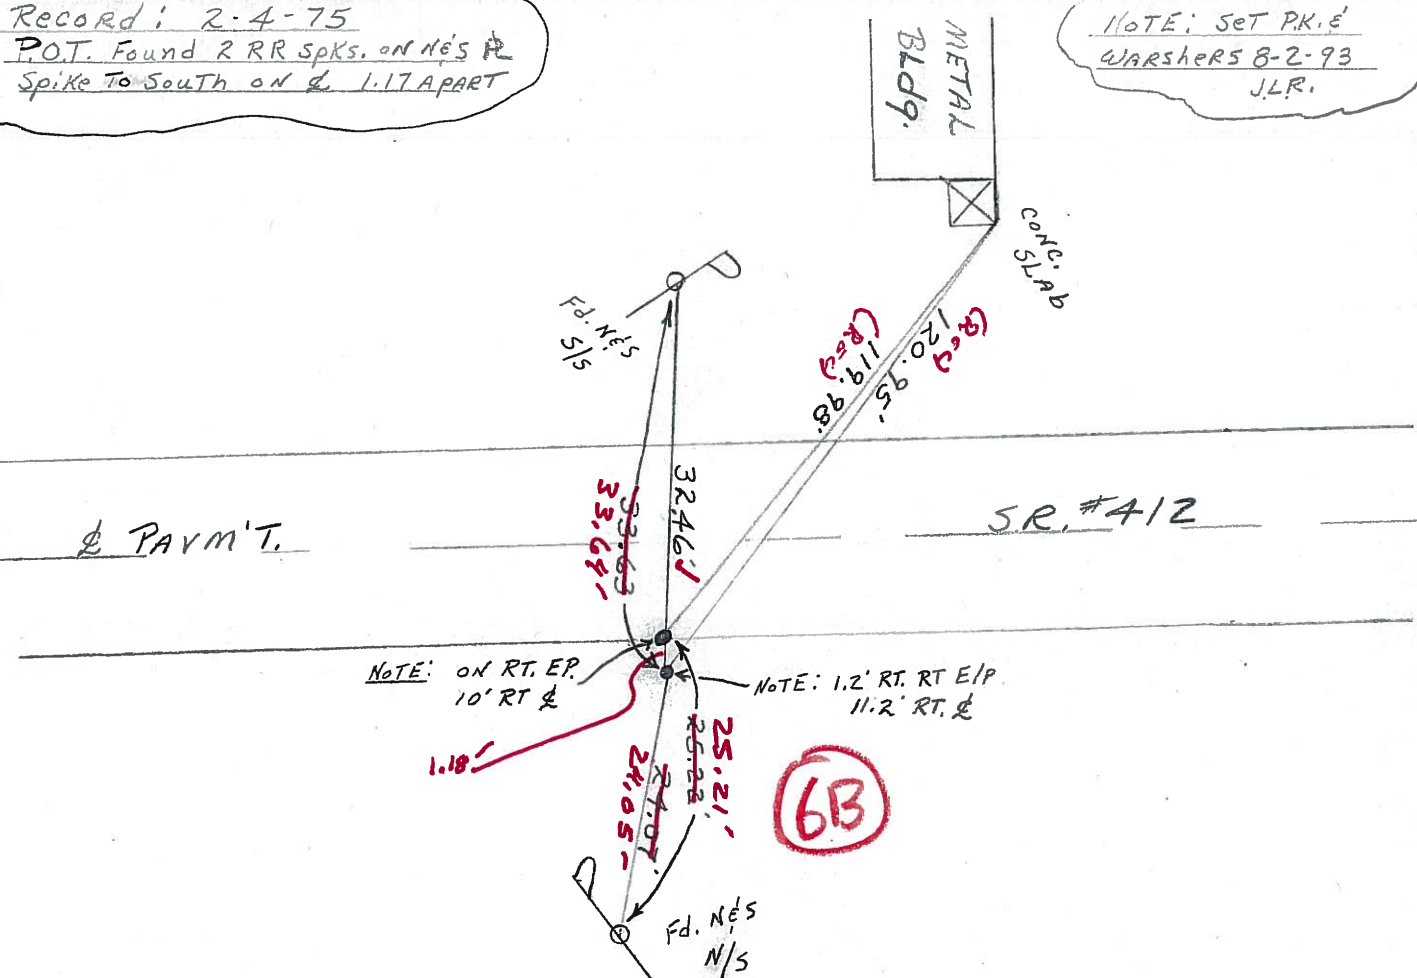

Preventive Maintenance
Microsurfaced 2000
Existing Point Uncovered
Date 7-24-2000

