

# O.D.O.T. DISTRICT 2 SURVEY OFFICE (USE ONLY)

PERSONNEL

REFERENCE NO. 7A

SHEET 26 OF 33

NOTES MILLER  
H.C. MILLER  
R.C. BARRIERE

DATE 9/3/24  
WEATHER SUNNY  
TEMP. 65°

ROUTE SR 412  
COUNTY SANDUSKY  
TOWNSHIP RILEY  
SECTION 28

T 5 N R 16 E

DWG BY PRESTON-COLVIN PID PAVING TRAIN

TYPE MONUMENT MAG NAIL

ON SURFACE - ~~BELOW~~ ON

OFFSET  $\varnothing$  PAVEMENT 3.5' LT : ~~RT~~

6.5' TO LT EDGE PAVEMENT

STATION: 181+05.26

HORZ.DATUM: NAD83 (2011)


GEOID: 18

GRID: NORTHING: 619358.814

EASTING: 1827905.896

LDP: NORTHING: 315540.2046

EASTING: 188142.5459

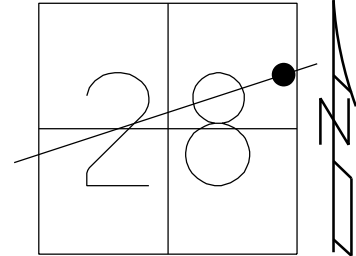

RECORD: 10-11-1984  
ON SEC. LINE SET PK & WASHER  
ATOP R.R. SPK. FROM COUNTY  
REFERENCES APPEARS TO BE ON  
BACK TANG OF SR 412 PRODUCED  
EASTERLY 3.5'± LT. OF  $\varnothing$  OF PAVM'T


SET P.K./WASHER  
8/2/93, JLR

FD P.K./WASHER  
REF20  
12/11/12, JMR

SET MAG WASHER  
NEWREFA7  
7/1/15, DCH

FD MAG/WASHER  
REF7A  
9/3/24, JAM

FD MAG/WASHER  
10/3/24, JAM

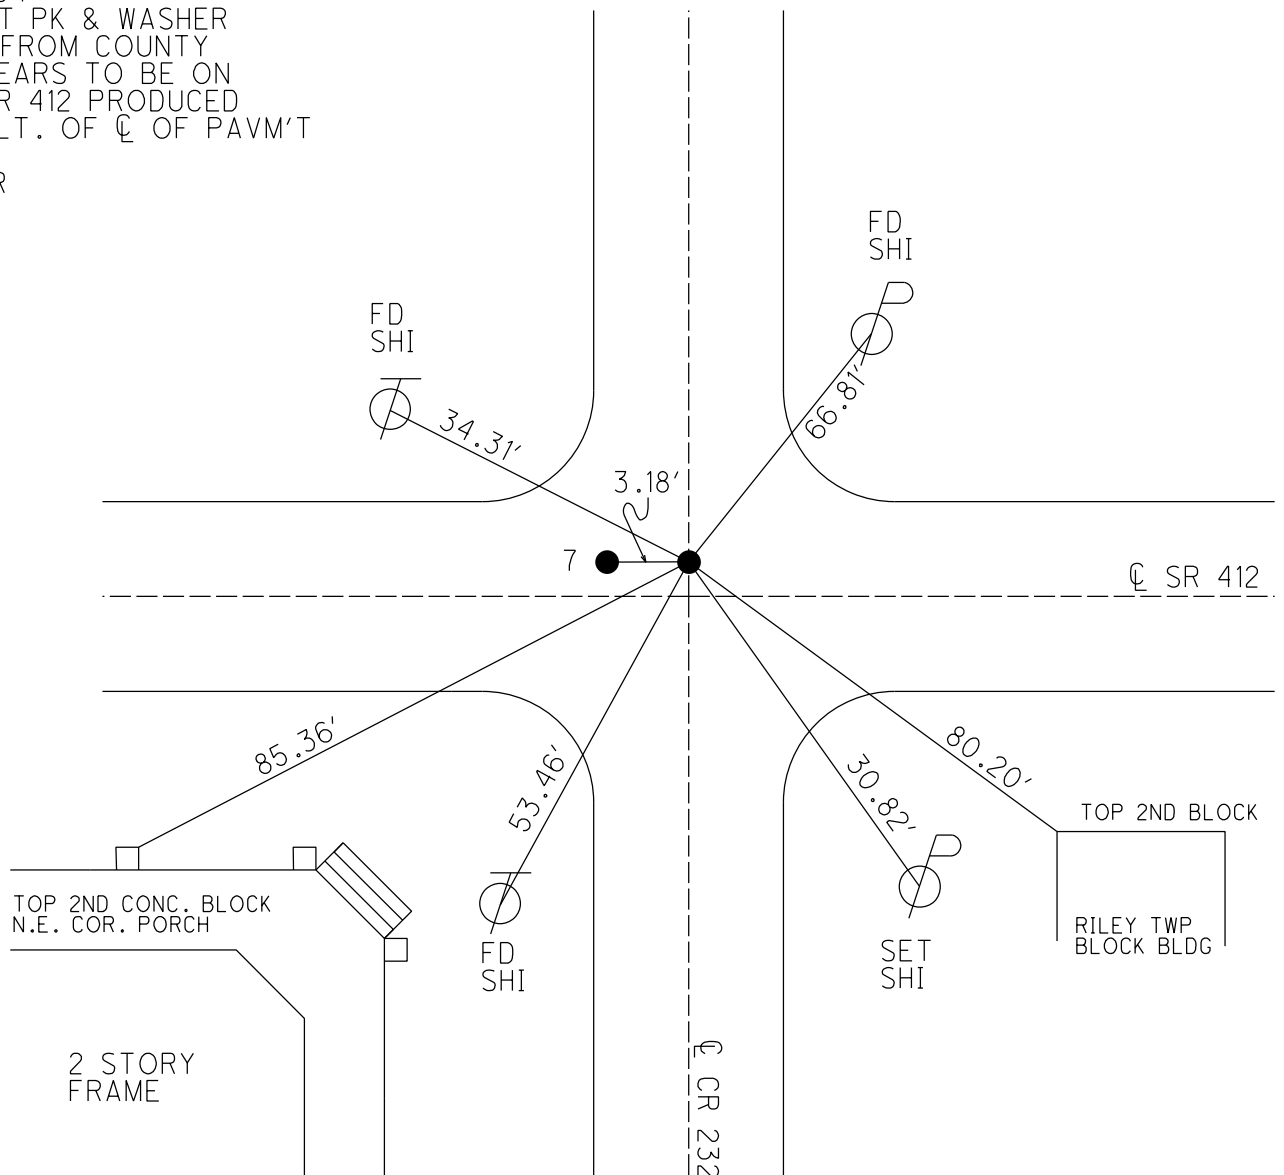

# O.D.O.T. DISTRICT 2 SURVEY OFFICE (USE ONLY)

PERSONNEL

REFERENCE NO. 7A

SHEET 26 OF 33


NOTES HOMAN  
H.C. LEU  
R.C. RHOADES  
WESTFALL

DATE 10-09-2014  
WEATHER PARTLY SUNNY  
TEMP. 55°

ROUTE SR 412  
COUNTY SANDUSKY  
TOWNSHIP RILEY  
SECTION 28  
T 5 N R 16 E

TYPE MONUMENT P.K./WASHER  
ON SURFACE - ~~BELOW~~ ON  
LEFT - CL PAV'T - RIGHT ON  
6.5' TO LT. EDGE PAVEMENT  
S.L.M. 194+47.17

Grid: Northing: 619358.814 Easting: 1827905.896

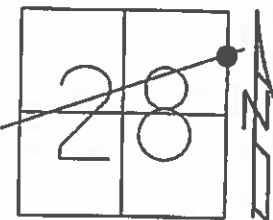


RECORD: 10-11-1984  
ON SEC. LINE SET PK & WASHER  
ATOP R.R. SPK. FROM COUNTY  
REFERENCES APPEARS TO BE ON  
BACK TANG OF SR 412 PRODUCED  
EASTERLY 3.5'± LT. OF CL OF PAVM'T

SET P.K./WASHER  
8/2/93, JLR

FD P.K./WASHER  
REF20  
12/11/12, JMR

SET MAG WASHER  
NEWREFA7  
7/1/15, DCH

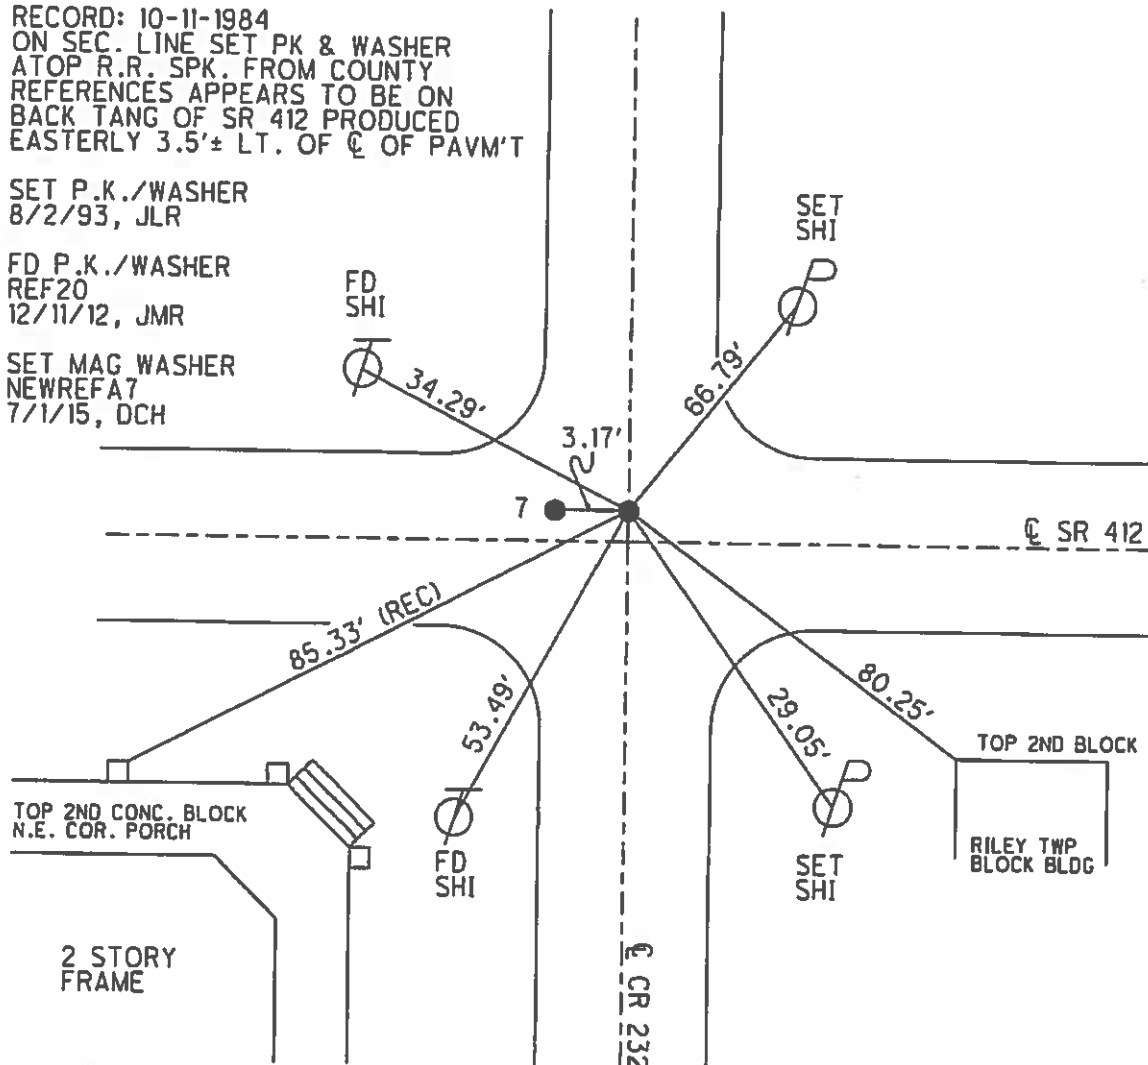

O.D.O.T. DISTRICT 2 SURVEY OFFICE

## PERSONNEL

REFERENCE NO. #7

SHEET 17 OF 21

NOTES CHENEY

H.C. RIPPLE

R.C. BARBOUR

GEVMAN

DATE 4-28-93

WEATHER PART SUNNY

TEMP. 55°

ROUTE SR#412

COUNTY SANDUSKY

TOWNSHIP RILEY

SECTION 28

T5 NR 16 E


TYPE MONUMENT FD. P.K.'S E' WASHERS

ON SURFACE - ~~BELOW~~ ON

LEFT - C PAV'T. - ~~RIGHT~~ 3.5' ±

6.5' TO LT. EDGE PAVEMENT

S.L.M. P.I. 193+51<sup>+</sup> Sec Line Point 193+54<sup>+</sup>

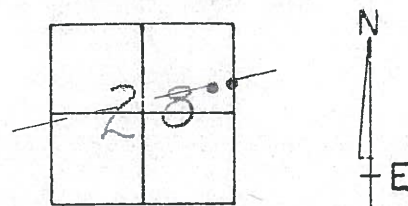

Record: 10-11-84

ON SEC. LINE SET P.K. & WASHER

A Top RR Spk. From County

References Appears To Be on

back Tan9 of SR#412 produced

EASTON  
P.I.


Set P.K. & Washer A Top

IRON ROD A TOP IRON PIPE

3.5' ± LT, & PAVM'T,

NOTE: SET P.K. & WASHERS  
ON BOTH POINTS 8-2-93

J.L.R

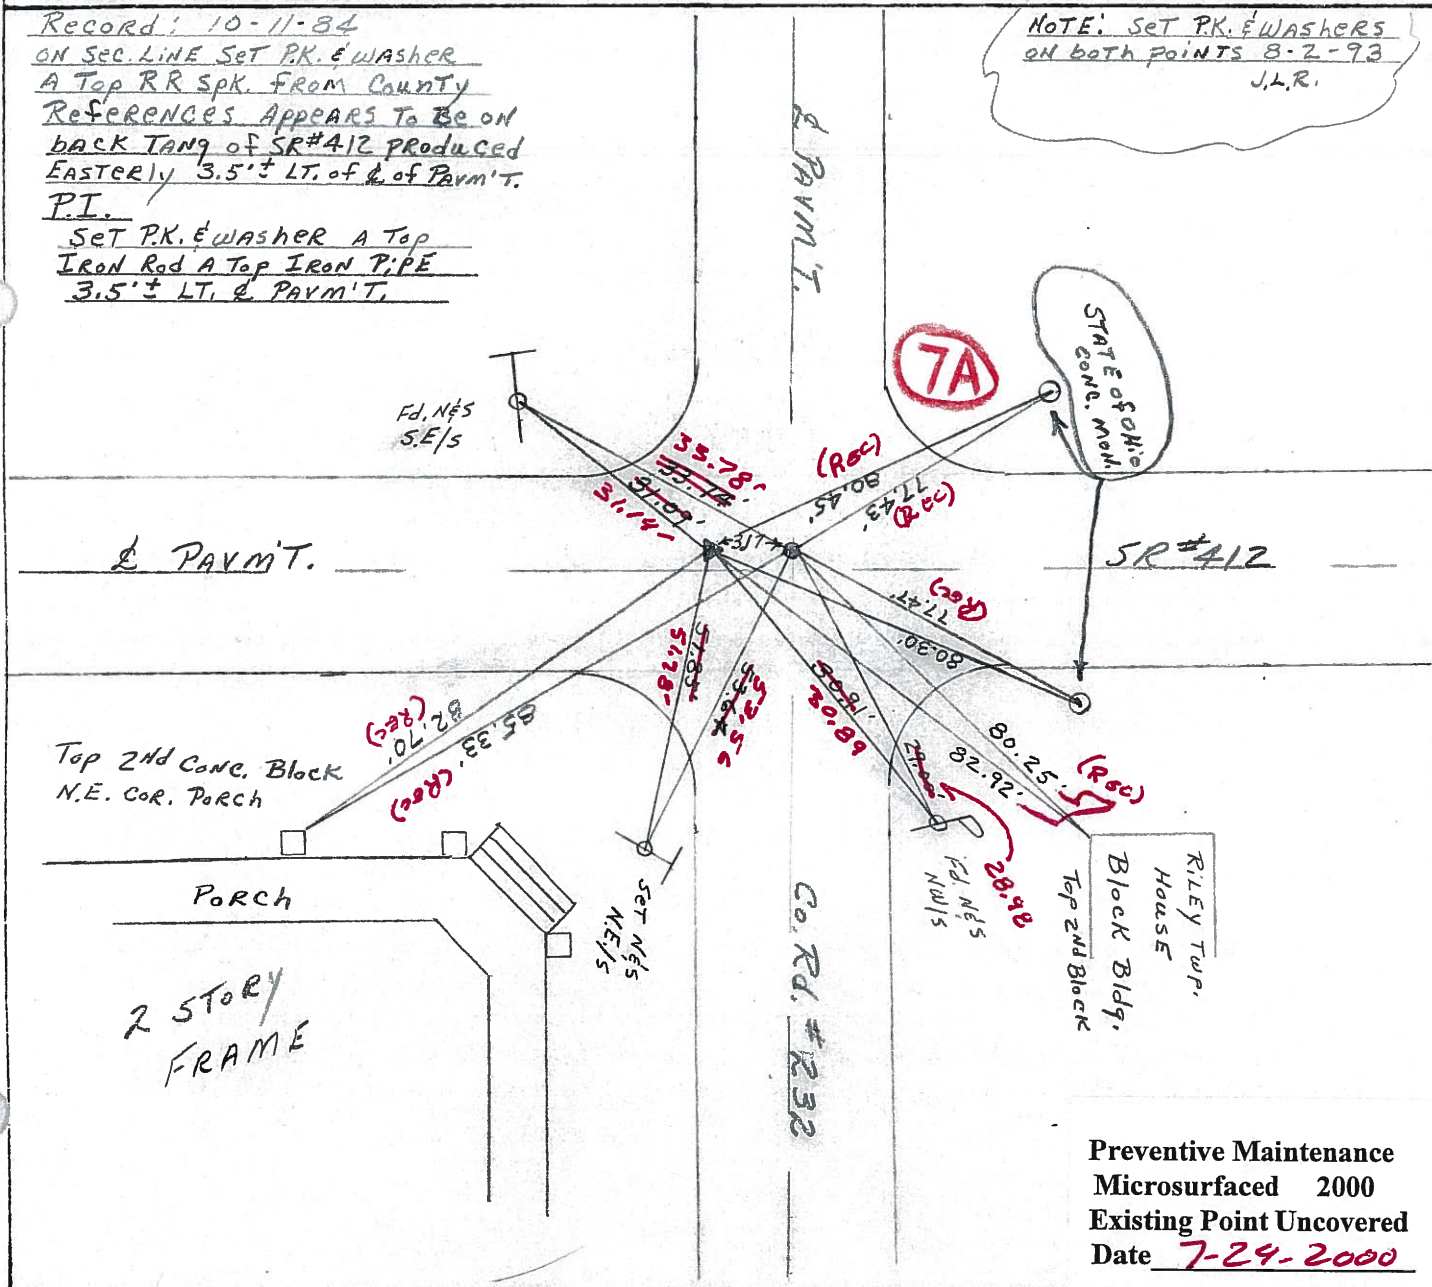

Preventive Maintenance  
Microsurfaced 2000  
Existing Point Uncovered  
Date 7-24-2000

# Q.D.O.T. DISTRICT 2 SURVEY OFFICE

SHEET 13 OF     

County Sandusky S.R. #412

Township Riley

Section 28

T 5 N, R 16 E

Personnel Cronin

Ripple


Geymen

Barbour

Date 10/11/84

Weather sunny

Temp. 65°

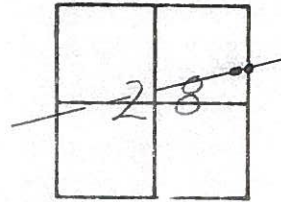


# 7

on sec. line set P.K.  
washer at top R.R. spike  
from County References  
Appears to be on back  
Tang. of S.R. #412 produced  
easterly 2.5' Lt. of P. limit.

P.I.

Set P.K. washer at top  
iron rod at top iron  
pipe 2.5' Lt. of Pavement

C.R. #232

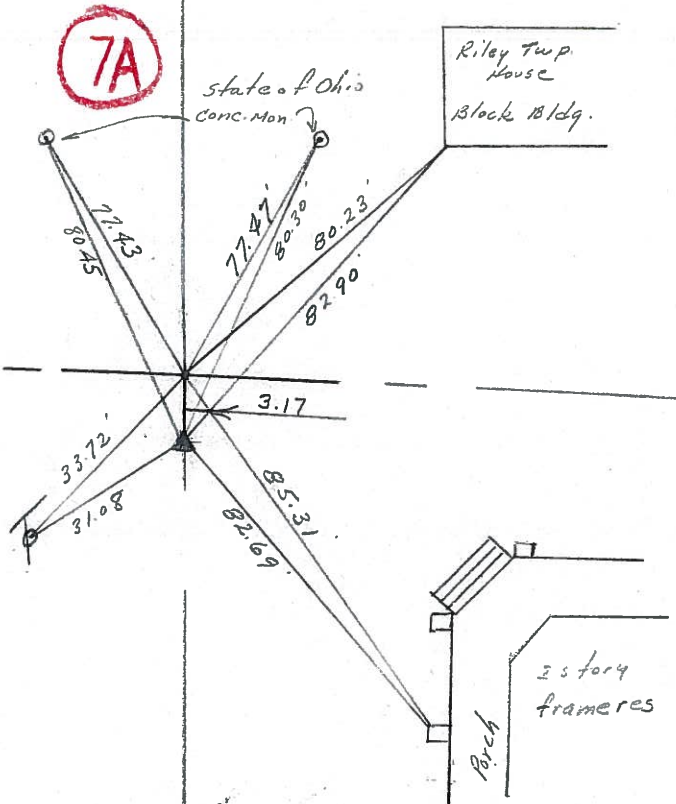

S.R. #412



Tied 2/4/75

DATE Drawn 1/30/75

PERSONNEL

TITLE

PERSONNEL

TITLE

COUNTY Sandusky

WEATHER overcast

S. R. # 4/2

SEC.

TEMP. 30°

DESCRIPTION Ties for Control Points

JOB NO.

LEFT

CENTER LINE

RIGHT

Riley Township

State of Ohio  
Conc. Mon.Riley  
Twp. House  
Block Bldg.

Top 3rd block

(1)

(7A)

Ed. L.R. spike 3" below surface  
from County References.

C.R. # 232

Sec 27

Sec. 28

Ed. iron pipe 3" below surface - set in  
rod at top 5' to the surface, State  
of Ohio P.T.

(7)

Top  
2nd block

Porch

2 story  
frame res.

Metal Bldg.

(6B)

P.O.T.

Ed. 2 R.R. spikes on P/C  
N.E.S. Spike to south is  
on E. 1.17' apart

(6A)

This spike 0.3' Rt. - Rt. Edge of permit.

Sec. 28