

O.D.O.T. DISTRICT 2 SURVEY OFFICE (USE ONLY)

PERSONNEL

REFERENCE NO. 8

SHEET 27 OF 33

NOTES MILLER

DATE 9/3/24

ROUTE SR 412

H.C. MILLER

WEATHER SUNNY

COUNTY SANDUSKY

R.C. BARRIERE

TEMP. 57°

TOWNSHIP RILEY

SECTION 27

DWG BY PRESTON-COLVIN PID PAVING TRAIN

T 5 N R 16 E

TYPE MONUMENT MAG NAIL

ON SURFACE - ~~BELOW~~ ON

OFFSET CL PAVEMENT 1.6' ~~LT~~ : RT

8' TO RT EDGE PAVEMENT

STATION: 221+15.03

HORIZ.DATUM: NAD83 (2011)


GEOID: 18

GRID: NORTHING: 619677.843

EASTING: 1830554.613

LDP: NORTHING: 315876.2524

EASTING: 190788.6178

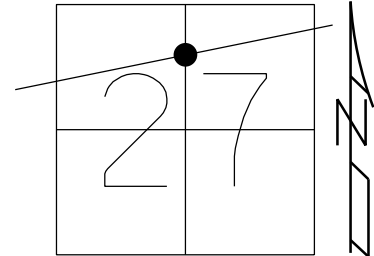

RECORD: 02-04-1975
FND IRON PIN BELOW SURFACE
SET IRON PIPE ATOP & TO THE
SURFACE 2'± RT. OF CL

FD IPIPE W/P.K. IN CTR
4/28/93, CHENEY


SET P.K./WASHER
8/2/93, JLR

FD MAG NAIL
REF21
12/11/12, JMR

SET MAG/WASHER
NEWREF8
7/1/15, DCH

FD MAG SHANK
REF8
9/3/24, JAM

SET MAG NAIL
10/3/24, JAM

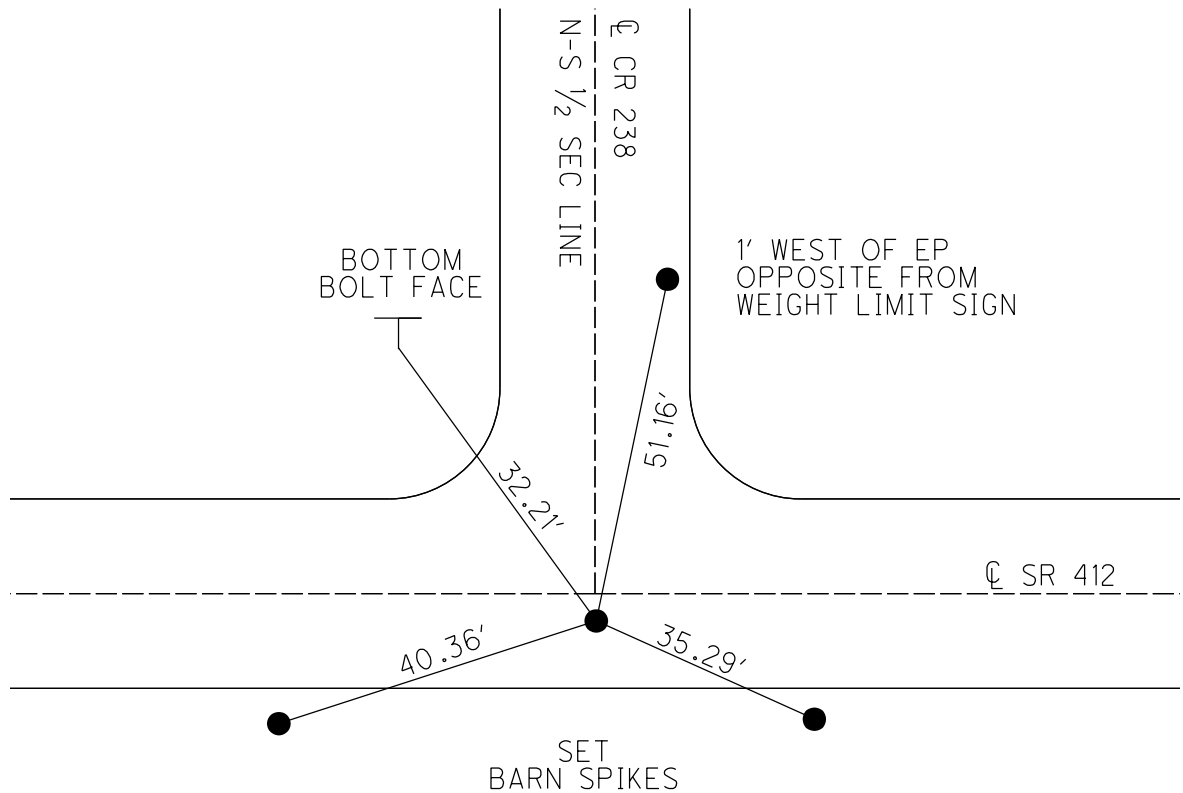


O.D.O.T. DISTRICT 2 SURVEY OFFICE (USE ONLY)

PERSONNEL	REFERENCE NO. <u>8</u>	SHEET <u>27</u> OF <u>33</u>
NOTES <u>HOMAN</u>	DATE <u>10-09-2014</u>	ROUTE <u>SR 412</u>
H.C. <u>LEU</u>	WEATHER <u>CLOUDY</u>	COUNTY <u>SANDUSKY</u>
R.C. <u>RHOADES</u>	TEMP. <u>55°</u>	TOWNSHIP <u>RILEY</u>
<u>WESTFALL</u>		SECTION <u>27</u>
		T <u>5</u> N R <u>16</u> E

TYPE MONUMENT P.K.NAIL
~~ON SURFACE~~ - BELOW 2"
~~LEFT~~ - CL PAV'T - RIGHT 1.6'
8' TO RT EDGE PAVEMENT
 S.L.M. 221+15.03

Grid: Northing: 619677.843 Easting: 1830554.613

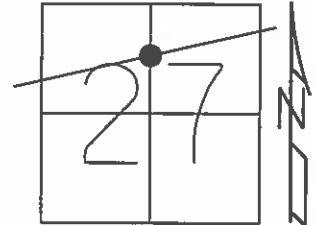


RECORD: 02-04-1975
 FND IRON PIN BELOW SURFACE
 SET IRON PIPE ATOP & TO THE
 SURFACE 2'± RT. OF CL

FD IPIPE W/P.K. IN CTR
 4/28/93, CHENEY

SET P.K./WASHER
 8/2/93, JLR

FD MAG NAIL
 REF21
 12/11/12, JMR

SET MAG/WASHER
 NEWREF8
 7/1/15, DCH

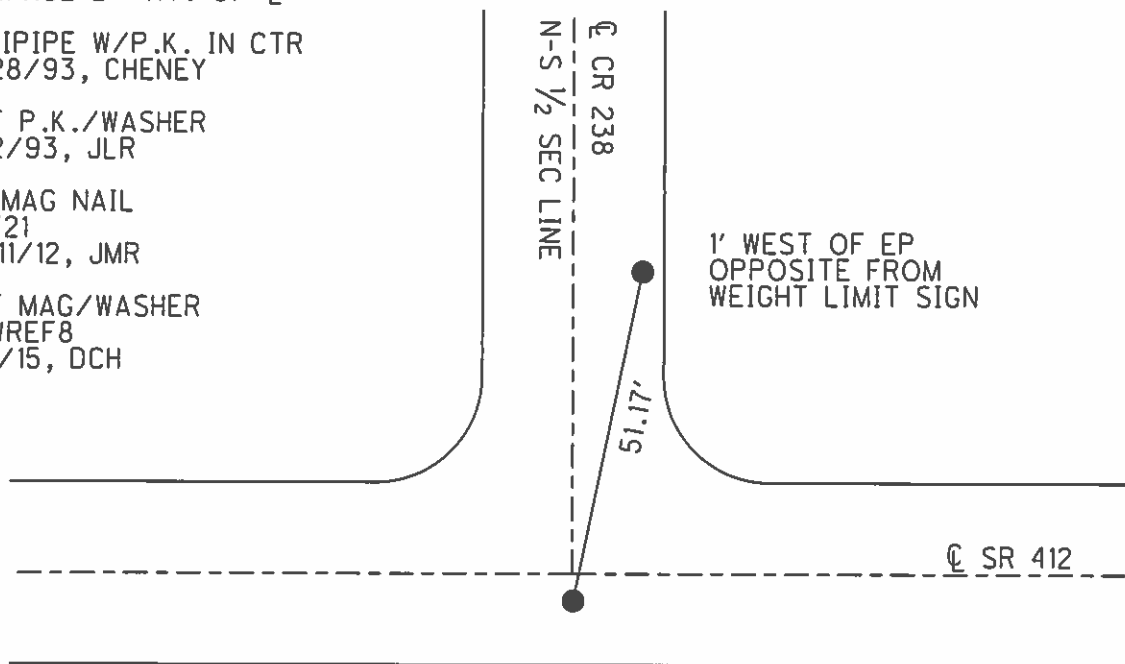

O.D.O.T. DISTRICT 2 SURVEY OFFICE

PERSONNEL

REFERENCE NO. 8

SHEET 18 OF 21

NOTES CHENEY

H.C. RIPPLE

R.C. BARBOUR

GEYMAN

DATE 4-28-93

WEATHER SUNNY

TEMP. 65°

ROUTE SR#412

COUNTY SANDUSKY

TOWNSHIP Riley

SECTION 27

T5 N R 16 E


TYPE MONUMENT Ed. Iron Pipe With P.K. in middle

ON SURFACE - BELOW 2"

LEFT - ℄ PAV'T. - RIGHT 2'

8' TO RT. EDGE PAVEMENT

S.L.M. R20+21

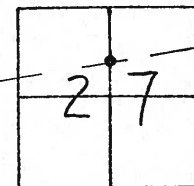

RECORD: 2-04-1975

Ed. Iron Pin below surface

Set Iron Pipe Atop & To The
surface 2' ± RT. of &

NOTE: SET P.K. & WASHER
8-02-1993 J.L.R.


PAV'T. C.R. # 238
N-S 1/2 Sec. LINE

5065

SET shi.
& Rmt.

℄ PAVM'T.

SR#412

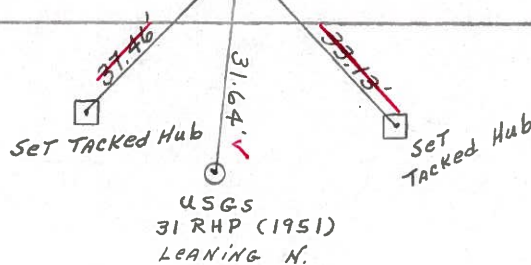

Preventive Maintenance
Microsurfaced 2000
Existing Point Uncovered
Date 7-24-2000

PERSONNEL

TITLE

PERSONNEL

TITLE

Cronin

Schneider

COUNTY Sandusky

Ash

Mosser

S. R. #412

WEATHER overcast

Ripple

Barbour-S.L.

SEC.

TEMP. 30°

Geyman-S.L.

DESCRIPTION


Ties for Control Points

JOB NO.

LEFT

CENTER LINE

RIGHT

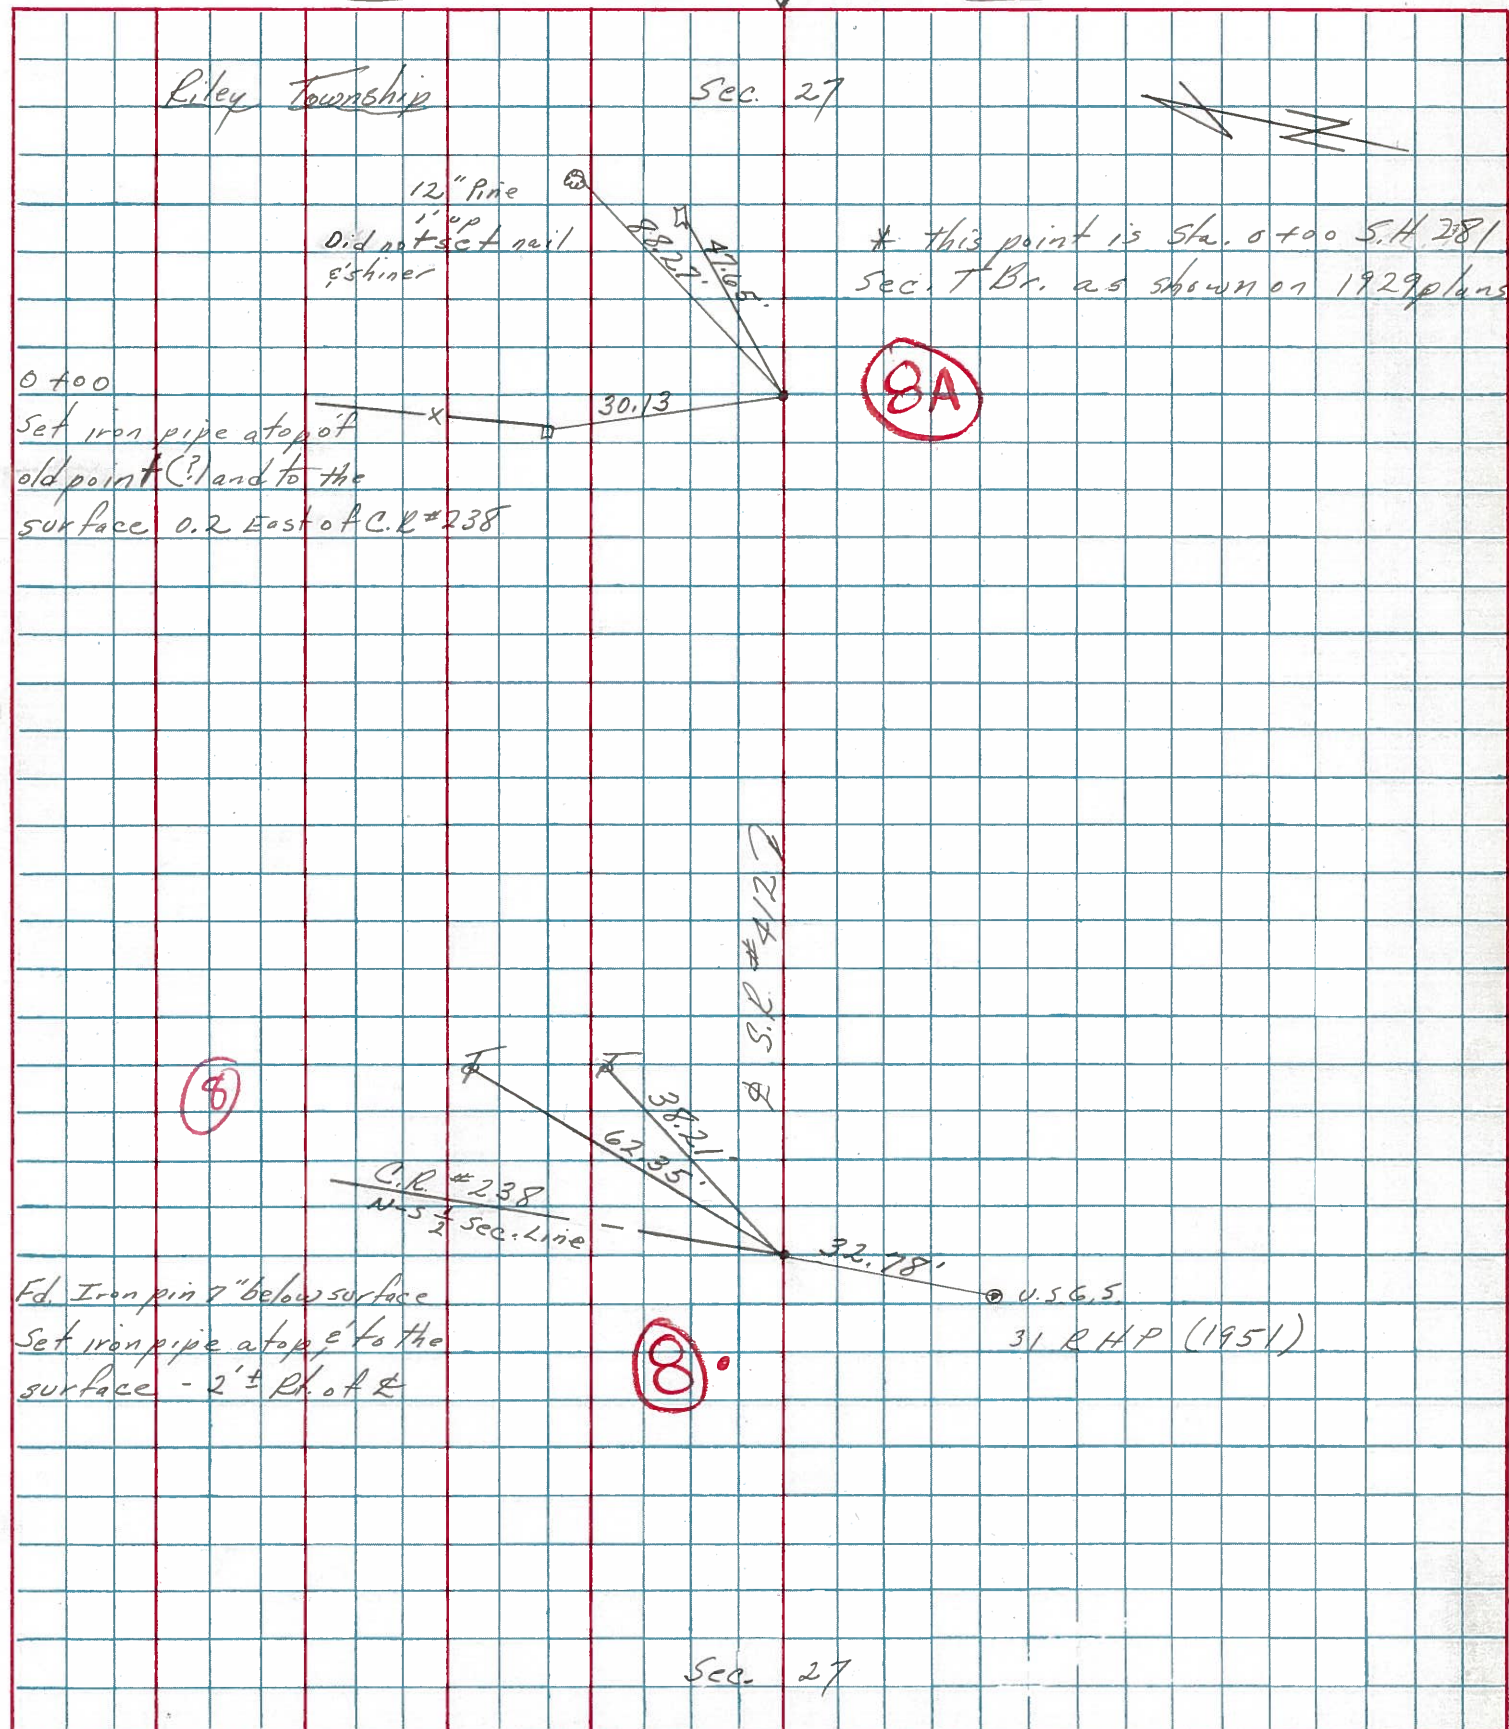

PERSONNEL	TITLE	PERSONNEL	TITLE	COUNTY	DATE
Schneider		Potts		Sandusky	Jan. 1968
Mosser				S. R. 412	WEATHER
Barbour				SEC. N. E. of Fremont	TEMP.
Redding					
DESCRIPTION	Ties for Control Points			JOB NO.	
	LEFT	CENTER LINE	RIGHT		

