

O.D.O.T. DISTRICT 2 SURVEY OFFICE (USE ONLY)

PERSONNEL

REFERENCE NO. 5

SHEET 5 OF 17

NOTES PRESTON-COLVIN

DATE 9/3/24

ROUTE SR 510

H.C. NEISE

WEATHER SUNNY

COUNTY SANDUSKY

R.C. PRESTON-COLVIN

TEMP. 74°

TOWNSHIP GREEN CREEK

SECTION 2

DWG BY PRESTON-COLVIN

PID PAVING TRAIN

T 4 N R 16 E

TYPE MONUMENT MAG NAIL

ON SURFACE - ~~BELOW~~ ON

OFFSET Q PAVEMENT 2.5' ~~LF~~ : RT

- TO - EDGE PAVEMENT

STATION: 80+24

HORIZ.DATUM: NAD83 (2011)


GEOID: 18

GRID: NORTHING: 605889.595


EASTING: 1838109.472

LDP: NORTHING: 302140.6

EASTING: 198439.4

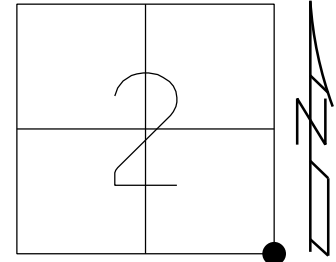

RECORD:
FD 12"X8"X?
GRANITE STONE
21" DOWN
5-21-85
FD P.K./WASHER
6/21/04, DCH
SET MAG/WASHER
10/08/04, DCH
FD MAG NAIL
REF5
7/23/20, JMR
3/10/21, JMR
FD MAG NAIL
REF 5
9-3-24, TDH
FD MAG NAIL
10/3/24, JAM

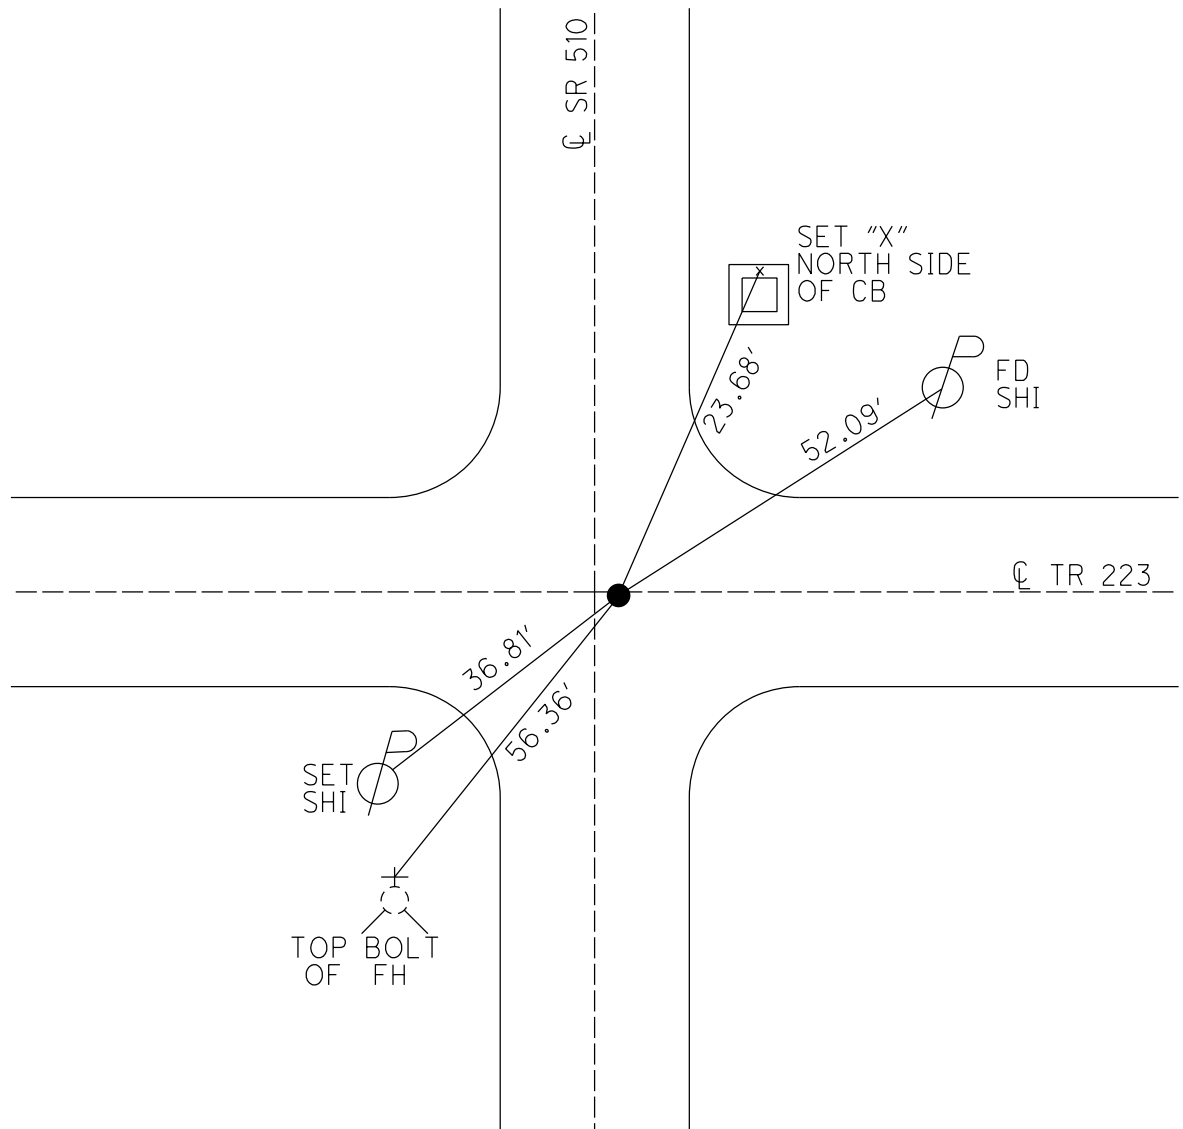

O.D.O.T. DISTRICT 2 SURVEY OFFICE (USE ONLY)

PERSONNEL

REFERENCE NO. 5

SHEET 5 OF 17

NOTES GARRETT

DATE 7/23/20

ROUTE SR 510

H.C. RHOADES

WEATHER CLOUDY

COUNTY SANDUSKY

R.C. MAHLER

TEMP. 77°

TOWNSHIP GREEN CREEK

SECTION 2

DWG BY RHOADES

PID PAVE TRAIN

T 4 N R 16 E

TYPE MONUMENT MAG NAIL

ON SURFACE - ~~BELOW~~ ON

OFFSET CL PAVEMENT 2.5' ~~LT~~ : RT

- TO - EDGE PAVEMENT


STATION: 80+24

HORIZ.DATUM: NAD83 2011


GEOID: NAVD88 2012A

GRID: NORTHING: 605889.595

EASTING: 1838109.472

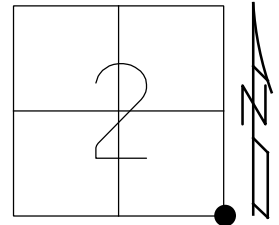

RECORD:
FD 12"X8"X?
GRANITE STONE
21" DOWN
5-21-85
FD P.K./WASHER
6/21/04, DCH
SET MAG/WASHER
10/08/04, DCH
FD MAG NAIL
REF5
7/23/20, JMR
3/10/21, JMR

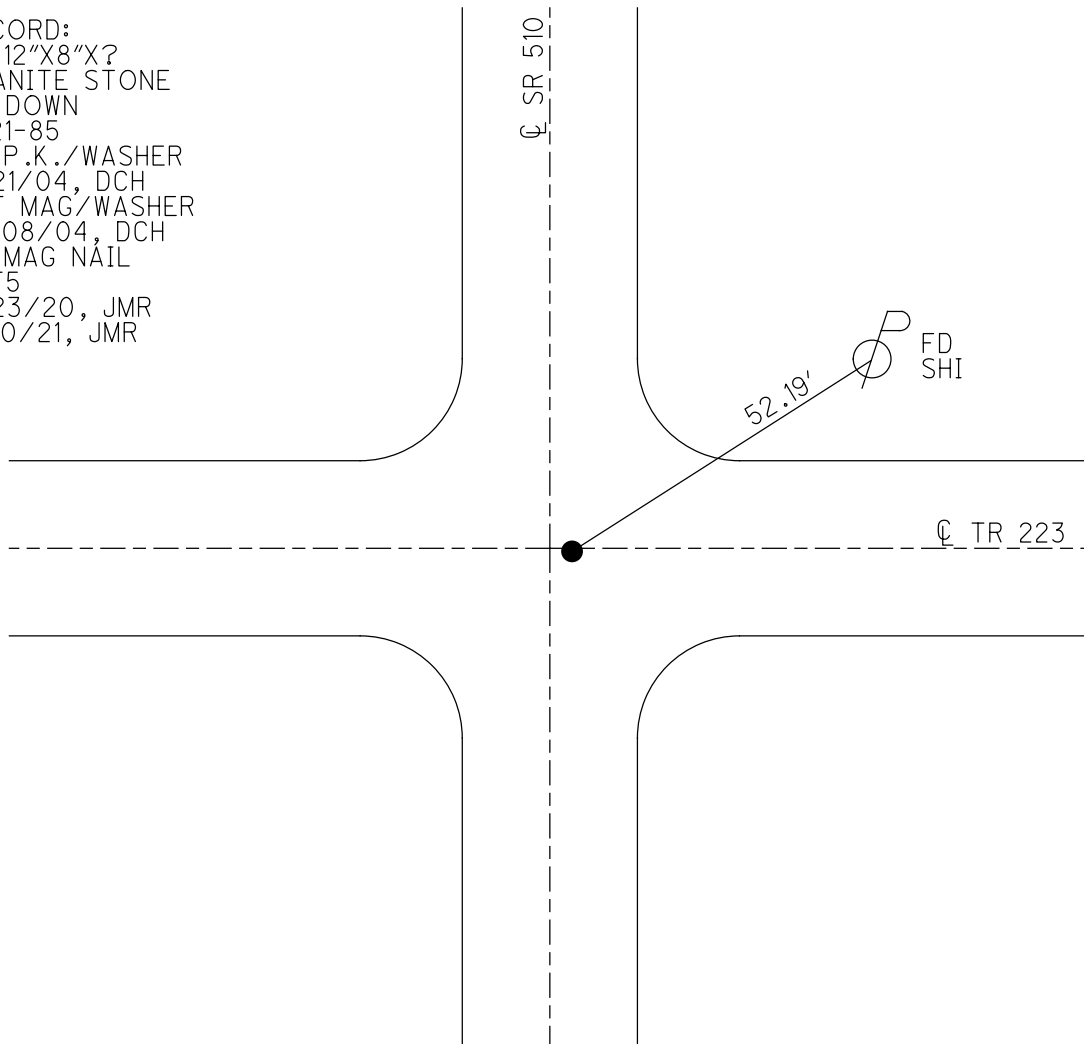

O.D.O.T. DISTRICT 2 SURVEY OFFICE (USE ONLY)

PERSONNEL

REFERENCE NO. 5

SHEET 5 OF 17

NOTES HOMAN

DATE 6/21/04

ROUTE SR 510

H.C. HOMAN

WEATHER SUNNY

COUNTY SANDUSKY

R.C. ADKINS

TEMP. 65°

TOWNSHIP GREEN CREEK

SECTION 2

DWG BY _____ PID _____

T 4 N R 16 E

TYPE MONUMENT P.K./WASHER

ON SURFACE - ~~BELOW~~ ON _____

OFFSET CL PAVEMENT 2.5' ~~LT~~ : RT

- TO - EDGE PAVEMENT


STATION: 80+24

HORZ.DATUM: _____


GEOID: _____

GRID: NORTHING: _____

EASTING: _____

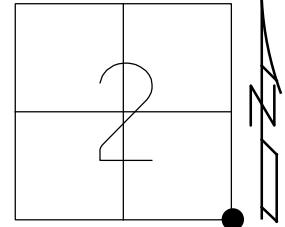

RECORD:
FD 12"X8"X?
GRANITE STONE
21" DOWN
5-21-85
SET MAG/WASHER
10/08/04, DCH

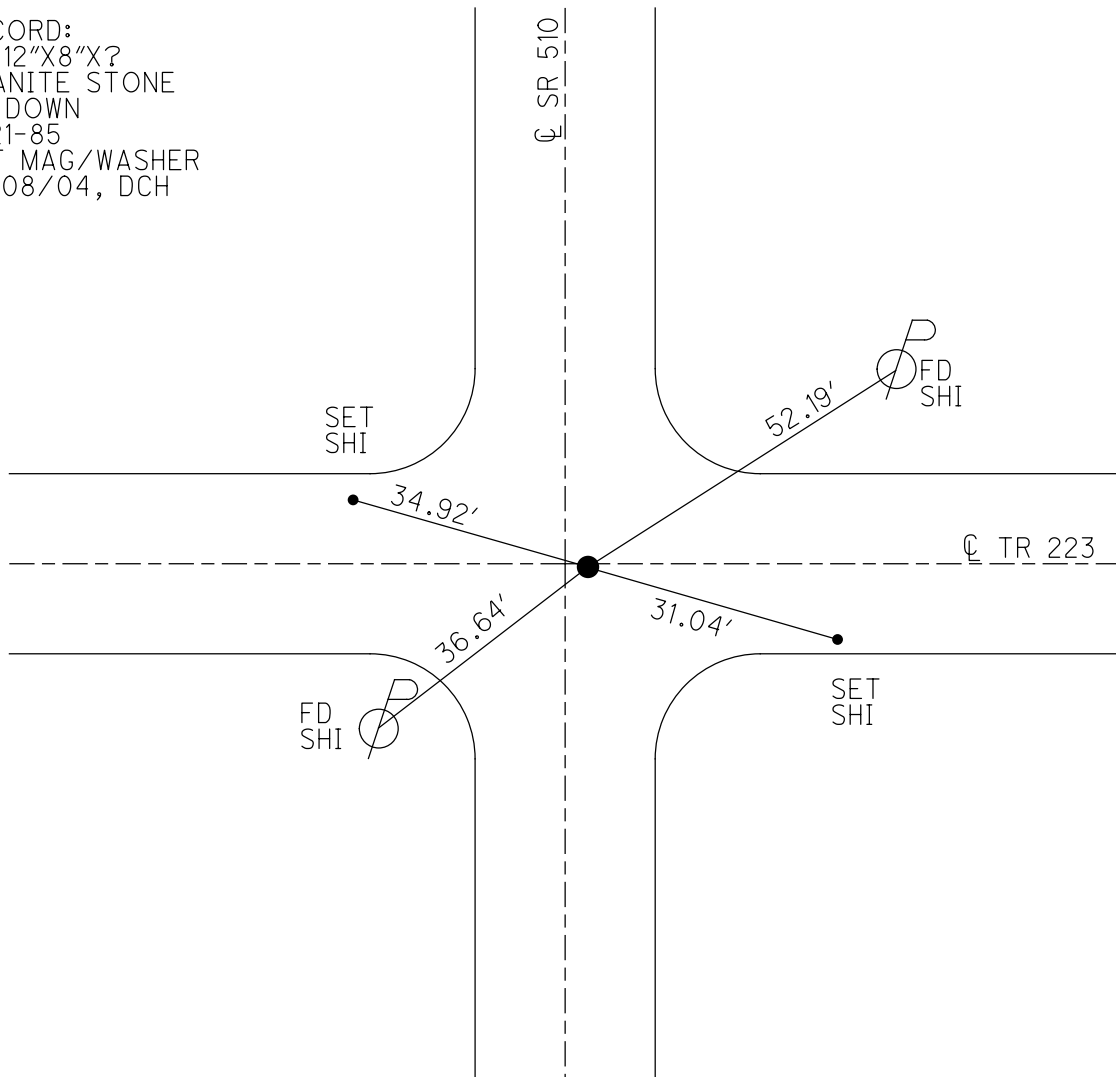

O.D.O.T. DISTRICT 2 SURVEY OFFICE

PERSONNEL

REFERENCE NO. 5

SHEET 5 OF 17

NOTES HOMAN

DATE 6-21-04

ROUTE SR 510

H.C. HOMAN

WEATHER SUNNY

COUNTY SANDUSKY

R.C. ADKINS

TEMP. +75°

TOWNSHIP GREEN CREEK

SECTION 1-2-11-12

T 4 N R 16 E


TYPE MONUMENT P.K. & WASHER

ON SURFACE - ~~BELOW~~ YES


~~LEFT - C PAVE~~ - RIGHT 2.5' RT

TO EDGE PAVEMENT

S.L.M. 80+24

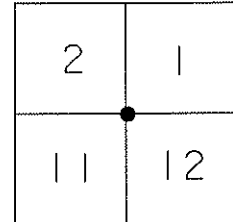

SET MAG NAIL
10-8-04
DCH

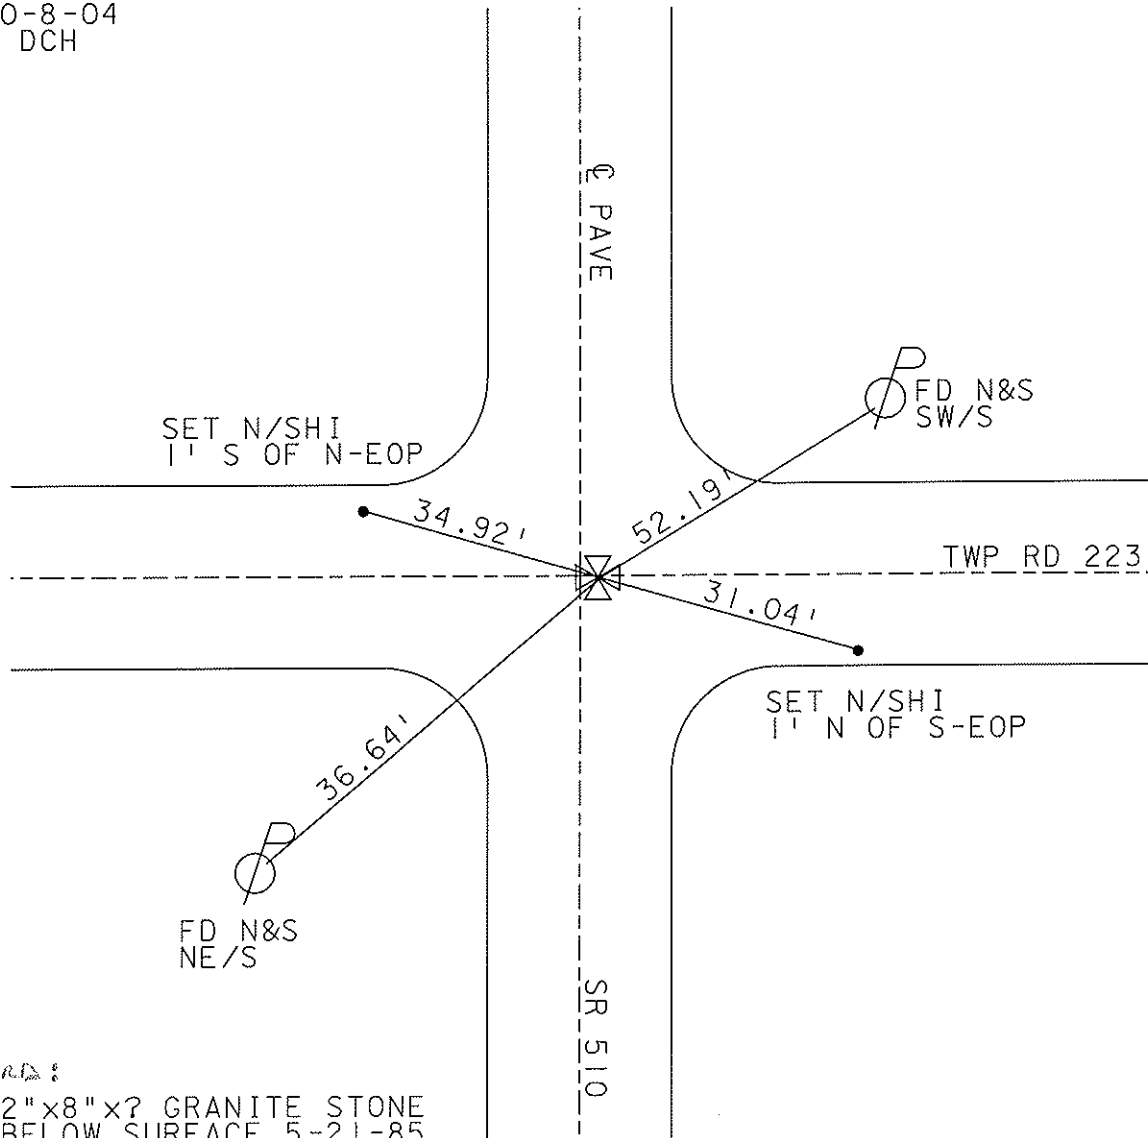

RECORD:

FD 12"x8"x? GRANITE STONE
21" BELOW SURFACE 5-21-85
X TIES IN ROAD

O.D.O.T. DISTRICT 2 SURVEY OFFICE

PERSONNEL

REFERENCE NO. 5

SHEET 3 OF 15

NOTES Ripple

H.C. BARBOUR

DATE 8/14/90

ROUTE SR.# 510

R.C. Geyman

WEATHER SUNNY

COUNTY SANDUSKY

TEMP. 75°

TOWNSHIP GREEN CREEK

SECTION _____

T 4 N R 16 E

TYPE MONUMENT Set P.K. & Washer


ON SURFACE - BELOW 12" x 8" GRANITE STONE

LEFT- & PAV'T. - RIGHT 2.5' ± RT. & PAV'T.

____ TO ____ EDGE PAVEMENT

S.L.M. _____

2	1
11	12

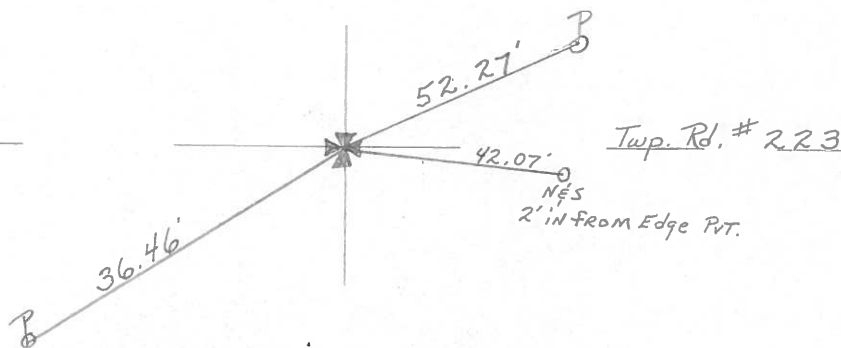

Found 12" x 8" x ? GRANITE STONE

21" below SURFACE 5/21/85

X Ties in Road

L R/W SR # 510

O.D.O.T. DISTRICT 2 SURVEY OFFICE

SHEET

OF

County Sandusky S.R. #510

Township Green Creek

Section _____

T 1 N, R 16 E

Personnel Cronin

Ripple

Geuman

Mosser


Barbour

#5


Date 9/9/82

Weather sunny

Temp. 75°

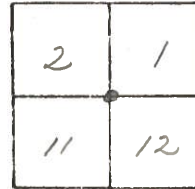

Fd $\frac{1}{2}$ " I. rod 7"
below surface. 3" North of
stone - 2.5' $\pm$ Rt. & pavement
should be dug for stone

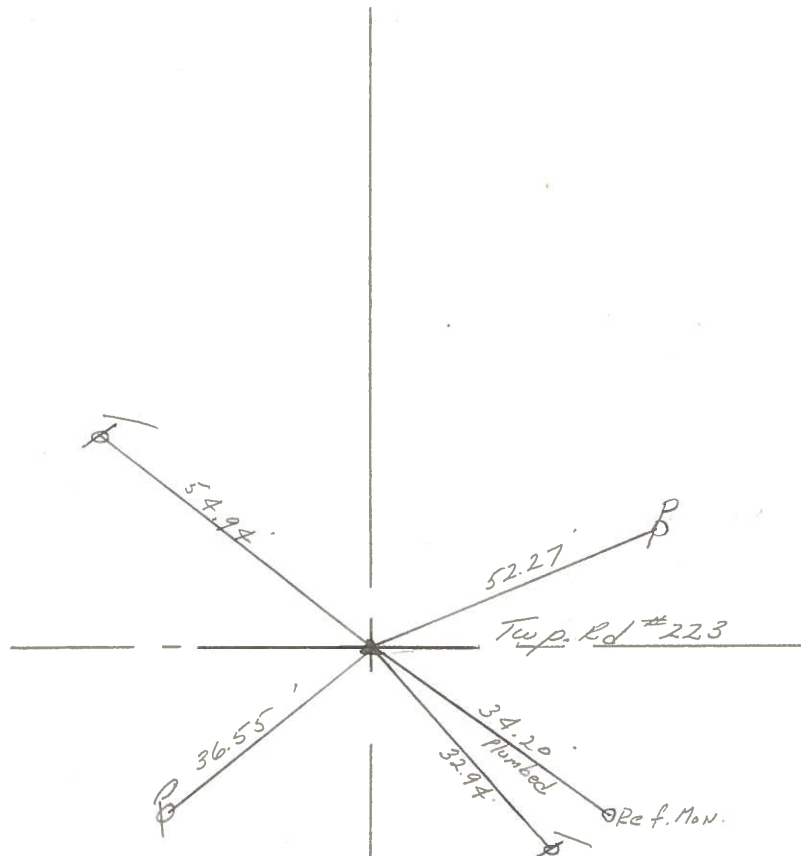

S.R. #510

PERSONNEL

TITLE

PERSONNEL

TITLE

COUNTY

Sandusky

DATE

8-21-72
4-14-71

S. R.

510

WEATHER

Fair

SEC.

45.20 to 45.6

TEMP.

32°

DESCRIPTION


LEFT

CENTER LINE


RIGHT

JOB NO.

①
Iron pipe
over stone

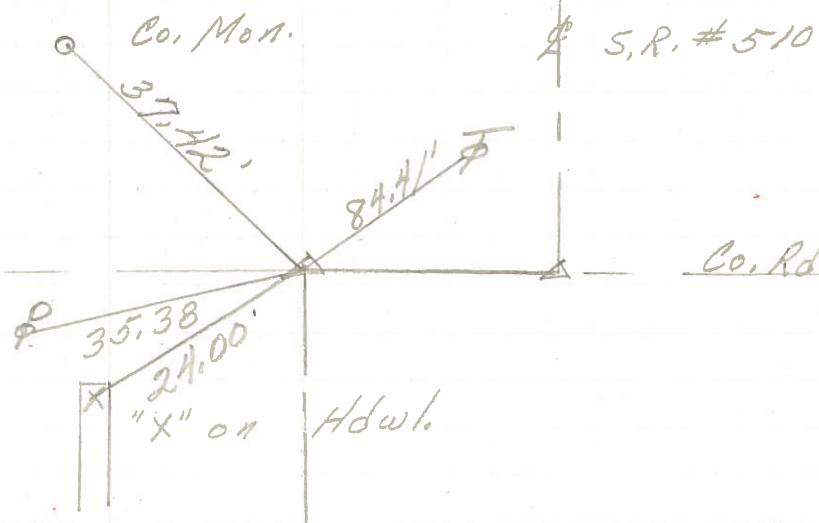

②
106+34
Bolt over
stone 2" down
center sec 1 & 2
Reset P.K. Nail

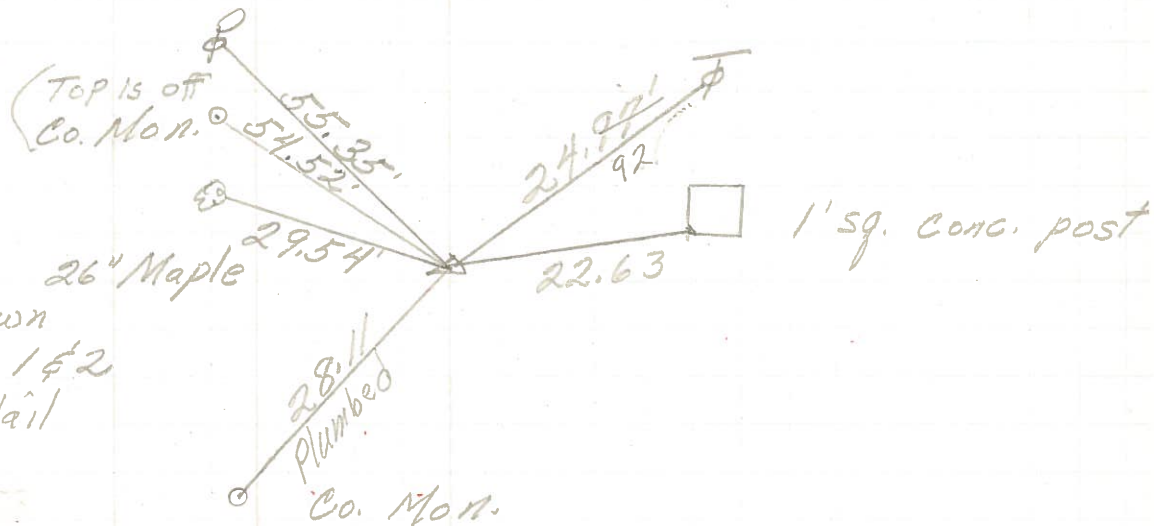

③
79+
sq. Bolt (Redug)
Iron Pin
3' N. of stone
1" down
2 1/2' Rt. of &



PERSONNEL TITLE PERSONNEL TITLE

Schneider

Potts

COUNTY

Sandusky

DATE

4-22-68

Mosser

S. R.

510

WEATHER

Fair

Barbour

SEC. U.S. #20 to

6

TEMP.

65°

Redding

DESCRIPTION

Ties for Control Point

JOB NO.

LEFT

CENTER LINE

RIGHT

