

O.D.O.T. DISTRICT 2 SURVEY OFFICE (USE ONLY)

PERSONNEL

REFERENCE NO. 7

SHEET 7 OF 17

NOTES PRESTON-COLVIN

DATE 9/3/24

ROUTE SR 510

H.C. NEISE

WEATHER SUNNY

COUNTY SANDUSKY

R.C. PRESTON-COLVIN

TEMP. 75°

TOWNSHIP GREEN CREEK

SECTION 2

DWG BY PRESTON-COLVIN

PID PAVING TRAIN

T 4 N R 16 E

TYPE MONUMENT MAG NAIL

~~ON SURFACE~~ - BELOW .75"

OFFSET Q PAVEMENT 35' LT : ~~RT~~

- TO - EDGE PAVEMENT

STATION: 132+52

HORIZ.DATUM: NAD83 (2011)


GEOID: 18

GRID: NORTHING:


EASTING:

LDP: NORTHING: 307389.7

EASTING: 198475.1

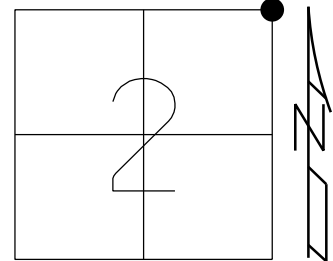

RECORD:
FD MONBOX
W/ IPIPE
OVER STONE
8/14/90, BARBOUR
D.N.F. MONBOX
PAVED OVER
7/23/20, JMR
FD MAG NAIL
REF7
9/3/24, TDN
FD MAG NAIL
10/3/24, JAM

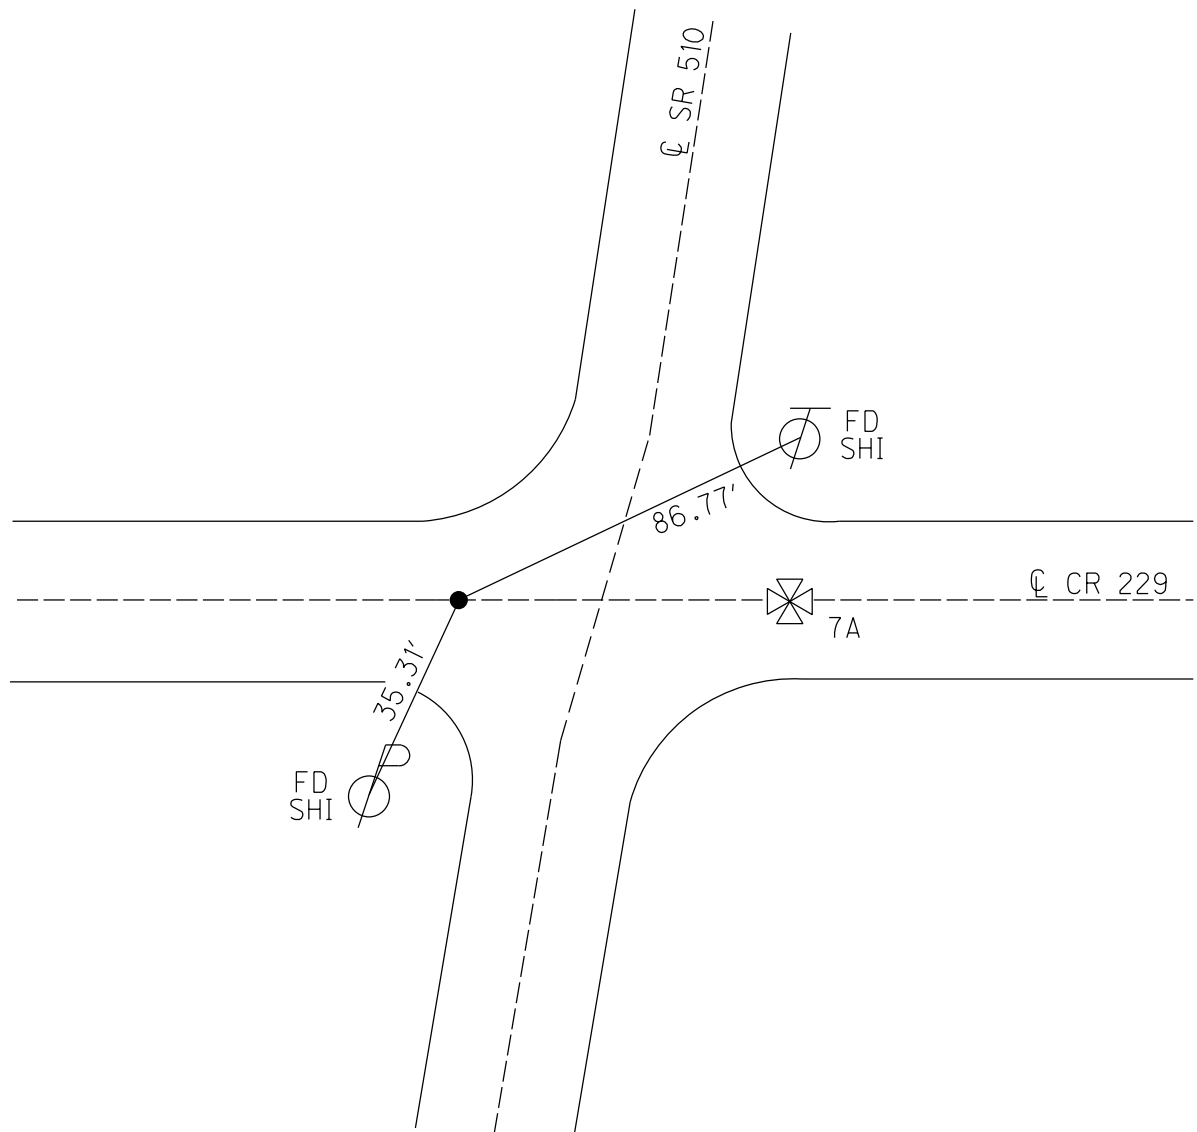

O.D.O.T. DISTRICT 2 SURVEY OFFICE (USE ONLY)

PERSONNEL

REFERENCE NO. 7

SHEET 7 OF 17

NOTES GARRETT

DATE 7/23/20

ROUTE SR 510

H.C. RHOADES

WEATHER CLOUDY

COUNTY SANDUSKY

R.C. MAHLER

TEMP. 77°

TOWNSHIP GREEN CREEK

SECTION 2

DWG BY RHOADES

PID PAVE TRAIN

T 4 N R 16 E

TYPE MONUMENT MONBOX

ON SURFACE - ~~BELOW~~ ON

OFFSET CL PAVEMENT 35' LT : ~~RT~~

- TO - EDGE PAVEMENT


STATION: 132+52

HORZ.DATUM: NAD83 2011


GEOID: NAVD88 2012A

GRID: NORTHING:

EASTING:

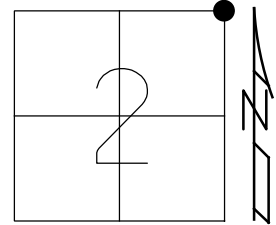

RECORD:
FD MONBOX
W/ IPIPE
OVER STONE
8/14/90, BARBOUR
D.N.F. MONBOX
PAVED OVER
7/23/20, JMR

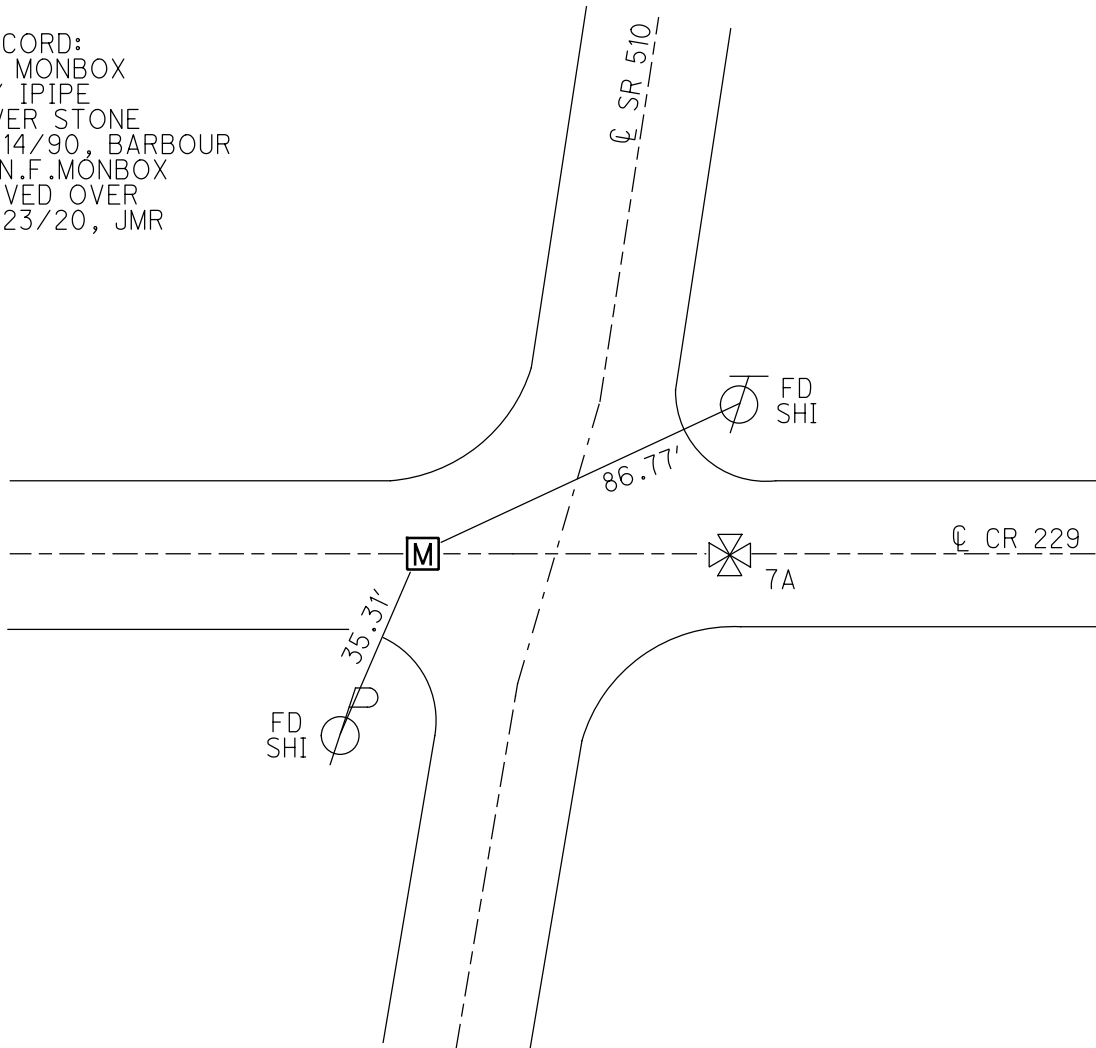

O.D.O.T. DISTRICT 2 SURVEY OFFICE (USE ONLY)

PERSONNEL

REFERENCE NO. 7

SHEET 7 OF 17

NOTES RIPPLE

DATE 8/14/90

ROUTE SR 510

H.C. BARBOUR

WEATHER SUNNY

COUNTY SANDUSKY

R.C. GEYMAN

TEMP. 75°

TOWNSHIP GREEN CREEK

SECTION 2

T 4 N R 16 E

DWG BY _____ PID _____

TYPE MONUMENT MONBOX

ON SURFACE - ~~BELOW~~ ON

OFFSET Q PAVEMENT 35' LT : ~~RT~~

- TO - EDGE PAVEMENT


STATION: 132+52±

HORIZ.DATUM: _____


GEOID: _____

GRID: NORTHING: _____

EASTING: _____

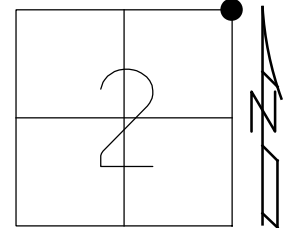

RECORD:
FD MONBOX
W/ IPIPE
OVER STONE
8/14/90, BARBOUR

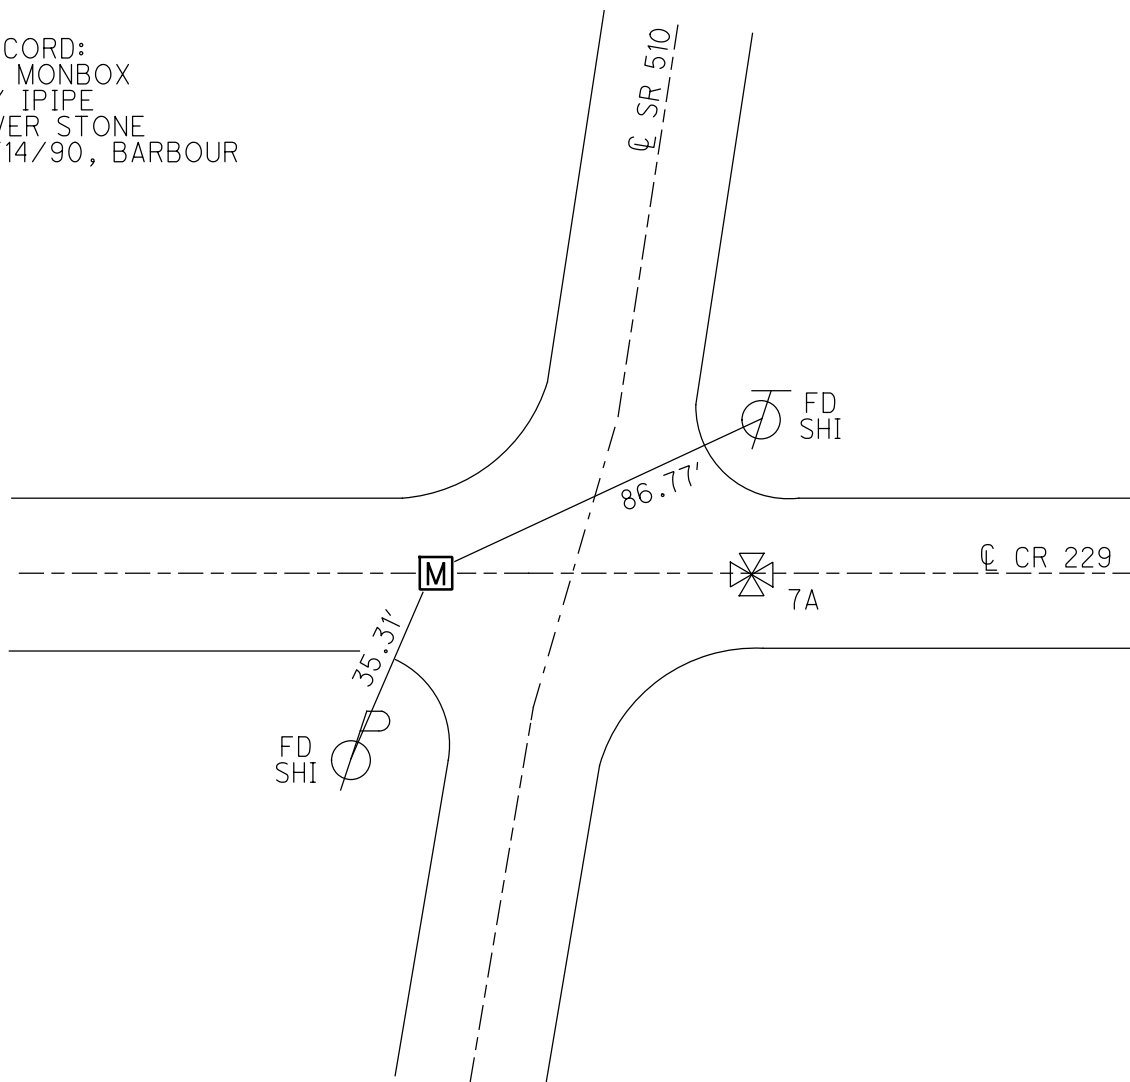

O.D.O.T. DISTRICT 2 SURVEY OFFICE

PERSONNEL

REFERENCE NO. 7

SHEET 7 OF 17

NOTES RIPPLE

DATE 8-14-90

ROUTE SR 510

H.C. BARBOUR

WEATHER SUNNY

COUNTY SANDUSKY

R.C. GEYMAN

TEMP. 75°

TOWNSHIP GREEN CREEK

SECTION 1 & 2

T 1 N R 2 E


TYPE MONUMENT MON BOX

ON SURFACE - BELOW STONE

LEFT - ~~C PAVT~~ - ~~RIGHT~~ 35' LT

TO EDGE PAVEMENT

S.L.M.

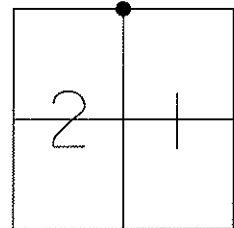


NOTE: MONUMENT BOX
WAS OUTSIDE OF STATE
ROUTE 510 WORK LIMITS
WORK WAS DONE ON
COUNTY ROAD LATER
AND MONUMENT BOX
WAS NOT BROUGHT UP
TO THE SURFACE

Note:

See previous Ref. ties

Also:

See FILE: SAN-94

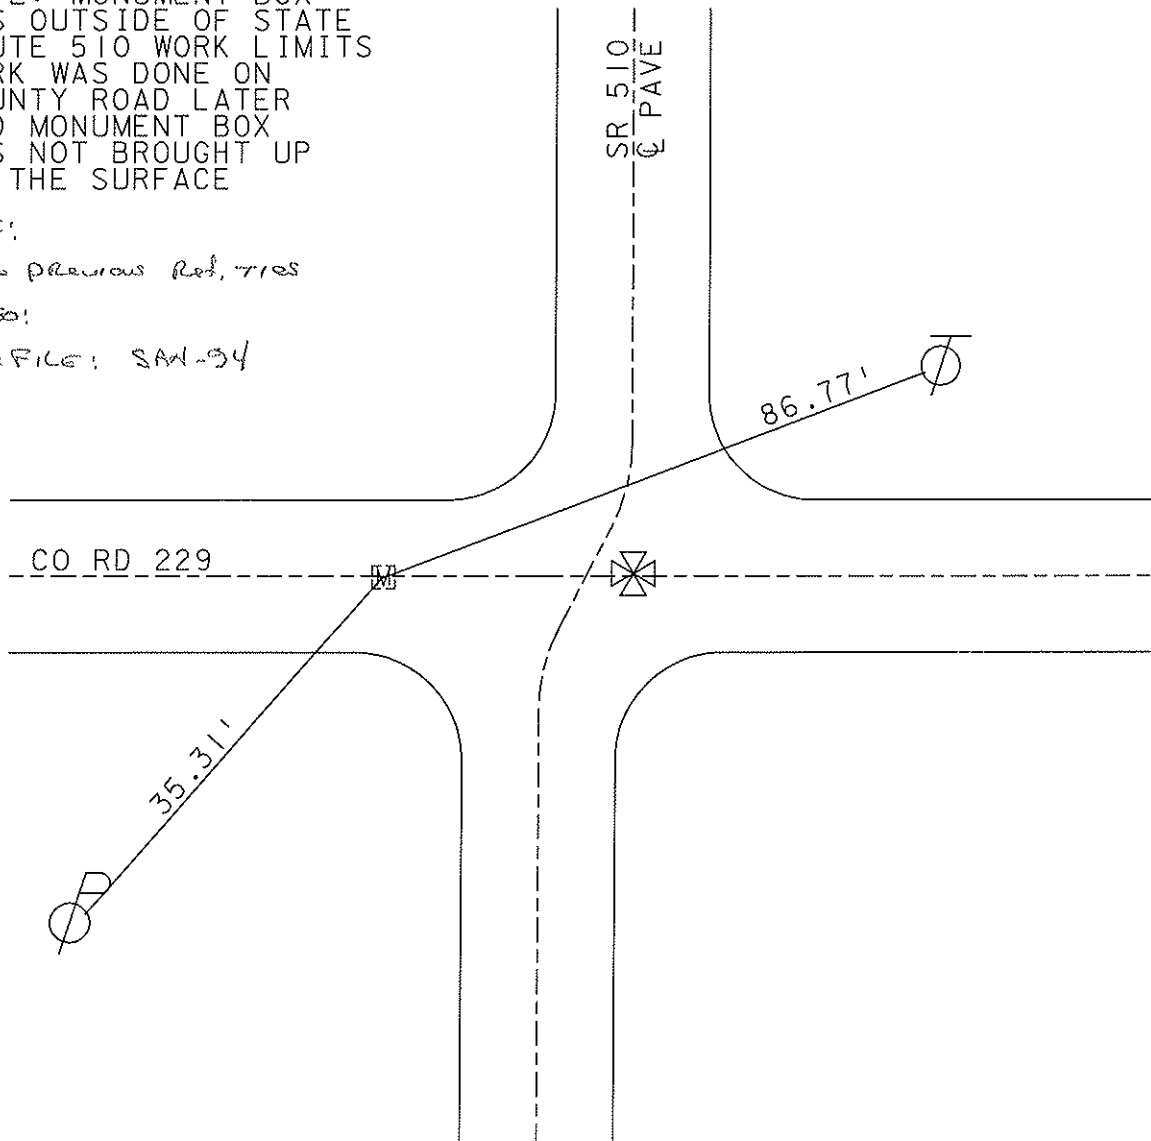

O.D.O.T. DISTRICT 2 SURVEY OFFICE

PERSONNEL

REFERENCE NO. 7

SHEET 5 OF 15

NOTES RIPPLE

H.C. BARBOUR

R.C. GEYMAN

DATE 8/14/90

WEATHER SUNNY

TEMP. 75°

ROUTE SR# 510

COUNTY SANDUSKY

TOWNSHIP GREEN CREEK

SECTION 1 & 2

T. 4 N. R. 16 E.



TYPE MONUMENT MONUMENT BOX

ON SURFACE - BELOW STONE

LEFT- & PAV'T. - RIGHT 35' LT. & PAV'T.

TO EDGE PAVEMENT

S.L.M.

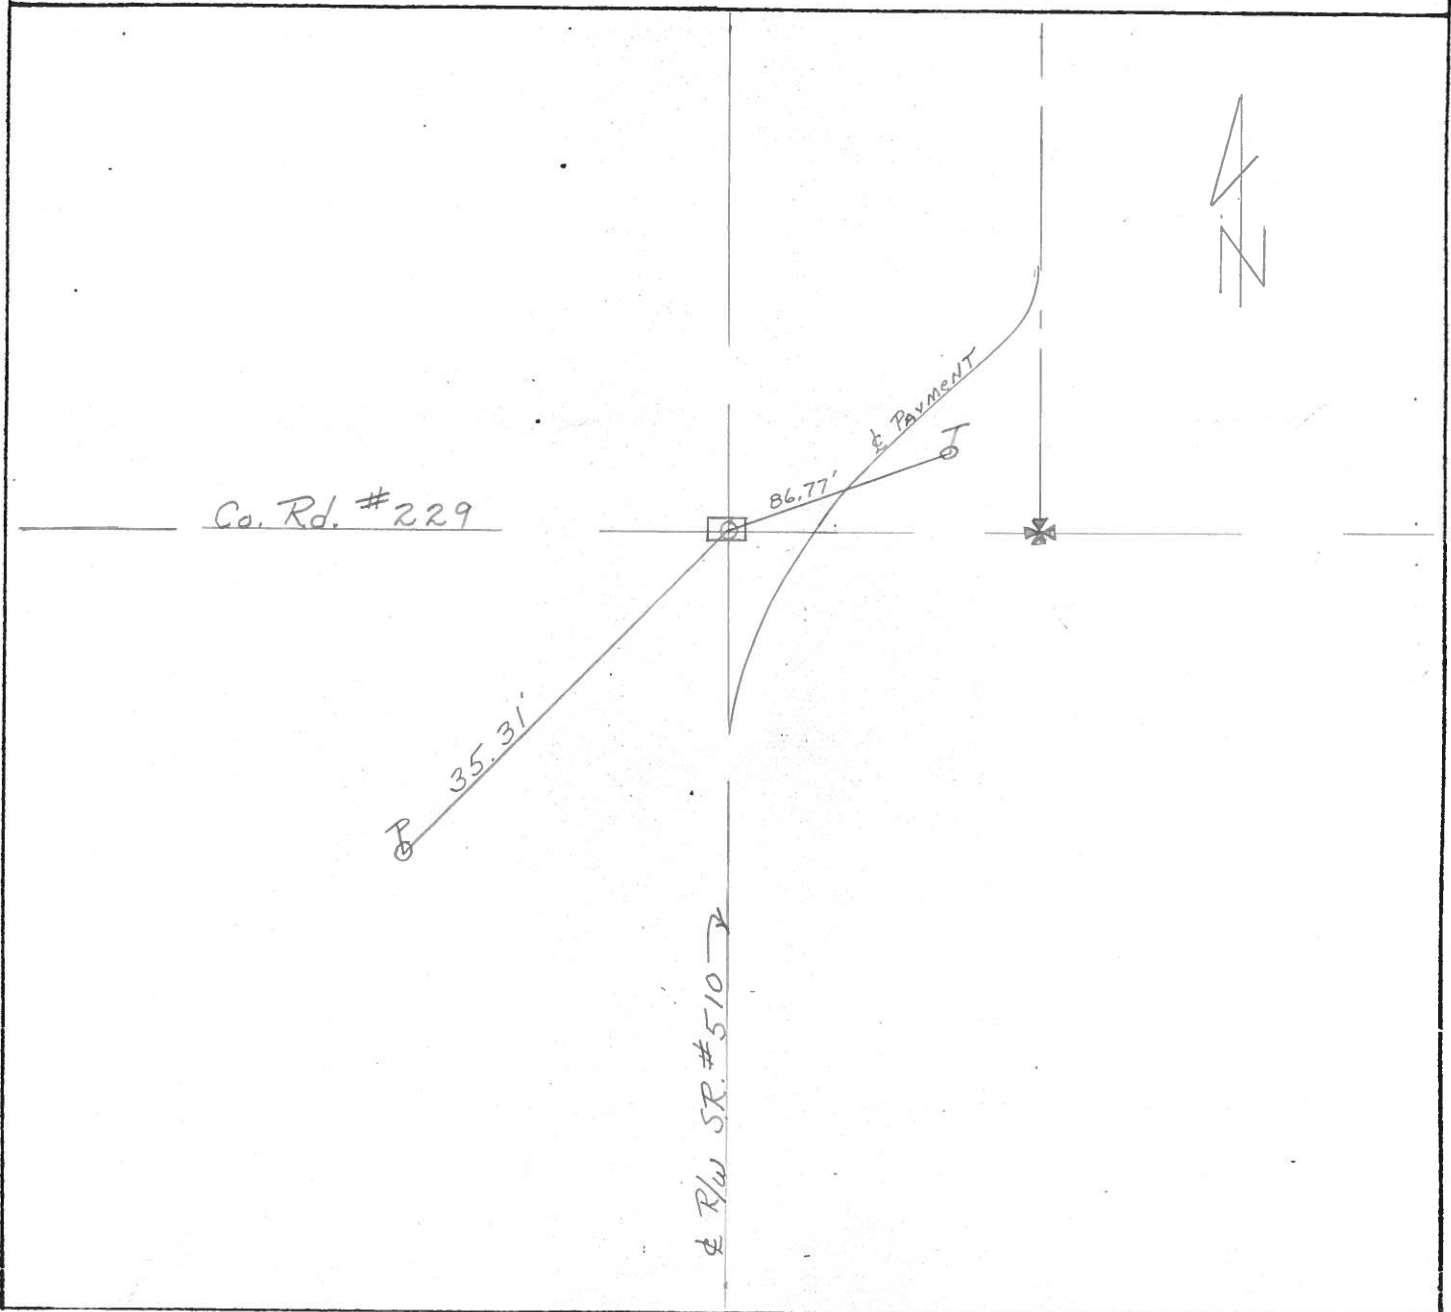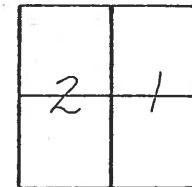

O.D.O.T. DISTRICT 2 SURVEY OFFICE

SHEET

OF

County Sandusky S.R. #510

Township Green Creek

Section 1st 2

T N, R 16 E

Personnel Cronin

Ripple

Geyman

Mosser


Barbour

#7

Date 4/26/82


Weather overcast

Temp. 60°

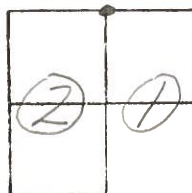

Mon. Bay over stone




C.O.R.D. #229

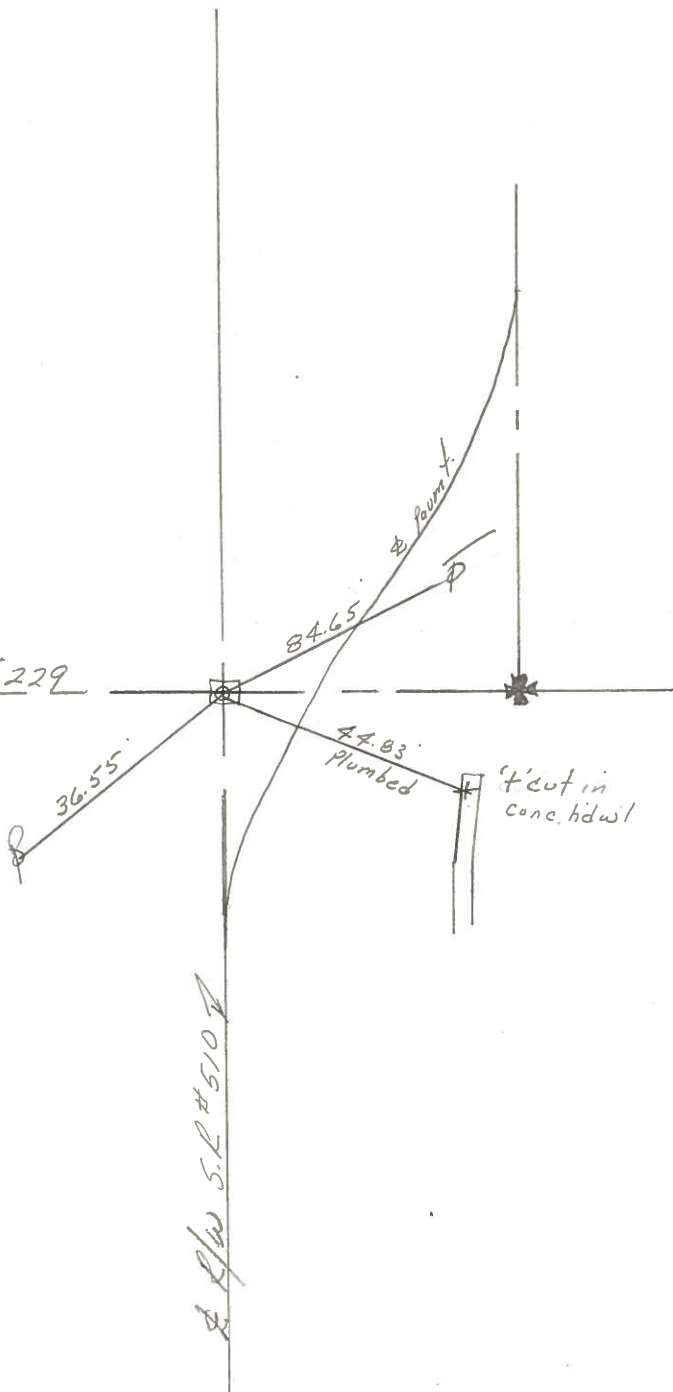

PERSONNEL TITLE PERSONNEL TITLE

COUNTY Sandusky DATE 8-21-72
4-14-71S. R. 510 WEATHER FairSEC. U.S. 20 to U.S. 6 TEMP. 32°

DESCRIPTION LEFT CENTER LINE RIGHT JOB NO.

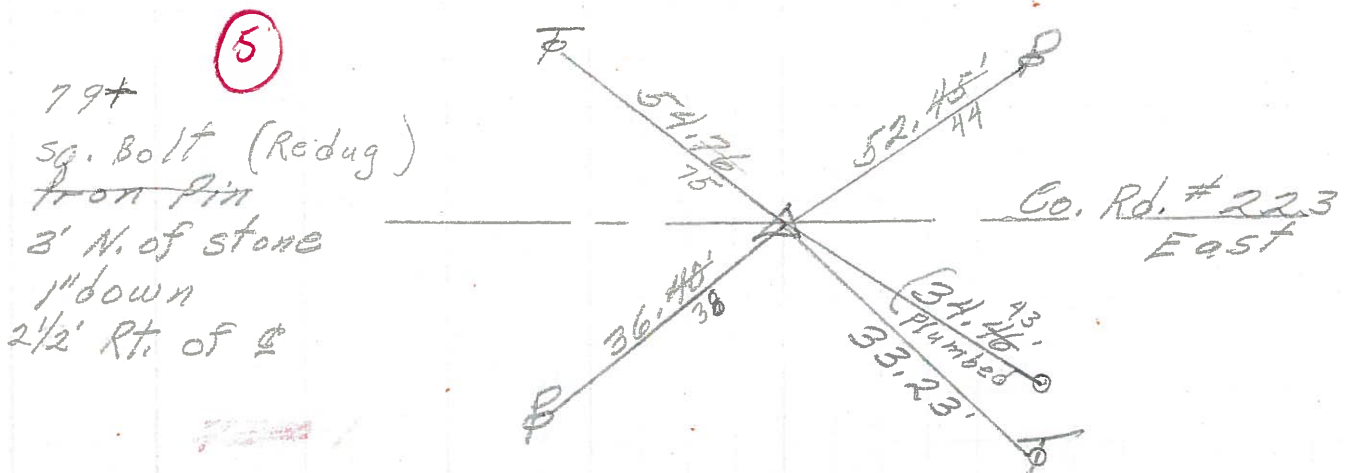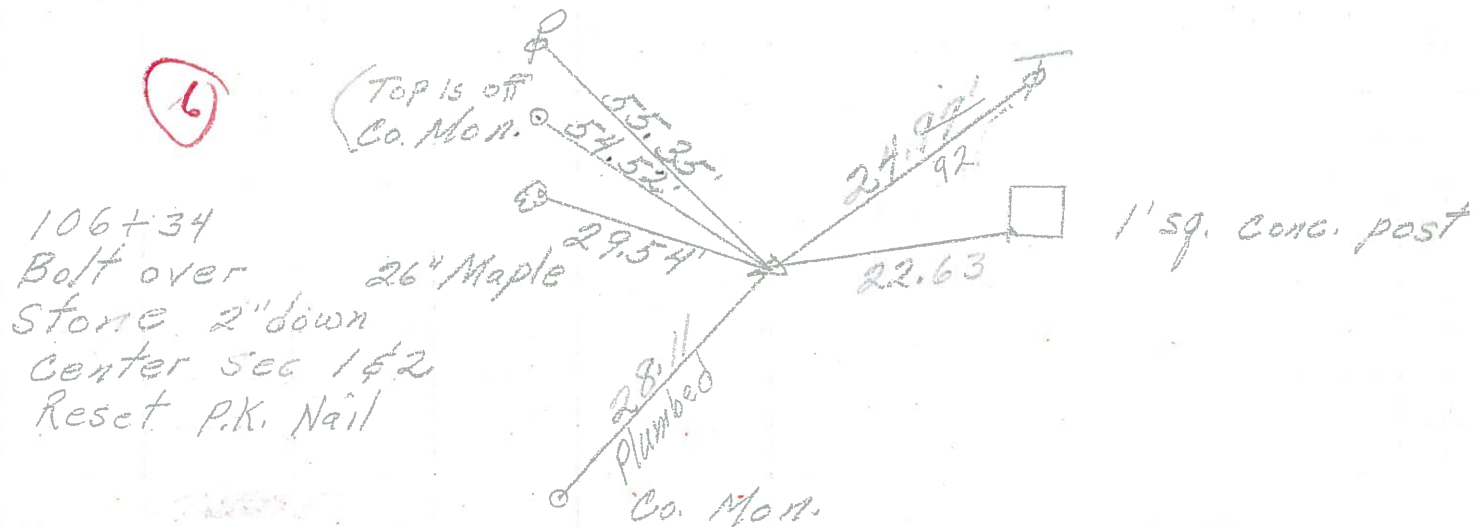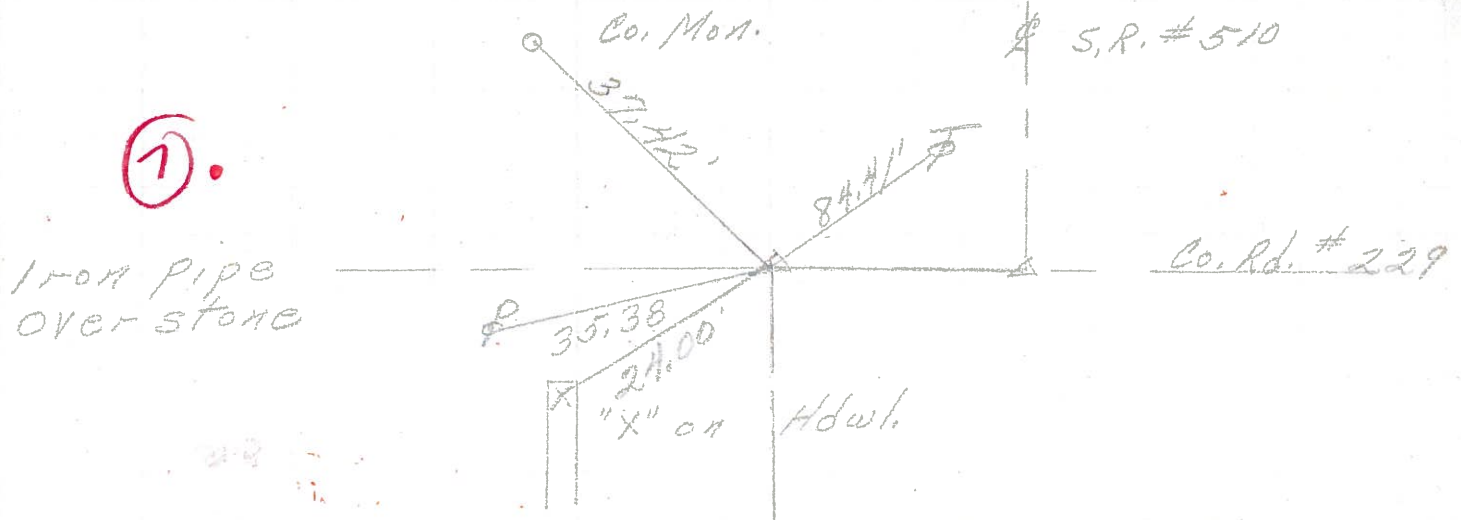

PERSONNEL TITLE PERSONNEL TITLE

Schneider

Potts

COUNTY

Sandusky

DATE

4-22-68

Mosser

S. R.

510

WEATHER

Fair

Barbour

SEC

U.S. #20 to U.S. #6

TEMP.

65°

DESCRIPTION

Ties for Control Points

JOB NO.

LEFT

CENTER LINE


RIGHT

S.R. #510

⑦

1" Iron pipe over
stone


7506

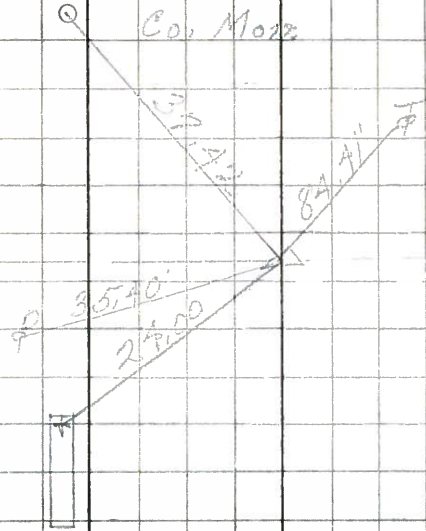

⑥

Bolt over stone
center sec-152.

7505

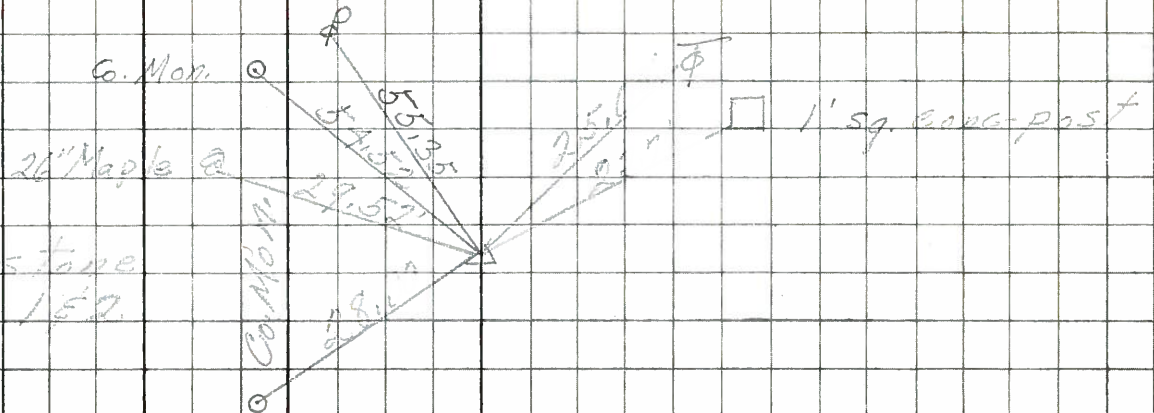

⑤

Iron pipe set 3' N. of stone
Co. Rd. #223 E&W.
3' Rt. of E

7504

