

O.D.O.T. DISTRICT 2 SURVEY OFFICE (USE ONLY)

PERSONNEL

REFERENCE NO. 7A

SHEET 8 OF 17

NOTES PRESTON-COLVIN

DATE 9/3/24

ROUTE SR 510

H.C. NEISE

WEATHER SUNNY

COUNTY SANDUSKY

R.C. PRESTON-COLVIN

TEMP. 75°

TOWNSHIP GREEN CREEK

SECTION 35

DWG BY PRESTON-COLVIN

PID PAVING TRAIN

T 4 N R 16 E

TYPE MONUMENT MAG SHANK

~~ON SURFACE~~ - BELOW 3/4" IPIN OVER STONE

OFFSET $\mathcal{Q}$ PAVEMENT 50' ~~LT~~ : RT

- TO - EDGE PAVEMENT

STATION: 132+52

HORIZ.DATUM: NAD83 (2011)


GEOID: 18

GRID: NORTHING:


EASTING:

LDP: NORTHING:

EASTING:

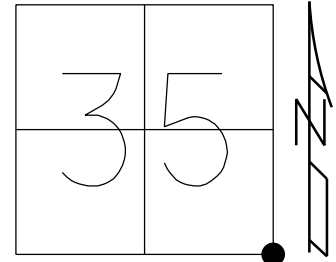

RECORD:
FD 3/4" IPIN
BENT ATOP
"X" IN STONE
9" DOWN
11/9/89, MB
D.N.F.
7/23/20, JMR
POSSIBLE MB
3.5" DOWN
9/3/24, TDN
POSSIBLE MB
3.5" DOWN
10/3/24, JAM

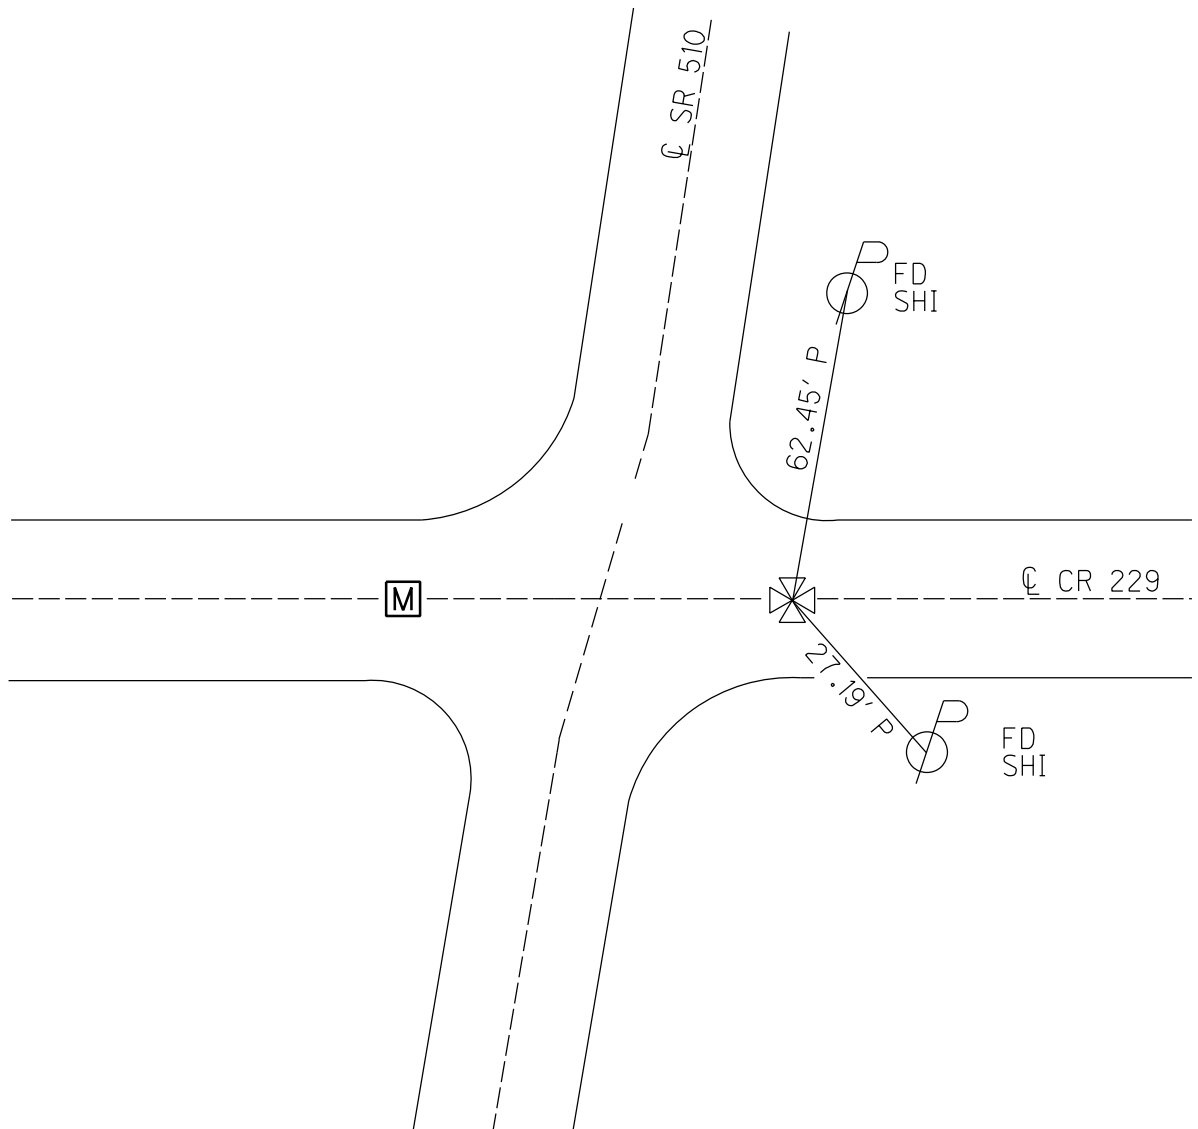

O.D.O.T. DISTRICT 2 SURVEY OFFICE (USE ONLY)

PERSONNEL

REFERENCE NO. 7 A

SHEET 8 OF 17

NOTES GARRETT

DATE 7/23/20

ROUTE SR 510

H.C. RHOADES

WEATHER CLOUDY

COUNTY SANDUSKY

R.C. MAHLER

TEMP. 77°

TOWNSHIP RILEY

SECTION 35

DWG BY RHOADES

PID PAVE TRAIN

T 5 N R 16 E

TYPE MONUMENT 3/4" IPIN OVER STONE

ON SURFACE - ~~BELOW~~ ON

OFFSET CL PAVEMENT 50' ~~LT~~ : RT

- TO - EDGE PAVEMENT


STATION: 132+52

HORZ.DATUM: NAD83 2011


GEOID: NAVD88 2012A

GRID: NORTHING: _____

EASTING: _____

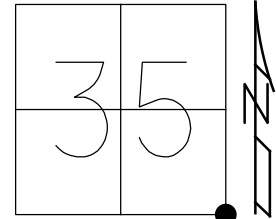

RECORD:
FD 3/4" IPIN
BENT ATOP
"X" IN STONE
9" DOWN
11/9/89, MB
D.N.F.
7/23/20, JMR

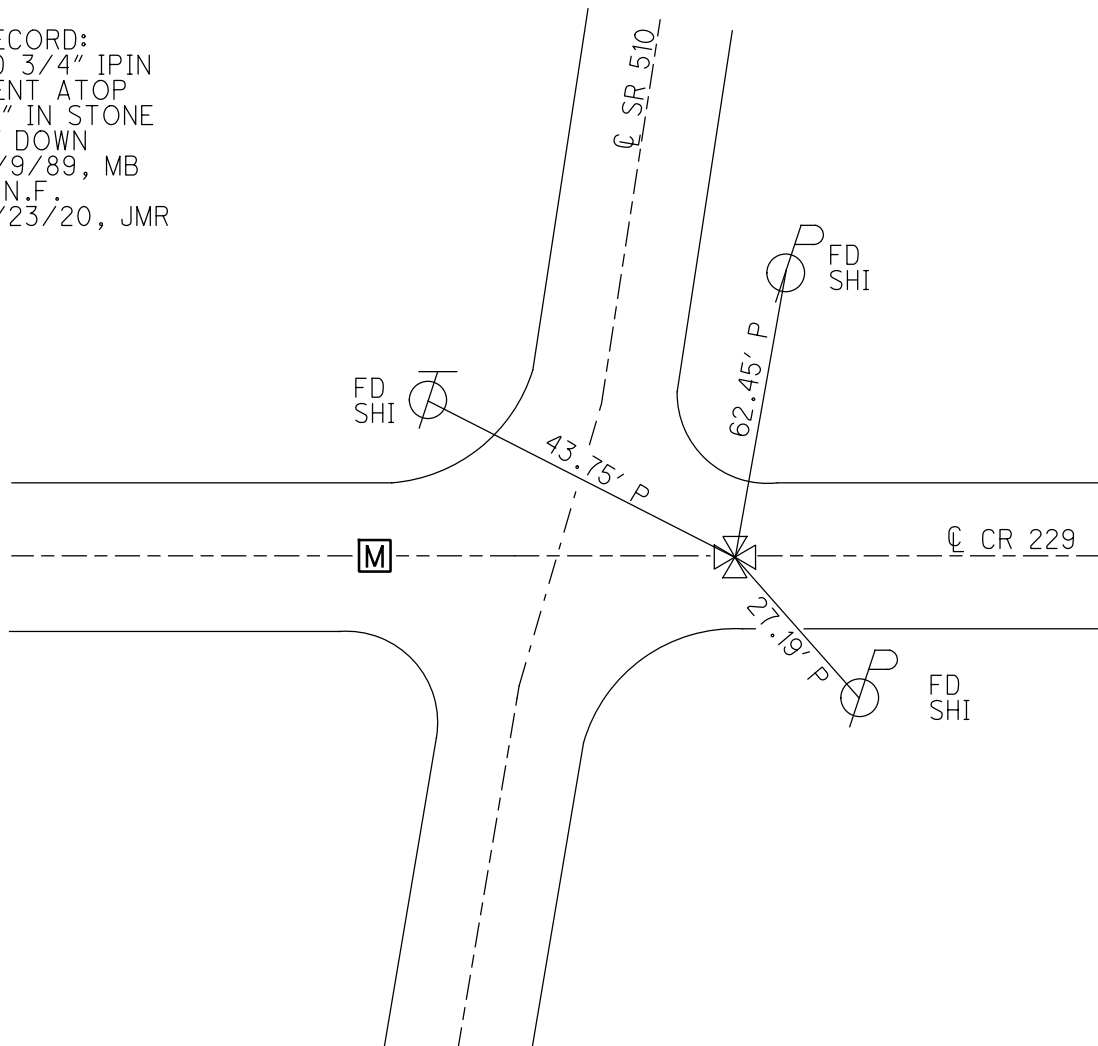

O.D.O.T. DISTRICT 2 SURVEY OFFICE (USE ONLY)

PERSONNEL

REFERENCE NO. 7 A

SHEET 8 OF 17

NOTES HOFFMAN

DATE 11/9/89

ROUTE SR 510

H.C. BARNHISEL

WEATHER CLOUDY

COUNTY SANDUSKY

R.C. _____

TEMP. 42°

TOWNSHIP RILEY

DWG BY _____ PID _____

SECTION 35

T 5 N R 16 E

TYPE MONUMENT 3/4" IPIN OVER STONE

ON SURFACE - ~~BELOW~~ ON

OFFSET CL PAVEMENT 50'± LT : RT

- TO - EDGE PAVEMENT


STATION: 132+52±

HORZ.DATUM: _____


GEOID: _____

GRID: NORTHING: _____

EASTING: _____

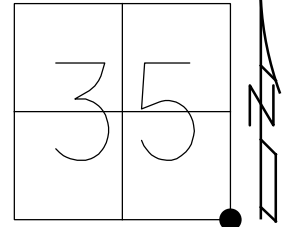

RECORD:
FD 3/4" IPIN
BENT ATOP
"X" IN STONE
9" DOWN
11/9/89, MB

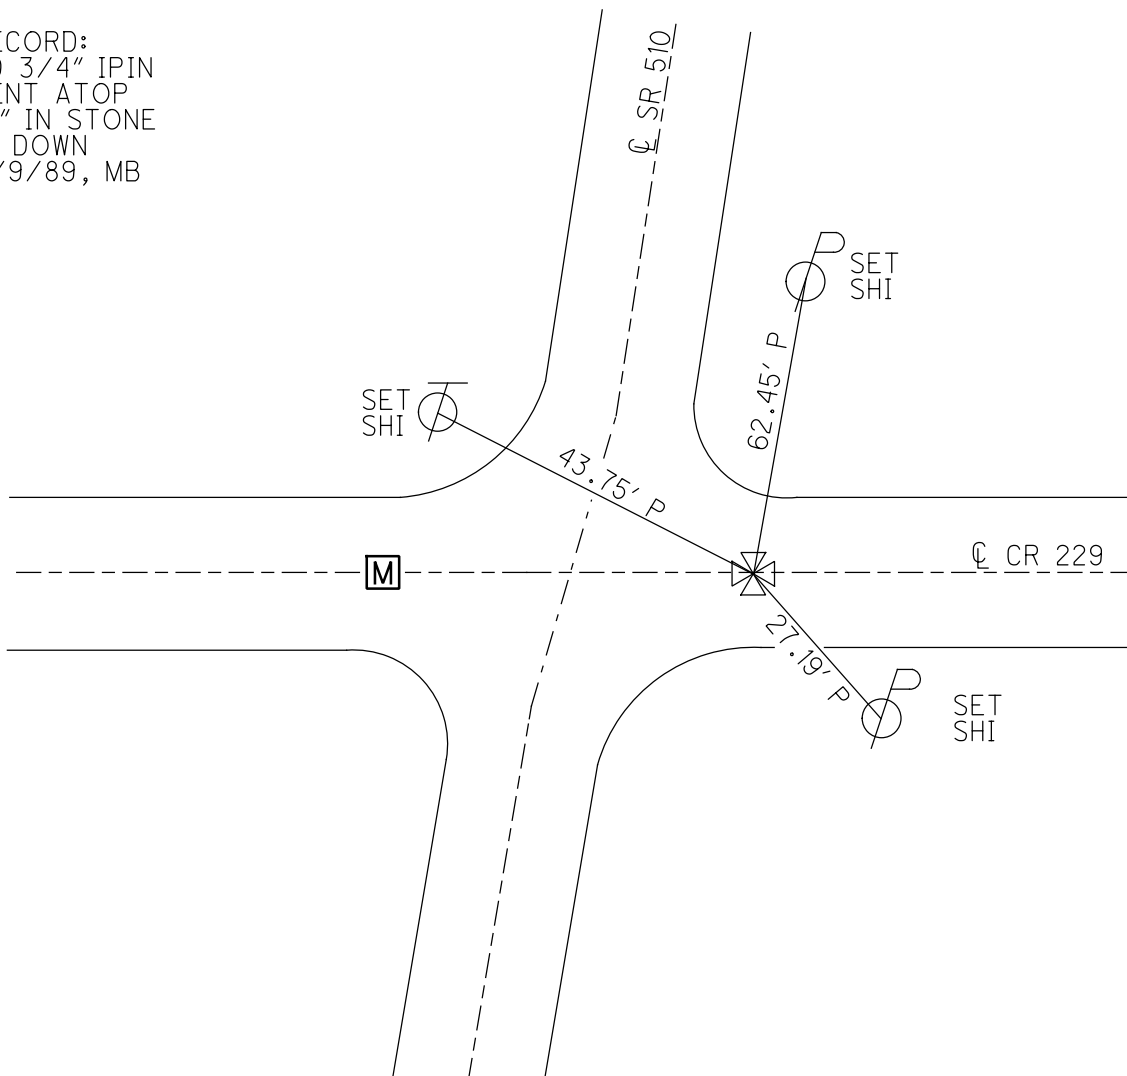

O.D.O.T. DISTRICT 2 SURVEY OFFICE

PERSONNEL

REFERENCE NO. 7A

SHEET 8 OF 17

NOTES HOFFMAN

DATE 11-9-89

ROUTE SR 510

H.C. BARNHISEL

WEATHER CLOUDY

COUNTY SANDUSKY

R.C. _____

TEMP. 42°

TOWNSHIP RILEY/GREEN

SECTION 35-36/1-2

T 4 N R 16 E

TYPE MONUMENT STONE w/ "x"

ALSO A
3/4" I. ROD
BENT OVER
ATOP "x"

35	36
2	1



~~ON SURFACE~~ - BELOW 9"


~~LEFT - C PAVT~~ - RIGHT 1'

1' TO SOUTH EDGE PAVEMENT

S.L.M. _____

NOTE: MONUMENT BOX
WAS OUTSIDE OF STATE
ROUTE 510 WORK LIMITS
WORK WAS DONE ON
COUNTY ROAD LATER
AND MONUMENT BOX
WAS NOT BROUGHT UP
TO THE SURFACE

Note:
See Previous TIES
Also:
See File: SAN-94

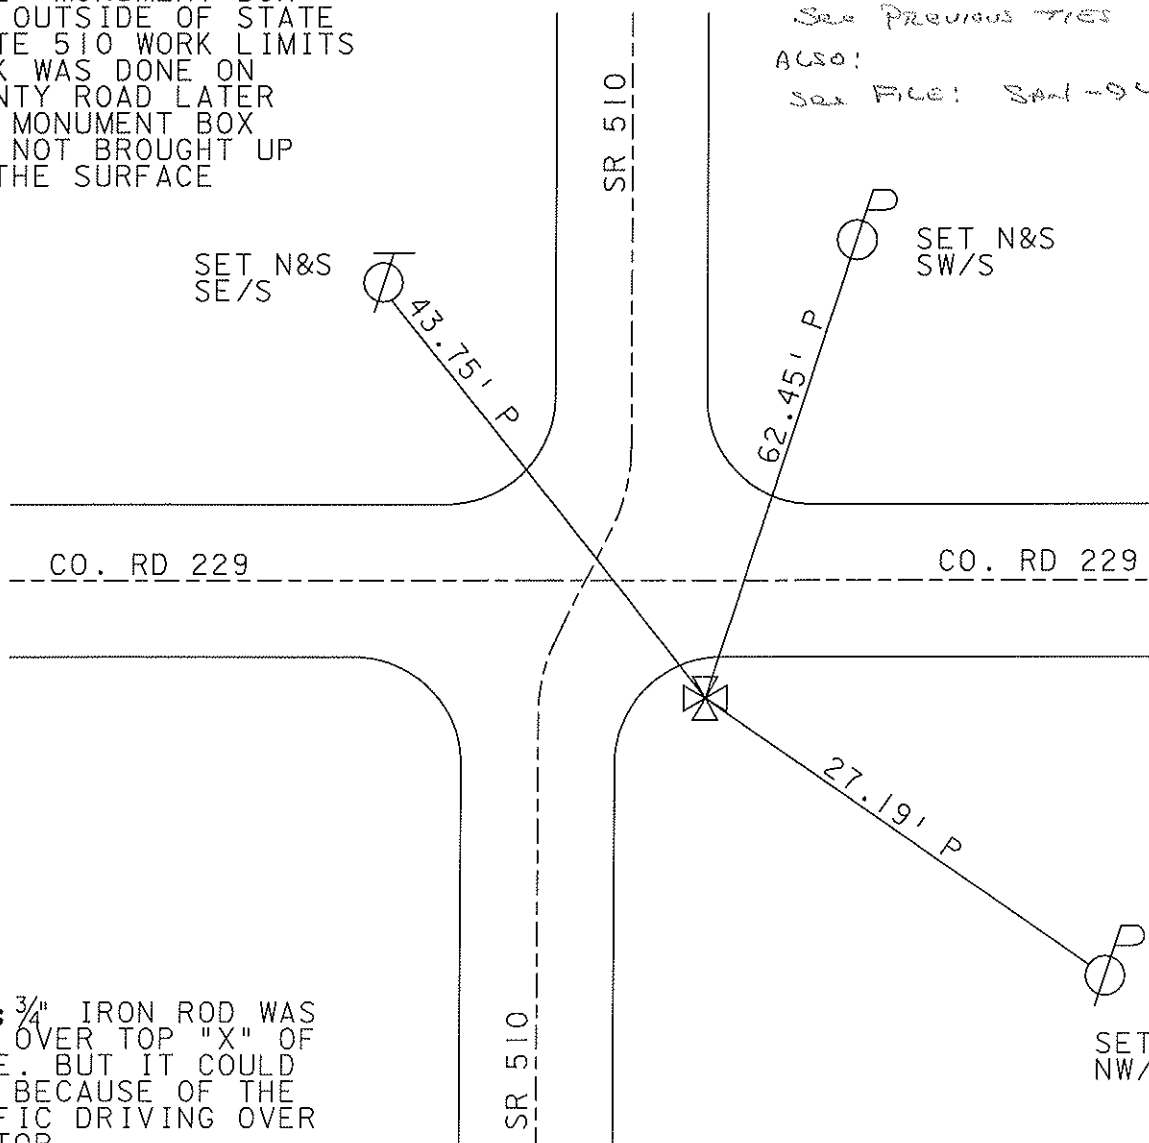

NOTE: 3/4" IRON ROD WAS
BENT OVER TOP "X" OF
STONE. BUT IT COULD
MOVE BECAUSE OF THE
TRAFFIC DRIVING OVER
THE TOP.

O.D.O.T. DISTRICT 2 SURVEY OFFICE

PERSONNEL

REFERENCE NO. 7-A

SHEET 6 OF 15

NOTES RIPPLE

H.C. BARBOUR

R.C. GEYMAN

DATE 8/14/90

WEATHER SUNNY

TEMP. 79°

ROUTE SR. #510

COUNTY SANDUSKY

TOWNSHIP Riley

SECTION 35 & 36

T. 5 N R. 16 E


TYPE MONUMENT STONE

ON SURFACE - BELOW 9" X 1' Limestone


LEFT - PAV'T. - RIGHT TO RT. & PAV'T.

TO EDGE PAVEMENT

S.L.M.

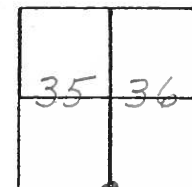

9" X 1' Limestone "t" ON Top
9" below surface 3/4" I. Rod
.43 S. of "t" ON Stone
1' South - South edge of point

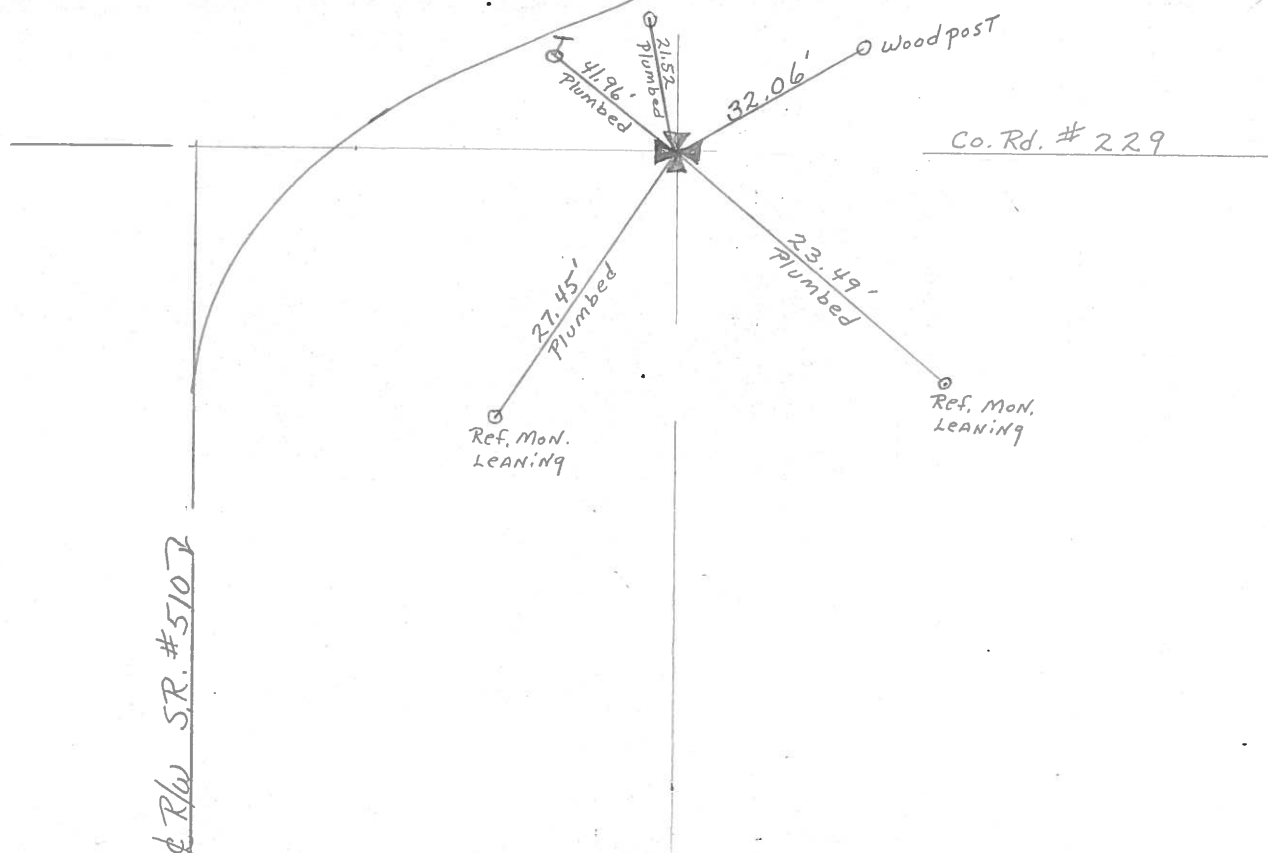

O.D.O.T. DISTRICT 2 SURVEY OFFICE

PERSONNEL

REFERENCE NO. 7-A

SHEET 6 OF 15

NOTES HOFFMAN

H.C. BARNHISEL

R.C. _____

DATE 11-9-89

WEATHER P. CLEAR

TEMP. 42° - WINDY

ROUTE SR 510

COUNTY SANDUSKY

TOWNSHIP RILEY & Green Creek

SECTION 1-2/35-36

T^{4E} N R 16 E

TYPE MONUMENT STONE w/ "t"

ON SURFACE - BELOW 9'



LEFT - C PAVT - RIGHT I'

1' TO South EDGE PAVEMENT

S.L.M. _____

ALSO A
3/4" I. ROD
BENT OVER
TOP "t" of
STONE

35	36
2	1

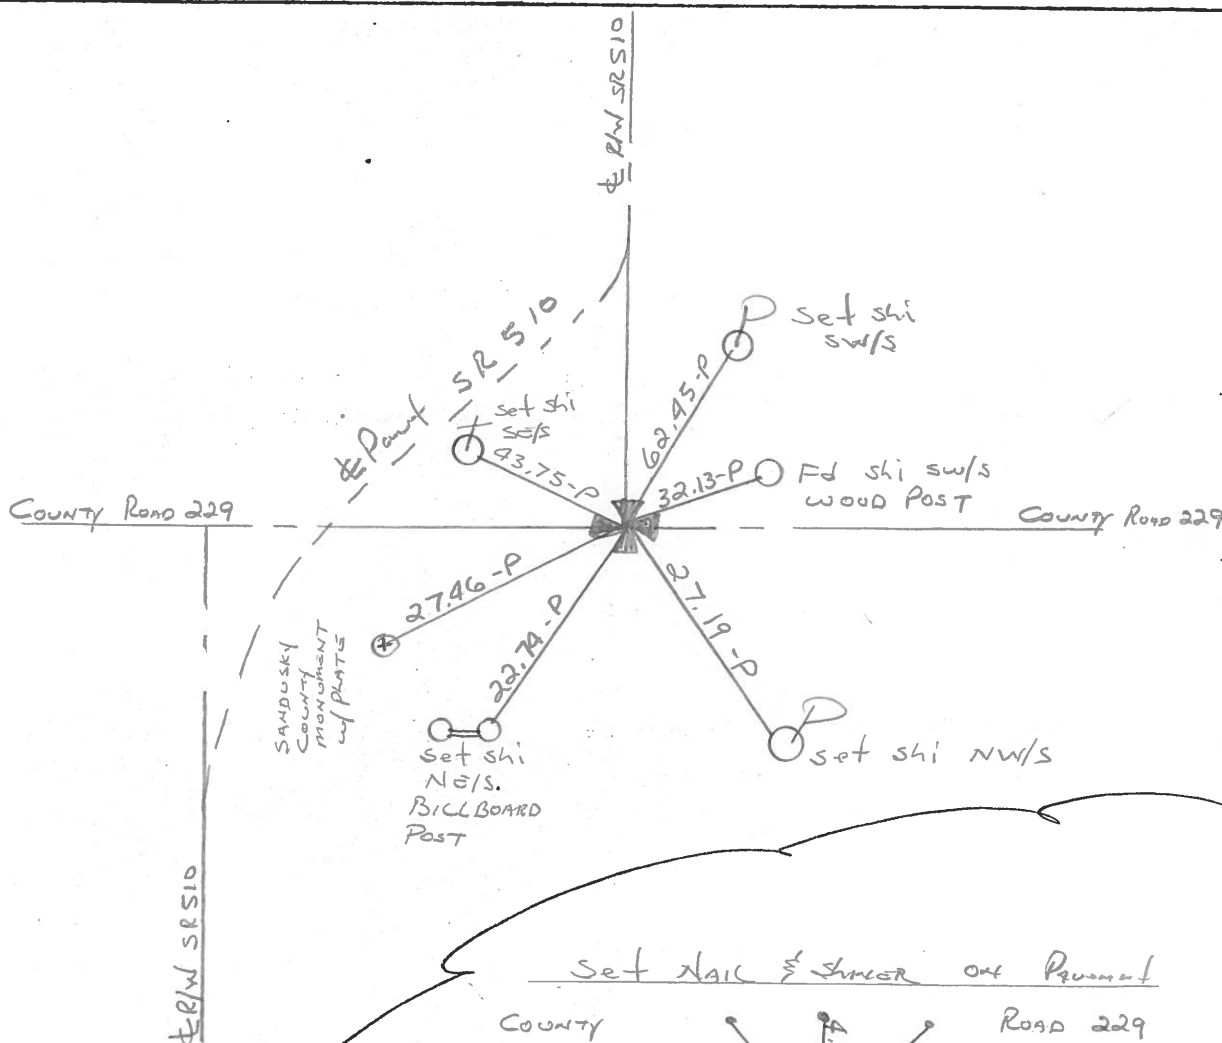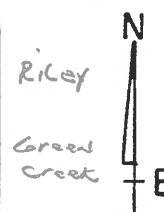

Set Nail & String out Monument

COUNTY ROAD 229

Notes: 3/4" I. ROD
WAS BENT OVER
TOP "t" of STONE.
BUT IT COULD MOVE
BECAUSE OF THE TRAFFIC
DRIVING OVER THE TOP.

CROSS FOUND ON
TOP OF 9"X11"
LIME STONE 9"
Below SURFACE

O.D.O.T. DISTRICT 2 SURVEY OFFICE

SHEET

OF

County Sandusky S.R. #510

Township Riley

Section 35 E 36

T5N, R16E

Personnel Cronin

Ripple

Geyman

Mosser


Barbour

#7-A


Date 4/26/82

Weather overcast

Temp. 75°

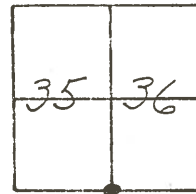

9x11' Limestone 't' on
top - 9" below surface 3/4"
T. Rod .43 S. of 't' on stone
1' south-south edge of permit

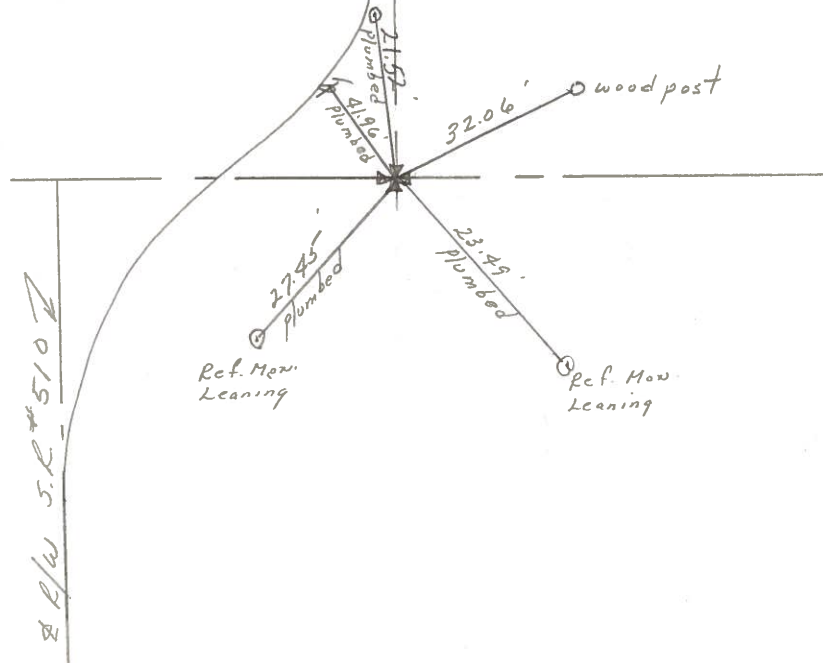

PERSONNEL	TITLE	PERSONNEL	TITLE	COUNTY	DATE
Schneider		Potts		Sandusky	2
Mosser				S. R. # 510	WEATHER
Barbour				SEC. U.S. # 206	TEMP. 6
Redding					

DESCRIPTION Ties for control Points JOB NO. _____

LEFT


CENTER LINE

RIGHT

P.T.
172+12.50
P.K. Nail
1/2" down

⑨


7509

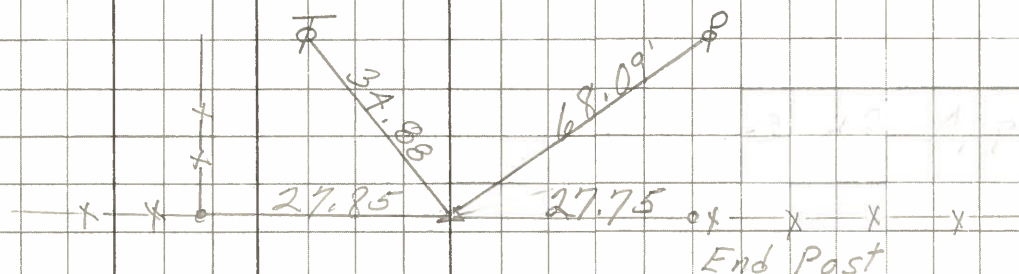

P.I.
158+92.80
Fd. P.K. Nail
Co. Rd. # 231

⑧

7508

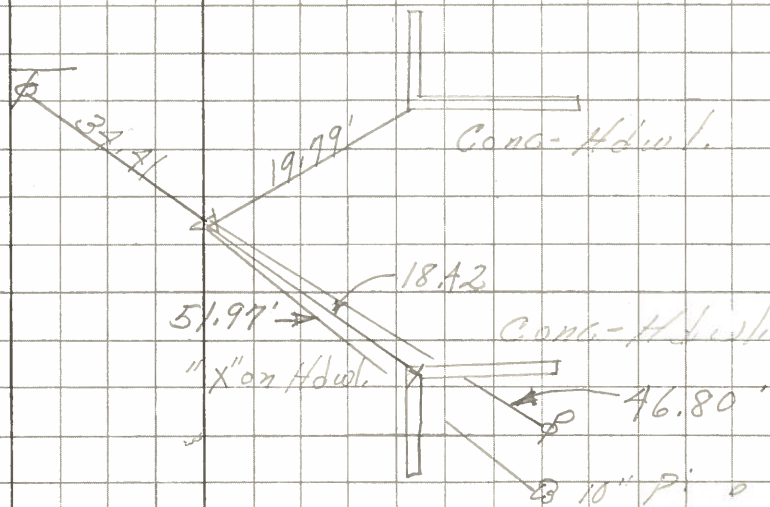

3/4" rod on south side
of stone

⑦A

7507

