

# O.D.O.T. DISTRICT 2 SURVEY OFFICE (USE ONLY)

PERSONNEL

REFERENCE NO. 8

SHEET 9 OF 17

NOTES PRESTON-COLVIN

DATE 9/3/24

ROUTE SR 510

H.C. NEISE

WEATHER SUNNY

COUNTY SANDUSKY

R.C. PRESTON-COLVIN

TEMP. 77°

TOWNSHIP RILEY

SECTION 35

DWG BY PRESTON-COLVIN PID PAVING TRAIN

T 5 N R 16 E

TYPE MONUMENT MAG NAIL

ON SURFACE - ~~BELOW~~ ON

OFFSET Q PAVEMENT 4.3' ~~LT~~ : RT

- TO - EDGE PAVEMENT

STATION: 159+50

HORIZ.DATUM: NAD83 (2011)


GEOID: 18

GRID: NORTHING:


EASTING:

LDP: NORTHING:

EASTING:

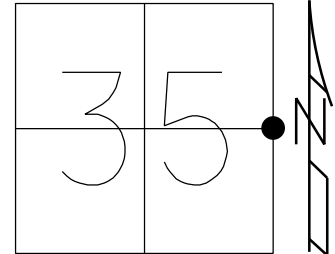

RECORD: P.I.  
STA. 158+92.80  
FD P.K.NAIL  
4/22/68, BARBOUR  
FD P.K./WASHER  
6/21/04, DCH  
SET MAG/WASHER  
10/08/04, DCH  
FD MAG/WASHER  
REF8  
7/23/20, JMR  
3/10/21, JMR  
FD MAG NAIL  
REF8  
9/3/24, TDN  
FD MAG NAIL  
10/3/24, JAM

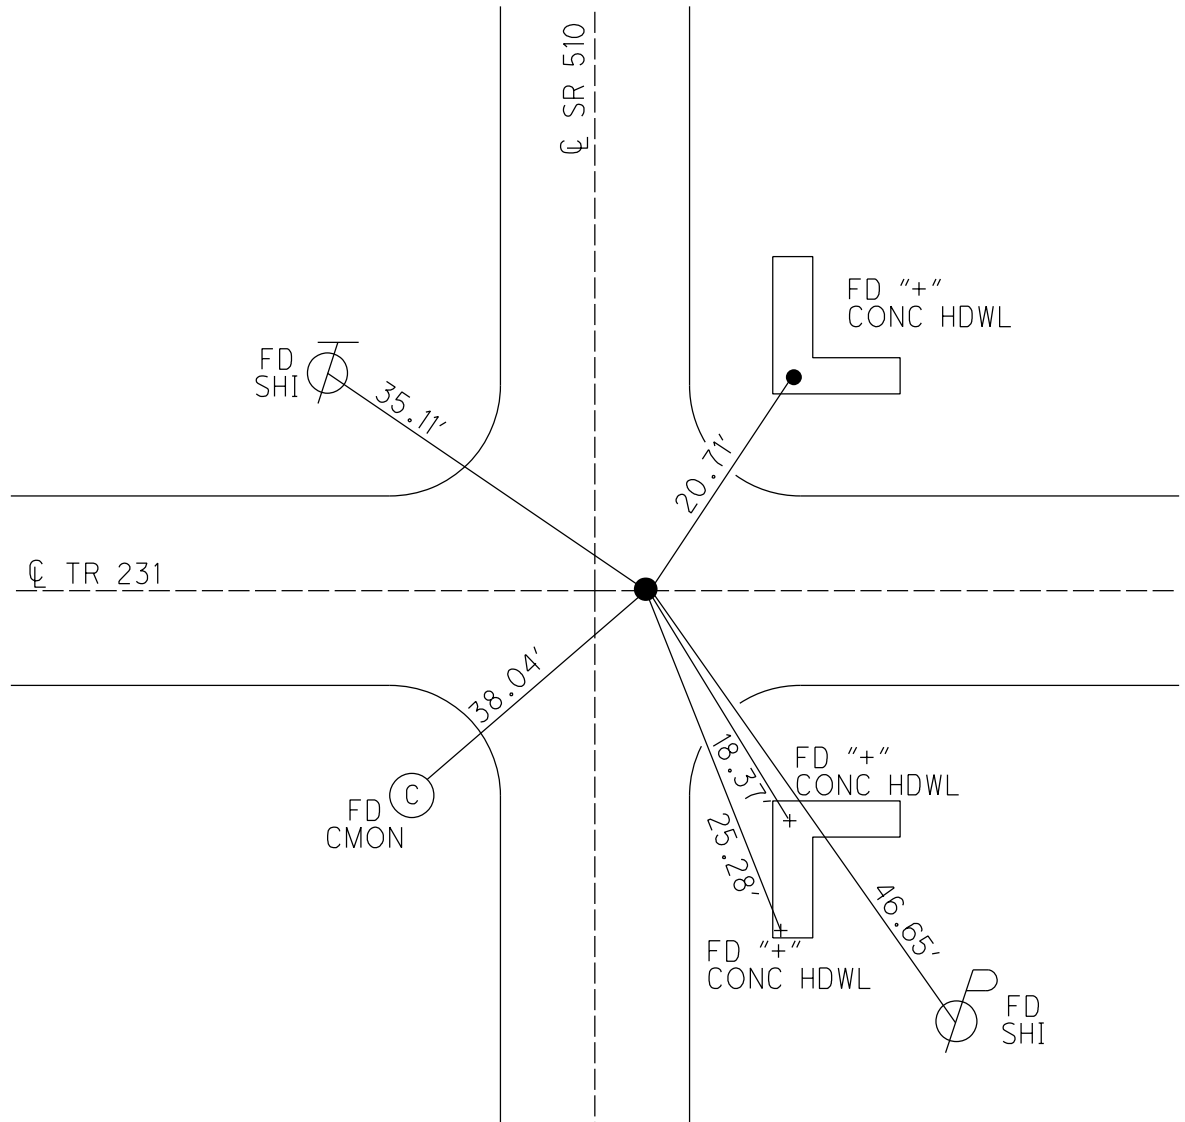

O.D.O.T. DISTRICT 2 SURVEY OFFICE (USE ONLY)

PERSONNEL

REFERENCE NO. 8

SHEET 9 OF 17

NOTES GARRETT

DATE 7/23/20

ROUTE SR 510

H.C. RHOADES

WEATHER CLOUDY

COUNTY SANDUSKY

R.C. MAHLER

TEMP. 77°

TOWNSHIP RILEY

SECTION 35

DWG BY RHOADES

PID PAVE TRAIN

T 5 N R 16 E

TYPE MONUMENT MAG/WASHER

ON SURFACE - ~~BELOW~~ ON

OFFSET CL PAVEMENT 4.3' ~~LT~~ : RT

- TO - EDGE PAVEMENT


STATION: 159+50

HORIZ.DATUM: NAD83 2011


GEOID: NAVD88 2012A

GRID: NORTHING: 613783.993

EASTING: 1838329.599

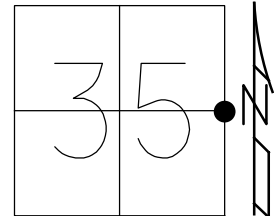

RECORD: P.I.  
STA. 158+92.80  
FD P.K.NAIL  
4/22/68, BARBOUR  
FD P.K./WASHER  
6/21/04, DCH  
SET MAG/WASHER  
10/08/04, DCH  
FD MAG/WASHER  
REF8  
7/23/20, JMR  
3/10/21, JMR

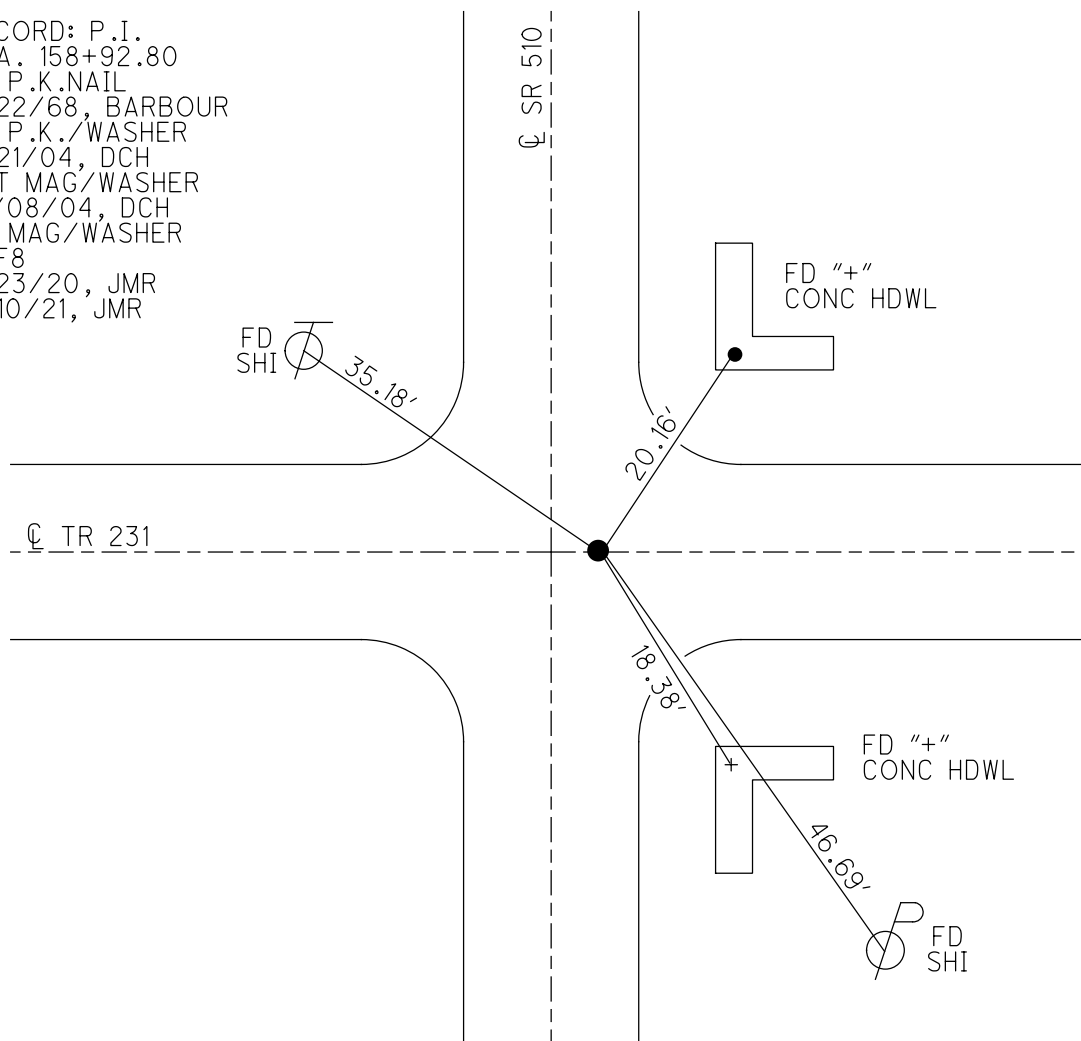

O.D.O.T. DISTRICT 2 SURVEY OFFICE (USE ONLY)

PERSONNEL

REFERENCE NO. 8

SHEET 9 OF 17

NOTES HOMAN

DATE 6/21/04

ROUTE SR 510

H.C. HOMAN

WEATHER SUNNY

COUNTY SANDUSKY

R.C. ADKINS

TEMP. 80°

TOWNSHIP RILEY

SECTION 35

DWG BY \_\_\_\_\_ PID \_\_\_\_\_

T 5 N R 16 E

TYPE MONUMENT P.K./WASHER

ON SURFACE - ~~BELOW~~ ON

OFFSET Q PAVEMENT 4.3' ~~LT~~ : RT

- TO - EDGE PAVEMENT


STATION: 159+50

HORZ.DATUM: \_\_\_\_\_


GEOID: \_\_\_\_\_

GRID: NORTHING: \_\_\_\_\_

EASTING: \_\_\_\_\_

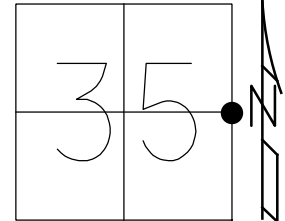

RECORD: P.I.  
STA. 158+92.80  
FD P.K.NAIL  
4/22/68, BARBOUR  
SET MAG/WASHER  
10/08/04, DCH

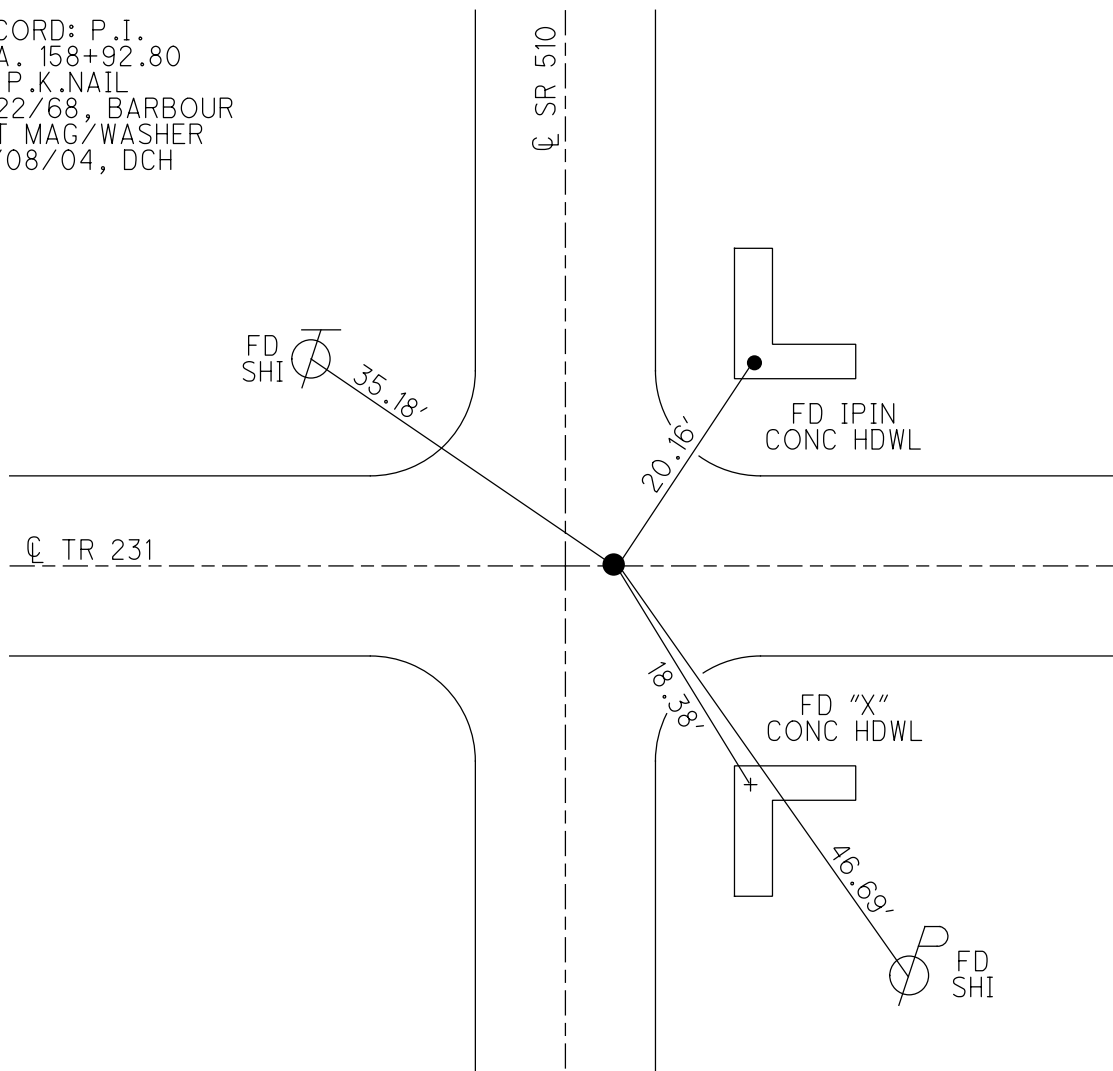

O.D.O.T. DISTRICT 2 SURVEY OFFICE

PERSONNEL

REFERENCE NO. 8

SHEET 9 OF 17

NOTES HOMAN

DATE 6-21-04

ROUTE SR 510

H.C. HOMAN

WEATHER SUNNY

COUNTY SANDUSKY

R.C. ADKINS

TEMP. +80°

TOWNSHIP RILEY

SECTION 35&36

T 5 N R 16 E


TYPE MONUMENT P.K. & WASHER

~~ON SURFACE~~ - BELOW YES


~~LEFT - C PAVE~~ - RIGHT 4.3' RT

TO EDGE PAVEMENT

S.L.M. 159+50

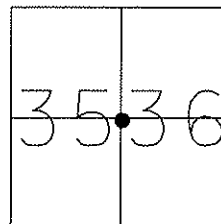

RESET MAG NAIL  
10-8-04  
DCH

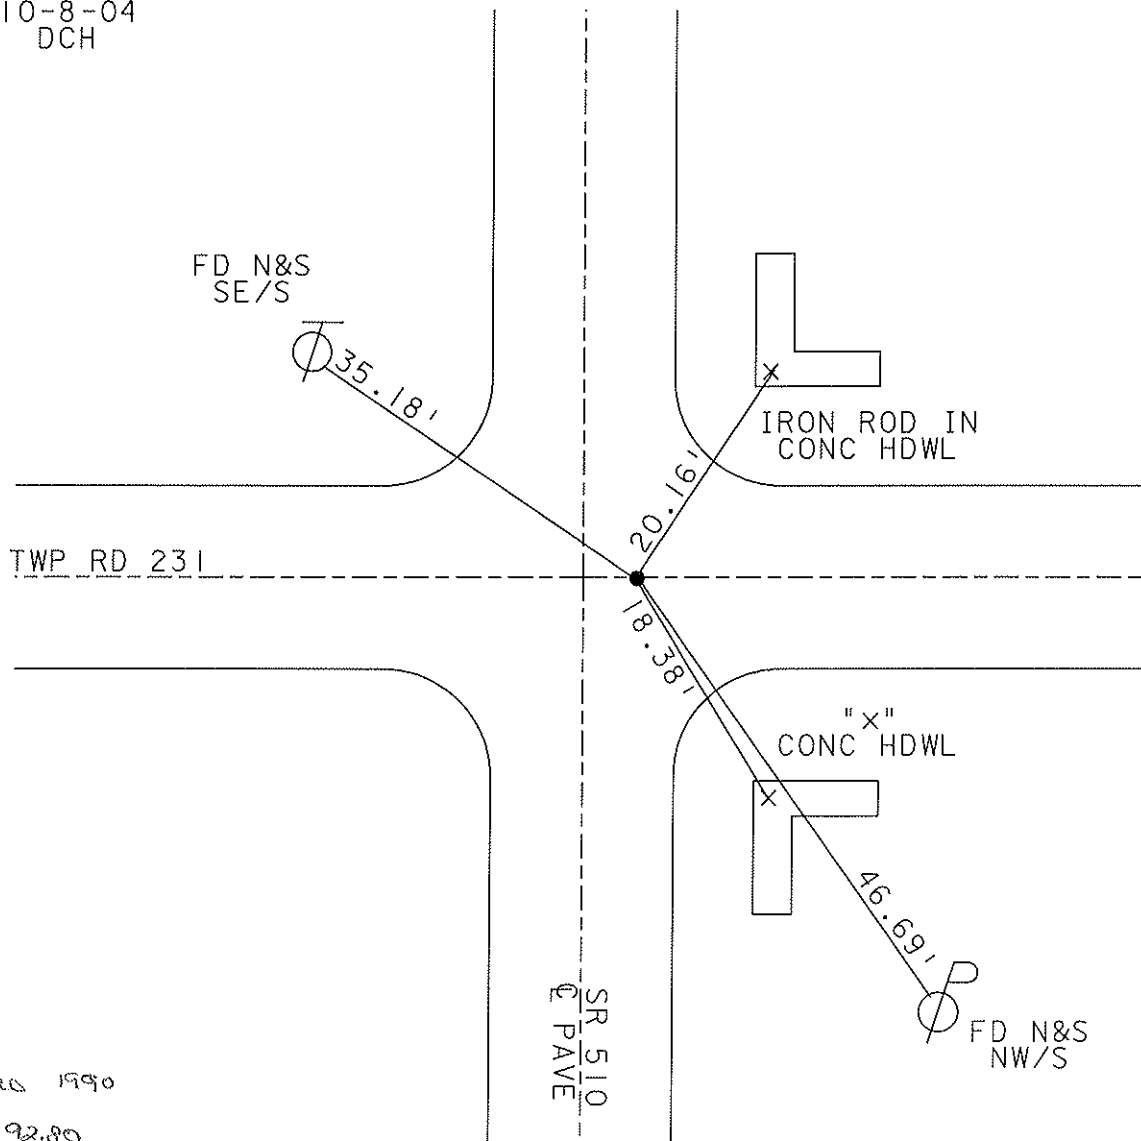

RECORD 1990

158+92.80

P.K. WASHER

O.D.O.T. DISTRICT 2 SURVEY OFFICE

PERSONNEL

REFERENCE NO. 8

SHEET 7 OF 15

NOTES RIPPLE

H.C. BARBOUR

R.C. GEYMAN

DATE 8/14/90

WEATHER SUNNY

TEMP. 79°

ROUTE SR#590

COUNTY SANDUSKY

TOWNSHIP Riley

SECTION 35 & 36

T 5 N R 16 E


TYPE MONUMENT P.K. & WASHER

ON SURFACE - BELOW A Top P.K. & WASHER

LEFT - CL PAV'T. - RIGHT 4.3' ± RT. CL PAV'T.

TO EDGE PAVEMENT

S.L.M.

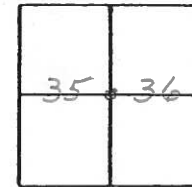

158+92.80

Twp. Rd. #231

35.17'

20.17'

18.40'

CL R/W SR#5107

Conc. Hdwl.

Re-Rod

Conc. Hdwl.

46.77'

51.78'

19" Pine

# O.D.O.T. DISTRICT 2 SURVEY OFFICE

SHEET

OF

County Sandusky S.R. #510

Date 9/10/82

Township Riley

Weather sunny

Section 35, 36

Temp. 72°

T5N, R16E

Personnel Cronin


Lipple

Geyman

Mosser


Barbour

#8

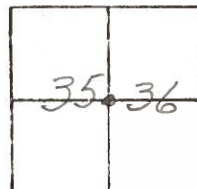

158+92.80

set P.K. & washer at top P.K. &  
washer 4.3 ± ft. & pavement

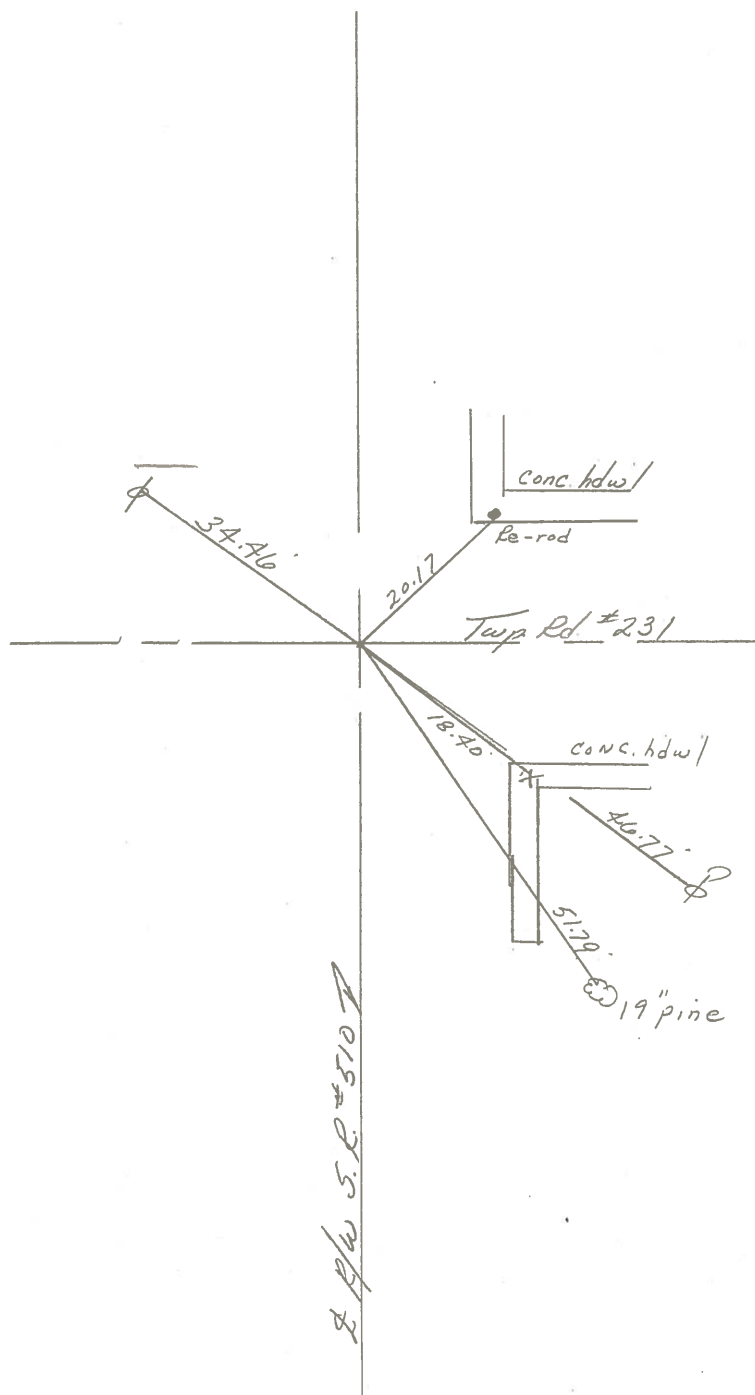


PERSONNEL TITLE PERSONNEL TITLE

COUNTY Sandusky DATE 4-15-71S. R. 510 WEATHER FairSEC. U.S. 20 to U.S. 6 TEMP. 50°

DESCRIPTION LEFT CENTER LINE RIGHT JOB NO.


(9)

172+12.50  
P.K. Nail  
1 1/2" down  
Reset small spk

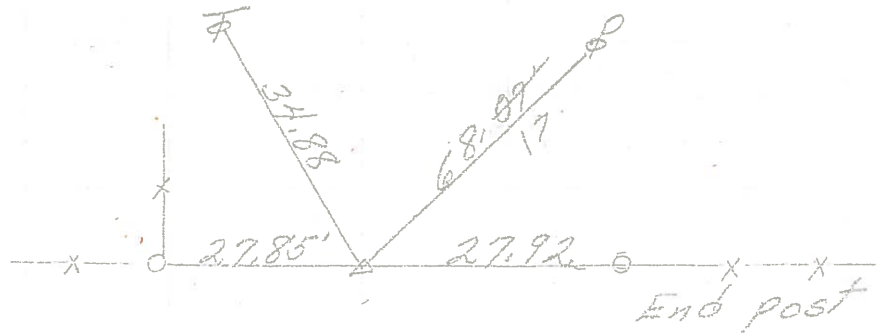


(8)

158+92.80  
Fd. P.K. Nail  
4.3' Rt. of L

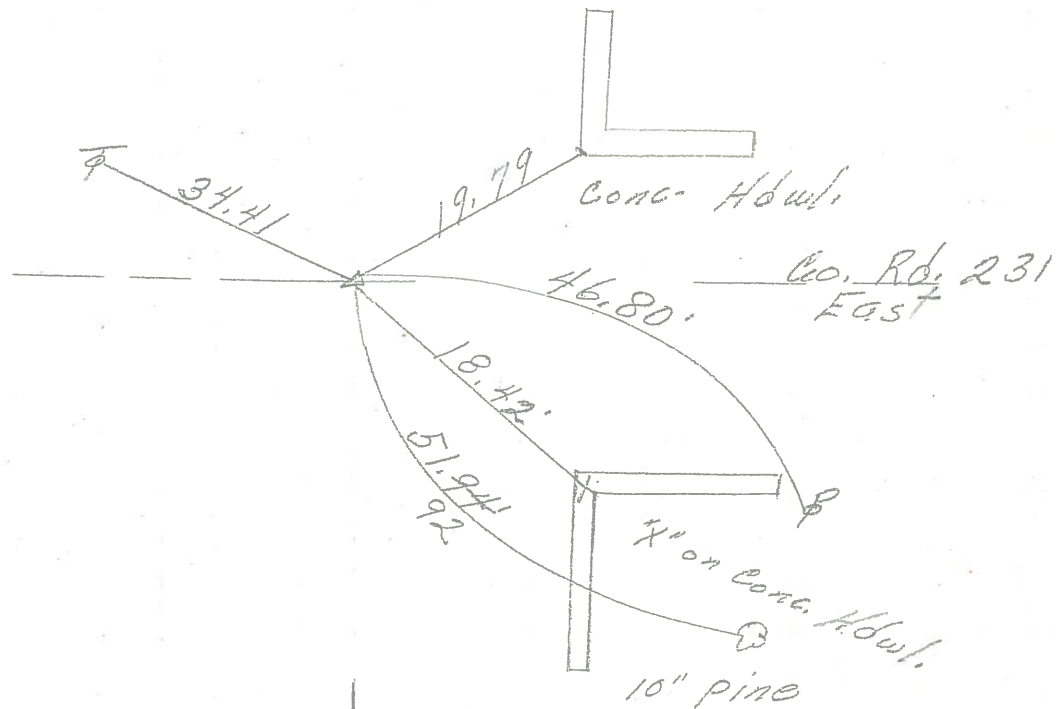~~7A~~

3/4" rod on south  
side of stone  
1' s. of edge Parm't.

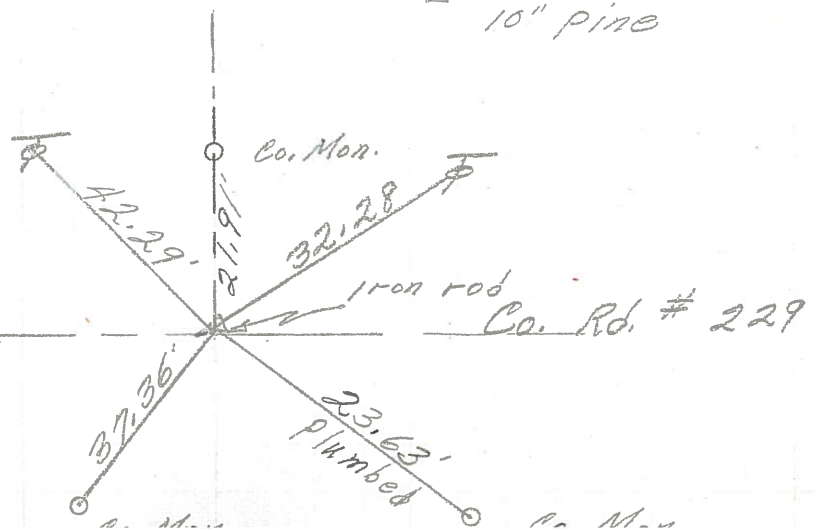

| PERSONNEL | TITLE | PERSONNEL | TITLE | COUNTY                   | DATE         |
|-----------|-------|-----------|-------|--------------------------|--------------|
| Schneider |       | Potts     |       | Sandusky                 | 9-22-68      |
| Mosser    |       |           |       | S. R. # 510              | WEATHER Fair |
| Barbour   |       |           |       | SEC. U.S. #20 to U.S. #6 | TEMP. 65°    |
| Redding   |       |           |       |                          |              |

DESCRIPTION Ties for control Points JOB NO. \_\_\_\_\_

