

O.D.O.T. DISTRICT 2 SURVEY OFFICE (USE ONLY)

PERSONNEL

REFERENCE NO. 10

SHEET 11 OF 17

NOTES PRESTON-COLVIN

H.C. NEISE

R.C. PRESTON-COLVIN

DATE 9/3/24

WEATHER SUNNY

TEMP. 65°

ROUTE SR 510

COUNTY SANDUSKY

TOWNSHIP RILEY

SECTION 26

DWG BY PRESTON-COLVIN PID PAVING TRAIN

T 5 N R 16 E

TYPE MONUMENT MAG/WASHER

ON SURFACE - ~~BELOW~~ ON

OFFSET Q PAVEMENT 0.8' ~~LT~~ : RT

- TO - EDGE PAVEMENT

STATION: 185+95

HORIZ.DATUM: NAD83 (2011)


GEOID: 18

GRID: NORTHING: 616423.172


EASTING: 1838390.514

LDP: NORTHING: 312676.7

EASTING: 198647.8

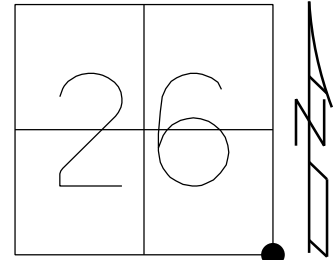

RECORD:
FD R.R.SPIKE
SET P.K./WASHER
1971
FD LG.R.R.SPIKE
3" DOWN
6/21/04, DCH
SET MAG/WASHER
10/08/04, DCH
FD MAG SHANK
REF10
9/15/14, JLL
D.N.F.
7/23/20, JMR
SET MAG/WASHER
REF10
7/20/22, JMR
FD MAG/WASHER
REF10
9/3/24, TDN
FD MAG/WASHER
10/3/24, JAM

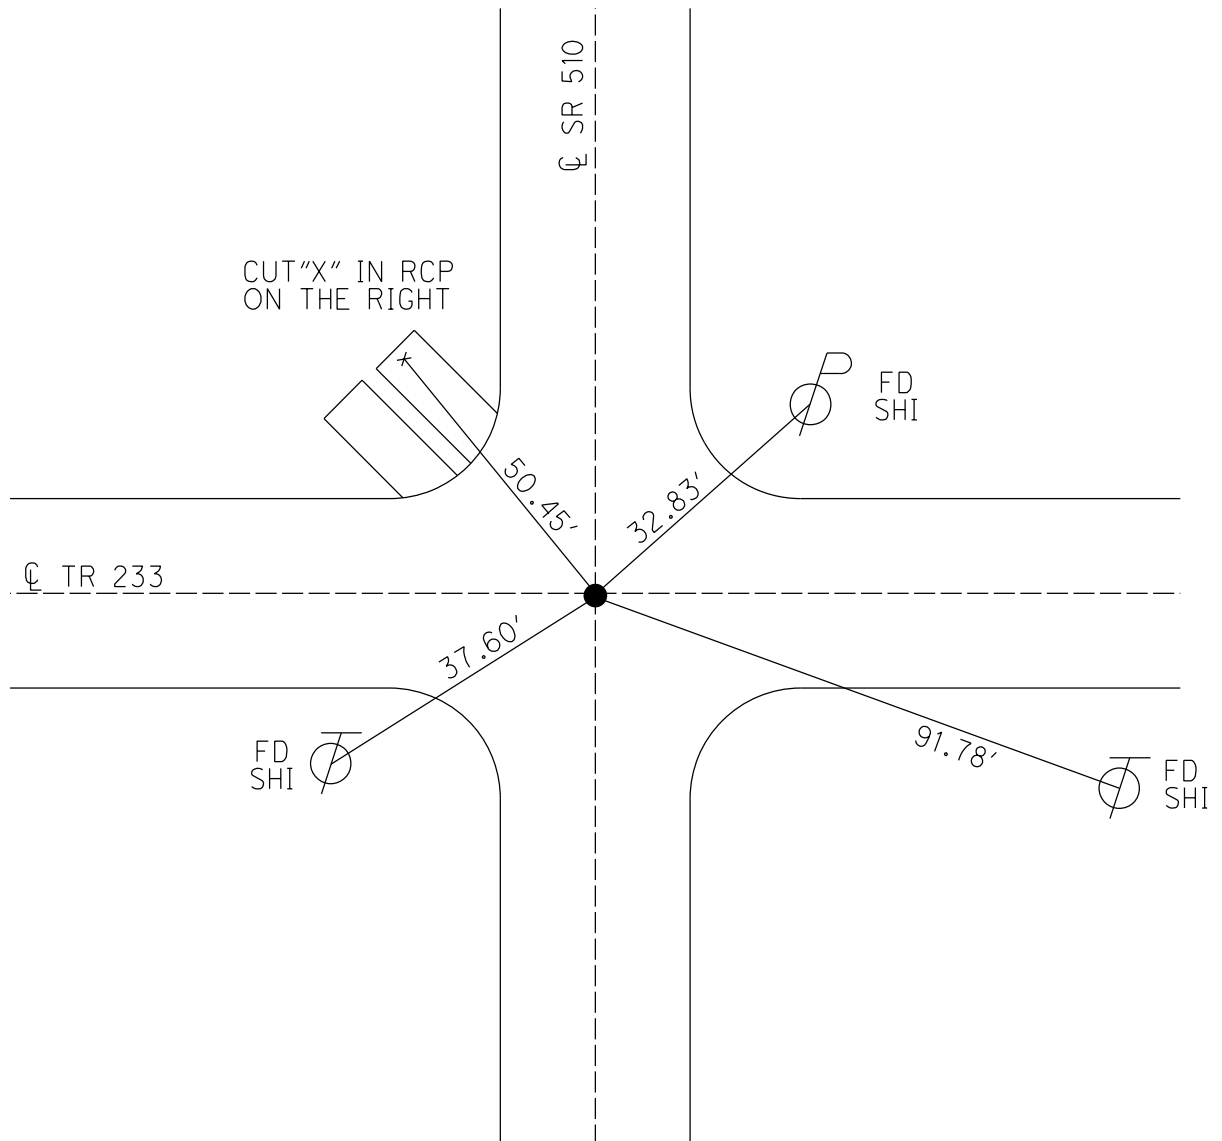

O.D.O.T. DISTRICT 2 SURVEY OFFICE (USE ONLY)

PERSONNEL

REFERENCE NO. 10

SHEET 11 OF 18

NOTES RHOADES

DATE 7/20/22

ROUTE SR 510

H.C. RHOADES

WEATHER HUMID

COUNTY SANDUSKY

R.C. WHITAKER

TEMP. 84°

TOWNSHIP RILEY

SECTION 26

DWG BY WHITAKER

PID PVTRN

T 5 N R 16 E

TYPE MONUMENT MAG/WASHER

ON SURFACE - ~~BELOW~~ ON

OFFSET CL PAVEMENT 0.8' LT : ~~RT~~

- TO - EDGE PAVEMENT


STATION: 185+95

HORZ.DATUM: NAD83 2011

GEOID: NAVD88 2012A

GRID: NORTHING: 616423.172

EASTING: 1838390.514

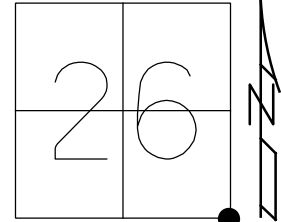

RECORD:

FD R.R.SPIKE
SET P.K./WASHER
1971

FD LG.R.R.SPIKE
3" DOWN

6/21/04, DCH
SET MAG/WASHER
10/08/04, DCH


FD MAG SHANK
REF10

9/15/14, JLL

D.N.F.

7/23/20, JMR
SET MAG/WASHER
REF10

7/20/22, JMR

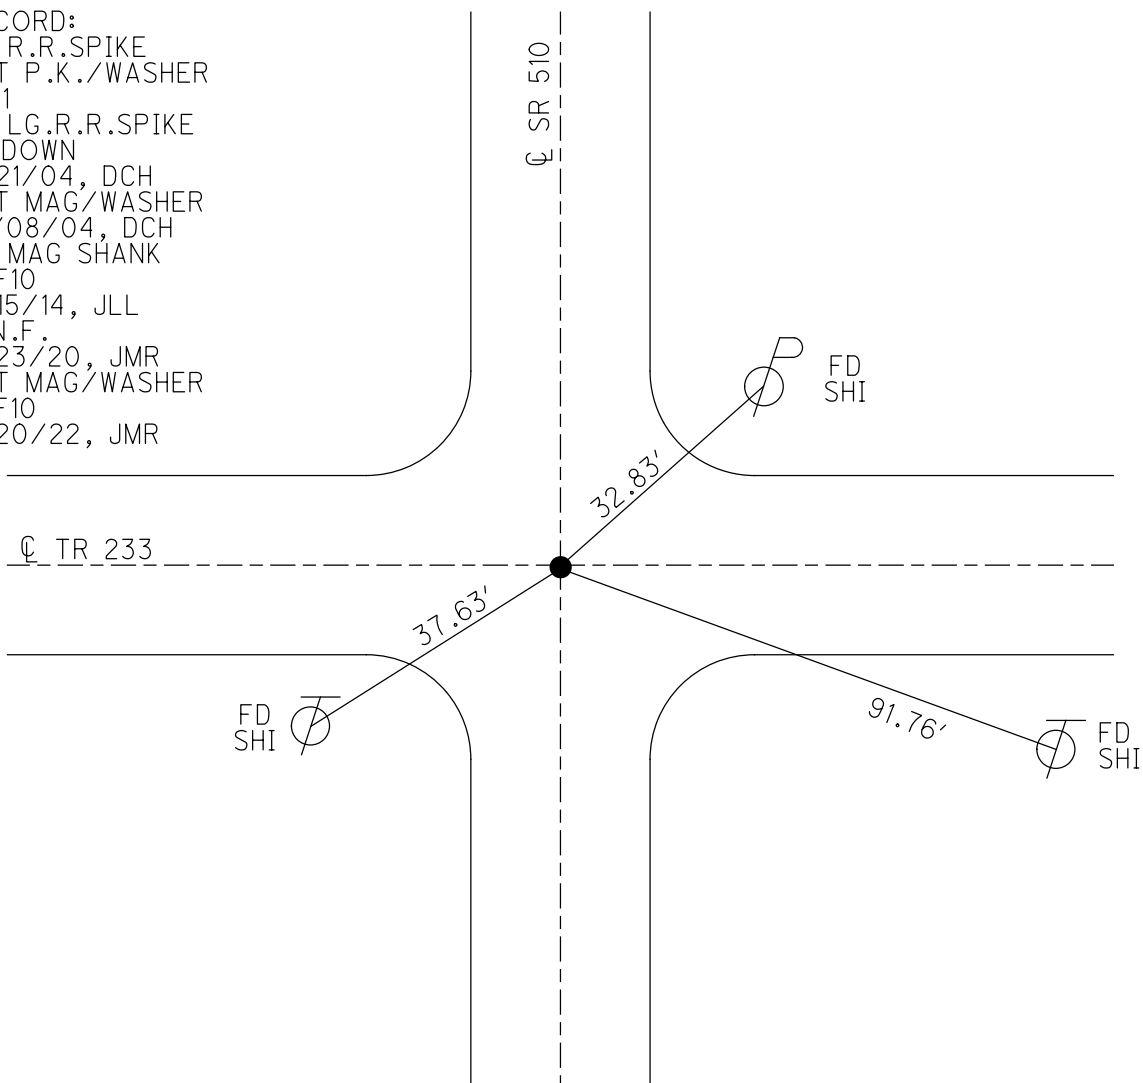

O.D.O.T. DISTRICT 2 SURVEY OFFICE (USE ONLY)

PERSONNEL

REFERENCE NO. 10

SHEET 11 OF 17

NOTES GARRETT

DATE 7/23/20

ROUTE SR 510

H.C. RHOADES

WEATHER CLOUDY

COUNTY SANDUSKY

R.C. MAHLER

TEMP. 77°

TOWNSHIP RILEY

SECTION 26

DWG BY RHOADES

PID PAVE TRAIN

T 5 N R 16 E

TYPE MONUMENT MAG SHANK

ON SURFACE - ~~BELOW~~ ON

OFFSET Q PAVEMENT ON LT : RT

- TO - EDGE PAVEMENT


STATION: 185+95

HORIZ.DATUM: NAD83 2011


GEOID: NAVD88 2012A

GRID: NORTHING: 616423.180

EASTING: 1838390.574

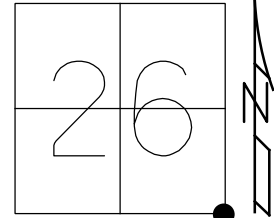

RECORD:
FD R.R.SPIKE
SET P.K./WASHER
1971
FD LG.R.R.SPIKE
3" DOWN
6/21/04, DCH
SET MAG/WASHER
10/08/04, DCH
FD MAG SHANK
REF10
9/15/14, JLL
D.N.F.
7/23/20, JMR

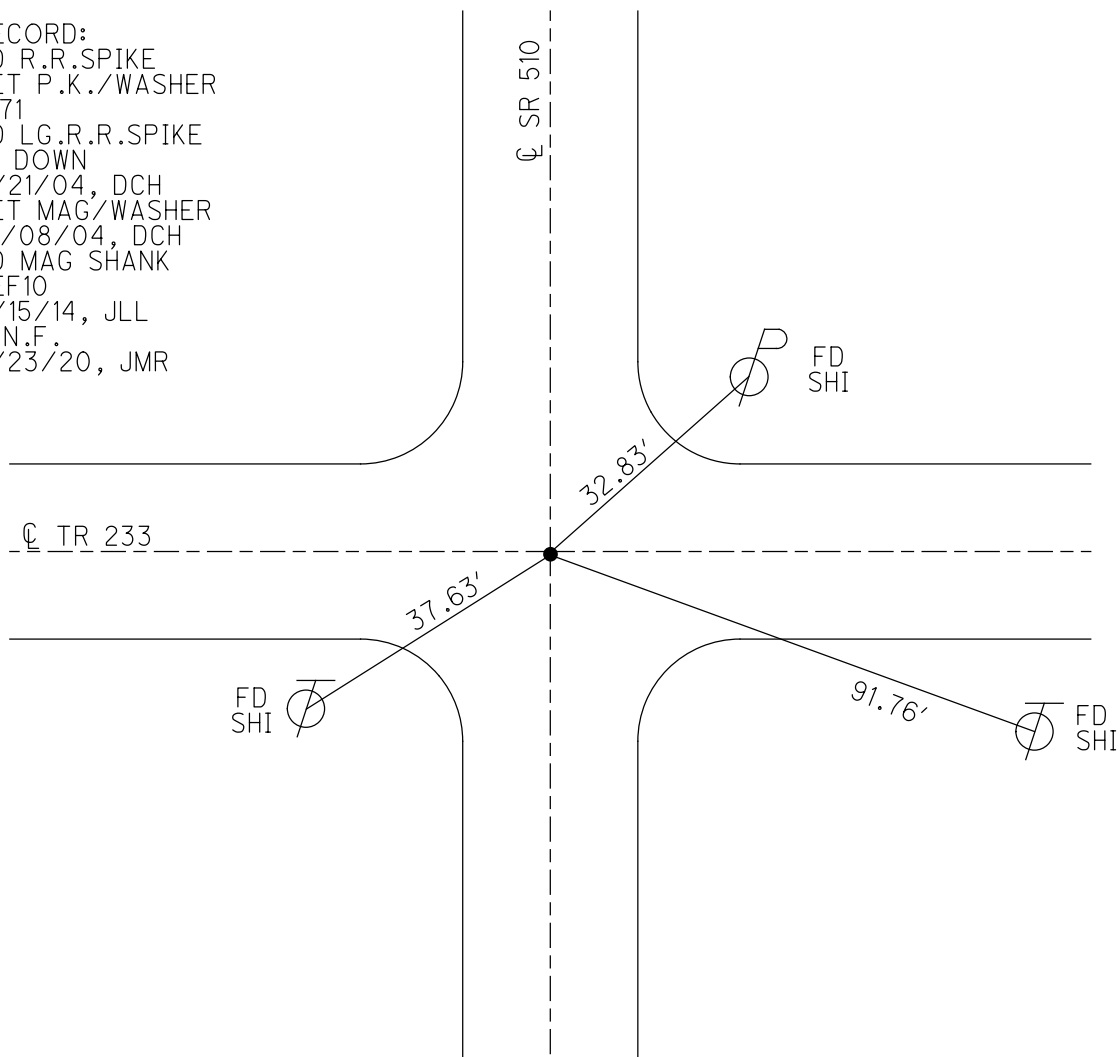

O.D.O.T. DISTRICT 2 SURVEY OFFICE (USE ONLY)

PERSONNEL

REFERENCE NO. 10

SHEET 11 OF 17

NOTES HOMAN

DATE 6/21/04

ROUTE SR 510

H.C. HOMAN

WEATHER SUNNY

COUNTY SANDUSKY

R.C. ADKINS

TEMP. 80°

TOWNSHIP RILEY

SECTION 26

DWG BY _____ PID _____

T 5 N R 16 E

TYPE MONUMENT LG.R.R.SPIKE

~~ON SURFACE~~ - BELOW 3"


OFFSET $\oslash$ PAVEMENT ON _____ LT : RT

- TO - EDGE PAVEMENT


STATION: 185+95

HORIZ.DATUM: _____ GEOID: _____

GRID: NORTHING: _____ EASTING: _____

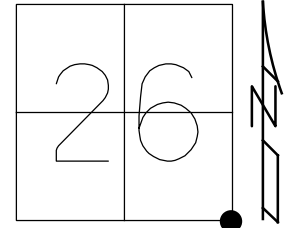

RECORD:
FD R.R.SPIKE
SET P.K./WASHER
1971
SET MAG/WASHER
10/08/04, DCH

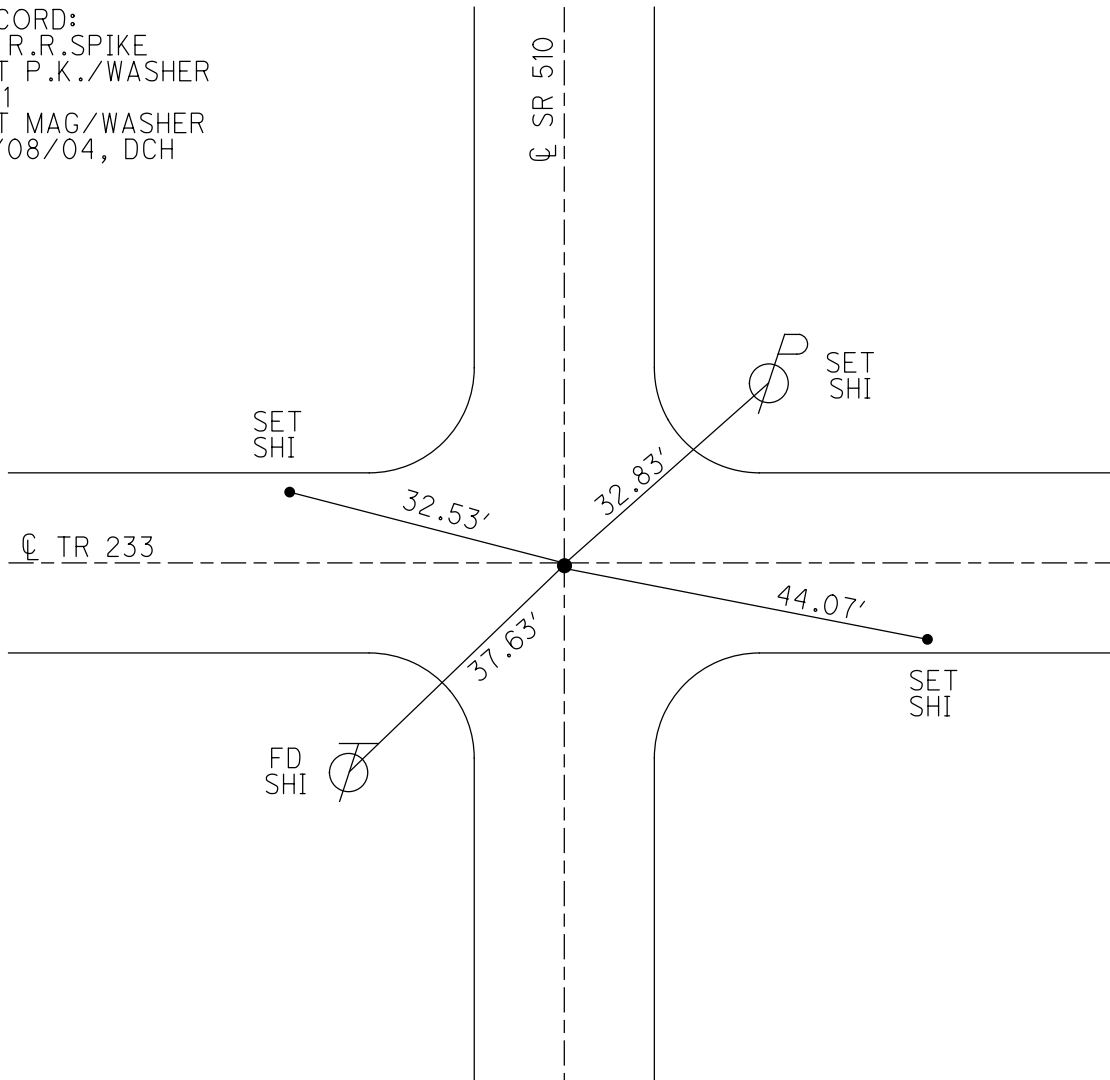

O.D.O.T. DISTRICT 2 SURVEY OFFICE

PERSONNEL

REFERENCE NO. 10

SHEET 11 OF 17

NOTES HOMAN

DATE 6-21-04

ROUTE SR 510

H.C. HOMAN

WEATHER SUNNY

COUNTY SANDUSKY

R.C. ADKINS

TEMP. +80°

TOWNSHIP RILEY

SECTION 25-26-35-36

T 5 N R 16 E

TYPE MONUMENT LG RR SPK

~~ON~~ SURFACE - BELOW 3"

~~LEFT~~ - Q PAV'T - ~~RIGHT~~


TO EDGE PAVEMENT

S.L.M. 185+95

26	25
35	36



RESET MAG NAIL
10-8-04
DCH

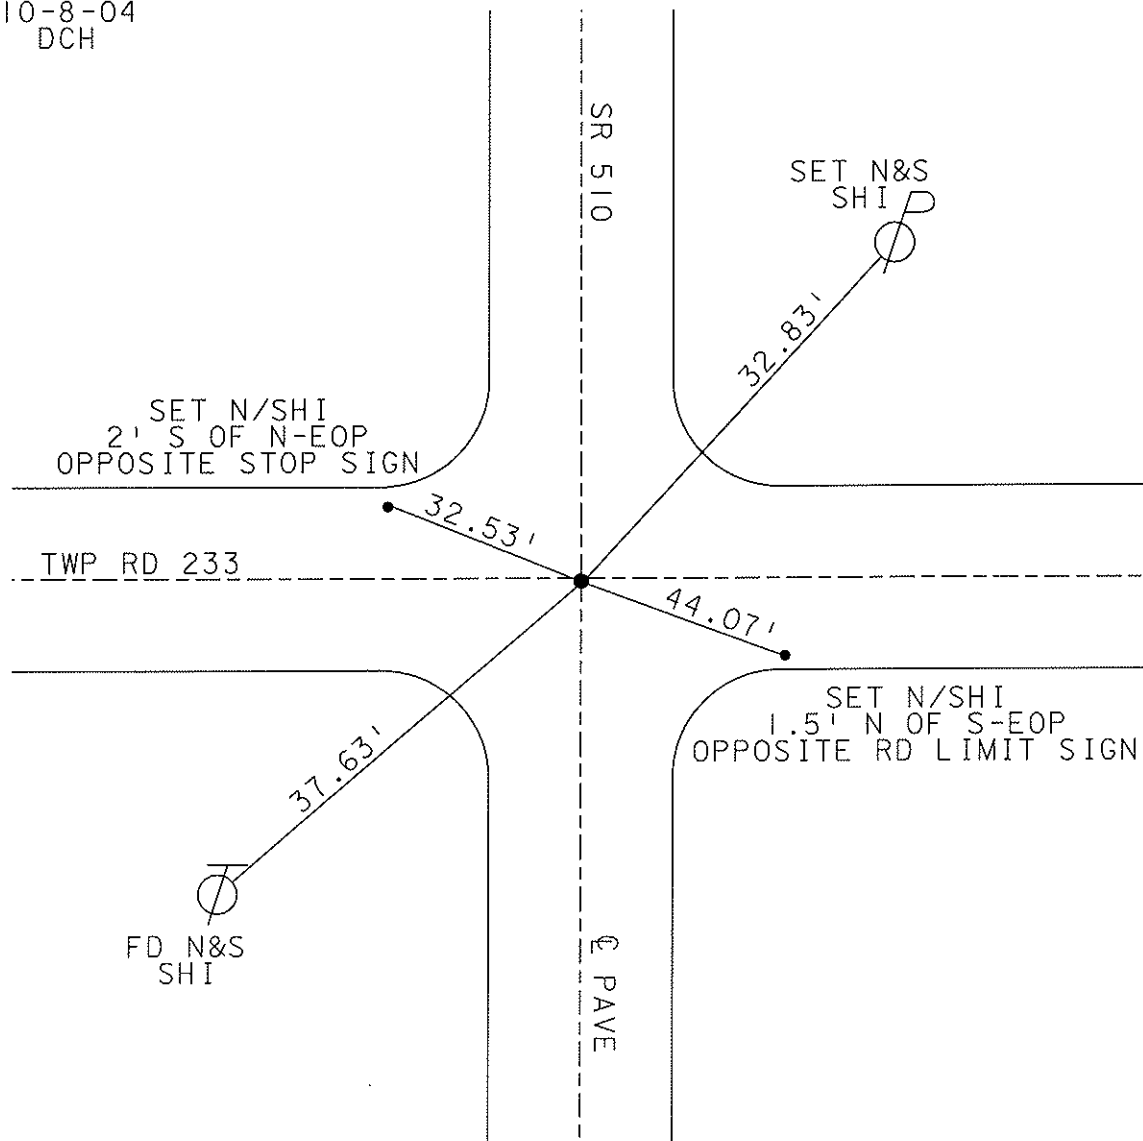

O.D.O.T. DISTRICT 2 SURVEY OFFICE

PERSONNEL

REFERENCE NO. 10

SHEET 9 OF 15

NOTES RIPPLE

H.C. BARBOUR

R.C. GEYMAN

DATE 8/15/90

WEATHER SUNNY

TEMP. 65°

ROUTE SR #510

COUNTY SANDUSKY

TOWNSHIP RILEY

SECTION 25, 26, 35, & 36

T 5 N R 16 E

TYPE MONUMENT SET PK. & WASHER

ON SURFACE - BELOW ATOP PK. & WASHER ATOP RR. SPIKE

LEFT - CL PAV'T. - RIGHT CL


TO EDGE PAVEMENT

S.L.M.

26	25
35	36



"X" CUT IN TOP END of
8' CONC. ELLIPTICAL PIPE

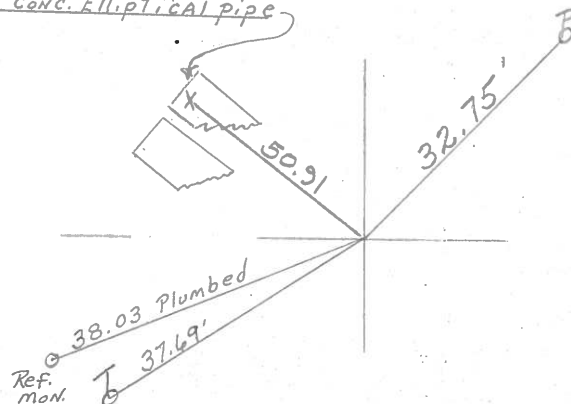

Twp. Rd. # 233

O.D.O.T. DISTRICT 2 SURVEY OFFICE

SHEET

OF

County Sandusky S.R. #510

Date 9/10/82

Township Riley

Weather sunny

Section 25, 26, 35, & 36

Temp. 75°

T5N, R16E

Personnel Cronin

Ripple


Geyman

Mosser

Barbour

#10

26	25
35	36

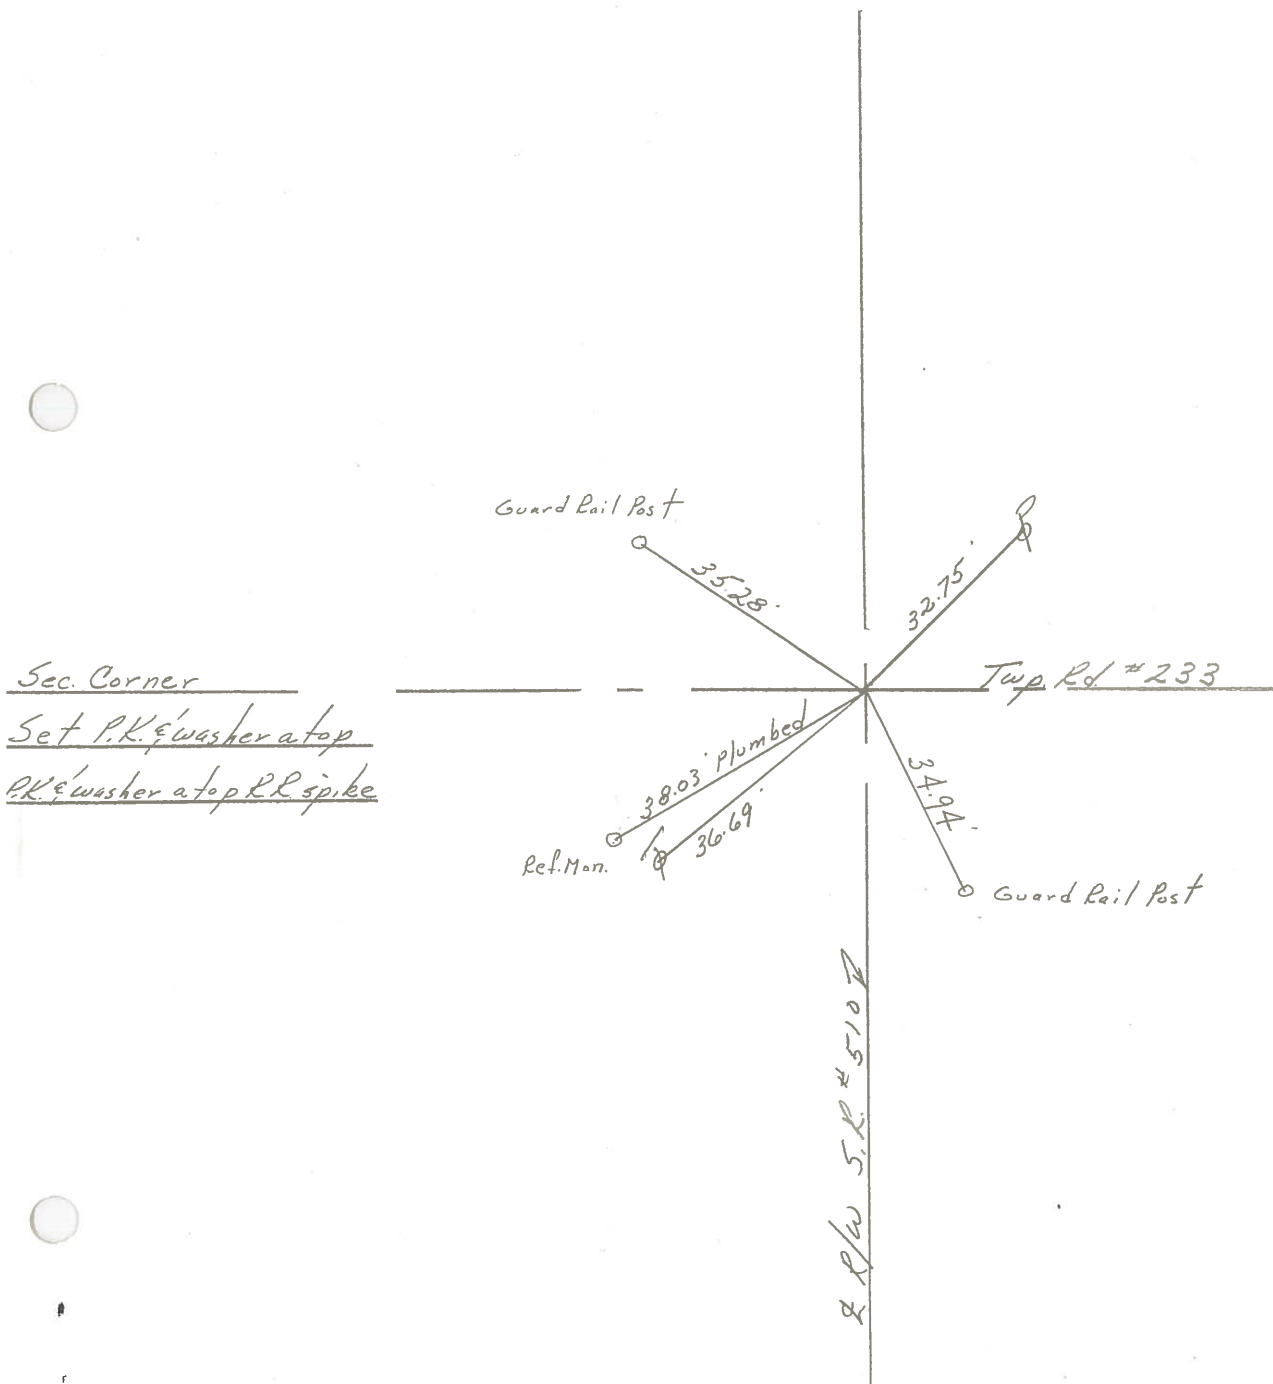

PERSONNEL

TITLE

PERSONNEL

TITLE

COUNTY

Sandusky

DATE

Aug. 1972
4-15-71

S. R.

510

WEATHER

Fair

SEC.

U.S. 20 to US 6

TEMP.

50°

DESCRIPTION

LEFT


CENTER LINE

RIGHT

JOB NO.

(13)

Bolt 1" down
 E of Ohio Turnpike
 Reset small R.R. spk.

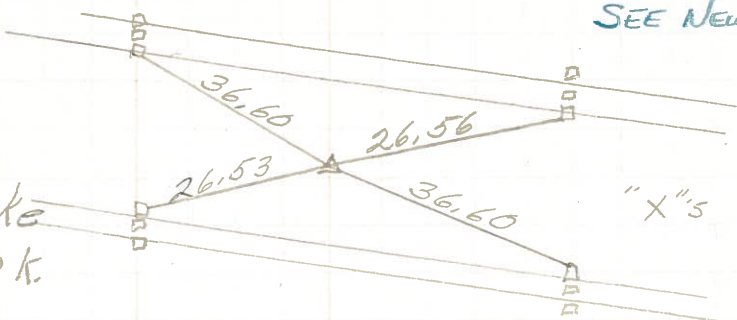

SEE NEW TIES OF 6/10/82

"X"s on Piers


(12)

surf Kap 25" down

3/4" pipe
 2" down

surf Kap
 21" down

S.R. #12

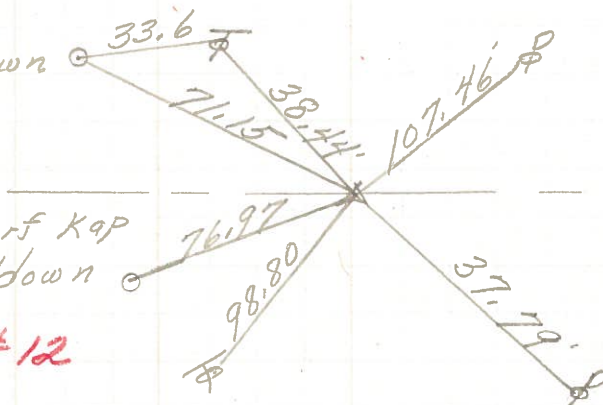


S.R. #12

211+98
 212+33.87

R.R. spk.
 1 1/2" down
 1' Rt. of E
 Reset small spk.

(11)

6" Ash

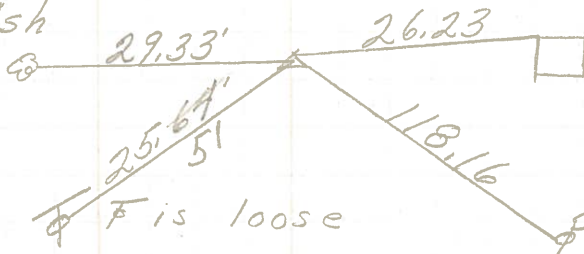


F is loose

SEE NEW TIES OF
9-10-82
conc. post

(10)

Fd. R.R. spk.
 on top
 sq. shiner on
 tie points
 Reset PK Nail

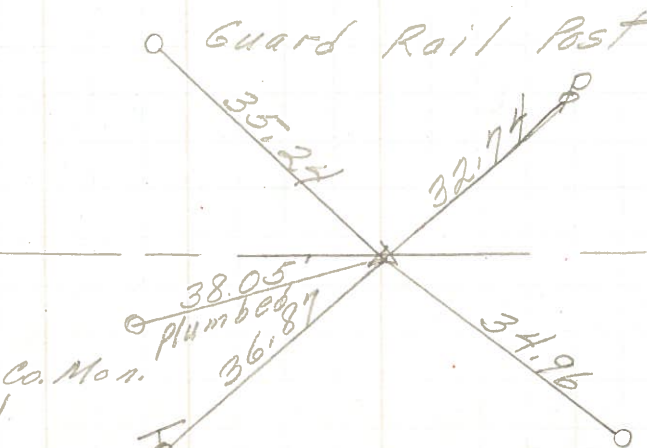

Co. Mon.

Co. Rd. #233

PERSONNEL	TITLE	PERSONNEL	TITLE	COUNTY	DATE	S. R.	WEATHER	TEMP.	DESCRIPTION	JOB NO.
Schneider		Potts		Sandusky	4 2 68	510	F	5	Ties for Control Point	
Mosser										
Barbour										
Redding										

