

O.D.O.T. DISTRICT 2 SURVEY OFFICE (USE ONLY)

PERSONNEL

REFERENCE NO. 11

SHEET 12 OF 18

NOTES GARRETT

DATE 7/23/20

ROUTE SR 510

H.C. RHOADES

WEATHER CLOUDY

COUNTY SANDUSKY

R.C. MAHLER

TEMP. 77°

TOWNSHIP RILEY

SECTION 26

DWG BY RHOADES

PID PAVE TRAIN

T 5 N R 16 E

TYPE MONUMENT MAG SHANK

ON SURFACE - ~~BELOW~~ ON

OFFSET Q PAVEMENT 1.5' ~~LT~~ : RT

7.8' TO RT EDGE PAVEMENT


STATION: 212+53

HORIZ.DATUM: NAD83 2011

GEOID: NAVD88 2012A

GRID: NORTHING: 619074.015

EASTING: 1838443.626

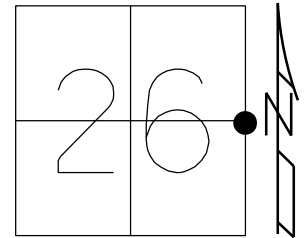

RECORD:

STA. 211+98

FD R.R.SPIKE

1 1/2" DOWN

SET SM.SPIKE

1971

FD P.K./WASHER

6/30/04, DCH

SET MAG/WASHER

9/03/04, DCH

FD MAG SHANK

REF11

9/15/14, JLL


D.N.F.

7/23/20, JMR

FD HOLE W/ COLD PATCH

TONE FROM HOLE

10/3/24, JAM

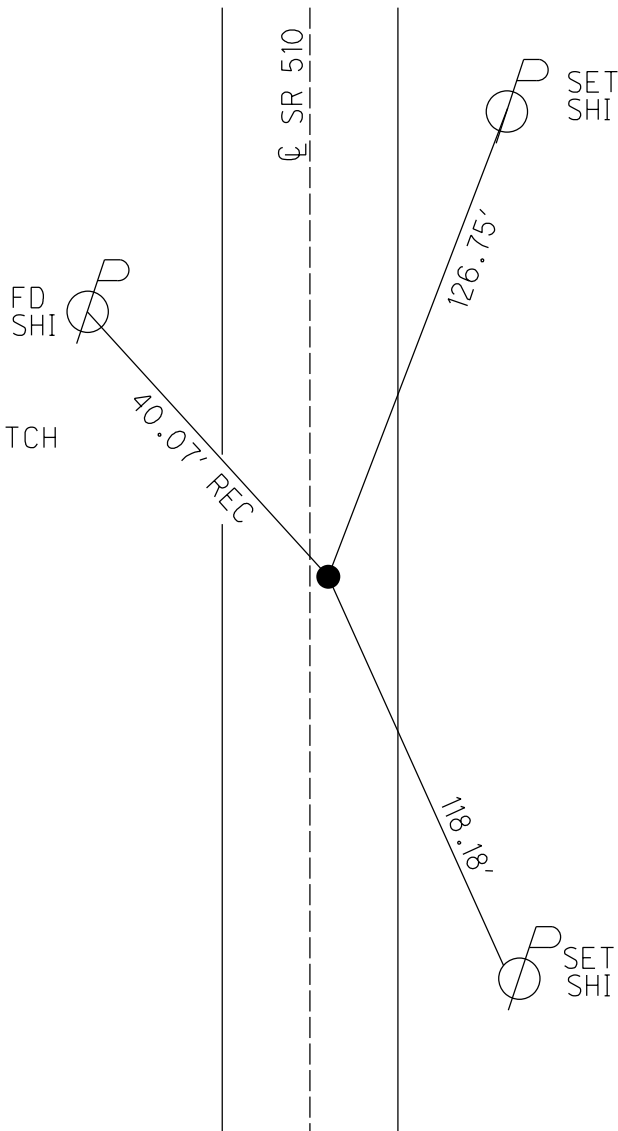

O.D.O.T. DISTRICT 2 SURVEY OFFICE (USE ONLY)

PERSONNEL

REFERENCE NO. 11

SHEET 12 OF 17

NOTES GARRETT

DATE 7/23/20

ROUTE SR 510

H.C. RHOADES

WEATHER CLOUDY

COUNTY SANDUSKY

R.C. MAHLER

TEMP. 77°

TOWNSHIP RILEY

SECTION 26

DWG BY RHOADES

PID PAVE TRAIN

T 5 N R 16 E

TYPE MONUMENT MAG SHANK

ON SURFACE - ~~BELOW~~ ON

OFFSET Q PAVEMENT 1.5' ~~LT~~ : RT

7.8' TO RT EDGE PAVEMENT


STATION: 212+53

HORZ.DATUM: NAD83 2011


GEOID: NAVD88 2012A

GRID: NORTHING: 619074.015

EASTING: 1838443.626

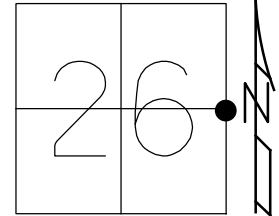

RECORD:
STA. 211+98
FD R.R.SPIKE
1 1/2" DOWN
SET SM.SPIKE
1971
FD P.K./WASHER
6/30/04, DCH
SET MAG/WASHER
9/03/04, DCH
FD MAG SHANK
REF11
9/15/14, JLL
D.N.F.
7/23/20, JMR

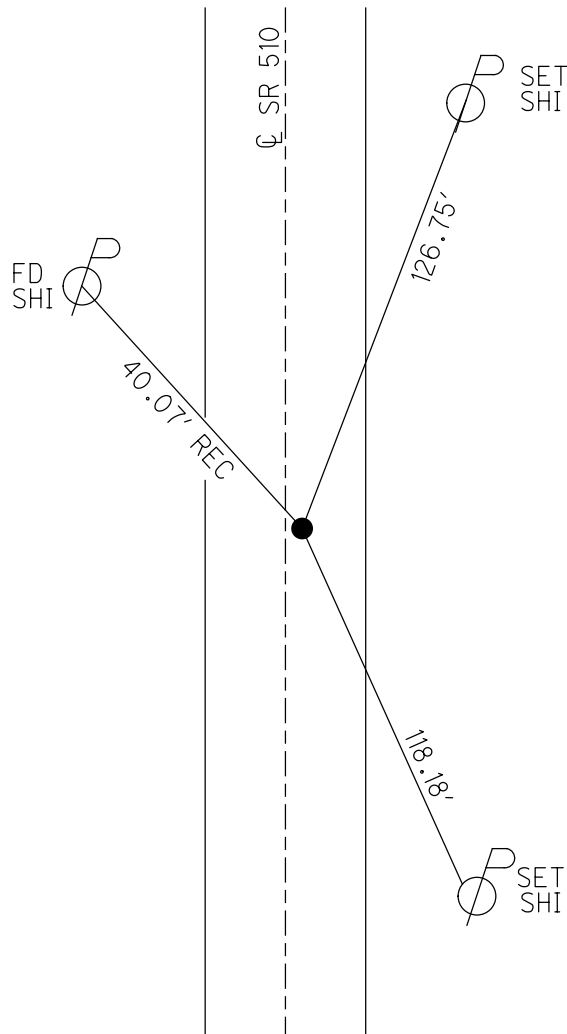

O.D.O.T. DISTRICT 2 SURVEY OFFICE (USE ONLY)

PERSONNEL

REFERENCE NO. 11

SHEET 12 OF 17

NOTES HOMAN

DATE 6/30/04

ROUTE SR 510

H.C. HUSS

WEATHER SUNNY

COUNTY SANDUSKY

R.C. NUHFER

TEMP. 75°

TOWNSHIP RILEY

SECTION 26

DWG BY _____ PID _____

T 5 N R 16 E

TYPE MONUMENT P.K./WASHER

ON SURFACE - ~~BELOW~~ ON

OFFSET CL PAVEMENT 1.5' ~~LT~~ : RT

7.8' TO RT EDGE PAVEMENT


STATION: 212+53

HORIZ.DATUM: _____


GEOID: _____

GRID: NORTHING: _____

EASTING: _____

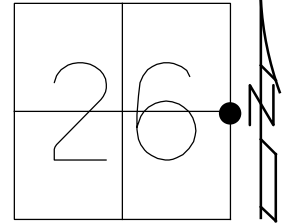

RECORD:
STA. 211+98
FD R.R.SPIKE
1 1/2" DOWN
SET SM.SPIKE
1971
SET MAG/WASHER
9/03/04, DCH

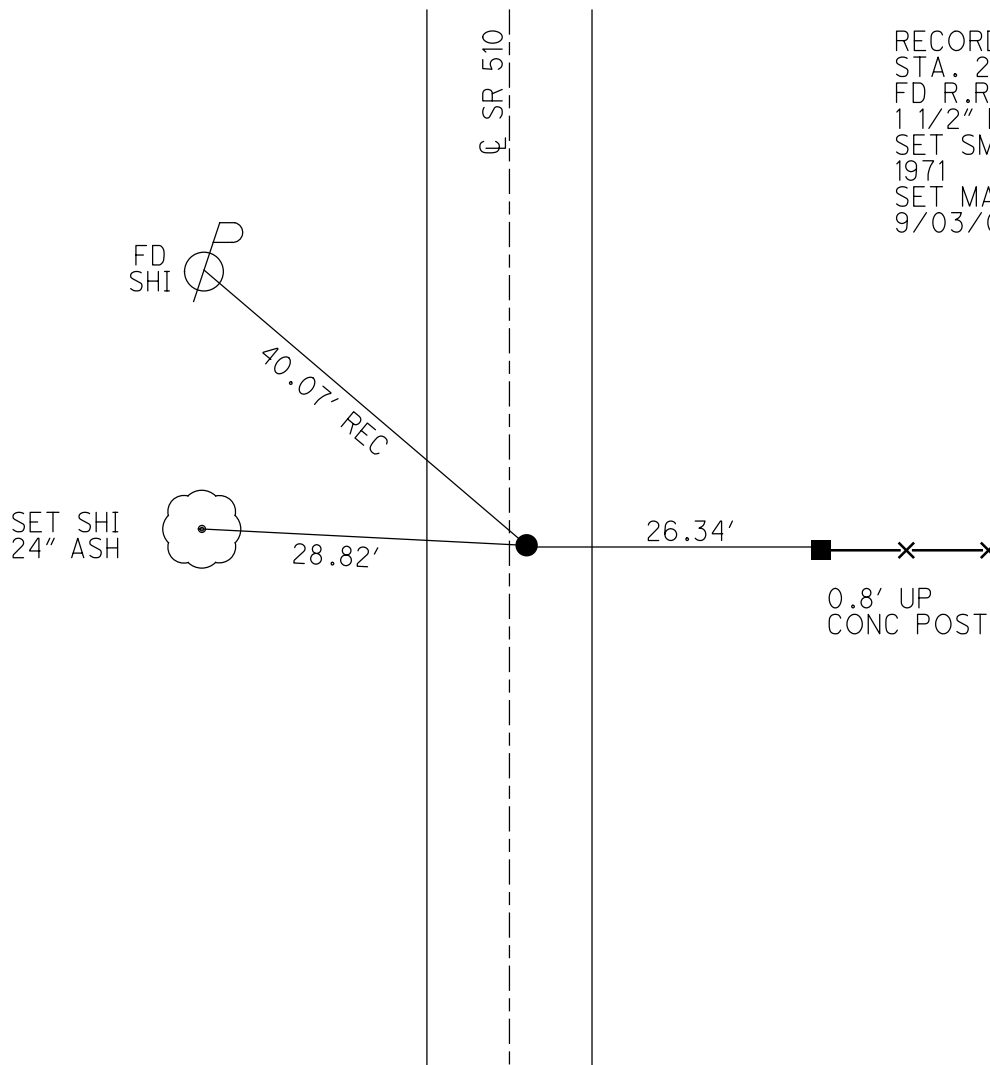

O.D.O.T. DISTRICT 2 SURVEY OFFICE

PERSONNEL

REFERENCE NO. 11

SHEET 12 OF 17

NOTES HOMAN

DATE 6-30-04

ROUTE SR 510

H.C. HUSS

WEATHER SUNNY

COUNTY SANDUSKY

R.C. NUHFER

TEMP. +75°

TOWNSHIP RILEY

SECTION 25 & 26

T 5 N R 16 E


TYPE MONUMENT P.K. & WASHER

ON SURFACE - ~~BELOW~~ ON


~~LEFT~~ - Q PAV'T - RIGHT 1.5'

7.8' TO RT EDGE PAVEMENT

S.L.M. 212+53

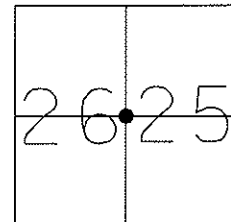

SET MAG NAIL
9-3-04
DCH

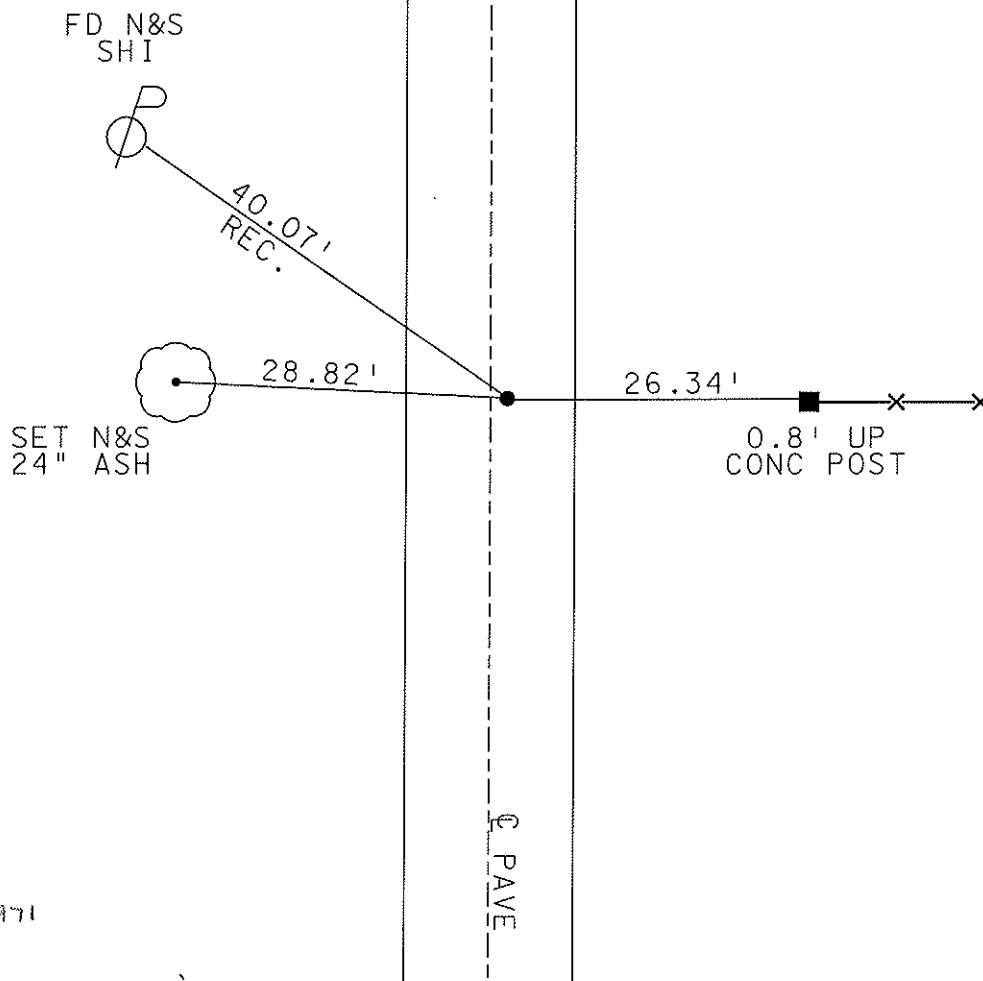

RECORD 1971

211+98

MINE SPIKE - R.L. SPIKE

O.D.O.T. DISTRICT 2 SURVEY OFFICE

PERSONNEL

REFERENCE NO. 11

SHEET 10 OF 15

NOTES RIPPLE

H.C. BARBOUR

R.C. GEYMAN

DATE 8/15/90

WEATHER SUNNY

TEMP. 65°

ROUTE SR. # 510

COUNTY SANDUSKY

TOWNSHIP Riley

SECTION 25 & 26

T. 5 N R. 16 E


TYPE MONUMENT Set P.K. Washer

ON SURFACE - BELOW Top mine spike & Top R.R. Spike


LEFT - CL PAV'T. - RIGHT 1.5' ± RT. CL PAVMT.

TO EDGE PAVEMENT

S.L.M. _____

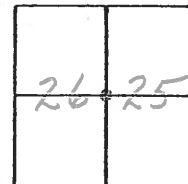

211+98

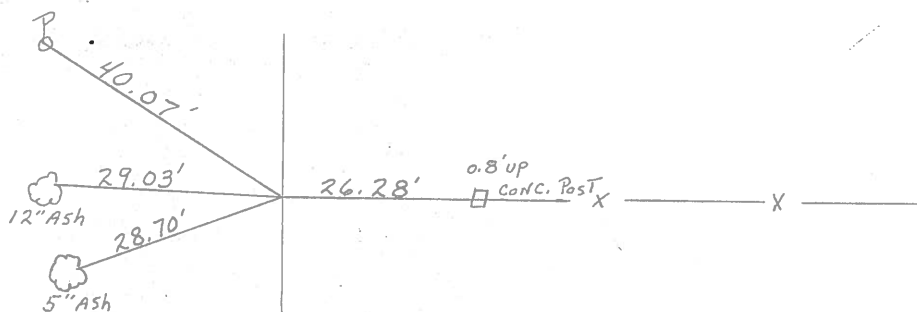

CL R/W SR # 510

QD.O.T. DISTRICT 2 SURVEY OFFICE

Sht. 10 of

County Sandusky S.R. #510

Township Riley

Section 25, E 26

T 5 N, R 6 E

Personnel Cronin

Ripple

Geyman

Mosser


Barbour

#11

Date 9/10/82

Weather sunny

Temp. 75°

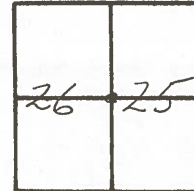


211+98

set P.K. & washer at top mine

spike at top R.R. spike

1.5 ± R.R. & Permit.

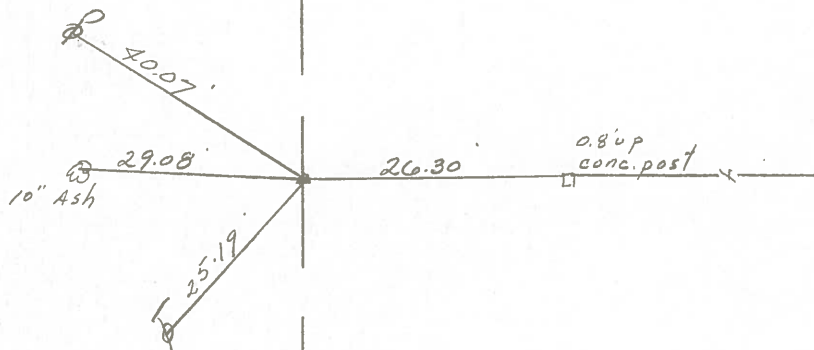


E R/W S.R. #510

PERSONNEL TITLE PERSONNEL TITLE

COUNTY Sandusky DATE Aug. 1972
4-15-71S. R. 510 WEATHER FairSEC. U.S. 20 to U.S. 6 TEMP. 50°

DESCRIPTION LEFT CENTER LINE RIGHT JOB NO.

(13)

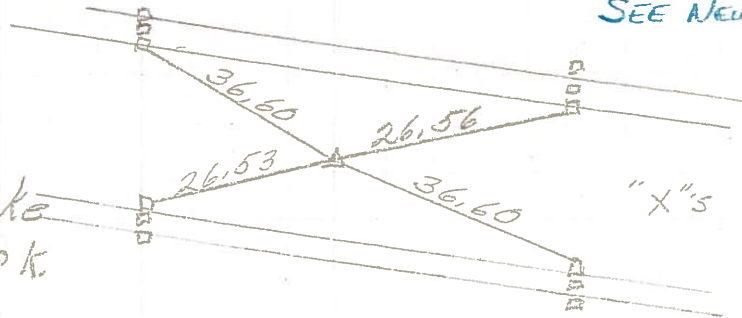
Bolt 1" down
E of Ohio Turnpike
Reset small R.R. spk.

SEE NEW TIES OF 6/10/82

"X"s on Piers

(12)

Surf Kap 25" down

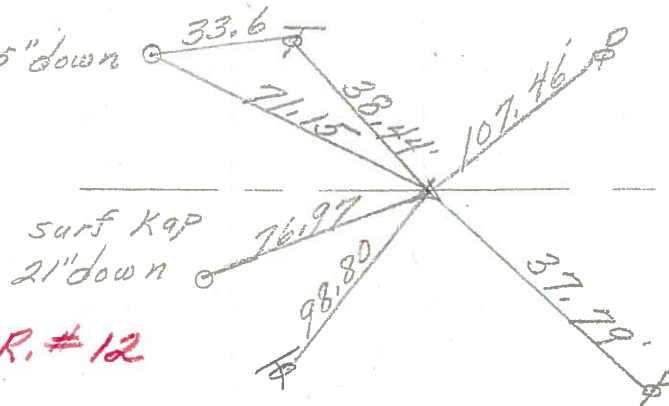3/4" pipe
2" down

S.R. #12

S.R. #12

211+98
212+33.87

R.R. spk.


1 1/2" down

1' Rt. of E

Reset small spk.

(11)

6" Ash

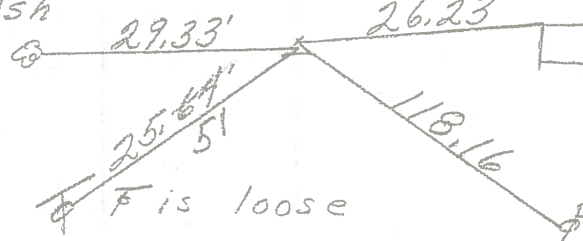

F is loose

SEE NEW TIES OF
9-10-87
conc. post


(10)

Fd. R.R. spk.

on top

sq. shiner on
tie points

Reset pk. Nail

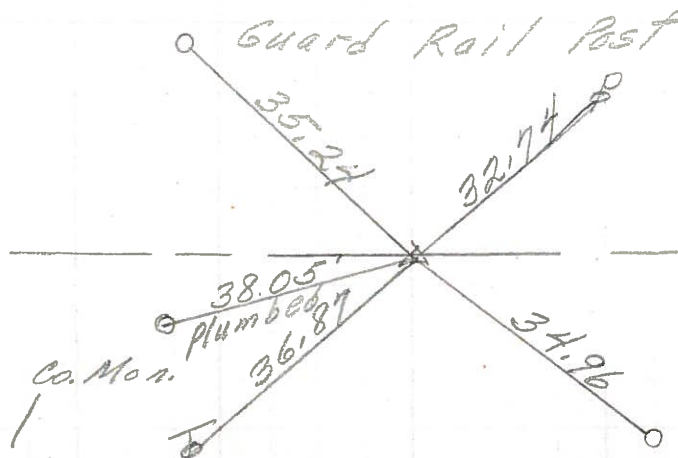

Co. Rd. #233

Guard Rail Post

PERSONNEL	TITLE	PERSONNEL	TITLE	COUNTY	DATE	WEATHER	TEMP.
Schneider		Potts		Sandusky	4-22-68	Fair	65°
Mosser				S. R.	510		
Barbour				SEC.	U.S. #20 to U.S. #6		
Redding							

DESCRIPTION Ties for Control Points JOB NO. _____

