

O.D.O.T. DISTRICT 2 SURVEY OFFICE (USE ONLY)

PERSONNEL

REFERENCE NO. 12

SHEET 13 OF 17

NOTES PRESTON-COLVIN

DATE 9/3/24

ROUTE SR 510

H.C. NEISE

WEATHER SUNNY

COUNTY SANDUSKY

R.C. PRESTON-COLVIN

TEMP. 60°

TOWNSHIP RILEY

SECTION 26

DWG BY PRESTON-COLVIN PID PAVING TRAIN

T 5 N R 16 E

TYPE MONUMENT MAG/WASHER

ON SURFACE - ~~BELOW~~ ON

OFFSET ϕ PAVEMENT 2.5' ~~LT~~ : RT

10.0' TO LT EDGE PAVEMENT

STATION: 227+81

HORIZ.DATUM: NAD83 (2011)


GEOID: 18

GRID: NORTHING: 620593.287

EASTING: 183847.137


LDP: NORTHING: 316847.6

EASTING: 198704.7

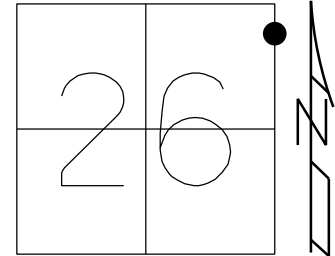

RECORD:
FD P.K./WASHER
ATOP IPIPE
SET P.K./WASHER
8-31-01, SAH
FD MAG/WASHER
2" DOWN
6/23/15
11/29/16, DCH
SET MAG/WASHER
8-21-2019, JFO
FD MAG/WASHER
REF A11
7/23/20, JMR
3/10/21, JMR
FD MAG/WASHER
REF 12
9/3/24, TDN
FD MAG/WASHER
10/3/24, JAM

NOTE: SR 412 REF 11

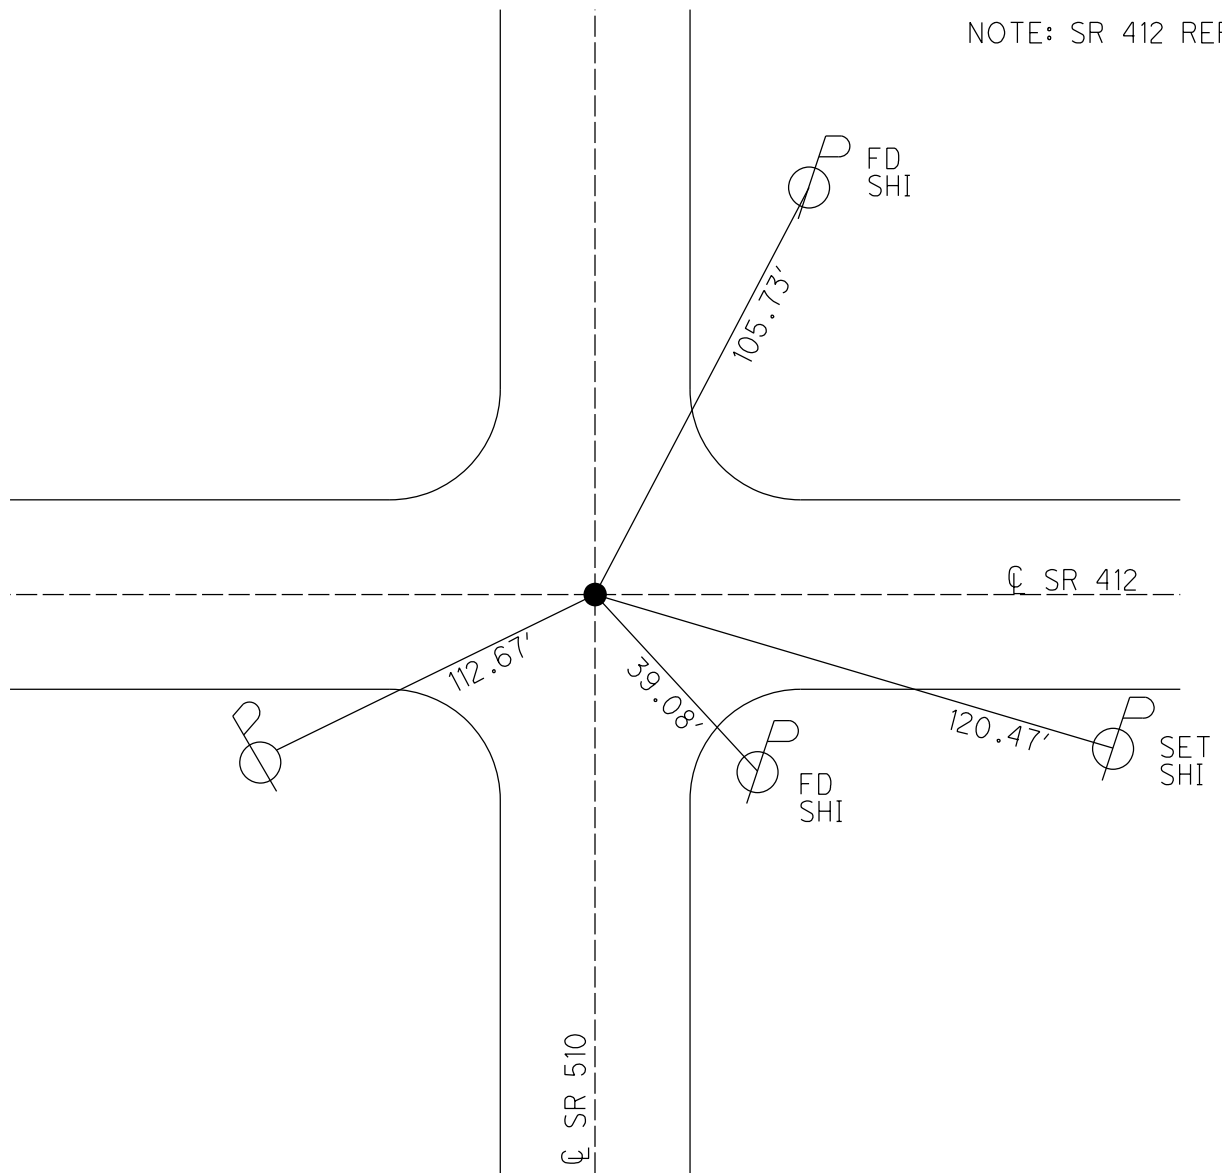

O.D.O.T. DISTRICT 2 SURVEY OFFICE (USE ONLY)

PERSONNEL

REFERENCE NO. 12

SHEET 13 OF 17

NOTES GARRETT

DATE 7/23/20

ROUTE SR 510

H.C. RHOADES

WEATHER CLOUDY

COUNTY SANDUSKY

R.C. MAHLER

TEMP. 77°

TOWNSHIP RILEY

SECTION 26

DWG BY RHOADES

PID PAVE TRAIN

T 5 N R 16 E

TYPE MONUMENT MAG/WASHER

ON SURFACE - ~~BELOW~~ ON

OFFSET CL PAVEMENT 2.5' LT : RT

10.0' TO LT EDGE PAVEMENT


STATION: 227+81

HORIZ.DATUM: NAD83 2011

GEOID: NAVD88 2012A


GRID: NORTHING: 620593.287

EASTING: 1838476.137

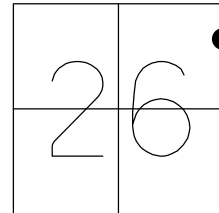

RECORD:
FD P.K./WASHER
ATOP IPIPE
SET P.K./WASHER
8-31-01, SAH
FD MAG/WASHER
2" DOWN
6/23/15
11/29/16, DCH
SET MAG/WASHER
8-21-2019, JFO
FD MAG/WASHER
REFA11
7/23/20, JMR
3/10/21, JMR

NOTE: SR 412 REF 11

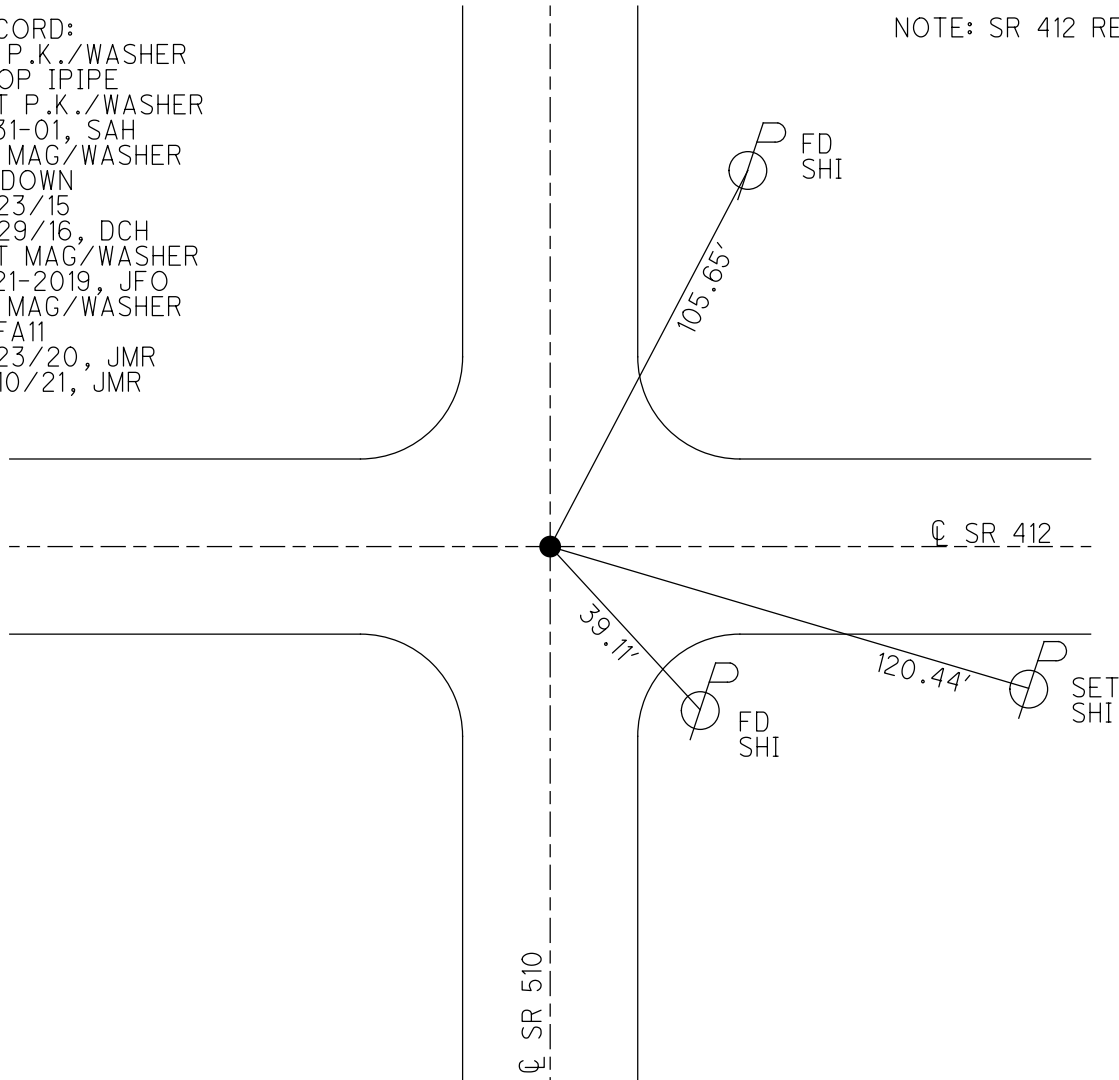

O.D.O.T. DISTRICT 2 SURVEY OFFICE (USE ONLY)

PERSONNEL

REFERENCE NO. 11

SHEET 13 OF 17

NOTES AUBLE

DATE 5/1/18

ROUTE SR 510

H.C. LEU

WEATHER SUNNY, BREEZY

COUNTY SANDUSKY

R.C. AUBLE

TEMP. 67°

TOWNSHIP RILEY

SECTION 26

DWG BY NIESE

PID 95765

T 5 N R 16 E

TYPE MONUMENT MAG/WASHER

ON SURFACE - ~~BELOW~~ ON

OFFSET CL PAVEMENT 2.5' LT : RT

10.0' TO LT EDGE PAVEMENT


STATION: 227+81

HORZ.DATUM: NAD83(2011)

GEOID: 2012A

GRID: NORTHING: 620593.326

EASTING: 1838476.101

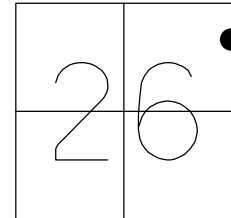


RECORD:
FD P.K./WASHER
ATOP IPIPE
NOT ON SEC.LINE
SET P.K./WASHER
8-31-01, SAH
FD MAG/WASHER
2" DOWN
REF11
6/23/15
11/29/16, DCH
SET MAG/WASHER
REF11
8-21-2019, JFO

FD NOTCH
STEEL POST
CTVM

FD
SHI

NOTE: SR 412 REF 11

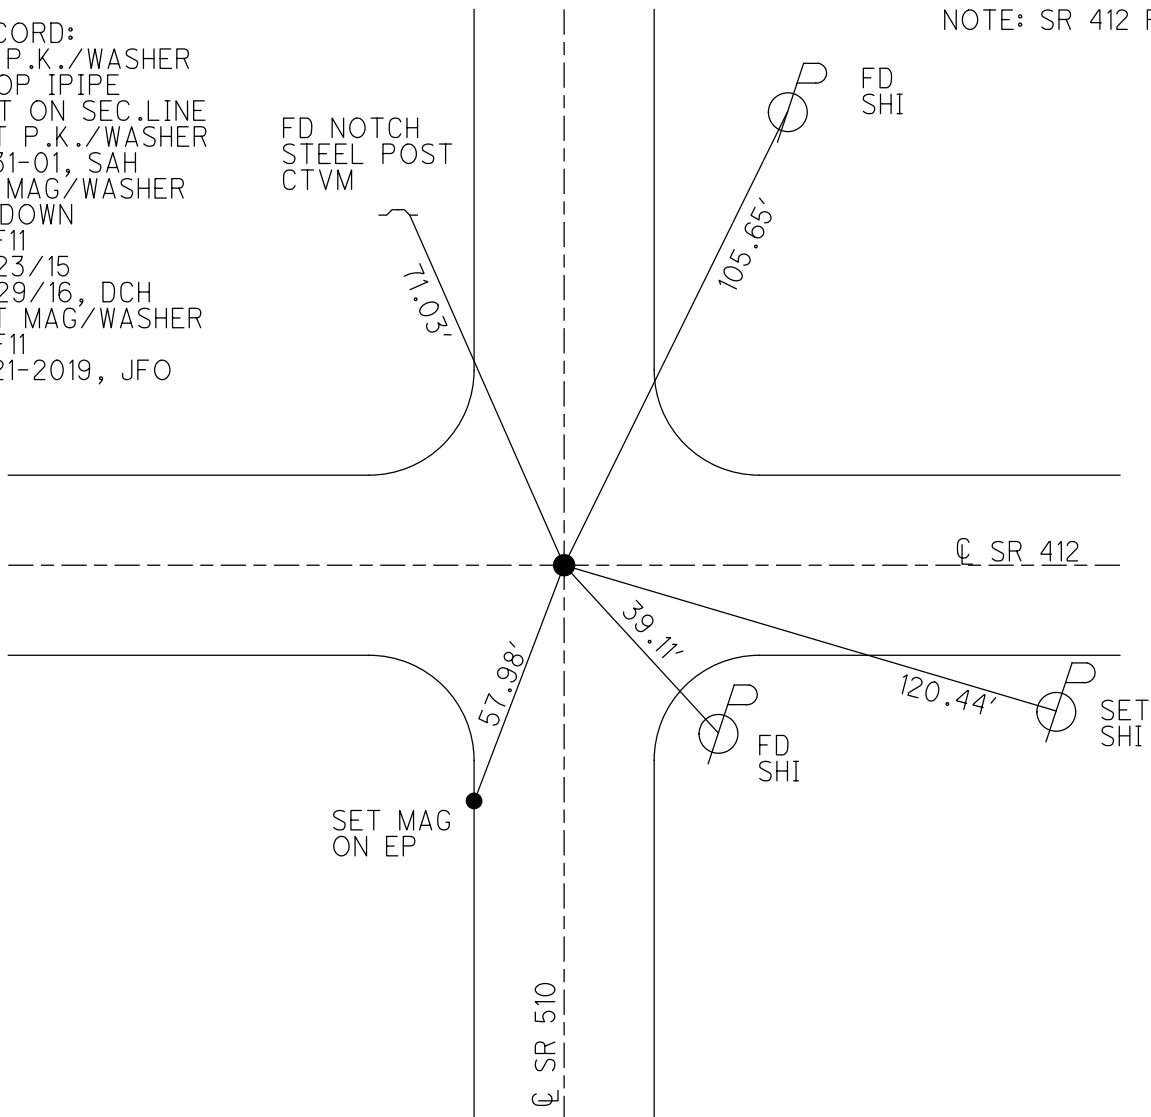

O.D.O.T. DISTRICT 2 SURVEY OFFICE (USE ONLY)

PERSONNEL

REFERENCE NO. 12

SHEET 13 OF 17

NOTES HOMAN

DATE 6/30/04

ROUTE SR 510

H.C. HUSS

WEATHER SUNNY

COUNTY SANDUSKY

R.C. NUHFER

TEMP. 80°

TOWNSHIP RILEY

SECTION 26

T 5 N R 16 E

TYPE MONUMENT P.K./WASHER


ON SURFACE - ~~BELOW~~ ON

LEFT - ℄ PAV'T - ~~RIGHT~~ 4', ON ℄ SR 412

10.0' TO LT EDGE PAVEMENT

S.L.M. 227+81

Grid: Northing: 620596.154 Easting: 1838476.089

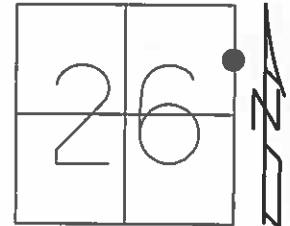

RECORD:
P.K./WASHER
ATOP IPIPE
(NOT ON SEC LINE)

SET P.K./WASHER
8/31/01, SAH

FD P.K.SHANK
REF27
12/11/12, JMR

NOTE: REF 11, SR 412
STA. 300+89.56

CUT "+" E/COR
TRAFFIC SIG BOX

37.56'

49.00'

CUT NOTCH
W/SIDE STOP
SIGN POST


℄ SR 412

47.72'

CUT NOTCH
E/LEG STOP
SIGN POST

40.96'

FD
SHI

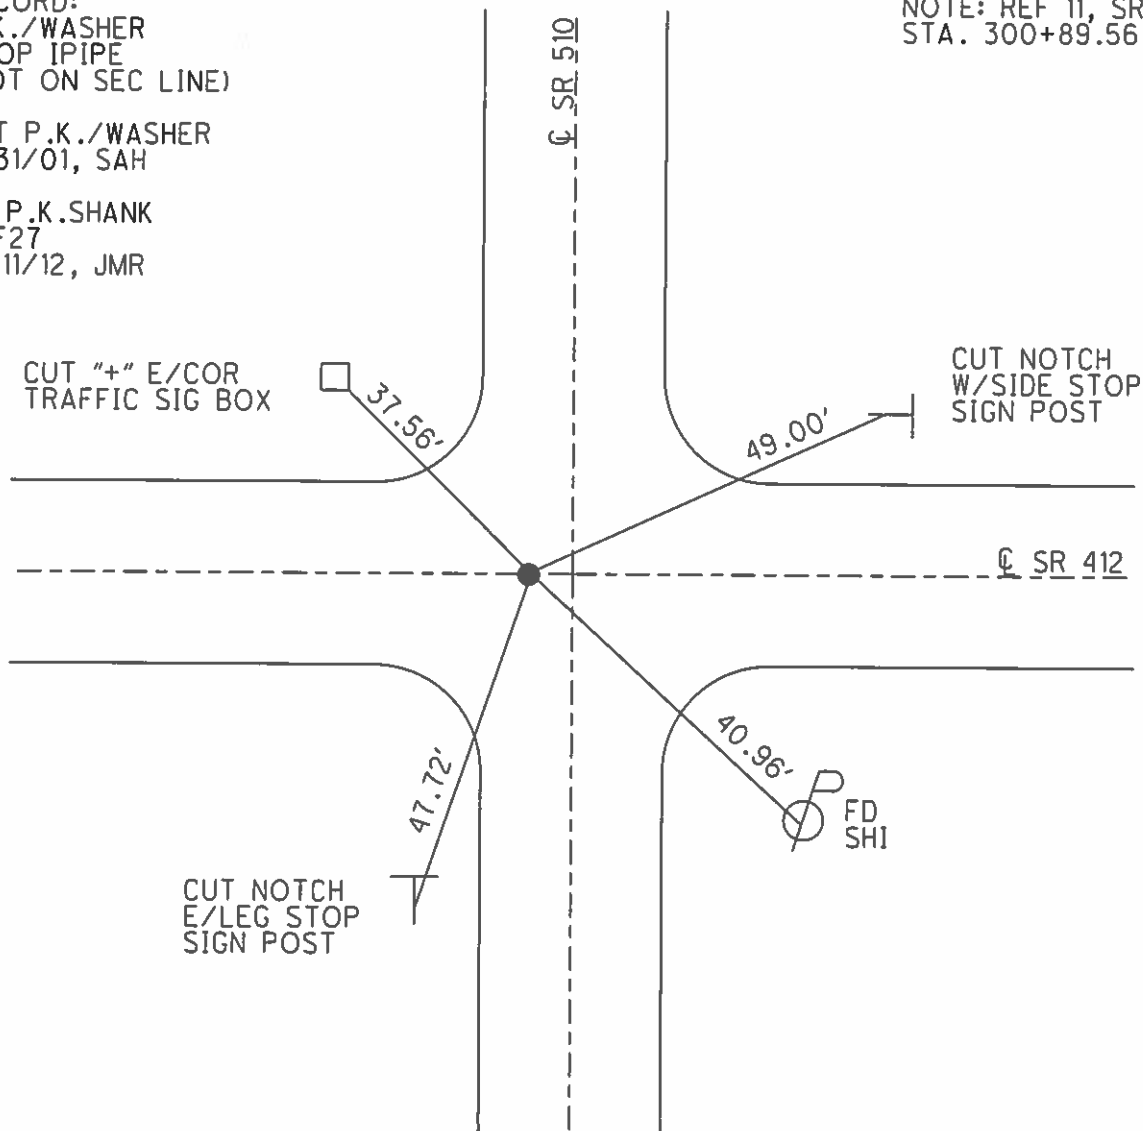

O.D.O.T. DISTRICT 2 SURVEY OFFICE

PERSONNEL

REFERENCE NO. 12

SHEET 13 OF 17

NOTES HOMAN

DATE 6-30-04

ROUTE SR 510

H.C. HUSS

WEATHER SUNNY

COUNTY SANDUSKY

R.C. NUHFER

TEMP. +80°

TOWNSHIP RILEY

SECTION 25 & 26

T 5 N R 16 E


TYPE MONUMENT P.K. & WASHER

ON SURFACE ~~-BELOW-~~ ON

LEFT - Q PAV'T - ~~RIGHT~~ 4'

TO EDGE PAVEMENT

S.L.M. 227+81

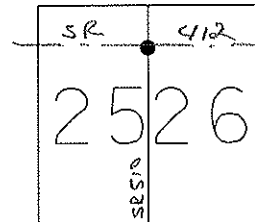

REC:

P.K./WASHER ATOP I. PIPE
NOT ON SECTION LINE

SET P.K./WASHER
8-31-01
SAH

Note

SR 412 = Ref # 11

Sta = 300+16

CUT "x"
EAST CORNER
TRAFFIC SIGNAL BOX

37.56'

CUT NOTCH
WEST SIDE
STOP SIGN POST

49.00'

Q PAVE

SR 412

47.72'

CUT NOTCH
EAST LEG
STOP SIGN POST

40.96'

FD
N&S

Q PAVE

O.D.O.T. DISTRICT 2 SURVEY OFFICE

PERSONNEL

REFERENCE NO. ~~11~~

12052530

SHEET ____ OF ____

NOTED Revised

H.C. VAN DUSEN

R.C. ADAM B.

DATE 7-5-01

WEATHER SUNNY

TEMP. +75°F

ROUTE 412

COUNTY SANDUSKY

TOWNSHIP RILEY

SECTION 25 or 26?

T5 N R 16 E


TYPE MONUMENT PK & WASHER

ON SURFACE - BELOW 2"

10.0' TO LT. EDGE PAVEMENT

S.L.M. 300 + 16

12

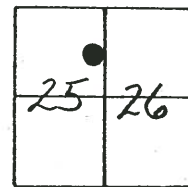

REC!
PK & WASHER
ATOP I. PIPE -
NOT ON SECTION LINE

STEEL POST FOR
UNDERGROUND
CABLE MARKER
NOTCH 1.0' UP
OUTSIDE E. LEG
OF 2 POST STOP SIGN

SET PK/WASHER
8-31-01
J.A.H.

PAVEMENT

SR 412

NOTCH 1.5' UP
TEL. CABLE MARKER
SIGN

SET PK

SET NAIL & SH!

SR 5102

SHEET NO. 1

Aug. 1972

PERSONNEL	TITLE	PERSONNEL	TITLE
1	2	3	4
5	6	7	8
9	10	11	12
13	14	15	16
17	18	19	20
21	22	23	24
25	26	27	28
29	30	31	32
33	34	35	36
37	38	39	40
41	42	43	44
45	46	47	48
49	50	51	52
53	54	55	56
57	58	59	60
61	62	63	64
65	66	67	68
69	70	71	72
73	74	75	76
77	78	79	80
81	82	83	84
85	86	87	88
89	90	91	92
93	94	95	96
97	98	99	100

COUNTY SANDUSKY DATE 4-15-71

S. R. 510 WEATHER Fair


SEC. U.S. 20 to 456 TEMP. 50°

[illegible]

SEE NEW TIES OF 6/10/82

13

Bolt 1" down
 E of Ohio Turnpike
 Reset small R.R. spk

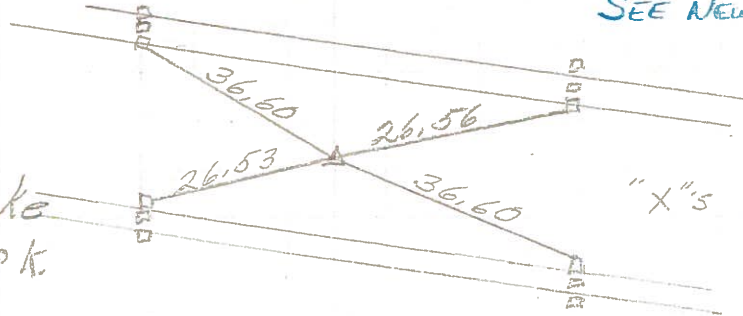


12

(12) surf Kap 25" down

3 1/2" pipe
2' down

surf K9P
21" down

S.R. # 12

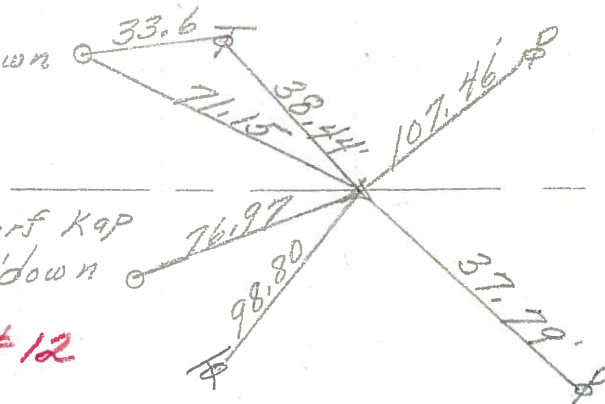
$$\begin{array}{r} 211 + 98 \\ \hline 212 + 33.87 \end{array}$$

R.R. Spk.
1 1/2" down
1' Pt. of $\pm$
Reset sma

11

6" Ash

52 29.33'

26.23

$$\begin{array}{r} 25.67 \\ \hline 5 \end{array}$$

$\mathbb{F}$ is loose


SEE NEW TIES OF
9-10-87
conc- Post

10

Fd. R.R. spk.
on top
sq. shiner on
the points
Reset pk. Na. /

Co. Mon

Co. Rd. #233

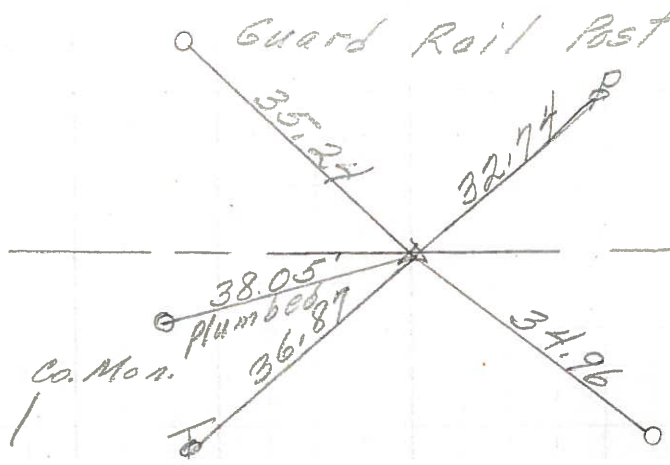

Guard Rail Post

PERSONNEL	TITLE	PERSONNEL	TITLE	COUNTY	DATE	WEATHER	TEMP.
Schneider		Potts		Sandusky	4-22-68	Fair	65°
Mosser				S. R.	510		
Barbour				SEC.	U.S. #20 to U.S. #6		
Redding							
DESCRIPTION				Ties for Control Points		JOB NO.	

LEFT

CENTER LINE

RIGHT

