

O.D.O.T. DISTRICT 2 SURVEY OFFICE (USE ONLY)

PERSONNEL

REFERENCE NO. 13

SHEET 14 OF 17

NOTES PRESTON-COLVIN

DATE 9/3/24

ROUTE SR 510

H.C. NEISE

WEATHER SUNNY

COUNTY SANDUSKY

R.C. PRESTON-COLVIN

TEMP. 60°

TOWNSHIP RILEY

SECTION 23

DWG BY PRESTON-COLVIN

PID PAVING TRAIN

T 5 N R 16 E

TYPE MONUMENT MAG/SHANK

ON SURFACE - ~~BELOW~~ ON

OFFSET Q PAVEMENT 0.6" ~~LT~~ : RT

8.5' TO LT EDGE PAVEMENT

STATION: 240+13

HORIZ.DATUM: NAD83 (2011)


GEOID: 18

GRID: NORTHING:

EASTING:


LDP: NORTHING:

EASTING:

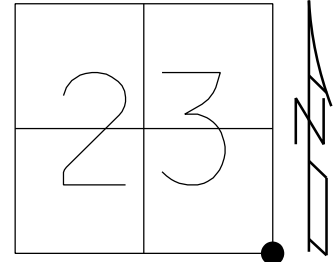

RECORD:
FD BOLT
1" DOWN
SET SM.R.R.SPIKE
1971
FD P.K./WASHER
6/30/04, DCH
SET MAG NAIL
10/08/04, DCH
D.N.F.
7/23/20
3/10/21, JMR
SET MAG/WASHER
7/20/22, JMR
FD MAG/SHANK
9/3/24, TDN
FD MAG SHANK
10/3/24, JAM

POINT UNDER BRIDGE
NO GPS

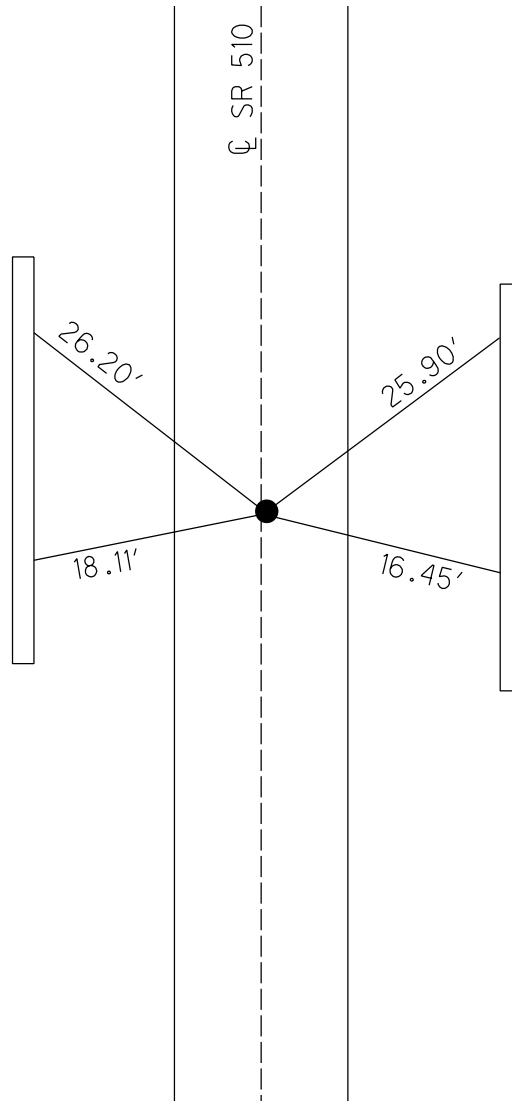

CUT "X"s ON
BARRIER WALL
UNDER TURNPIKE
OPPOSITE PIERS

O.D.O.T. DISTRICT 2 SURVEY OFFICE (USE ONLY)

PERSONNEL

REFERENCE NO. 13

SHEET 14 OF 18

NOTES RHOADES

DATE 7/20/22

ROUTE SR 510

H.C. RHOADES

WEATHER HUMID

COUNTY SANDUSKY

R.C. WHITAKER

TEMP. 84°

TOWNSHIP RILEY

DWG BY WHITAKER PID PVTRN

SECTION 23

T 5 N R 16 E

TYPE MONUMENT MAG/WASHER

ON SURFACE - ~~BELOW~~ ON

OFFSET Q PAVEMENT 1' ~~LT~~ : RT

8.5' TO RT EDGE PAVEMENT


STATION: 240+13

HORZ.DATUM: _____

GEOID: _____


GRID: NORTHING: _____

EASTING: _____

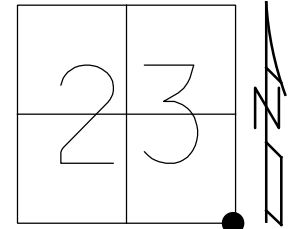

RECORD:
FD BOLT
1" DOWN
SET SM.R.R.SPIKE
1971
FD P.K./WASHER
6/30/04, DCH
SET MAG NAIL
10/08/04, DCH
D.N.F.
7/23/20
3/10/21, JMR
SET MAG/WASHER
7/20/22, JMR

POINT UNDER BRIDGE
NO GPS

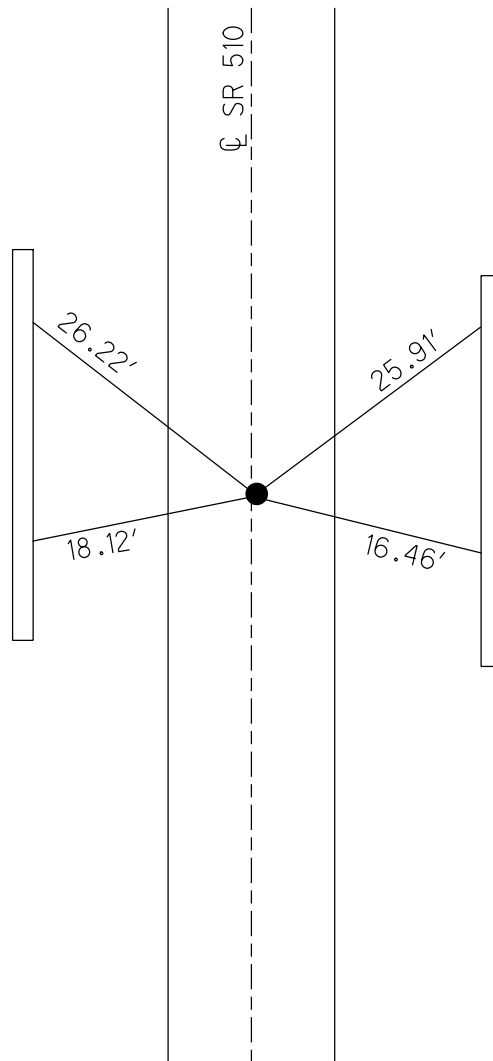

CUT "X"s ON
BARRIER WALL
UNDER TURNPIKE
OPPOSITE PIERS

O.D.O.T. DISTRICT 2 SURVEY OFFICE (USE ONLY)

PERSONNEL

REFERENCE NO. 13

SHEET 14 OF 17

NOTES GARRETT

DATE 7/23/20

ROUTE SR 510

H.C. RHOADES

WEATHER CLOUDY

COUNTY SANDUSKY

R.C. MAHLER

TEMP. 77°

TOWNSHIP RILEY

SECTION 23

DWG BY RHOADES

PID PAVE TRAIN

T 5 N R 16 E

TYPE MONUMENT P.K./WASHER

ON SURFACE - ~~BELOW~~ ON

OFFSET Q PAVEMENT 1' ~~LT~~ : RT

8.5' TO RT EDGE PAVEMENT


STATION: 240+13

HORIZ.DATUM: NAD83 2011


GEOID: NAVD88 2012A

GRID: NORTHING: _____

EASTING: _____

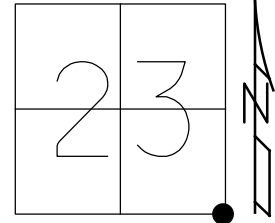

RECORD:
FD BOLT
1" DOWN
SET SM.R.R.SPIKE
1971
FD P.K./WASHER
6/30/04, DCH
SET MAG NAIL
10/08/04, DCH
D.N.F.
7/23/20, JMR

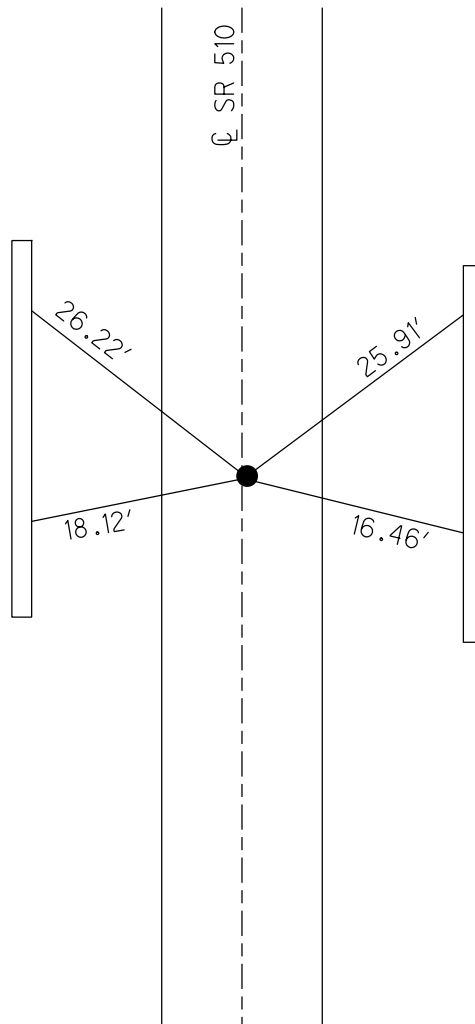

CUT "X"s ON
BARRIER WALL
UNDER TURNPIKE
OPPOSITE PIERS

O.D.O.T. DISTRICT 2 SURVEY OFFICE (USE ONLY)

PERSONNEL

REFERENCE NO. 13

SHEET 14 OF 17

NOTES HOMAN

DATE 6/30/04

ROUTE SR 510

H.C. HUSS

WEATHER SUNNY

COUNTY SANDUSKY

R.C. NUHFER

TEMP. 80°

TOWNSHIP RILEY

SECTION 23

DWG BY _____ PID _____

T 5 N R 16 E

TYPE MONUMENT P.K./WASHER

ON SURFACE - ~~BELOW~~ ON

OFFSET Q PAVEMENT 1' ~~LT~~ : RT

8.5' TO RT EDGE PAVEMENT


STATION: 240+13

HORIZ.DATUM: _____


GEOID: _____

GRID: NORTHING: _____

EASTING: _____

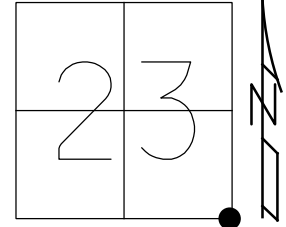

RECORD:
FD BOLT
1" DOWN
SET SM.R.R.SPIKE
1971
SET MAG NAIL
10/08/04, DCH

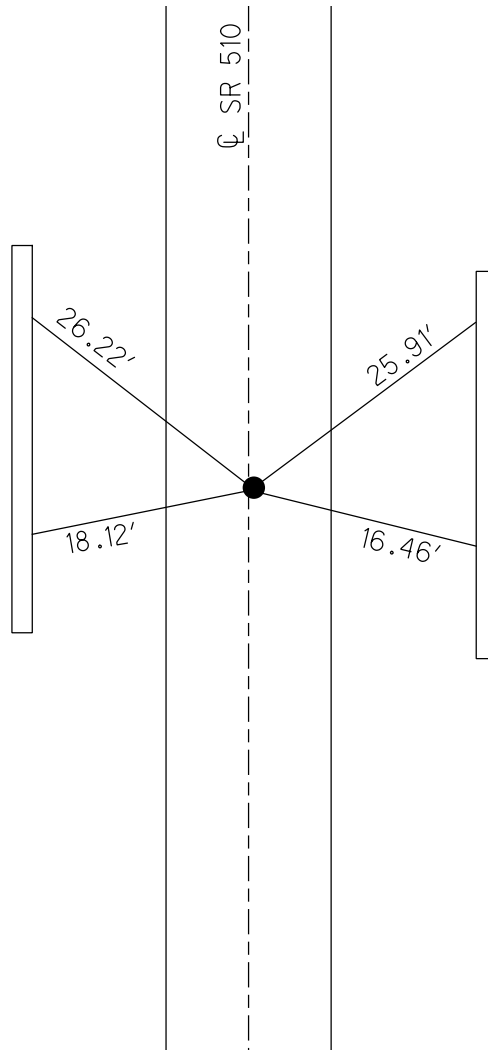

CUT "X"s ON
BARRIER WALL
UNDER TURNPIKE
OPPOSITE PIERS

O.D.O.T. DISTRICT 2 SURVEY OFFICE

PERSONNEL

REFERENCE NO. 13

SHEET 14 OF 17

NOTES HOMAN

DATE 6-30-04

ROUTE SR 510

H.C. HUSS

WEATHER SUNNY

COUNTY SANDUSKY

R.C. NUHFER

TEMP. +80°

TOWNSHIP RILEY

SECTION 26

T 5 N R 16 E


TYPE MONUMENT P.K. & WASHER

ON SURFACE -BELOW ON

~~LEFT - Q PAVT~~ - RIGHT 1'


8.5' TO RT EDGE PAVEMENT

S.L.M. 240+13

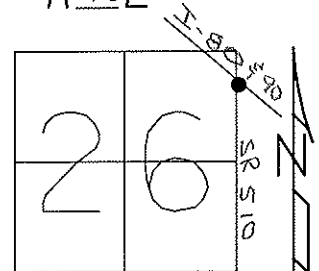

RESET MAG NAIL
10-8-04
DCH

CUT "x"s
BARRIER WALL
UNDER TURNPIKE
OPPOSITE PIERS

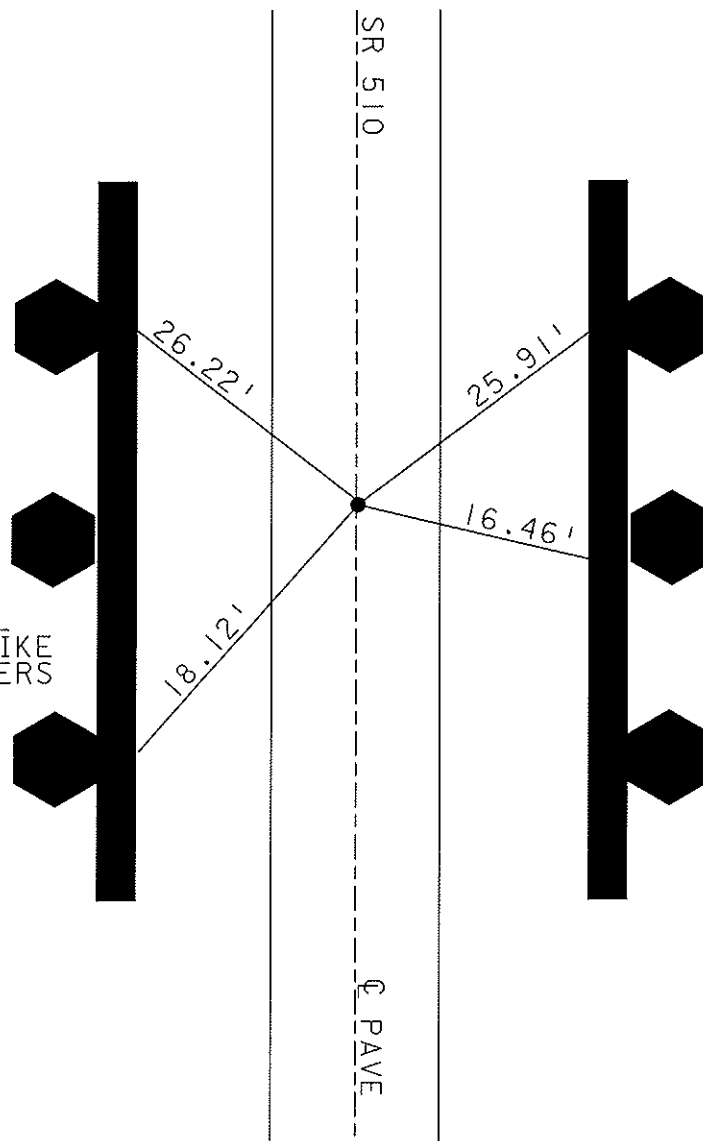

CUT "x"s
BARRIER WALL
UNDER TURNPIKE
OPPOSITE PIERS

O.D.O.T. DISTRICT 2 SURVEY OFFICE

PERSONNEL

REFERENCE NO. 13

SHEET 12 OF 15

NOTES Ripple

H.C. BARBOUR

R.C. Geyman

DATE 8/15/90

WEATHER SUNNY

TEMP. 70°

ROUTE SR#510



COUNTY SANDUSKY

TOWNSHIP Riley

SECTION #26

T. 5 N R. 16 E

TYPE MONUMENT Set PK & Washer
ON SURFACE - BELOW mine Spike A Top Iron Bolt
LEFT - & PAV'T. - RIGHT &
TO EDGE PAVEMENT
S.L.M.

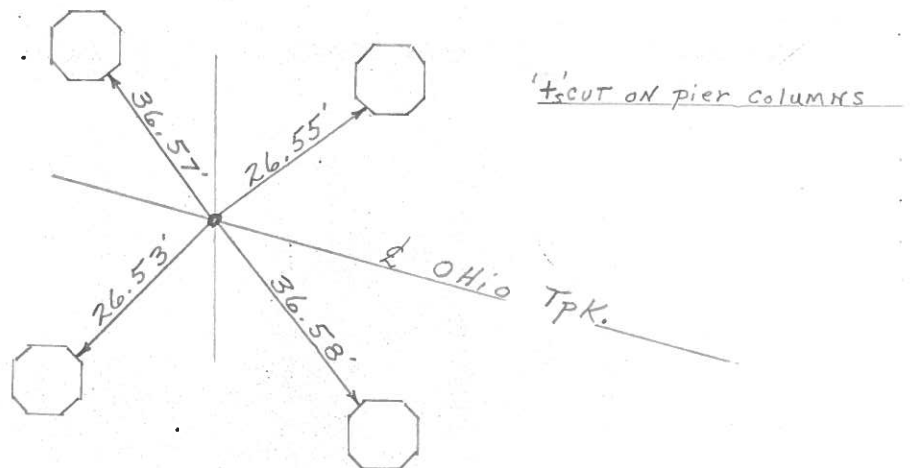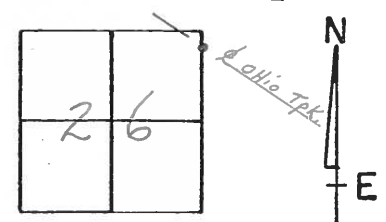

& R/W S.R. #510

O.D.O.T. DISTRICT 2 SURVEY OFFICE

SHEET

OF

County Sandusky S.R. #510

Township Riley

Section #26

T5N, R16E

Personnel Cronin

Ripple

Mosser


Barbour

#13


Date 6/10/82

Weather sunny

Temp. 75°

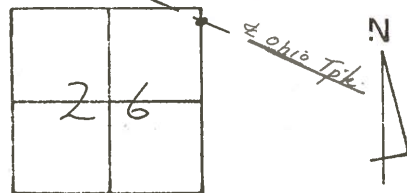

①

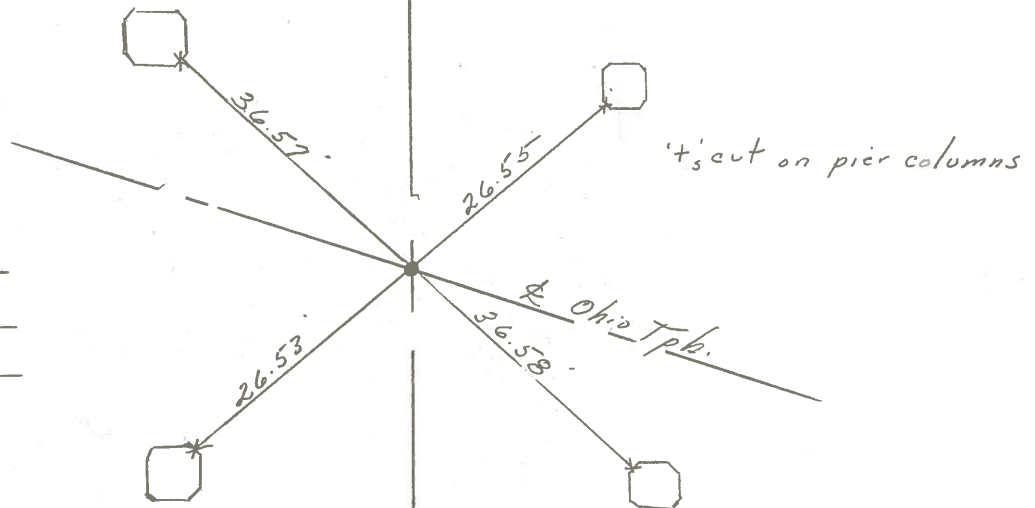

Mine spike was set atop I.
bolt in 1971 - Reset P.K. 5
Washer 6/28/79

S.R. # 510

Aug. 1972

PERSONNEL TITLE PERSONNEL TITLE

COUNTY SANDUSKY DATE 4-15-71S. R. 510 WEATHER FairSEC. U.S. 20 to U.S. 6 TEMP. 50°

DESCRIPTION

LEFT

CENTER LINE

RIGHT

JOB NO.

(13)

Bolt 1" down
 & of Ohio Turnpike
 Reset small R.R. spk.

SEE NEW TIES OF 6/10/82

"X"s on Piers

(12)

surf Kap 25" down

3/4" pipe
 2" down

S.R. #12

S.R. #12

211+98

212+33.87

R.R. spk.

1 1/2" down

1' Rt. of &

Reset small spk.

6" Ash

Q

29.33'

26.23

25.64'

51

F is loose

SEE NEW TIES OF
9-10-87
CONC. POST

Guard Rail Post

35.24

32.74

38.05'

36.87

34.96

Co. Rd. #233

(10)

Fd. R.R. spk.
 on top

sq. shiner on
 tie points

Reset pk Nail

Co. Mon.

Guard Rail Post