

O.D.O.T. DISTRICT 2 SURVEY OFFICE (USE ONLY)

PERSONNEL

REFERENCE NO. 15

SHEET 16 OF 18

NOTES GARRETT

DATE 7/23/20

ROUTE SR 510

H.C. RHOADES

WEATHER CLOUDY

COUNTY SANDUSKY

R.C. MAHLER

TEMP. 77°

TOWNSHIP RILEY

SECTION 23

DWG BY RHOADES PID PAVE TRAIN

T 5 N R 16 E

TYPE MONUMENT P.K./WASHER

ON SURFACE - ~~BELOW~~ ON

OFFSET Q PAVEMENT 3' LT : ~~RT~~

- TO - EDGE PAVEMENT


STATION: 292+10

HORZ.DATUM: NAD83 2011

GEOID: NAVD88 2012A

GRID: NORTHING: 627012.138

EASTING: 1838592.850

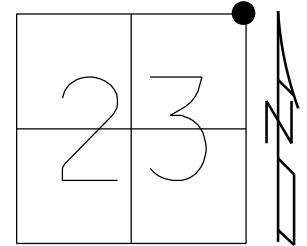

RECORD:

FD BOAT SPIKE/WASHER

ATOP 5/8" IPIN

LEANING 2" EASTERLY

ATOP CORNER STONE

SET P.K./WASHER

8/15/90, BARBOUR

FD P.K./WASHER

6/30/04, DCH

SET MAG/WASHER

10/08/04, DCH


FD P.K./WASHER

REF15

7/23/20, 3/10/21,

1/20/23, JMR

10/3/24, JAM

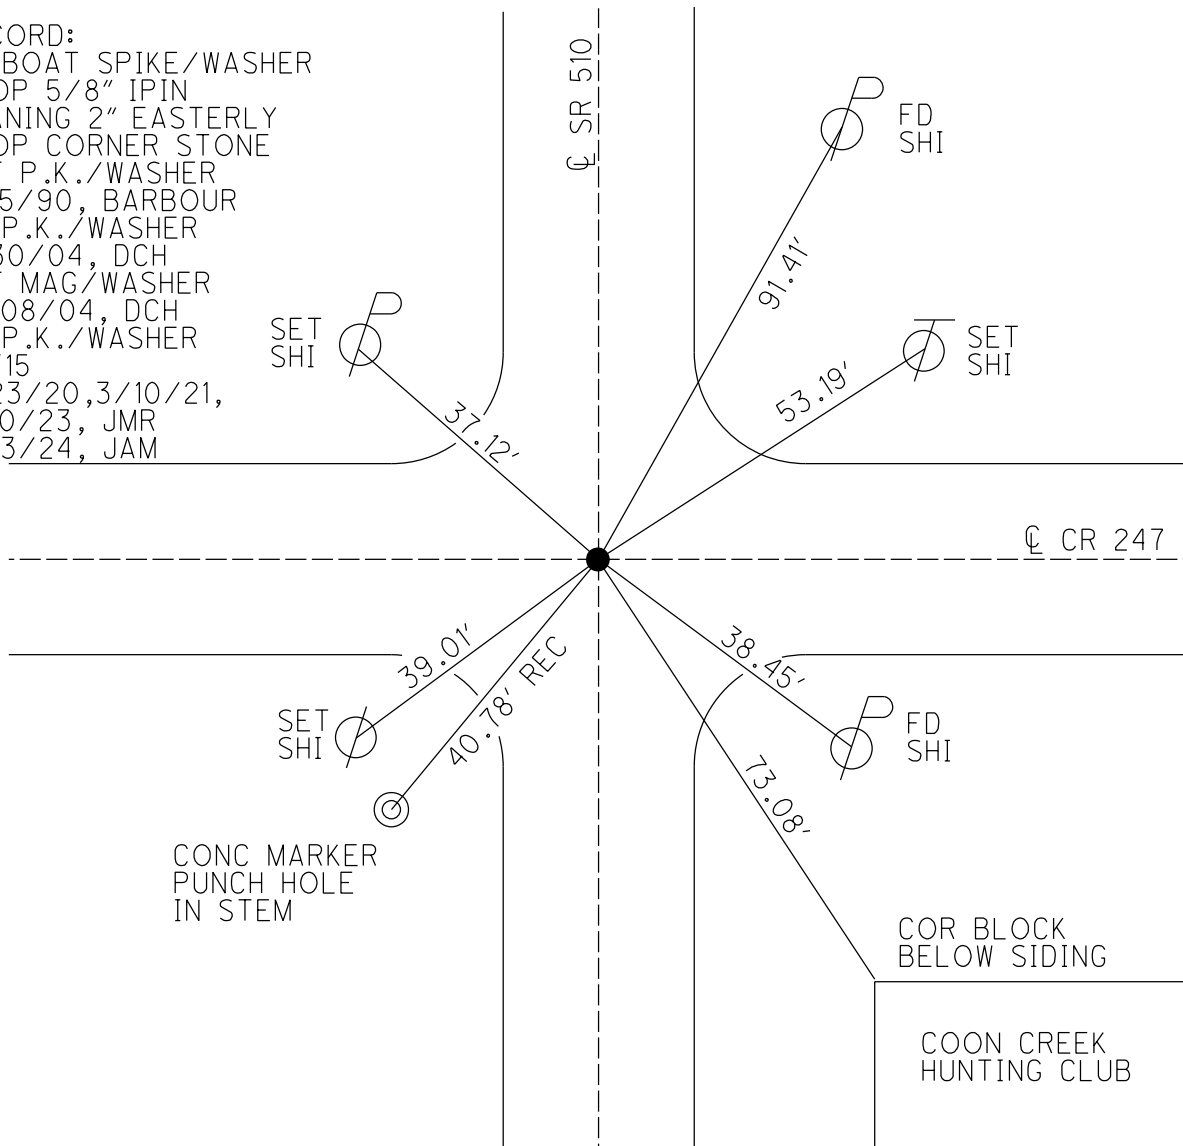

O.D.O.T. DISTRICT 2 SURVEY OFFICE (USE ONLY)

PERSONNEL

REFERENCE NO. 15

SHEET 16 OF 18

NOTES GARRETT
H.C. RHOADES
R.C. MAHLER

DATE 7/23/20
WEATHER CLOUDY
TEMP. 77°

ROUTE SR 510
COUNTY SANDUSKY
TOWNSHIP RILEY
SECTION 23
T 5 N R 16 E

DWG BY RHOADES PID PAVE TRAIN

TYPE MONUMENT P.K./WASHER

ON SURFACE - ~~BELOW~~ ON

OFFSET Q PAVEMENT 3' LT : ~~RT~~

- TO - EDGE PAVEMENT


STATION: 292+10

HORIZ.DATUM: NAD83 2011


GEOID: NAVD88 2012A

GRID: NORTHING: 627012.138

EASTING: 1838592.850

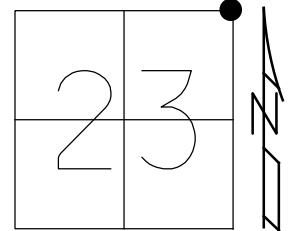

RECORD:
FD BOAT SPIKE/WASHER
ATOP 5/8" IPIN
LEANING 2" EASTERLY
ATOP CORNER STONE
SET P.K./WASHER
8/15/90, BARBOUR
FD P.K./WASHER
6/30/04, DCH
SET MAG/WASHER
10/08/04, DCH
FD P.K./WASHER
REF15
7/23/20, 3/10/21,
1/20/23, JMR

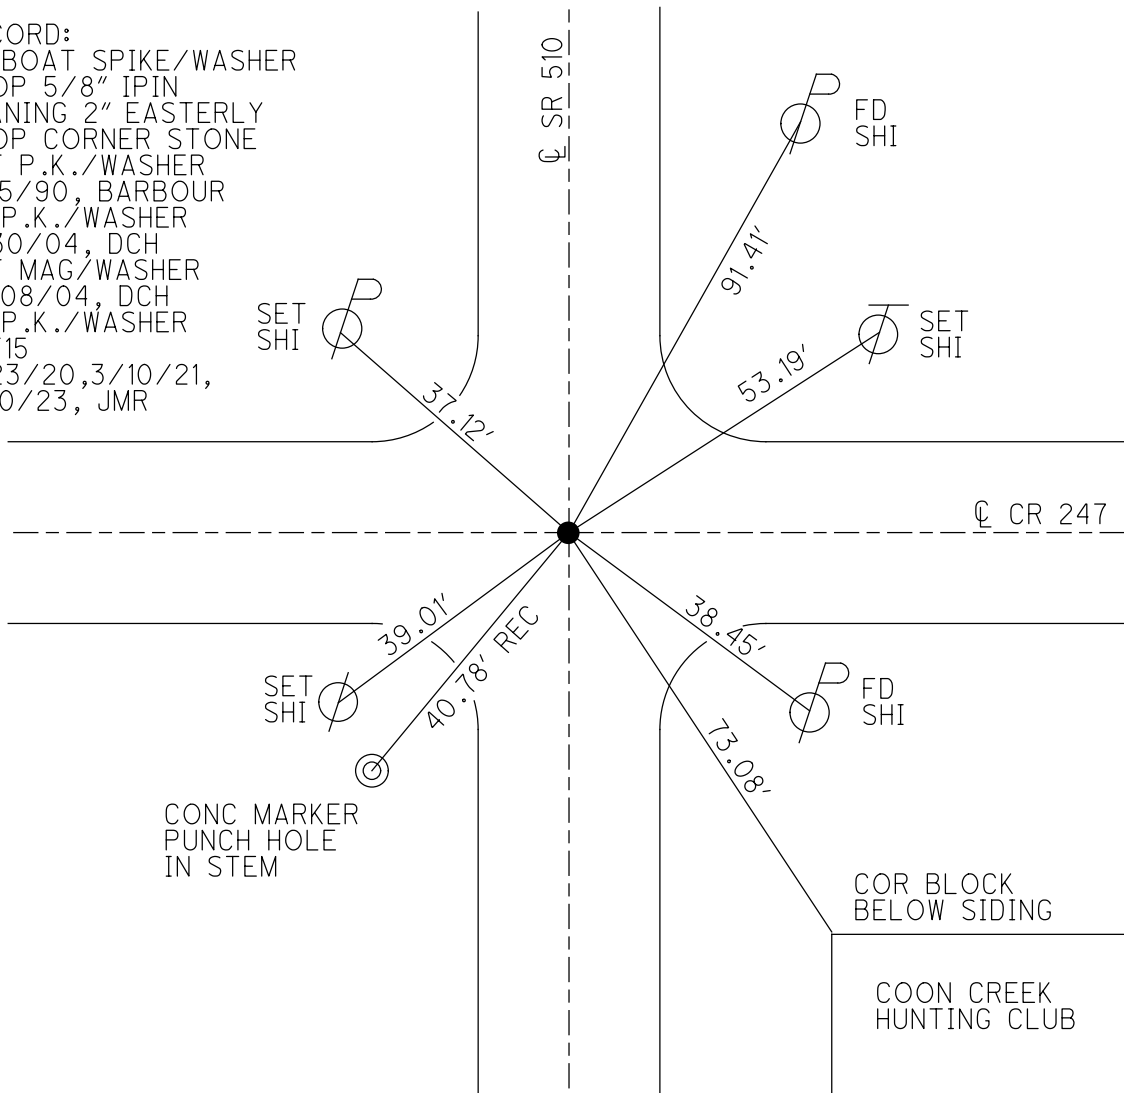

O.D.O.T. DISTRICT 2 SURVEY OFFICE (USE ONLY)

PERSONNEL

REFERENCE NO. 15

SHEET 15 OF 17

NOTES GARRETT

DATE 7/23/20

ROUTE SR 510

H.C. RHOADES

WEATHER CLOUDY

COUNTY SANDUSKY

R.C. MAHLER

TEMP. 77°

TOWNSHIP RILEY

SECTION 23

DWG BY RHOADES

PID PAVE TRAIN

T 5 N R 16 E

TYPE MONUMENT P.K./WASHER

ON SURFACE - ~~BELOW~~ ON

OFFSET Q PAVEMENT ON LT : RT

- TO - EDGE PAVEMENT


STATION: 292+10

HORZ.DATUM: NAD83 2011

GEOID: NAVD88 2012A

GRID: NORTHING: 627012.138

EASTING: 1838592.850

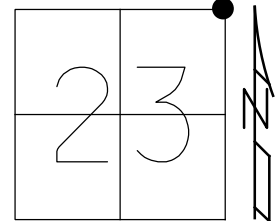

RECORD:

FD BOAT SPIKE/WASHER

ATOP 5/8" IPIN

LEANING 2" EASTERLY

ATOP CORNER STONE

SET P.K./WASHER

8/15/90, BARBOUR

FD P.K./WASHER

6/30/04, DCH

SET MAG/WASHER


10/08/04, DCH

FD P.K./WASHER

REF15

7/23/20, JMR

3/10/21, JMR

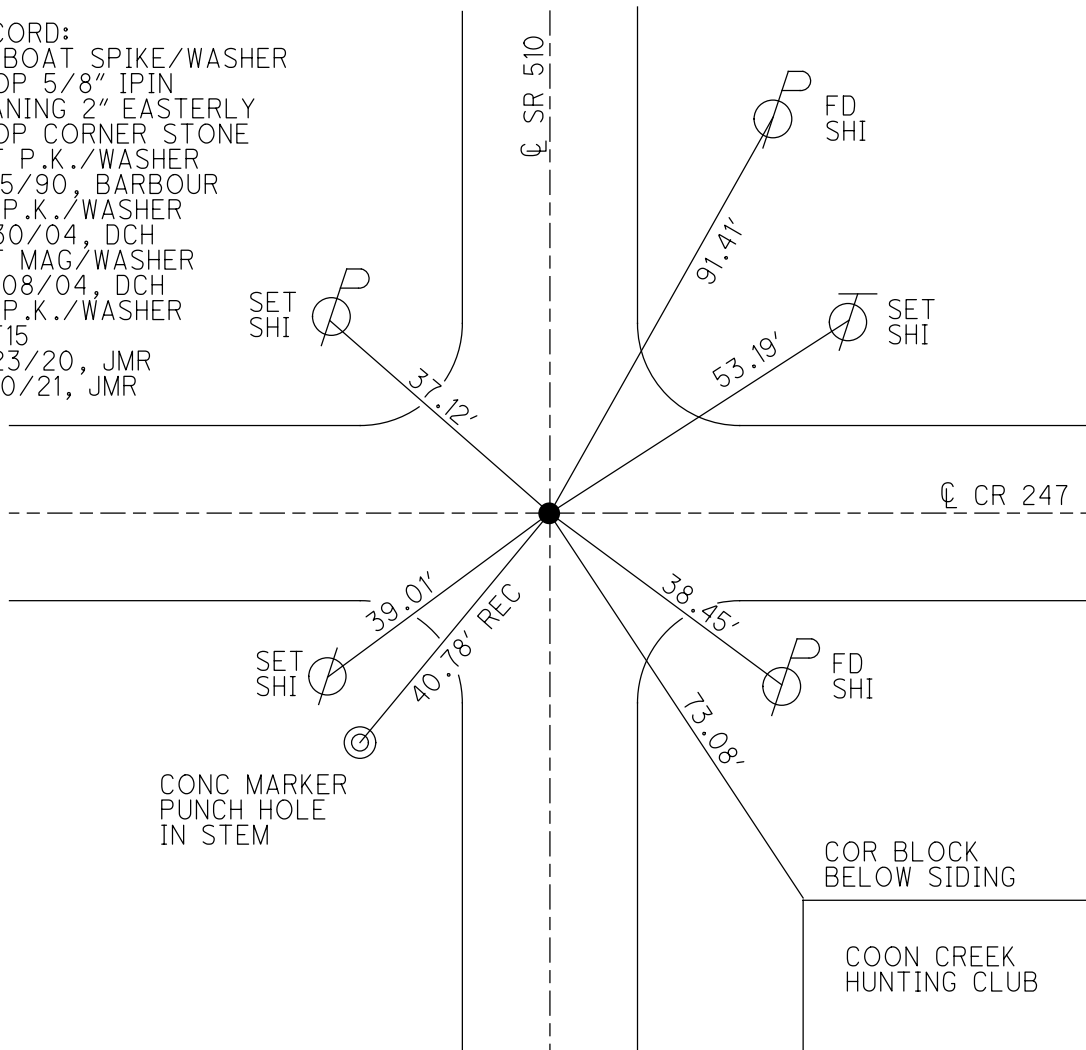

O.D.O.T. DISTRICT 2 SURVEY OFFICE (USE ONLY)

PERSONNEL

REFERENCE NO. 15

SHEET 15 OF 17

NOTES HOMAN

DATE 6/30/04

ROUTE SR 510

H.C. HUSS

WEATHER SUNNY

COUNTY SANDUSKY

R.C. NUHFER

TEMP. 75°

TOWNSHIP RILEY

SECTION 23

DWG BY _____ PID _____

T 5 N R 16 E

TYPE MONUMENT P.K./WASHER

ON SURFACE - ~~BELOW~~ ON

OFFSET Q PAVEMENT ON _____ LT : RT

- TO - EDGE PAVEMENT


STATION: 292+10

HORZ.DATUM: _____


GEOID: _____

GRID: NORTHING: _____

EASTING: _____

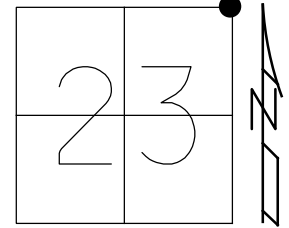

RECORD:
FD BOAT SPIKE/WASHER
ATOP 5/8" IPIN
LEANING 2" EASTERLY
ATOP CORNER STONE
SET P.K./WASHER
8/15/90, BARBOUR
SET MAG/WASHER
10/08/04, DCH

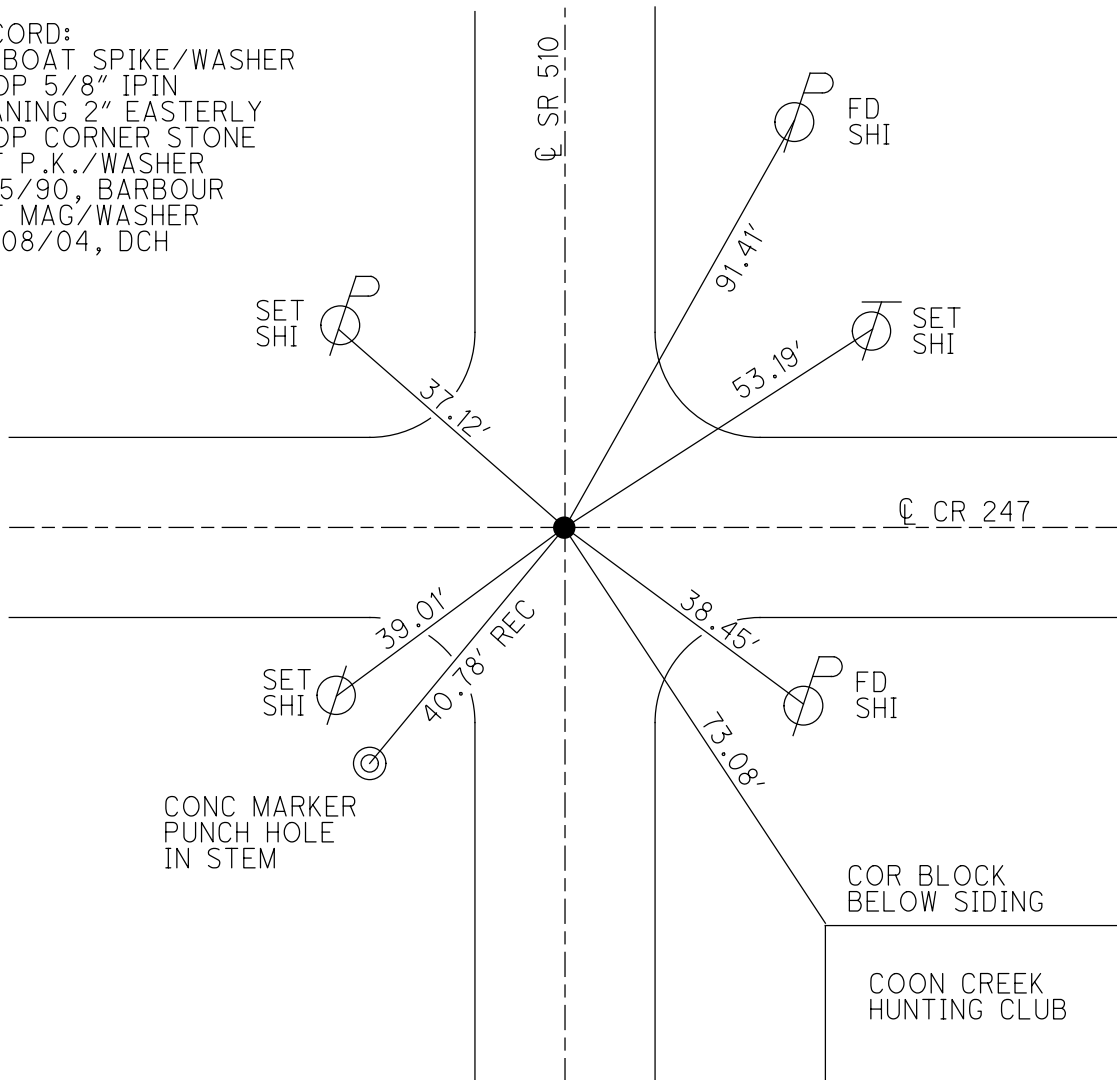

O.D.O.T. DISTRICT 2 SURVEY OFFICE

PERSONNEL

REFERENCE NO. 15

SHEET 15 OF 17

NOTES HOMAN

DATE 6-30-04

ROUTE SR 510

H.C. HUSS

WEATHER SUNNY

COUNTY SANDUSKY

R.C. NUHFER

TEMP. +80°

TOWNSHIP RILEY

SECTION 23

T 5 N R 16 E


TYPE MONUMENT P.K. & WASHER

ON SURFACE -BELOW- ON

~~LEFT~~ - Q PAV'T - ~~RIGHT~~ ON

TO EDGE PAVEMENT


S.L.M. 292+10

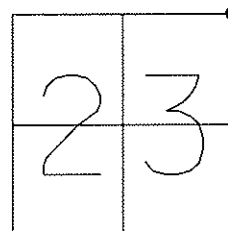

RESET MAG NAIL
10-8-04
DCH

Record 1990

Boat Spike/Washer, corner stone
5/8" I. Rod is 2" to the East

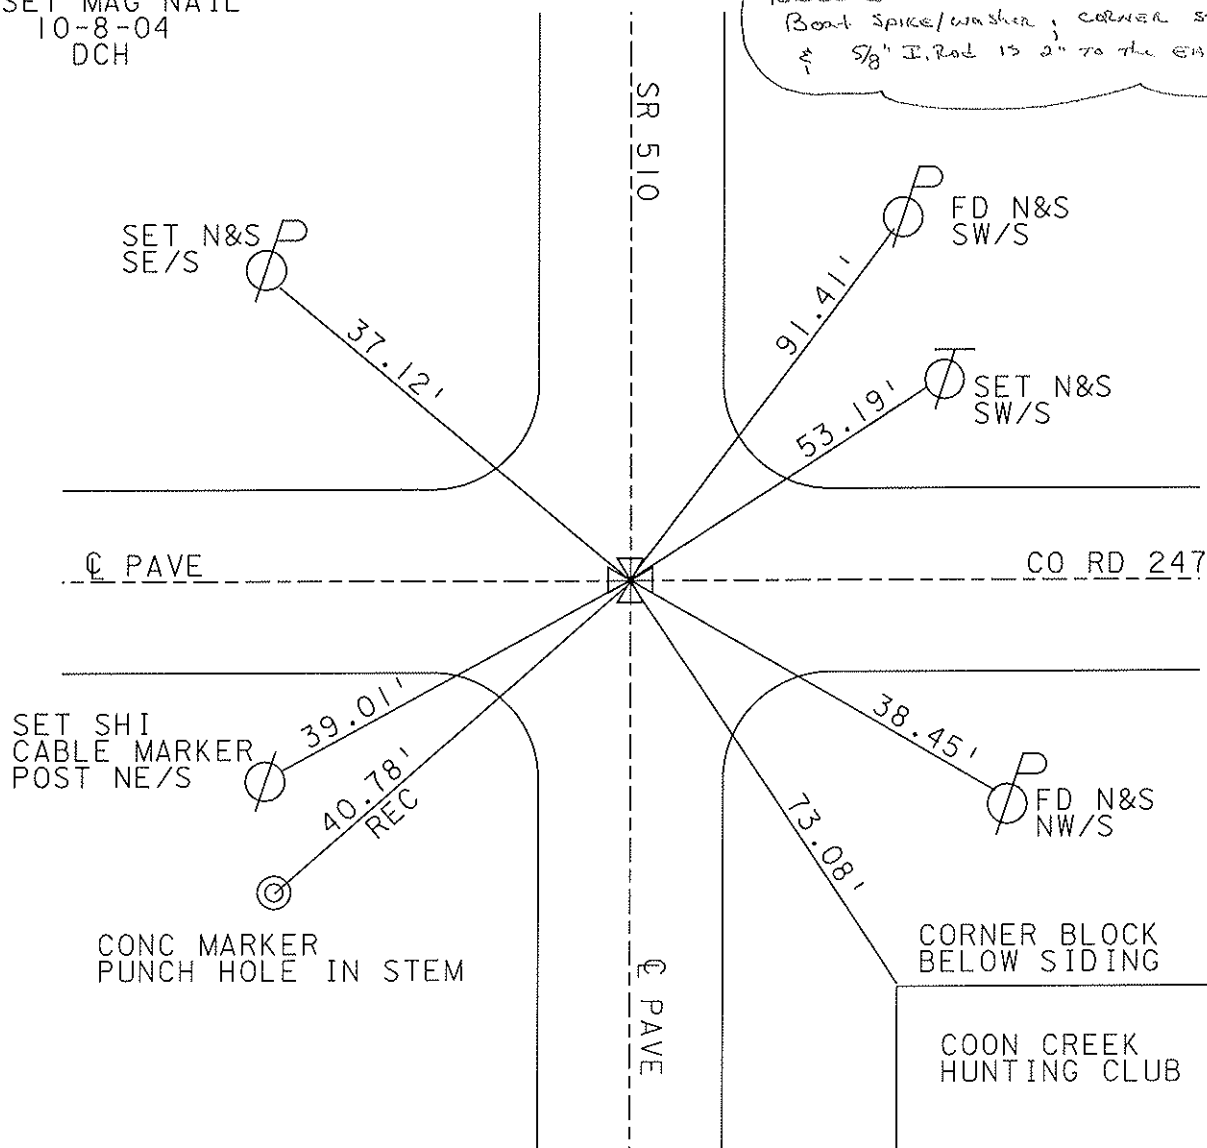

O.D.O.T. DISTRICT 2 SURVEY OFFICE

PERSONNEL

REFERENCE NO. 15

SHEET 13 OF 15

NOTES RIPPLE

H.C. BARBOUR

R.C. GEYMAN

DATE 8/15/90

WEATHER SUNNY

TEMP. 83°

ROUTE SR# 510

COUNTY SANDUSKY

TOWNSHIP RILEY

SECTION 23

T. 5 N R. 16 E



TYPE MONUMENT Set P.K. & Washer

ON SURFACE - BELOW A Top Boat Spike & Washer A Top Stone

LEFT - & Pav't. - RIGHT 1.5' Lt. & Pavmt.

TO EDGE PAVEMENT

S.L.M.

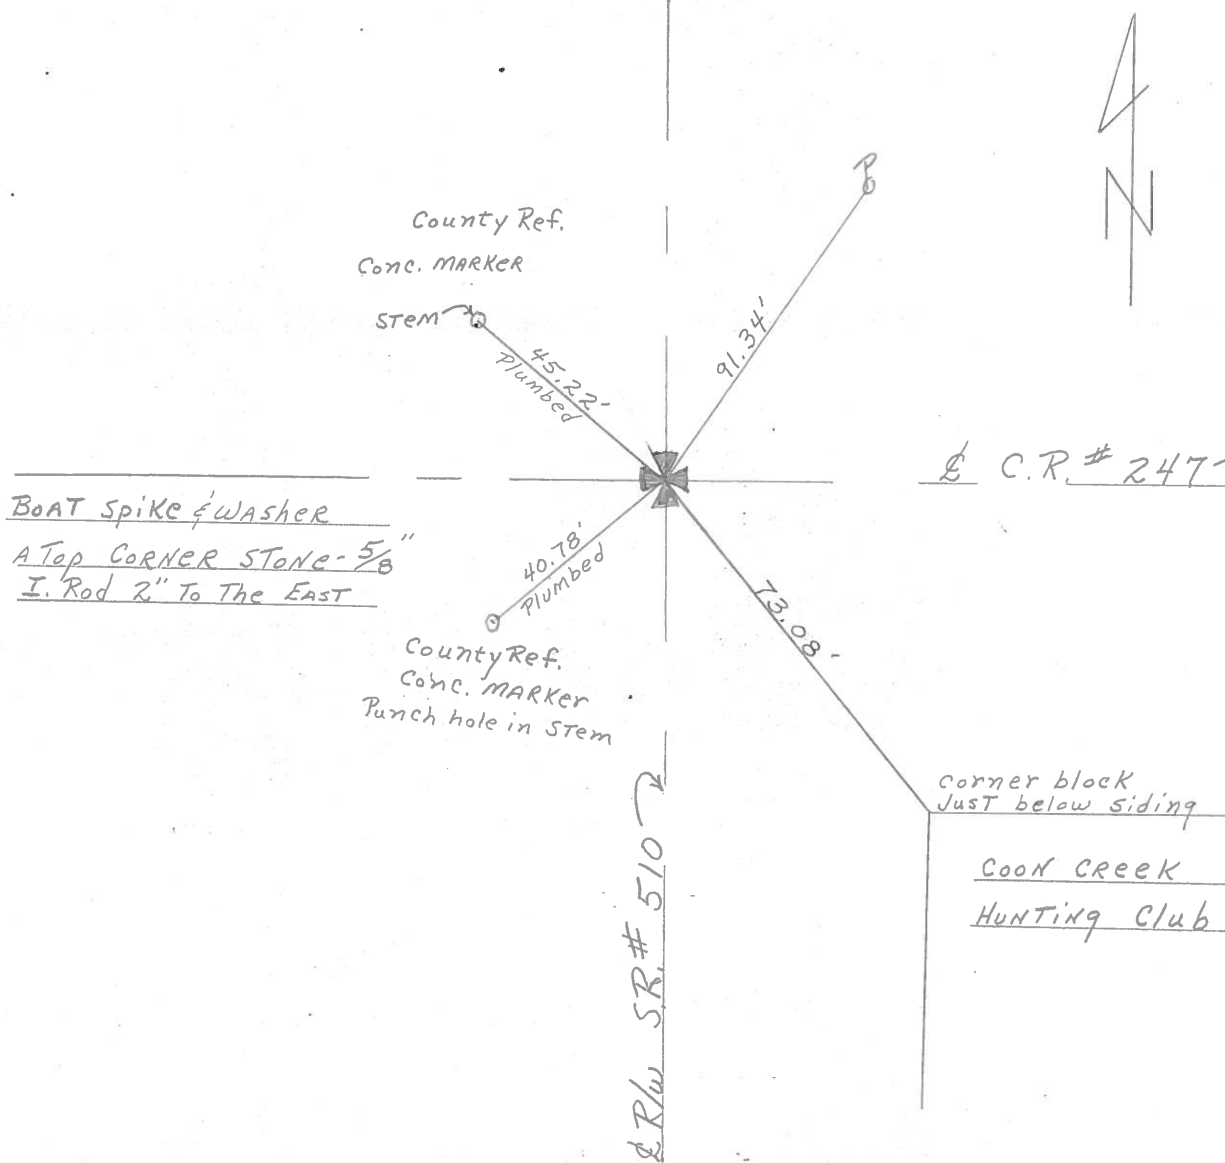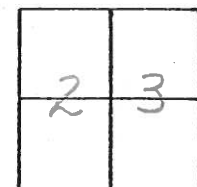

O.D.O.T. DISTRICT 2 SURVEY OFFICE

SHEET

OF

County Sandusky S.R. #510

Township Riley

Section 23

T5N, R16E

Personnel Cronin

Ripple

Mosser


Barbour

#15

Date 6/10/82


Weather sunny

Temp. 75°

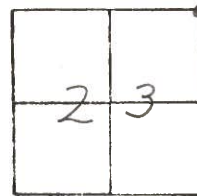

(2)

Corner stone - $\frac{5}{8}$ "
I Rd 2" to the east

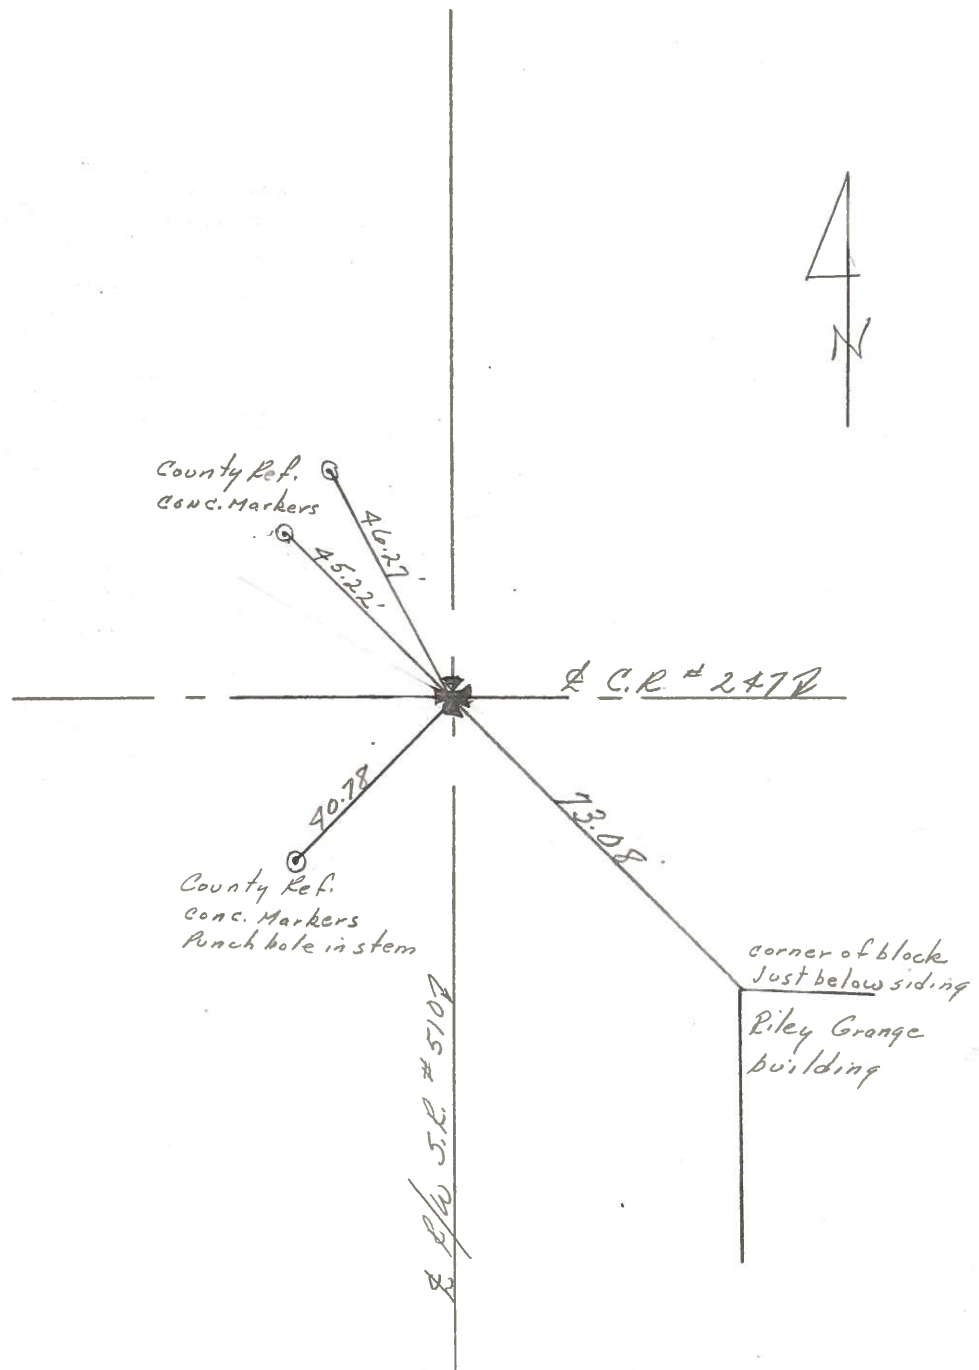

PERSONNEL

TITLE

PERSONNEL

TITLE

COUNTY

Sandusky

DATE

8-14-725-15-71

S. R.

510

WEATHER

Fair

SEC.

U.S. 20 to 456

TEMP.

50°

DESCRIPTION

LEFT

CENTER LINE

RIGHT

JOB NO.

AS 7065 U.S. #6U.S. #6(16)

334+62.63

R. R. Spk.

1" down

Reset P.K. Nail

Hdw.

21.03

C

25.36

36" Oak

46.93

41.43

Cor. of Hdws

(15A)

331+26.26

R. R. Spk.

1/2" down

Reset P.K. Nail

F 29.45

60.45

C

15" Hickory

37.16

SEE NEW TIES OF 6/10/82

(15)

5/8" iron pin

Reset P.K. Nail

F

38.43

49.57

Co. Mon.

SEE NEW TIES OF 6/10/82

Co. Rd. # 247

40.87

72.25

Co. Mon.

Riley Grange
N.W. Cor. Building