

O.D.O.T. DISTRICT 2 SURVEY OFFICE (USE ONLY)

PERSONNEL

REFERENCE NO. 8 A

SHEET 14 OF 56

NOTES RHOADES

DATE 10/31/23

ROUTE SR 4

H.C. AUBLE

WEATHER 40°

COUNTY SENECA

R.C. ASTON

TEMP. 66°

TOWNSHIP VENICE

NIESE

SECTION 15

DWG BY RHOADES PID 101241

T 1 N R 17 E

TYPE MONUMENT MAG/WASHER

ON SURFACE - ~~BELOW~~ ON

OFFSET Q PAVEMENT 2.45' LT : ~~RT~~

7.7' TO LT EDGE PAVEMENT


STATION: 215+95.12

HORIZ.DATUM: NAD83(2011)


GEOID: NAVD88 2018

GRID: NORTHING: 503913.082

EASTING: 1859468.980

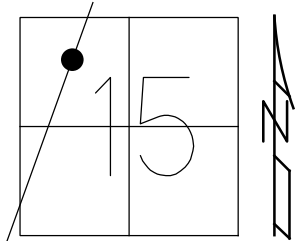

RECORD: P.I.
STA. 215+99.72
 $\Delta = 02^\circ 05' \text{ RT}$
12/17/74
SET P.K./WASHER
ATOP P.K.NAIL
10/6/1993 RCC
FD P.K./WASHER
SV112
9/15/09
SET P.K./WASHER
FIN 112
10/20/10, KPM
FD P.K./WASHER
REFA8
9/15/21, DSA
D.N.F
REFA8
2/8/22, JFO
SET MAG/WASHER
NEWREFA8
7/25/22, DSA
FD MAG/WASHER
REF8A
7/14/23, DSA
SET MAG/WASHER
10/31/23, DSA

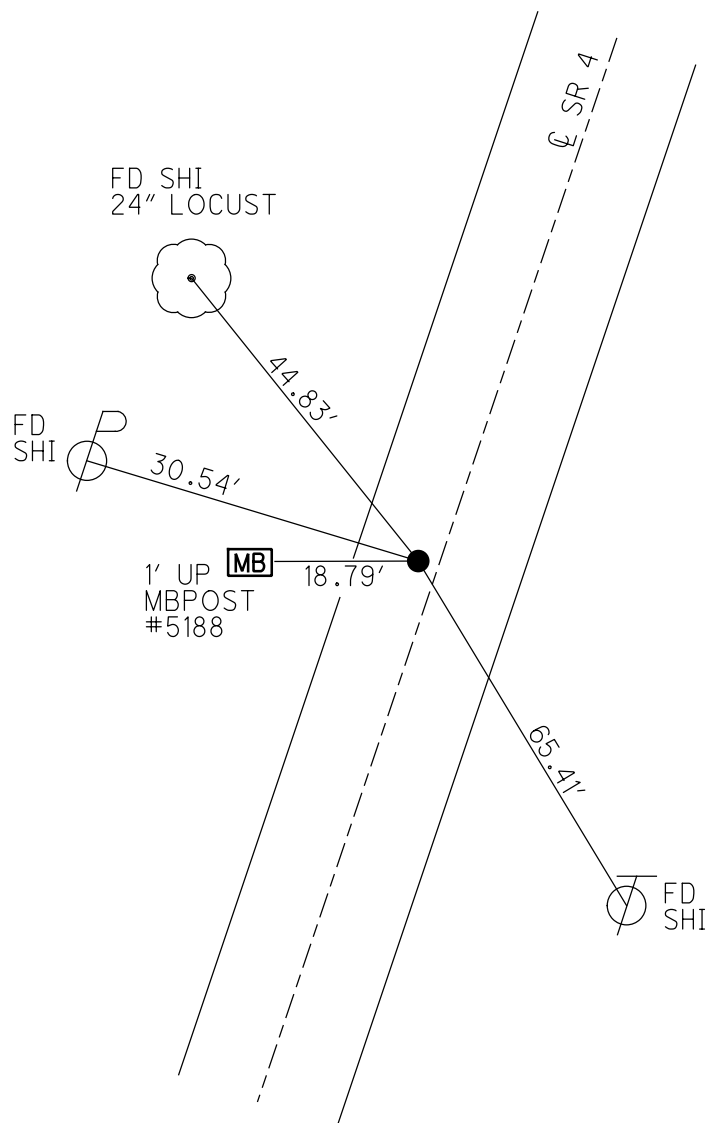

O.D.O.T. DISTRICT 2 SURVEY OFFICE (USE ONLY)

PERSONNEL

REFERENCE NO. 8 A

SHEET 14 OF 41

NOTES NIESE

DATE 9/15/21

ROUTE SR 4

H.C. AUBLE

WEATHER OVERCAST

COUNTY SENECA

R.C. NIESE

TEMP. 66°

TOWNSHIP VENICE

DWG BY WHITAKER

PID PVTRN

SECTION 15

T 1 N R 17 E

TYPE MONUMENT P.K./WASHER

ON SURFACE - ~~BELOW~~ ON

OFFSET 7.7' Q PAVEMENT 2.45' LT : ~~RT~~

7.7' TO LT EDGE PAVEMENT


STATION: 215+95.12

HORZ.DATUM: NAD83(2011)


GEOID: NAVD88 2012A

GRID: NORTHING: 503913.191

EASTING: 1859468.909

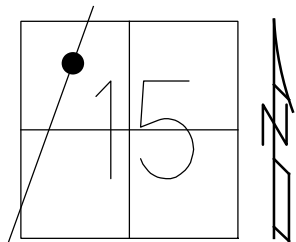

RECORD: P.I.
STA. 215+99.72
 $\Delta = 02^{\circ} 05' \text{ RT}$
12/17/74
SET P.K./WASHER
ATOP P.K.NAIL
10/6/1993 RCC
FD P.K./WASHER
SV112
9/15/09
SET P.K./WASHER
FIN 112
10/20/10, KPM
FD P.K./WASHER
REFA8
9/15/21, DSA
D.N.F
REFA8
2/8/22, JFO
SET MAG/WASHER
NEWREFA8
7/25/22, DSA

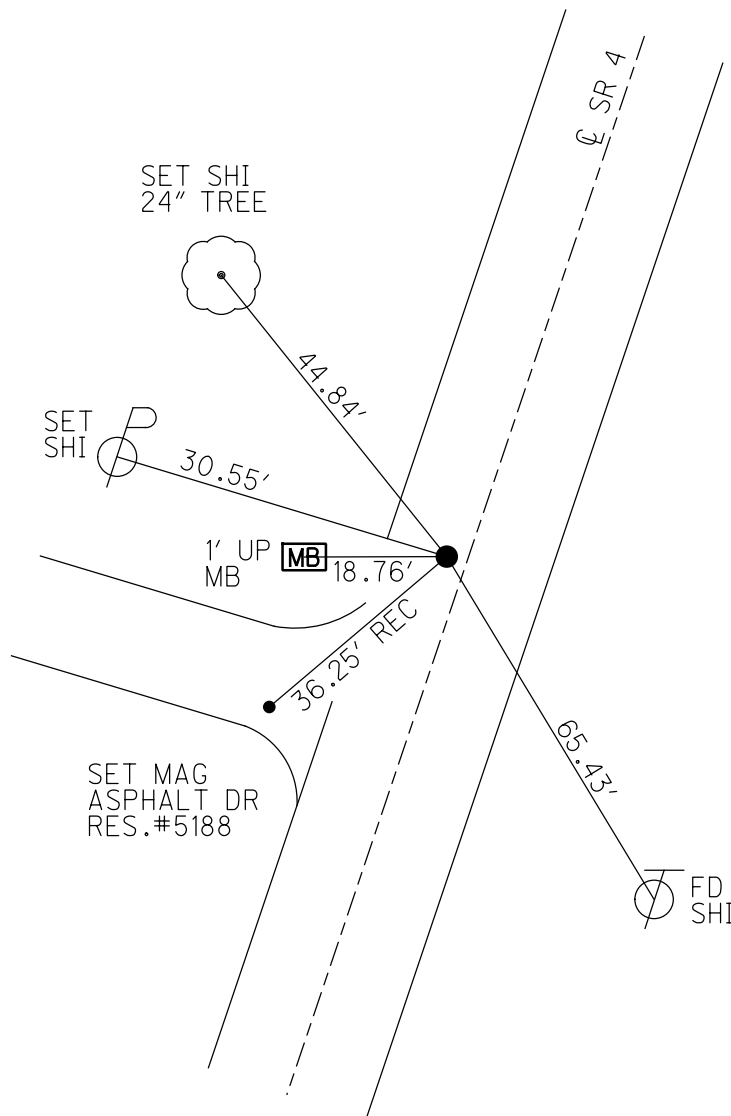

O.D.O.T. DISTRICT 2 SURVEY OFFICE (USE ONLY)

PERSONNEL

REFERENCE NO. 8 A

SHEET 14 OF 41

NOTES_____FINTEL

DATE 8/11/10

ROUTE SR 4

H.C. HARBAUGH

WEATHER FAIR

COUNTY SENECA

R.C. FINTEL

TEMP. 90°

TOWNSHIP VENICEDWG BY RHOADES

PID 85242

T_1_N R_17_E

TYPE MONUMENT P.K./WASHER

ON SURFACE - ~~BELOW~~ ON

OFFSET @ PAVEMENT 2.45' LT : RT


7.7' TO LT EDGE PAVEMENT

STATION: 215+95.12


HORZ.DATUM: NAD83(2011)

GEOID: NAVD88 2012A

GRID: NORTHING: 503913.191

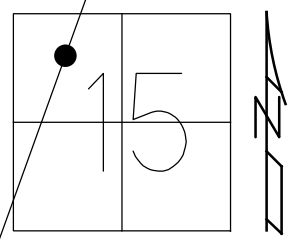EASTING: 1859468.909


RECORD: 12/17/1974
P.I. STA. 215+99.72
 $\Delta = 02^{\circ} 05' RT.$
SET P.K./WASHER
ATOP P.K.NAIL
SET P.K./WASHER
10/6/1993 RCC
FD P.K./WASHER
9/3/09
SV112 9/15/09
SET P.K./WASHER
GPS FIN 112
10/20/10 KPM

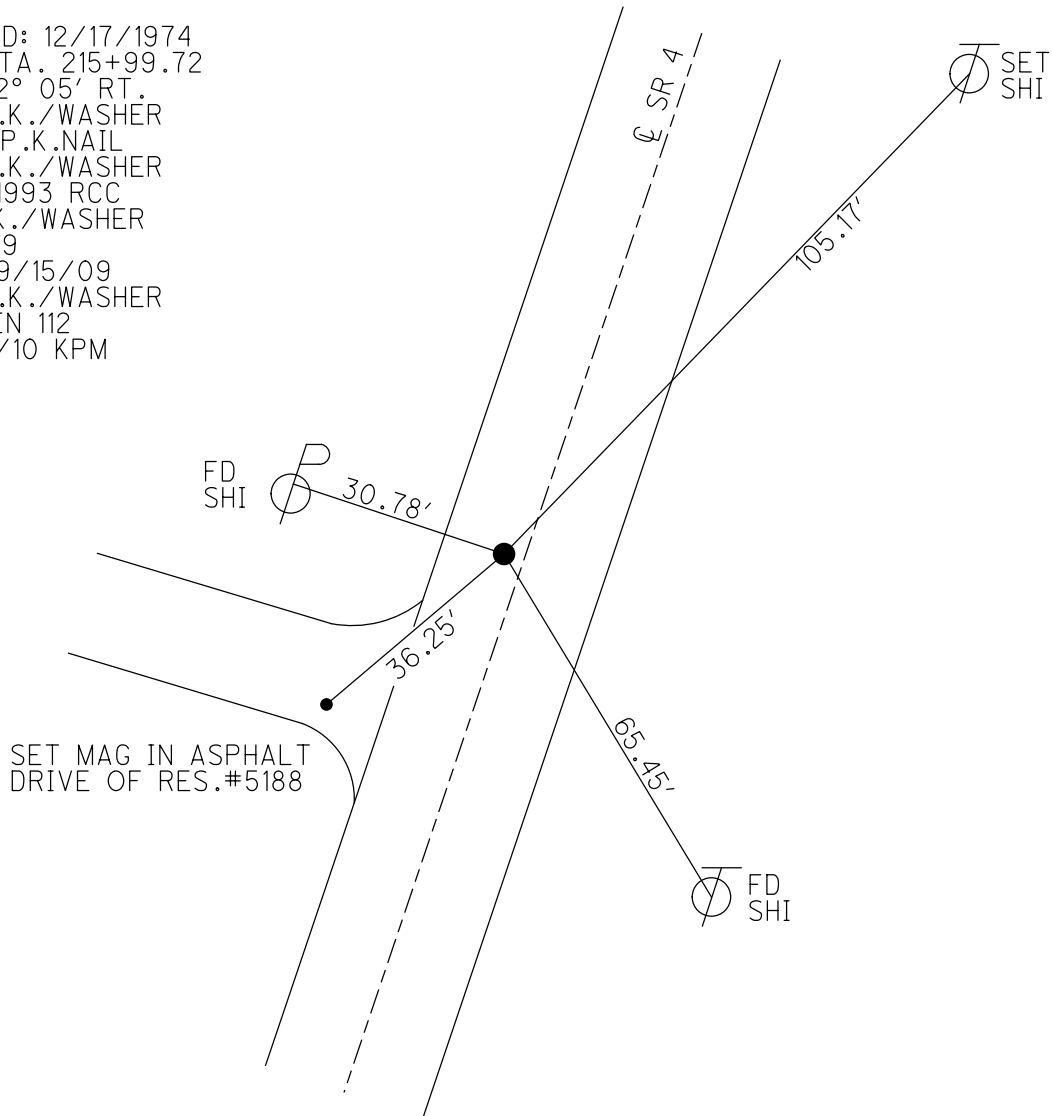

O.D.O.T. DISTRICT 2 SURVEY OFFICE (USE ONLY)


PERSONNEL	REFERENCE NO. <u>8 A</u>	SHEET <u>14</u> OF <u>41</u>	
NOTES	DATE <u>8/11/10</u>	ROUTE <u>SR 4</u>	
H.C. <u>FINTEL</u>	WEATHER <u>FAIR</u>	COUNTY <u>SENECA</u>	
R.C. <u>HARBAUGH</u>	TEMP. <u>90°</u>	TOWNSHIP <u>VENICE</u>	
		SECTION <u>15</u>	
		T <u>1</u> N R <u>17</u> E	

TYPE MONUMENT P.K./WASHER
 ON SURFACE - ~~BELOW~~ ON
 LEFT - C PAV'T - ~~RIGHT~~ 2.45'
7.7' TO LT EDGE PAVEMENT
 S.L.M. 215+95.12

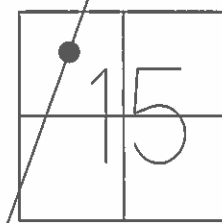

GRID: NORTHING: 503913.191 EASTING: 1859468.909

RECORD: 12/17/1974
 P.I. STA. 215+99.72
 $\Delta = 02^\circ 05' \text{ RT.}$
 SET P.K./WASHER
 ATOP P.K.NAIL
 SET P.K./WASHER
 10/6/1993 RCC
 FD P.K./WASHER
 9/3/09
 SV112 9/15/09
 SET P.K./WASHER
 GPS FIN 112
 10/20/10 KPM

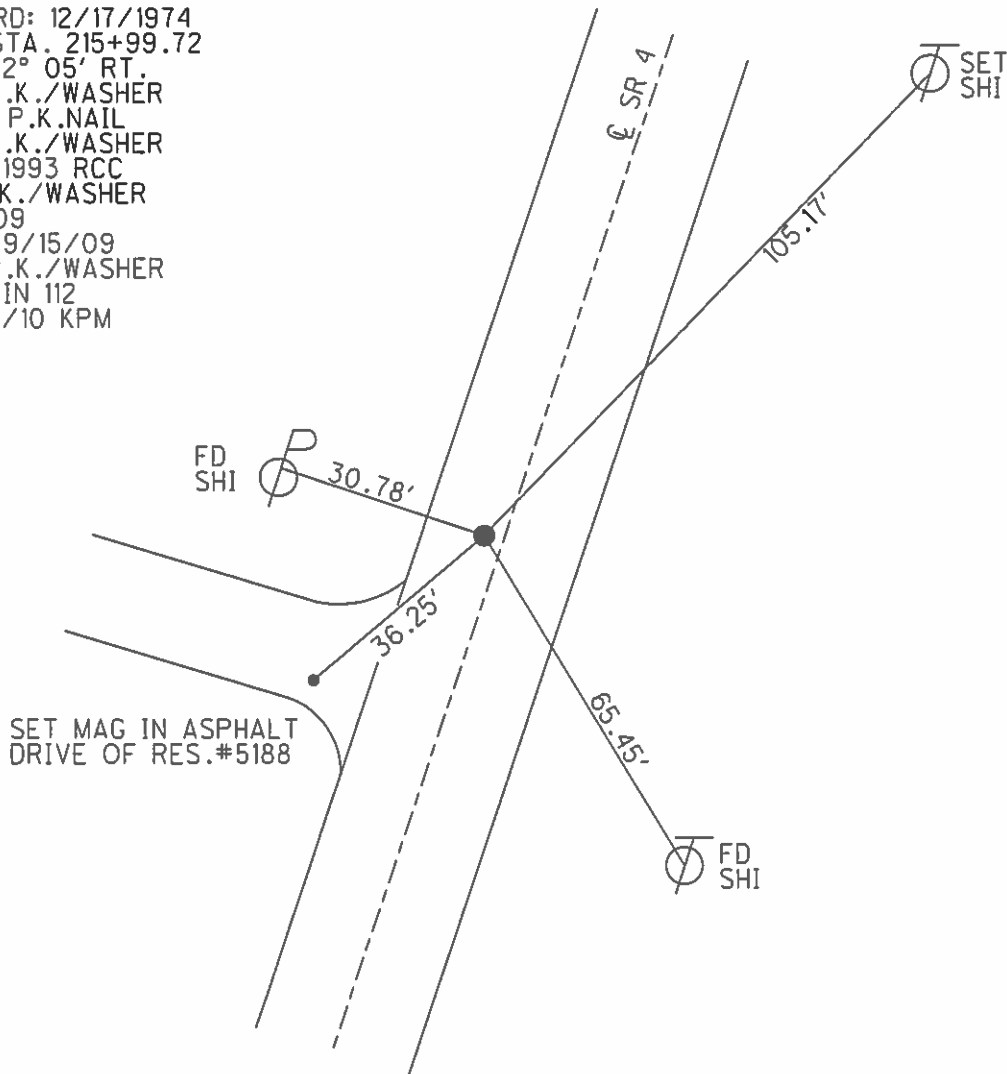

O.D.O.T. DISTRICT 2 SURVEY OFFICE

PERSONNEL

REFERENCE NO. 8-A

SHEET 13 OF 50

NOTES CHENEY

H.C. RIPPLE

R.C. BARBOUR

GEYMAN

DATE 7-26-1993

WEATHER FAIR

TEMP. 90°

ROUTE S.R. #4

COUNTY SENECA

TOWNSHIP VENICE

SECTION 15

T 1 N R 17 E


TYPE MONUMENT PK/WASHER

ON SURFACE - ~~BELOW~~ ON

LEFT - 0 PAV'T. - RIGHT 1.5'

12' TO RT. EDGE PAVEMENT

S.L.M. 216+47

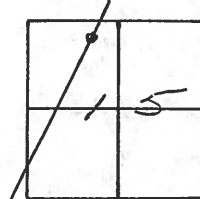

RECORD: 12-17-1974


P.I. STA. 215+99.72

$\Delta = 02^\circ 05'$ Rt.

SET PK/WASHER ATOP

P.K. NAIL


SET PK/WASHER
10-6-1993
RCC

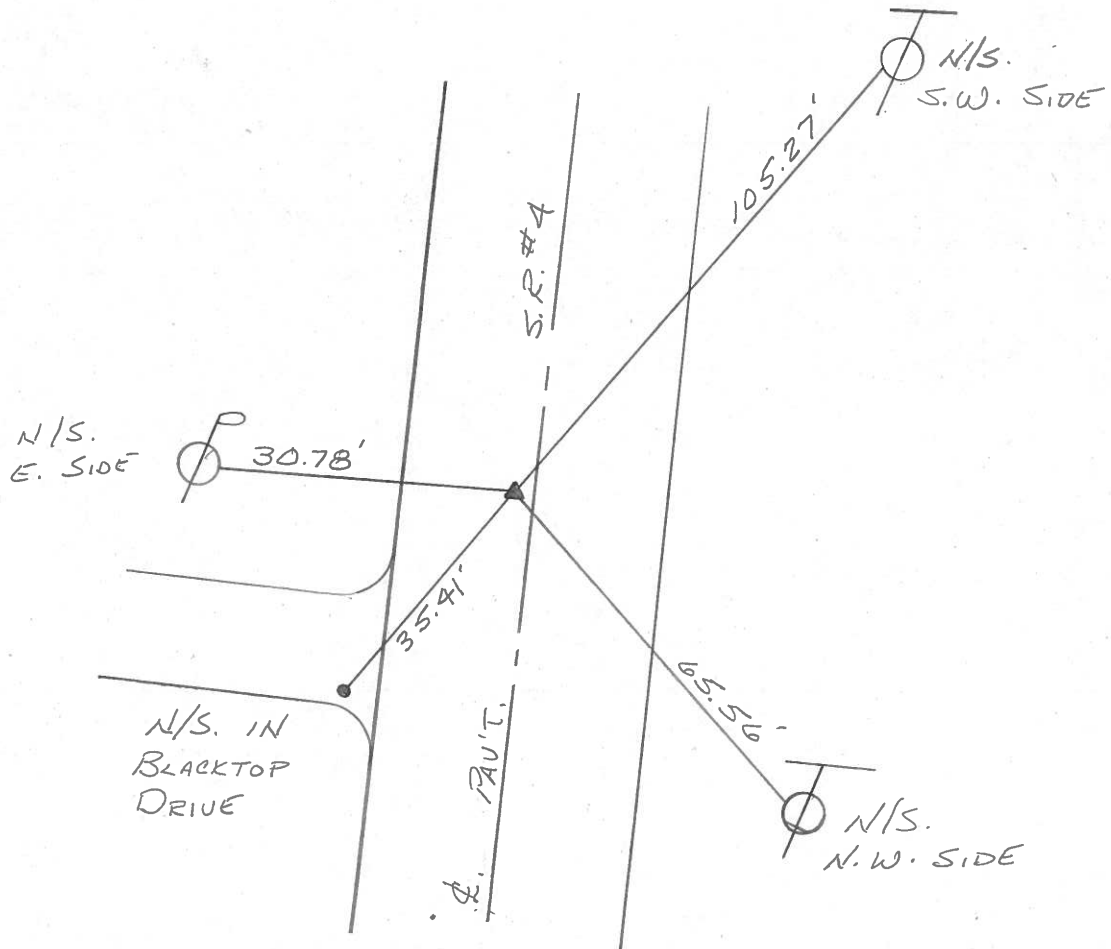

PERSONNEL	TITLE	PERSONNEL	TITLE	COUNTY	DATE	WEATHER	TEMP
Cronin		Schneider		Seneca	12/17/74	overcast-snow	32°
Ash		Mosser		S. R. #4			
Ripple		Barbour		SEC. Crawford Co. Line-North			
Geyman							

DESCRIPTION Ties for Control Points

JOB NO.

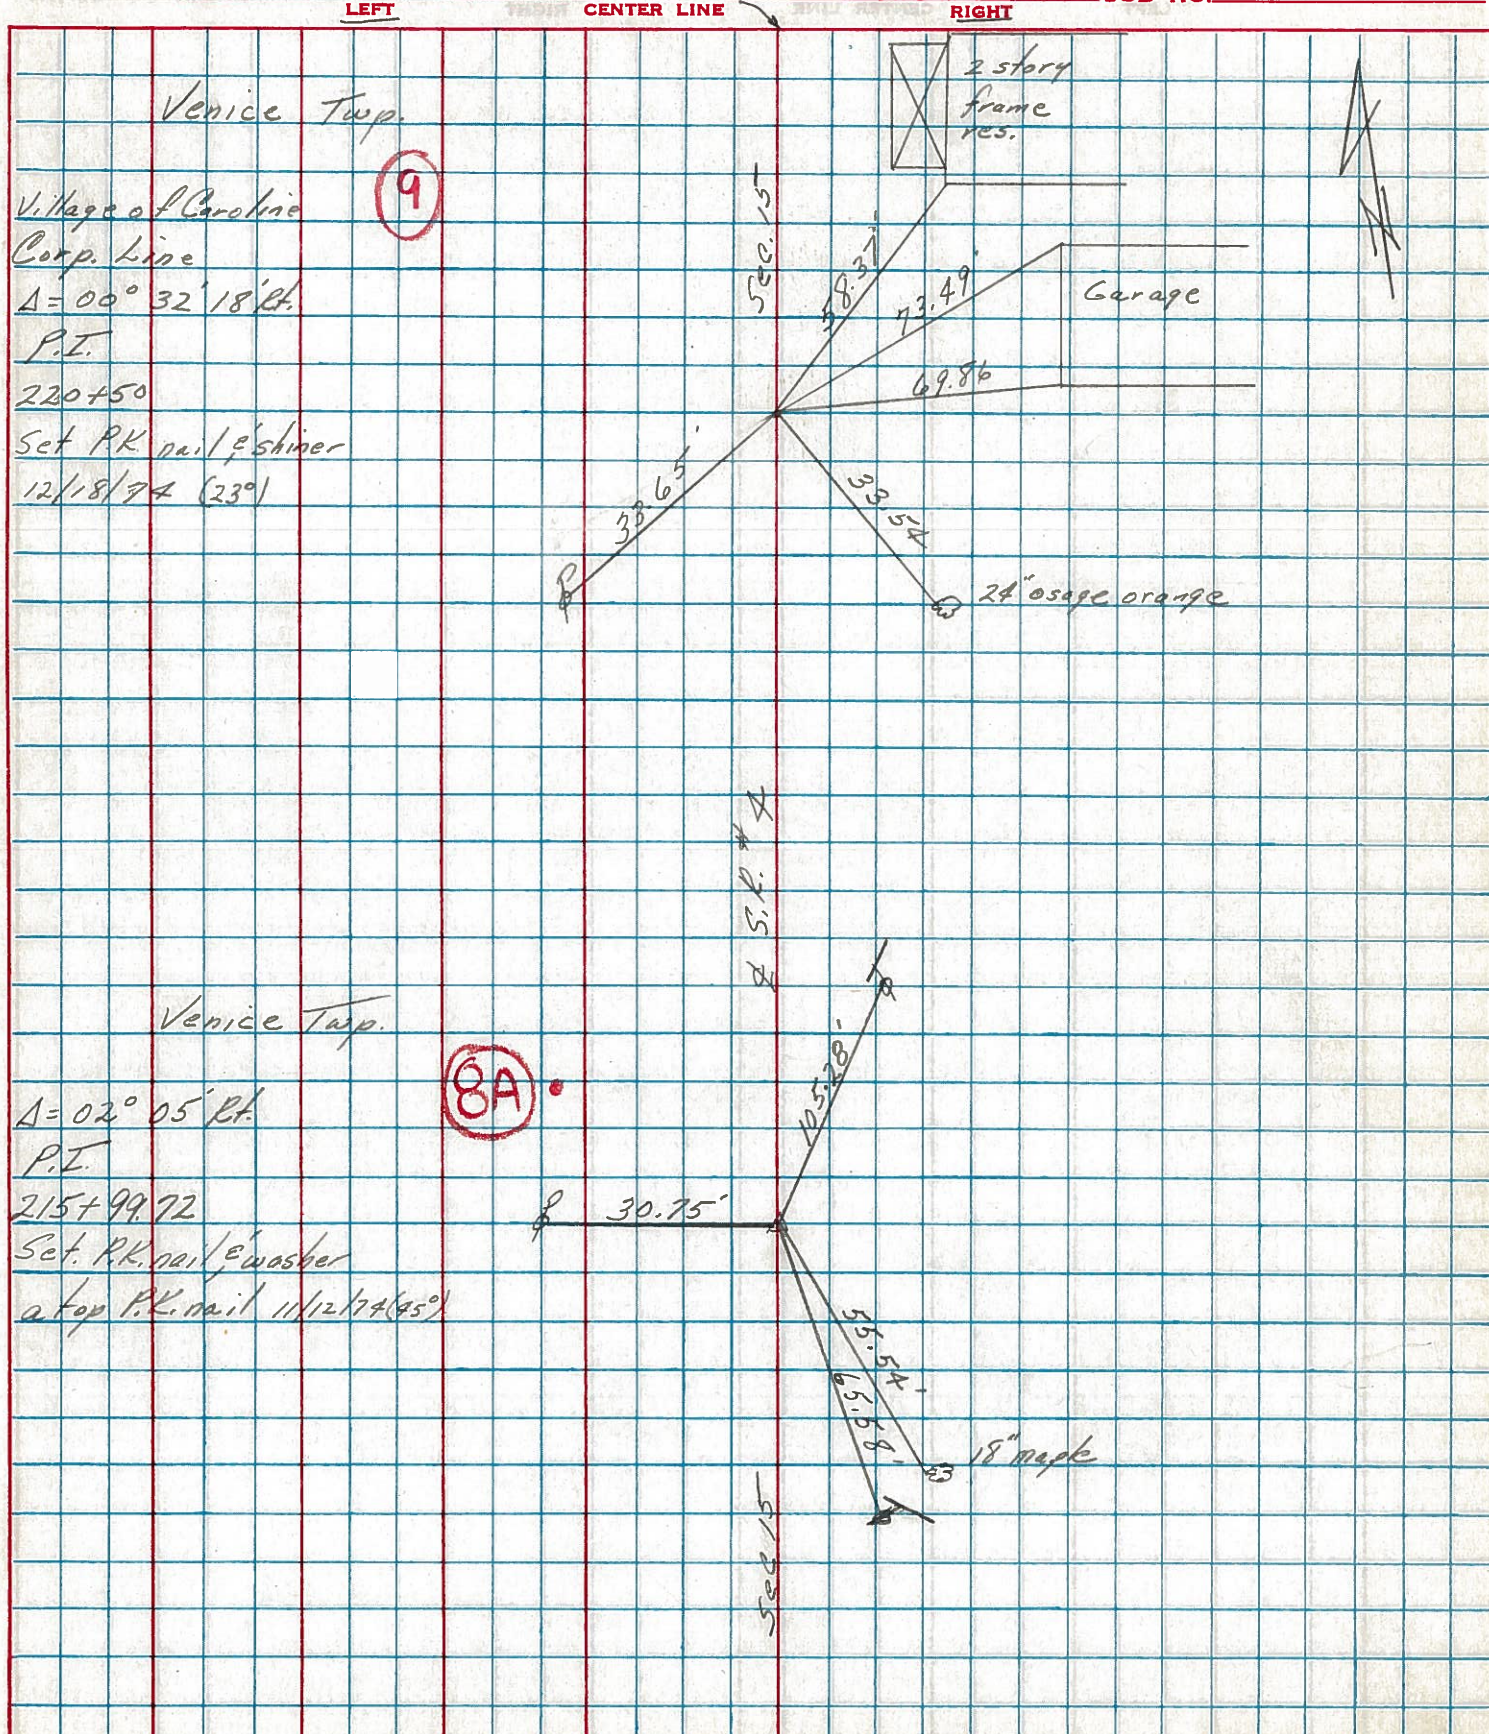

PERSONNEL TITLE PERSONNEL TITLE

Schneider

Potts

COUNTY SenecaDATE 10-1-68

Mosser

S. R. 4WEATHER Fair

Barbour

SEC.

TEMP.

70°

Redding

DESCRIPTION

Ties for Control Points

JOB NO.

LEFT

CENTER LINE

RIGHT

(9B)

228+53.33

 $\Delta = 2^{\circ} 06' 12''$ Rt.

P.K. Nail

8016

(9A)

224+58.58

 $\Delta = 0^{\circ} 19' 18''$ Rt.

8015

(9)

P.I.

220+50

 $\Delta = 0^{\circ} 32' 18''$ Rt.

Village of Caroline

Corp. Line

8014

(8A)


P.I.

215+99.72


 $\Delta = 2^{\circ} 05'$ Rt.

P.K. Nail

8013

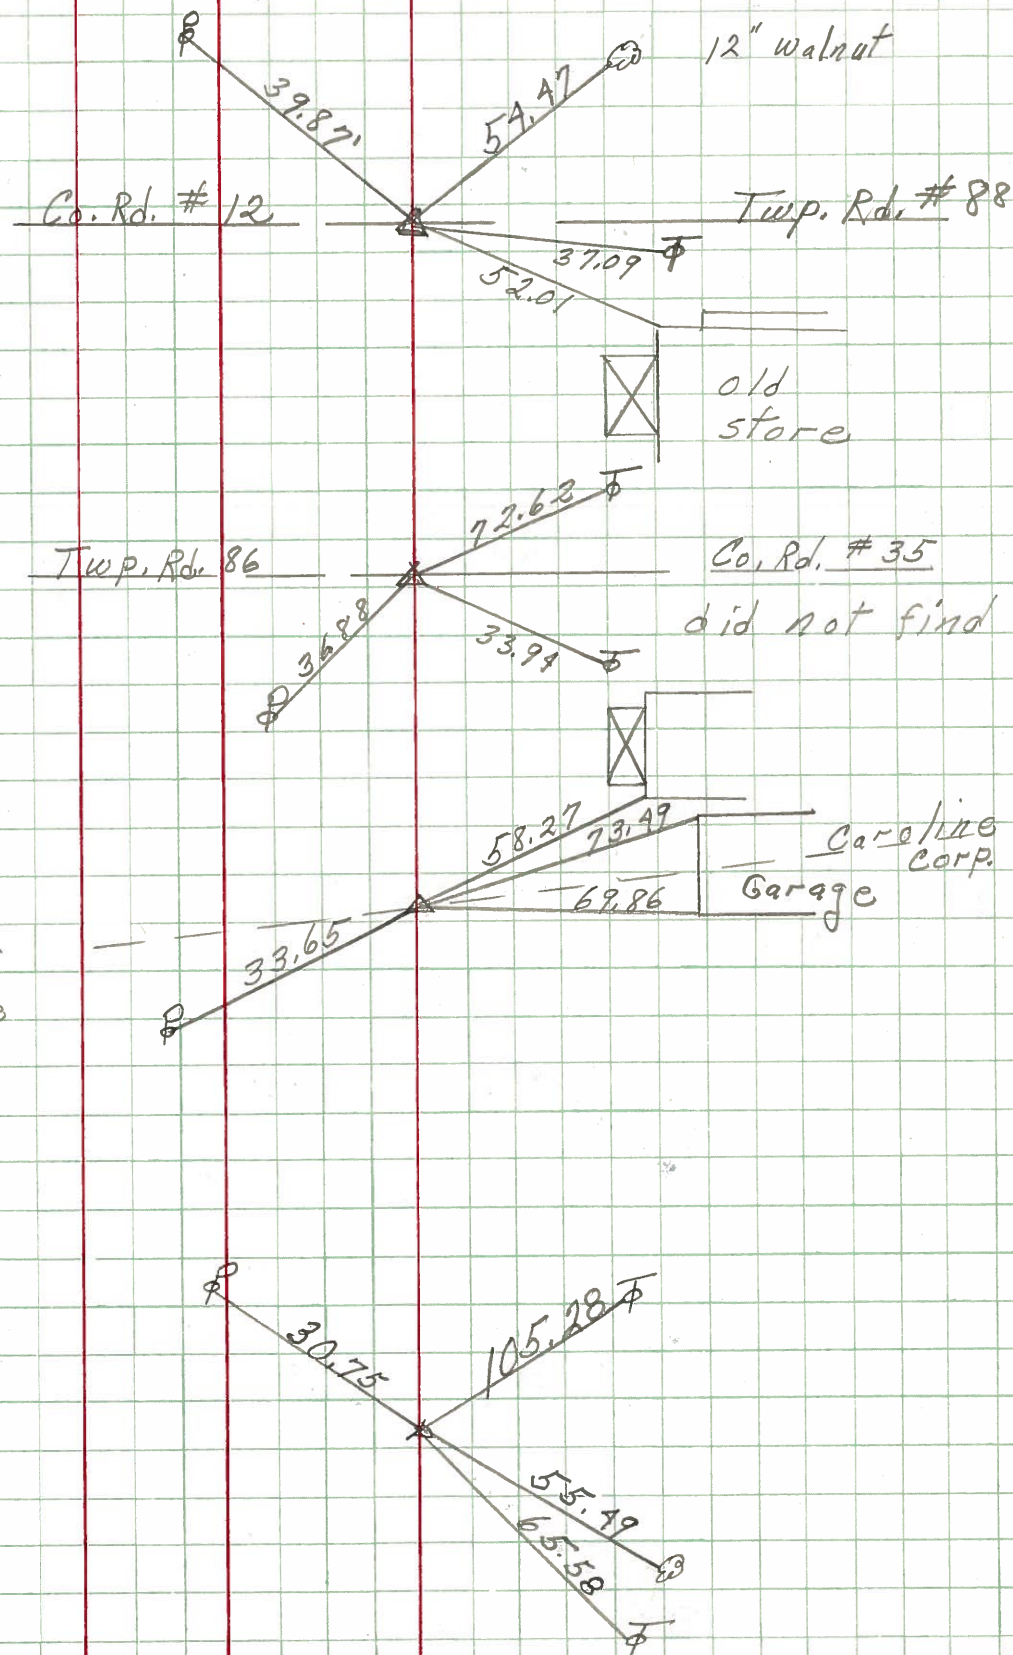

PERSONNEL	TITLE	PERSONNEL	TITLE	COUNTY	DATE
Schneider		Potts		Seneca	10-1-68
Mosser				S. R. 4	WEATHER Fair
Barbour				SEC.	TEMP. 70°
Redding					
DESCRIPTION Ties for Control Points				JOB NO.	
LEFT		CENTER LINE		RIGHT	

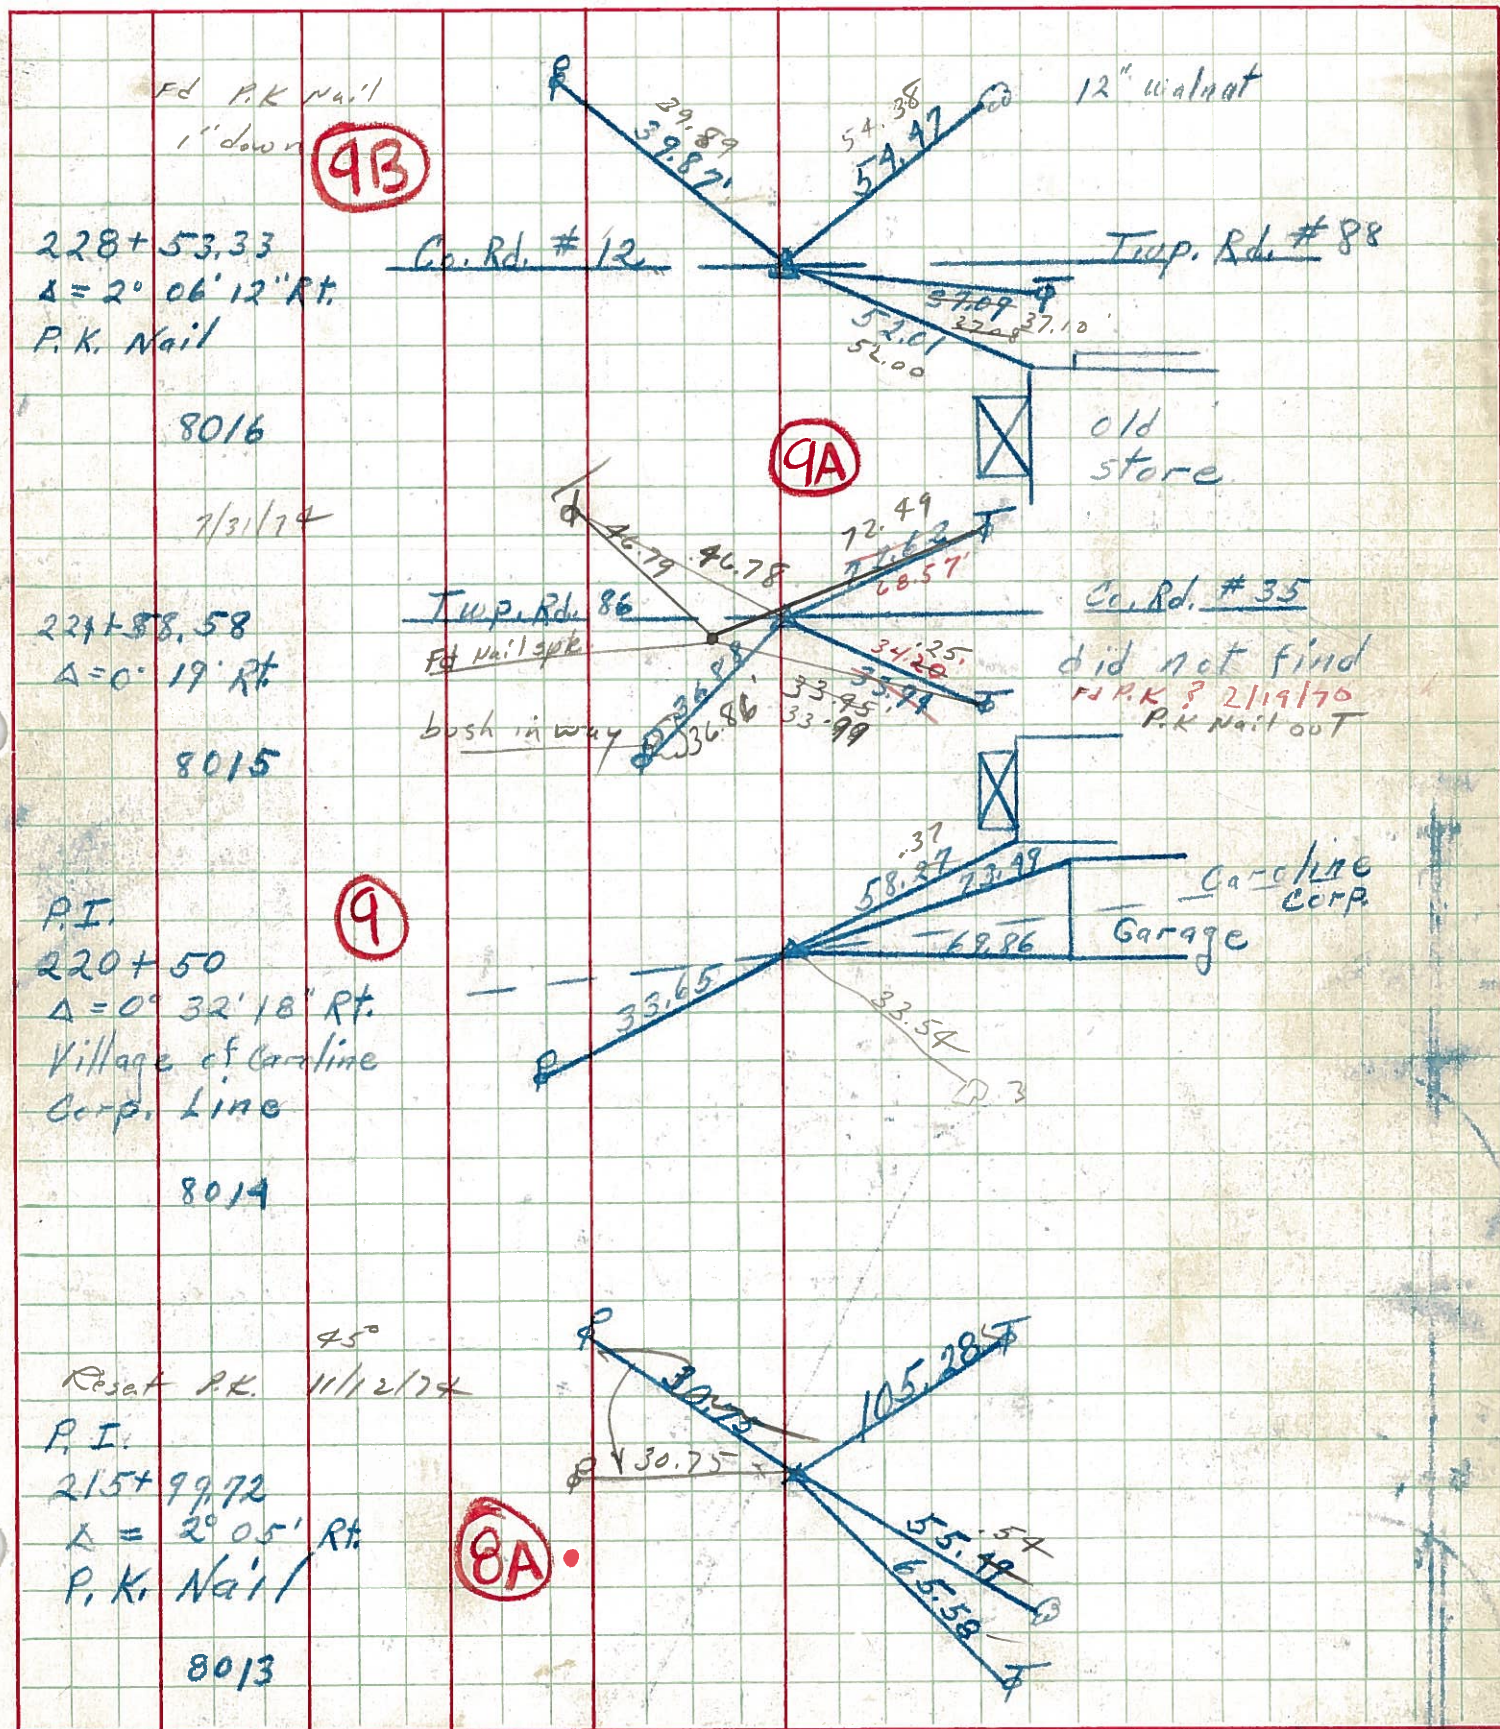

PERSONNEL TITLE PERSONNEL TITLE

KraBill

Kowaleski

Brooks

COUNTY Seneca

DATE

S. R. 4

WEATHER

SEC.

TEMP.

DESCRIPTION

LEFT

CENTER LINE

RIGHT

JOB NO.

215+99.72

P.I. $\Delta = 2^{\circ} - 05' - 00''$ RT

P.k. nail

(8A)

1-17-64

220+50

P.I. $\Delta = 0^{\circ} - 32' - 18''$ RT

P.k. nail

(9)

1-17-64

224+58.58

P.I. $\Delta = 0^{\circ} - 9' - 00''$ RT

P.k. nail

(9A)

Twp Rd 86

1-17-64

228+53.33

P.I. $\Delta = 2^{\circ} - 06' - 12''$ RT

P.k. nail

Co. Rd. #12

(9B)