

O.D.O.T. DISTRICT 2 SURVEY OFFICE (USE ONLY)

PERSONNEL

REFERENCE NO. 22 A

SHEET 4 OF 15

NOTES CORDES

DATE 5/31/01

ROUTE SR 4

H.C. BROWN

WEATHER SUNNY

COUNTY SENECA

R.C. HOMAN

TEMP. 68°

TOWNSHIP REED

SECTION 12

DWG BY NASON

PID 107060

T 2 N R E

TYPE MONUMENT P.K./WASHER

ON SURFACE - ~~BELOW~~ ON

OFFSET CL PAVEMENT ON LT : RT
11' TO RT EDGE PAVEMENT


STATION: 575+44

HORIZ.DATUM: NAD83 (2011)


GEOID: 2012A

GRID: NORTHING: 537566.182

EASTING: 1871641.561

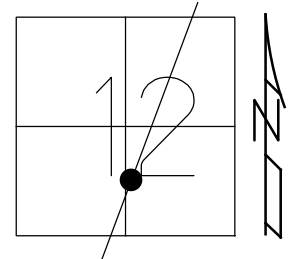


RECORD:
STA. 573+04.22
FD P.K./WASHER
ATOP R.R.SPIKE
5/21/87
SET P.K./WASHER
7/02/01, BWC
FD P.K./WASHER
REFA22
2/25/19, JFO
8/19/19, JFO

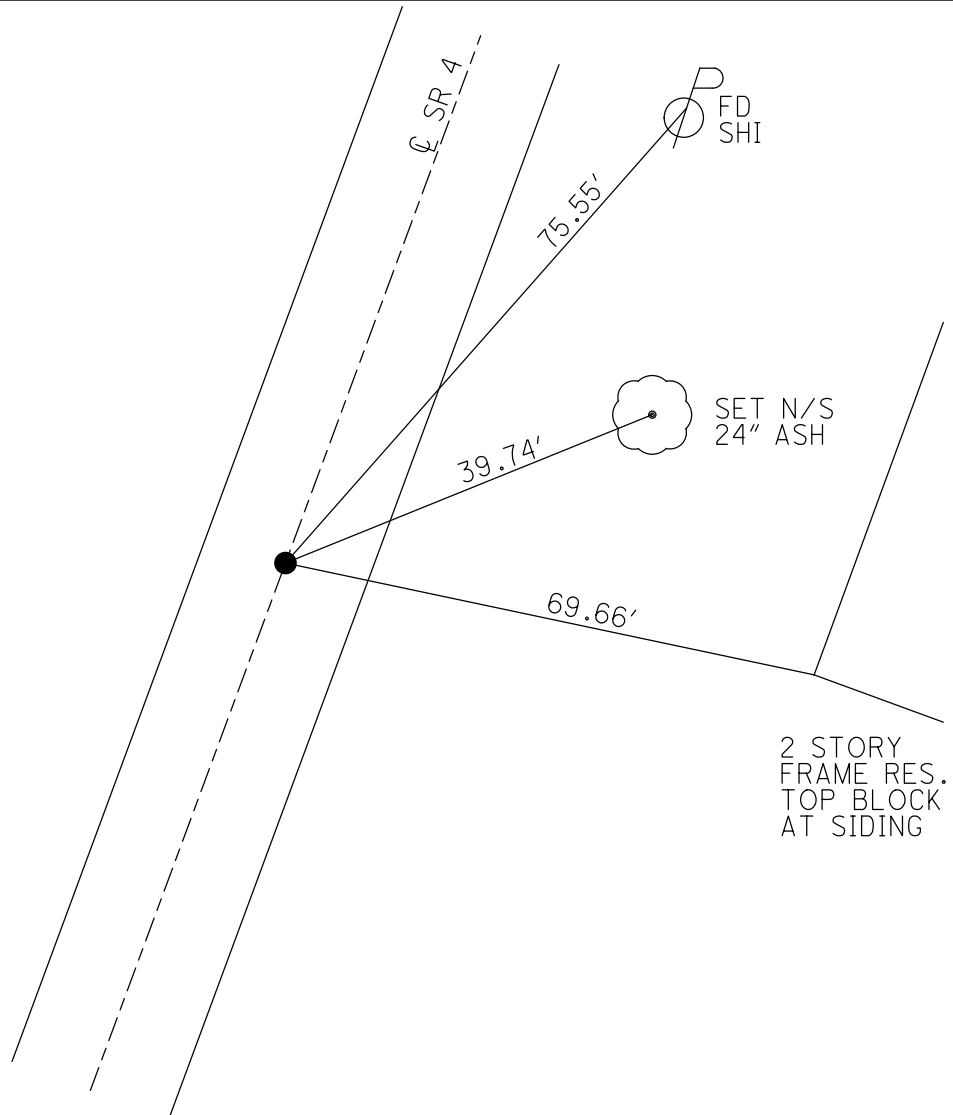

O.D.O.T. DISTRICT 2 SURVEY OFFICE (USE ONLY)


PERSONNEL	REFERENCE NO.	22 A	SHEET	45	OF	56
NOTES	CORDES	DATE	5/31/01	ROUTE	SR 4	
H.C.	BROWN	WEATHER	SUNNY	COUNTY	SENECA	
R.C.	HOMAN	TEMP.	68°	TOWNSHIP	REED	
				SECTION	12	
				T	2 N	R 17 E

TYPE MONUMENT P.K./WASHER
 ON SURFACE - ~~BELOW~~ ON
 LEFT - C PAV'T - RIGHT ON
11' TO RT. EDGE PAVEMENT
 S.L.M. 575+44
 GRID: NORTHING: _____ EASTING: _____

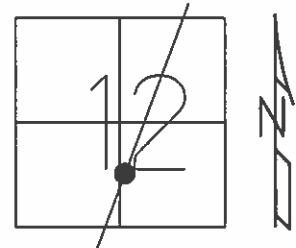

RECORD:
 STA. 573+04.22
 P.K./WASHER ATOP
 R.R.SPIKE, 5/21/87

SET P.K./WASHER
 7/02/01, BWC

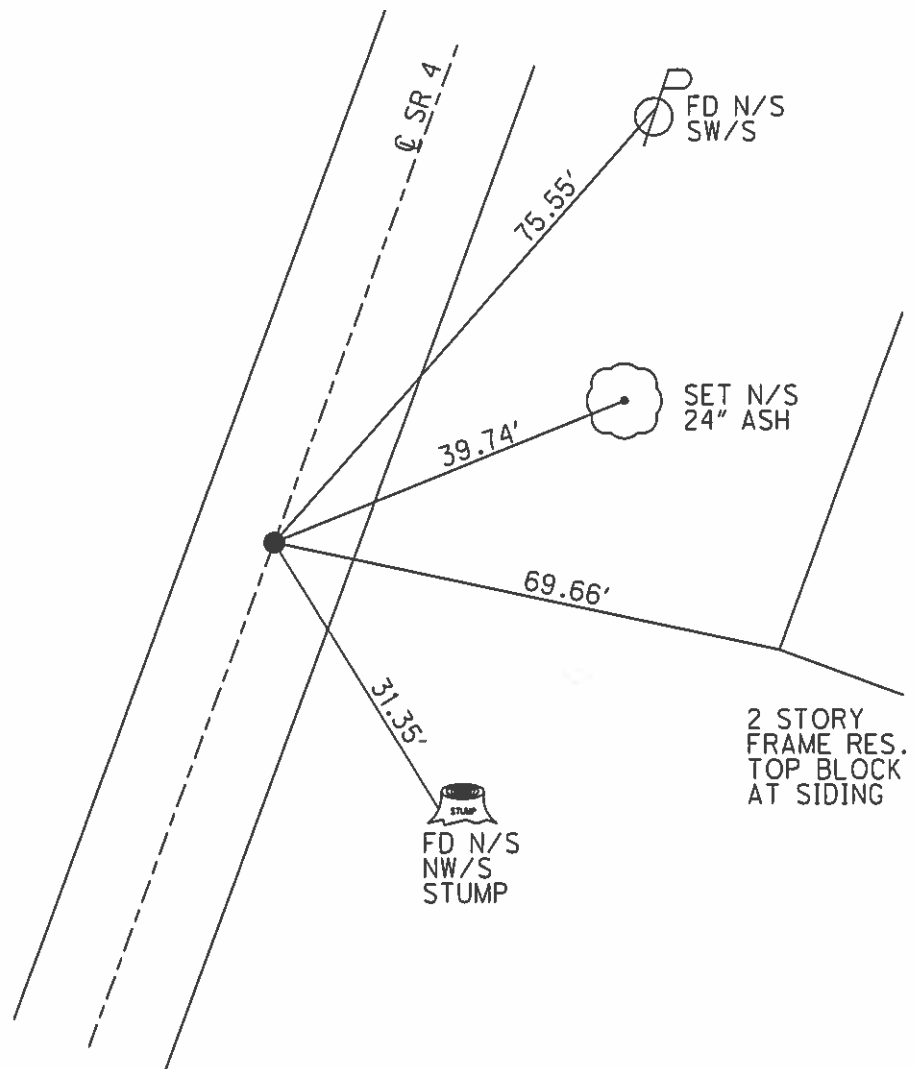

O.D.O.T. DISTRICT 2 SURVEY OFFICE

PERSONNEL

REFERENCE NO. 22-A

SHEET 10 OF 519

NOTES Cordes

H.C. Brown

R.C. Homan

DATE 5-31-01

WEATHER Sunny

TEMP. 68°

ROUTE 4

COUNTY Seneca

TOWNSHIP Reed

SECTION 12

T2 N R17 E


TYPE MONUMENT PK/Washer

ON SURFACE - ~~BELOW~~ On

~~LEFT - & PAV'T. - RIGHT~~ On

11' TO R+ EDGE PAVEMENT

S.L.M. 575+44

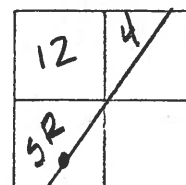


Record: 5-21-1987

P.O.T. Sta 573+04.22

PK/Washer Atop RR Spk

Set PK/Washer
7-2-01 BWC

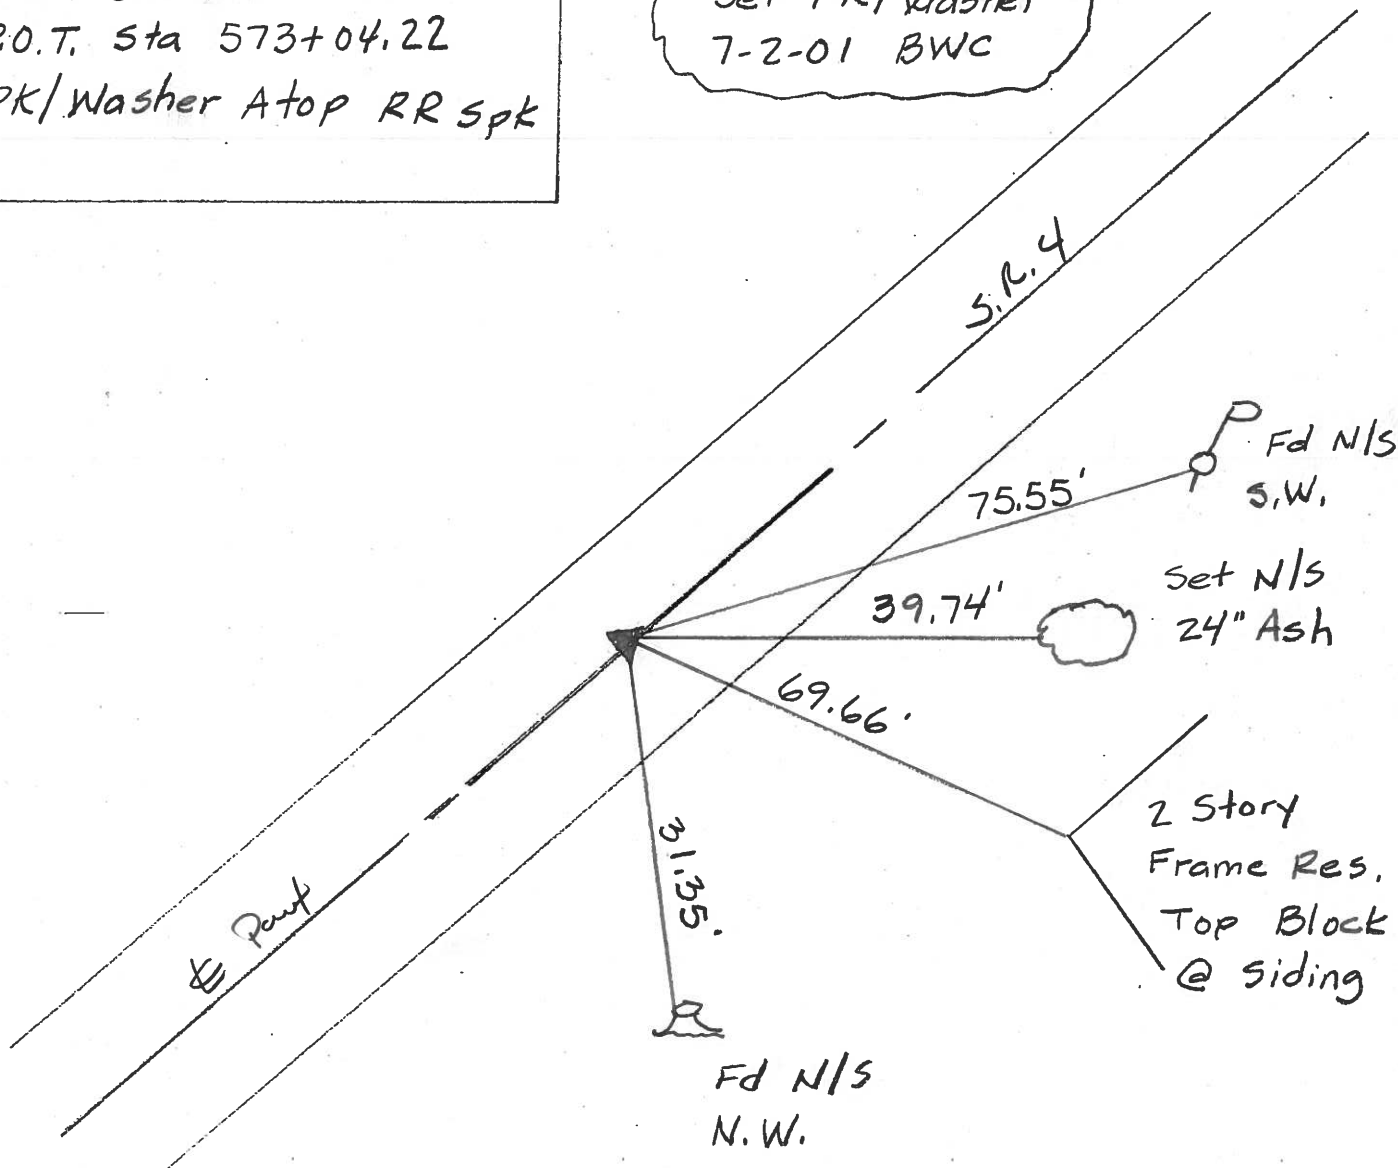

O.D.O.T. DISTRICT 2 SURVEY OFFICE

PERSONNEL

REFERENCE NO. 22-A

SHEET 41 OF 50

NOTES CHENEY

H.C. RIPPLE

R.C. BARBOUR

GEYMAN

DATE 7-27-1993

WEATHER FAIR

TEMP. 90°

ROUTE #4

COUNTY SENECA

TOWNSHIP REED

SECTION 12

T2N R17E


TYPE MONUMENT PK/WASHER

ON SURFACE - ~~BELOW~~ ON

~~LEFT - & PAW'T.~~ RIGHT ON

11' TO LT. EDGE PAVEMENT

S.L.M. 575+44

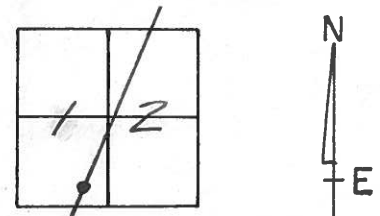


RECORD: 5-21-1987

P.O.T. STA. 573+04.22

R.R. SPK. 6.5" BELOW
SURFACE

SET PK/WASHER
10-13-1993
RCC

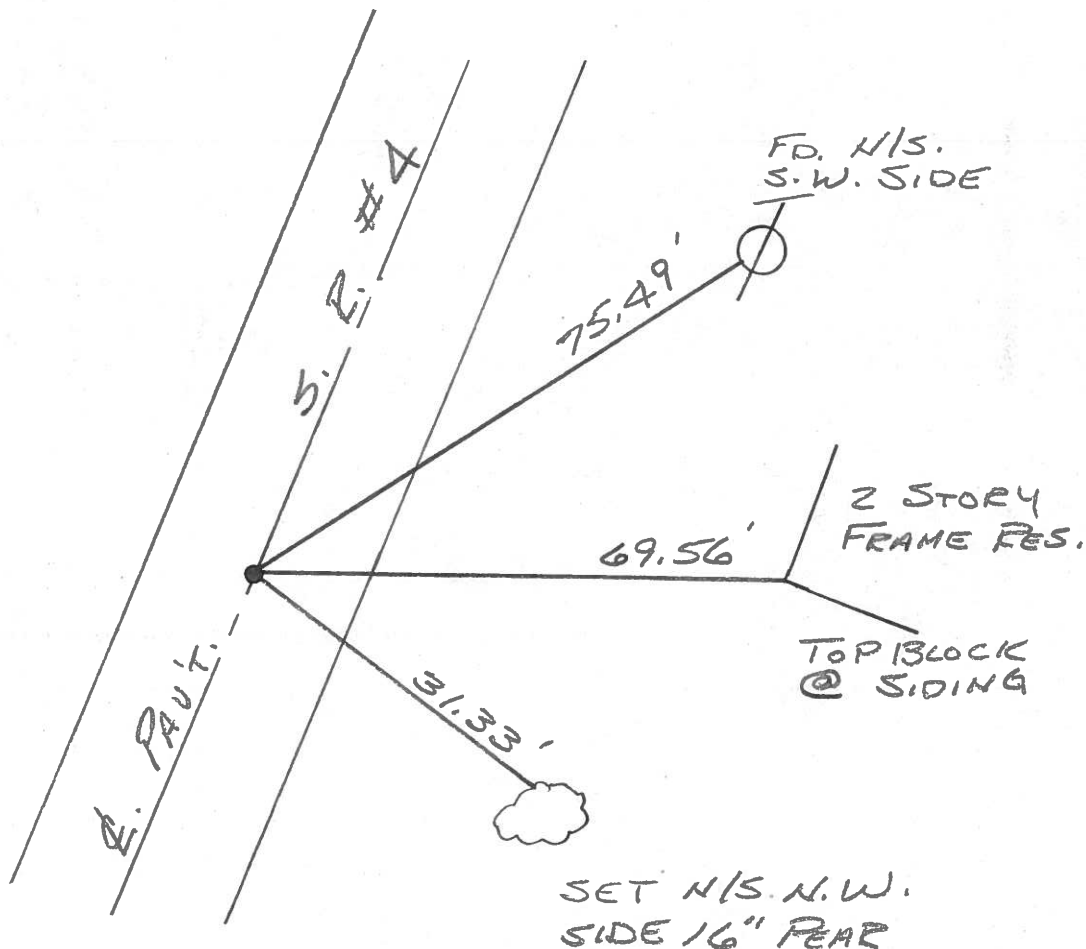

O.D.O.T. DISTRICT 2 SURVEY OFFICE

PERSONNEL

NOTES

H.C.

R.C.

REFERENCE NO.

DRAWN 12/09/87

DATE

WEATHER sunny

TEMP.

SHEET 16 OF

ROUTE

COUNTY

TOWNSHIP

SECTION

T 2 N R 17 E

TYPE MONUMENT P.K. & washer


ON SURFACE - BELOW on surface

LEFT - & PAW'T. - RIGHT & Part

TO EDGE PAVEMENT

S.L.M.

22A

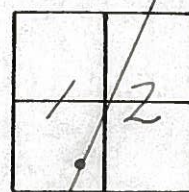

P.O.T.

573+04.22

R.R. spike 6 1/2"

below surface

2 S.R. #48

75.47'

69.61'


82.67'

2 story
frame

Top block
& siding



PERSONNEL	TITLE	PERSONNEL	TITLE	COUNTY	DATE
Schneider		Potts		Seneca	10-2-68
Mosser				S. R.	4
Barbour				WEATHER	Cloudy-Windy
Redding				SEC.	75°
DESCRIPTION				Ties for Control Points	
LEFT		CENTER LINE		RIGHT	
JOB NO.					

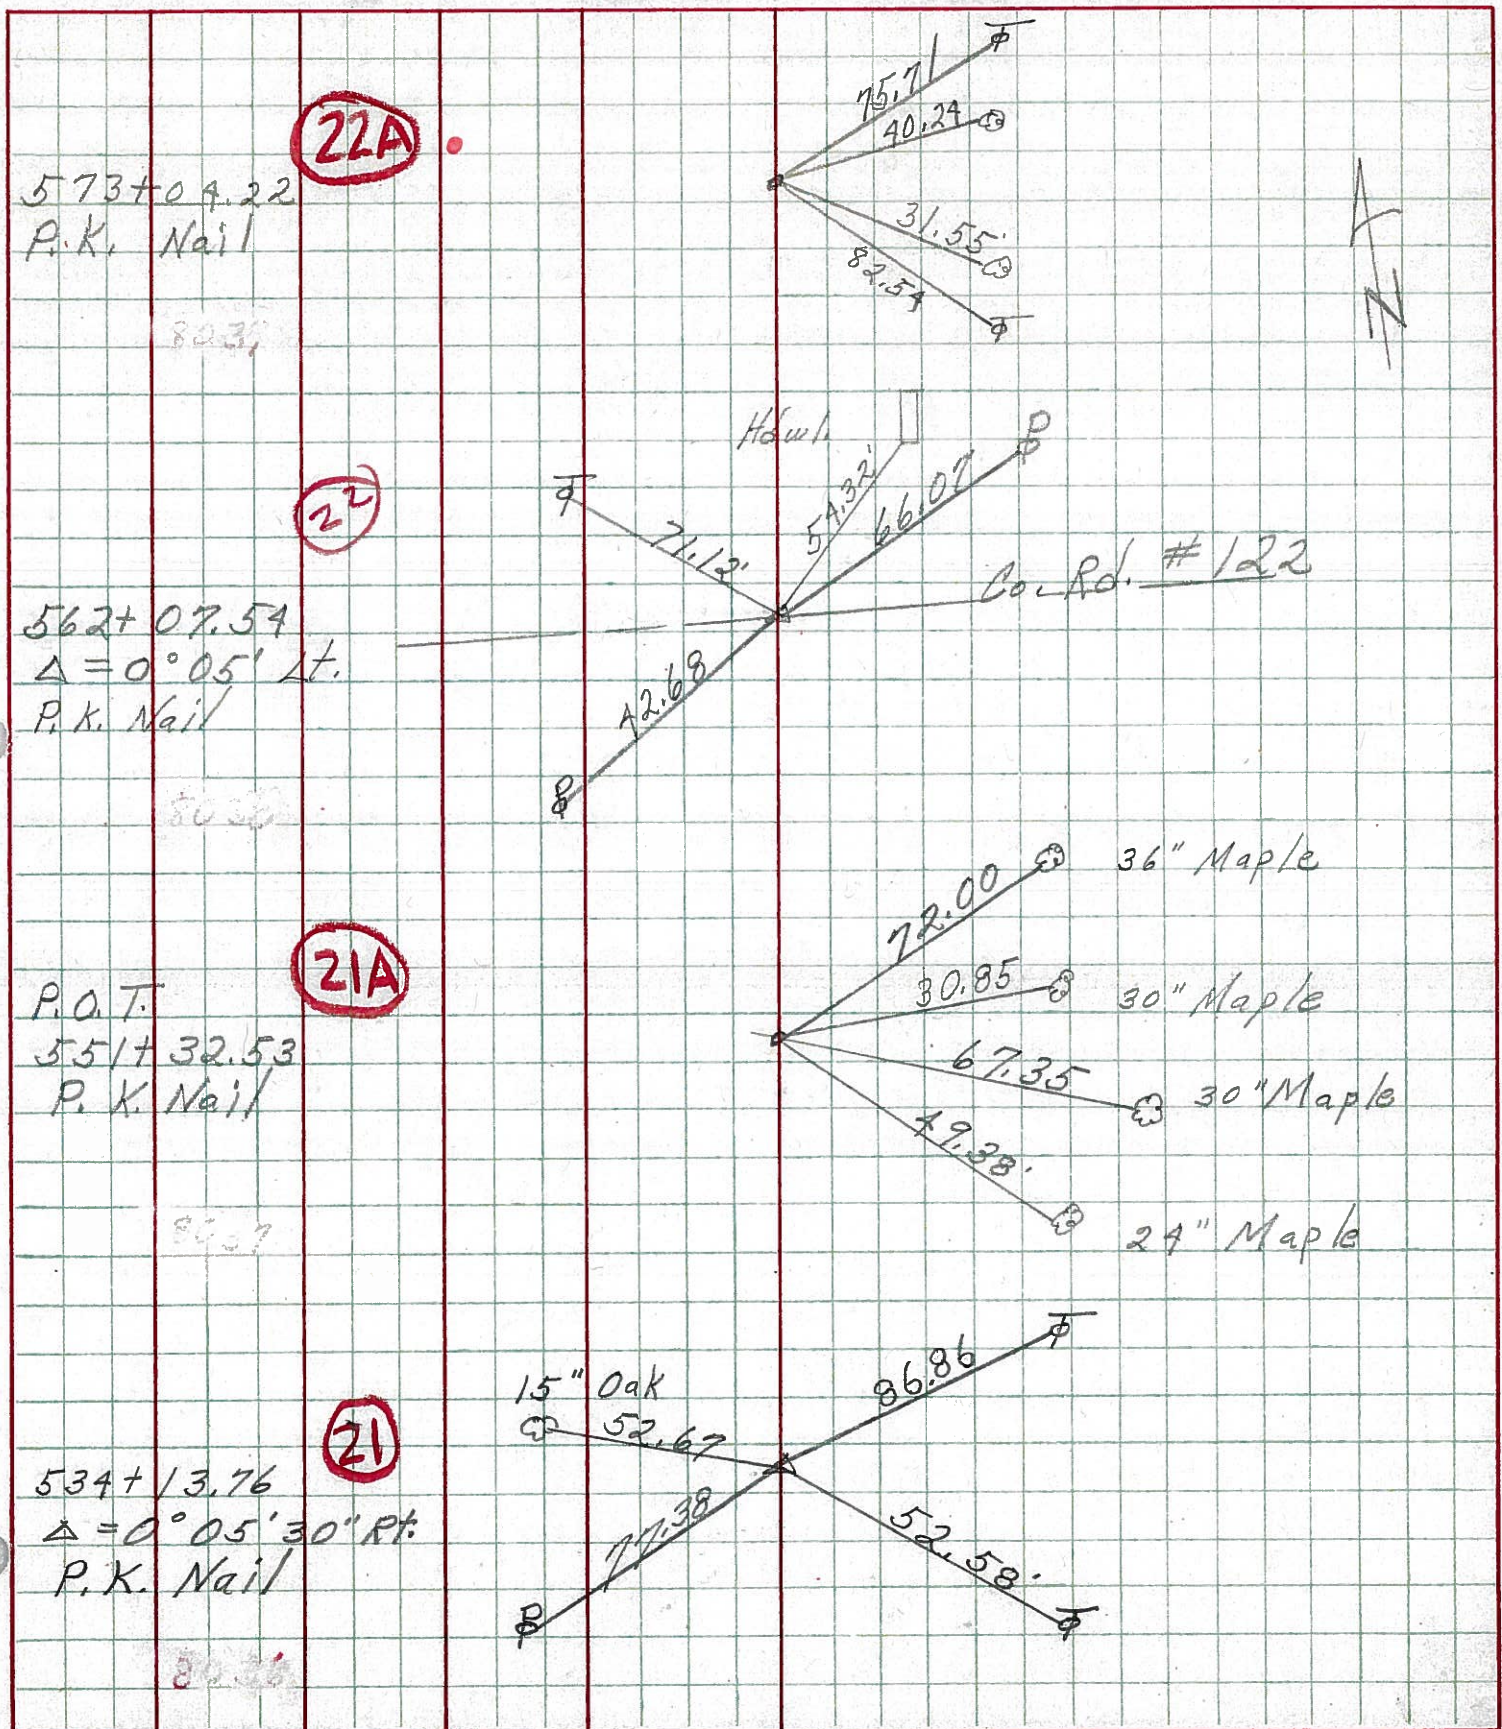

COUNTY Seneca DATE 10-2-68
S. R. 4 WEATHER Cloudy-Windy
SEC. _____ TEMP 75


Ties for Control Points

JOB NO

LEFT

CENTER LINE

RIGHT

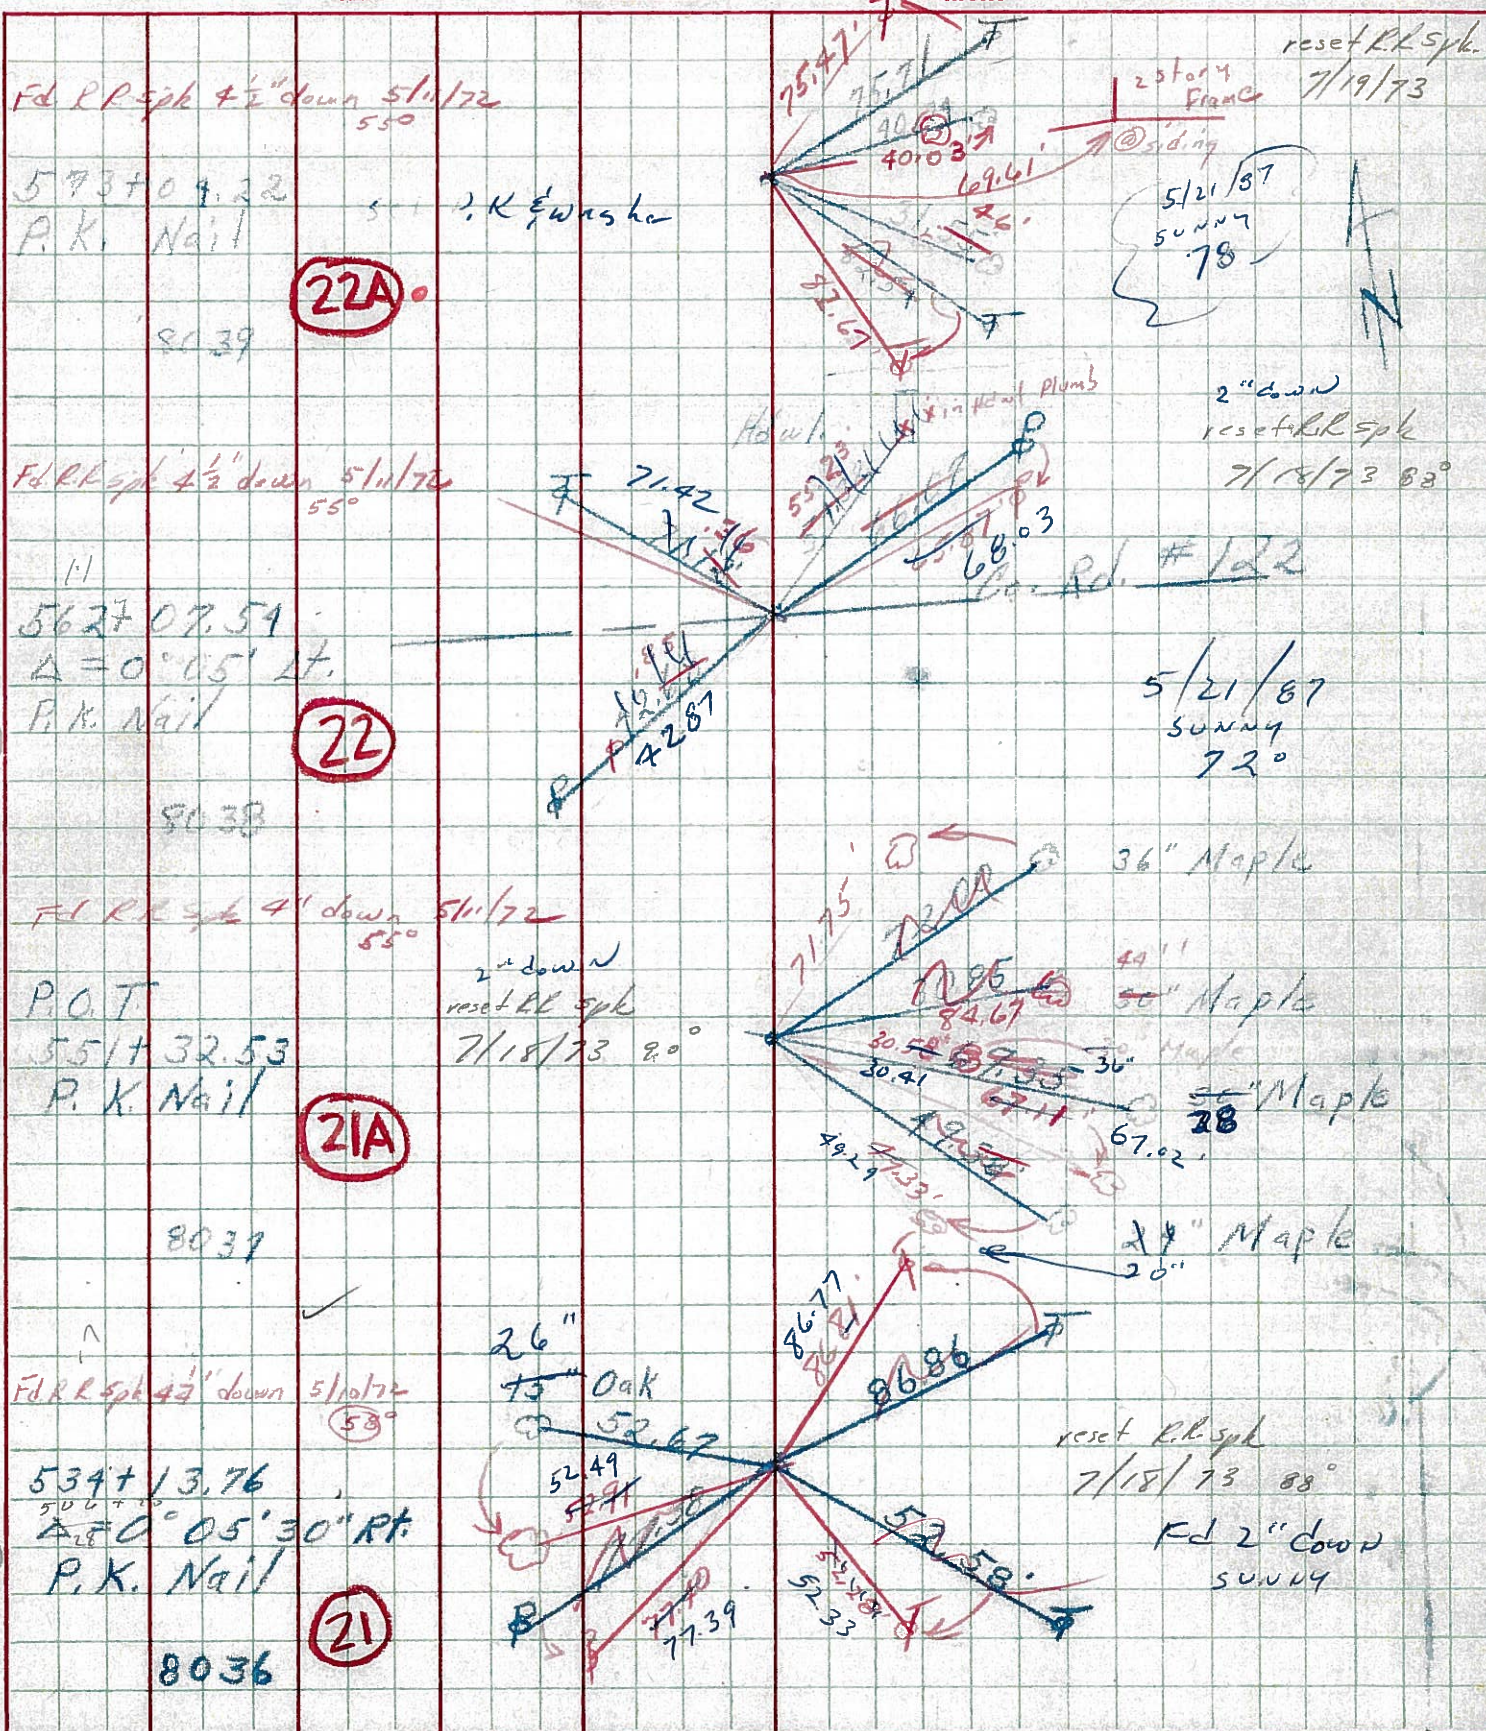JOB NO

PERSONNEL TITLE PERSONNEL TITLE

COUNTY Seneca

DATE

F. Krabill
T. Kowalewski
D. Brooks

S. R. 4

WEATHER

SEC.

TEMP.

DESCRIPTION

LEFT

CENTER LINE


RIGHT

JOB NO.

562+07.54 #261
P.I. $\Delta=0^{\circ}-05'-00''$ LT
P.k. nail


(22)

1-22-64

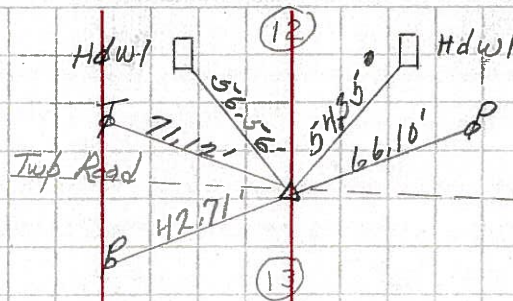573+04.22 #262
P.O.T. $\Delta=0^{\circ}-00'-00''$
P.k. nail


(22A)

1-22-64

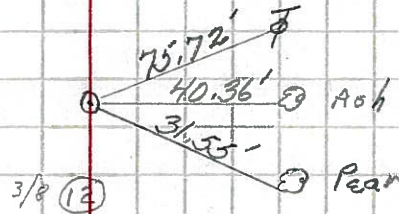590+16.14 #263
P.I. $\Delta=0^{\circ}-02'-00''$ LT
P.k. nail

(23)

1-22-64

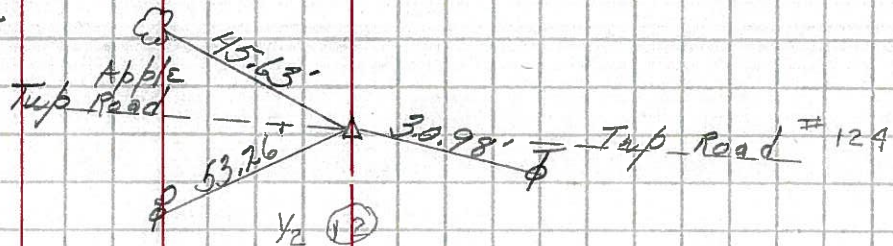612+75.21 #264
P.I. $\Delta=0^{\circ}-14'-00''$ RT
P.k. nail

(24)

1-22-64

