

O.D.O.T. DISTRICT 2 SURVEY OFFICE (USE ONLY)

PERSONNEL

REFERENCE NO. A

SHEET 1 OF 13

NOTES MILLER

DATE 4/26/23

ROUTE SR 18

H.C. MILLER

WEATHER CLEAR

COUNTY SENECA

R.C. RHOADES

TEMP. 57°

TOWNSHIP LOUDON

DWG BY RHOADES

PID 101280

SECTION 8

T 2 N R 13 E

TYPE MONUMENT P.K.NAIL

ON SURFACE - ~~BELOW~~ ON

OFFSET Q PAVEMENT ON LT : RT

- TO - EDGE PAVEMENT



STATION: 82+36

HORIZ.DATUM: SEN LDP

GEOID: NAVD88 2018

GRID: NORTHING: 310134.778

EASTING: 94703.491

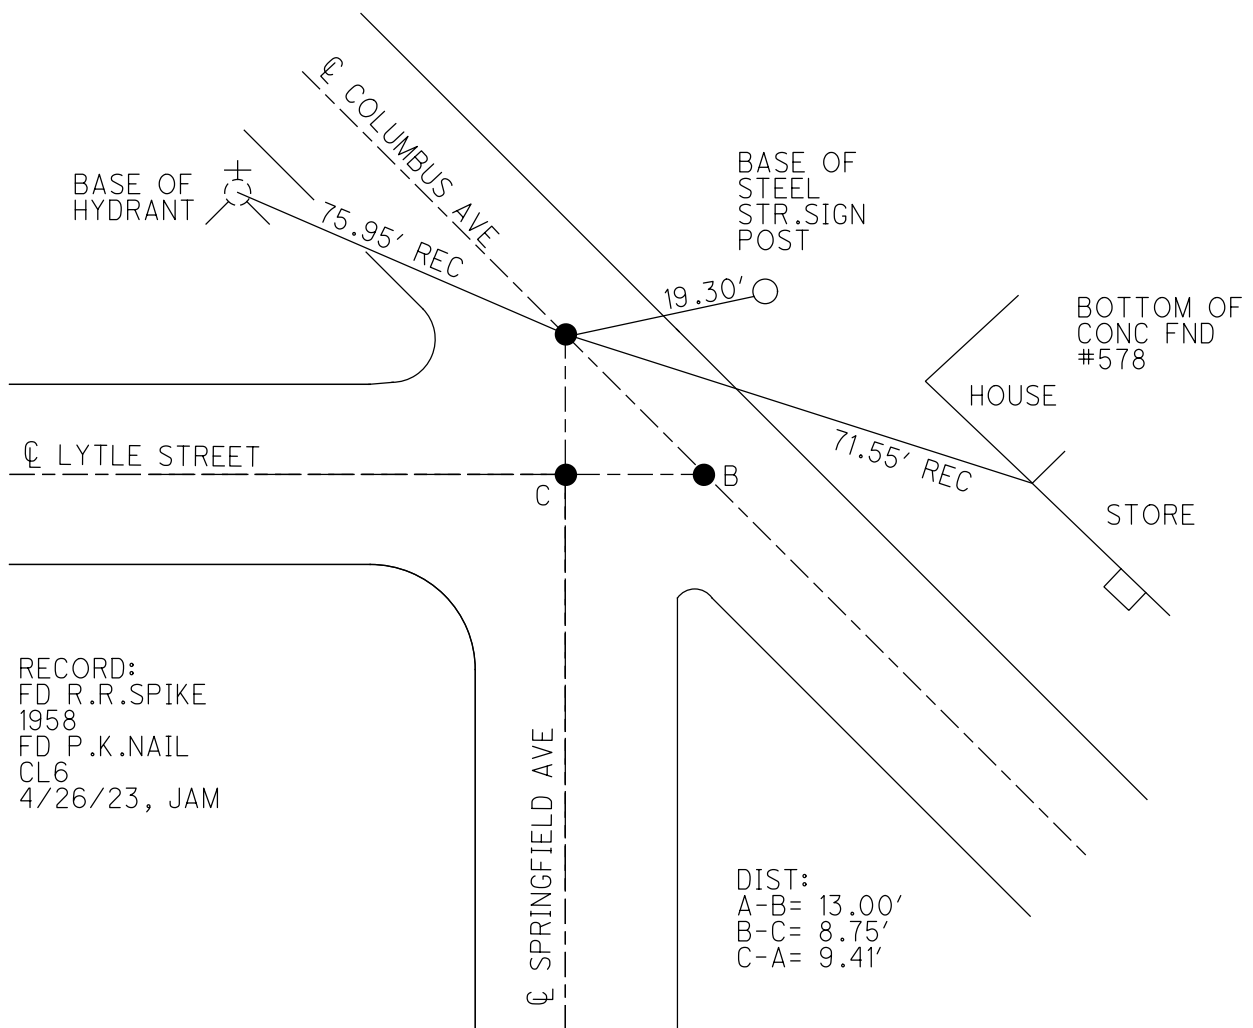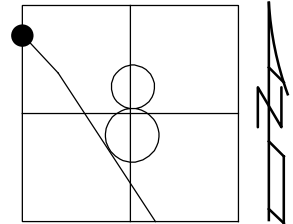

O.D.O.T. DISTRICT 2 SURVEY OFFICE (USE ONLY)

PERSONNEL

REFERENCE NO. B

SHEET 2 OF 13

NOTES MILLER

DATE 5/4/23

ROUTE SR 18

H.C. MILLER

WEATHER FAIR

COUNTY SENECA

R.C. RHOADES

TEMP. 51°

TOWNSHIP LOUDON

DWG BY RHOADES PID 101280

SECTION 8

T 2 N R 13 E

TYPE MONUMENT R.R.SPIKE

~~ON SURFACE~~ - BELOW 5"

OFFSET $\varnothing$ PAVEMENT ON LT : RT

- TO - EDGE PAVEMENT



STATION: 82+36

HORIZ.DATUM: SEN LPD

GEOID: NAVD88 2018

GRID: NORTHING: 310125.474

EASTING: 94712.292

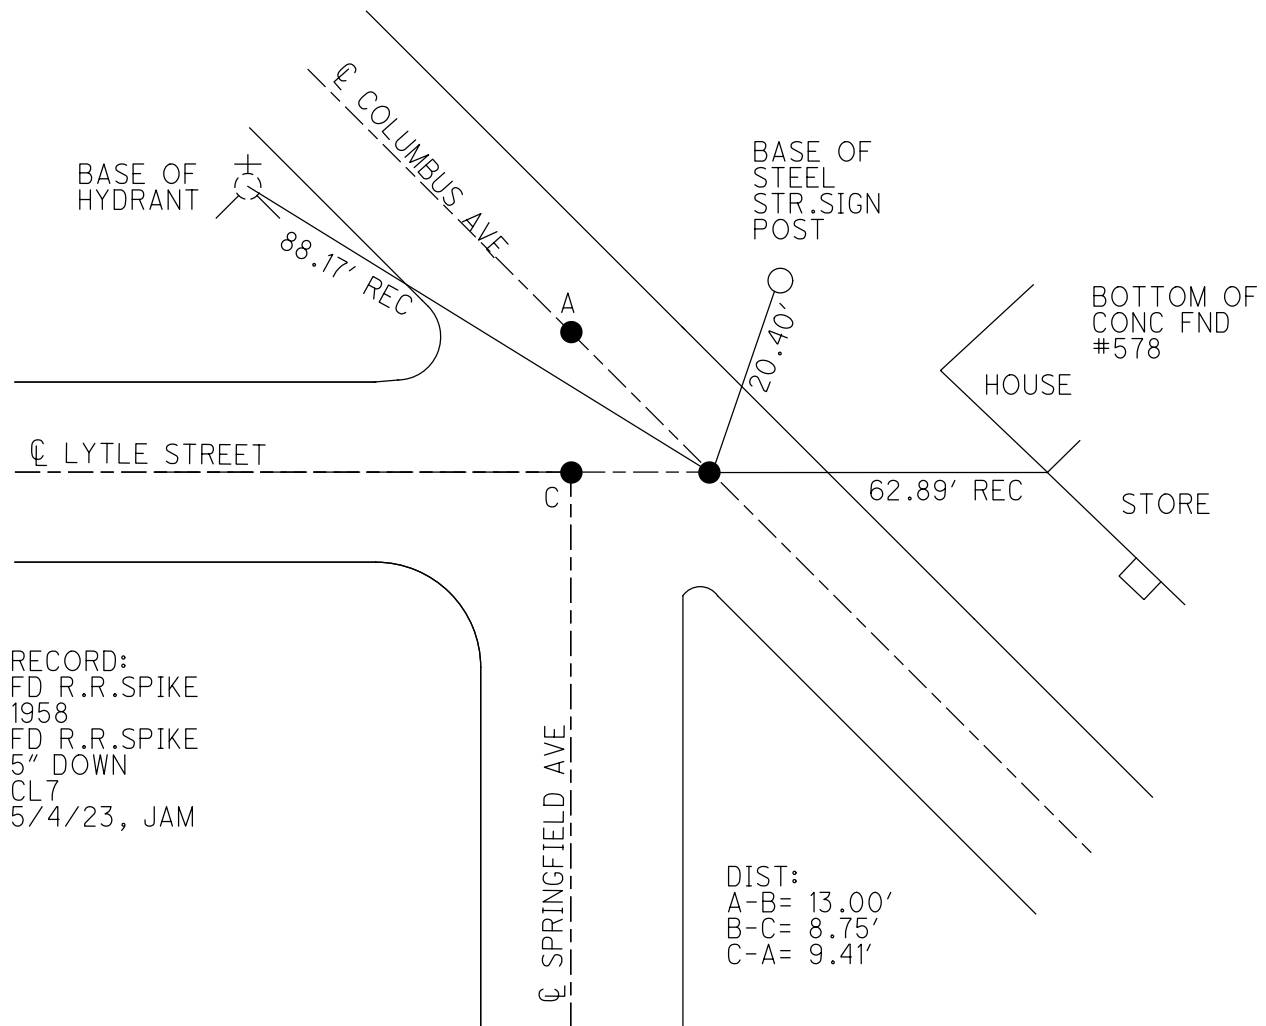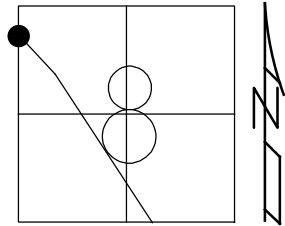

O.D.O.T. DISTRICT 2 SURVEY OFFICE (USE ONLY)

PERSONNEL

REFERENCE NO. C

SHEET 3 OF 13

NOTES MILLER

DATE 5/4/23

ROUTE SR 18

H.C. MILLER

WEATHER FAIR

COUNTY SENECA

R.C. RHOADES

TEMP. 51°

TOWNSHIP LOUDON

SECTION 8

DWG BY RHOADES PID 101280

T 2 N R 13 E

TYPE MONUMENT R.R.SPIKE

~~ON SURFACE~~ - BELOW 5"

OFFSET CL PAVEMENT ON LT : RT

- TO - EDGE PAVEMENT



STATION: 82+45

HORIZ.DATUM: SEN LDP

GEOID: NAVD88 2018

GRID: NORTHING: 310125.629

EASTING: 94703.537

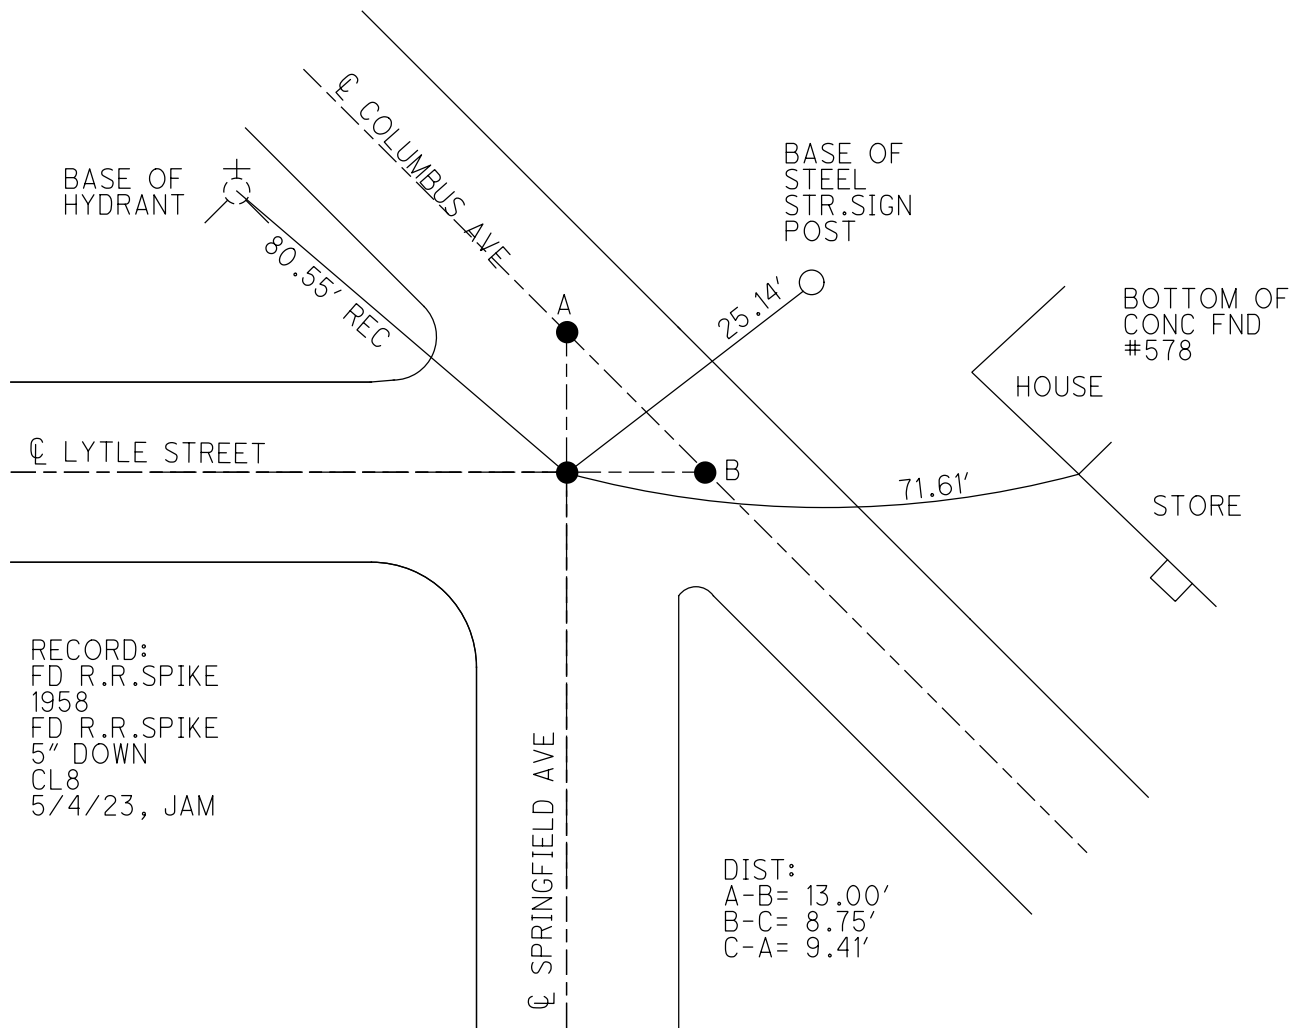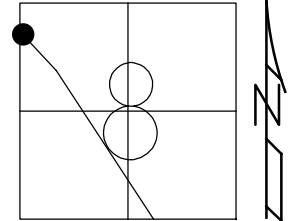

O.D.O.T. DISTRICT 2 SURVEY OFFICE (USE ONLY)

PERSONNEL

REFERENCE NO. D

SHEET 4 OF 13

NOTES MILLER

DATE 5/4/23

ROUTE SR 18

H.C. MILLER

WEATHER FAIR

COUNTY SENECA

R.C. RHOADES

TEMP. 51°

TOWNSHIP LOUDON

DWG BY RHOADES

PID 101280

SECTION 8

T 2 N R 13 E

TYPE MONUMENT R.R.SPIKE

ON SURFACE - ~~BELOW~~ ON

OFFSET Q PAVEMENT ON LT : RT

- TO - EDGE PAVEMENT



STATION: 83+95

HORIZ.DATUM: _____

GEOID: _____

GRID: NORTHING: _____

EASTING: _____

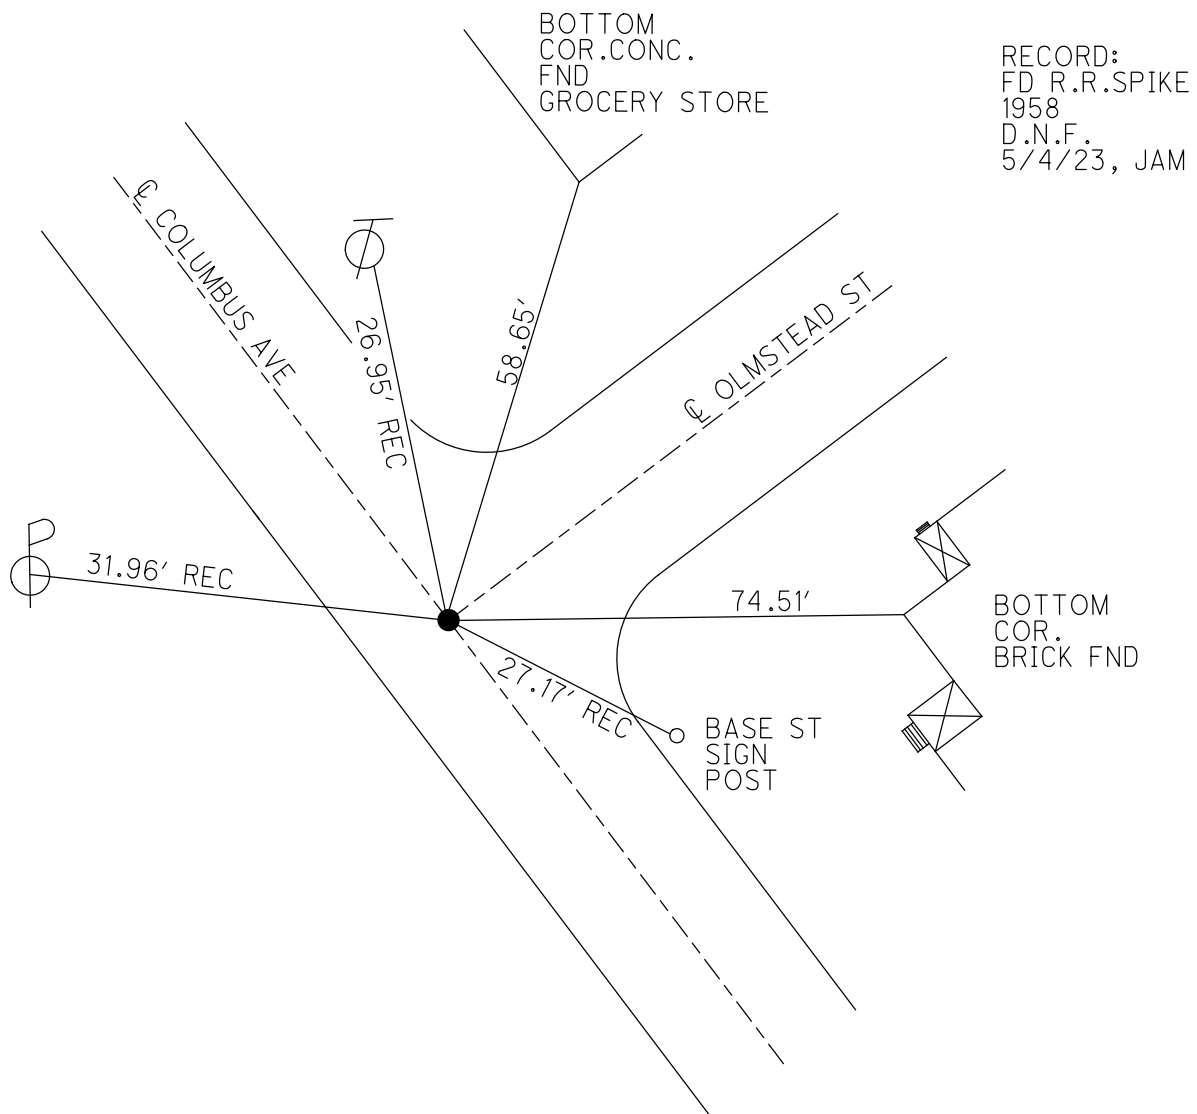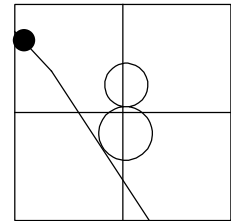

O.D.O.T. DISTRICT 2 SURVEY OFFICE (USE ONLY)

PERSONNEL

REFERENCE NO. E

SHEET 5 OF 13

NOTES MILLER

DATE 5/4/23

ROUTE SR 18

H.C. MILLER

WEATHER FAIR

COUNTY SENECA

R.C. RHOADES

TEMP. 51°

TOWNSHIP LOUDON

DWG BY RHOADES

PID 101280

SECTION 8

T 2 N R 13 E

TYPE MONUMENT R.R.SPIKE

~~ON SURFACE~~ - BELOW 6"

OFFSET CL PAVEMENT ON LT : RT

- TO - EDGE PAVEMENT



STATION: 86+59

HORIZ.DATUM: SEN LPD

GEOID: NAVD88 2018

GRID: NORTHING: 309805.329

EASTING: 95010.024

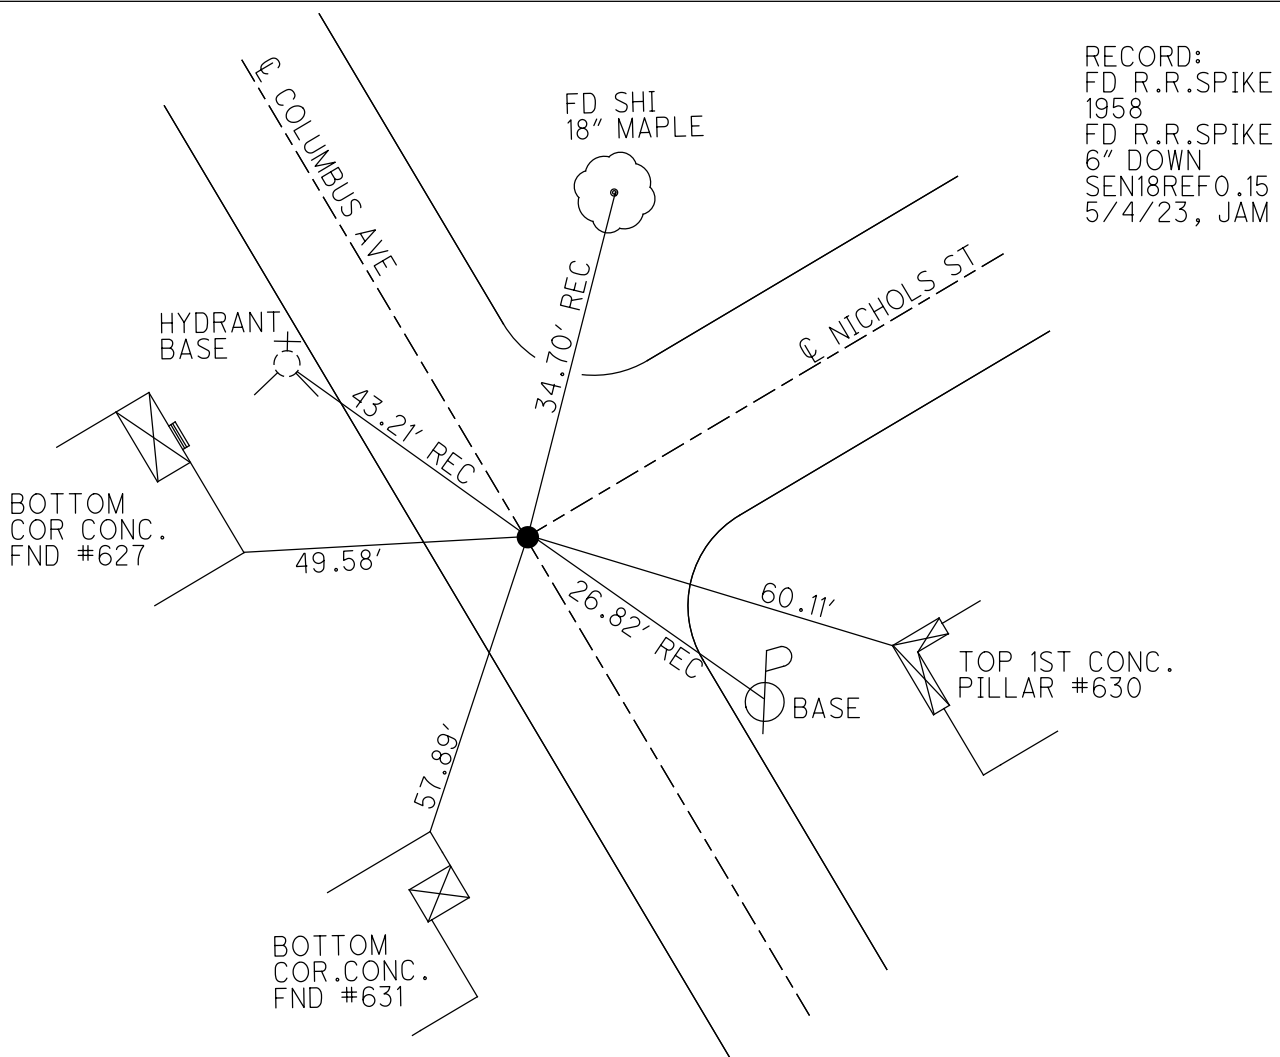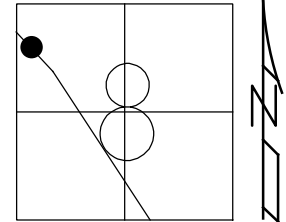

O.D.O.T. DISTRICT 2 SURVEY OFFICE (USE ONLY)

PERSONNEL

REFERENCE NO. F

SHEET 6 OF 13

NOTES MILLER

DATE 5/4/23

ROUTE SR 18

H.C. MILLER

WEATHER FAIR

COUNTY SENECA

R.C. RHOADES

TEMP. 51°

TOWNSHIP LOUDON

DWG BY RHOADES

PID 101280

SECTION 8

T 2 N R 13 E

TYPE MONUMENT R.R.SPIKE

~~ON SURFACE~~ - BELOW 6"

OFFSET Q PAVEMENT ON LT : RT

- TO - EDGE PAVEMENT



STATION: 89+76

HORZ.DATUM: SEN LPD

GEOID: NAVD88 2018

GRID: NORTHING: 309578.287

EASTING: 95221.255

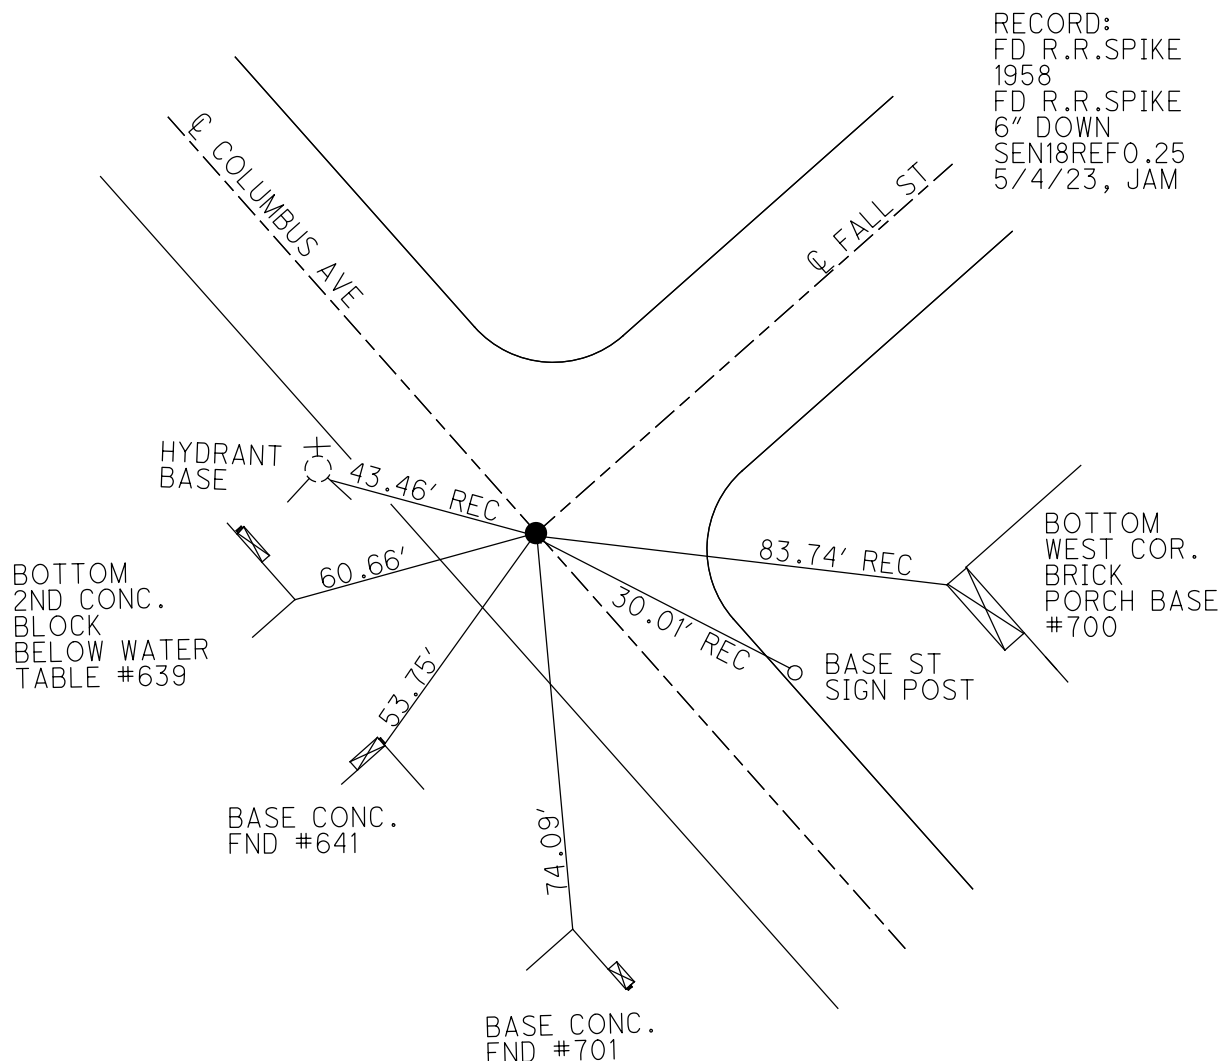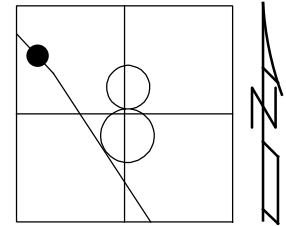

O.D.O.T. DISTRICT 2 SURVEY OFFICE (USE ONLY)

PERSONNEL

REFERENCE NO. G

SHEET 7 OF 13

NOTES MILLER DATE 4/27/23

H.C. MILLER WEATHER SUNNY

R.C. RHOADES TEMP. 44°

ROUTE SR 18

COUNTY SENECA

TOWNSHIP LOUDON

SECTION 8

T 2 N R 13 E

DWG BY RHOADES PID 101280

TYPE MONUMENT MAG NAIL

ON SURFACE - ~~BELOW~~ ON

OFFSET CL PAVEMENT 5' LT : ~~RT~~

7' TO LT EDGE PAVEMENT


STATION: 94+99 ±

HORZ.DATUM: SEN LPD

GEOID: NAVD88 2018

GRID: NORTHING: 309146.509

EASTING: 95623.424

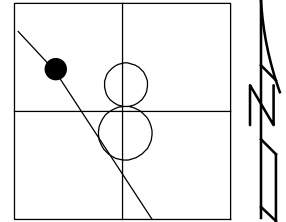

1350.165'
TO P.K.
@ SPRINGFIELD ST
INTERSECTION

PARKING
LOT

#716

RECORD:
FD MAG NAIL
REFSEN18REF0.5
4/27/23, JAM

DIST. G-1= 511.86'

O.D.O.T. DISTRICT 2 SURVEY OFFICE (USE ONLY)

PERSONNEL

REFERENCE NO. 1

SHEET OF

NOTES ASTON

DATE 4/5/24

ROUTE SR 18

H.C. NIESE

WEATHER BREEZY

COUNTY SENECA

R.C. MILLER

TEMP. 37°

TOWNSHIP LOUDON

RHODES

SECTION 8

DWG BY BARRIERE

PID 92371

T 2 N R 13 E

TYPE MONUMENT PK NAIL

ON SURFACE - BELOW 1.5" DOWN

OFFSET $\odot$ PAVEMENT LT : RT

 TO EDGE PAVEMENT

STATION: 100+19.70

HORZ.DATUM: NAD83 (2011)


GEOID: 18

GRID: NORTHING: 540438.983

EASTING: 1721355.349


LDP: NORTHING:

EASTING:

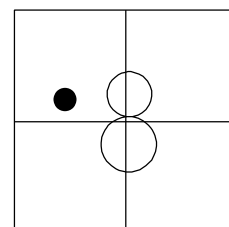

RECORD:
STA 87+93.95

FD P.K./WASHER
ATOP R.R. SPIKE
FD P.K./WASHER
7/10/97, MRC
SET P.K./WASHER
9/10/97, MRC
FD PK SHANK
REF1
9/21/22, TDN
FD PK NAIL
1 1/2" DOWN
4/5/24, TDN

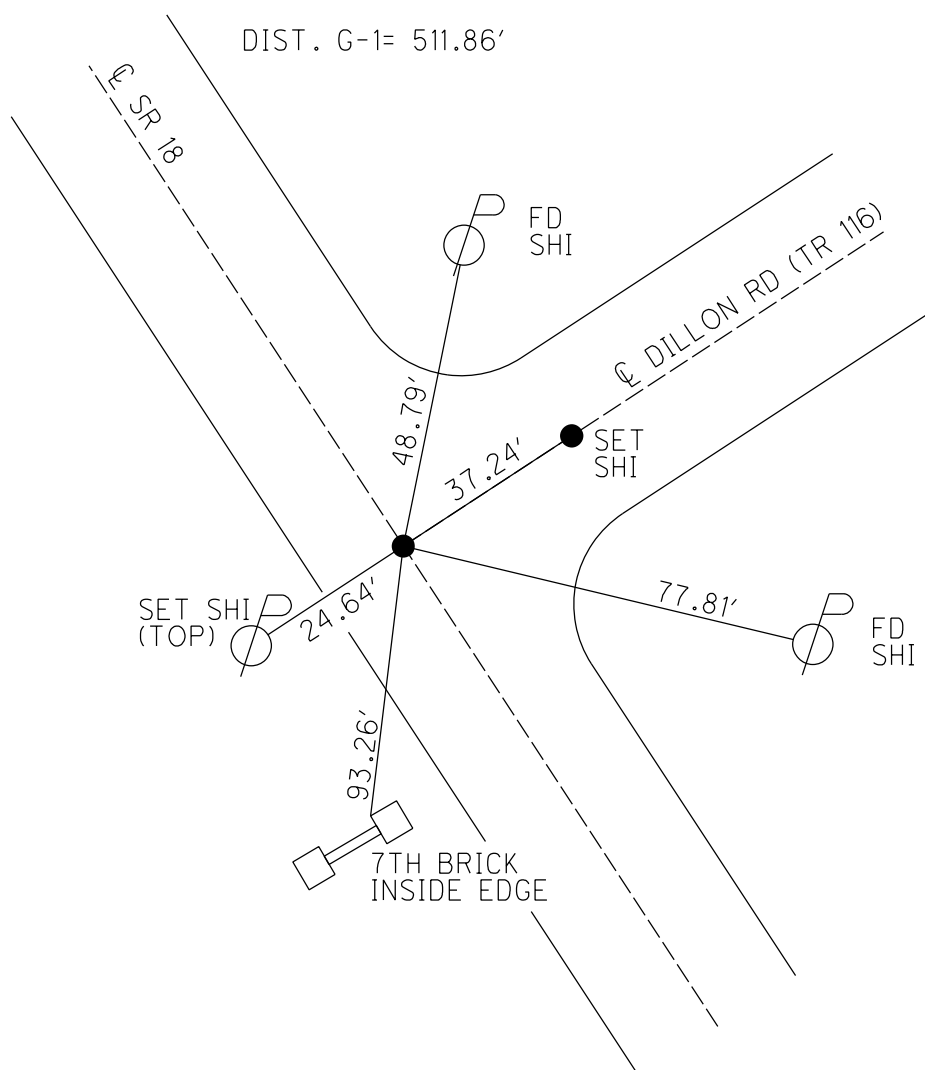

O.D.O.T. DISTRICT 2 SURVEY OFFICE (USE ONLY)

PERSONNEL

REFERENCE NO. 2

SHEET OF

NOTES ASTON

DATE 4/5/24

ROUTE SR 18

H.C. NIESE

WEATHER BREEZY

COUNTY SENECA

R.C. MILLER

TEMP. 37°

TOWNSHIP LOUDON

DWG BY BARRIERE

PID 92371

SECTION 8

T 2 N R 13 E

TYPE MONUMENT MAG NAIL

ON SURFACE - BELOW ON

OFFSET Q PAVEMENT 4.1' LT LT : RT

 TO EDGE PAVEMENT

STATION: 107+19.2

HORZ.DATUM: NAD83 (2011)


GEOID: 18

GRID: NORTHING: 539843.760

EASTING: 1721734.618


LDP: NORTHING:

EASTING:

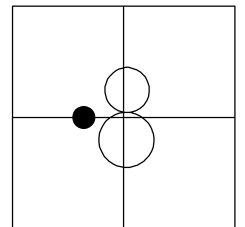

RECORD: P.I.
 $\Delta = 00^{\circ} 23' 00''$ RT

FD P.K./WASHER
ATOP P.K./WASHER
ATOP R.R. SPIKE,
FD SM.R.R.SPIKE,
2" DOWN
7/10/97, MRC
SET P.K./WASHER
9/10/97, MRC
FD MAG NAIL
REF2
9/21/22, TDN
4/5/24, TDN

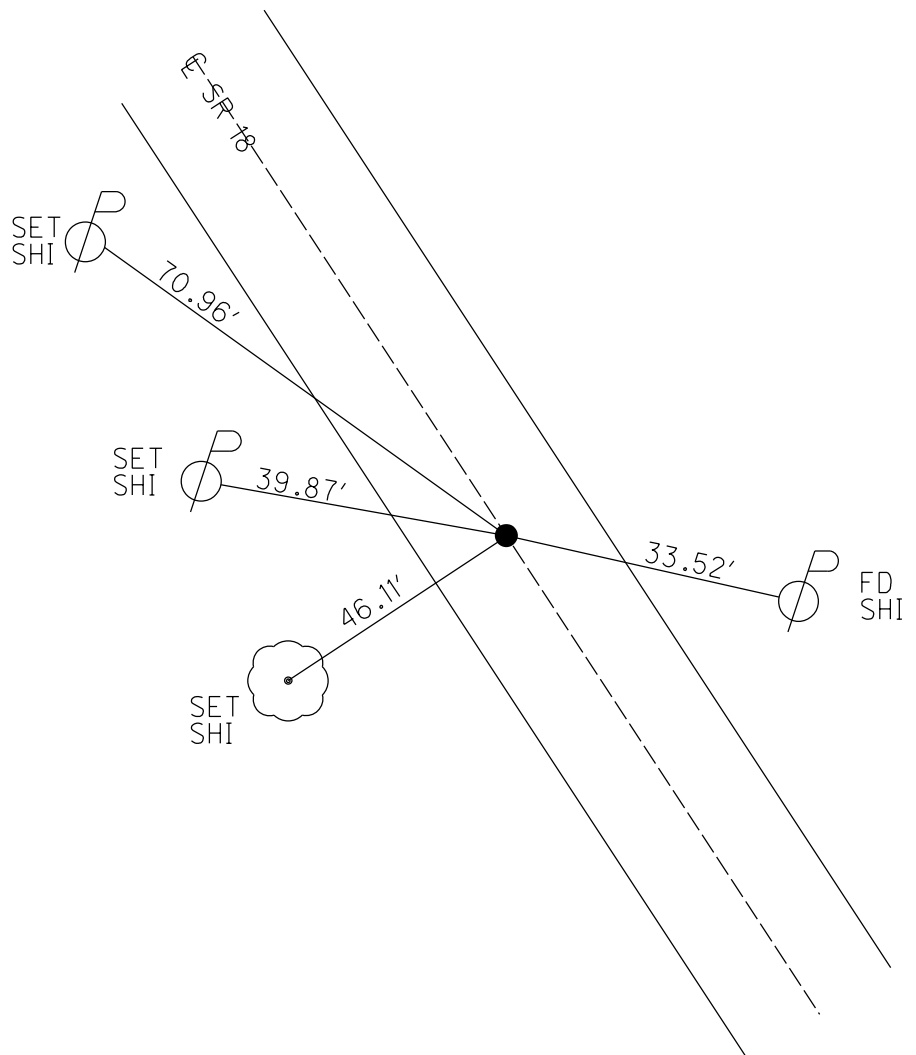

O.D.O.T. DISTRICT 2 SURVEY OFFICE (USE ONLY)

PERSONNEL

REFERENCE NO. 3

SHEET OF

NOTES ASTON

DATE 4/5/24

ROUTE SR 18

H.C. NIESE

WEATHER BREEZY

COUNTY SENECA

R.C. MILLER

TEMP. 40°

TOWNSHIP LOUDON

DWG BY BARRIERE

PID 92371

SECTION 8

T 2 N R 13 E

TYPE MONUMENT P.K. NAIL

ON SURFACE - BELOW ON

OFFSET $\mathcal{Q}$ PAVEMENT ON LT : RT

 TO EDGE PAVEMENT

STATION: 115+19.03

HORZ.DATUM: NAD83 (2011)


GEOID: 18

GRID: NORTHING: 539171.465


EASTING: 1722155.838

LDP: NORTHING:

EASTING:

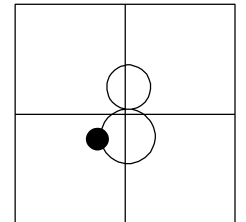

RECORD: P.O.T.
STA 102+93.51
FD P.K./WASHER
ATOP R.R. SPIKE
INTERSECTION OF
 $\mathcal{Q}$ SURVEY AND
 $\mathcal{Q}$ CONSTRUCTION
FD P.K./WASHER
7/10/97, MRC
SET P.K./WASHER
9/10/97, MRC
7/10/97, MRC
FD PK WASHER
REF3
9/21/22, TDN
FD PK
4/5/24, TDN

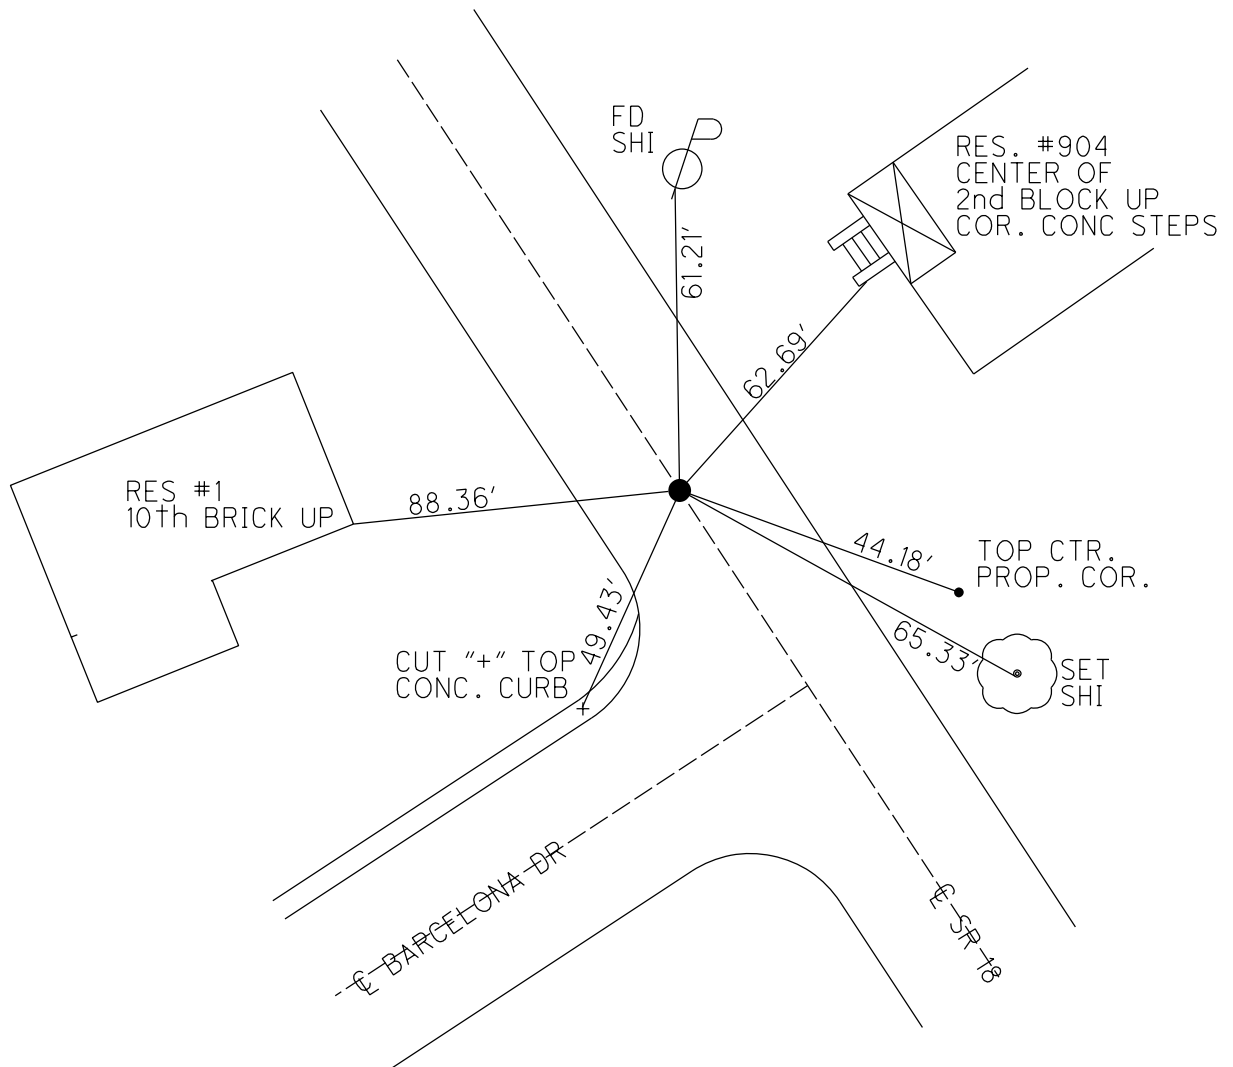

O.D.O.T. DISTRICT 2 SURVEY OFFICE (USE ONLY)

PERSONNEL

REFERENCE NO. A3

SHEET OF

NOTES MILLER

DATE 8/5/24

ROUTE SR 18

H.C. NIESE

WEATHER BREEZY

COUNTY SENECA

R.C. PRESTON-COLVIN

TEMP. 80°

TOWNSHIP LOUDON

ASTON

SECTION 8

DWG BY BARRIERE

PID 92371

T 2 N R 13 E

TYPE MONUMENT MAG NAIL

ON SURFACE - BELOW ON

OFFSET Q PAVEMENT 8.3' RT LT : RT

 TO EDGE PAVEMENT

STATION: 128+14.63

HORZ.DATUM: NAD83 (2011)


GEOID: 18

GRID: NORTHING: 538067.681

EASTING: 1722847.906

LDP: NORTHING:


EASTING:

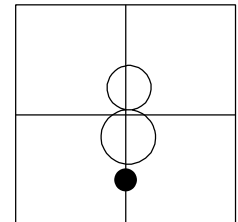

RECORD:
POINT UNKNOWN
FD P.K./WASHER
7/10/97, MRC
SET P.K./WASHER
9/10/97, MRC
FD PK WASHER
REFA3
9/21/22, TDN
FD PK
4/5/24, TDN
SET MAG/WASHER
8/5/24

DIST A3-4= 7.55'
DIST A3-3AA= 0.36'
DIST 3AA-4= 7.72'

RECORD:
UNKNOWN POINT
FD MAG NAIL
REF 3AA
4/5/24

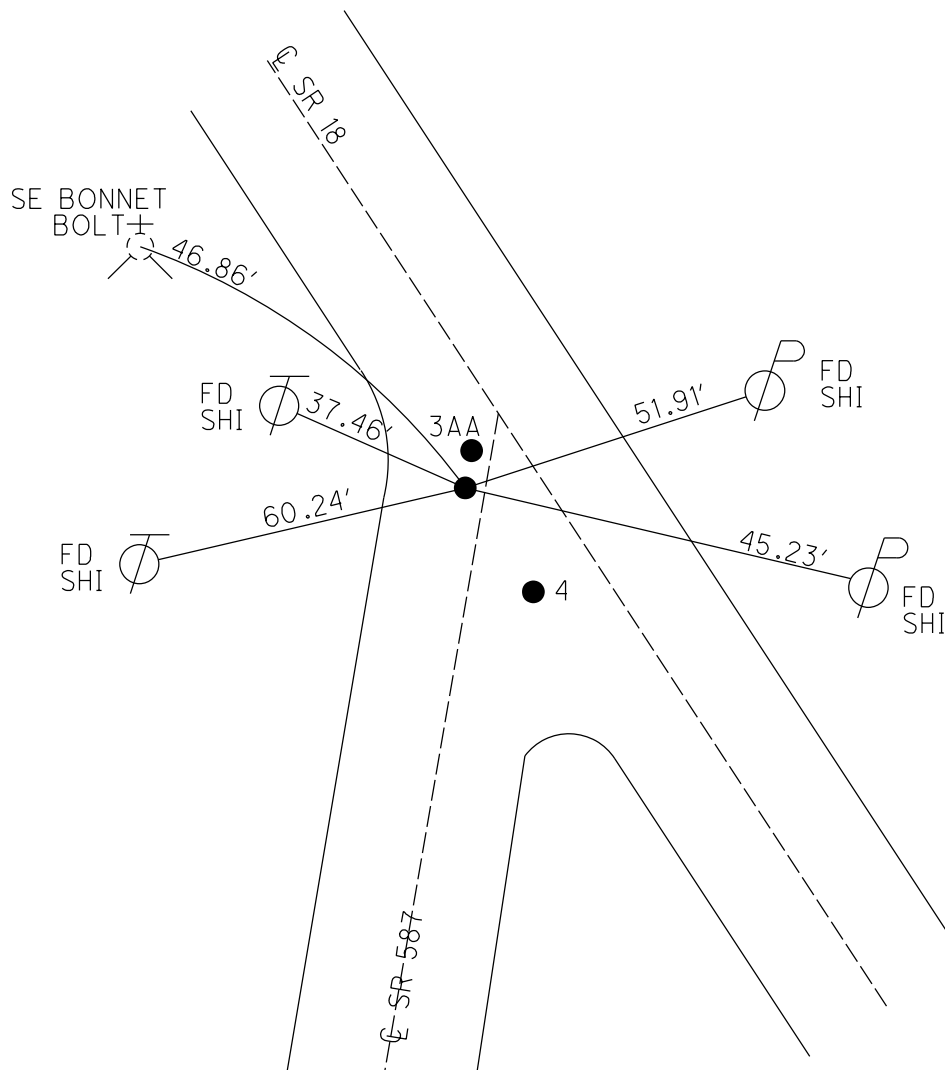

O.D.O.T. DISTRICT 2 SURVEY OFFICE (USE ONLY)

PERSONNEL

REFERENCE NO. 3AA

SHEET OF

NOTES MILLER

DATE 8/5/24

ROUTE SR 18

H.C. NIESE

WEATHER BREEZY

COUNTY SENECA

R.C. PRESTON-COLVIN

TEMP. 80°

TOWNSHIP LOUDON

ASTON

SECTION 8

DWG BY BARRIERE

PID 92371

T 2 N R 13 E

TYPE MONUMENT MAG NAIL

ON SURFACE - BELOW ON

OFFSET Q PAVEMENT 8.1' RT LT : RT

 TO EDGE PAVEMENT

STATION: 128+14.63

HORZ.DATUM: NAD83 (2011)


GEOID: 18

GRID: NORTHING: 538067.681

EASTING: 1722847.906


LDP: NORTHING:

EASTING:

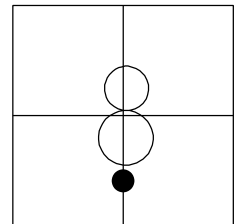

RECORD:
UNKNOWN POINT
FD MAG NAIL
REF 3AA
4/5/24

DIST A3-4= 7.47'
DIST A3-3AA= 0.36'
DIST 3AA-4= 7.72'

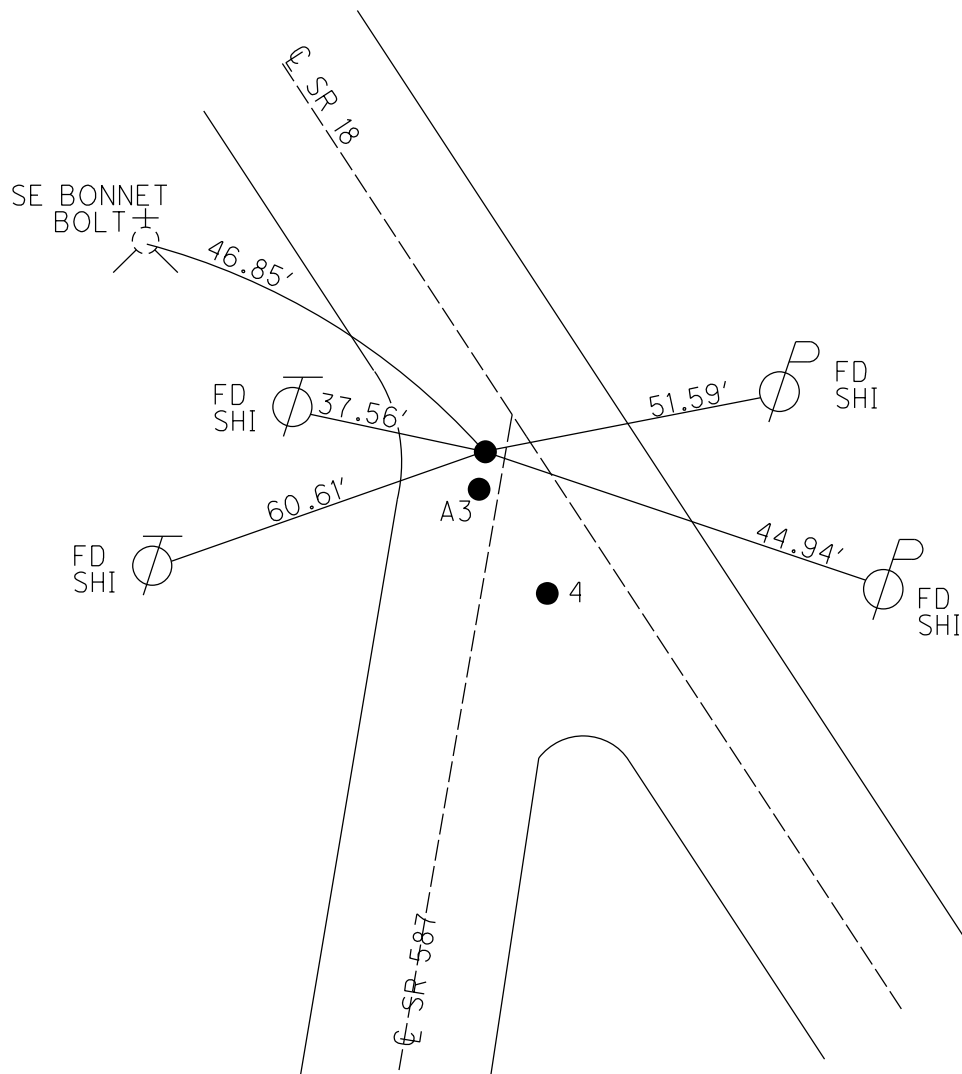

O.D.O.T. DISTRICT 2 SURVEY OFFICE (USE ONLY)

PERSONNEL

REFERENCE NO. 4

SHEET OF

NOTES MILLER DATE 8/5/24

H.C. NIESE WEATHER CLOUDY

R.C. PRESTON-COLVIN TEMP. 80°

ASTON

ROUTE SR 18

COUNTY SENECA

TOWNSHIP LOUDON

SECTION 8

DWG BY BARRIERE PID 92371

T 2 N R 13 E

TYPE MONUMENT MAG NAIL

ON SURFACE - BELOW ON

OFFSET $\odot$ PAVEMENT 8.3' RT LT : RT

 TO EDGE PAVEMENT

STATION: 128+22.18

HORZ.DATUM: NAD83 (2011)


GEOID: 18

GRID: NORTHING: 538061.428

EASTING: 1722851.926


LDP: NORTHING:

EASTING:

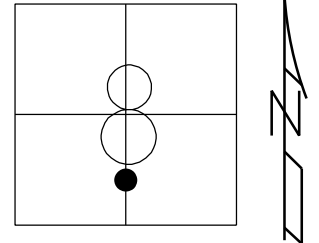

RECORD: P.I.
STA 115+96.07
 $\Delta = 00^{\circ}47'00''$ LT
FD P.K./WASHER
7/10/97, MRC
SET P.K./WASHER
9/10/97, MRC
FD PK NAIL
1" DOWN
9/21/22, TDN
FD RRSPK 6" DOWN
NEWREF4
4/5/24, TDN
SET MAG/WASHER
8/5/24

DIST A3-4= 7.47'
DIST A3-3AA= 0.36'
DIST 3AA-4= 7.72'

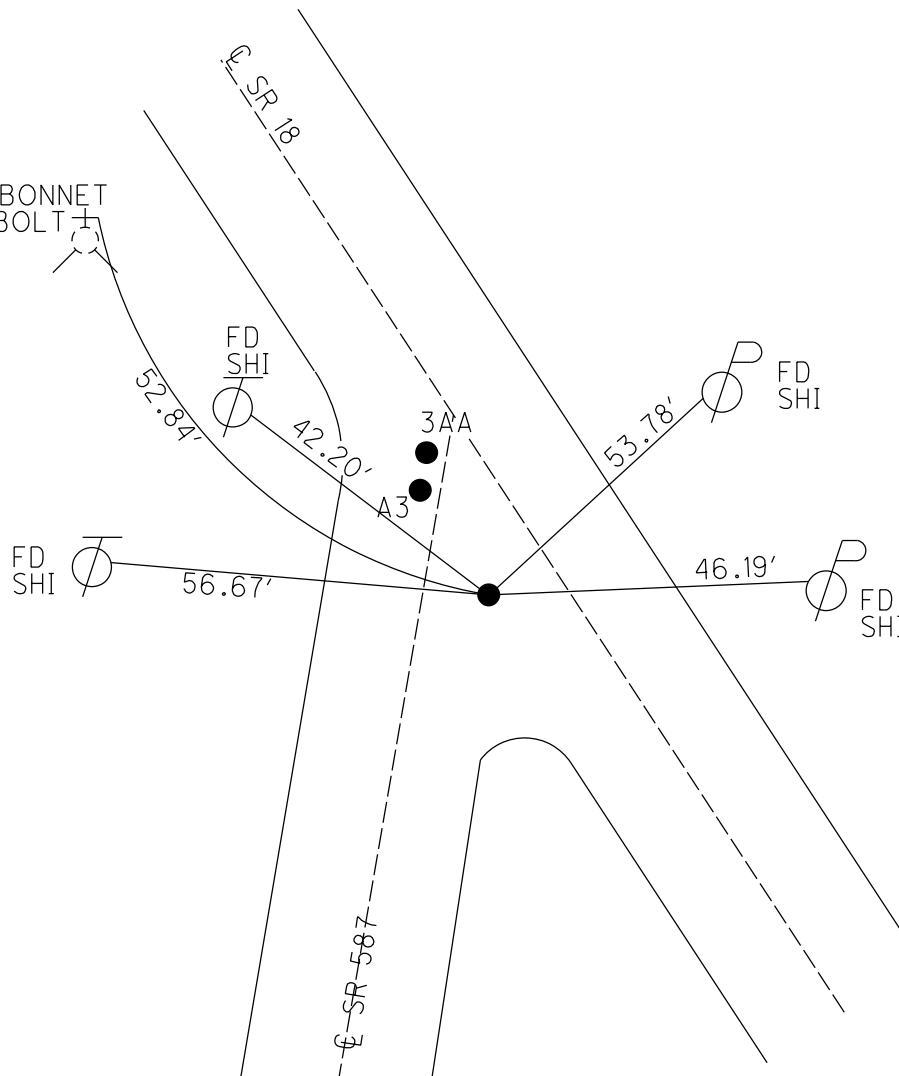

O.D.O.T. DISTRICT 2 SURVEY OFFICE (USE ONLY)

PERSONNEL

REFERENCE NO. 5

SHEET OF

NOTES MILLER DATE 8/5/24

H.C. NIESE WEATHER CLOUDY

R.C. PRESTON-COLVIN TEMP. 80°

ASTON

DWG BY BARRIERE PID 92371

ROUTE SR 18

COUNTY SENECA

TOWNSHIP LOUDON

SECTION 8

T 2 N R 13 E

TYPE MONUMENT MAG NAIL/WASHER

ON SURFACE - BELOW ON

OFFSET Q PAVEMENT 5.1' RT LT : RT

 TO EDGE PAVEMENT

STATION: 128+22.18

HORZ.DATUM: NAD83 (2011)



GEOID: 18

GRID: NORTHING: 537479.312


EASTING: 1723227.806

LDP: NORTHING:

EASTING:

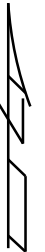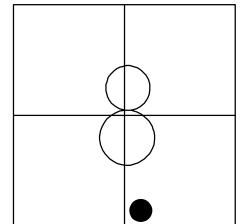

RECORD: P.C.
STA 122+96.63
FD R.R.SPIKE
4" DOWN
7/10/97, MRC
SET P.K./WASHER
9/10/97, MRC
FD PK/WASHER
REF5
9/21/22
SET MAG/WASHER
8/5/24, TDN

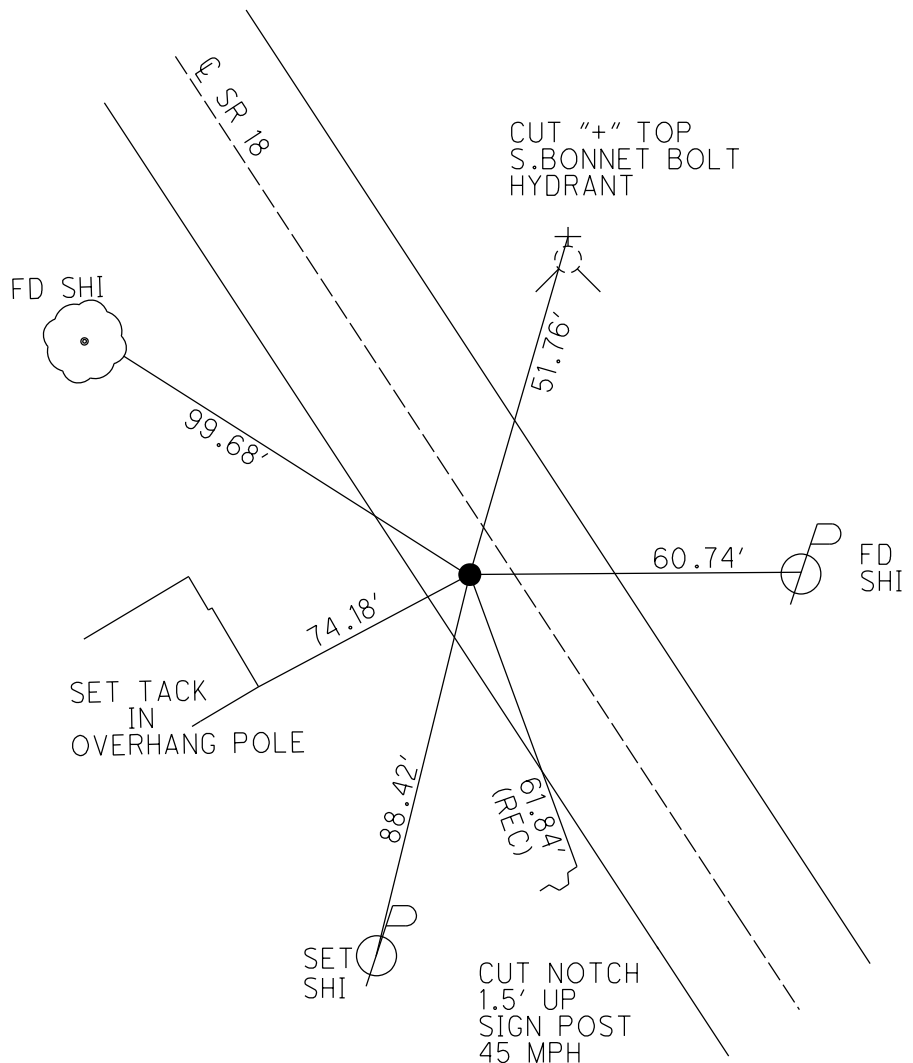

O.D.O.T. DISTRICT 2 SURVEY OFFICE (USE ONLY)

PERSONNEL

REFERENCE NO. 6

SHEET OF

NOTES MILLER DATE 8/5/24

H.C. NIESE WEATHER SUNNY

R.C. PRESTON-COLVIN TEMP. 80°

ASTON

DWG BY BARRIERE PID 92371

ROUTE SR 18

COUNTY SENECA

TOWNSHIP LOUDON

SECTION 17

T 2 N R 13 E

TYPE MONUMENT MAG NAIL/WASHER

ON SURFACE - BELOW ON

OFFSET $\oslash$ PAVEMENT 6.5' RT LT : RT

 TO EDGE PAVEMENT

STATION: 142+40.63

HORZ.DATUM: NAD83 (2011)



GEOID: 18

GRID: NORTHING: 536454.063

EASTING: 1724811.172

LDP: NORTHING:

EASTING:

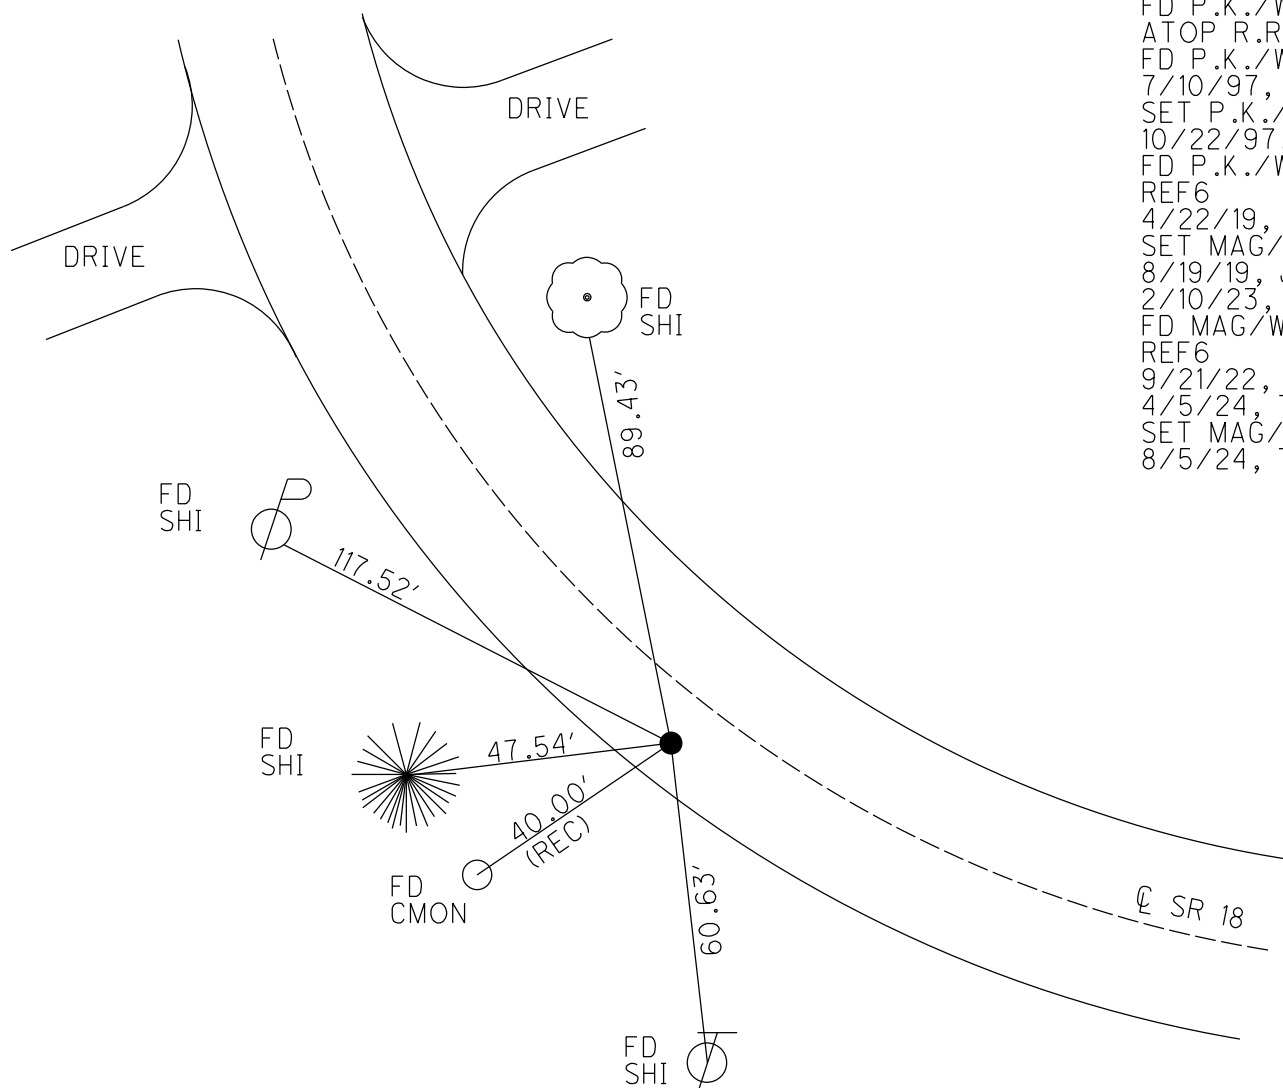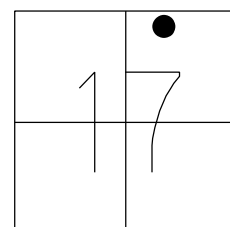

RECORD: P.T.
STA.142+40.63
FD P.K./WASHER
ATOP R.R. SPIKE
FD P.K./WASHER
7/10/97, TMR
SET P.K./WASHER
10/22/97, MB
FD P.K./WASHER
REF6
4/22/19, JFO
SET MAG/WASHER
8/19/19, JFO
2/10/23, JMR
FD MAG/WASHER
REF6
9/21/22, TDN
4/5/24, TDN
SET MAG/WASHER
8/5/24, TDN

O.D.O.T. DISTRICT 2 SURVEY OFFICE (USE ONLY)

PERSONNEL

REFERENCE NO. 7

SHEET OF

NOTES MILLER

DATE 8/5/24

ROUTE SR 18

H.C. NIESE

WEATHER SUNNY

COUNTY SENECA

R.C. PRESTON-COLVIN

TEMP. 80°

TOWNSHIP LOUDON

ASTON

SECTION 16

DWG BY BARRIERE

PID 92371

T 2 N R 13 E

TYPE MONUMENT MAG NAIL/WASHER

ON SURFACE - BELOW ON

OFFSET Q PAVEMENT 5.4' RT LT : RT

 TO EDGE PAVEMENT

STATION: 159+97.89

HORZ.DATUM: NAD83 (2011)


GEOID: 18

GRID: NORTHING: 536193.792


EASTING: 1726548.260

LDP: NORTHING:

EASTING:

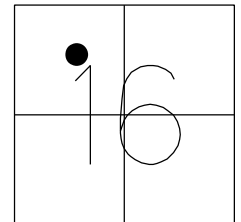

RECORD: P.C.
STA.159+97.89
FD MINE SPIKE
4" DOWN
7/10/97, MB
SET P.K./WASHER
10/22/97, TR
FD P.K./WASHER
REF7
4/22/19
8/19/19
2/15/22, JFO
9/21/22, TDN
2/10/23, JMR
4/5/24, TDN
SET MAG/WASHER
8/5/24

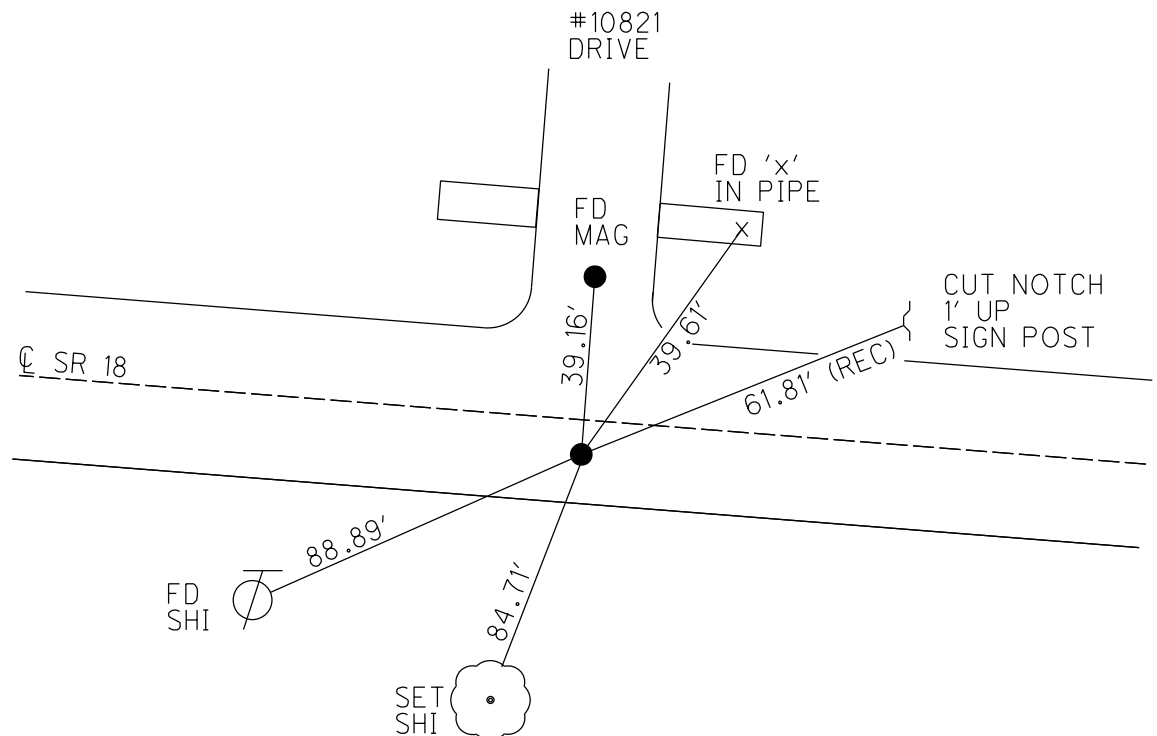

O.D.O.T. DISTRICT 2 SURVEY OFFICE (USE ONLY)

PERSONNEL

REFERENCE NO. 8

SHEET OF

NOTES MILLER

DATE 8/5/24

ROUTE SR 18

H.C. NIESE

WEATHER SUNNY

COUNTY SENECA

R.C. PRESTON-COLVIN

TEMP. 80°

TOWNSHIP LOUDON

ASTON

SECTION 16

DWG BY BARRIERE

PID 92371

T 2 N R 13 E

TYPE MONUMENT MAG NAIL/WASHER

ON SURFACE - BELOW ON

OFFSET Q PAVEMENT 9.3' RT LT : RT

 TO EDGE PAVEMENT

STATION: 161+11.28

HORZ.DATUM: NAD83 (2011)


GEOID: 18

GRID: NORTHING: 536177.099


EASTING: 1726660.377

LDP: NORTHING:

EASTING:

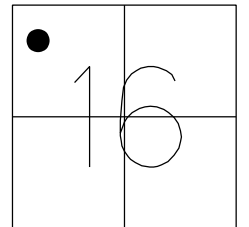

RECORD: P.I.
STA. 161+11.28
 $\Delta = 4^{\circ}32'00''$ LT
FD P.K./WASHER
ATOP MINE SPIKE
FD P.K.SHANK
7/10/97, MB
SET P.K./WASHER
10/22/97, TR
FD P.K./WASHER
REF8
4/22/19
8/19/19
2/15/22, JFO
2/10/23, JMR
9/21/22, TDN
4/5/24, TDN
SET MAG/WASHER
8/5/24, TDN

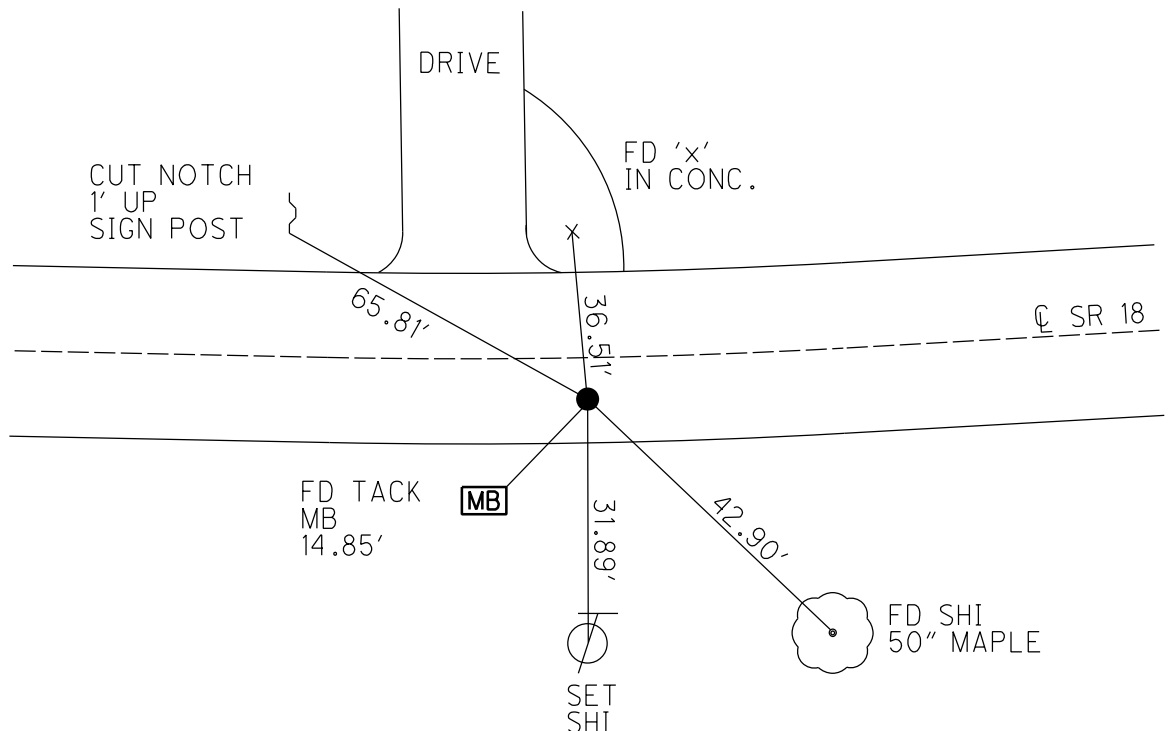

O.D.O.T. DISTRICT 2 SURVEY OFFICE (USE ONLY)

PERSONNEL

REFERENCE NO. 9

SHEET OF

NOTES MILLER DATE 8/5/24

H.C. NIESE WEATHER SUNNY

R.C. PRESTON-COLVIN TEMP. 80°

ASTON

ROUTE SR 18

COUNTY SENECA

TOWNSHIP LOUDON

SECTION 16

T 2 N R 13 E

DWG BY BARRIERE PID 92371

TYPE MONUMENT MAG NAIL/WASHER

ON SURFACE - BELOW ON

OFFSET Q PAVEMENT 4.3' RT LT : RT

 TO EDGE PAVEMENT

STATION: 162+24.55

HORZ.DATUM: NAD83 (2011)


GEOID: 18

GRID: NORTHING: 536169.218


EASTING: 1726773.446

LDP: NORTHING:

EASTING:

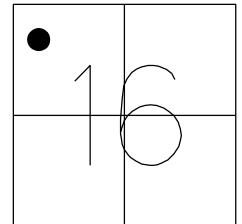

RECORD: P.T.
STA. 162+24.55
FD P.K./SHINER
ATOP R.R. SPIKE
FD P.K.NAIL
7/10/97, JFO
SET P.K./WASHER
10/22/97, TR
FD P.K./WASHER
REF9
4/22/19
8/19/19
2/15/22, JFO
9/21/22, TDN
2/10/23, JMR
4/5/24, TDN
SET MAG/WASHER
8/5/24, TDN

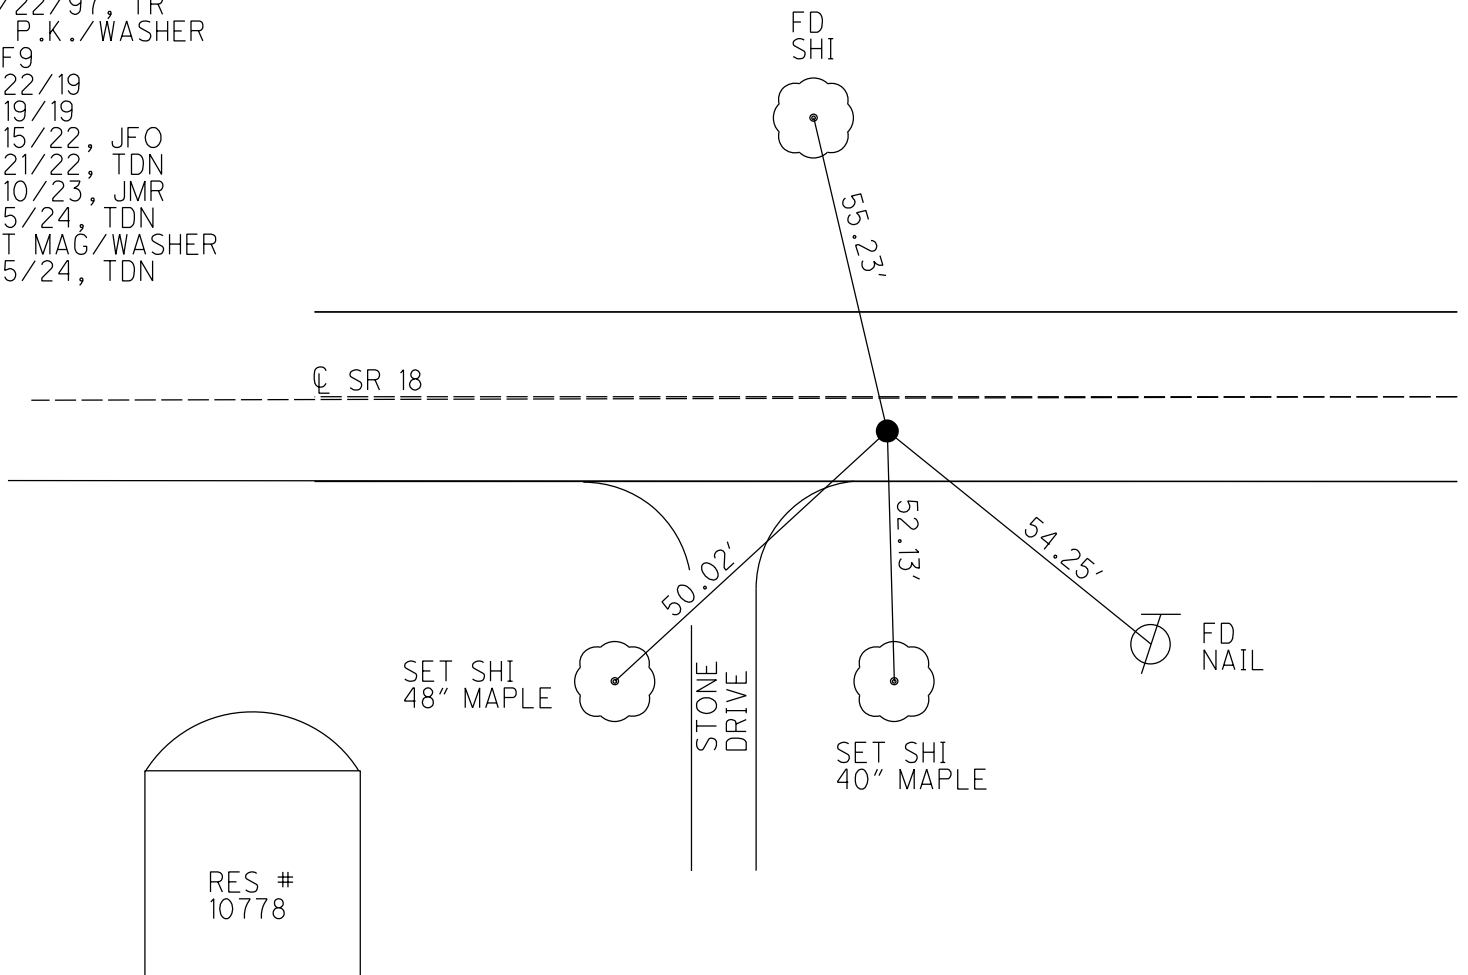

O.D.O.T. DISTRICT 2 SURVEY OFFICE (USE ONLY)

PERSONNEL

REFERENCE NO. 10

SHEET OF

NOTES MILLER

DATE 8/5/24

ROUTE SR 18

H.C. NIESE

WEATHER SUNNY

COUNTY SENECA

R.C. PRESTON-COLVIN

TEMP. 80°

TOWNSHIP LOUDON

ASTON

SECTION 16

DWG BY BARRIERE

PID 92371

T 2 N R 13 E

TYPE MONUMENT MAG NAIL/WASHER

ON SURFACE - BELOW ON

OFFSET $\odot$ PAVEMENT 0.5' RT LT : RT

 TO EDGE PAVEMENT

STATION: 176+58

HORZ.DATUM: NAD83 (2011)


GEOID: 18

GRID: NORTHING: 536069.814


EASTING: 1728203.030

LDP: NORTHING:

EASTING:

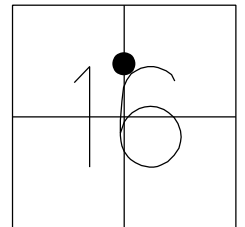

RECORD: P.O.T.
STA.176+58
FD P.K.SHINER
ATOP R.R.SPIKE
FD P.K./WASHER
7/10/97, MB
SET P.K./WASHER
10/22/97, MRC
FD P.K./WASHER
REF10
4/22/19
8/19/19, JFO
FD P.K./WASHER
2" DOWN
2/10/23, JMR
4/5/24, TDN
SET MAG/WASHER
8/5/24, TDN

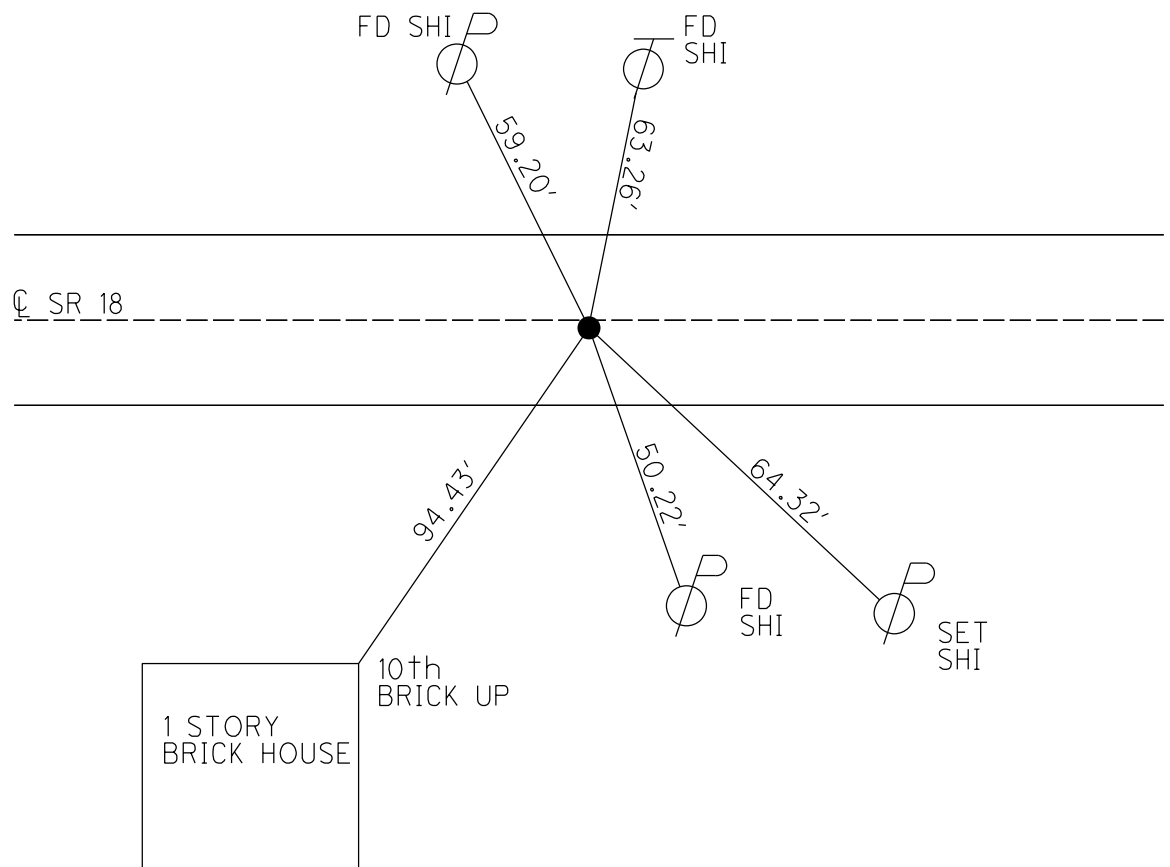

O.D.O.T. DISTRICT 2 SURVEY OFFICE (USE ONLY)

PERSONNEL

REFERENCE NO. 11

SHEET OF

NOTES MILLER DATE 8/5/24

H.C. NIESE WEATHER SUNNY

R.C. PRESTON-COLVIN TEMP. 80°

ASTON

DWG BY BARRIERE PID 92371

ROUTE SR 18

COUNTY SENECA

TOWNSHIP LOUDON

SECTION 16

T 2 N R 13 E

TYPE MONUMENT MAG NAIL/WASHER

ON SURFACE - BELOW 2" BELOW

OFFSET $\text{\textcircled{C}}$ PAVEMENT 1.5' LT LT : RT

 TO EDGE PAVEMENT

STATION: 190+00.62

HORIZ.DATUM: NAD83 (2011)



GEOID: 18

GRID: NORTHING: 535977.128


EASTING: 1729541.914

LDP: NORTHING:

EASTING:

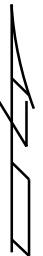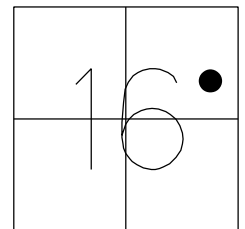

RECORD: P.O.T.
STA. 190+00.62
FD P.K./WASHER
ATOP MINE SPIKE
FD P.K./WASHER
7/10/97, MB
SET P.K./WASHER
11/6/97, MB
FD P.K./WASHER
REF11
4/22/19
8/19/19, JFO
FD P.K./WASHER
2" DOWN
2/10/23, JMR
FD P.K.SHANK
2 1/2" DOWN
9/15/23,
10/6/23, DSA
4/5/24, TDN
SET MAG/WASHER
8/5/24, TDN

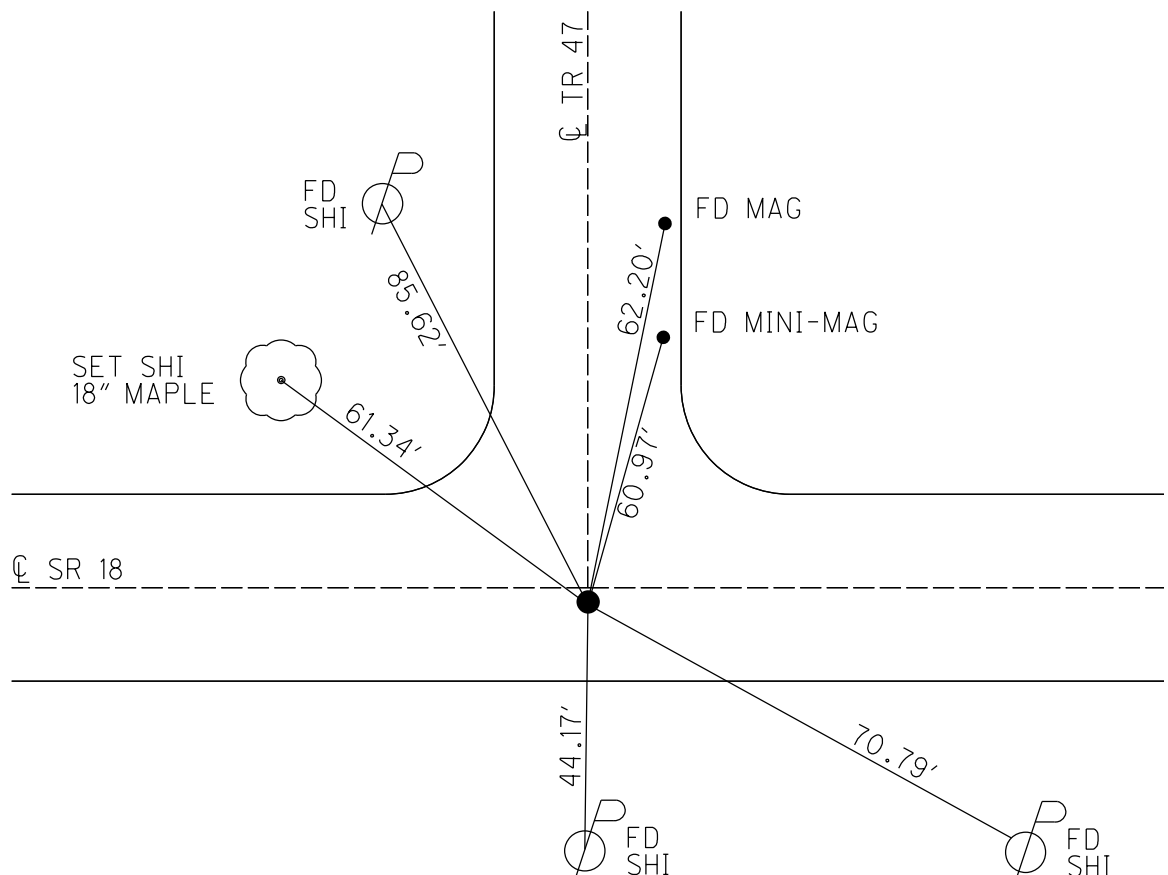

O.D.O.T. DISTRICT 2 SURVEY OFFICE (USE ONLY)

PERSONNEL

REFERENCE NO. 12

SHEET OF

NOTES MILLER

DATE 8/5/24

ROUTE SR 18

H.C. NIESE

WEATHER SUNNY

COUNTY SENECA

R.C. PRESTON-COLVIN

TEMP. 80°

TOWNSHIP LOUDON

ASTON

SECTION 16

DWG BY BARRIERE

PID 92371

T 2 N R 13 E

TYPE MONUMENT MAG NAIL/WASHER

ON SURFACE - BELOW 2" BELOW

OFFSET $\odot$ PAVEMENT 2.2' LT LT : RT

 TO EDGE PAVEMENT

STATION: 196+63.75

HORIZ.DATUM: NAD83 (2011)


GEOID: 18

GRID: NORTHING: 535931.200

EASTING: 1730203.225

LDP: NORTHING:

EASTING:

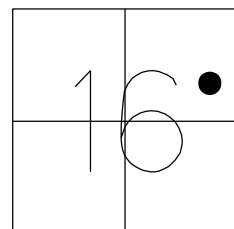

RECORD: P.O.T.
STA.196+63.75
FD P.K./SHINER
ATOP MINE SPIKE
FD P.K.SHANK
7/10/97, TMR
SET P.K./WASHER
11/6/97, MB
FD P.K./WASHER
REF12
4/22/19, JFO
SET MAG/WASHER
8/19/19, JFO
FD MAG/WASHER
9/1/21, DSA
2/15/22, JFO
2/10/23, JMR
10/6/23, DSA
SET MAG/WASHER
8/5/24, TDN



2 STORY
RES. #
10141

TOP 2ND BLOCKS
OUTER CORNERS

37.94'
37.89'

64.61'
FD
SHI

$\odot$ SR 18

106.83'

62.75'

FD
SHI

TOP COR. BLOCK

FRUTH WETLAND

O.D.O.T. DISTRICT 2 SURVEY OFFICE (USE ONLY)

PERSONNEL

REFERENCE NO. 13

SHEET OF

NOTES MILLER DATE 8/5/24

H.C. NIESE WEATHER SUNNY

R.C. PRESTON-COLVIN TEMP. 80°

ASTON

ROUTE SR 18

COUNTY SENECA

TOWNSHIP LOUDON

SECTION 16

DWG BY BARRIERE PID 92371

T 2 N R 13 E

TYPE MONUMENT MAG NAIL/WASHER

ON SURFACE - BELOW ON

OFFSET $\odot$ PAVEMENT 1' RT LT : RT

 TO EDGE PAVEMENT

STATION: 203+17.80

HORZ.DATUM: NAD83 (2011)


GEOID: 18

GRID: NORTHING: 535880.492


EASTING: 1730855.427

LDP: NORTHING:

EASTING:

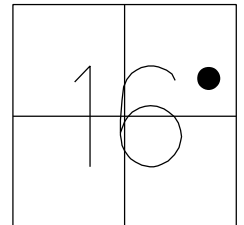

RECORD: P.I.
 $\Delta=02^{\circ}41'$ LT
STA.203+17.80
FD MINE SPIKE
4" BELOW
7/11/97, TMR
SET P.K./WASHER
11/6/97, MB
FD P.K.SHANK
REF13
4/22/19, JFO
SET MAG/WASHER
8/19/19, JFO
FD MAG/WASHER
9/1/21, DSA
2/15/22, JFO
2/10/23, JMR
10/6/23, DSA
SET MAG/WASHER
8/5/24, TDN

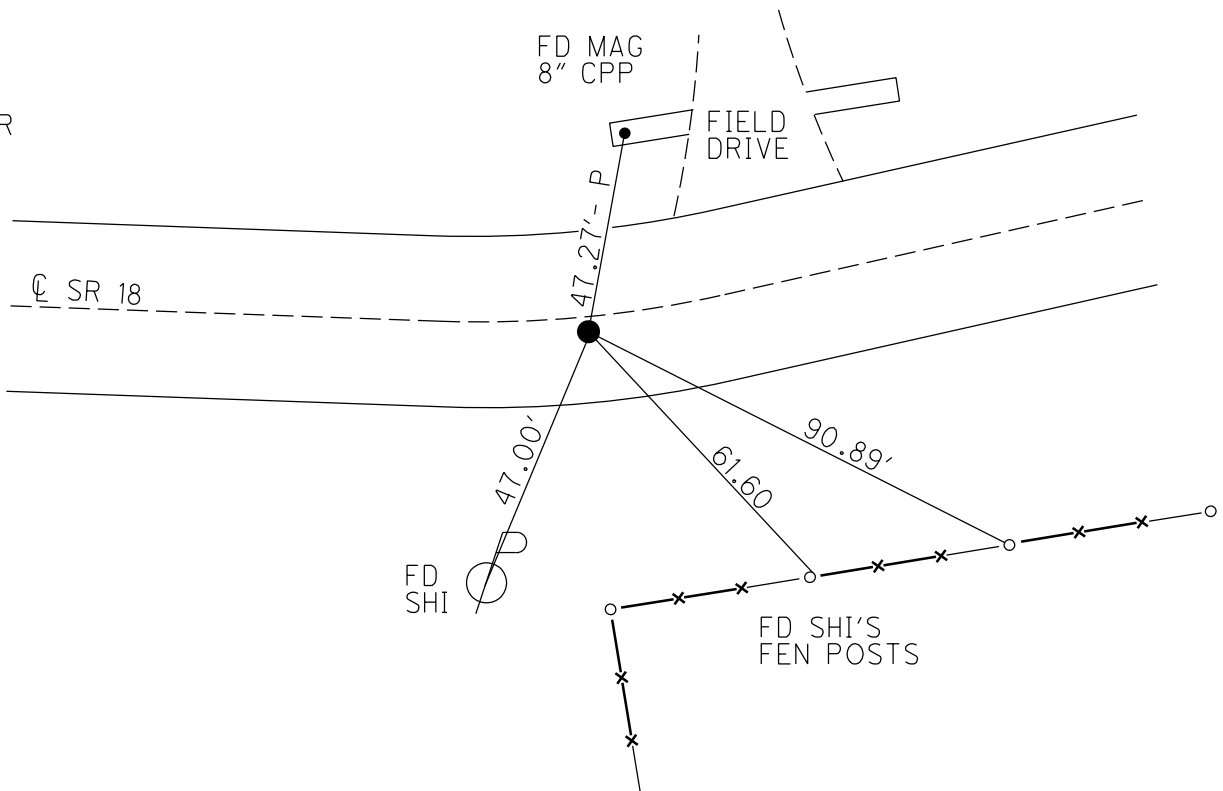

O.D.O.T. DISTRICT 2 SURVEY OFFICE (USE ONLY)

PERSONNEL

REFERENCE NO. A13

SHEET OF

NOTES MILLER
H.C. NIESE
R.C. PRESTON-COLVIN
ASTON

DATE 8/5/24
WEATHER SUNNY
TEMP. 80°

ROUTE SR 18
COUNTY SENECA
TOWNSHIP LOUDON
SECTION 15
T 2 N R 13 E

DWG BY BARRIERE PID 92371

TYPE MONUMENT 1" IPIN

ON SURFACE - BELOW ON

OFFSET $\varnothing$ PAVEMENT 21.3' LT LT : RT



 TO EDGE PAVEMENT

STATION: 212+13.77

HORIZ.DATUM: NAD83 (2011) GEOID: 18


GRID: NORTHING: 535852.983 EASTING: 1731750.364

LDP: NORTHING: EASTING:

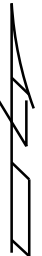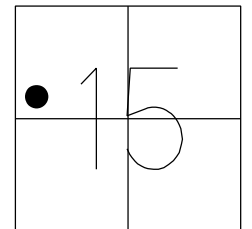

RECORD: P.I.
STA. 212+13.77
 $\Delta = 07^\circ 56' 00''$ RT
D.N.F.
4/22/19, JFO
FD 1" IPIN
4" DOWN
REFA13
9/21/20, TDN
FD 1" IPIN
NEWREF13A
8/5/24, TDN

FD SHI
6" HAWTHORN

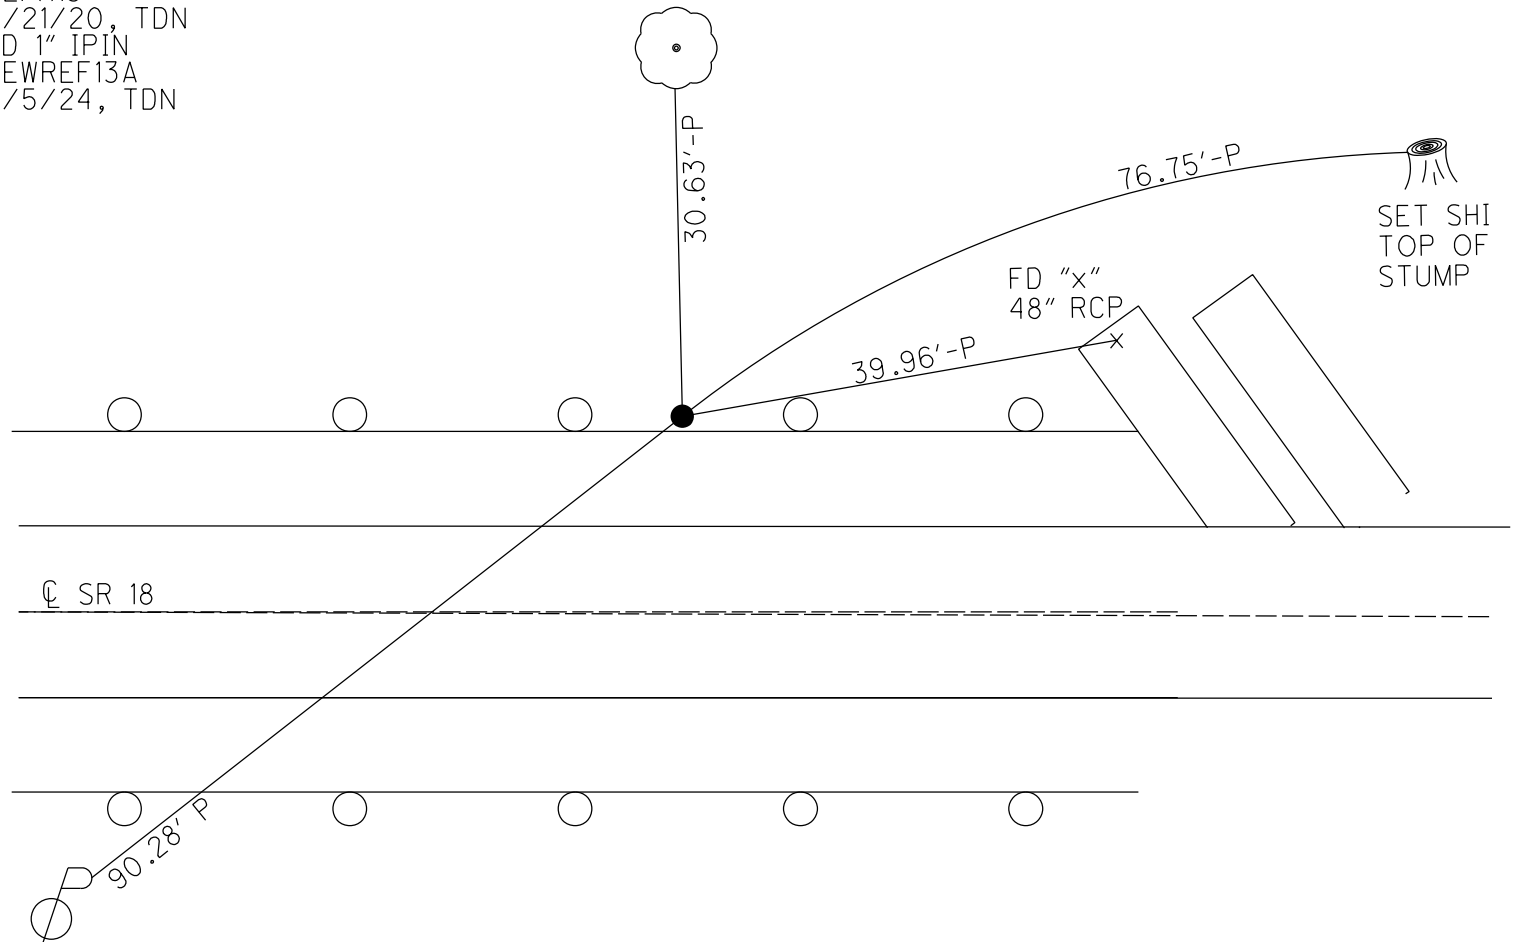

O.D.O.T. DISTRICT 2 SURVEY OFFICE (USE ONLY)

PERSONNEL

REFERENCE NO. 13B

SHEET OF

NOTES MILLER DATE 8/5/24

H.C. NIESE WEATHER SUNNY

R.C. PRESTON-COLVIN TEMP. 80°

ASTON

DWG BY BARRIERE PID 92371

ROUTE SR 18

COUNTY SENECA

TOWNSHIP LOUDON

SECTION 15

T 2 N R 13 E

TYPE MONUMENT MAG NAIL/WASHER

ON SURFACE - BELOW ON

OFFSET CL PAVEMENT 21.3' LT LT : RT

 TO EDGE PAVEMENT

STATION: 212+13.77

HORZ.DATUM: NAD83 (2011)


GEOID: 18

GRID: NORTHING: 535768.414


EASTING: 1732243.483

LDP: NORTHING:

EASTING:

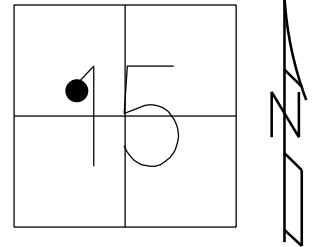

RECORD: P.I.
 $\Delta = 04^{\circ} 58' 00''$ LT
STA. 217+13.97
FD P.K./WASHER
ATOP MINE SPIKE
FD P.K./WASHER
7/11/97, MB
SET P.K./WASHER
11/6/97, MB
FD P.K./WASHER
1 1/2" DOWN
REFB13
4/22/19
8/19/19, JFO
9/1/21, DSA
2/15/22, JFO
2/10/23, JMR
9/15/23, JAM
SET MAG/WASHER
11/6/23, DSA
SET MAG/WASHER
8/5/24, TDN

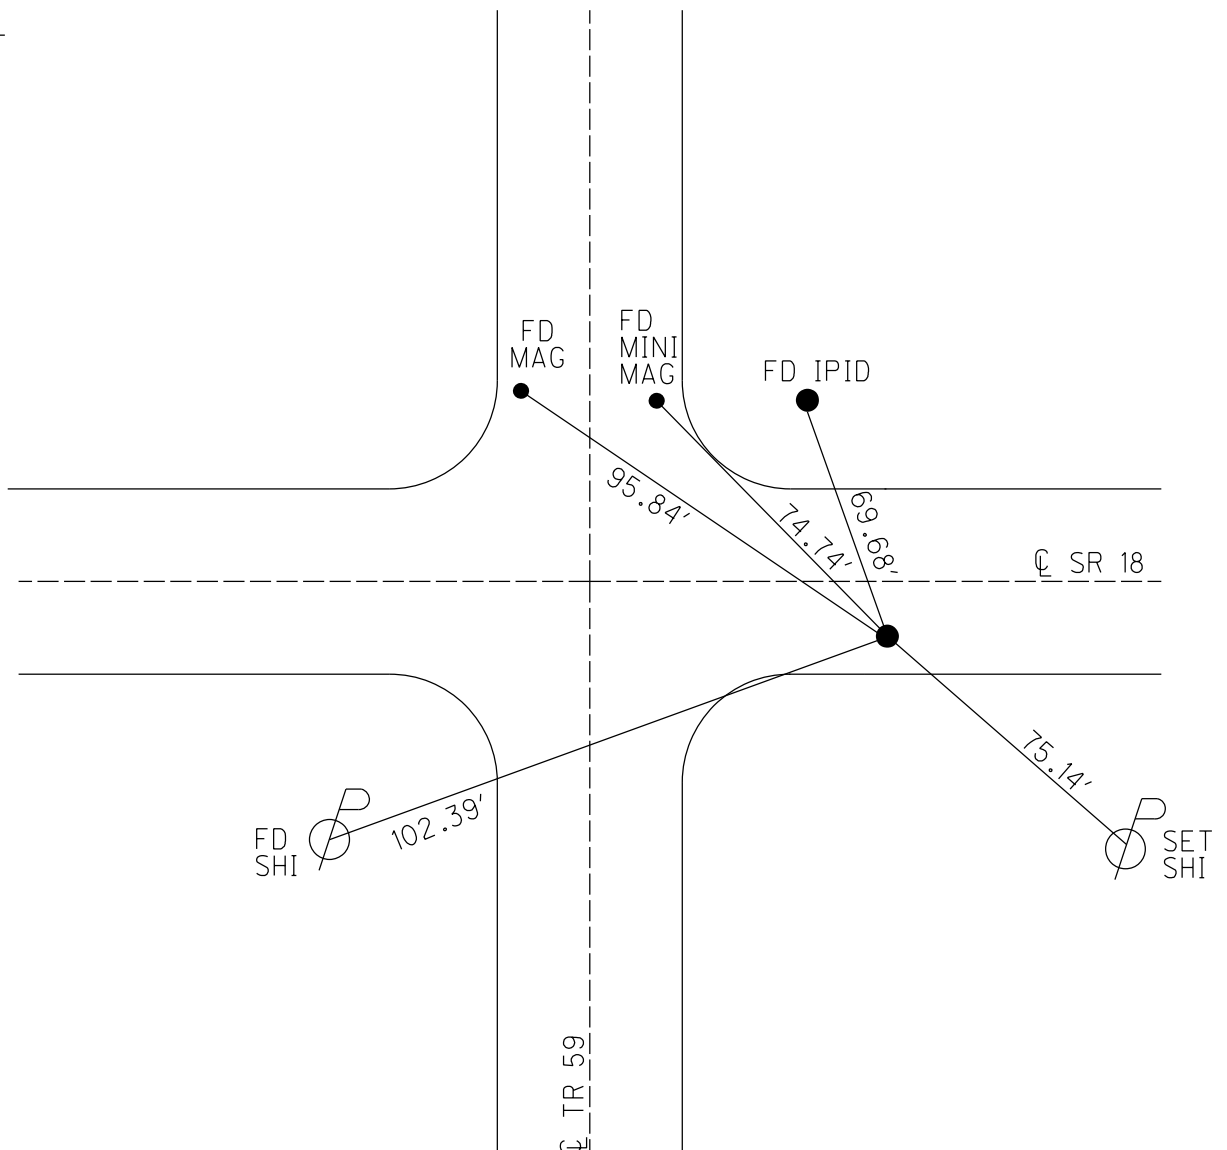

O.D.O.T. DISTRICT 2 SURVEY OFFICE (USE ONLY)

PERSONNEL

REFERENCE NO. 14

SHEET OF

NOTES MILLER DATE 8/5/24

H.C. NIESE WEATHER SUNNY

R.C. PRESTON-COLVIN TEMP. 80°

ASTON

DWG BY BARRIERE PID 92371

ROUTE SR 18

COUNTY SENECA

TOWNSHIP LOUDON

SECTION 15

T 2 N R 13 E

TYPE MONUMENT MAG NAIL/WASHER

ON SURFACE - BELOW ON

OFFSET $\odot$ PAVEMENT 1.6' LT LT : RT

 TO EDGE PAVEMENT

STATION: 226+77.92

HORZ.DATUM: NAD83 (2011)


GEOID: 18

GRID: NORTHING: 535688.938


EASTING: 1733203.713

LDP: NORTHING:

EASTING:

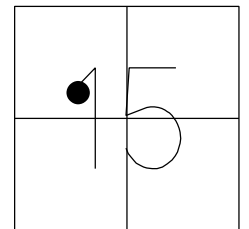

RECORD: P.I.
 $\Delta = 04^{\circ} 18' 00''$ LT
STA.226+77.92
FD P.K./WASHER
ATOP MINE SPIKE
FD P.K./WASHER
7/11/97, TMR
SET P.K./WASHER
11/6/97, MB
FD P.K./WASHER
REF14
4/22/19, JFO
SET MAG/WASHER
8/19/19, JFO
FD MAG/WASHER
9/1/21, DSA
2/15/22, JFO
2/10/23, JMR
10/6/23, DSA
SET MAG/WASHER
8/5/24, TDN

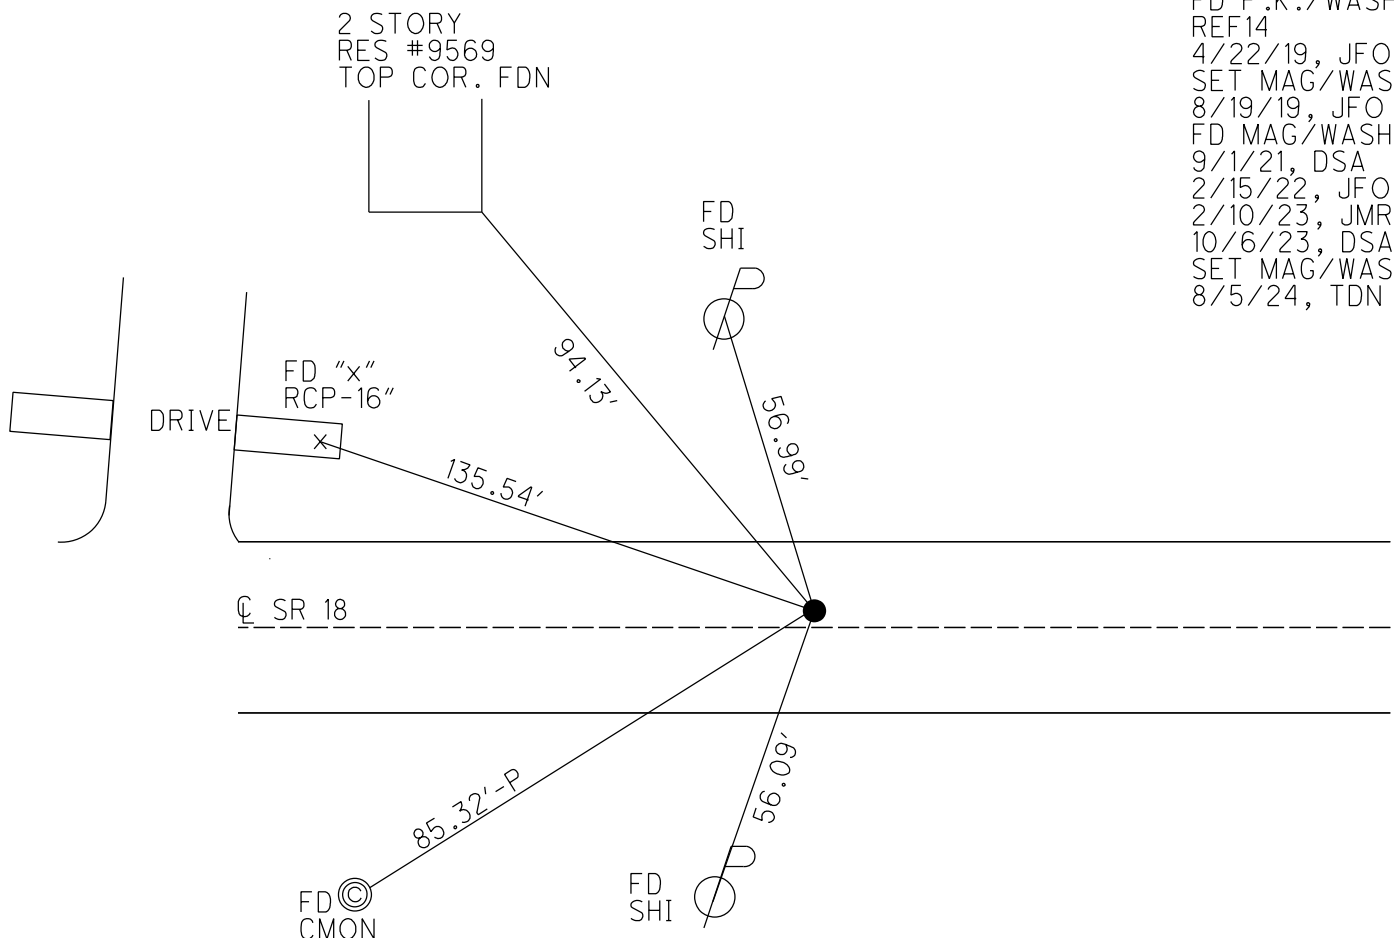

O.D.O.T. DISTRICT 2 SURVEY OFFICE (USE ONLY)

PERSONNEL

REFERENCE NO. 15

SHEET OF

NOTES BARRIERE

DATE 8/15/24

ROUTE SR 18

H.C. NIESE

WEATHER SUNNY

COUNTY SENECA

R.C. MILLER

TEMP. 77°

TOWNSHIP LOUDON

DWG BY BARRIERE

PID 92371

SECTION 15

T 2 N R 13 E

TYPE MONUMENT MAG NAIL/WASHER

ON SURFACE - BELOW ON

OFFSET $\odot$ PAVEMENT 7.2' RT LT : RT

 TO EDGE PAVEMENT

STATION: 242+80.39

HORZ.DATUM: NAD83 (2011)


GEOID: 18

GRID: NORTHING: 535676.921


EASTING: 1734805.720

LDP: NORTHING:

EASTING:

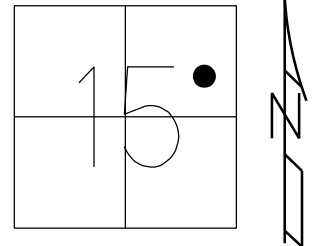

RECORD: P.I.
 $\Delta = 09^{\circ} 54' 00''$ LT
STA.242+80.39
FD P.K./WASHER
7/11/97, MB
SET P.K./WASHER
11/6/97, MB
FD P.K./WASHER
REF15
4/22/19
8/19/19, JFO
9/1/21, DSA
2/15/22, JFO
2/10/23, JMR
SET MAG/WASHER
REF15
8/15/24, TDN

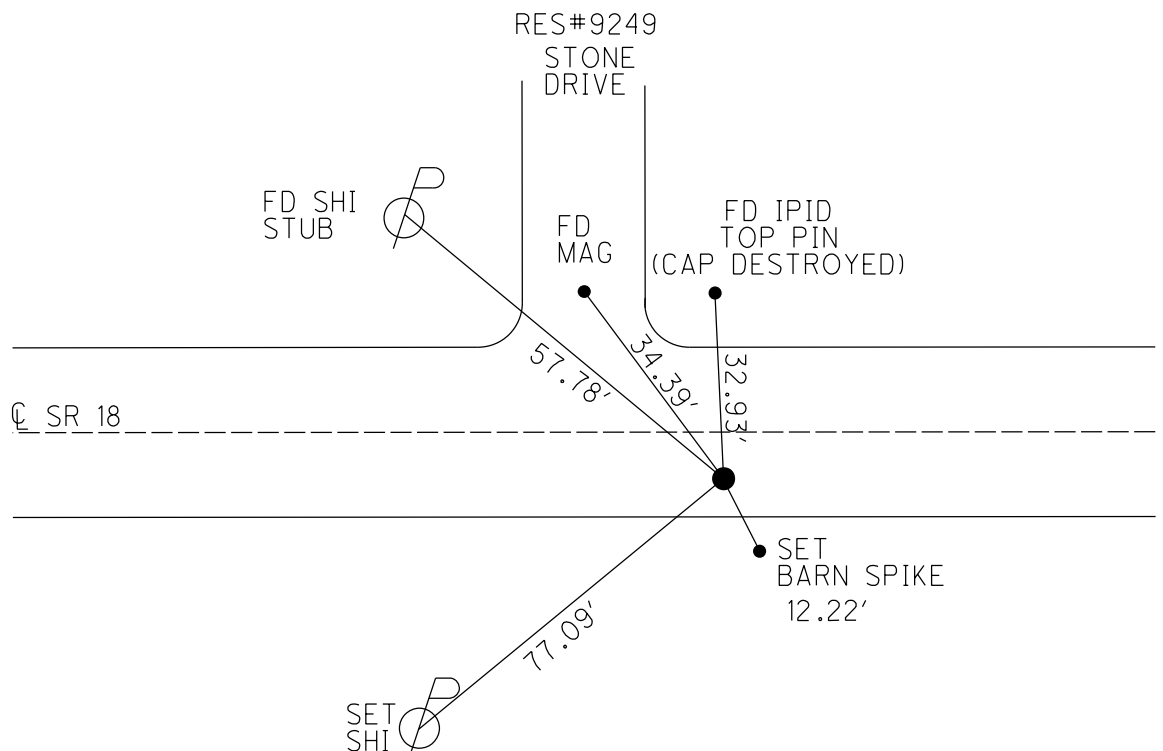

O.D.O.T. DISTRICT 2 SURVEY OFFICE (USE ONLY)

PERSONNEL

REFERENCE NO. 16

SHEET OF

NOTES BARRIERE

DATE 8/15/24

ROUTE SR 18

H.C. NIESE

WEATHER SUNNY

COUNTY SENECA

R.C. MILLER

TEMP. 76°

TOWNSHIP LOUDON

DWG BY BARRIERE

PID 92371

SECTION 14

T 2 N R 13 E

TYPE MONUMENT MAG NAIL/WASHER

ON SURFACE - BELOW ON

OFFSET Q PAVEMENT 5.3' LT LT : RT

 TO EDGE PAVEMENT

STATION: 256+34.31

HORZ.DATUM: NAD83 (2011)


GEOID: 18

GRID: NORTHING: 535899.795


EASTING: 1736141.438

LDP: NORTHING:

EASTING:

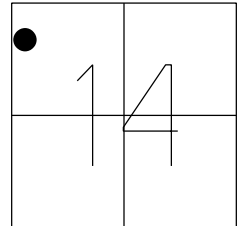

RECORD: P.I.
 $\Delta = 02^{\circ} 00' \text{ RT}$
STA. 256+34.31'
FD MINE SPIKE
4" DOWN
7/11/97, MB
SET P.K./WASHER
11/6/97, MB
FD P.K.SHANK
REF16
4/22/19
8/19/19, JFO
9/1/21, DSA
2/15/22, JFO
2/10/23, JMR
SET MAG/WASHER
REF16
8/15/24, TDN

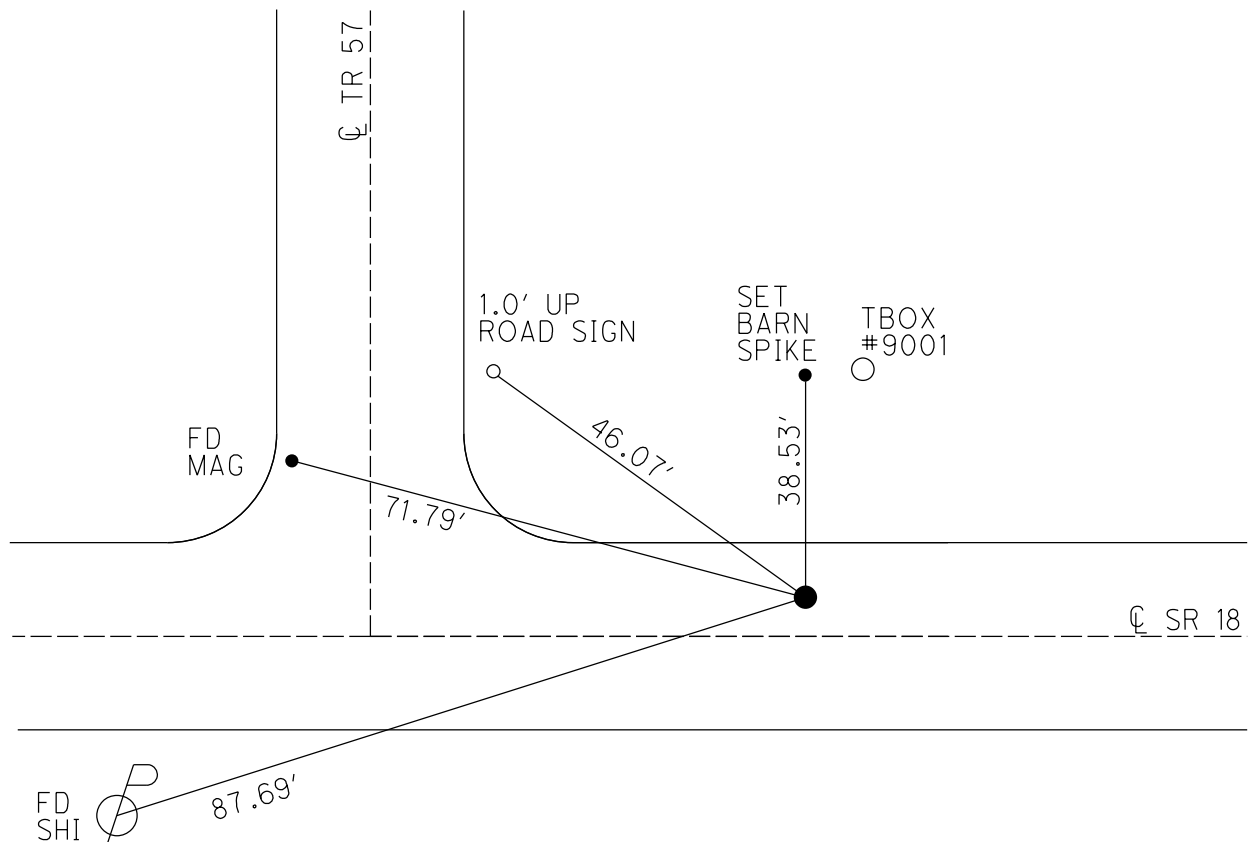

O.D.O.T. DISTRICT 2 SURVEY OFFICE (USE ONLY)

PERSONNEL

REFERENCE NO. 17

SHEET 14 OF 48

NOTES LEU

DATE 3/23/18

ROUTE SR 18

H.C. LEU

WEATHER SUNNY

COUNTY SENECA

R.C. AUBLE

TEMP. 34°

TOWNSHIP LOUDON

SEAMAN

SECTION 14

DWG BY NIESE PID 101340

T 2 N R 13 E

TYPE MONUMENT 1" IPIN

~~ON SURFACE~~ - BELOW 4"

OFFSET Q PAVEMENT 26.5' LT : ~~RT~~

- TO - EDGE PAVEMENT


STATION: 274+20.7

HORZ.DATUM: NAD83(2011)


GEOID: 2012A

GRID: NORTHING: 536131.902

EASTING: 1737911.598

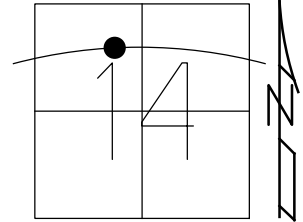

RECORD: P.I.
 $\Delta = 11^{\circ}08' 00''$ RT
STA. 274+20.70
FD IPIN
1/19/90, CRONIN
11/6/97
FD 1" IPIN
4 1/2" DOWN
3/23/18, JLL
REF17
4/22/19, JFO

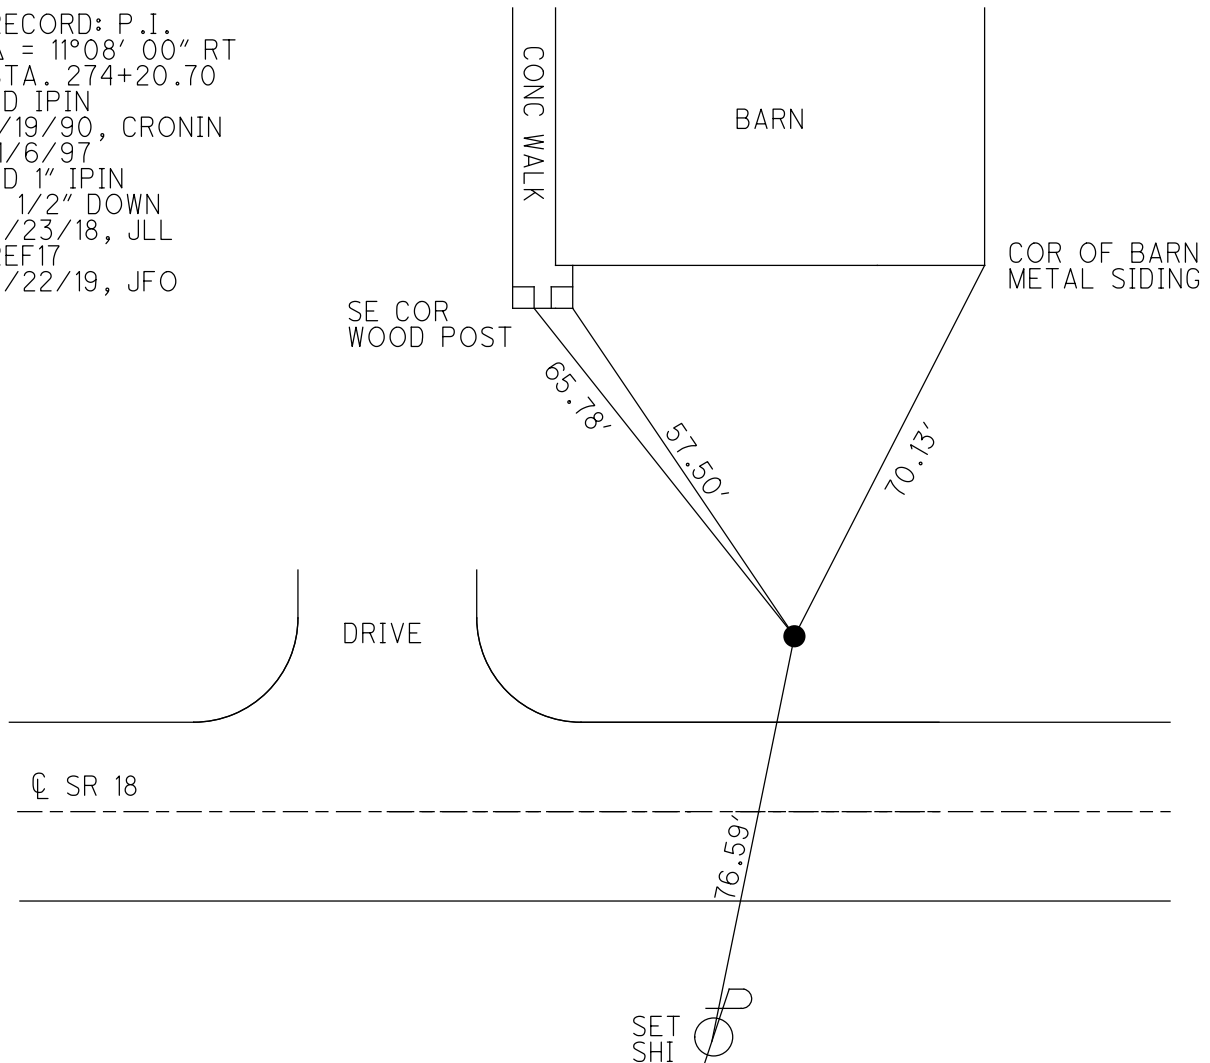

O.D.O.T. DISTRICT 2 SURVEY OFFICE (USE ONLY)

PERSONNEL

REFERENCE NO. 17A

SHEET OF

NOTES BARRIERE

DATE 8/15/24

ROUTE SR 18

H.C. NIESE

WEATHER SUNNY

COUNTY SENECA

R.C. MILLER

TEMP. 76°

TOWNSHIP LOUDON

SECTION 14

DWG BY BARRIERE

PID 92371

T 2 N R 13 E

TYPE MONUMENT MAG NAIL/WASHER

ON SURFACE - BELOW ON

OFFSET $\mathcal{C}$ PAVEMENT 14' LT LT : RT

 TO EDGE PAVEMENT

STATION: 282+31.06

HORZ.DATUM: NAD83 (2011)


GEOID: 18

GRID: NORTHING: 536080.718


EASTING: 1738722.920

LDP: NORTHING:

EASTING:

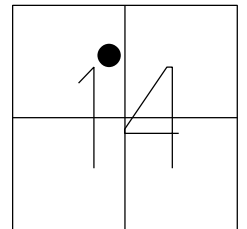

RECORD: P.I.
 $\Delta = 07^{\circ}20'00''$ RT
 STA.282+31.06
 FD R.R.SPIKE
 4" DOWN
 7/1/97, MB
 SET P.K./WASHER
 11/6/97, MB
 FD R.R.SPIKE
 4" DOWN
 REF18
 3/23/18, JLL
 REFA17
 4/22/19
 8/19/19, JFO
 9/1/21, DSA
 2/15/22, JFO
 2/10/23, JMR
 SET MAG/WASHER
 REF17A
 8/15/24, TDN

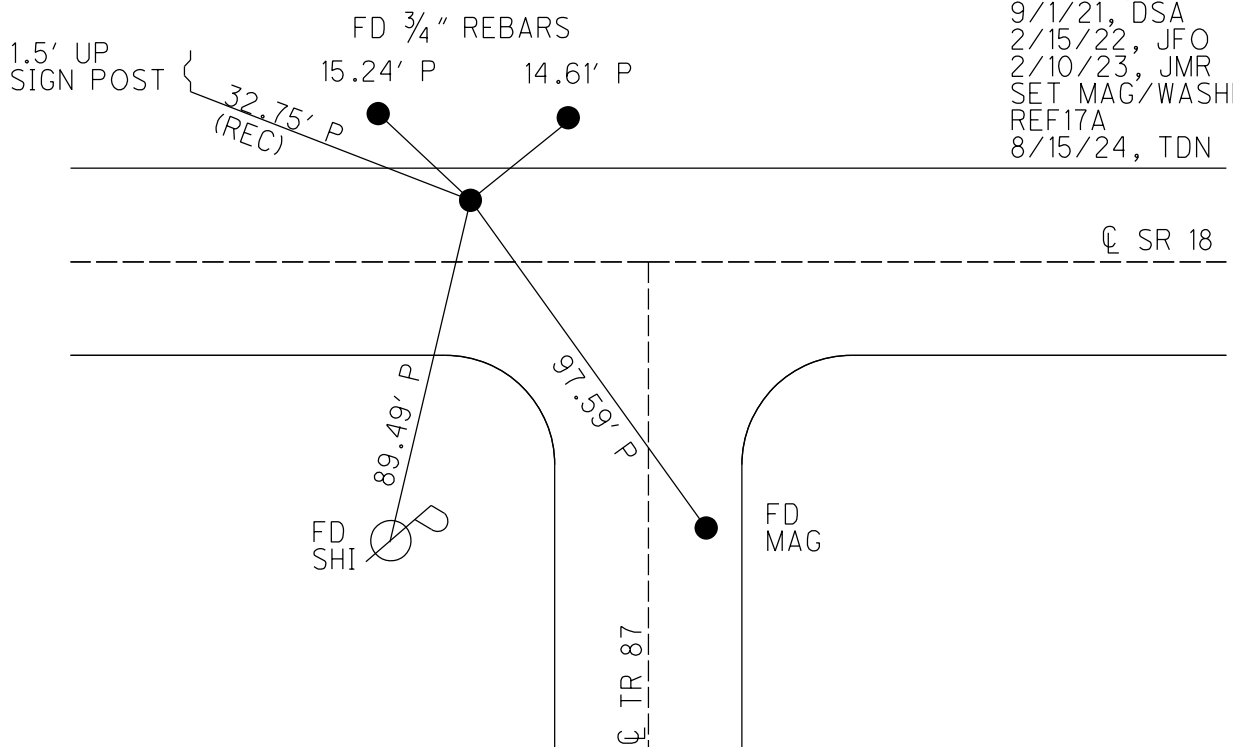

O.D.O.T. DISTRICT 2 SURVEY OFFICE (USE ONLY)

PERSONNEL

REFERENCE NO. 17 B

SHEET 16 OF 48

NOTES _____ AUBLE

DATE 3/30/18

ROUTE SR 18

H.C. LEU

WEATHER CLOUDY

COUNTY SENECA

R.C. AUBLE

TEMP. 38°

TOWNSHIP LOUDON

SEAMAN

SECTION 14

DWG BY NIESE PID 101340

T_2_N R_13_E

TYPE MONUMENT IPIN

ON SURFACE - BELOW 5"

OFFSET @ PAVEMENT 17.0' LT : RT


____TO____EDGE PAVEMENT

STATION: 295+01.25


HORZ.DATUM: NAD83(2011)

GEOID: 2012A

GRID: NORTHING: 535838.888

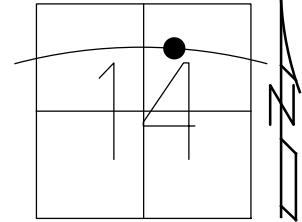EASTING: 1739969.312

RECORD: P.I.
 $\Delta = 10^{\circ}12' 00''$ RT
 STA.295+01.25
 FD 3/4" IPIN
 11/19/90, CRONIN
 11/6/97
 FD 3/4" IPIN
 5" DOWN
 REF19
 3/23/19, JLL
 FD 3/4" IPIN
 5" DOWN
 REFB17
 4/22/19, JFO

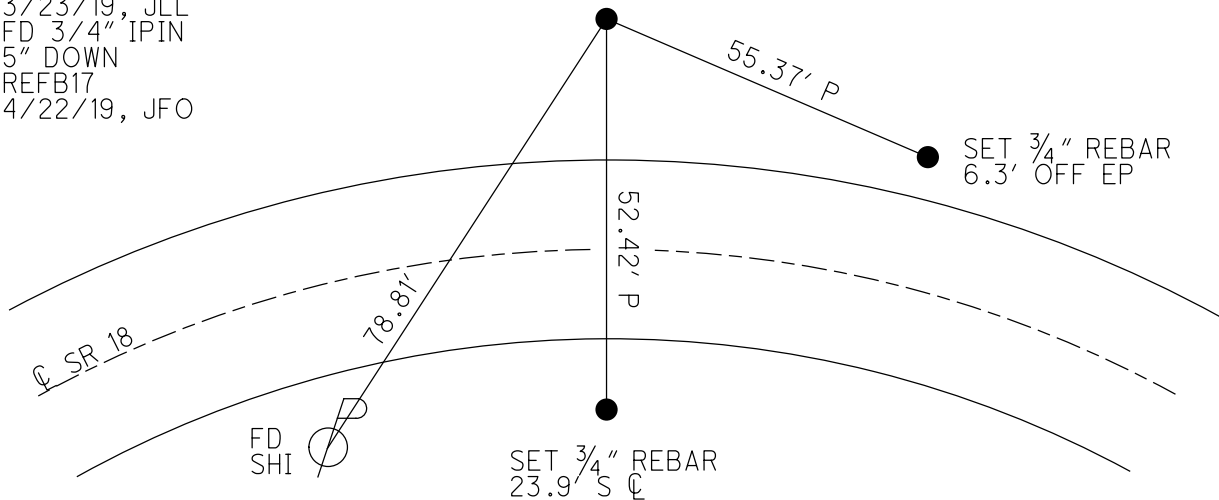

O.D.O.T. DISTRICT 2 SURVEY OFFICE (USE ONLY)

PERSONNEL

REFERENCE NO. 18

SHEET OF

NOTES BARRIERE

DATE 8/15/24

ROUTE SR 18

H.C. NIESE

WEATHER SUNNY

COUNTY SENECA

R.C. MILLER

TEMP. 76°

TOWNSHIP LOUDON

DWG BY BARRIERE

PID 92371

SECTION 14

T 2 N R 13 E

TYPE MONUMENT MAG NAIL/WASHER

ON SURFACE - BELOW ON

OFFSET Q PAVEMENT 3.7' LT LT : RT

 TO EDGE PAVEMENT

STATION: 306+99.07

HORZ.DATUM: NAD83 (2011)


GEOID: 18

GRID: NORTHING: 536080.718

EASTING: 1738722.920


LDP: NORTHING:

EASTING:

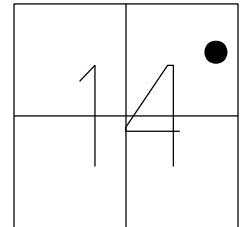

NOTE: GUARDRAIL TO BE REPLACED

RECORD: P.C.
STA. 306+99.07
SET P.K./WASHER
11/6/97, MB
FD P.K./WASHER
REF20
3/30/18, JLL
REF18
4/22/19, JFO
SET MAG/WASHER
8/19/19, JFO
FD MAG/WASHER
9/1/21, DSA
2/15/22, JFO
2/10/23, JMR
10/6/23, DSA
SET MAG/WASHER
REF18
8/15/24, TDN

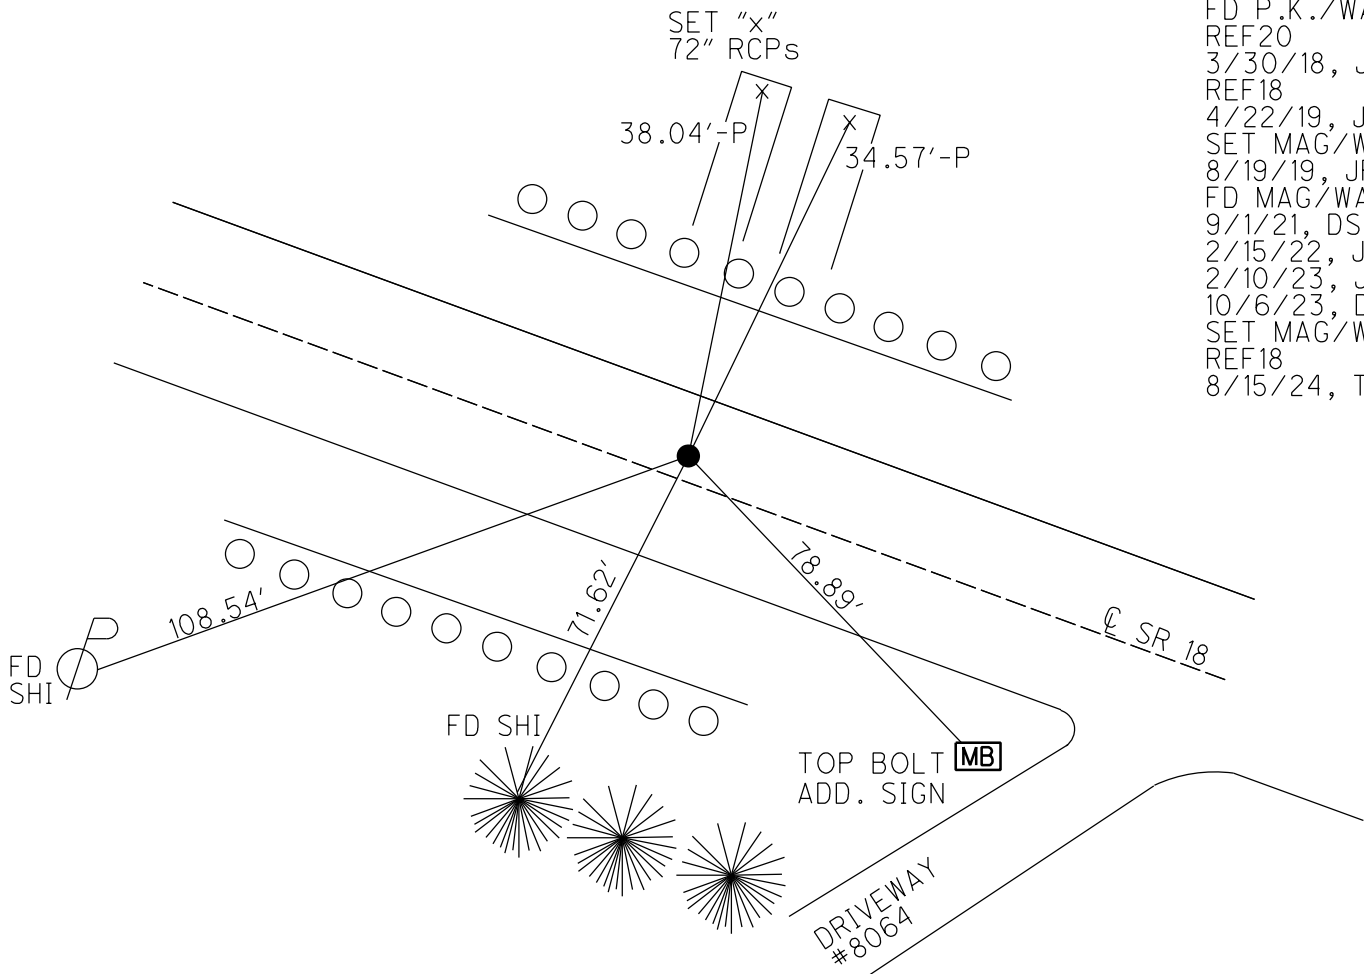

O.D.O.T. DISTRICT 2 SURVEY OFFICE (USE ONLY)

PERSONNEL

REFERENCE NO. 18 A

SHEET 18 OF 48

NOTES CRONIN DATE 1/19/90

H.C. RIPPLE WEATHER CLEAR

R.C. BARBOUR TEMP. 29°

GEYMAN

DWG BY NIESE PID NO PID

ROUTE SR 18

COUNTY SENECA

TOWNSHIP LOUDON

SECTION 13

T 2 N R 13 E

TYPE MONUMENT CALPT

ON SURFACE - BELOW -


OFFSET Q PAVEMENT 70.0' LT : RT

- TO - EDGE PAVEMENT


STATION: 314+72.85

HORIZ.DATUM: - GEOID: -

GRID: NORTHING: - EASTING: -

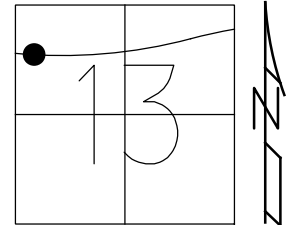

RECORD: P.I.
STA 314+72.85
 $\Delta=19^{\circ}55'00''$ LT
 $D=1^{\circ}18'00''$
 $R=4407.46'$
 $L=1532.05'$
 $T=773.78'$
 $E=67.42'$
1/2/59, CRONIN
CALCULATED POINT
WAS NEVER SET
AFTER 1958 CONSTRUCTION

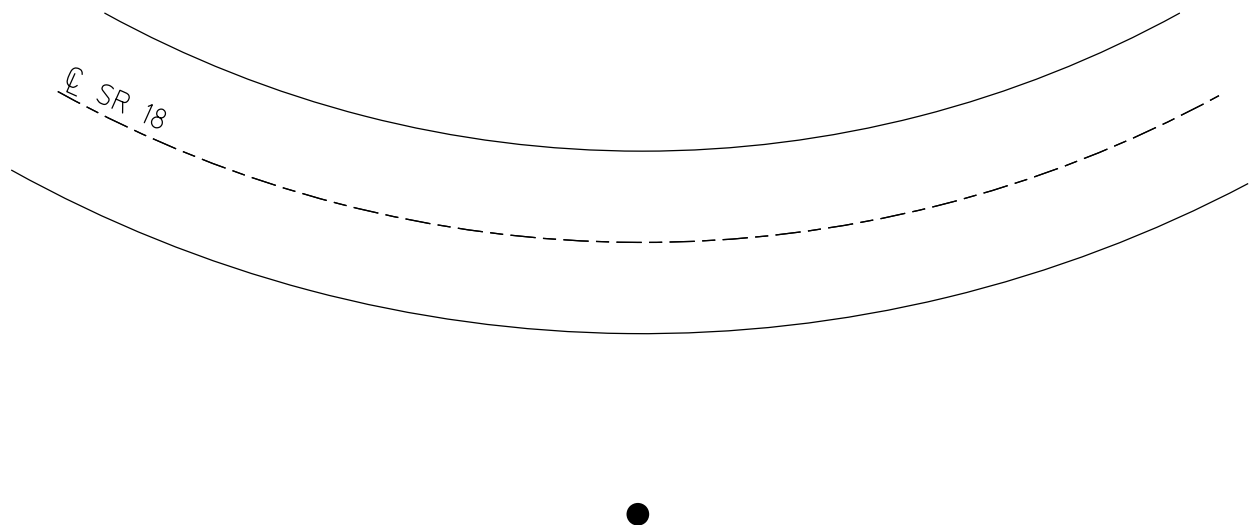

O.D.O.T. DISTRICT 2 SURVEY OFFICE (USE ONLY)

PERSONNEL

REFERENCE NO. 20

SHEET OF

NOTES BARRIERE

DATE 8/15/24

ROUTE SR 18

H.C. NIESE

WEATHER CLDY/WNDY

COUNTY SENECA

R.C. MILLER

TEMP. 63°

TOWNSHIP LOUDON

DWG BY BARRIERE

PID 92371

T 2 N R 13 E

TYPE MONUMENT MAG NAIL/WASHER

ON SURFACE - BELOW ON

OFFSET $\mathcal{Q}$ PAVEMENT 4' LT LT : RT

 TO EDGE PAVEMENT

STATION: 340+23

HORIZ.DATUM: NAD83 (2011)


GEOID: 18

GRID: NORTHING: 535098.180

EASTING: 1743113.553


LDP: NORTHING:

EASTING:

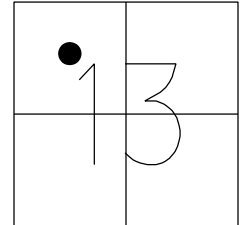

RECORD: P.I.
RR SPIKE
P.K./SHI
R.R.SPIKE
FD P.K./WASHER
6/28/01, JFO
SET P.K./WASHER
7/31/01, SAH
FD P.K./WASHER
REF20
4/22/19
8/19/19, JFO
FD RR SPIKE
3" DOWN
REF20
9/28/22, TDN
SET MAG/WASHER
REF20
8/15/24, TDN

REF 20A
FD MAG NAIL
REFA20
4/22/19, JFO
NORTHING: 535098.138
EASTING: 1743118.440
D.N.F.
9/22/22, TDN

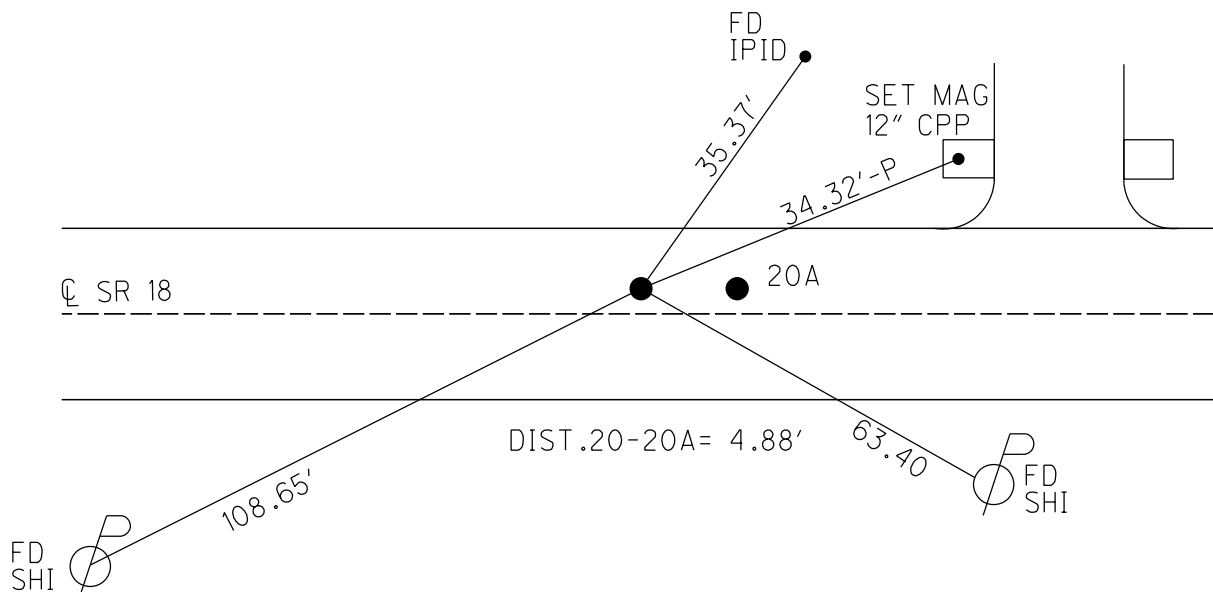

O.D.O.T. DISTRICT 2 SURVEY OFFICE (USE ONLY)

PERSONNEL

REFERENCE NO. 21

SHEET OF

NOTES BARRIERE

DATE 8/15/24

ROUTE SR 18

H.C. NIESE

WEATHER CLDY/WNDY

COUNTY SENECA

R.C. MILLER

TEMP. 63°

TOWNSHIP LOUDON

SECTION 13

DWG BY BARRIERE

PID 92371

T 2 N R 13 E

TYPE MONUMENT 1" IPIN

ON SURFACE - BELOW 3" BELOW

OFFSET Q PAVEMENT 22.9' RT LT : RT

 TO EDGE PAVEMENT

STATION: 351+88

HORZ.DATUM: NAD83 (2011)



GEOID: 18

GRID: NORTHING: 535083.681


EASTING: 1744291.202

LDP: NORTHING:

EASTING:

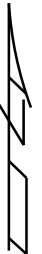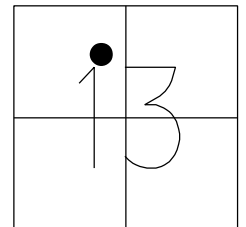

RECORD: P.I.
FD 1" IPIN
6/28/01, DCH
FD 1" IPIN
3" DOWN
REF21
4/22/19, JFO
9/22/22, TDN

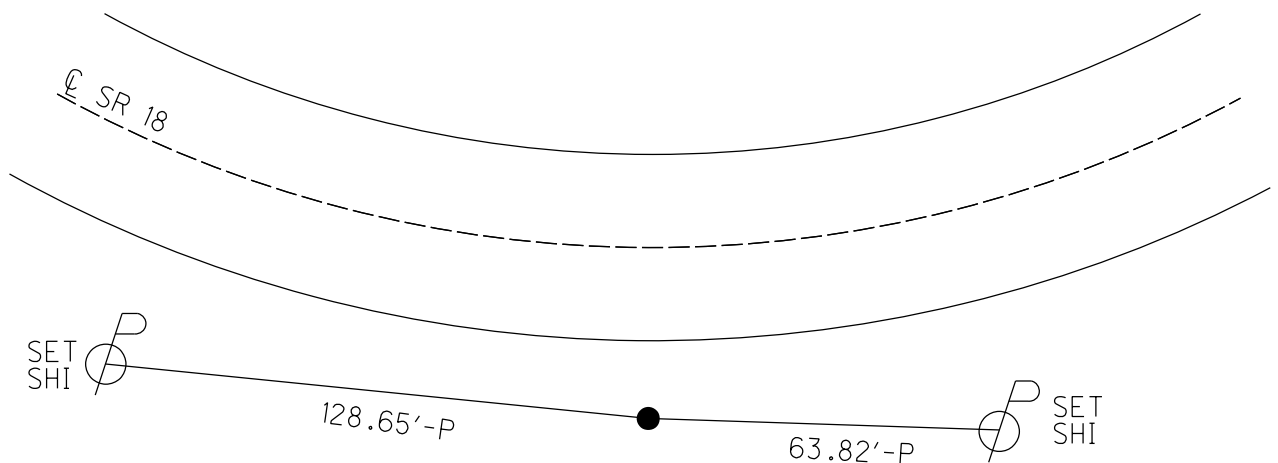

O.D.O.T. DISTRICT 2 SURVEY OFFICE (USE ONLY)

PERSONNEL

REFERENCE NO. 22

SHEET OF

NOTES BARRIERE

DATE 8/15/24

ROUTE SR 18

H.C. NIESE

WEATHER CLDY/WNDY

COUNTY SENECA

R.C. MILLER

TEMP. 75°

TOWNSHIP LOUDON

DWG BY BARRIERE

PID 92371

SECTION 13

T 2 N R 13 E

TYPE MONUMENT 1" IPIN

ON SURFACE - BELOW ON

OFFSET $\mathcal{C}$ PAVEMENT 23' RT LT : RT

 TO EDGE PAVEMENT

STATION: 364+58

HORZ.DATUM: NAD83 (2011)


GEOID: 18

GRID: NORTHING: 535429.775


EASTING: 1745516.136

LDP: NORTHING:

EASTING:

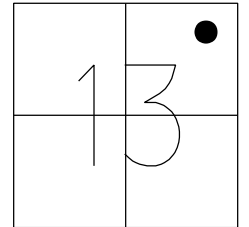

RECORD P.I.:
352+09.75
 $\Delta = 15^\circ 30' \text{ RT}$
 $D = 4^\circ 00' 00''$
 $R = 1432.69'$
 $L = 387.50'$
 $T = 194.97'$
 $E = 13.21'$
D.N.F.
4/22/19, JFO
FD 1" IPIN
REF22
9/22/22, TDN

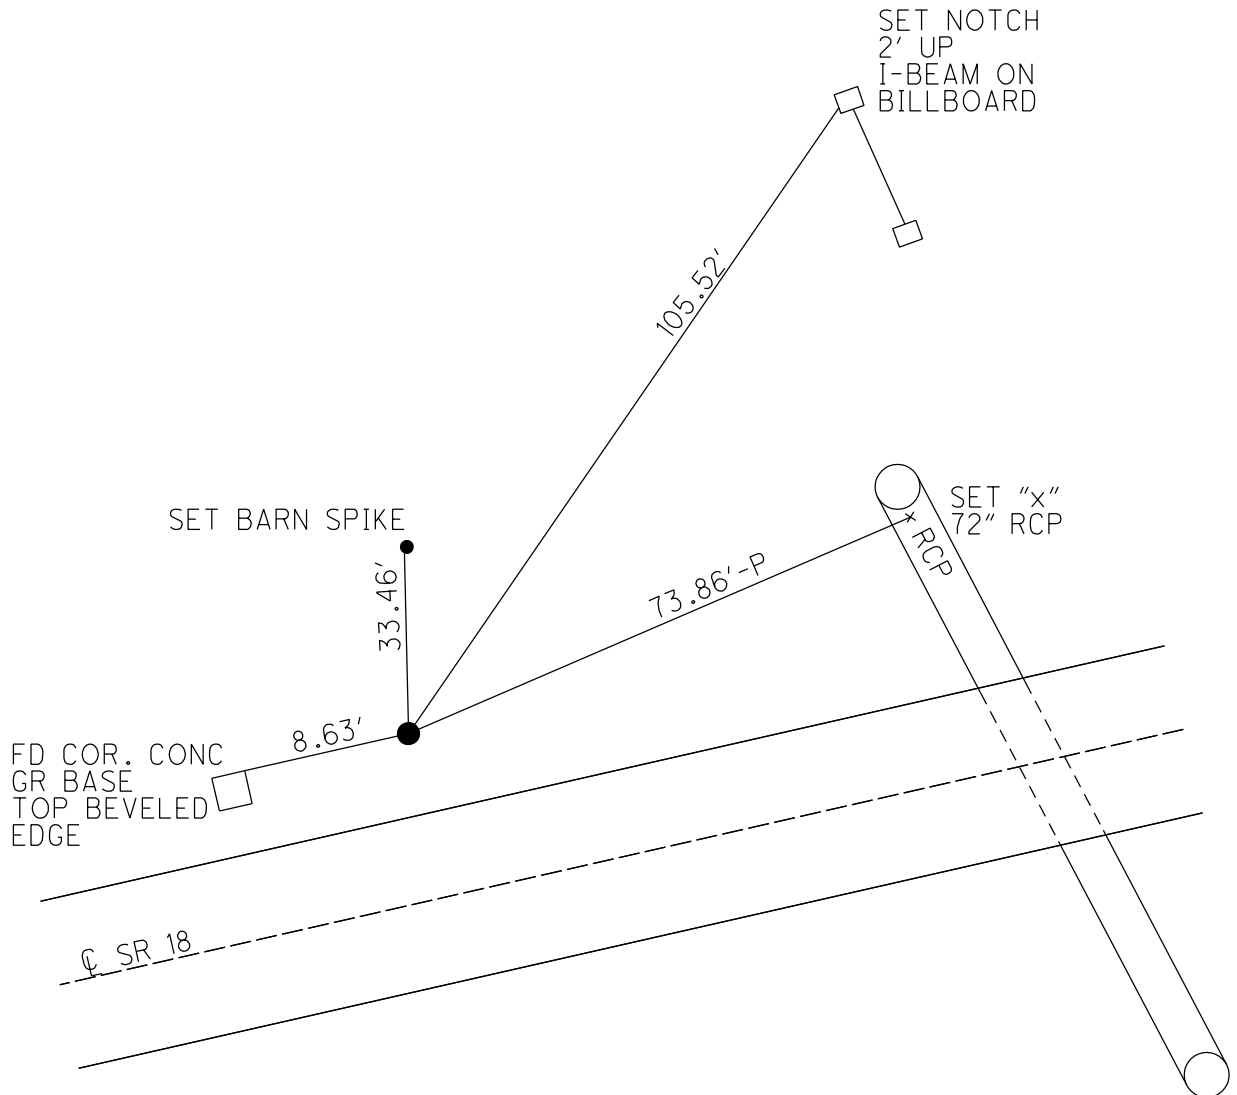

O.D.O.T. DISTRICT 2 SURVEY OFFICE (USE ONLY)

PERSONNEL

REFERENCE NO. 23

SHEET OF

NOTES BARRIERE

DATE 8/15/24

ROUTE SR 18

H.C. NIESE

WEATHER CLDY/WNDY

COUNTY SENECA

R.C. MILLER

TEMP. 75°

TOWNSHIP LOUDON

DWG BY BARRIERE

PID 92371

SECTION 13

T 2 N R 13 E

TYPE MONUMENT MAG NAIL/WASHER

ON SURFACE - BELOW ON

OFFSET $\mathcal{Q}$ PAVEMENT 7.5' LT LT : RT

 TO EDGE PAVEMENT

STATION: 378+17

HORIZ.DATUM: NAD83 (2011)


GEOID: 18

GRID: NORTHING: 535432.817


EASTING: 1746878.574

LDP: NORTHING:

EASTING:

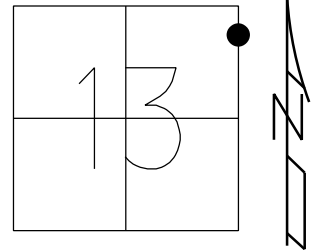

RECORD P.I.
STA. 365+70.33
 $\Delta = 2^\circ 21' 00''$ RT
D = $1^\circ 0' 00''$
R = 5729.58'
L = 235.00'
T = 117.51'
E = 1.21'
PREV. MONUMENTS:
P.K./SHI
R.R.SPIKE
FD P.K./WASHER
6/28/01, DCH
REF23
4/22/19
8/19/19, JFO
FD PK SHANK
REF23
9/22/22, TDN
SET MAG/WASHER
REF23
8/15/24, TDN

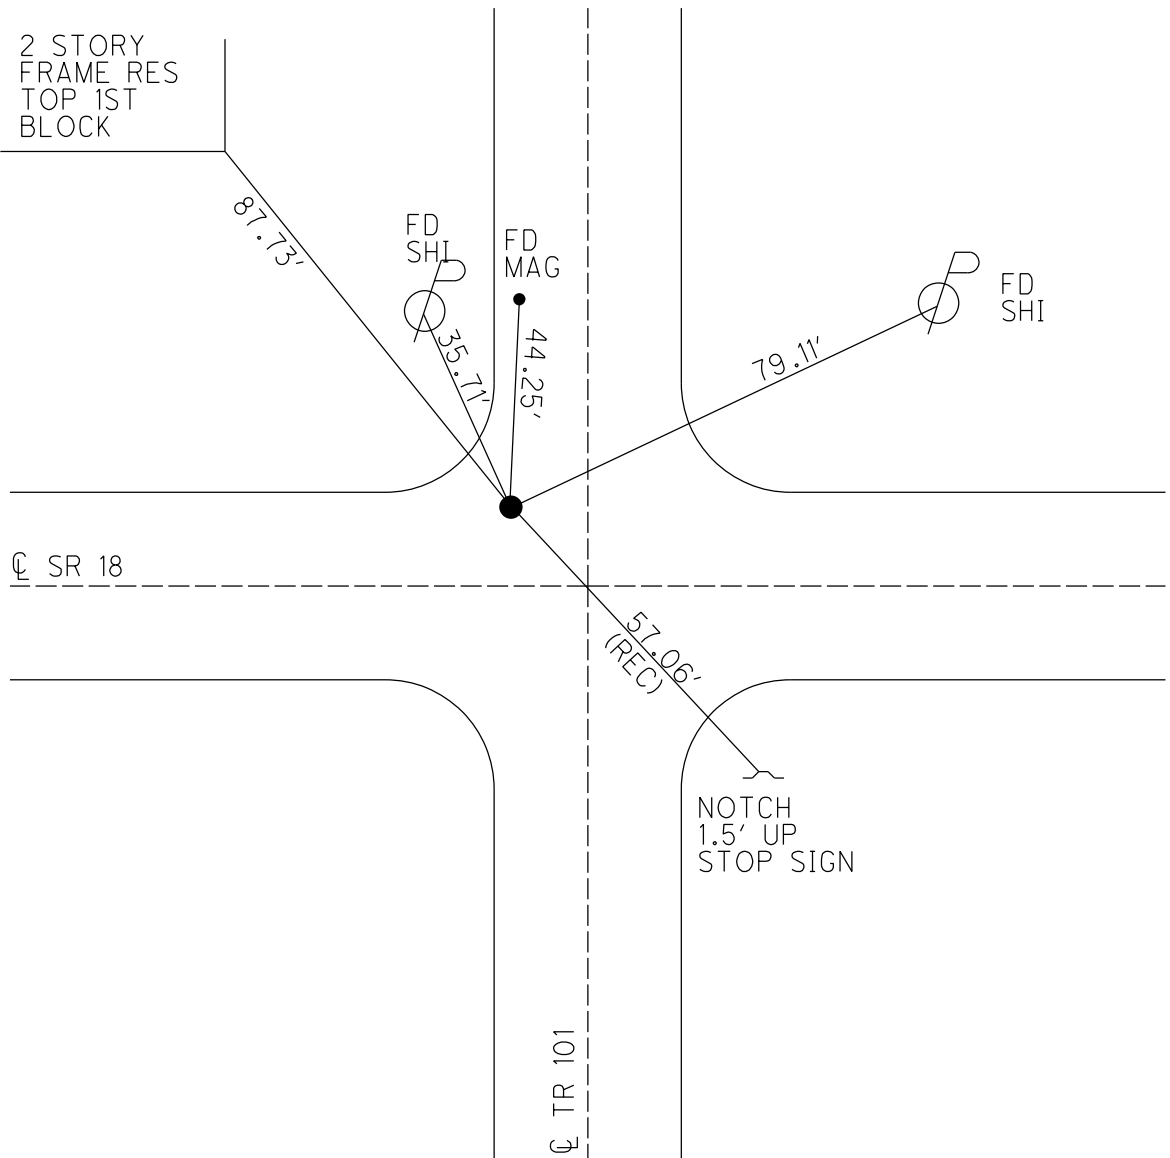

O.D.O.T. DISTRICT 2 SURVEY OFFICE (USE ONLY)

PERSONNEL

REFERENCE NO. 24

SHEET OF

NOTES BARRIERE
H.C. NIESE
R.C. MILLER

DATE 8/15/24
WEATHER CLDY/WNDY
TEMP. 75°

ROUTE SR 18
COUNTY SENECA
TOWNSHIP HOPEWELL
SECTION 18
T 2 N R 14 E

DWG BY BARRIERE PID 92371

TYPE MONUMENT MAG NAIL/WASHER

ON SURFACE - BELOW ON

OFFSET $\odot$ PAVEMENT 3' LT LT : RT

 TO EDGE PAVEMENT

STATION: 391+69

HORZ.DATUM: NAD83 (2011)


GEOID: 18

GRID: NORTHING: 535381.632



EASTING: 1748194.546

LDP: NORTHING:

EASTING:

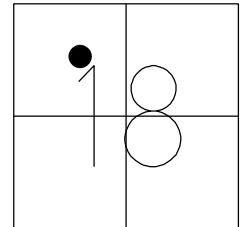

RECORD: P.I.
 $\odot$ SURVEY-BACK
STA.378+88.39
PREV MONUMENTS
P.K.NAIL
R.R.SPIKE
FD P.K./WASHER
6/28/01, DCH
SET P.K./WASHER
7/31/01, SAH
FD P.K./WASHER
REF24
4/22/19
8/19/19, JFO
FD PK SHANK
REF24
9/22/22, TDN
SET MAG/WASHER
REF24
8/15/24, TDN

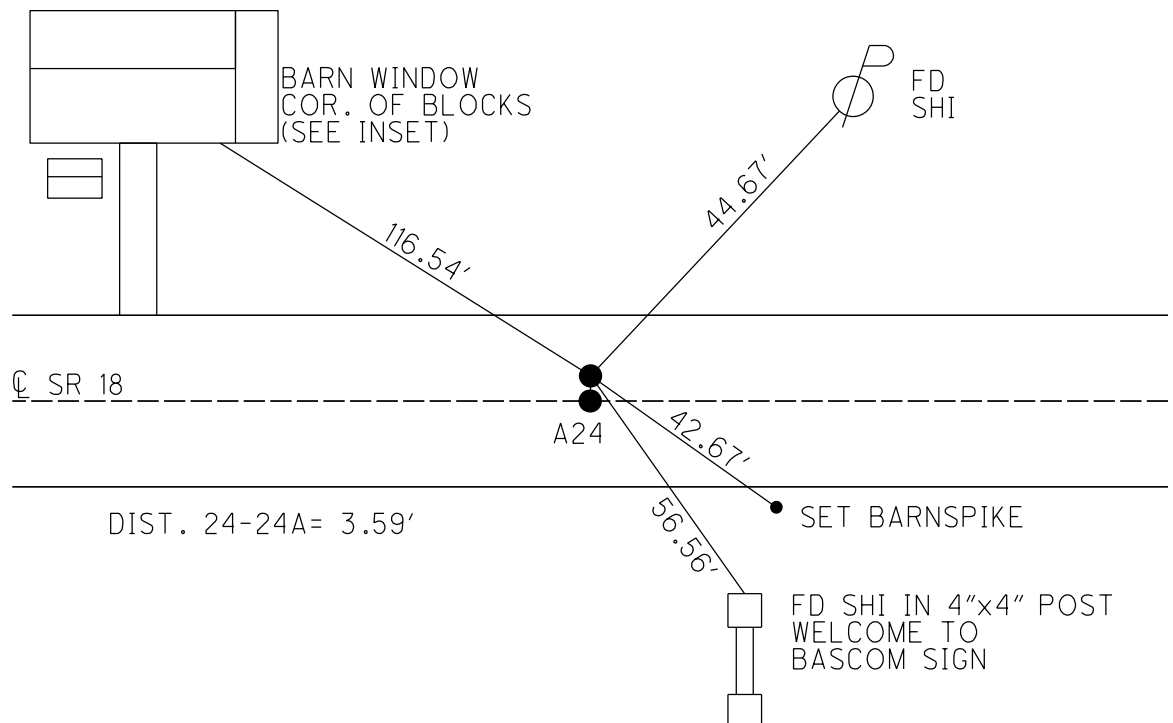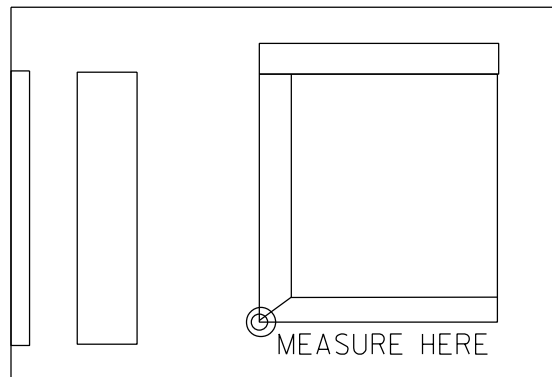

O.D.O.T. DISTRICT 2 SURVEY OFFICE (USE ONLY)

PERSONNEL

REFERENCE NO. A24

SHEET _____ OF _____

NOTES BARRIERE

DATE 8/15/24

ROUTE SR 18

H.C. NIESE

WEATHER CLDY/WNDY

COUNTY SENECA

R.C. MILLER

TEMP. 75°

TOWNSHIP HOPEWELL

DWG BY BARRIERE

PID 92371

SECTION 18

T 2 N R 14 E

TYPE MONUMENT MAG NAIL/WASHER

ON SURFACE - BELOW ON

OFFSET $\odot$ PAVEMENT 0.5' RT LT : RT

TO EDGE PAVEMENT

STATION: 391+69

HORZ.DATUM: NAD83 (2011)


GEOID: 18

GRID: NORTHING: 535378.043

EASTING: 1748194.432



LDP: NORTHING: _____

EASTING: _____

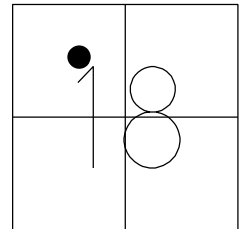

RECORD: P.I.
 $\odot$ SURVEY-CONSTRUCTION

STA.378+88.39
PREV MONUMENTS
P.K.NAIL
R.R.SPIKE
FD P.K./WASHER
6/28/01, DCH
SET P.K./WASHER
7/31/01, SAH
FD P.K./WASHER
REFA24
4/22/19
8/19/19, JFO
FD PK/WASHER
REFA24
9/22/22, TDN
SET MAG/WASHER
REFA24
8/15/24, TDN

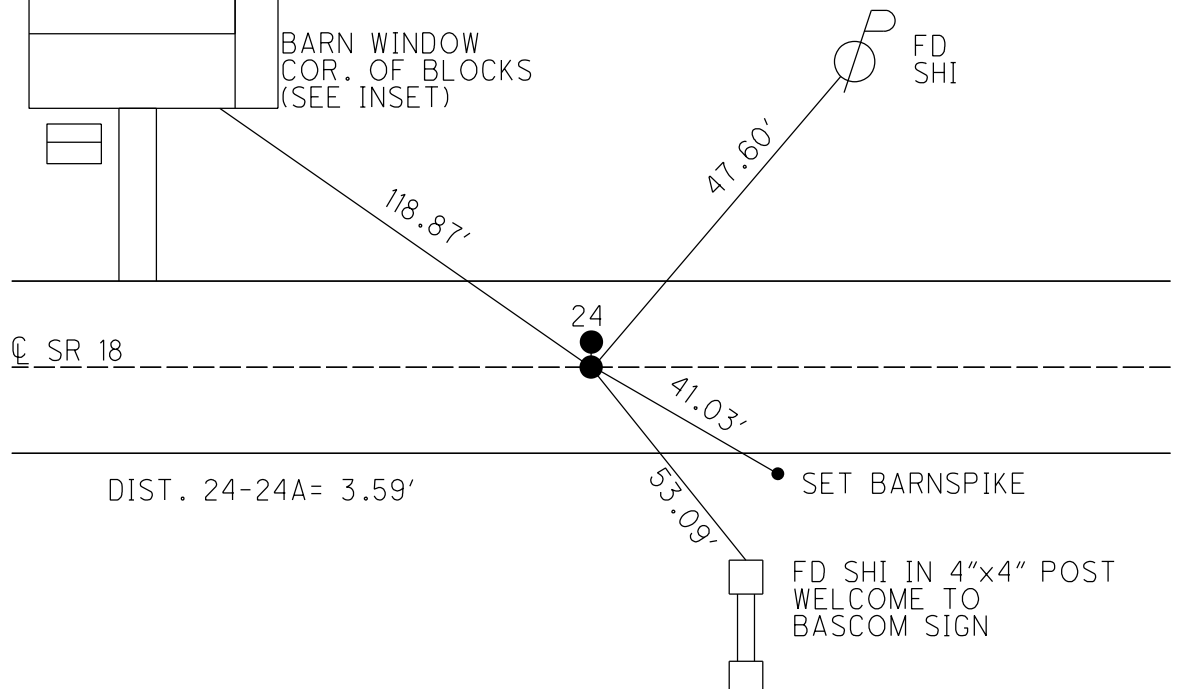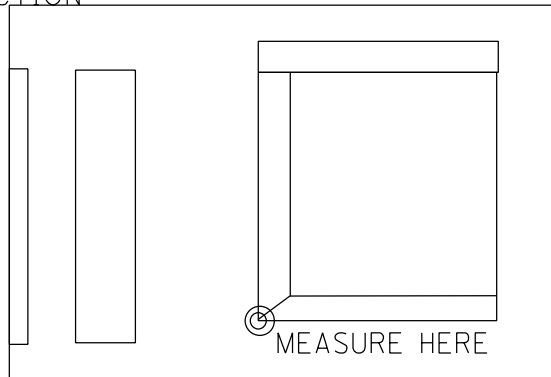

O.D.O.T. DISTRICT 2 SURVEY OFFICE (USE ONLY)

PERSONNEL

REFERENCE NO. 25

SHEET OF

NOTES BARRIERE

DATE 8/15/24

ROUTE SR 18

H.C. NIESE

WEATHER CLDY/WNDY

COUNTY SENECA

R.C. MILLER

TEMP. 74°

TOWNSHIP HOPEWELL

DWG BY BARRIERE

PID 92371

SECTION 18

T 2 N R 14 E

TYPE MONUMENT MAG NAIL/WASHER

ON SURFACE - BELOW ON

OFFSET $\text{\textcircled{C}}$ PAVEMENT 8.5' LT LT : RT

 TO EDGE PAVEMENT

STATION: 396+10

HORIZ.DATUM: NAD83 (2011)


GEOID: 18

GRID: NORTHING: 535360.875


EASTING: 1748634.266

LDP: NORTHING:

EASTING:

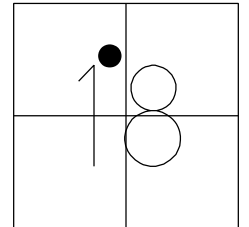

RECORD P.I.:
 STA 383+28.17
 $\Delta=7^{\circ}05'00''$ RT
 $D=1^{\circ}20'00''$
 $R=4297.18'$
 $L=531.25'$
 $T=265.96'$
 $E=8.22'$
 PREV. MONUMENTS
 P.K./SHI
 R.R.SPIKE
 FD P.K./WASHER
 6/28/01, DCH
 SET P.K./WASHER
 7/31/01, SAH
 FD P.K./WASHER
 REF25
 4/22/19
 8/19/19, JFO
 9/22/22, TDN
 SET MAG/WASHER
 REF25
 8/15/24, TDN

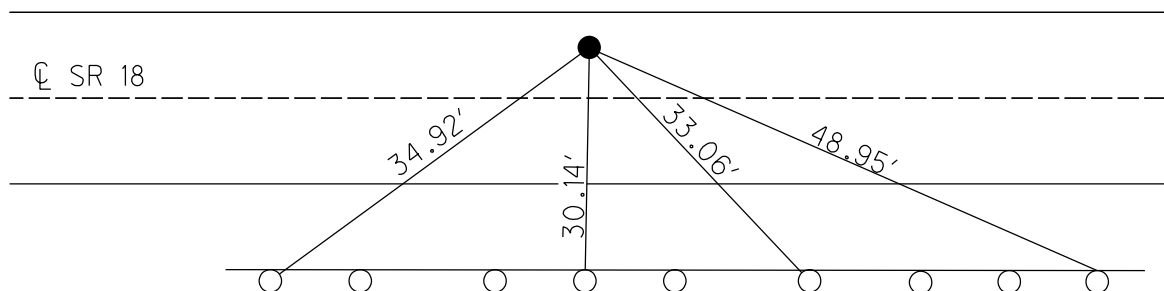

SET SHI
GR POSTS

O.D.O.T. DISTRICT 2 SURVEY OFFICE (USE ONLY)

PERSONNEL

REFERENCE NO. 26

SHEET OF

NOTES BARRIERE
H.C. NIESE
R.C. MILLER

DATE 8/15/24
WEATHER CLDY/WNDY
TEMP. 74°

ROUTE SR 18
COUNTY SENECA
TOWNSHIP HOPEWELL
SECTION 18

DWG BY BARRIERE PID 92371

T 2 N R 14 E

TYPE MONUMENT MAG NAIL/WASHER

ON SURFACE - BELOW ON

OFFSET C PAVEMENT 9' RT LT : RT

 TO EDGE PAVEMENT

STATION: 404+01

HORIZ.DATUM: NAD83 (2011)



GEOID: 18

GRID: NORTHING: 535233.426


EASTING: 1749407.419

LDP: NORTHING:

EASTING:

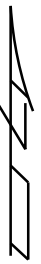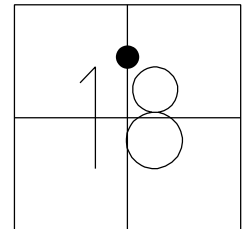

RECORD P.I.:
STA 391+11.32
 $\Delta=8^{\circ}25'00''$ LT
D=2°30'00"
R =2291.83'
L =300.00'
T =318.74'
L =36.67'
E =7.83'
S.C.=390+92.58
C.S.=391+29.25
PREV MONUMENTS
PK/SHI
RR SPIKE
SET PK/WASHER
7/31/01, SAH
FD PK/WASHER
REF26
4/22/19
8/19/19, JFO
9/22/22, TDN
SET MAG/WASHER
REF26
8/15/24, TDN

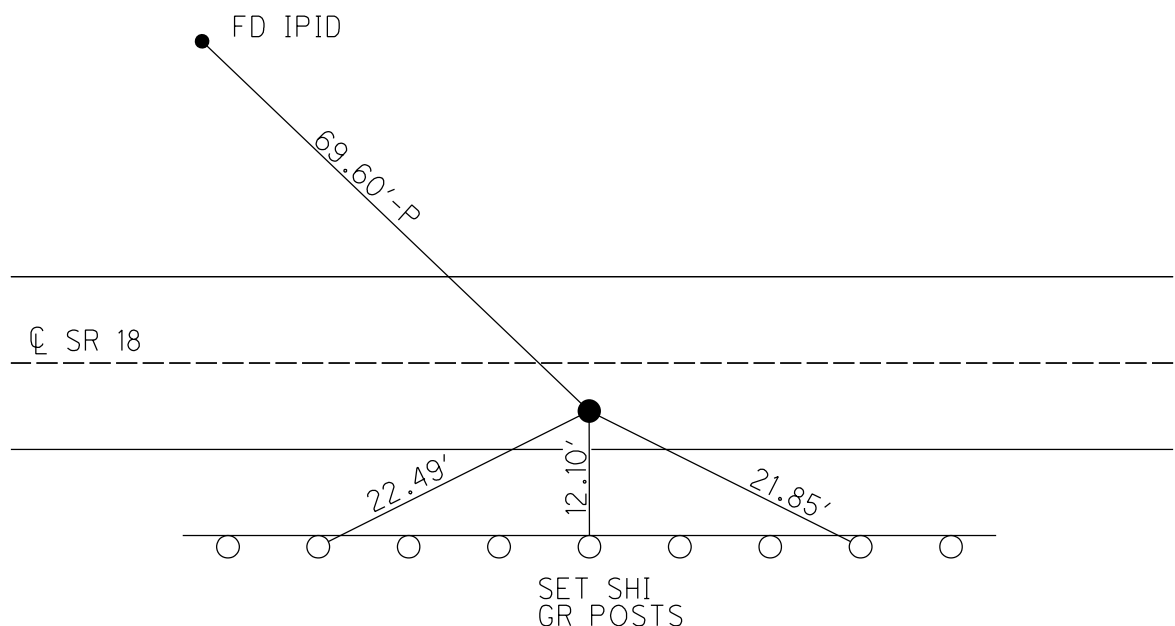

O.D.O.T. DISTRICT 2 SURVEY OFFICE (USE ONLY)

PERSONNEL

REFERENCE NO. 27

SHEET 27 OF 48

NOTES CORDES
H.C. HOMAN
R.C. VAN DUSEN
CANTERBURY

DATE 6/28/01
WEATHER SUNNY
TEMP. 90°

ROUTE SR 18
COUNTY SENECA
TOWNSHIP HOPEWELL
SECTION 18
T 2 N R 14 E

DWG BY NIESE PID NO PID

TYPE MONUMENT P.K./WASHER


ON SURFACE - ~~BELOW~~ ON

OFFSET CL PAVEMENT 1.0' LT : ~~RT~~
15.7' TO RT EDGE PAVEMENT


STATION: 419+69.88

HORIZ.DATUM: NAD83(2011) GEOID: 2012A

GRID: NORTHING: 535206.219 EASTING: 1751051.442

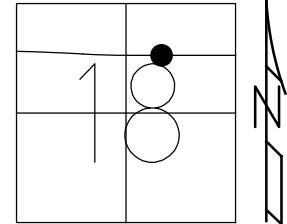

RECORD P.I.
STA 407+80.90
 $\Delta = 3^\circ 27' 00''$ RT
FD P.K./WASHER
6/28/01, DCH
SET P.K./WASHER
8/1/01, SAH
FD P.K./WASHER
12/5/14, DCH
REF27
12/11/14, EBW
FD P.K./WASHER
REF27
4/22/19
FD 8/19/19, JFO

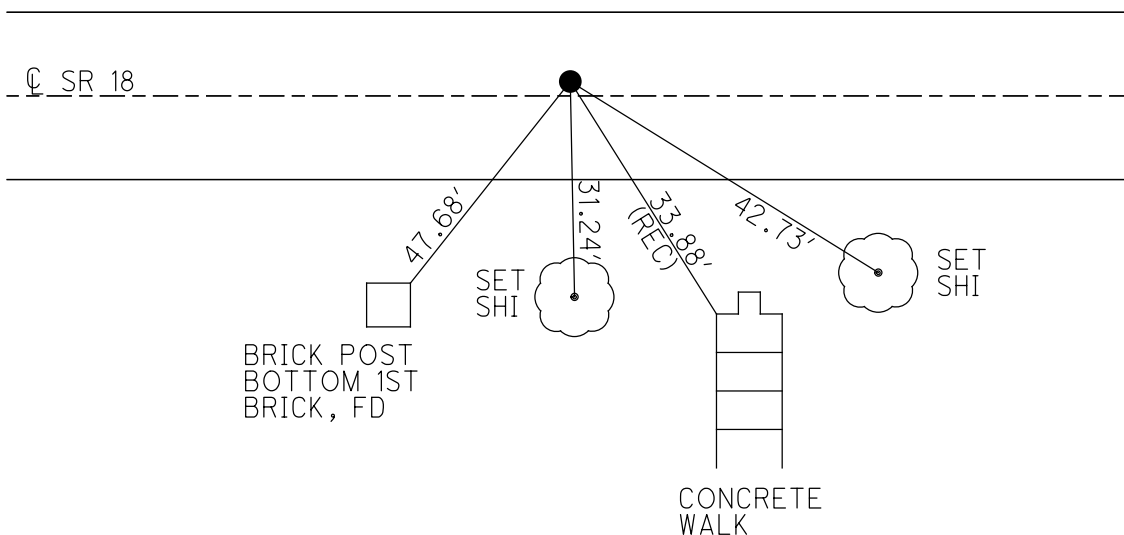

O.D.O.T. DISTRICT 2 SURVEY OFFICE (USE ONLY)

PERSONNEL

REFERENCE NO. 28

SHEET 28 OF 48

NOTES RHOADES

DATE 12/19/18

ROUTE SR 18

H.C. O'DONNELL

WEATHER FAIR

COUNTY SENECA

R.C. RHOADES

TEMP. 35°

TOWNSHIP HOPEWELL

DWG BY RHOADES PID 92128

SECTION 18

T 2 N R 14 E

TYPE MONUMENT DRILLH

ON SURFACE - ~~BELOW~~ ON

OFFSET 1' LT : RT

- TO - EDGE PAVEMENT


STATION: 431+78

HORIZ.DATUM: NAD83(2011)


GEOID: 2012A

GRID: NORTHING: 535119.000

EASTING: 1752182.656

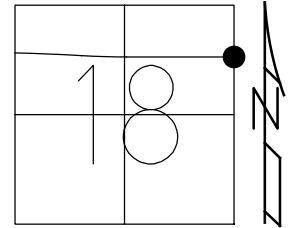

RECORD:
FD 1/2" IPIN
3" DOWN
REF A1
5/4/18, JFO
6/12/18, JMR
SET DRILLH
IN CONC
NEW REF A1
4/22/19, JFO

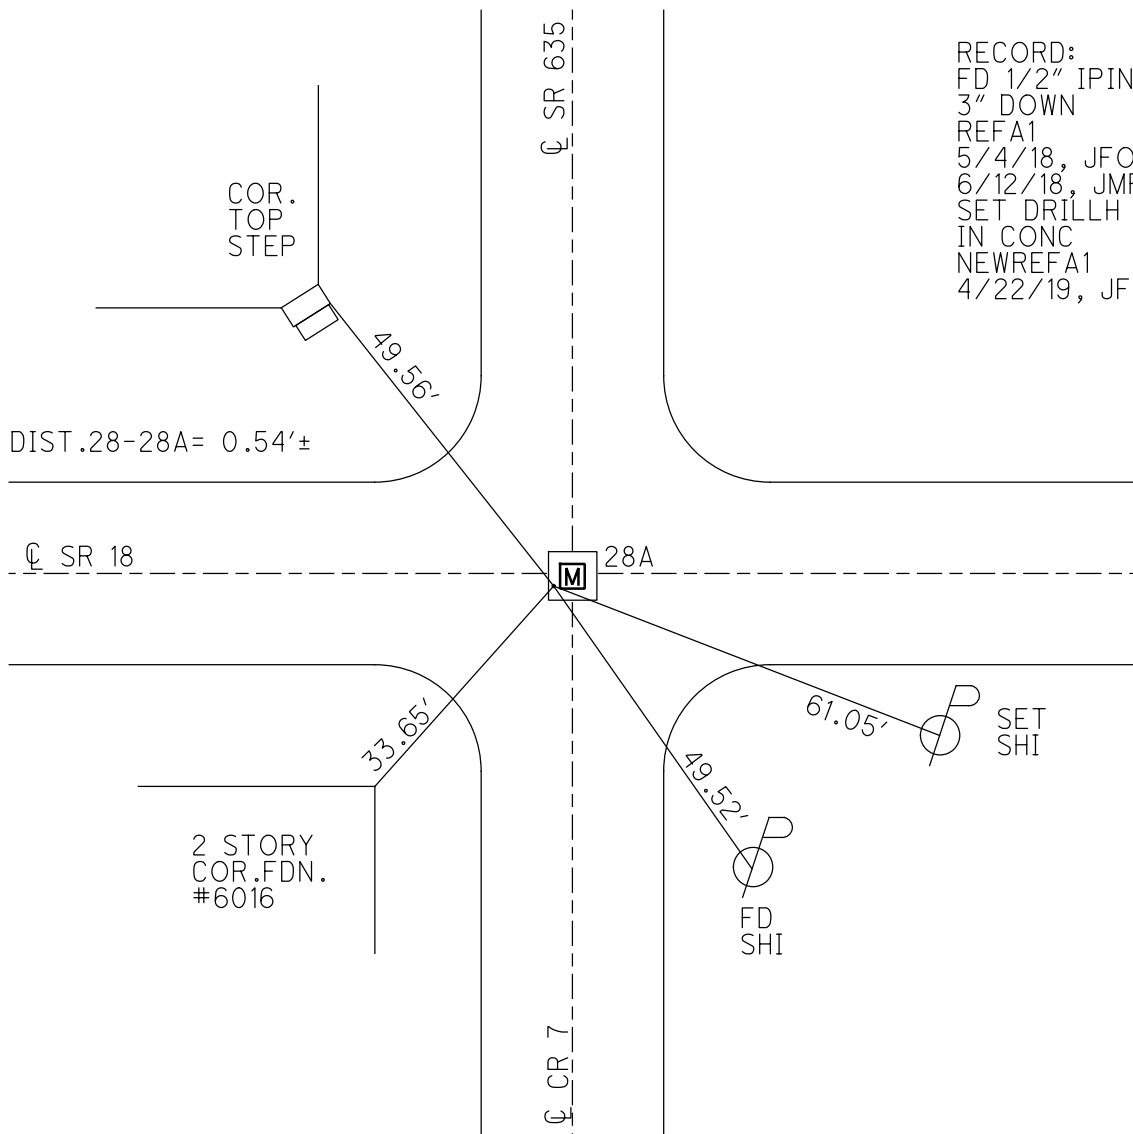

O.D.O.T. DISTRICT 2 SURVEY OFFICE (USE ONLY)

PERSONNEL

REFERENCE NO. 28 A

SHEET 29 OF 48

NOTES RHOADES

DATE 12/19/18

ROUTE SR 18

H.C. O'DONNELL

WEATHER FAIR

COUNTY SENECA

R.C. RHOADES

TEMP. 35°

TOWNSHIP HOPEWELL

SECTION 18

DWG BY RHOADES PID 92128

T 2 N R 14 E

TYPE MONUMENT MONBOX W/1" IPIN

ON SURFACE - ~~BELOW~~ ON

OFFSET Q PAVEMENT - LT : RT

- TO EDGE PAVEMENT


STATION: 431+78

HORZ.DATUM: NAD83 2011


GEOID: 2012A

GRID: NORTHING: 535118.908

EASTING: 1752183.195

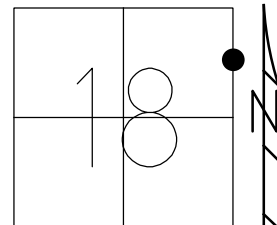

NOTE: REF 1A SR 635

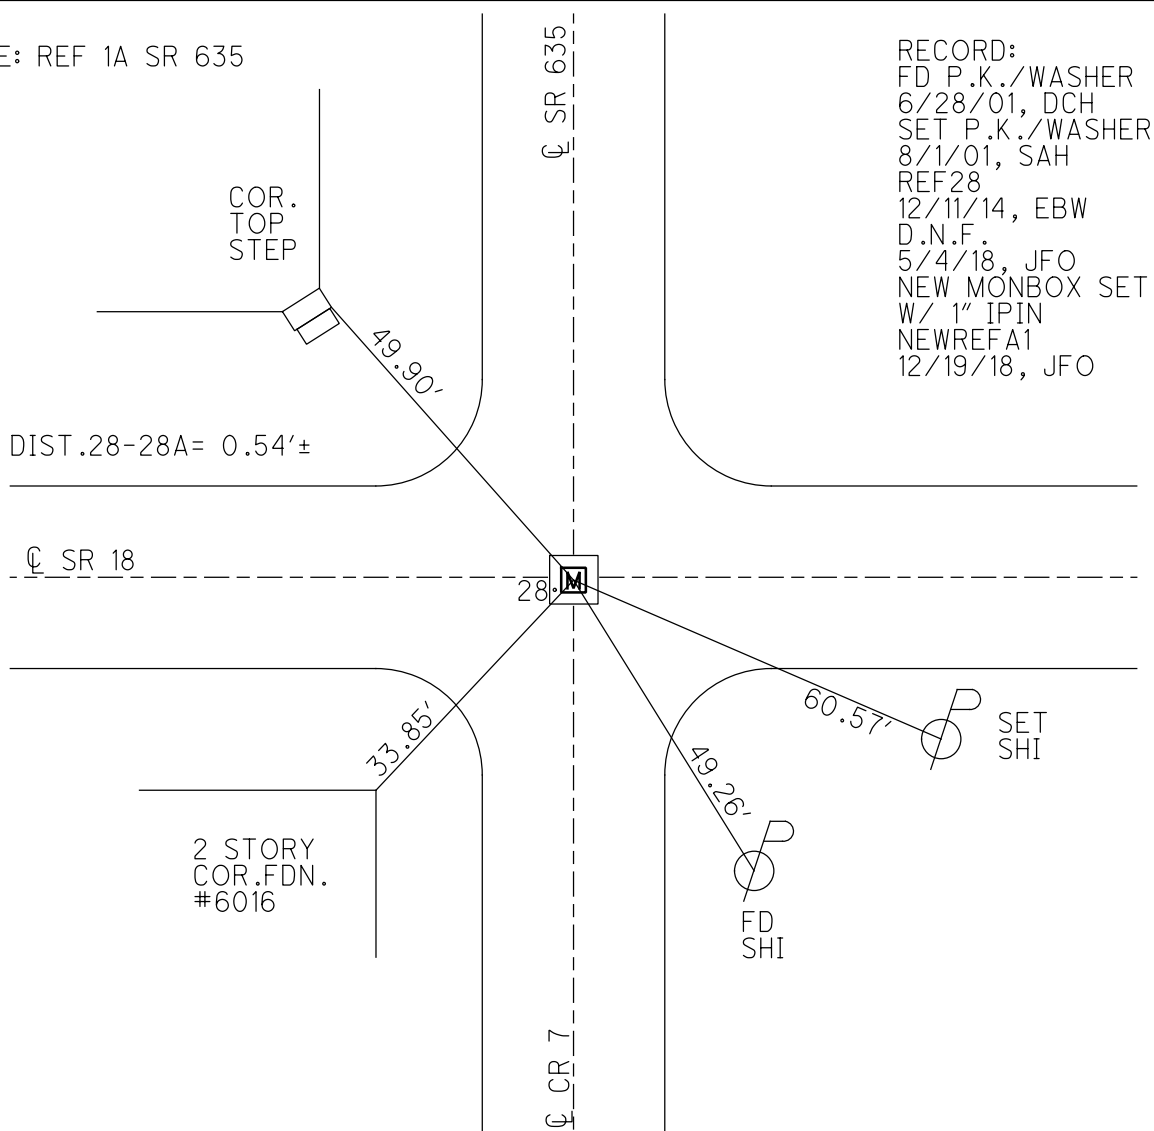

RECORD:
FD P.K./WASHER
6/28/01, DCH
SET P.K./WASHER
8/1/01, SAH
REF28
12/11/14, EBW
D.N.F.
5/4/18, JFO
NEW MONBOX SET
W/ 1" IPIN
NEWREFA1
12/19/18, JFO

O.D.O.T. DISTRICT 2 SURVEY OFFICE (USE ONLY)

PERSONNEL

REFERENCE NO. 28 B

SHEET 30 OF 48

NOTES NIESE

DATE 11/6/23

ROUTE SR 18

H.C. AUBLE

WEATHER CLOUDY

COUNTY SENECA

R.C. RHOADES

TEMP. 58°

TOWNSHIP HOPEWELL

SECTION 17

DWG BY RHOADES PID R/W

T 2 N R 14 E

TYPE MONUMENT R.R. SPIKE

~~ON SURFACE~~ - BELOW 3"

OFFSET Q PAVEMENT - LT : RT

- TO - EDGE PAVEMENT


STATION: 435+83.75

HORZ.DATUM: NAD83(2011)

GEOID: NAVD88 2018


GRID: NORTHING: 535080.510

EASTING: 1752680.447

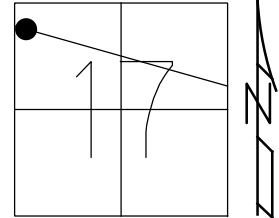

FD R.R.SPIKE
3" DOWN
REFA9
11/1/17
8/19/19, JLL
FD R.R.SPIKE
3" DOWN
REF28B
11/6/23, DSA

SENECA LPD:
N: 303589.871
E: 127266.421

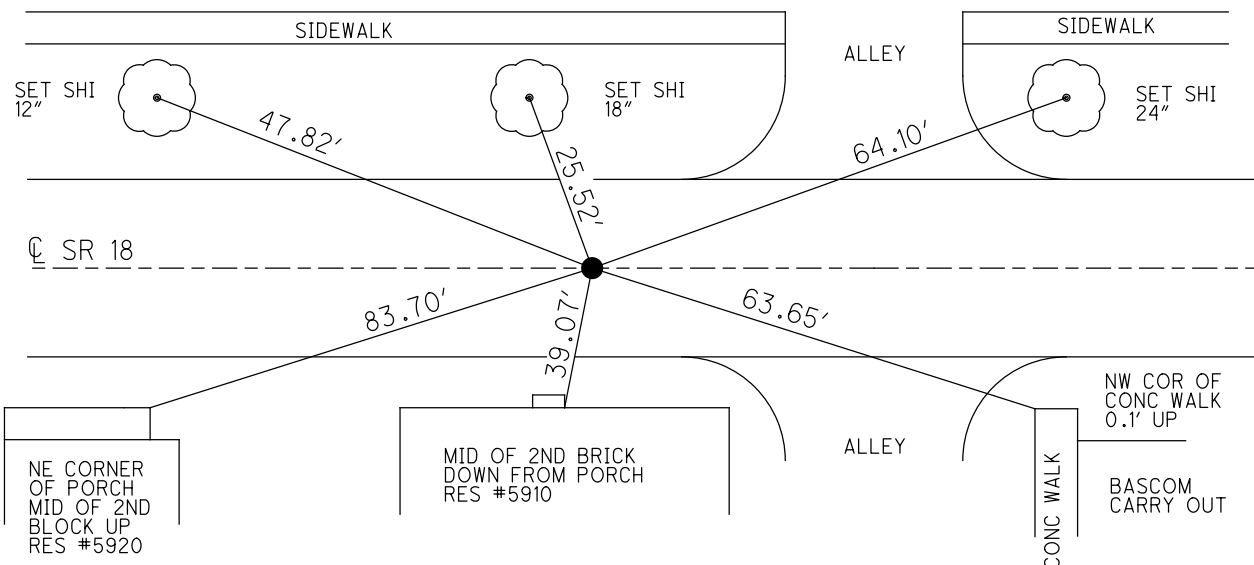

O.D.O.T. DISTRICT 2 SURVEY OFFICE (USE ONLY)

PERSONNEL

REFERENCE NO. 29

SHEET 31 OF 48

NOTES NIESE

DATE 11/6/23

ROUTE SR 18

H.C. AUBLE

WEATHER CLOUDY

COUNTY SENECA

R.C. RHOADES

TEMP. 58°

TOWNSHIP HOPEWELL

SECTION 17

DWG BY RHOADES

PID R/W

T 2 N R 14 E

TYPE MONUMENT P.K./WASHER

ON SURFACE - ~~BELOW~~ ON

OFFSET CL PAVEMENT ON LT : RT

16.0' TO RT EDGE PAVEMENT


STATION: 446+08.90

HORZ.DATUM: NAD83(2011)

GEOID: NAVD88 2018


GRID: NORTHING: 534994.953

EASTING: 1753702.041

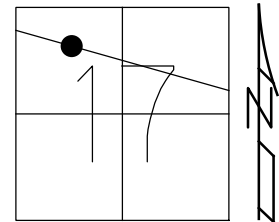

SENECA LPD:
N: 303511.922
E: 128288.729

RECORD:
PREV MONUMENTS:
P.K./SHINER
R.R.SPIKE
FD P.K./WASHER
6/28/01, DCH
SET P.K./WASHER
8/1/01, SAH
FD P.K./WASHER
12/5/14, DCH
REF29
12/11/14, EBW
FD P.K./WASHER
REF29
4/23/19
8/19/19, JFO
FD P.K./WASHER
REF29
11/6/23, DSA

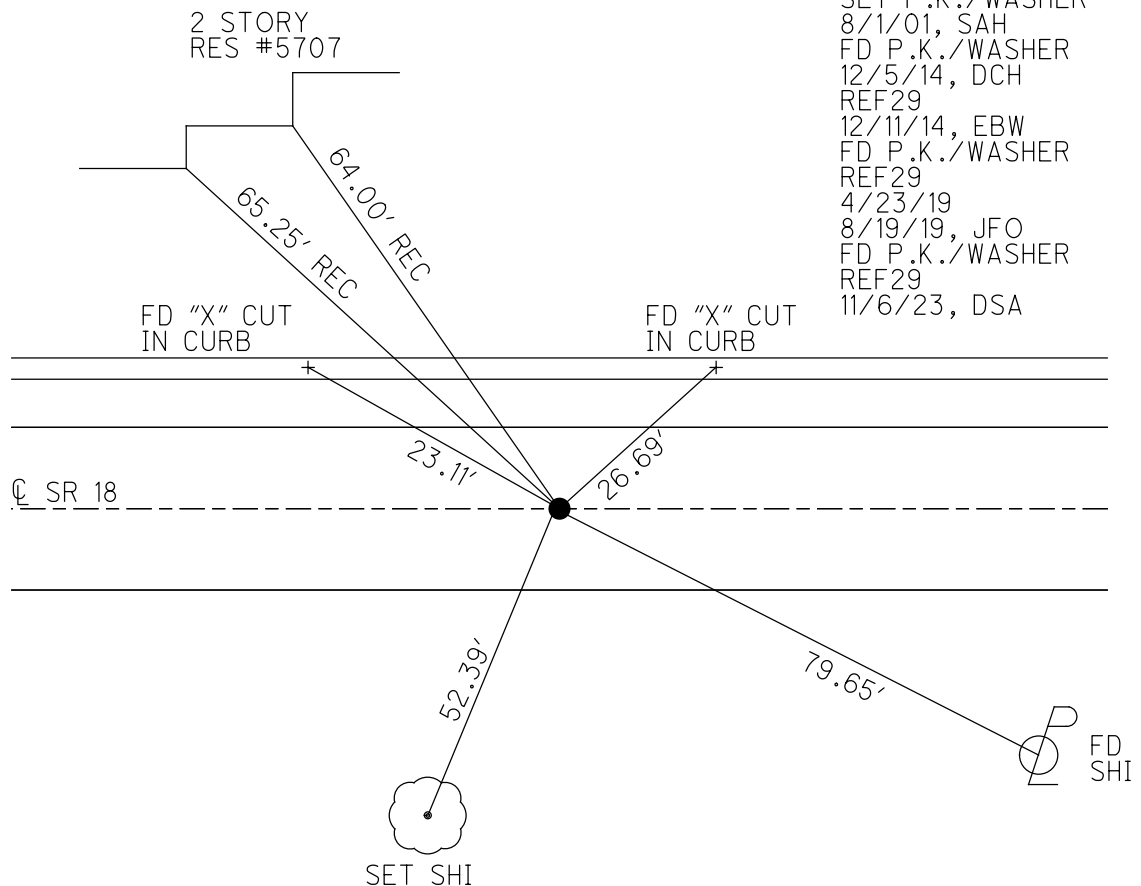

O.D.O.T. DISTRICT 2 SURVEY OFFICE (USE ONLY)

PERSONNEL

REFERENCE NO. 30

SHEET 32 OF 48

NOTES NIESE

DATE 11/6/23

ROUTE SR 18

H.C. AUBLE

WEATHER CLOUDY

COUNTY SENECA

R.C. RHOADES

TEMP. 58°

TOWNSHIP HOPEWELL

SECTION 17

DWG BY RHOADES PID R/W

T 2 N R 14 E

TYPE MONUMENT P.K.NAIL

ON SURFACE - ~~BELOW~~ ON

OFFSET Q PAVEMENT 2.0' ~~LT~~ : RT

14.0' TO RT EDGE PAVEMENT


STATION: 454+71

HORIZ.DATUM: NAD83(2011)

GEOID: 2012A

GRID: NORTHING: 534912.472

EASTING: 1754473.286

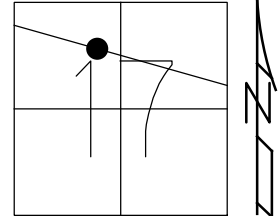

RECORD:

STA 442+14.82

$\Delta = 1^{\circ}16'00''$ LT

PREV. MONUMENTS:

P.K./WASHER

R.R.SPIKE

FD P.K./WASHER

6/4/01, BVD

SET P.K./WASHER

8/1/01, SAH

FD P.K./WASHER

REF30

4/23/19

8/19/19, JFO

FD P.K.NAIL

REF30

11/6/23, DSA


SENECA LPD:

N: 303435.170

E: 129060.638

RES#5571

BALTIMORE
OHIO
RAILROAD

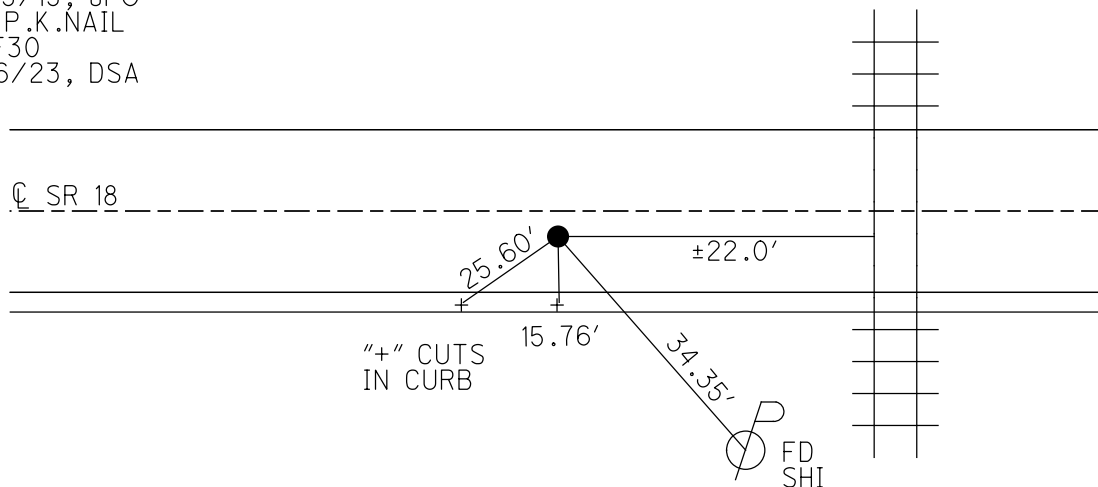

O.D.O.T. DISTRICT 2 SURVEY OFFICE (USE ONLY)

PERSONNEL

REFERENCE NO. 31

SHEET 33 OF 48

NOTES VAN DUSEN

DATE 6/4/01

ROUTE SR 18

H.C. ROUSOS

WEATHER SUNNY

COUNTY SENECA

R.C. BROWN

TEMP. 60°

TOWNSHIP HOPEWELL

DWG BY NIESE

PID NO PID

SECTION 17

T 2 N R 14 E

TYPE MONUMENT P.K./WASHER

ON SURFACE - ~~BELOW~~ ON

OFFSET 14.5' TO LT EDGE PAVEMENT

14.5' TO LT EDGE PAVEMENT


STATION: 459+96

HORIZ.DATUM: NAD83(2011)

GEOID: 2012A

GRID: NORTHING: 534865.903

EASTING: 1755024.710

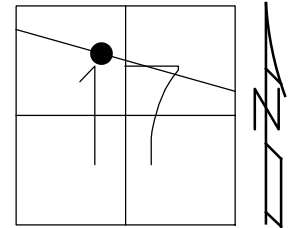

RECORD:

STA 447+68.27

$\Delta = 1^{\circ} 02' 00''$ LT

PREV MONUMENTS:

P.K./WASHER

R.R.SPIKE

FD P.K./WASHER

6/4/01, BVD

SET P.K./WASHER


8/1/01, SAH

FD P.K./WASHER

REF31

4/23/19

8/19/19, JFO

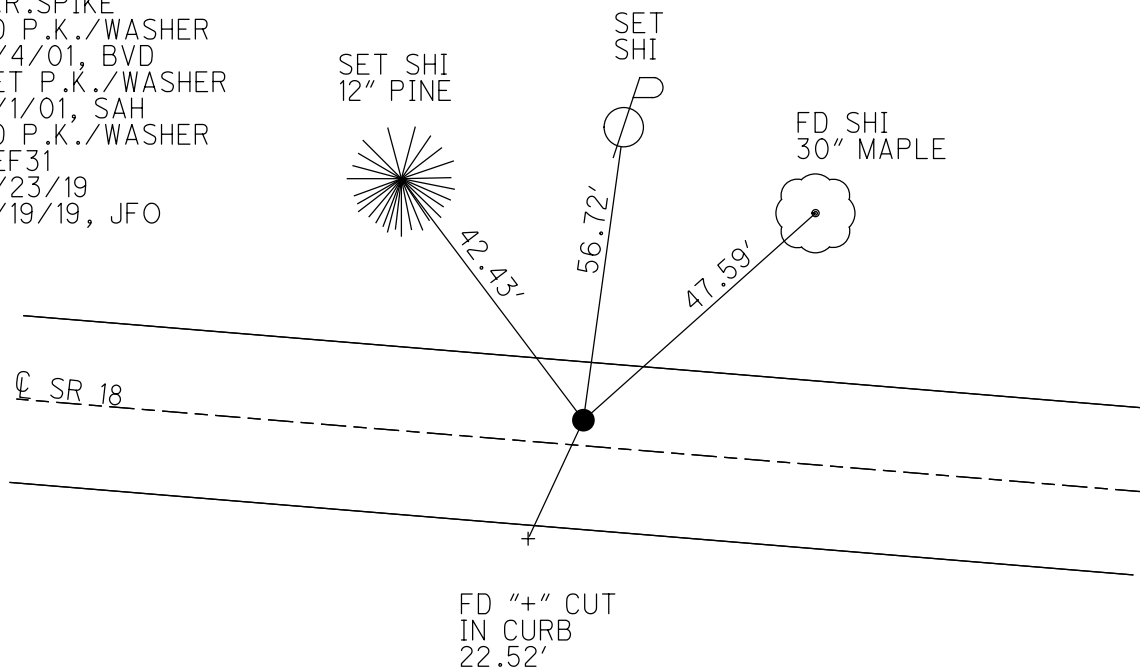

O.D.O.T. DISTRICT 2 SURVEY OFFICE (USE ONLY)

PERSONNEL

REFERENCE NO. 32

SHEET 34 OF 48

NOTES VAN DUSEN

DATE 6/04/01

ROUTE SR 18

H.C. ROUSOS

WEATHER SUNNY

COUNTY SENECA

R.C. BROWN

TEMP. 60°

TOWNSHIP HOPEWELL

DWG BY NIESE

PID NO PID

SECTION 17

T 2 N R 14 E

TYPE MONUMENT P.K./WASHER

ON SURFACE - ~~BELOW~~ ON

OFFSET Q PAVEMENT 8.0' LT : ~~RT~~

7.0' TO LT EDGE PAVEMENT


STATION: 464+05

HORZ.DATUM: NAD83(2011)

GEOID: 2012A


GRID: NORTHING: 534840.602

EASTING: 1755403.806

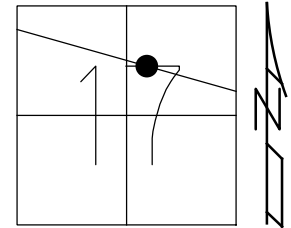

RECORD:
STA. 451+48.06
PREV. MONUMENTS:
P.K./SHINER
R.R. SPIKE
FD P.K./WASHER
6/4/01, BVD
SET P.K./WASHER
8/1/01, SAH
FD P.K./WASHER
REF32
4/23/19
8/19/19, JFO

RES#5385

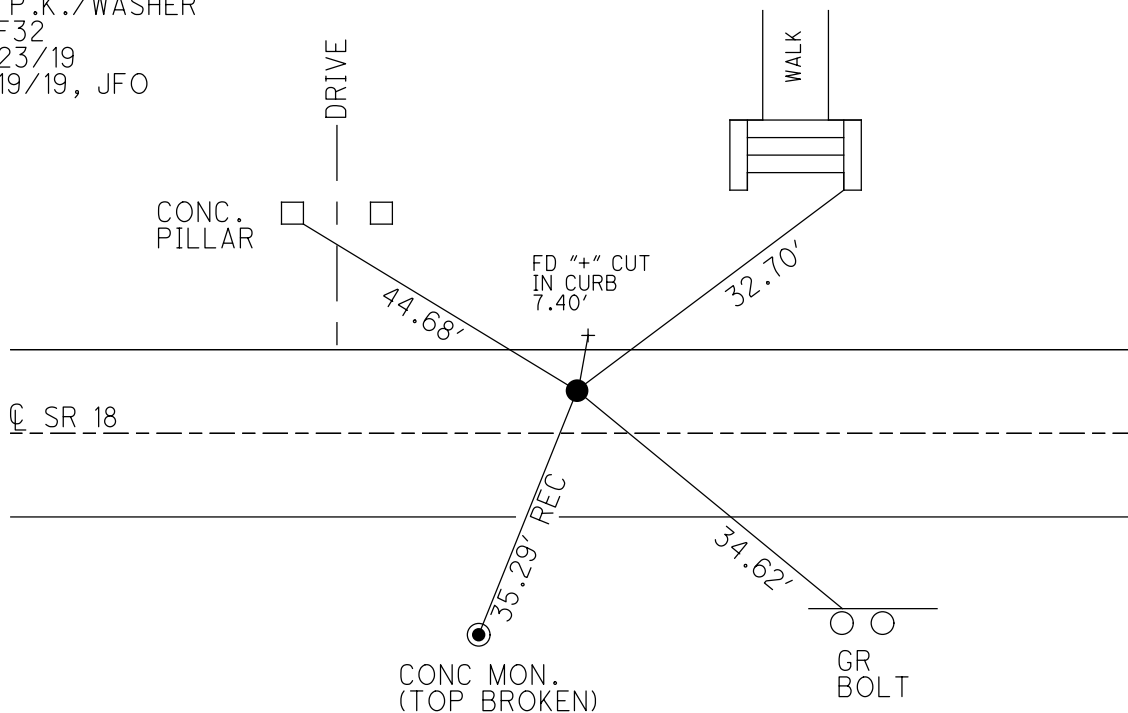

O.D.O.T. DISTRICT 2 SURVEY OFFICE (USE ONLY)

PERSONNEL

REFERENCE NO. 33

SHEET 35 OF 48

NOTES VAN DUSEN

DATE 6/4/01

ROUTE SR 18

H.C. ROUSOS

WEATHER SUNNY

COUNTY SENECA

R.C. BROWN

TEMP. 60°

TOWNSHIP HOPEWELL

DWG BY NIESE

PID NO PID

SECTION 17

T 2 N R 14 E

TYPE MONUMENT P.K./WASHER

ON SURFACE - ~~BELOW~~ ON

OFFSET CL PAVEMENT 1.0' LT : RT

9.5' TO LT EDGE PAVEMENT


STATION: 467+23

HORZ.DATUM: NAD83(2011)


GEOID: 2012A

GRID: NORTHING: 534804.034

EASTING: 1755720.557

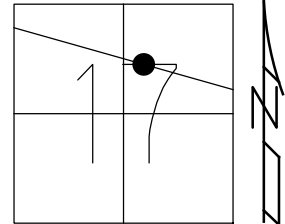

RECORD: P.I.
STA. 454+66.89
 $\Delta = 0^\circ 42' 00''$ LT
PREV MONUMENTS:
P.K./WASHER
R.R.SPIKE
FD P.K./WASHER
6/4/01, BVD
SET P.K./WASHER
8/1/01, SAH
FD P.K./WASHER
REF33
4/23/19
8/19/19, JFO

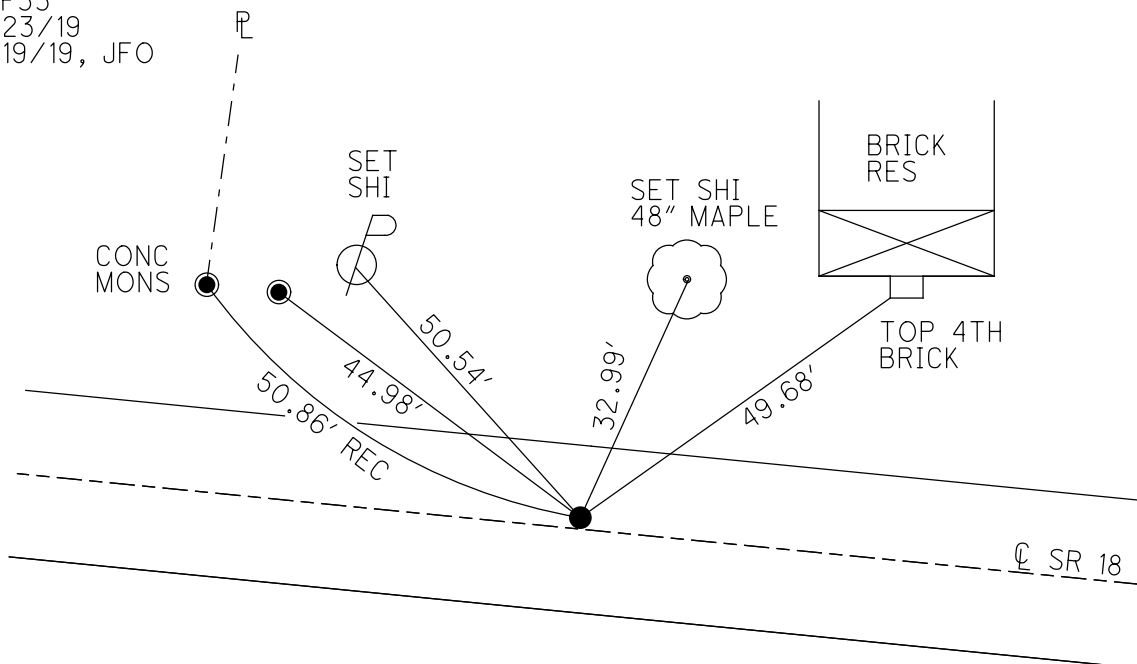

O.D.O.T. DISTRICT 2 SURVEY OFFICE (USE ONLY)

PERSONNEL

REFERENCE NO. 34

SHEET OF

NOTES BARRIERE

DATE 8/15/24

ROUTE SR 18

H.C. NIESE

WEATHER CLDY/WNDY

COUNTY SENECA

R.C. MILLER

TEMP. 74°

TOWNSHIP HOPEWELL

DWG BY BARRIERE

PID 92371

SECTION 17

T 2 N R 14 E

TYPE MONUMENT MAG NAIL/WASHER

ON SURFACE - BELOW ON

OFFSET $\odot$ PAVEMENT 0.5' LT LT : RT

 TO EDGE PAVEMENT

STATION: 471+38

HORZ.DATUM: NAD83 (2011)


GEOID: 18

GRID: NORTHING: 534760.742


EASTING: 1756133.191

LDP: NORTHING:

EASTING:

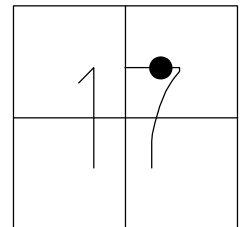

RECORD:
PREV MONUMENTS:
P.K./SHINER
R.R.SPIKE
FD P.K./WASHER
6/4/01, BVD
SET P.K./WASHER
8/1/01, SAH
FD P.K.NAIL
REF34
4/23/19
8/19/19, JFO
FD PK SHANK
REF34
9/27/22, TDN
SET MAG/WASHER
9/11/24, TDN

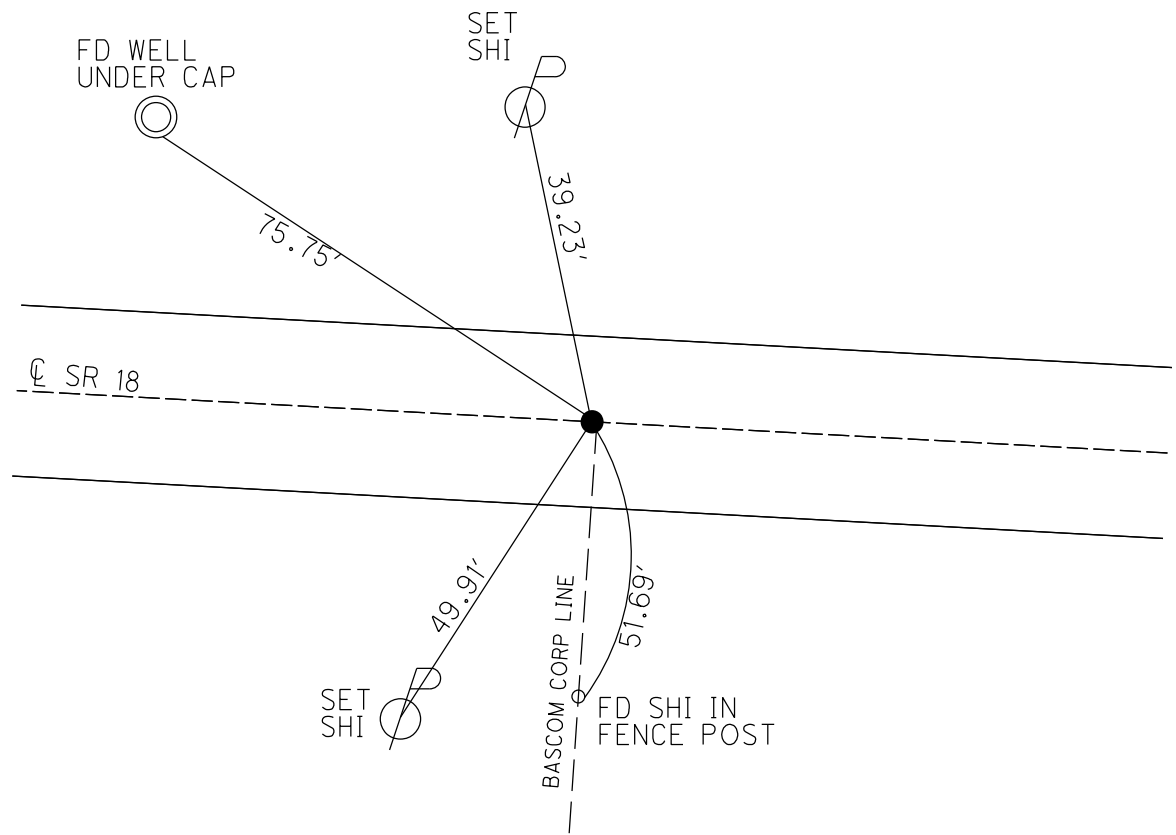

O.D.O.T. DISTRICT 2 SURVEY OFFICE (USE ONLY)

PERSONNEL

REFERENCE NO. 35

SHEET OF

NOTES RHOADES

H.C. NIESE

R.C. MILLER

DATE 4/10/24

WEATHER CLOUDY

TEMP. 62°

ROUTE SR 18

COUNTY SENECA

TOWNSHIP HOPEWELL

SECTION 17

DWG BY BARRIERE

PID 92371

T 2 N R 14 E

TYPE MONUMENT 1" IPIN

ON SURFACE - BELOW 4" BELOW

OFFSET CL PAVEMENT 18.5' LT LT : RT

 TO EDGE PAVEMENT

STATION: 476+50.21

HORIZ.DATUM: NAD83 (2011)


GEOID: 18

GRID: NORTHING: 534700.434


EASTING: 1756698.285

LDP: NORTHING:

EASTING:

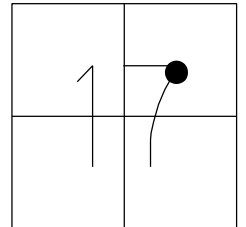

RECORD: P.I.
CONSTRUCTION
STA. 464+50.21
FD BOLT
± DOWN
6/4/01, BVD
FD 1" IPIN
4" DOWN
REF35
4/23/19, JFO
9/27/22, TDN

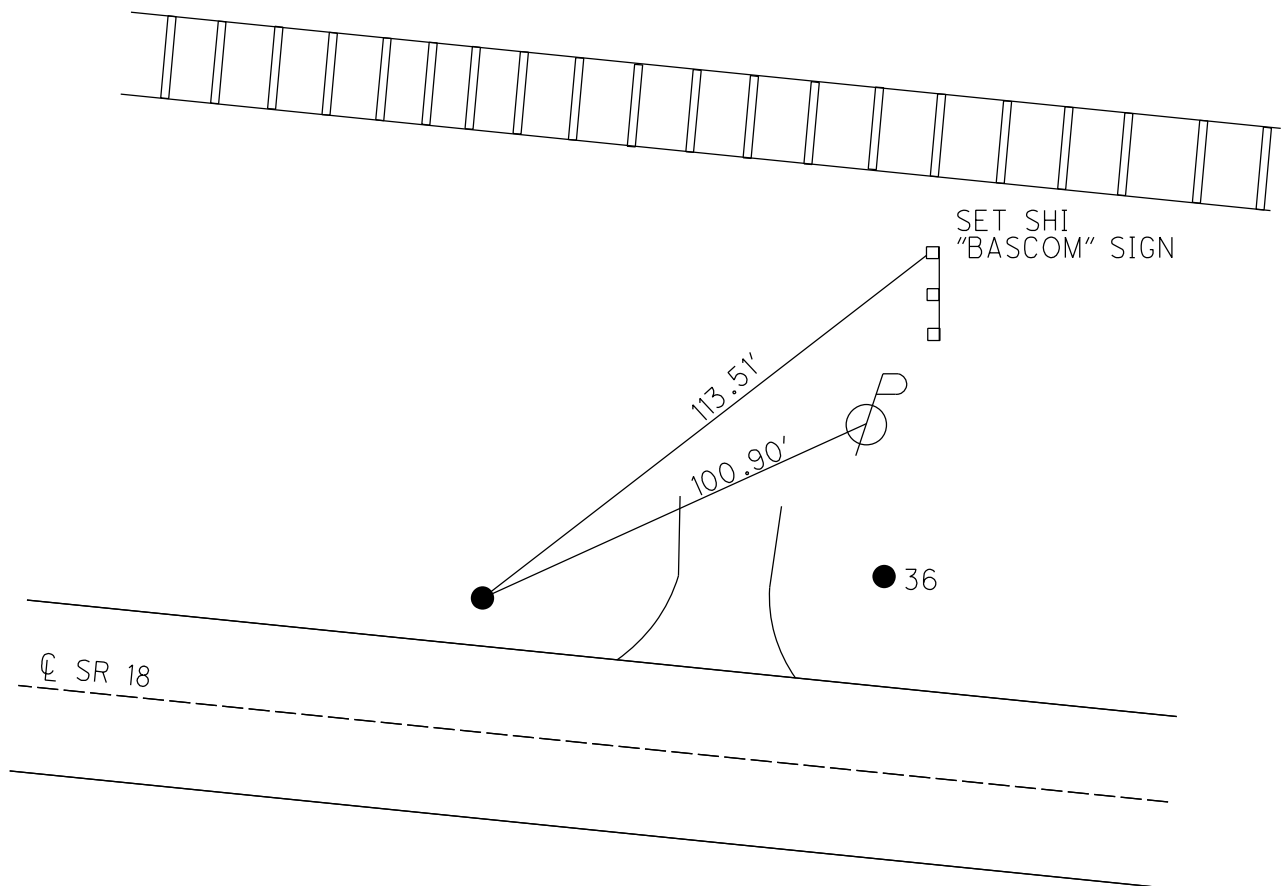

DIST. 35-36 = 111.85' (GPS INV)

O.D.O.T. DISTRICT 2 SURVEY OFFICE (USE ONLY)

PERSONNEL

REFERENCE NO. 36

SHEET OF

NOTES RHOADES

H.C. NIESE

R.C. MILLER

DATE 4/10/24

WEATHER CLOUDY

TEMP. 62°

ROUTE SR 18

COUNTY SENECA

TOWNSHIP HOPEWELL

SECTION 17

DWG BY BARRIERE

PID 92371

T 2 N R 14 E

TYPE MONUMENT 1" IPIN

ON SURFACE - BELOW 3" BELOW

OFFSET $\mathcal{C}$ PAVEMENT 36.5' LT LT : RT

 TO EDGE PAVEMENT

STATION: 477+88

HORIZ.DATUM: NAD83 (2011)


GEOID: 18

GRID: NORTHING: 534688.742


EASTING: 1756809.516

LDP: NORTHING:


EASTING:

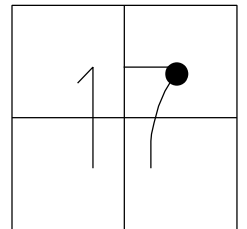

RECORD P.I.
SURVEY
STA. 465+61.90
 $\Delta = 18^\circ 49' 00''$ RT
 $D = 8^\circ 30' 00''$
 $R = 674.07'$
 $L = 221.37'$
 $T = 111.69'$
 $E = 9.19'$
FD 1" IPIN
 $\pm$ DOWN
6/4/01, BVD
FD 1" IPIN
3" DOWN
REF 36
4/23/19, JFO
9/27/22, TDN

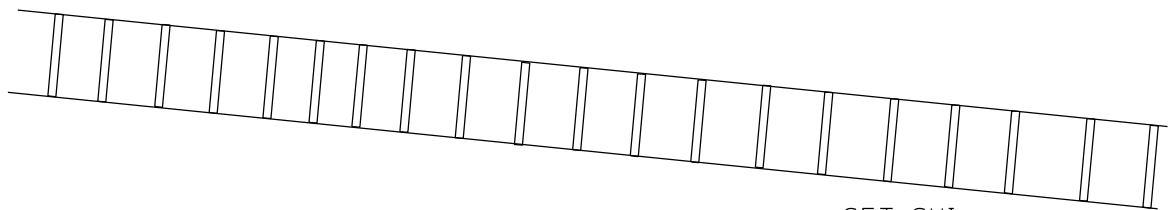

SET SHI
"BASCOM" SIGN

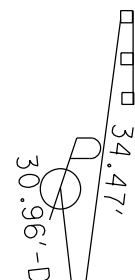

35 ●

$\mathcal{C}$ SR 18

DIST. 35-36 = 111.85' (GPS INV)

O.D.O.T. DISTRICT 2 SURVEY OFFICE (USE ONLY)

PERSONNEL

REFERENCE NO. 37

SHEET OF

NOTES RHOADES

DATE 4/10/24

ROUTE SR 18

H.C. NIESE

WEATHER CLOUDY

COUNTY SENECA

R.C. MILLER

TEMP. 62°

TOWNSHIP HOPEWELL

DWG BY BARRIERE

PID 92371

SECTION 16

T 2 N R 14 E

TYPE MONUMENT MAG NAIL/WASHER

ON SURFACE - BELOW ON

OFFSET $\mathcal{C}$ PAVEMENT 22.5' RT LT : RT

 TO EDGE PAVEMENT

STATION: 485+30

HORIZ.DATUM: NAD83 (2011)


GEOID: 18

GRID: NORTHING: 534382.777


EASTING: 1757469.237

LDP: NORTHING:

EASTING:

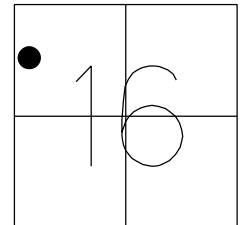

RECORD P.I.
STA 472+87.33
 $\Delta = 17^{\circ} 26' 00''$ LT
D = $12^{\circ} 00' 00''$
R = 477.46'
L = 145.28'
T = 73.21'
E = 5.58'
PREV MONUMENTS:
P.K./SHINER
R.R.SPIKE
FD P.K./WASHER
6/4/01, BVD
SET P.K./WASHER
8/1/01, SAH
FD P.K.SHANK
1 1/2" DOWN
REF37
4/23/19
8/19/19, JFO
9/2/21, DSA
2/16/22, JFO
9/27/22, TDN
SET MAG/WASHER
9/11/24, TDN

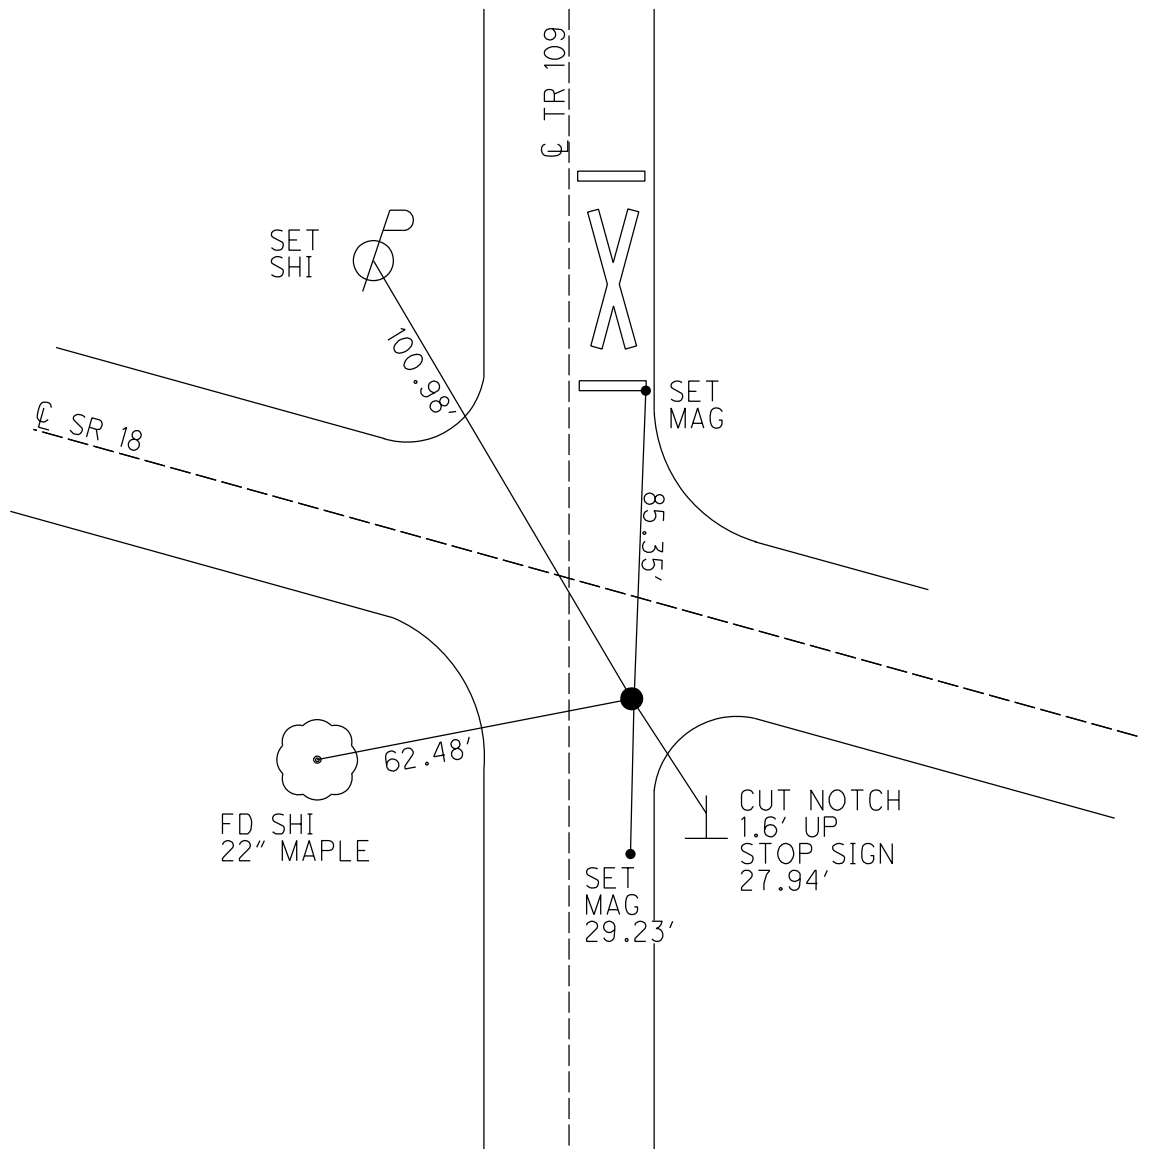

O.D.O.T. DISTRICT 2 SURVEY OFFICE (USE ONLY)

PERSONNEL

REFERENCE NO. 38

SHEET OF

NOTES RHOADES

DATE 4/10/24

ROUTE SR 18

H.C. NIESE

WEATHER CLOUDY

COUNTY SENECA

R.C. MILLER

TEMP. 55°

TOWNSHIP HOPEWELL

DWG BY BARRIERE

PID 92371

SECTION 16

T 2 N R 14 E

TYPE MONUMENT MAG NAIL/WASHER

ON SURFACE - BELOW ON

OFFSET $\odot$ PAVEMENT 1.6' RT LT : RT

 TO EDGE PAVEMENT

STATION: 491+59

HORIZ.DATUM: NAD83 (2011)


GEOID: 18

GRID: NORTHING: 534301.811


EASTING: 1758089.246

LDP: NORTHING:

EASTING:

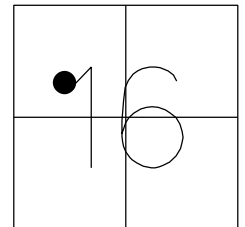

RECORD:
STA 479+11.18
PREV MONUMENTS:
P.K./WASHER
R.R.SPIKE
FD P.K./WASHER
6/4/01, BVD
SET P.K./WASHER
8/1/01, SAH
FD P.K./WASHER
REF38
4/23/19
8/19/19, JFO
D.N.F
2/16/22, JFO
SET MAG/WASHER
REF38
7/25/22, DSA
FD MAG/WASHER
REF38
9/27/22, TDN
SET MAG/WASHER
9/11/24, TDN

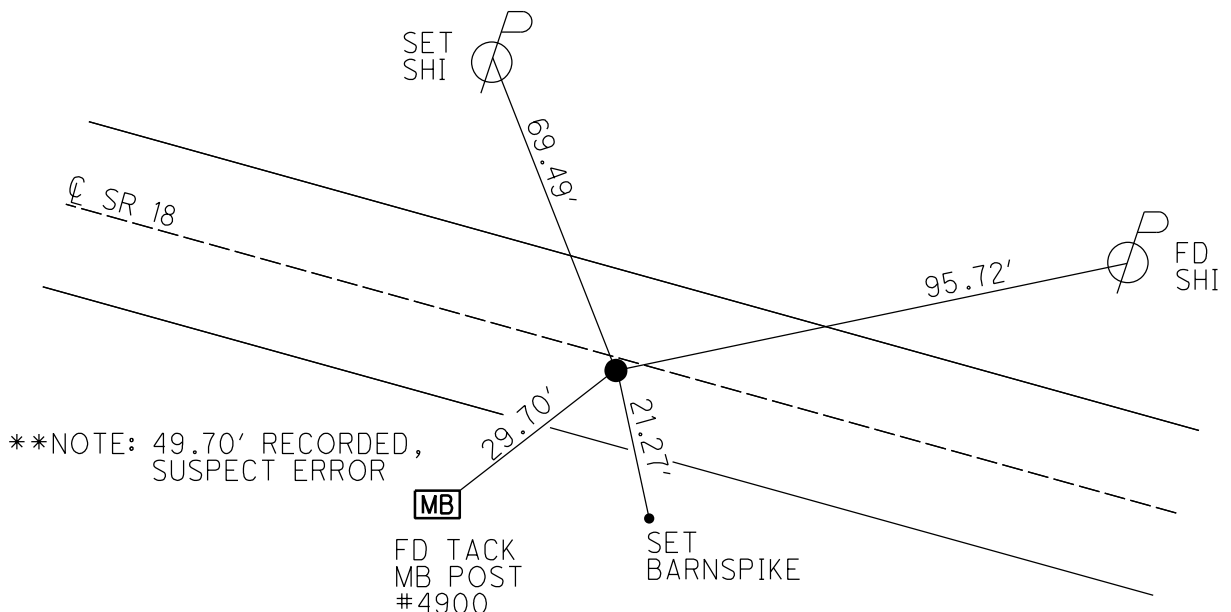

O.D.O.T. DISTRICT 2 SURVEY OFFICE (USE ONLY)

PERSONNEL

REFERENCE NO. 39

SHEET 41 OF 48

NOTES SAVAGE

DATE 9/2/21

ROUTE SR 18

H.C. AUBLE

WEATHER SUNNY

COUNTY SENECA

R.C. NIESE

TEMP. 64°

TOWNSHIP HOPEWELL

SECTION 16

DWG BY RHOADES

PID PVTRAIN

T 2 N R 14 E

TYPE MONUMENT IPIN

~~ON SURFACE~~ - BELOW 3 1/2"

OFFSET Q PAVEMENT 24.0' LT : ~~RT~~

13.5' TO LT EDGE PAVEMENT


STATION: 501+04

HORZ.DATUM: NAD83(2011)


GEOID: 2012A

GRID: NORTHING: 534285.482

EASTING: 1759035.245

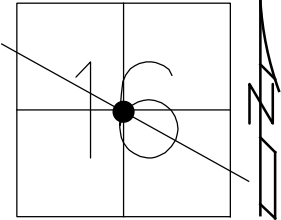

RECORD P.I.
STA 488+57.14
 $\Delta = 10^{\circ} 26' 00''$ RT
D = $5^{\circ} 20' 00''$
R = 1074.30'
L = 195.62'
T = 98.08'
E = 4.47'
FD IPIN
6/4/01, BVD
FD 1" IPIN
2" DOWN
REF39
4/23/19, JFO
FD IPIN
3 1/2" DOWN
9/2/21, DSA

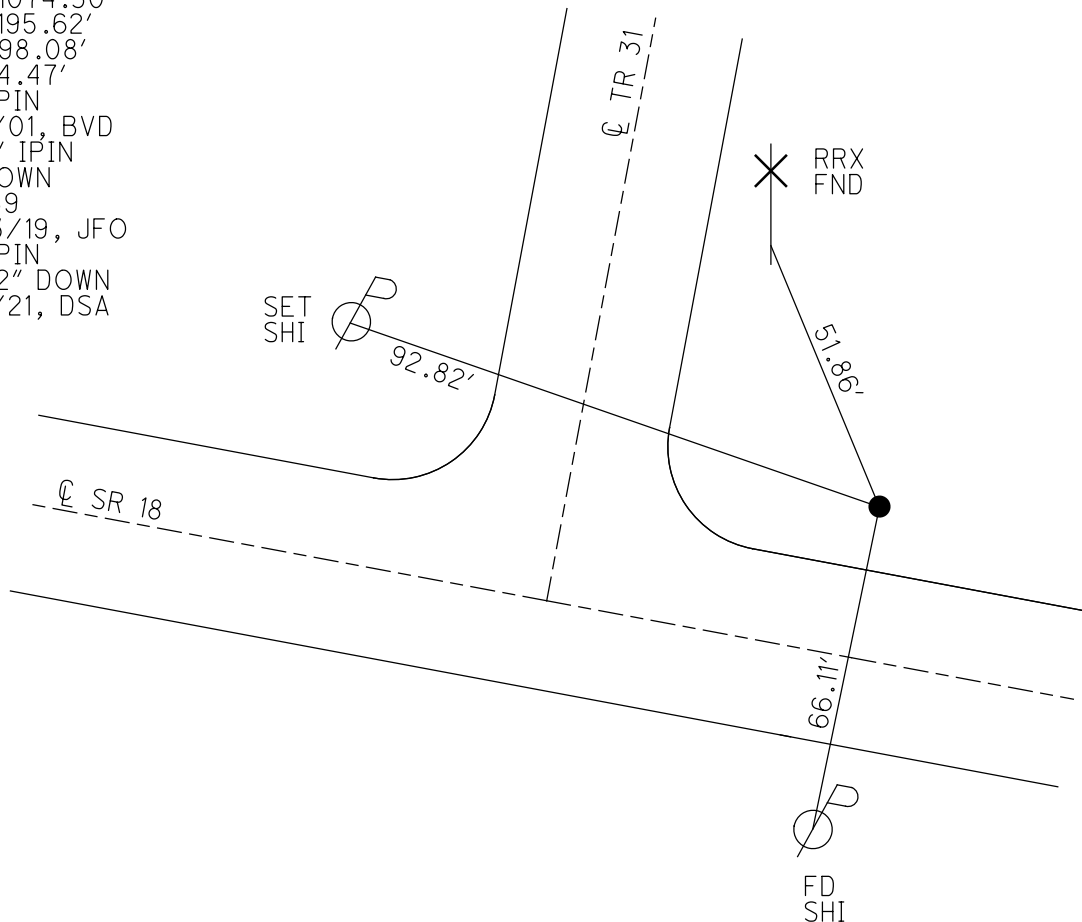

O.D.O.T. DISTRICT 2 SURVEY OFFICE (USE ONLY)

PERSONNEL

REFERENCE NO. 40

SHEET OF

NOTES RHOADES

DATE 4/10/24

ROUTE SR 18

H.C. NIESE

WEATHER CLOUDY

COUNTY SENECA

R.C. MILLER

TEMP. 55°

TOWNSHIP HOPEWELL

DWG BY BARRIERE

PID 92371

SECTION 16

T 2 N R 14 E

TYPE MONUMENT MAG NAIL/WASHER

ON SURFACE - BELOW ON

OFFSET $\odot$ PAVEMENT ON LT : RT

 TO EDGE PAVEMENT

STATION: 517+69

HORZ.DATUM: NAD83 (2011)



GEOID: 18

GRID: NORTHING: 533953.788

EASTING: 1760676.059


LDP: NORTHING:

EASTING:

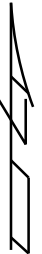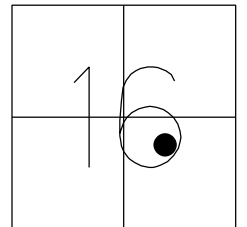

RECORD: P.C.
STA.505+48.59
PREV MONUMENTS:
P.K./SHINER
R.R.SPIKE
FD P.K./WASHER
6/4/01, BVD
SET P.K./WASHER
8/1/01, SAH
FD P.K.NAIL
REF40
4/22/19
8/19/19, JFO
FD P.K./WASHER
REF40
9/2/21, DSA
2/16/22, JFO
9/27/22, TDN
SET MAG/WASHER
9/11/24, TDN

FD "+" CUTS
IN CURB

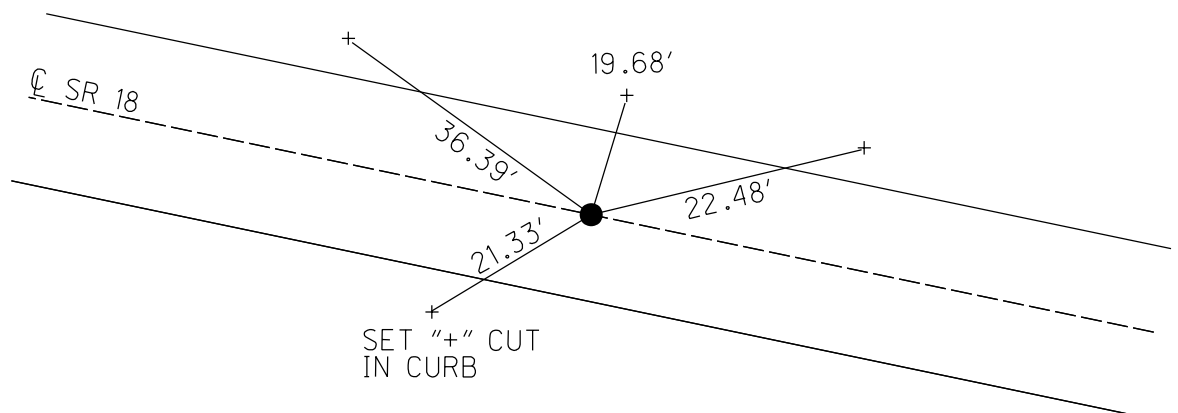

O.D.O.T. DISTRICT 2 SURVEY OFFICE (USE ONLY)

PERSONNEL

REFERENCE NO. 40A

SHEET OF

NOTES RHOADES

DATE 4/10/24

ROUTE SR 18

H.C. NIESE

WEATHER CLOUDY

COUNTY SENECA

R.C. MILLER

TEMP. 55°

TOWNSHIP HOPEWELL

SECTION 15

DWG BY BARRIERE

PID 92371

T 2 N R 14 E

TYPE MONUMENT MAG NAIL/WASHER

ON SURFACE - BELOW ON

OFFSET $\mathcal{C}$ PAVEMENT 1' RT LT : RT

 TO EDGE PAVEMENT

STATION: 558+84

HORZ.DATUM: NAD83 (2011)


GEOID: 18

GRID: NORTHING: 531634.153

EASTING: 1763997.707

LDP: NORTHING:

EASTING:

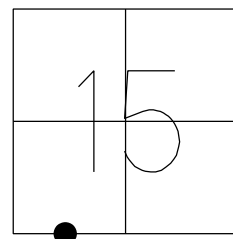

RECORD:

FD P.K./WASHER

11/5/91

FD P.K./WASHER

6/4/01, BVD

SET P.K./WASHER

8/1/01, SAH

FD P.K./WASHER

REFA40

4/23/19

8/16/19, JFO

FD P.K.SHANK


9/8/21, DSA

2/16/22, JFO

9/27/22, TDN

SET MAG/WASHER

9/11/24, TDN

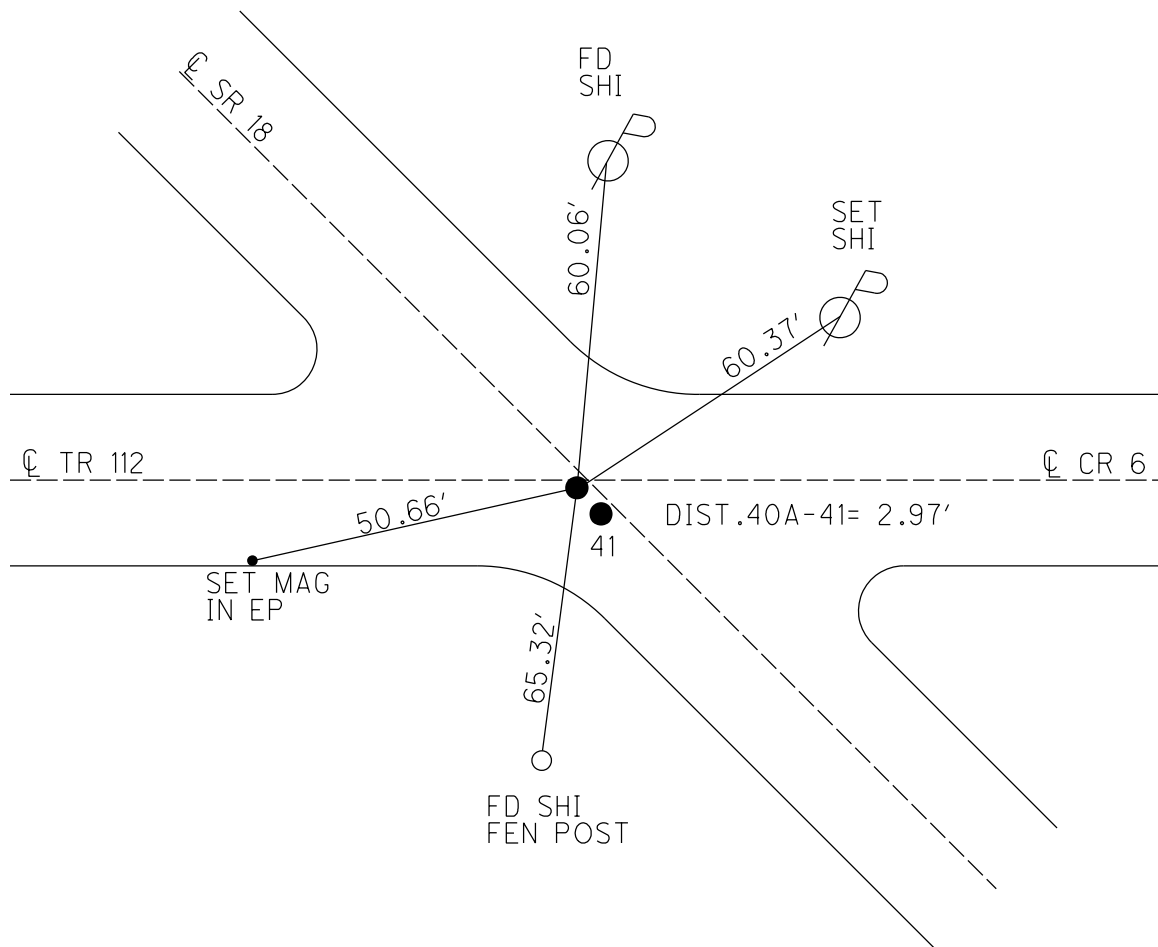

O.D.O.T. DISTRICT 2 SURVEY OFFICE (USE ONLY)

PERSONNEL

REFERENCE NO. 41

SHEET OF

NOTES RHOADES

DATE 4/10/24

ROUTE SR 18

H.C. NIESE

WEATHER CLOUDY

COUNTY SENECA

R.C. MILLER

TEMP. 55°

TOWNSHIP HOPEWELL

DWG BY BARRIERE

PID 92371

SECTION 15

T 2 N R 14 E

TYPE MONUMENT MAG NAIL/WASHER

ON SURFACE - BELOW ON

OFFSET $\odot$ PAVEMENT 0.8' RT LT : RT

 TO EDGE PAVEMENT

STATION: 558+87

HORZ.DATUM: NAD83 (2011)


GEOID: 18

GRID: NORTHING: 531634.153

EASTING: 1763997.707


LDP: NORTHING:

EASTING:

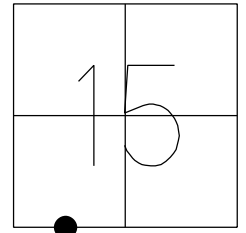

RECORD:

FD P.K./WASHER
11/5/91
FD P.K./WASHER
6/4/01, BVD
SET P.K./WASHER
8/1/01, SAH
FD P.K./WASHER
REF41
4/23/19
8/16/19, JFO
FD P.K./WASHER
9/2/21, DSA
2/16/22, JFO
9/27/22, TDN
SET MAG/WASHER
9/11/24, TDN

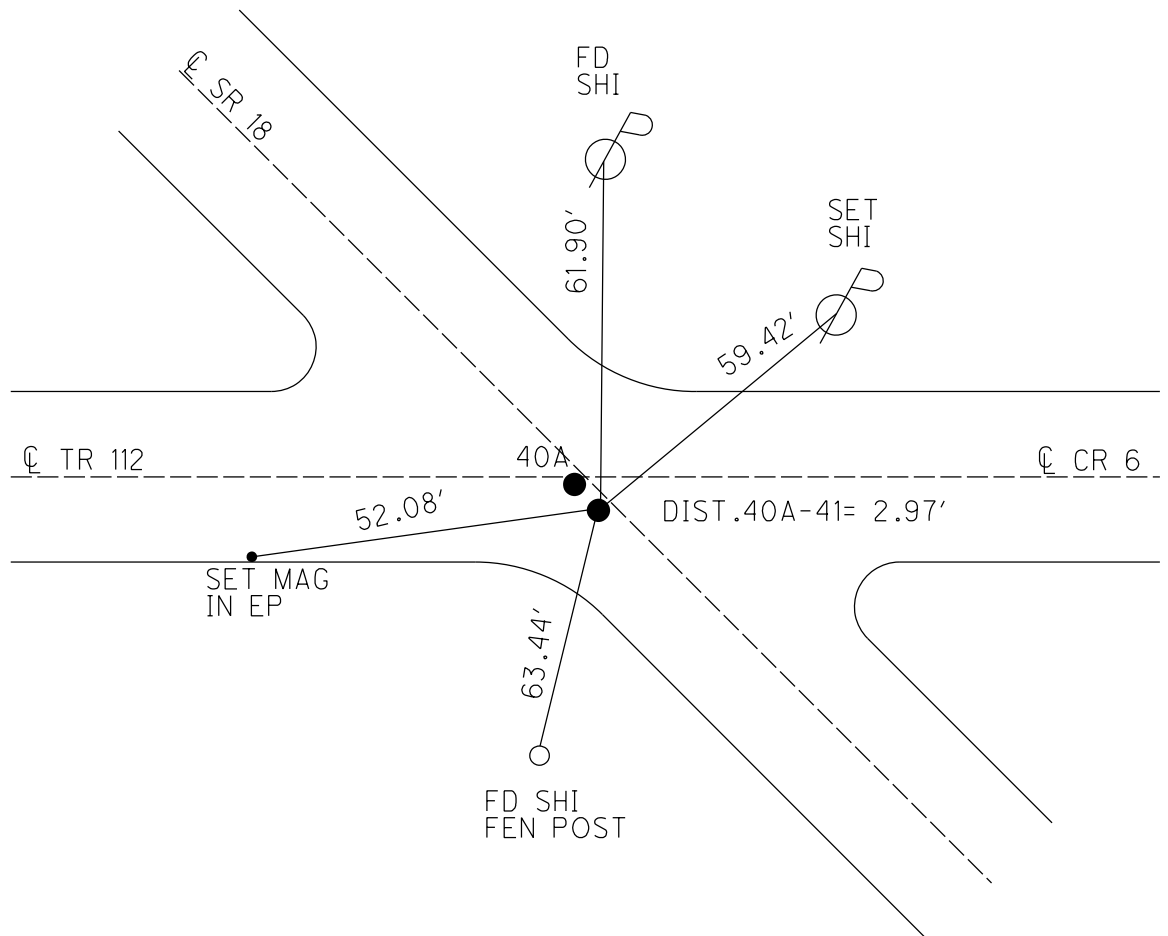

O.D.O.T. DISTRICT 2 SURVEY OFFICE (USE ONLY)

PERSONNEL

REFERENCE NO. A41

SHEET OF

NOTES RHOADES

DATE 4/10/24

ROUTE SR 18

H.C. NIESE

WEATHER CLOUDY

COUNTY SENECA

R.C. MILLER

TEMP. 55°

TOWNSHIP HOPEWELL

SECTION 22

DWG BY BARRIERE

PID 92371

T 2 N R 14 E

TYPE MONUMENT MAG NAIL/WASHER

ON SURFACE - BELOW ON

OFFSET Q PAVEMENT 4' RT LT : RT

 TO EDGE PAVEMENT

STATION: 589+95

HORIZ.DATUM: NAD83 (2011)



GEOID: 18

GRID: NORTHING: 529503.915

EASTING: 1766259.294


LDP: NORTHING:

EASTING:

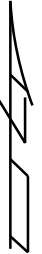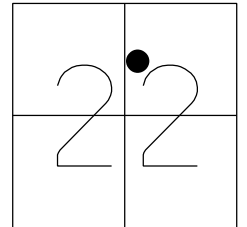

RECORD: P.I.
STA: 482+88
 $\Delta = 1^{\circ}35'$ LT
R= 11459.16'
T= 158.34'
L= 316.67'

FD P.K.SHANK
FD P.K./WASHER
6/4/01, BVD
SET P.K./WASHER
8/1/01, SAH
FD P.K./WASHER
REFA41
4/23/19
8/16/19, JFO
D.N.F
2/16/22, JFO
SET MAG/WASHER
REFA41
7/25/22, DSA
9/27/22, TDN
SET MAG/WASHER
9/11/24, TDN

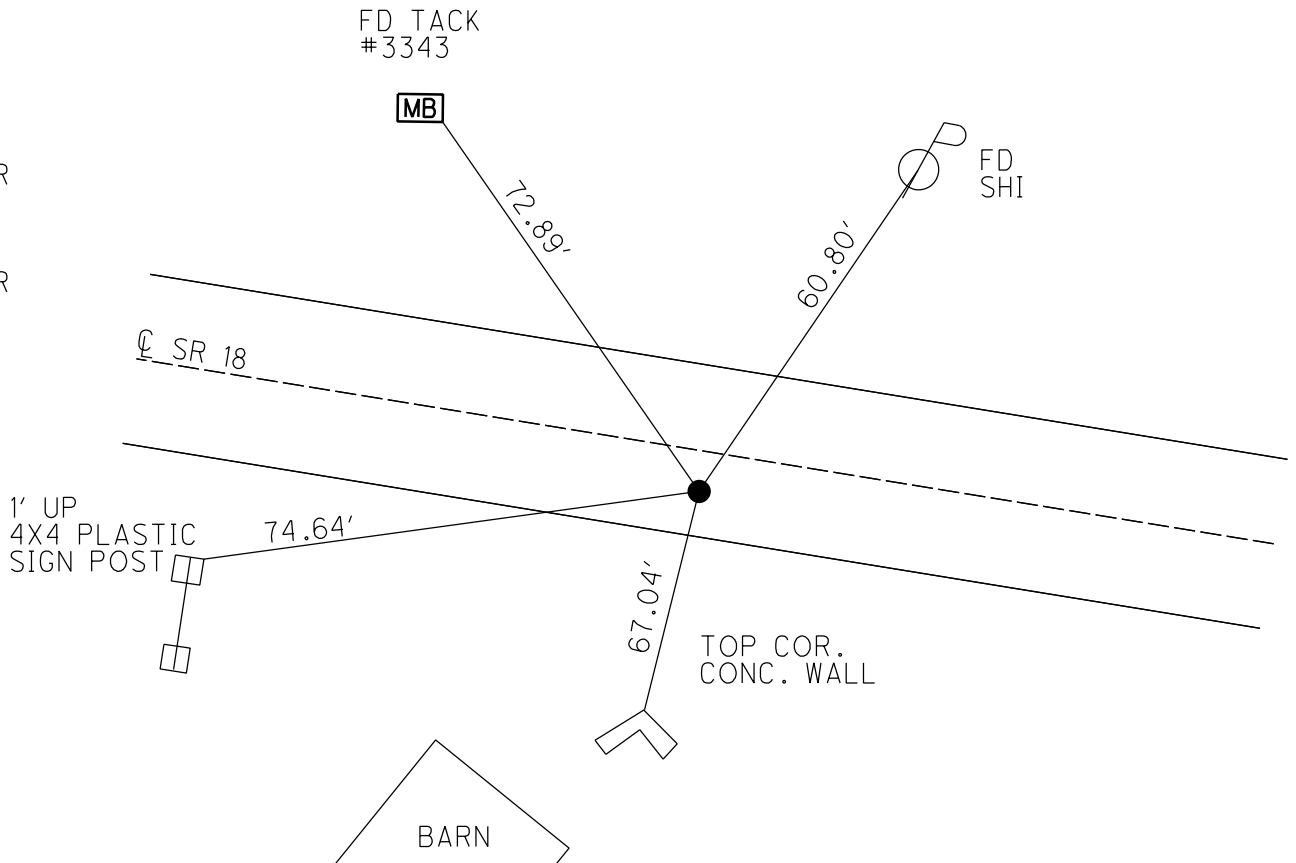

O.D.O.T. DISTRICT 2 SURVEY OFFICE (USE ONLY)

PERSONNEL

REFERENCE NO. 41B

SHEET OF

NOTES RHOADES

DATE 4/10/24

ROUTE SR 18

H.C. NIESE

WEATHER CLOUDY

COUNTY SENECA

R.C. MILLER

TEMP. 55°

TOWNSHIP HOPEWELL

DWG BY BARRIERE

PID 92371

SECTION 22

T 2 N R 14 E

TYPE MONUMENT MAG NAIL/WASHER

ON SURFACE - BELOW ON

OFFSET $\odot$ PAVEMENT 3' RT LT : RT

 TO EDGE PAVEMENT

STATION: 591+50

HORIZ.DATUM: NAD83 (2011)


GEOID: 18

GRID: NORTHING: NO DATA

EASTING: NO DATA

LDP: NORTHING:


EASTING:

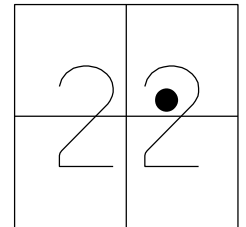

RECORD: P.C.
STA. 489+43.33
PER 1942 PLANS
 $\Delta = 0^\circ 58' 00''$ RT
L = 483.33'
T = 241.67'
D.N.F.
4/23/19, JFO
FD NAIL 1 1/2" DOWN
REF 41B
4/10/24, TDN
SET MAG/WASHER
9/11/24, TDN

****NOTE****

GET COORDINATES ON NEXT VISIT

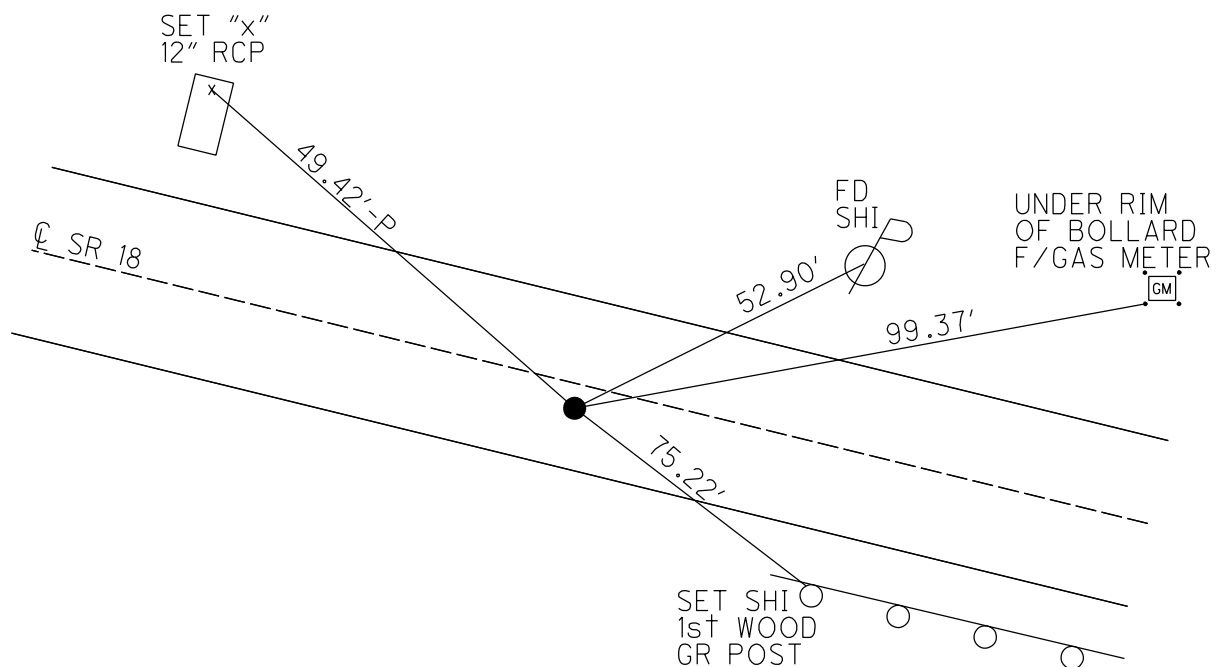

O.D.O.T. DISTRICT 2 SURVEY OFFICE (USE ONLY)

PERSONNEL

REFERENCE NO. C41

SHEET OF

NOTES RHOADES

DATE 4/10/24

ROUTE SR 18

H.C. NIESE

WEATHER CLOUDY

COUNTY SENECA

R.C. MILLER

TEMP. 55°

TOWNSHIP HOPEWELL

SECTION 22

DWG BY BARRIERE

PID 92371

T 2 N R 14 E

TYPE MONUMENT MAG NAIL/WASHER

ON SURFACE - BELOW ON

OFFSET $\mathcal{C}$ PAVEMENT 3.2' RT LT : RT

 TO EDGE PAVEMENT

STATION: 589+92

HORIZ.DATUM: NAD83 (2011)


GEOID: 18

GRID: NORTHING: 528907.505

EASTING: 1766929.871


LDP: NORTHING:

EASTING:

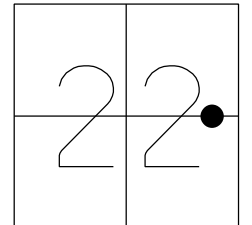

RECORD: P.I.
STA. 491+85.00
PER 1942 PLANS
 $\Delta = 0^\circ 58' 00''$ RT
D = $0^\circ 12'$
R = 28647.90'
T = 241.67'

FD P.K./WASHER
6/4/01, BVD
FD P.K.SHANK
REFC41
4/23/19
8/16/19
2/16/22, JFO
SET MAG/WASHER
REFC41
7/25/22, DSA
FD MAG/WASHER
REFC41
9/27/22, TDN
SET MAG/WASHER
9/11/24, TDN

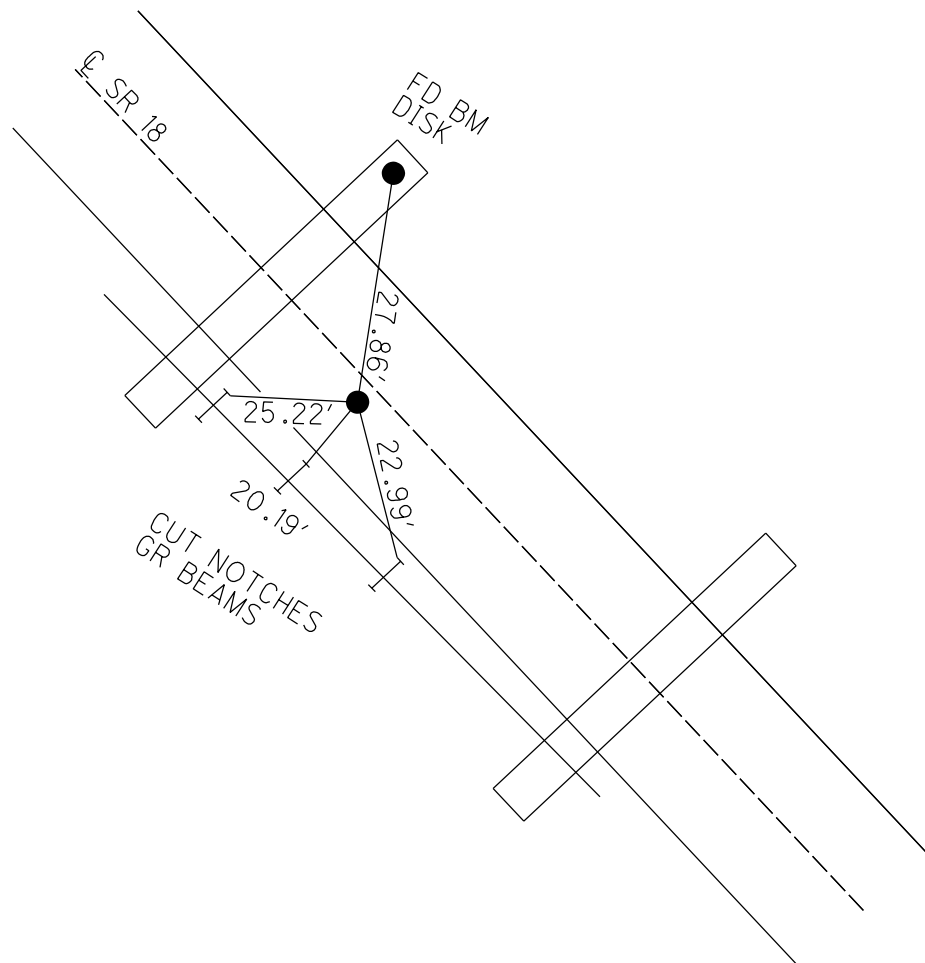

O.D.O.T. DISTRICT 2 SURVEY OFFICE (USE ONLY)

PERSONNEL

REFERENCE NO. 42

SHEET OF

NOTES RHOADES

H.C. NIESE

R.C. MILLER

DATE 4/10/24

WEATHER CLOUDY

TEMP. 55°

ROUTE SR 18

COUNTY SENECA

TOWNSHIP HOPEWELL

SECTION 22

DWG BY BARRIERE

PID 92371

T 2 N R 14 E

TYPE MONUMENT MAG NAIL/WASHER

ON SURFACE - BELOW ON

OFFSET $\mathcal{Q}$ PAVEMENT 3.0' RT LT : RT

 TO EDGE PAVEMENT

STATION: 603+06

HORIZ.DATUM: NAD83 (2011)


GEOID: 18

GRID: NORTHING: 528626.997

EASTING: 1767234.823


LDP: NORTHING:

EASTING:

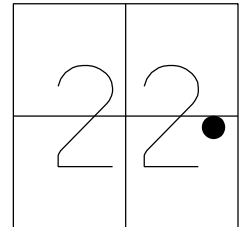

RECORD: P.I.
STA. 495+99.20
PER 1942 PLANS
 $\Delta = 0^\circ 26' 00''$ LT
R = 28647.90'
T = 108.33'

PREV MONUMENTS:
P.K./SHINER
P.K.NAIL
FD P.K./WASHER
6/4/01, BVD
SET P.K./WASHER
8/1/01, SAH
FD P.K./WASHER
REF42
4/22/19
8/18/19, JFO
FD P.K.NAIL
9/8/21, DSA
2/16/22, JFO
FD P.K. SHANK
REF42
9/27/22, TDN
SET MAG/WASHER
9/11/24, TDN

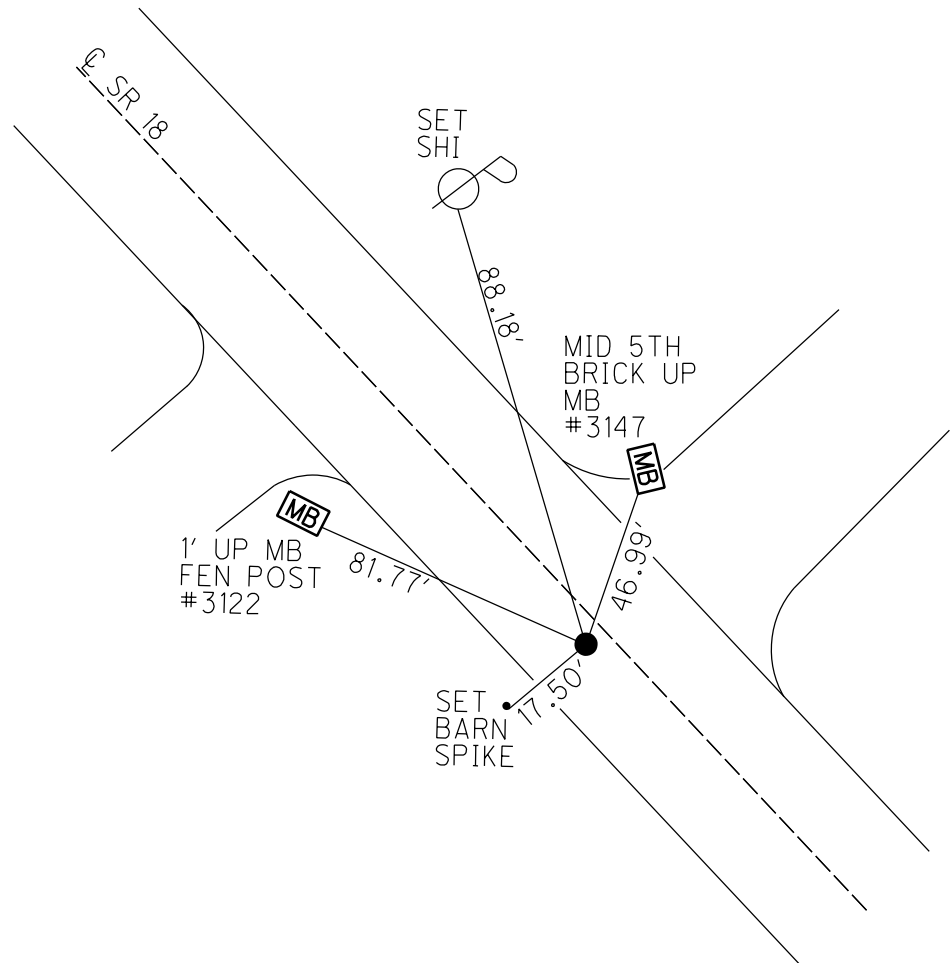

O.D.O.T. DISTRICT 2 SURVEY OFFICE (USE ONLY)

PERSONNEL

REFERENCE NO. 42A

SHEET OF

NOTES RHOADES
H.C. NIESE
R.C. MILLER

DATE 4/10/24
WEATHER CLOUDY
TEMP. 55°

ROUTE SR 18
COUNTY SENECA
TOWNSHIP HOPEWELL
SECTION 23

DWG BY BARRIERE PID 92371

T 2 N R 14 E

TYPE MONUMENT MAG NAIL/WASHER

ON SURFACE - BELOW ON

OFFSET $\mathcal{Q}$ PAVEMENT ON LT : RT

 TO EDGE PAVEMENT

STATION: 631+52

HORIZ.DATUM: NAD83 (2011)


GEOID: 18

GRID: NORTHING: 526723.269

EASTING: 1769350.959

LDP: NORTHING:

EASTING:

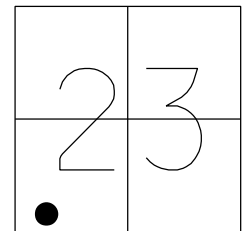


RECORD:
STA 631+57.65
SEN-224-10.64-1998
PID 11690

P.K./WASHER
FD P.K./WASHER
6/4/01, TR
SET P.K./WASHER
8/1/01, SAHFD MAG NAIL
*BELIEVE TO BE REF42A
BASED OFF FIELD NOTES
FROM LOEHRKE ON 3/2/99
AND REF TIE FROM 11/5/91.
SV2 (42A)
4/10/24, TDN
SET MAG/WASHER
9/11/24, TDN

RECORD:
FND MAG NAILS
ORIGIN UNKNOWN
SV1 (42AA)
SV3 (42AB)
4/10/24, TDN
SET MAG/WASHER
9/11/24, TDN

SET
SHI 42AA- 61.33'
42A - 63.61'
42AB- 81.90'

42AA-42A: 2.83'
42AA-42AB: 24.33'
42A-42AB: 21.49'

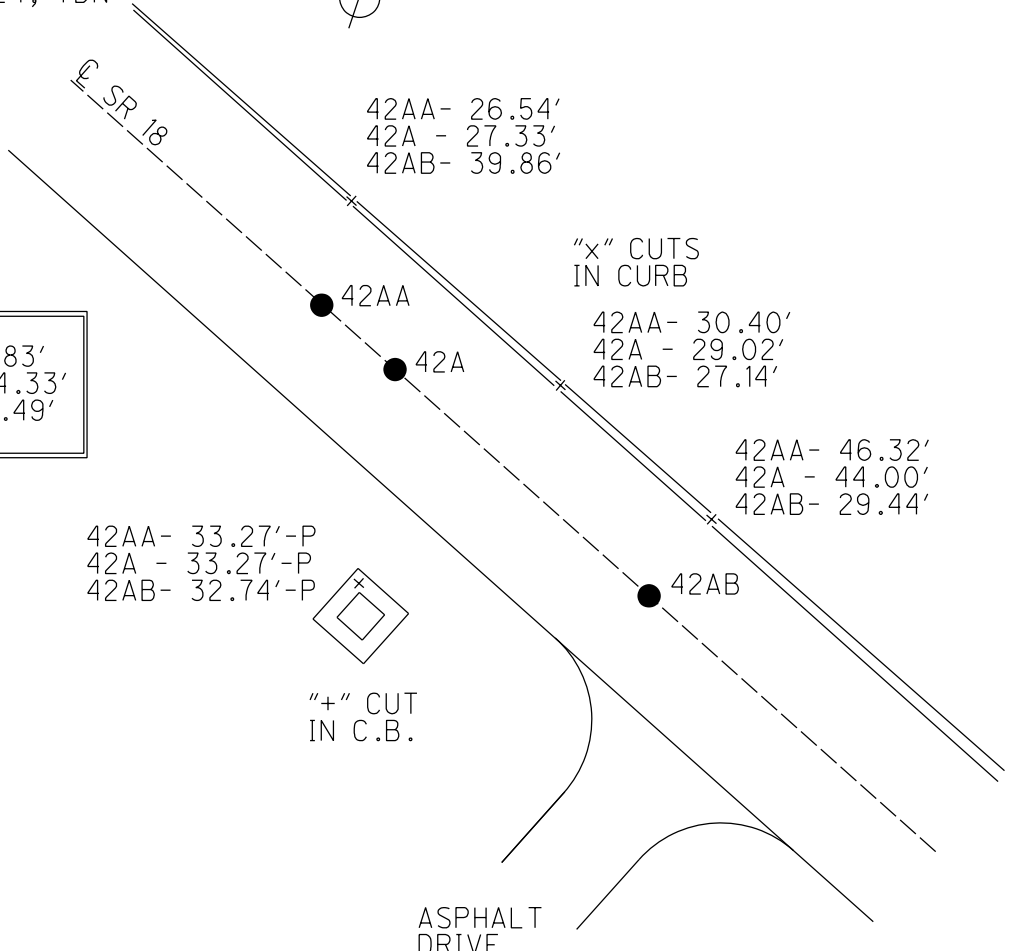

O.D.O.T. DISTRICT 2 SURVEY OFFICE (USE ONLY)

PERSONNEL

REFERENCE NO. 42 B

SHEET 2 OF 18

NOTES ASTON

DATE 9/14/23

ROUTE SR 18

H.C. NIESE

WEATHER SUNNY

COUNTY SENECA

R.C. ASTON

TEMP. 70°

TOWNSHIP HOPEWELL

SECTION 26

DWG BY RHOADES

PID R/W

T 2 N R 14 E

TYPE MONUMENT MON BOX W/ 1" IPIN

ON SURFACE - ~~BELOW~~ ON

OFFSET CL PAVEMENT ON LT : RT

- TO - EDGE PAVEMENT


STATION: 638+35

HORZ.DATUM: NAD83 (2011)

GEOID: NAVD88 2018

GRID: NORTHING: 526252.172


EASTING: 1769858.373

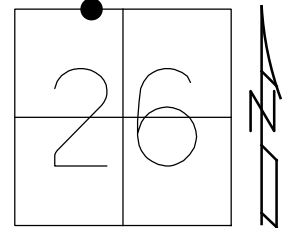

RECORD: P.I.
FD MONBOX
11/5/91, CHENEY
FD MONBOX
W/ 1" IPIN
REF37
6-13-17
12-17-18, JFO
FD MONBOX
W/1" IPIN
REF37
9/14/23, TDN

NOTE: REF 37 SR 224

SENECA LDP:
N: 294888.904
E: 144511.264

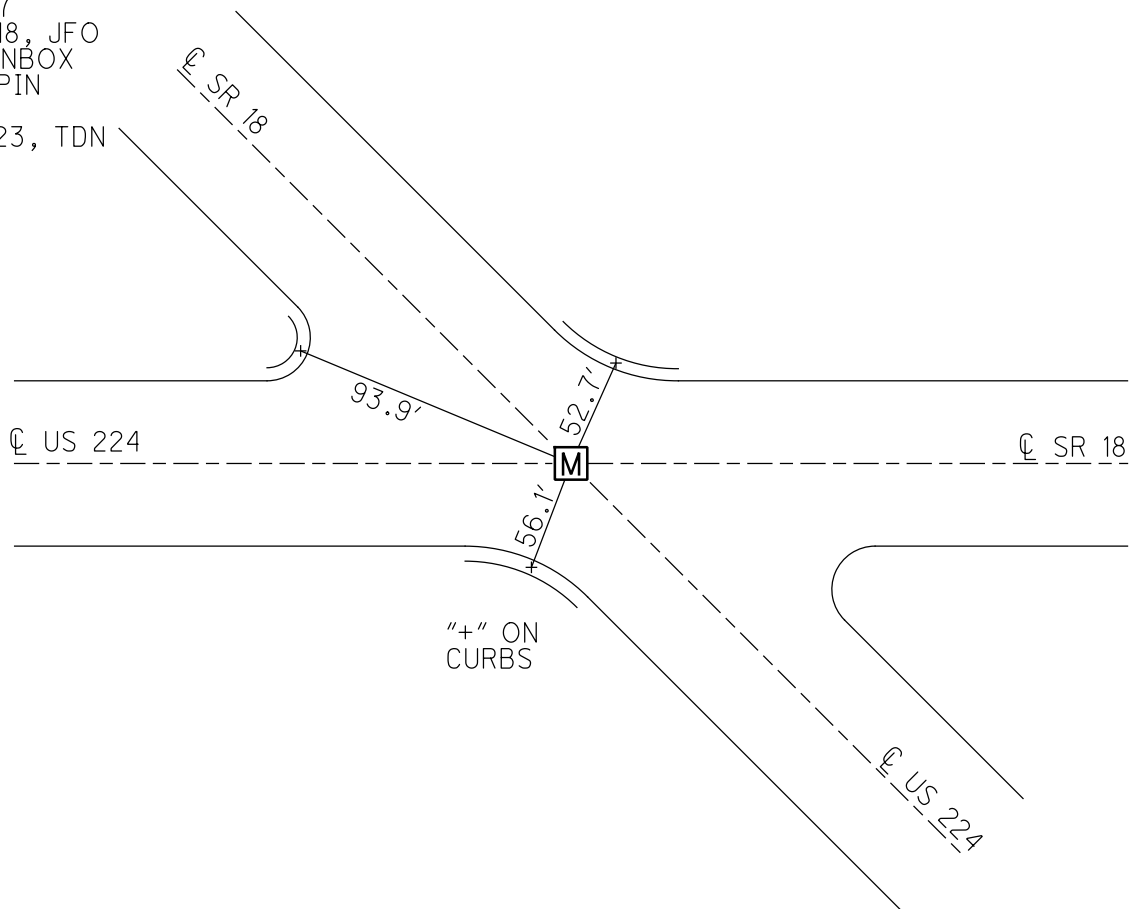

O.D.O.T. DISTRICT 2 SURVEY OFFICE (USE ONLY)

PERSONNEL

REFERENCE NO. 43

SHEET 3 OF 18

NOTES CRONIN

DATE 12/13/79

ROUTE SR 18

H.C. RIPPLE

WEATHER OVERCAST

COUNTY SENECA

R.C. SCHNEIDER

TEMP. 33°

TOWNSHIP HOPEWELL

MOSSER/BARBOUR

SECTION 23

DWG BY NIESE PID

T 2 N R 14 E

TYPE MONUMENT P.K./WASHER

ON SURFACE - ~~BELOW~~ ON


OFFSET CL PAVEMENT ON LT : RT

- TO - EDGE PAVEMENT


STATION: 642+57

HORZ.DATUM: GEOID:

GRID: NORTHING: EASTING:

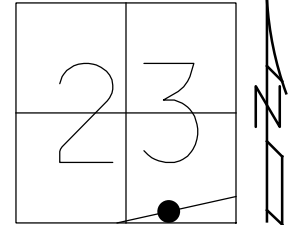

RECORD: P.I.
 $\Delta = 00^{\circ} 57' 00''$ LT
STA 24+61.60
FD P.K./WASHER
12/13/79, CRONIN

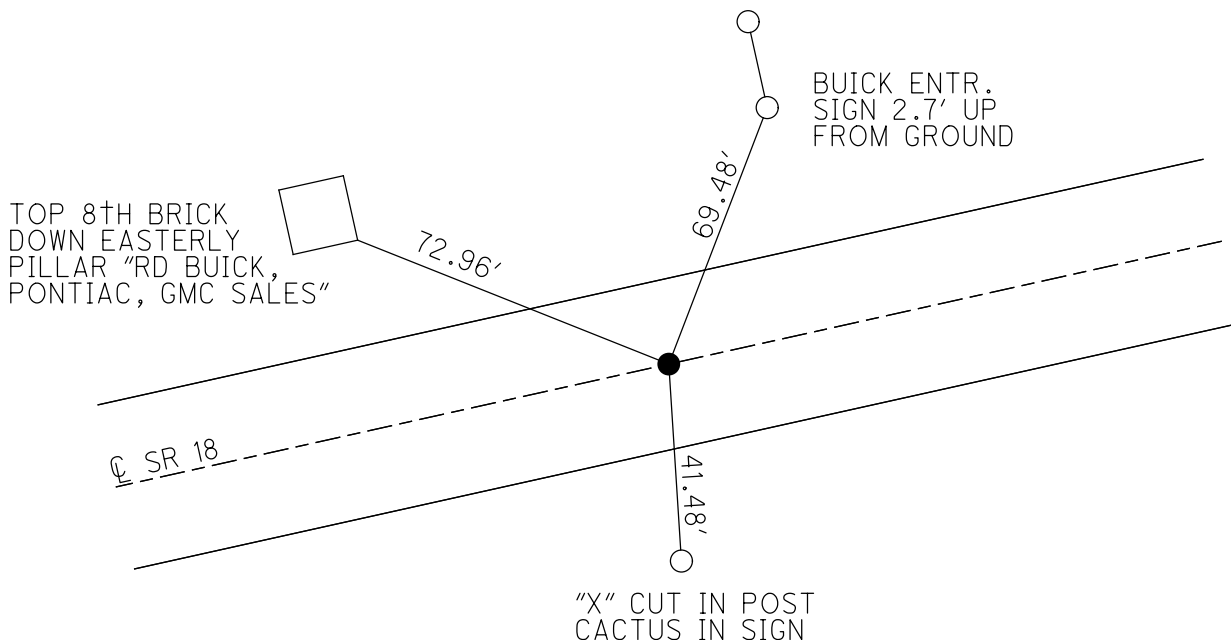

O.D.O.T. DISTRICT 2 SURVEY OFFICE (USE ONLY)

PERSONNEL

REFERENCE NO. 44

SHEET 4 OF 18

NOTES CRONIN DATE 12/13/79

H.C. RIPPLE WEATHER OVERCAST

R.C. SCHNEIDER TEMP. 33°

MOSSER/BARBOUR

ROUTE SR 18

COUNTY SENECA

TOWNSHIP HOPEWELL

SECTION 23

DWG BY NIESE PID

T 2 N R 14 E

TYPE MONUMENT P.K./WASHER

ON SURFACE - ~~BELOW~~ ON


OFFSET Q PAVEMENT ON LT : RT

- TO - EDGE PAVEMENT


STATION: 646+80

HORIZ.DATUM: GEOID:

GRID: NORTHING: EASTING:

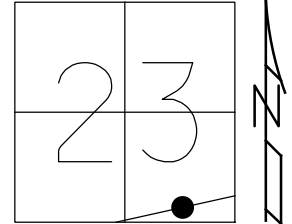

RECORD: P.I.
 $\Delta = 00^{\circ} 04' 00''$ LT
STA 28+52
FD P.K./WASHER
12/13/79, CRONIN

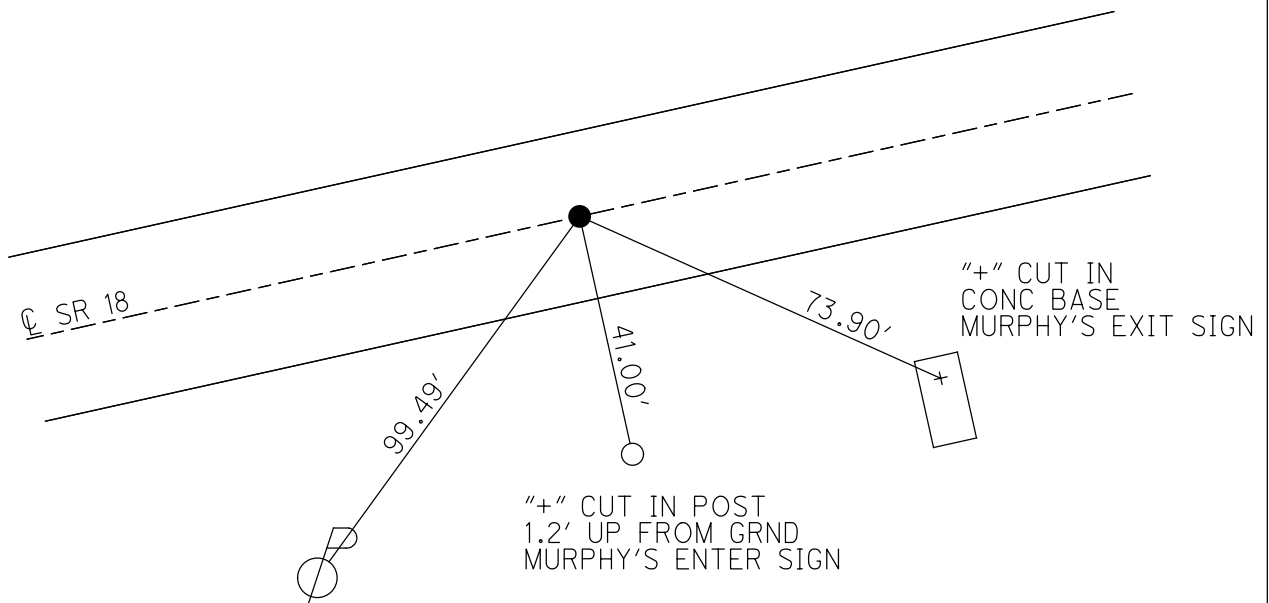

O.D.O.T. DISTRICT 2 SURVEY OFFICE (USE ONLY)

PERSONNEL

REFERENCE NO. 45

SHEET 5 OF 18

NOTES CRONIN

DATE 12/13/79

ROUTE SR 18

H.C. RIPPLE

WEATHER OVERCAST

COUNTY SENECA

R.C. SCHNEIDER
MOSSER/BARBOUR

TEMP. 30°

TOWNSHIP HOPEWELL

SECTION 23

DWG BY NIESE PID

T 2 N R 12 E

TYPE MONUMENT P.K./WASHER

ON SURFACE - ~~BELOW~~ ON

OFFSET $\varnothing$ PAVEMENT ON LT : RT

 TO EDGE PAVEMENT


STATION: 665+28

HORIZ.DATUM:


GEOID:

GRID: NORTHING:

EASTING:

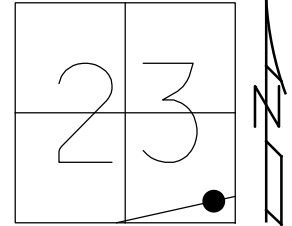

RECORD: P.I.
 $\Delta = 00^{\circ} 38' 00''$ LT
STA 47+23.42
FD P.K./WASHER
12/13/79, CRONIN

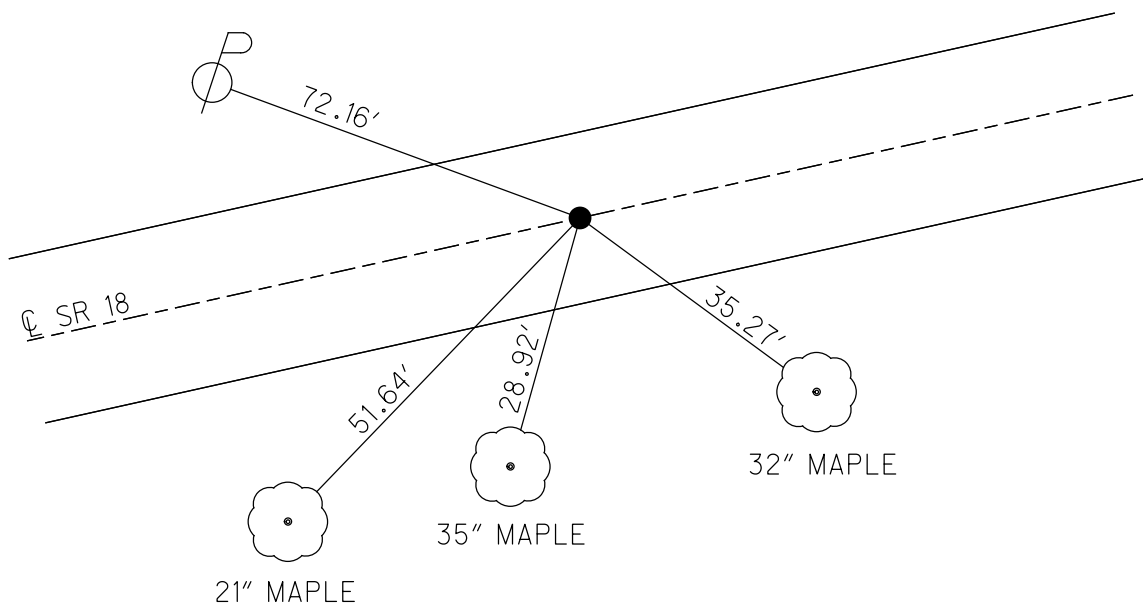

O.D.O.T. DISTRICT 2 SURVEY OFFICE (USE ONLY)

PERSONNEL

REFERENCE NO. 46

SHEET 6 OF 18

NOTES CRONIN

DATE 12/13/79

ROUTE SR 18

H.C. RIPPLE

WEATHER OVERCAST

COUNTY SENECA

R.C. SCHNEIDER
MOSSER/BARBOUR

TEMP. 30°

TOWNSHIP HOPEWELL

DWG BY NIESE PID

SECTION 24

T 2 N R 14 E

TYPE MONUMENT P.K./WASHER

ON SURFACE - ~~BELOW~~ ON

OFFSET Q PAVEMENT ON LT : RT

- TO - EDGE PAVEMENT


STATION: 693+79

HORZ.DATUM:


GEOID:

GRID: NORTHING:

EASTING:

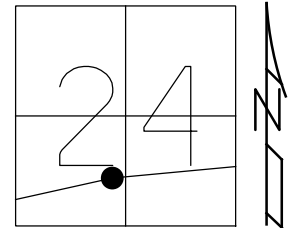

RECORD: P.I.
 $\Delta = 05^{\circ} 42' 00''$ RT
STA 75+81.72
FD P.K./WASHER
12/13/79, CRONIN

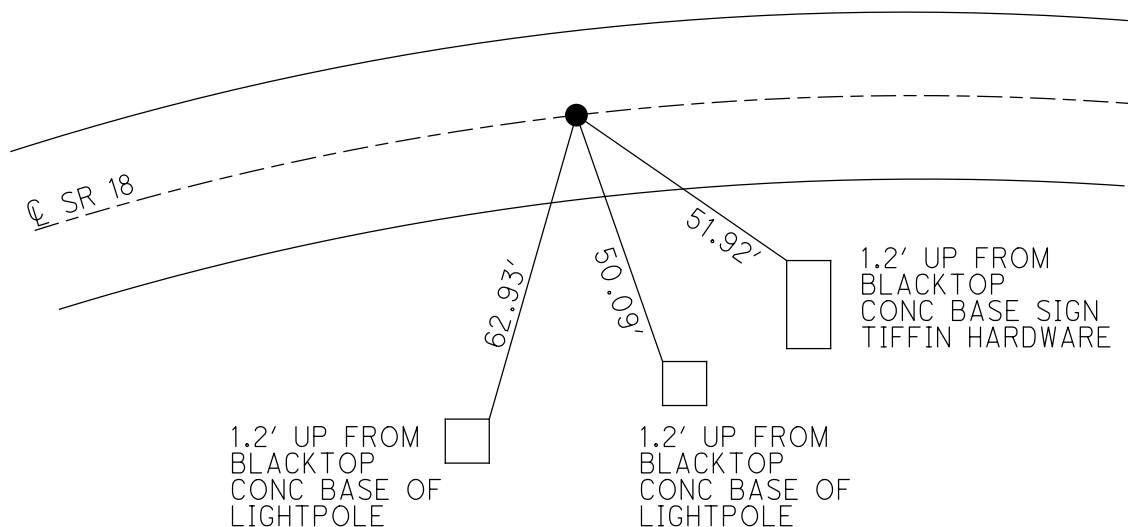

O.D.O.T. DISTRICT 2 SURVEY OFFICE (USE ONLY)

PERSONNEL

REFERENCE NO. 47

SHEET 7 OF 18

NOTES CRONIN

DATE 12/13/97

ROUTE SR 18

H.C. RIPPLE

WEATHER OVERCAST

COUNTY SENECA

R.C. SCHNEIDER

TEMP. 30°

TOWNSHIP HOPEWELL

MOSER/BARBOUR

SECTION 24

DWG BY NIESE PID

T 2 N R 14 E

TYPE MONUMENT P.K./WASHER

ON SURFACE - ~~BELOW~~ ON


OFFSET PAVEMENT ON LT : RT

 TO EDGE PAVEMENT


STATION: 698+01

HORZ.DATUM: GEOID:

GRID: NORTHING: EASTING:

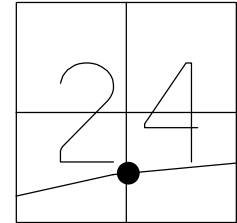

RECORD:
STA 79+71.75
CORP. LINE
FD P.K./WASHER
12/13/79, CRONIN

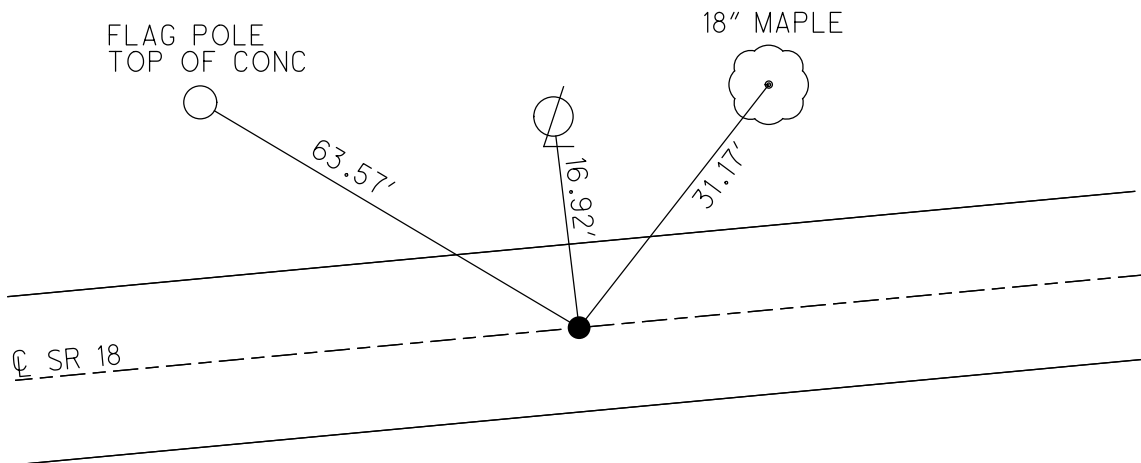

O.D.O.T. DISTRICT 2 SURVEY OFFICE (USE ONLY)

PERSONNEL

REFERENCE NO. 49

SHEET 3 OF 12

NOTES CHENEY

DATE 6-30-1993

ROUTE SR 18

H.C. RIPPLE

WEATHER CLOUDY

COUNTY SENECA

R.C. GEYMAN

TEMP. 75°

TOWNSHIP CLINTON

SECTION 20

DWG BY AUBLE

PID 107060

T 2 N R 15 E

TYPE MONUMENT 1.25" IPIPE

~~ON SURFACE~~ - BELOW 5"

OFFSET CL PAVEMENT 1.5' ~~LT~~ : RT

15.5' TO LT EDGE PAVEMENT


STATION: 814+25

HORIZ.DATUM: -

GEOID: -


GRID: NORTHING: -

EASTING: -

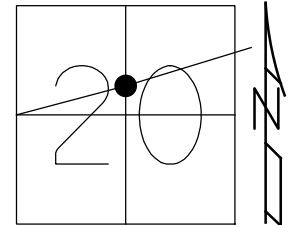

RECORD:
ORIGIN UNKNOWN
SET P.K./WASHER
8/25/1993
DNF
3/6/2019, JFO

DIST. 49-50= 1.75' REC

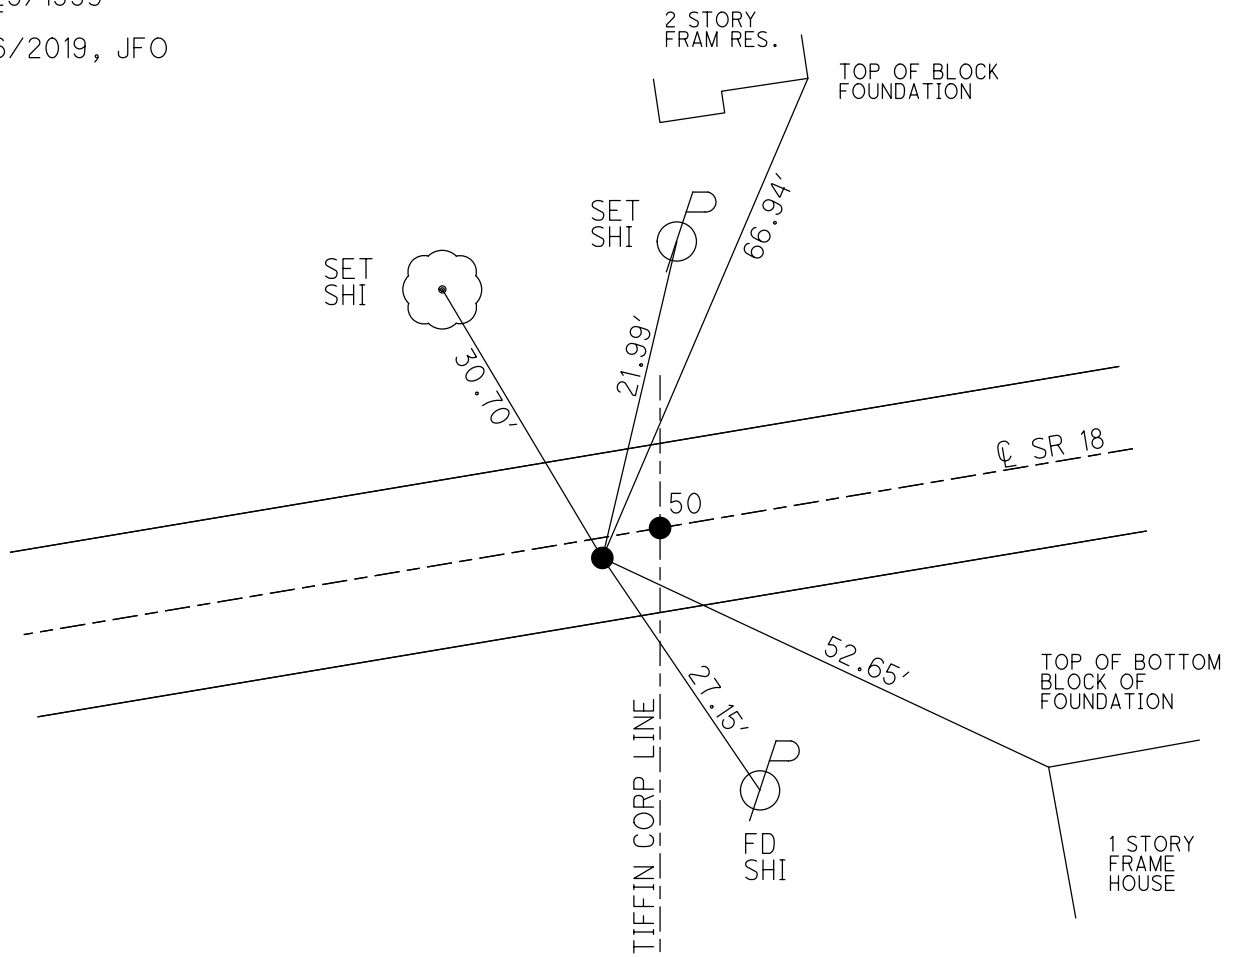

O.D.O.T. DISTRICT 2 SURVEY OFFICE (USE ONLY)

PERSONNEL

REFERENCE NO. 50

SHEET 2 OF 12

NOTES CHENEY

DATE 6-30-1993

ROUTE SR 18

H.C. RIPPLE

WEATHER CLOUDY

COUNTY SENECA

R.C. GEYMAN

TEMP. 75°

TOWNSHIP CLINTON

DWG BY AUBLE

PID 107060

T 2 N R 15 F

TYPE MONUMENT MINE SPIKE SHANK

~~ON SURFACE - BELOW~~ 3"

OFFSET @ PAVEMENT _____ ON _____ LT : RT _____

14' TO LT EDGE PAVEMENT


STATION: 814+25

HORZ.DATUM: -

GEOID: _____


GRID: NORTHING: -

EASTING: -

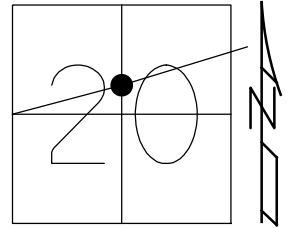

RECORD:
TIFFIN CORP.
STA. 0+00
FD SMALL R.R.SPK
1.5" DOWN
3/18/76
SET P.K./WASHER
9/7/76
SET P.K./WASHER
8/25/1993
DNF
3/6/2019, JFO

DIST. 49-50= 1.75' REC

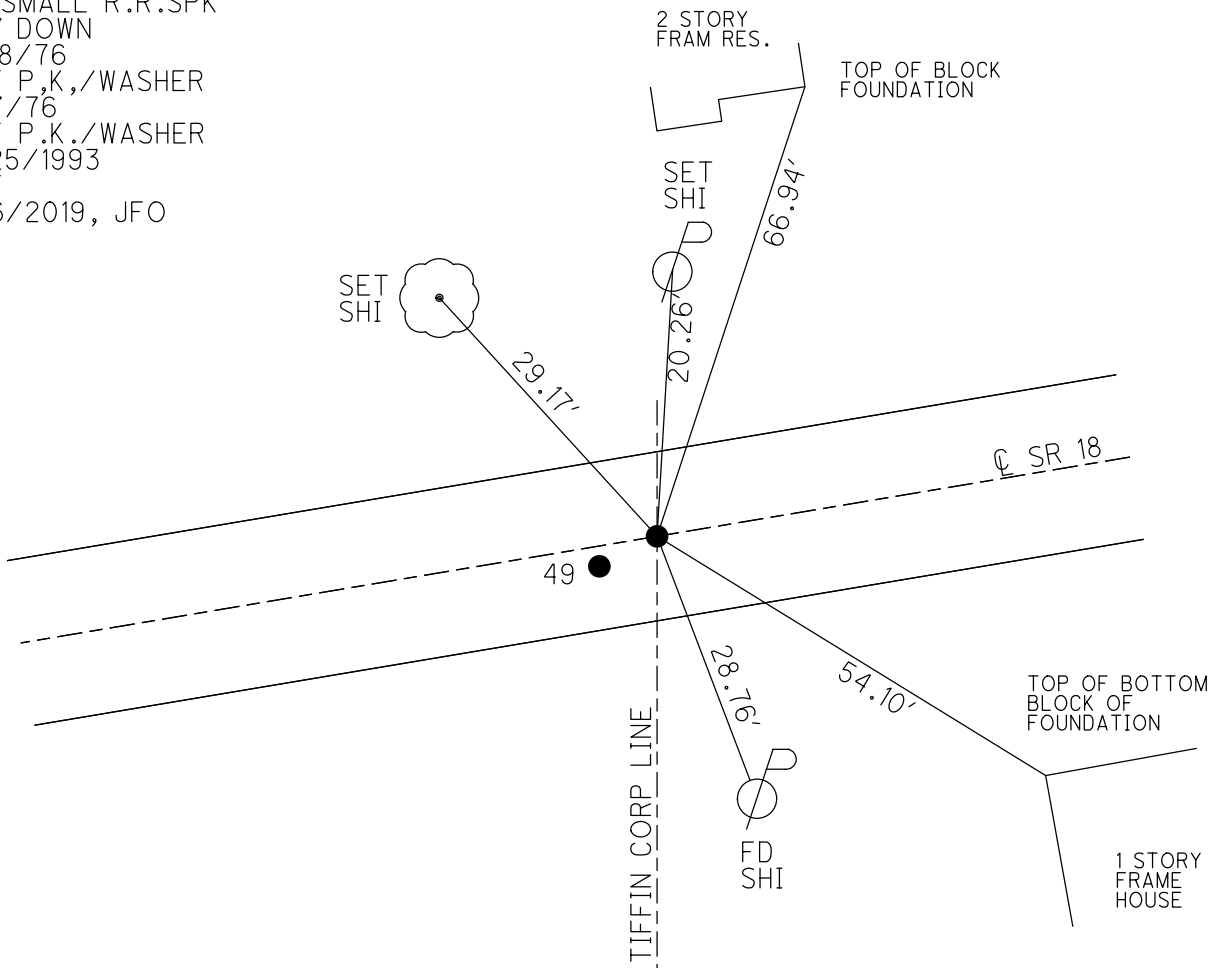

O.D.O.T. DISTRICT 2 SURVEY OFFICE (USE ONLY)

PERSONNEL

REFERENCE NO. 50 A

SHEET 10 OF 18

NOTES RHOADES

DATE 9/8/21

ROUTE SR 18

H.C. AUBLE

WEATHER SUNNY

COUNTY SENECA

R.C. NIESE

TEMP. 73°

TOWNSHIP CLINTON

SECTION 20

DWG BY RHOADES

PID PVTRAIN

T 2 N R 15 E

TYPE MONUMENT P.K.SHANK/WASHER

ON SURFACE - ~~BELOW~~ ON

OFFSET 0.5' LT : RT

11' TO RT EDGE PAVEMENT


STATION: 823+54

HORIZ.DATUM: NAD83 (2011)


GEOID: 2012A

GRID: NORTHING: 530102.969

EASTING: 1787586.788

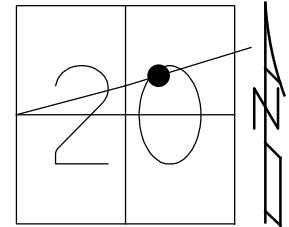

RECORD:
C SURVEY CONTROL
FOR STR. #15.64
BRIDGE SURVEY
FD R.R.SPIKE SHANK
6/30/93, RCC
SET P.K./WASHER
8/25/1993, RCC
FD P.K.SHANK/WASHER
REFB50
3/6/2019
8/16/2019, JFO
9/8/21, DSA
2/16/22, JFO

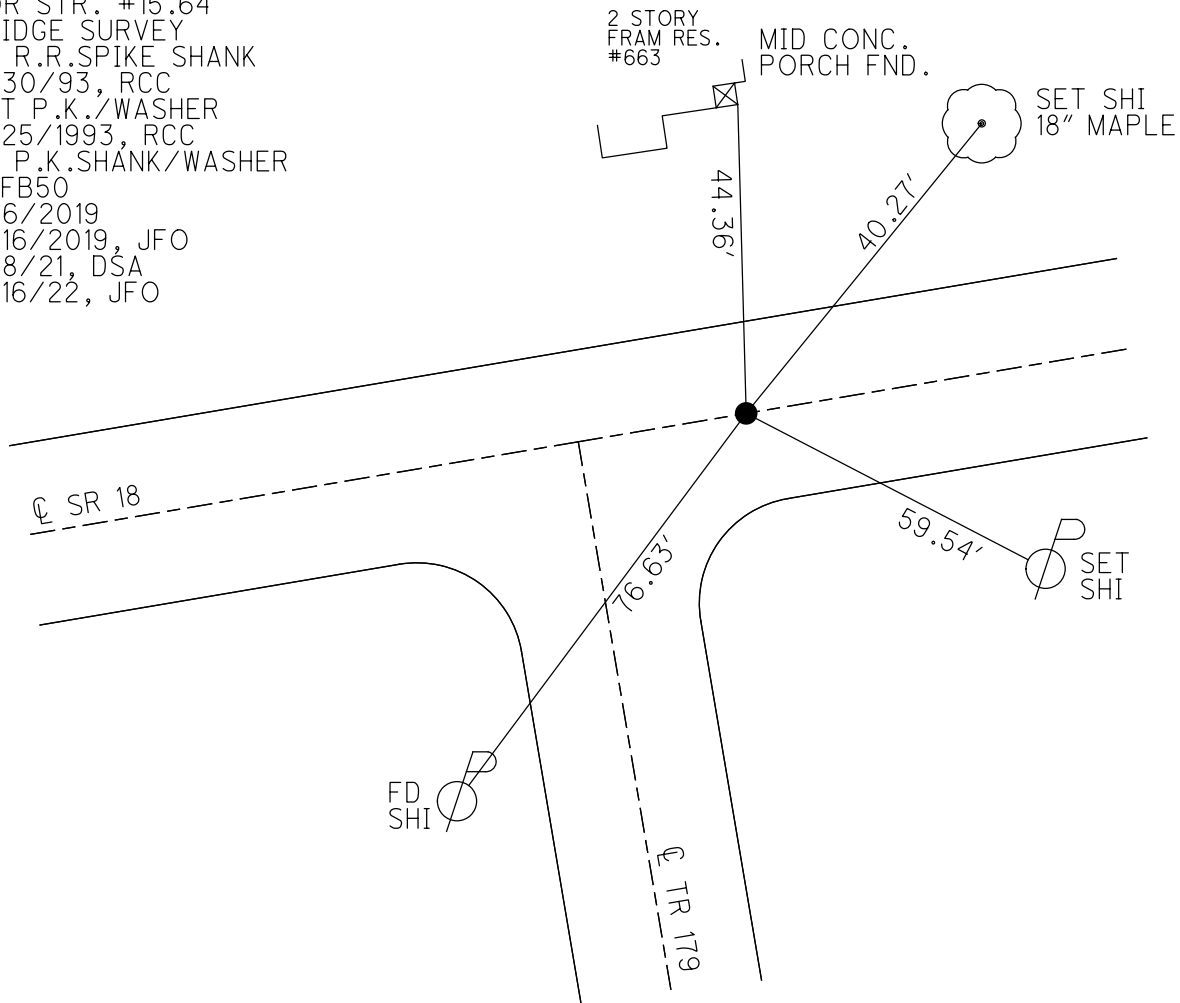

O.D.O.T. DISTRICT 2 SURVEY OFFICE (USE ONLY)

PERSONNEL

REFERENCE NO. 51

SHEET 11 OF 18

NOTES RHOADES

DATE 7/25/22

ROUTE SR 18

H.C. AUBLE

WEATHER CLEAR

COUNTY SENECA

R.C. NIESE

TEMP. 75°

TOWNSHIP CLINTON

WHITAKER

SECTION 20

DWG BY WHITAKER

PID PVTRN

T 2 N R 15 E

TYPE MONUMENT MAG/WASHER

ON SURFACE - ~~BELOW~~ ON

OFFSET Q PAVEMENT ON LT : RT

10.5' TO RT EDGE PAVEMENT


STATION: 829+28

HORZ.DATUM: NAD83 (2011)


GEOID: 2012A

GRID: NORTHING: 530286.637

EASTING: 1788130.380

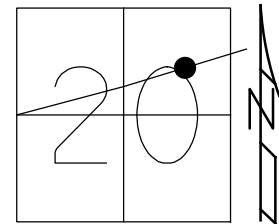

RECORD: P.I.
STA 15+00
 $\Delta = 0^\circ 05' \text{ RT}$
FD NAIL/SHINER
1.5" DOWN
3/18/76
SET P.K./WASHER
9/7/76
SET P.K./WASHER
8/25/93, RCC
FD HOLE REF51
3/6/2019, JFO
SET MAG/WASHER
7/25/22, DSA

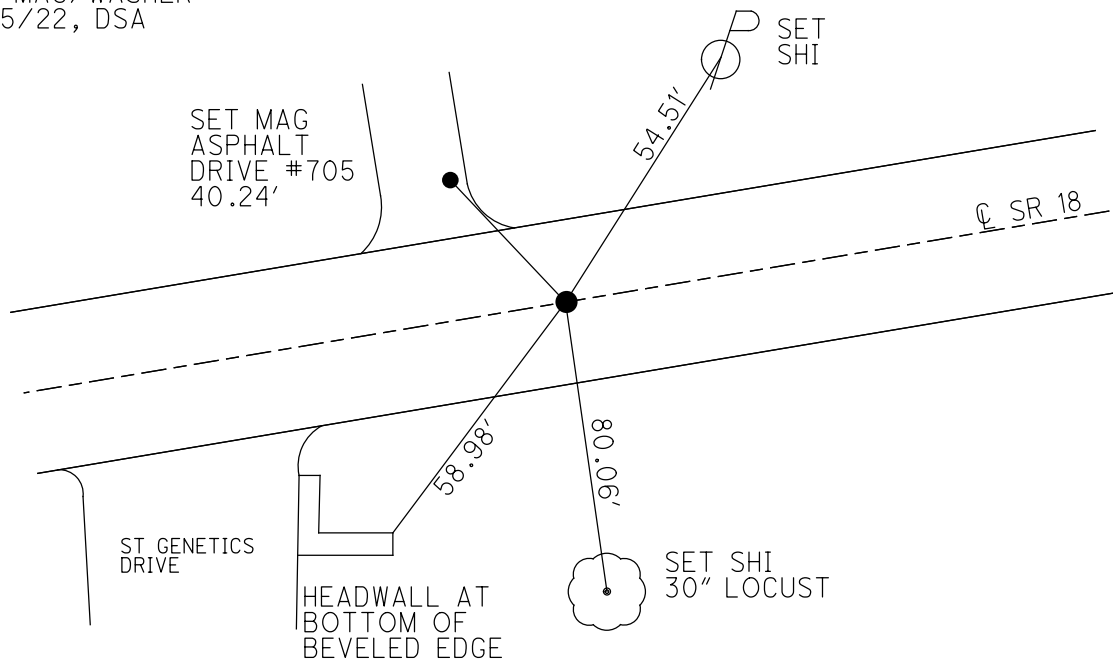

O.D.O.T. DISTRICT 2 SURVEY OFFICE (USE ONLY)

PERSONNEL

REFERENCE NO. 52

SHEET 12 OF 18

NOTES RHOADES

DATE 9/8/21

ROUTE SR 18

H.C. AUBLE

WEATHER SUNNY

COUNTY SENECA

R.C. NIESE

TEMP. 73°

TOWNSHIP CLINTON

SECTION 20

DWG BY RHOADES

PID PVTRAIN

T 2 N R 15 E

TYPE MONUMENT P.K.NAIL

ON SURFACE - ~~BELOW~~ ON

OFFSET Q PAVEMENT 1' ~~LT~~ : RT

8.5' TO RT EDGE PAVEMENT


STATION: 842+75

HORZ.DATUM: NAD83 (2011)


GEOID: 2012A

GRID: NORTHING: 530718.648

EASTING: 1789404.328

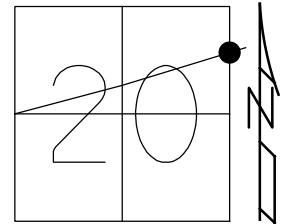

RECORD:
FD R.R.SPIKE
3/18/76
SET P.K./WASHER
9/7/76
FD P.K./WASHER
6/30/93, RCC
SET P.K./WASHER
8/25/93
FD P.K.NAIL
REF52
3/6/19
8/16/19, JFO
9/8/21, DSA
2/16/22, JFO

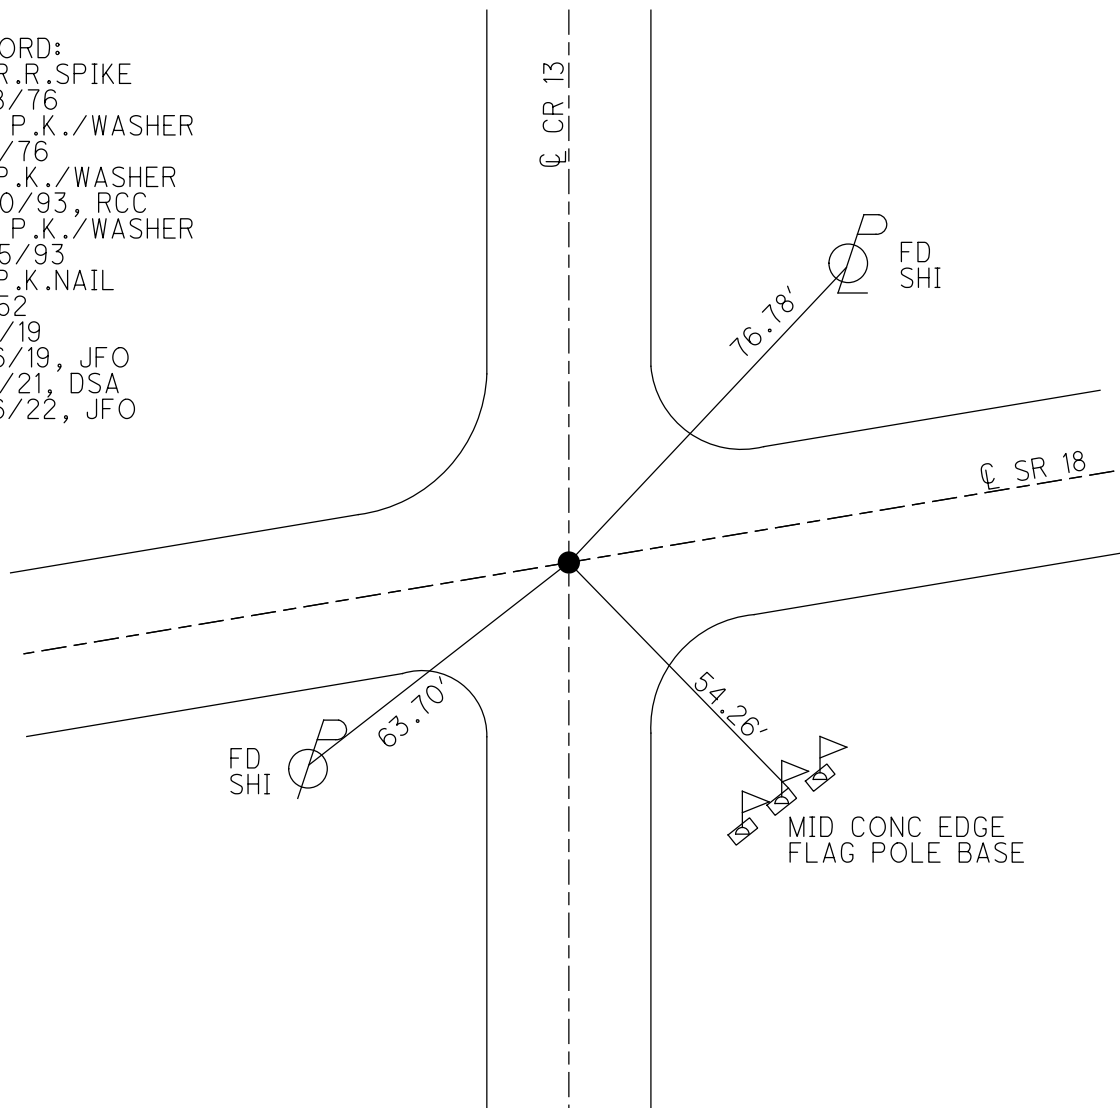

O.D.O.T. DISTRICT 2 SURVEY OFFICE (USE ONLY)

PERSONNEL

REFERENCE NO. 53

SHEET 13 OF 18

NOTES RHOADES

DATE 7/25/22

ROUTE SR 18

H.C. AUBLE

WEATHER CLOUDY

COUNTY SENECA

R.C. NIESE

TEMP. 75°

TOWNSHIP CLINTON

WHITAKER

PID PVTRN

SECTION 21

DWG BY WHITAKER

T 2 N R 15 E

TYPE MONUMENT MAG/WASHER

ON SURFACE - ~~BELOW~~ ON

OFFSET 0.8' LT : RT

9.5' TO RT EDGE PAVEMENT


STATION: 853+86

HORZ.DATUM: NAD83 (2011)


GEOID: 2012A

GRID: NORTHING: 531074.956

EASTING: 1790455.494

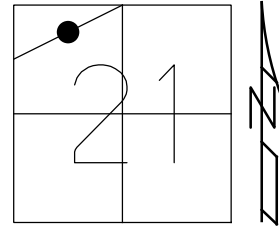

RECORD: P.I.
STA. 39+56
 $\Delta = 1^{\circ} 57' \text{ LT}$
FD R.R.SPIKE
1.5" DOWN
3/18/76
SET P.K./WASHER
9/7/76
SET P.K./WASHER
8/25/93
FD P.K.SHANK
REF53
3/6/19
8/16/19, JFO
SET MAG/WASHER
7/25/22, DSA

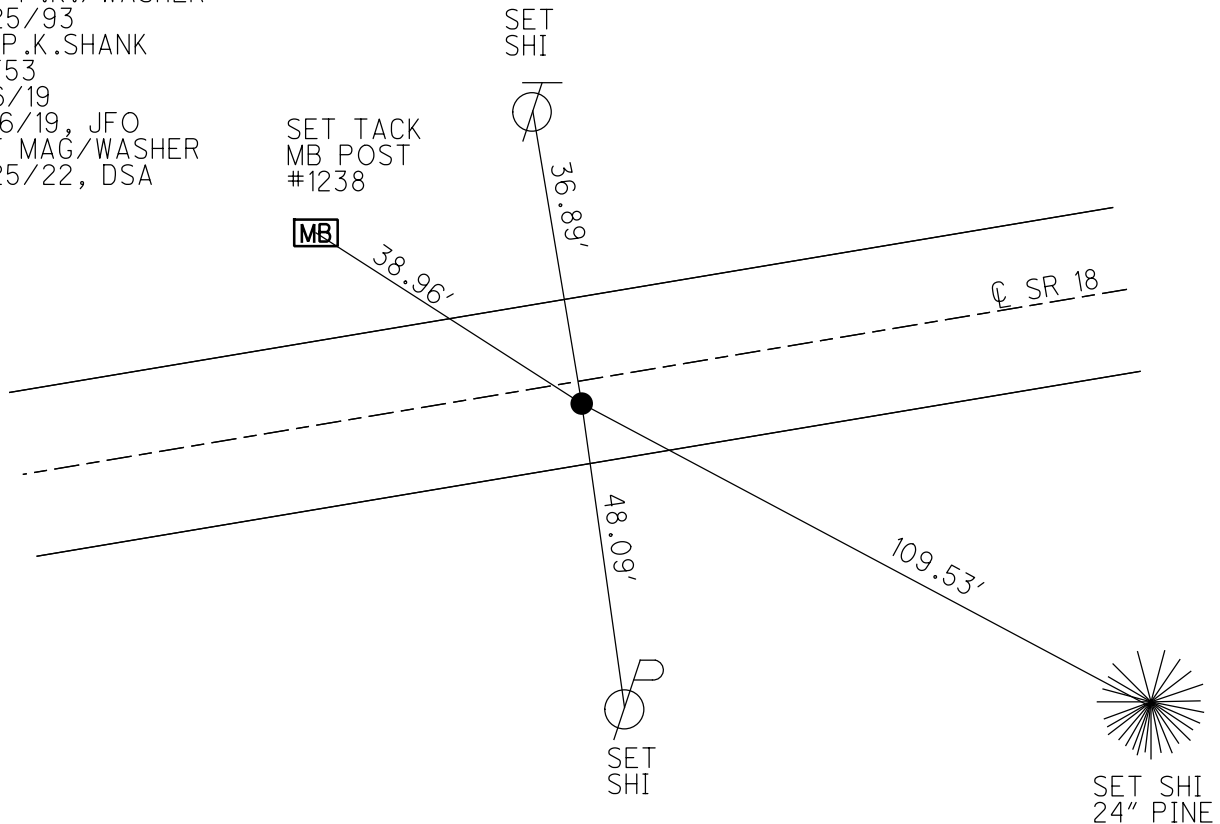

O.D.O.T. DISTRICT 2 SURVEY OFFICE (USE ONLY)

PERSONNEL

REFERENCE NO. 54

SHEET 14 OF 18

NOTES CHENEY

DATE 6-30-1993

ROUTE SR 18

H.C. RIPPLE

WEATHER CLOUDY

COUNTY SENECA

R.C. GEYMAN

TEMP. 75°

TOWNSHIP CLINTON

DWG BY AUBLE

PID 107060

SECTION 21

T 2 N R 15 E

TYPE MONUMENT 1" IPIN

~~ON SURFACE~~ - BELOW 2"

OFFSET Q PAVEMENT 66' LT : ~~RT~~

55' TO LT EDGE PAVEMENT


STATION: 870+13

HORZ.DATUM: NAD83 (2011)



GEOID: 2012A

GRID: NORTHING: 531650.251

EASTING: 1791981.345

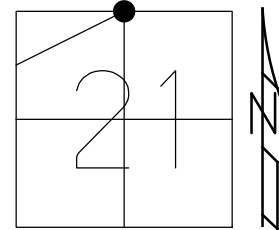

RECORD: P.I.
STA. 55+86.85
 $\Delta = 20^{\circ} 01' RT$
FD IPIN
3/18/76
SET SURVEY MARKER
POST ON N/SIDE
8/25/1993
FD 1" IPIN
3" DOWN
REF54
3/6/2019, JFO

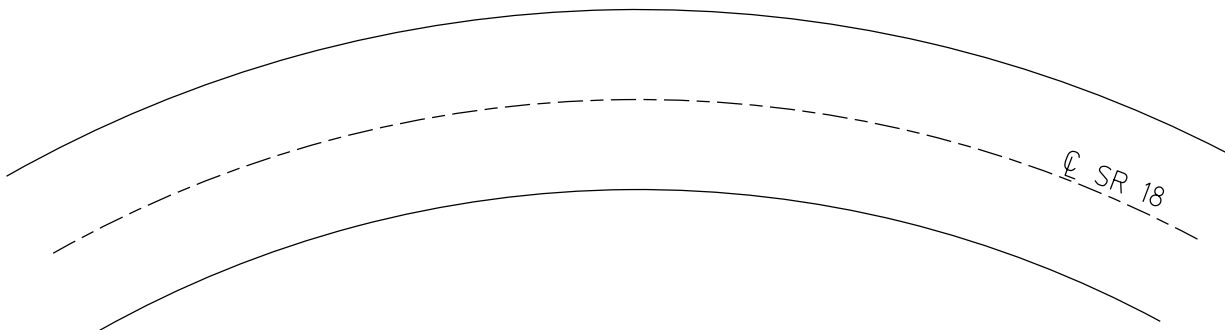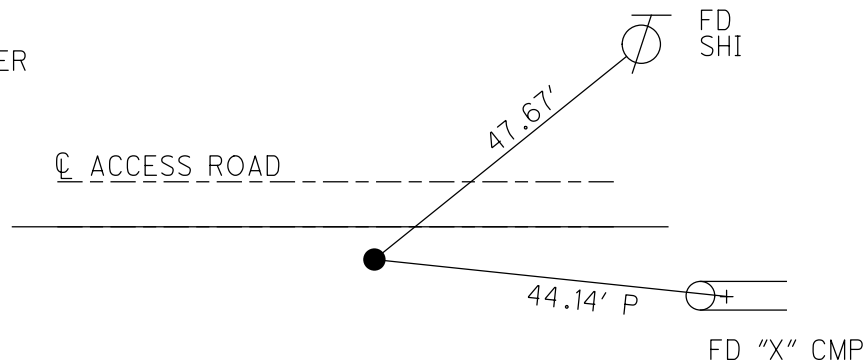

O.D.O.T. DISTRICT 2 SURVEY OFFICE (USE ONLY)

PERSONNEL

REFERENCE NO. 55

SHEET 15 OF 18

NOTES CHENEY

DATE 7-2-1993

ROUTE SR 18

H.C. RIPPLE

WEATHER CLOUDY

COUNTY SENECA

R.C. BARBOUR

TEMP. 75°

TOWNSHIP CLINTON

GEYMAN

SECTION 21

DWG BY AUBLE

PID 107060

T 2 N R 15 E

TYPE MONUMENT D.N.F.

ON SURFACE - BELOW -


OFFSET Q PAVEMENT - LT : RT

- TO - EDGE PAVEMENT


STATION: 877+56

HORIZ.DATUM: - GEOID: -

GRID: NORTHING: - EASTING: -

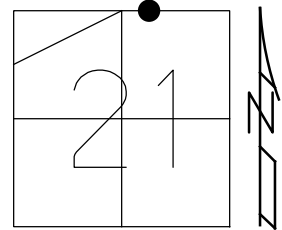

RECORD: P.I.
STA 63+29.73
DNF
12/22/65
3/18/76
7/2/1993, RCC
3/6/19, JFO

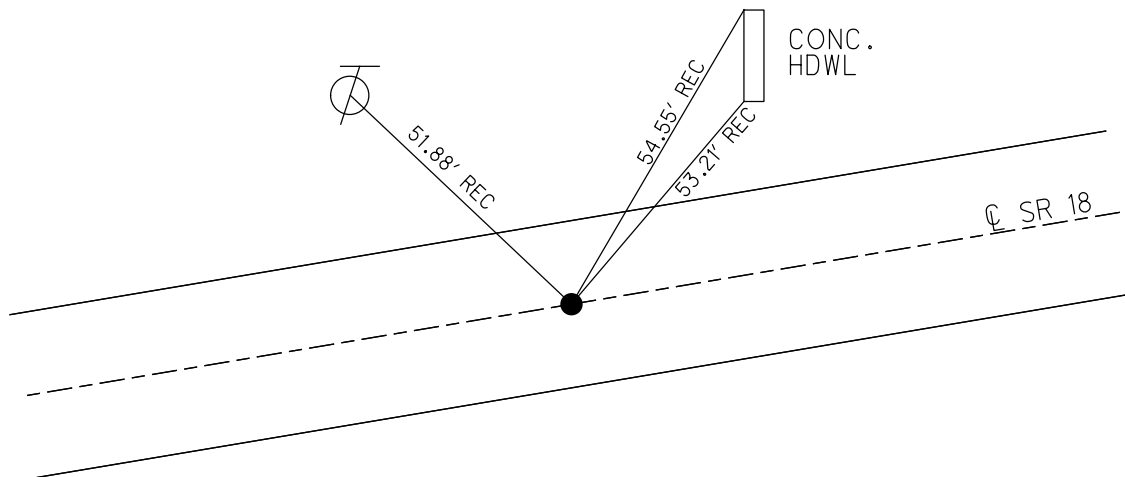

O.D.O.T. DISTRICT 2 SURVEY OFFICE (USE ONLY)

PERSONNEL

REFERENCE NO. 56

SHEET 16 OF 18

NOTES RHOADES

DATE 9/8/21

ROUTE SR 18

H.C. AUBLE

WEATHER SUNNY

COUNTY SENECA

R.C. NIESE

TEMP. 73°

TOWNSHIP CLINTON

DWG BY RHOADES

PID PVTRAIN

SECTION 21

T 2 N R 15 E

TYPE MONUMENT MAG/WASHER

ON SURFACE - ~~BELOW~~ ON

OFFSET CL PAVEMENT ON LT : RT

10.5' TO RT EDGE PAVEMENT


STATION: 879+60

HORZ.DATUM: NAD83 (2011)


GEOID: 2012A

GRID: NORTHING: 531661.704

EASTING: 1792937.341

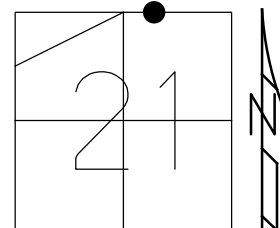

RECORD: P.I.
STA. 65+25.8
 $\Delta = 0^\circ 39' \text{ LT}$
FD SM.R.R.SPIKE
ATOP P.K.NAIL
3/18/76
SET P.K./WASHER
9/7/76
FD P.K./WASHER
7/2/93, RCC
SET P.K./WASHER
8/25/93
FD PK/WASHER
1" DOWN
REF56
3/6/2019
8/16/2019, JFO
SET MAG/WASHER
9/8/21, DSA
FD MAG/WASHER
2/16/22, JFO

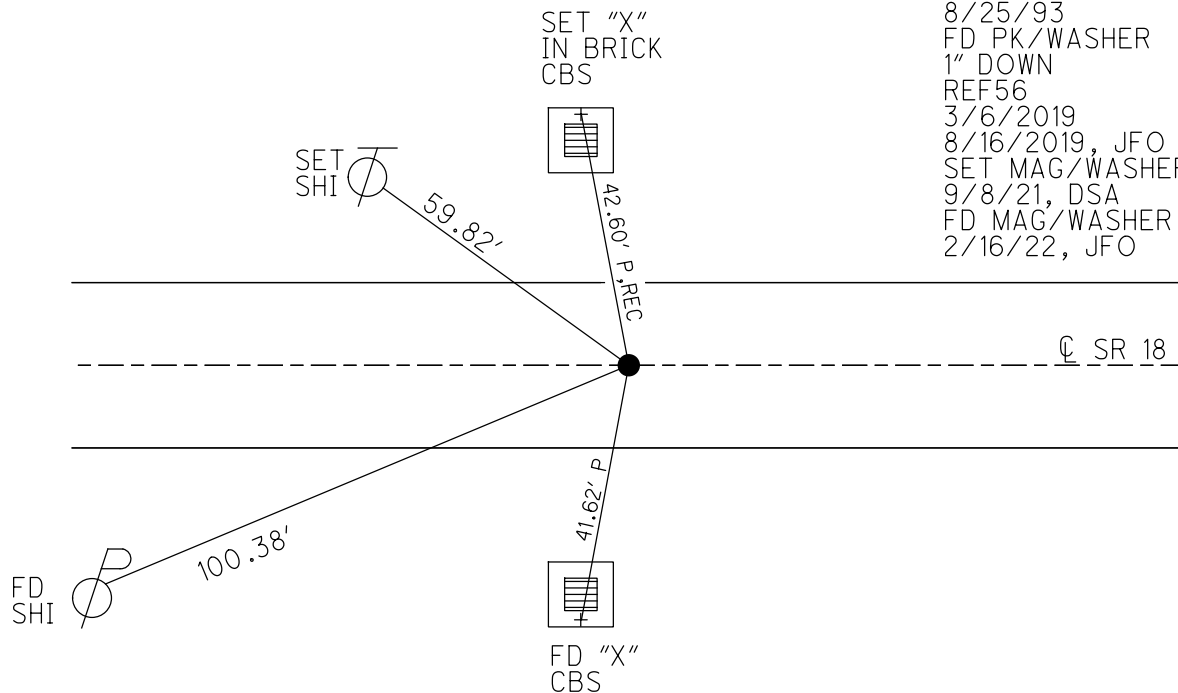

O.D.O.T. DISTRICT 2 SURVEY OFFICE (USE ONLY)

PERSONNEL

REFERENCE NO. 57

SHEET 17 OF 18

NOTES RHOADES

DATE 9/8/21

ROUTE SR 18

H.C. AUBLE

WEATHER SUNNY

COUNTY SENECA

R.C. NIESE

TEMP. 73°

TOWNSHIP CLINTON

SECTION 21

DWG BY RHOADES

PID PVTRAIN

T 2 N R 15 E

TYPE MONUMENT P.K. SHANK

~~ON SURFACE~~ - BELOW 2"

OFFSET Q PAVEMENT 0.5' LT : ~~RT~~

10.5' TO RT EDGE PAVEMENT


STATION: 896+88

HORZ. DATUM: NAD83 (2011)


GEOID: 2012A

GRID: NORTHING: 531680.046

EASTING: 1794664.848

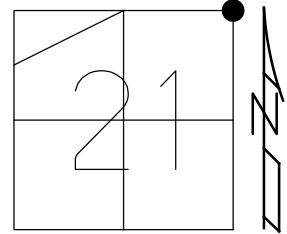

RECORD: P.I.
STA. 82+55
 $\Delta = 0^\circ 40' \text{ RT}$
FD SM.R.R.SPIKE
3/18/76
SET P.K./WASHER
9/7/76
FD P.K./WASHER
7/2/93, RCC
SET P.K./WASHER
8/25/93, RCC
FD P.K./SHANK
2" DOWN
REF57
3/6/2019
8/16/2019, JFO
9/8/21, DSA
2/16/22, JFO

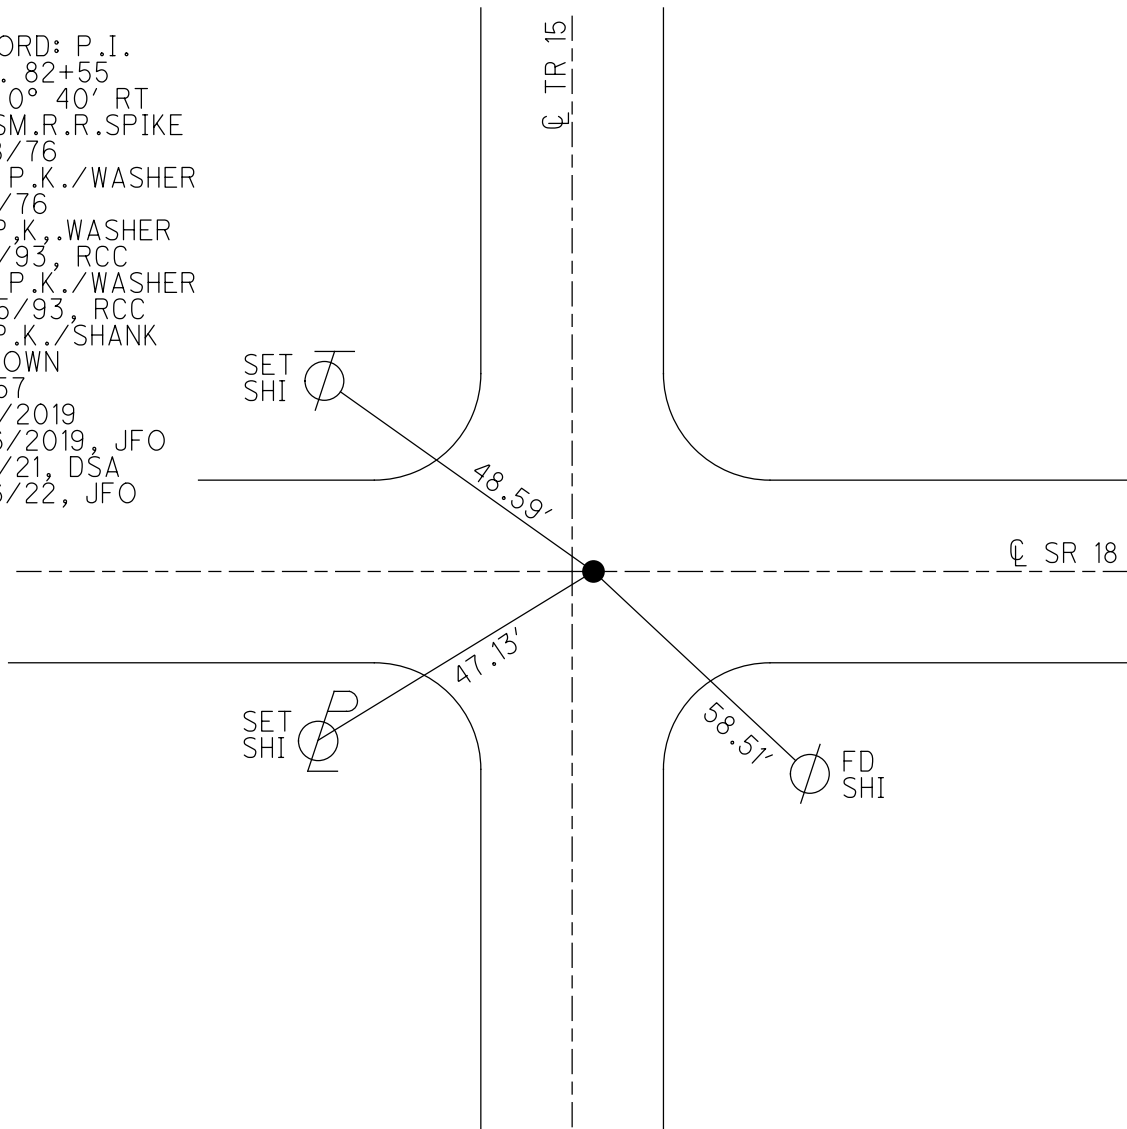

O.D.O.T. DISTRICT 2 SURVEY OFFICE (USE ONLY)

PERSONNEL

REFERENCE NO. 58

SHEET 18 OF 18

NOTES RHOADES

DATE 9/8/21

ROUTE SR 18

H.C. AUBLE

WEATHER SUNNY

COUNTY SENECA

R.C. NIESE

TEMP. 73°

TOWNSHIP CLINTON

DWG BY RHOADES

PID PVTRAIN

SECTION 22

T 2 N R 15 E

TYPE MONUMENT MAG/WASHER

ON SURFACE - ~~BELOW~~ ON

OFFSET Q PAVEMENT ON LT : RT

11.5' TO LT EDGE PAVEMENT


STATION: 922+54

HORZ.DATUM: NAD83 2011


GEOID: NAVD88 2018

GRID: NORTHING: 531676.783

EASTING: 1797231.824

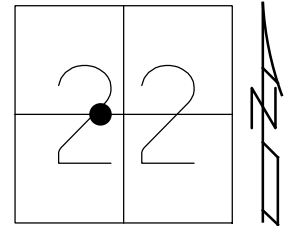

RECORD: P.I.
STA. 923+38.39
 Δ = OBS 0° 23' 20" LT
 Δ = REC 0° 24' 31" LT
SET PK/WASHER
10/7/91
FD P.K./WASHER
8/25/1993, RCC
SET MAG NAIL
3/6/19, JFO
SET MAG/WASHER
9/8/21, DSA
FD MAG/WASHER
2/16/22, JFO

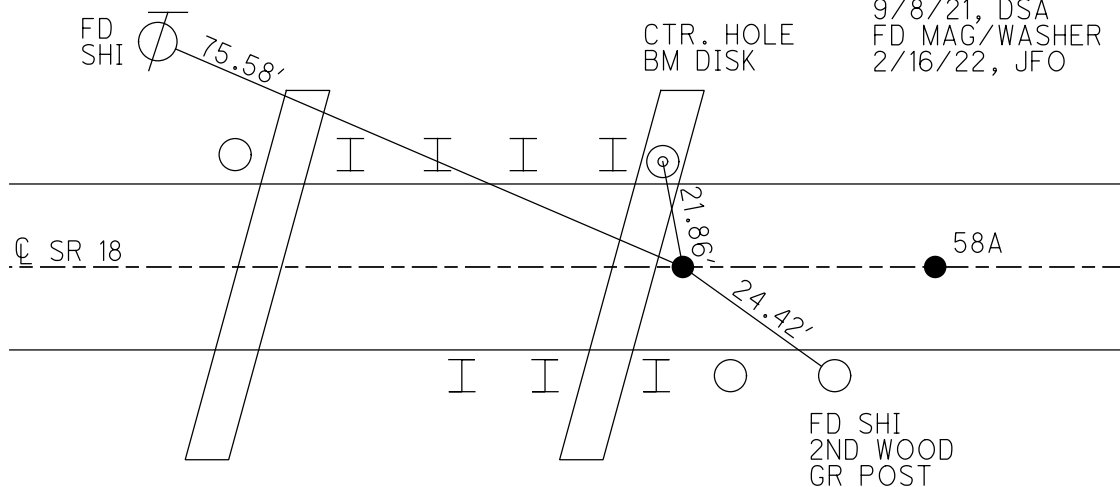

RECORD:
FD MAG NAIL
REFA58
3/6/19
8/16/2019, JFO
N: 531676.982
E: 1797269.4278

O.D.O.T. DISTRICT 2 SURVEY OFFICE (USE ONLY)

PERSONNEL

REFERENCE NO. 59

SHEET 1 OF 14

NOTES RHOADES

DATE 7/8/2015

ROUTE SR 18

H.C. O'DONNELL

WEATHER SUNNY

COUNTY SENECA

R.C. HOMAN

TEMP. 61° F

TOWNSHIP CLINTON

DWG BY AUBLE PID 107060

SECTION 14

T 2 N R 15 E

TYPE MONUMENT R.R. SPIKE

~~ON SURFACE~~ - BELOW 3"

OFFSET CL PAVEMENT ON LT : RT

12' TO LT EDGE PAVEMENT


STATION: 949+39.40

HORZ.DATUM: NAD83 (2011)


GEOID: 2012A

GRID: NORTHING: 531692.095

EASTING: 1799887.819

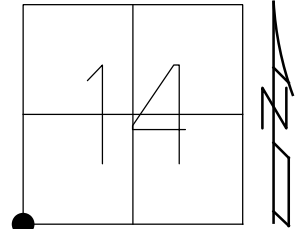

RECORD: P.I.
SET R.R.SPIKE
POST WAR PLAN(1950)
6/71
STA. 164+19.53
 $\Delta=0^{\circ}17'$ LT
STA 134+78.58
3-18-1976
SET P.K./WASHER
9-7-76
SET P.K./WASHER
8-25-1993, RCC
FD R.R. SPIKE
3" BELOW
REF59
5-1-14, EBW
SET MAG/WASHER
NEWREF59
7-11-16, DCH
FD MAG/WASHER
REF59
3-6-19
8/16/19, JFO

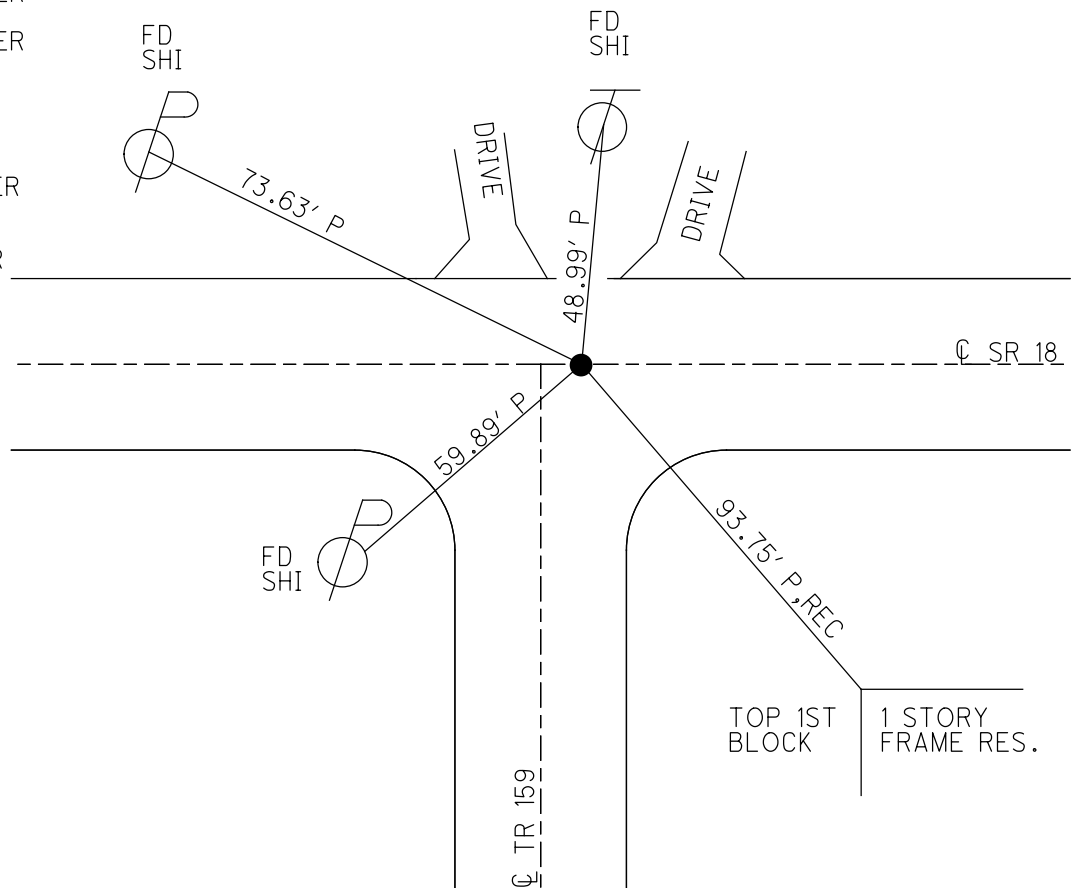

O.D.O.T. DISTRICT 2 SURVEY OFFICE (USE ONLY)

PERSONNEL		REFERENCE NO.	<u>60</u>	SHEET	<u>2</u>	OF	<u>17</u>
NOTES	<u>RHOADES</u>	DATE	<u>7-8-15</u>	ROUTE	<u>SR 18</u>		
H.C.	<u>O'DONNELL</u>	WEATHER	<u>SUNNY</u>	COUNTY	<u>SENECA</u>		
R.C.	<u>HOMAN</u>	TEMP.	<u>61°F</u>	TOWNSHIP	<u>CLINTON</u>		
				SECTION	<u>14</u>		
				T <u>2</u> N R <u>15</u> E			

TYPE MONUMENT SM. RR. SPIKE


~~ON SURFACE~~ - BELOW 3"

LEFT - ℄ PAV'T - RIGHT ON

11.3' TO RT EDGE PAVEMENT

S.L.M. 978+80.41

Grid: Northing: 531724.0671 Easting: 1802828.6871

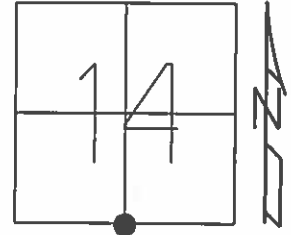


RECORD:
P.I. Δ0°29' RT
STA 164+19.53
SET SM. SPK
USED TIES FROM 1953
PLANS TO ESTABLISHED
6-11-1971

SET PK/WASHER
8-25-1993, RCC

FD PK/WASHER
GPS, REF60
05-01-14

SET MAG/WASHER
GPS, NEWREF60
7-11-16, DCH

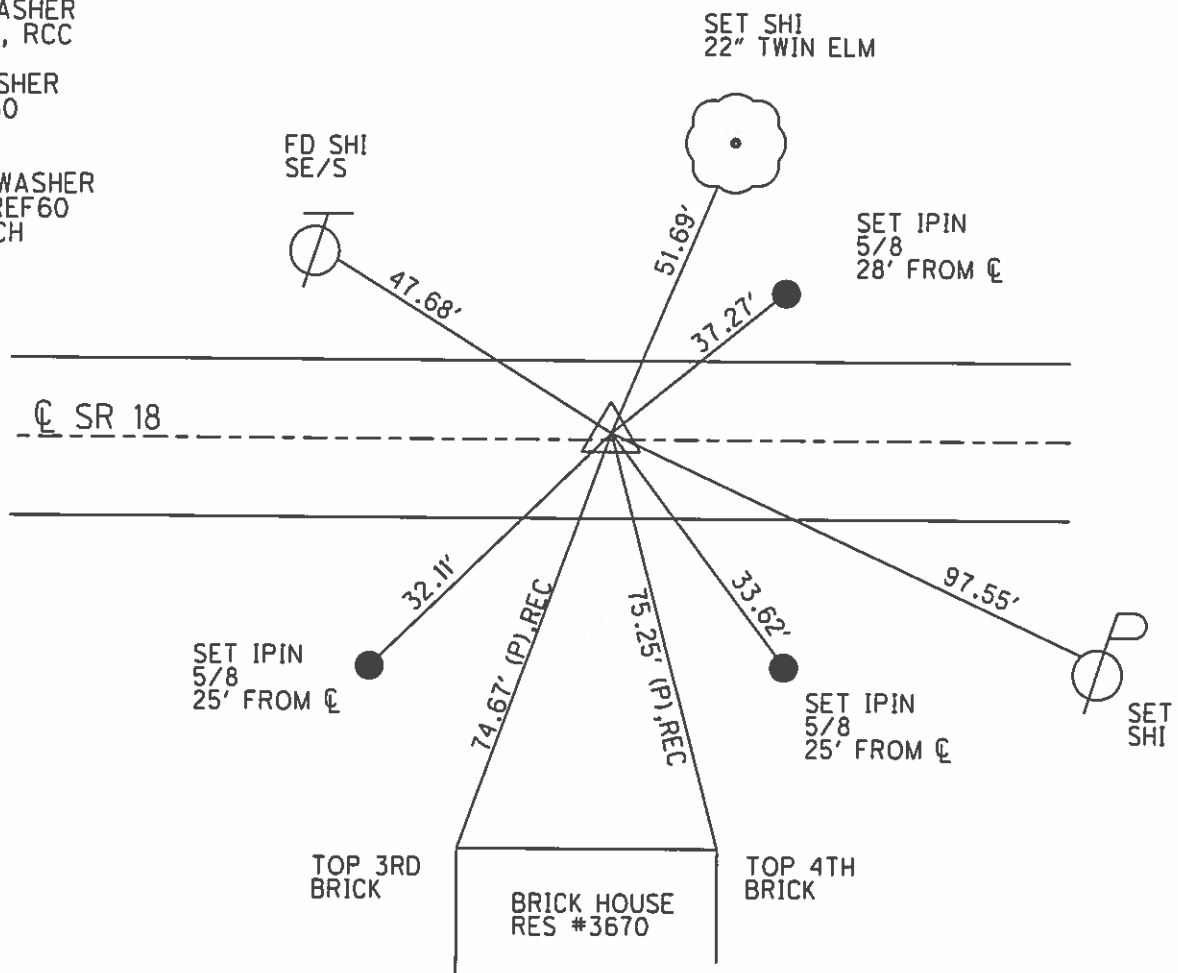


O.D.O.T. DISTRICT 2 SURVEY OFFICE (USE ONLY)

PERSONNEL _____ REFERENCE NO. 61 SHEET 3 OF 17
 NOTES RHOADES DATE 7-8-15 ROUTE SR 18
 H.C. O'DONNELL WEATHER SUNNY COUNTY SENECA
 R.C. HOMAN TEMP. 61°F TOWNSHIP CLINTON
 SECTION 14
 T 2 N R 15 E

TYPE MONUMENT PK NAIL
~~ON SURFACE~~ - BELOW 1"
 LEFT - CL PAV'T - ~~RIGHT~~ 1'
11.5' TO LT EDGE PAVEMENT
 S.L.M. 1001+17.18

Grid: Northing: 531729.265 Easting: 1805065.372

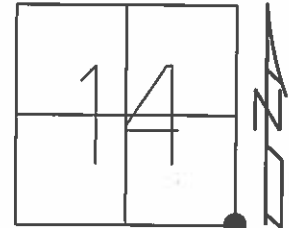

RECORD:
 P.I. $\Delta=1^{\circ}22'RT$
 STA 186+57.20
 SET SMALL SPIKE
 6-14-1971


FD OLD HINGE NAILS
 @ 100' STA 2" DOWN ON
 CR 165-CHECKED
 OUT WITH TIE FROM PLAN

SET PK/WASHER
 8-26-1993, RCC

FD PK/WASHER
 1" BELOW
 GPS, REF61
 05-06-14

RESHOT
 5-29-14

SET MAG/WASHER
 GPS, NEWREF61
 7-11-16,DCH

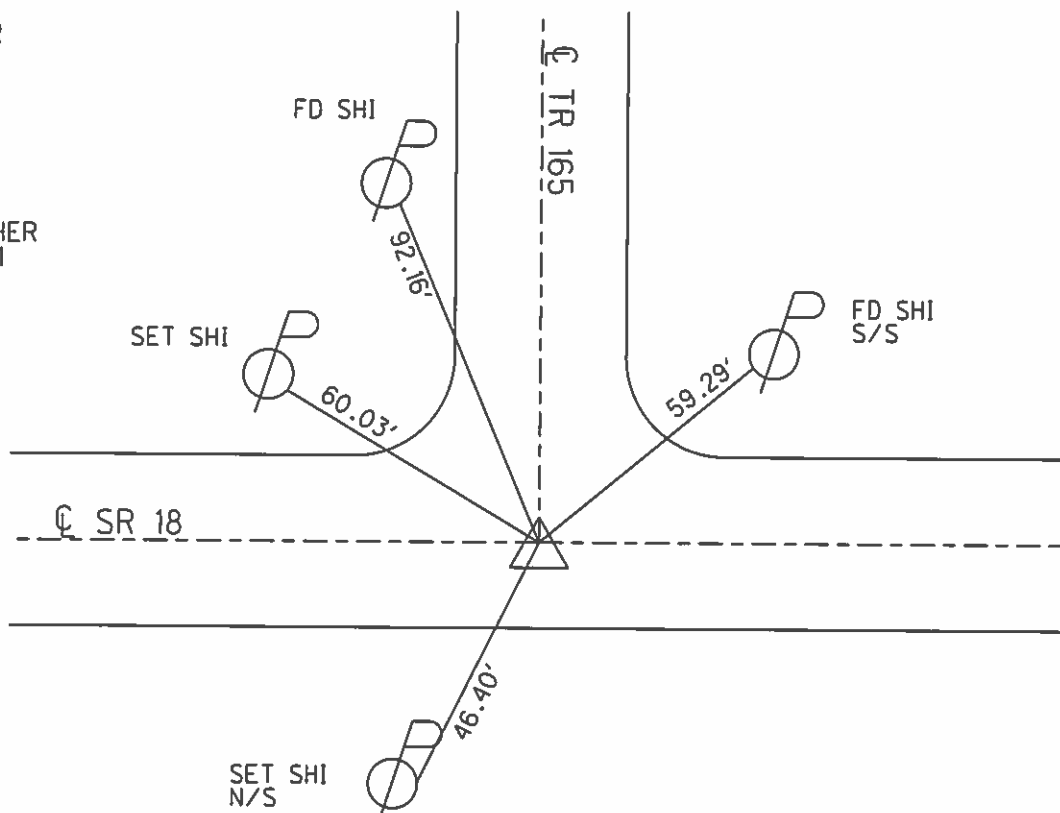

O.D.O.T. DISTRICT 2 SURVEY OFFICE (USE ONLY)

PERSONNEL

REFERENCE NO. 62

SHEET 4 OF 17

NOTES RHOADES
H.C. O'DONNELL
R.C. HOMAN

DATE 7-8-15
WEATHER SUNNY
TEMP. 61°F

ROUTE SR 18
COUNTY SENECA
TOWNSHIP CLINTON
SECTION 13
T 2 N R 15 E

TYPE MONUMENT RR. SPIKE


~~ON SURFACE~~ - BELOW 3"

LEFT - CL PAV'T - RIGHT ON

11' TO RT EDGE PAVEMENT

S.L.M. 1032+13.95

Grid: Northing: 531662.6749 Easting: 1808161.4160

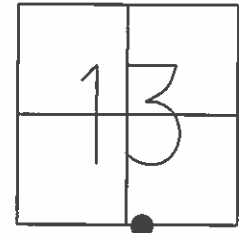

RECORD:

P.I. $\Delta=0^{\circ}17'$ RT

STA 217+53.96

FD RR. SPK @ SURFACE

6-14-1971

SET PK/WASHER

8-26-1993, RCC

FD RR. SPK

2" BELOW

05-06-14, JLL, EBW


GPS, REF62

5-29-14

SET MAG/WASHER

GPS, NEWREF62

7-11-16.DCH

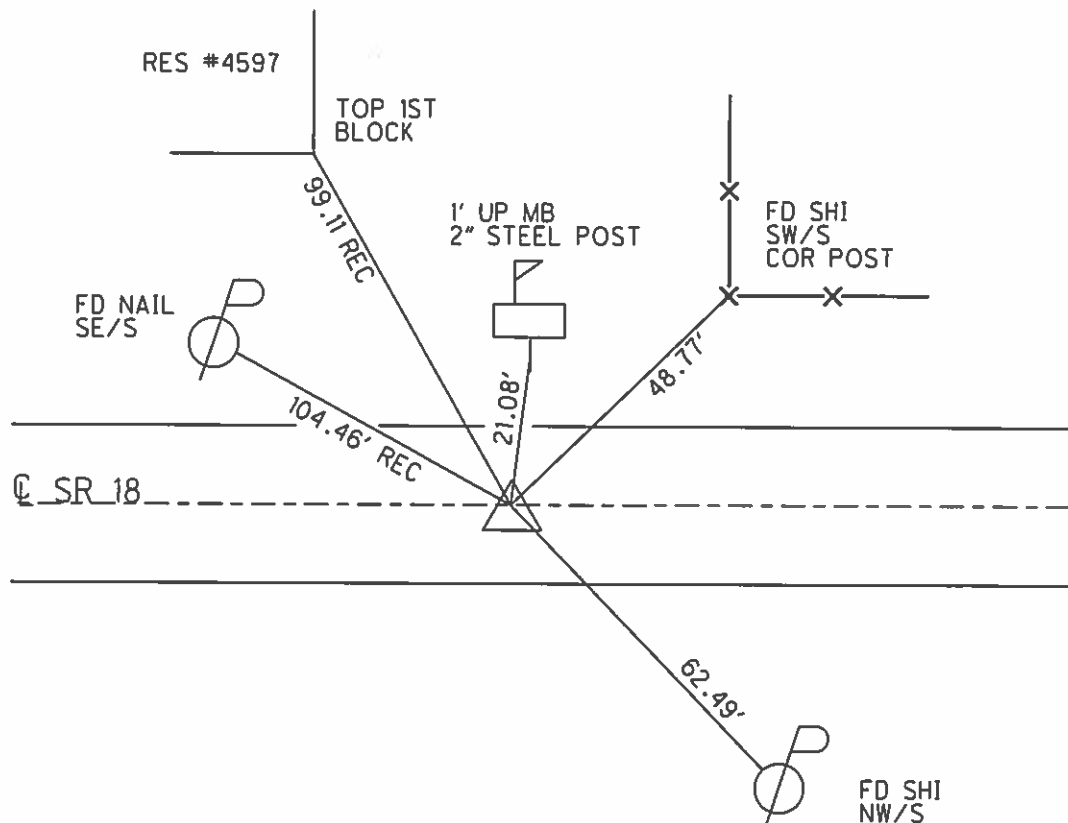


O.D.O.T. DISTRICT 2 SURVEY OFFICE (USE ONLY)

PERSONNEL	REFERENCE NO.	<u>63</u>	SHEET	<u>5</u>	OF	<u>17</u>		
NOTES	<u>RHOADES</u>	DATE	<u>7-8-15</u>	ROUTE	<u>SR 18</u>			
H.C.	<u>O'DONNELL</u>	WEATHER	<u>SUNNY</u>	COUNTY	<u>SENECA</u>			
R.C.	<u>HOMAN</u>	TEMP.	<u>61°F</u>	TOWNSHIP	<u>CLINTON</u>			
				SECTION	<u>13</u>			
				T	<u>2</u>	R	<u>15</u>	E

TYPE MONUMENT PK NAIL
ON SURFACE - ~~BELOW~~ ON
LEFT - Q PAV'T - ~~RIGHT~~ 3'
7' TO LT EDGE PAVEMENT
S.L.M. 1054+44

Grid: Northing: 531603.9316 Easting: 1810390.7329

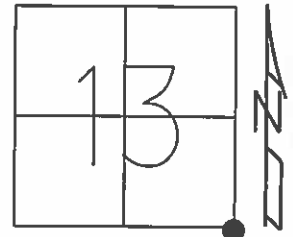

RECORD:
P.I. $\Delta=3^{\circ}08'$ RT
STA 239+83.74
FD RR. SPK @ SURFACE
6-14-1971


SET PK/WASHER
8-26-1993, RCC

FD RR. SPK
GPS, REF63
05-06-14, JLL, EBW

GPS, REF63
5-29-14

SET MAG/WASHER
GPS, NEWREF63
7-11-16, DCH

FD. SHI
S/S
CUT POLE

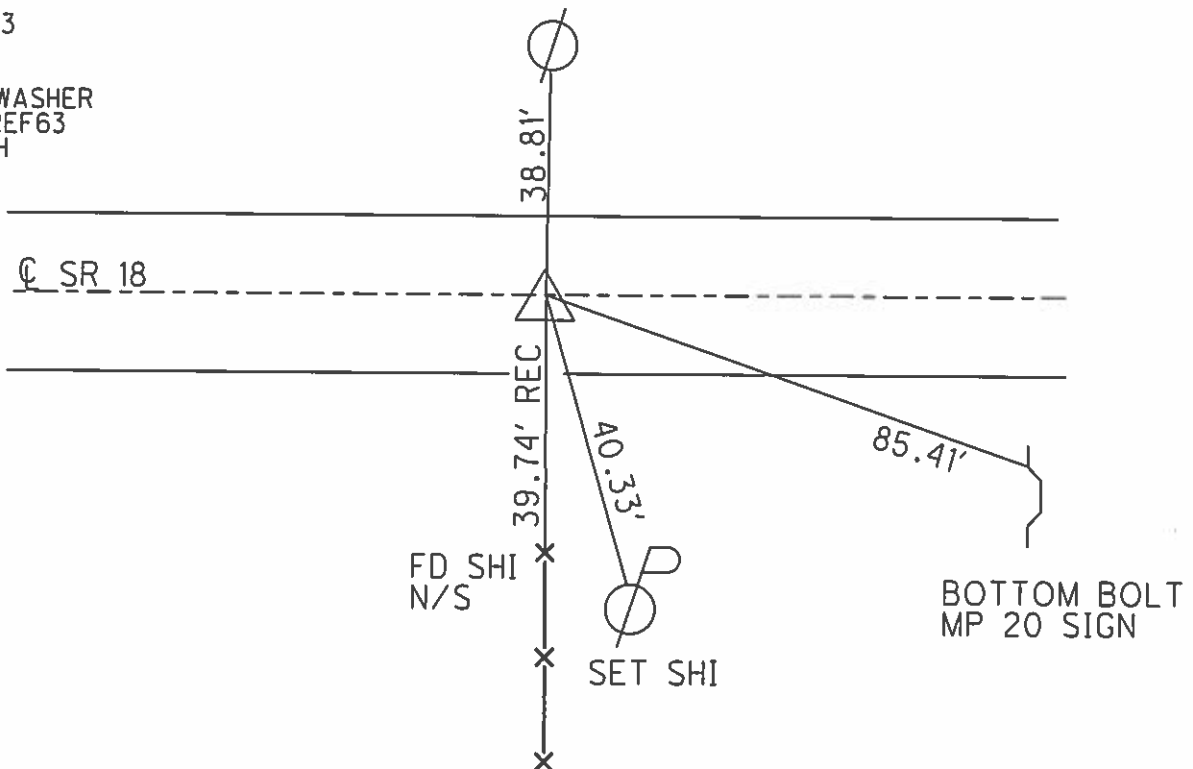

O.D.O.T. DISTRICT 2 SURVEY OFFICE (USE ONLY)

PERSONNEL

REFERENCE NO.

64

SHEET

6

OF 17

NOTES RHOADES

DATE

7-8-15

ROUTE

SR 18

H.C. O'DONNELL

WEATHER

SUNNY

COUNTY

SENECA

R.C. HOMAN

TEMP.

61°F

TOWNSHIP

SCIPIO

SECTION

18

T 2 N R 16 E

TYPE MONUMENT RR. SPIKE


~~ON SURFACE~~ - BELOW 3"

~~LEFT~~ - ℄ PAV'T - RIGHT 4.5'

6' TO RT EDGE PAVEMENT

S.L.M. 1068+97.59

Grid: Northing: 531479.418 Easting: 1811838.8945

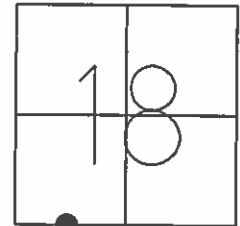

RECORD:

P.I. $\Delta=5^{\circ}00'$ LT

STA 254+37.35

FD RR. SPK @ SURFACE

6-14-1971

SET PK/WASHER

8-26-1993, RCC

FD RR. SPK

3" BELOW

GPS, REF64

05-06-14, JLL, EBW


GPS, REF64

5-29-14

SET MAG/WASHER

GPS, NEWREF64


7-11-16, DCH

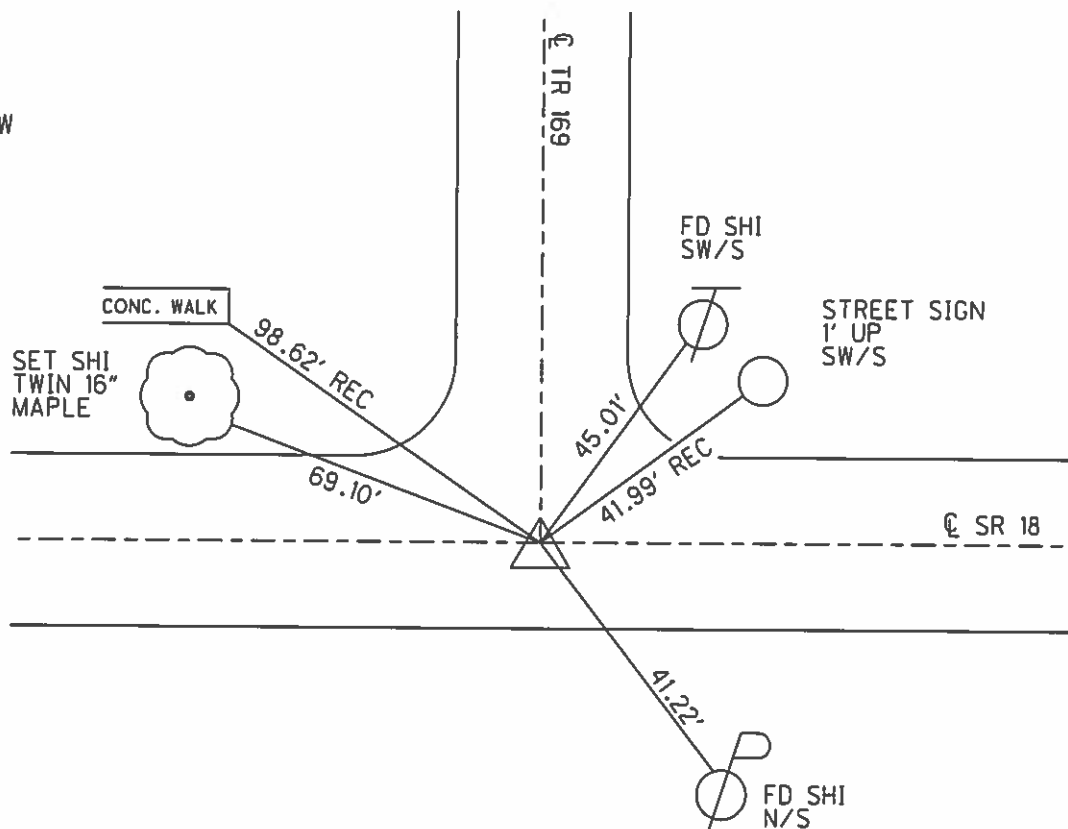

O.D.O.T. DISTRICT 2 SURVEY OFFICE (USE ONLY)

PERSONNEL _____ REFERENCE NO. 65 SHEET 7 OF 17
 NOTES RHOADES DATE 7-8-15 ROUTE SR 18
 H.C. O'DONNELL WEATHER SUNNY COUNTY SENECA
 R.C. HOMAN TEMP. 61°F TOWNSHIP SCPIO
 _____ SECTION 18
 _____ T 2 N R 16 E

TYPE MONUMENT PK SHANK
 ON SURFACE - ~~BELOW~~ _____ ON _____
 LEFT - CL PAV'T - ~~RIGHT~~ 1.0'
10' TO LT EDGE PAVEMENT
 S.L.M. 1083+43.65
 Grid: Northing: 531478.1269 Easting: 1813284.9349

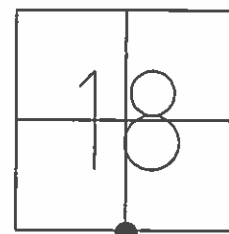


RECORD:
 P.I. $\Delta=0^{\circ}07'$ LT
 STA 268+84.38
 FD RR. SPK @ SURFACE
 6-14-1971

SET PK/WASHER
 8-26-1993, RCC

FD RR. SPK
 GPS, REF65
 05-06-14, JLL, EBW

GPS, REF65
 5-29-14

SET MAG/WASHER
 GPS, NEWREF65
 7-12-16, JFO

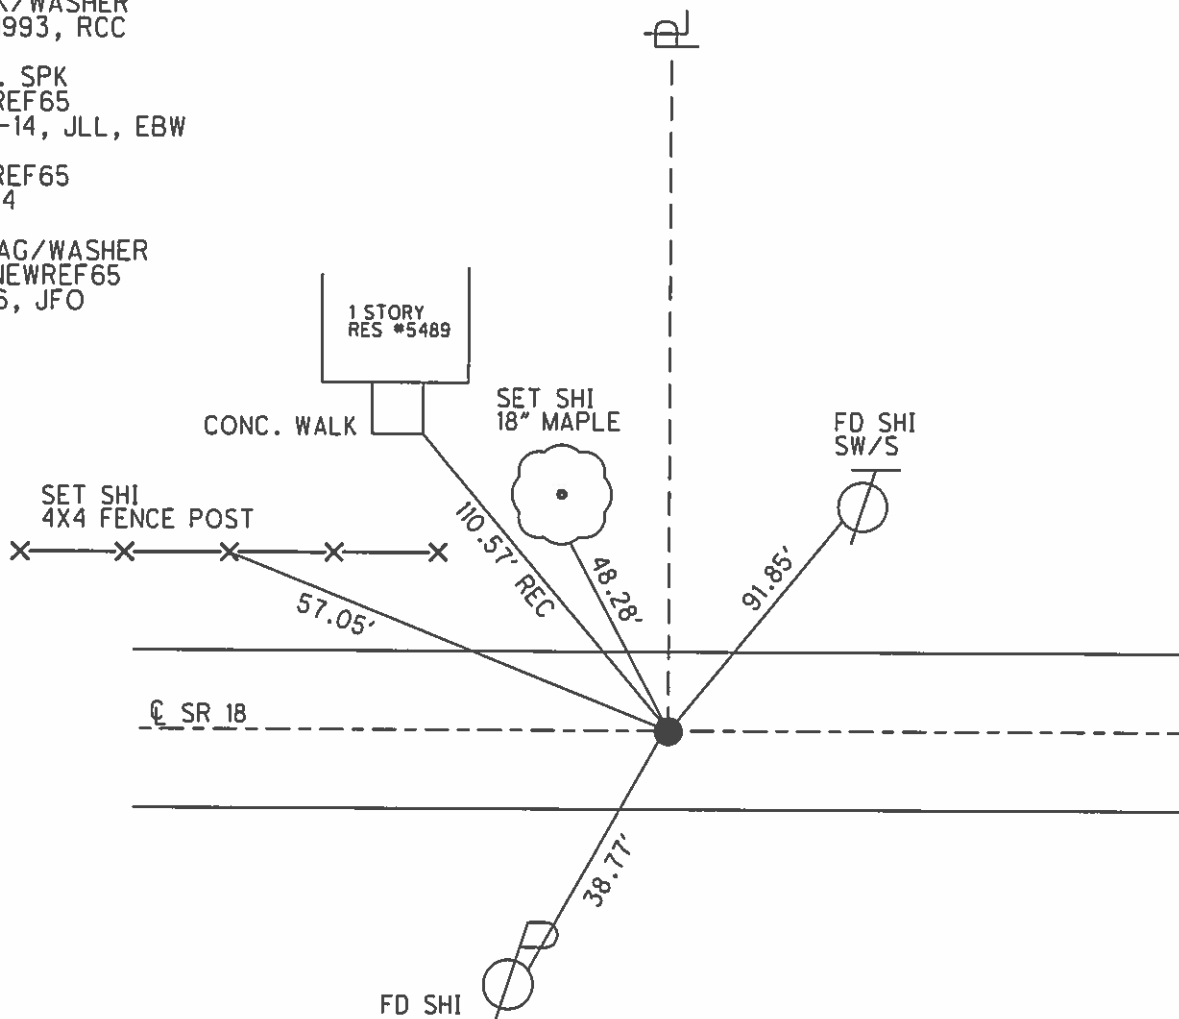

O.D.O.T. DISTRICT 2 SURVEY OFFICE (USE ONLY)

PERSONNEL

REFERENCE NO.

66

SHEET

8

OF

14

NOTES

RHOADES

DATE

7-8-15

ROUTE

SR 18

H.C.

O'DONNELL

WEATHER

SUNNY

COUNTY

SENECA

R.C.

HOMAN

TEMP.

61°F

TOWNSHIP

SCIPIO

SECTION

17

T 2 N

R 16 E

TYPE MONUMENT

RR. SPIKE

~~ON SURFACE~~ - BELOW

3"

~~LEFT~~ - ℄ PAV'T - RIGHT

1'

11'

TO LT

EDGE PAVEMENT

S.L.M.


1109+77.68

Grid: Northing:


531481.294

Easting:

1815919.0925

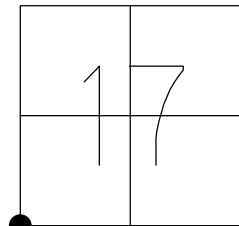

RECORD: P.I.
Δ=1°03' LT
STA 295+19.48
FD 3/4" IPIN
SET SM. R.R.SPIKE
6-14-1971
SET PK/WASHER
8-26-1993, RCC
FD RR. SPIKE
3" DOWN
REF66
5-29-14, EBW
SET MAG/WASHER
NEWREF66
7-12-16, JFO

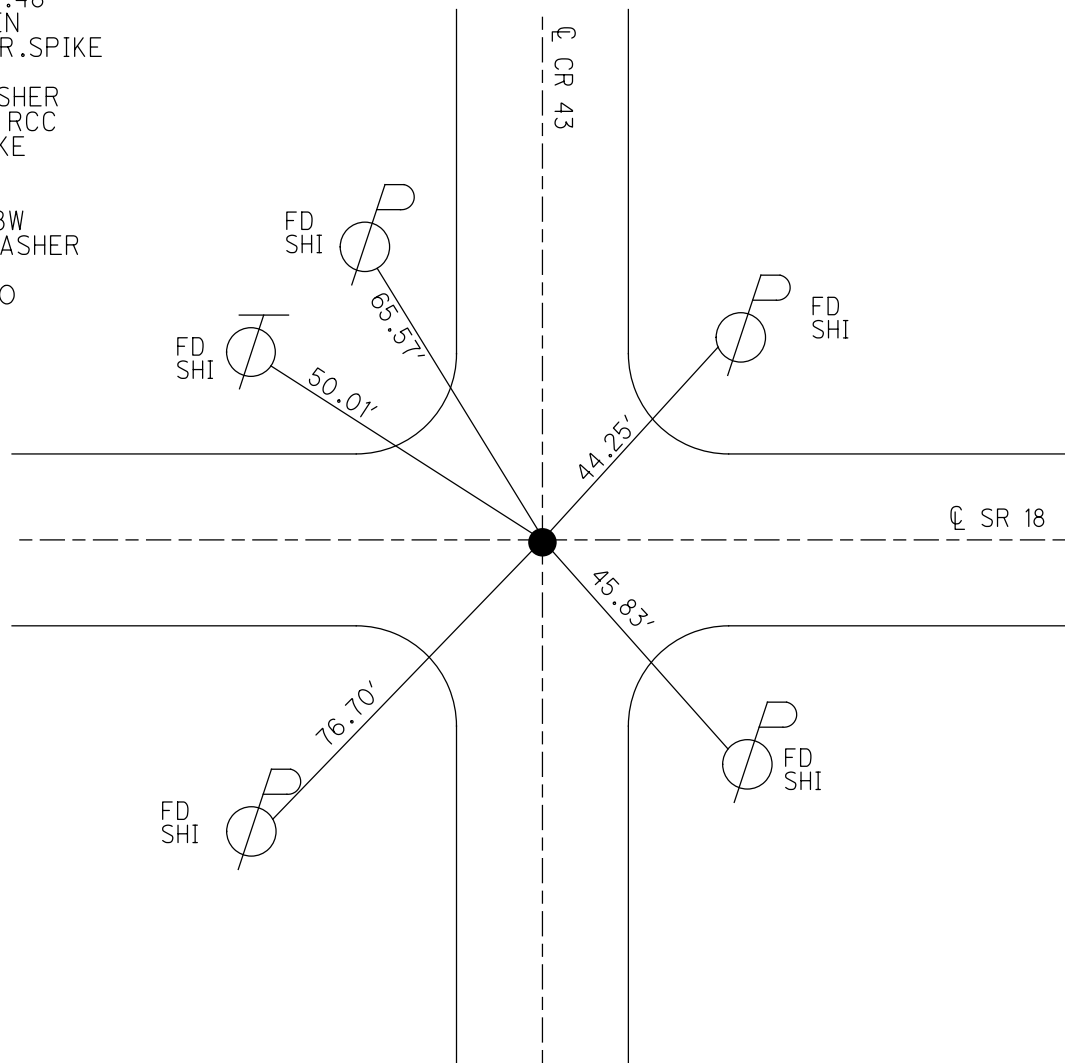

O.D.O.T. DISTRICT 2 SURVEY OFFICE (USE ONLY)

PERSONNEL _____ REFERENCE NO. 67 SHEET 9 OF 17
 NOTES RHOADES DATE 7-8-15 ROUTE SR 18
 H.C. O'DONNELL WEATHER SUNNY COUNTY SENECA
 R.C. HOMAN TEMP. 61°F TOWNSHIP SCIPIO
 _____ SECTION 17
 _____ T 2 N R 16 E

TYPE MONUMENT PK/WASHER


~~ON SURFACE~~ - BELOW 1.5"

LEFT - CL PAV'T - ~~RIGHT~~ 1.5'

10' TO LT EDGE PAVEMENT

S.L.M. 1136+20.92

Grid: Northing: 531532.3321 Easting: 1818561.8099

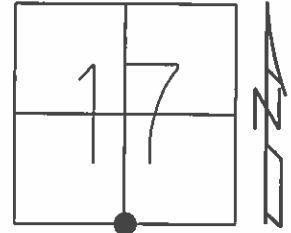


RECORD:

P.I. $\Delta=0^{\circ}25'$ RT
 STA 321+62.14
 FD RR.SPIKE 4" BELOW
 SET SM. RR. SPK. ATOP
 6-14-1971

FD RR. SPK
 1.5" BELOW
 GPS, REF67
 05-07-14, JLL, EBW

SET MAG/WASHER
 GPS, NEWREF67
 7-14-16, JFO

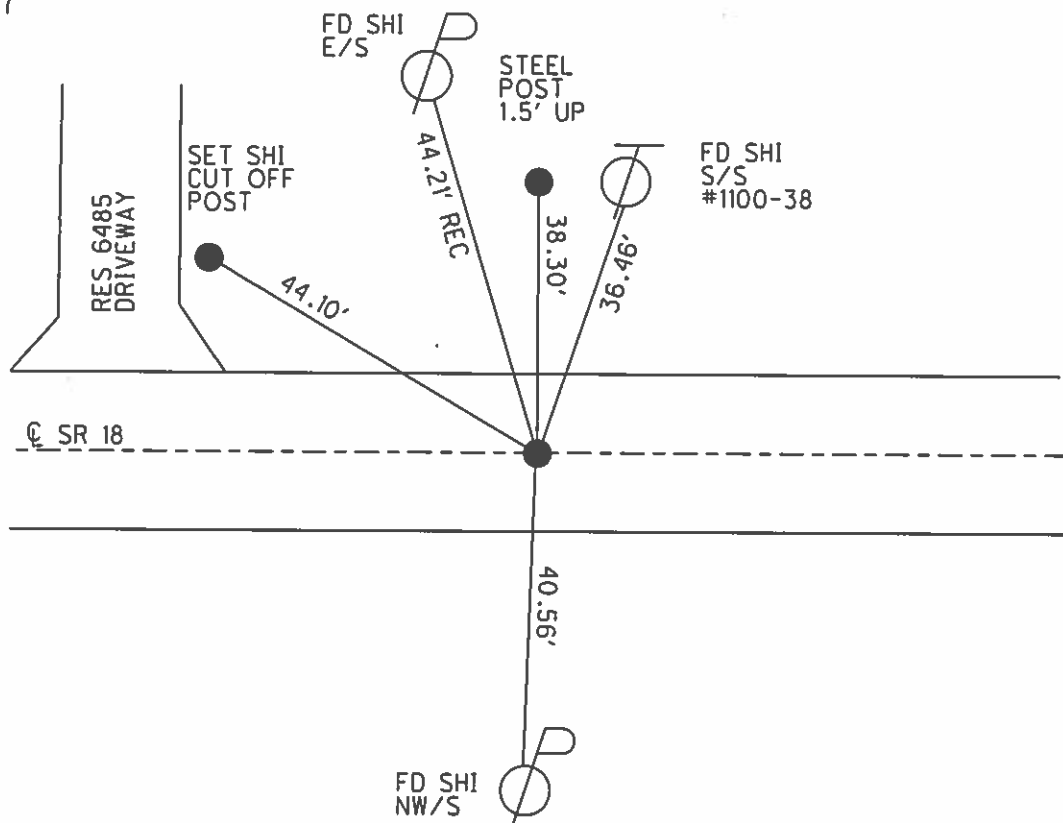

O.D.O.T. DISTRICT 2 SURVEY OFFICE (USE ONLY)

PERSONNEL

REFERENCE NO. 68

SHEET 10 OF 17

NOTES RHOADES
H.C. O'DONNELL
R.C. HOMAN

DATE 7-8-15
WEATHER SUNNY
TEMP. 61°F

ROUTE SR 18
COUNTY SENECA
TOWNSHIP SCIPIO
SECTION 16
T 2 N R 16 E

TYPE MONUMENT RR. SPIKE


~~ON SURFACE~~ - BELOW 4"

LEFT - Q PAV'T - ~~RIGHT~~ 1.5'

12' TO LT EDGE PAVEMENT

S.L.M. 1162+54.53

Grid: Northing: 531564.2784 Easting: 1821195.1738

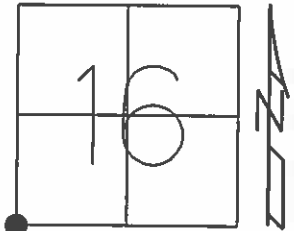


RECORD:
P.I. $\Delta=0^{\circ}20'$ RT
STA 347+97.61
FD RR.SPIKE
@ SURFACE
6-14-1971

SET PK/WASHER
8-27-93, RCC

FD RR. SPK
3" BELOW
GPS, REF68
05-07-14, JLL, EBW

SET MAG/WASHER
GPS, NEWREF68
7-14-16, JFO

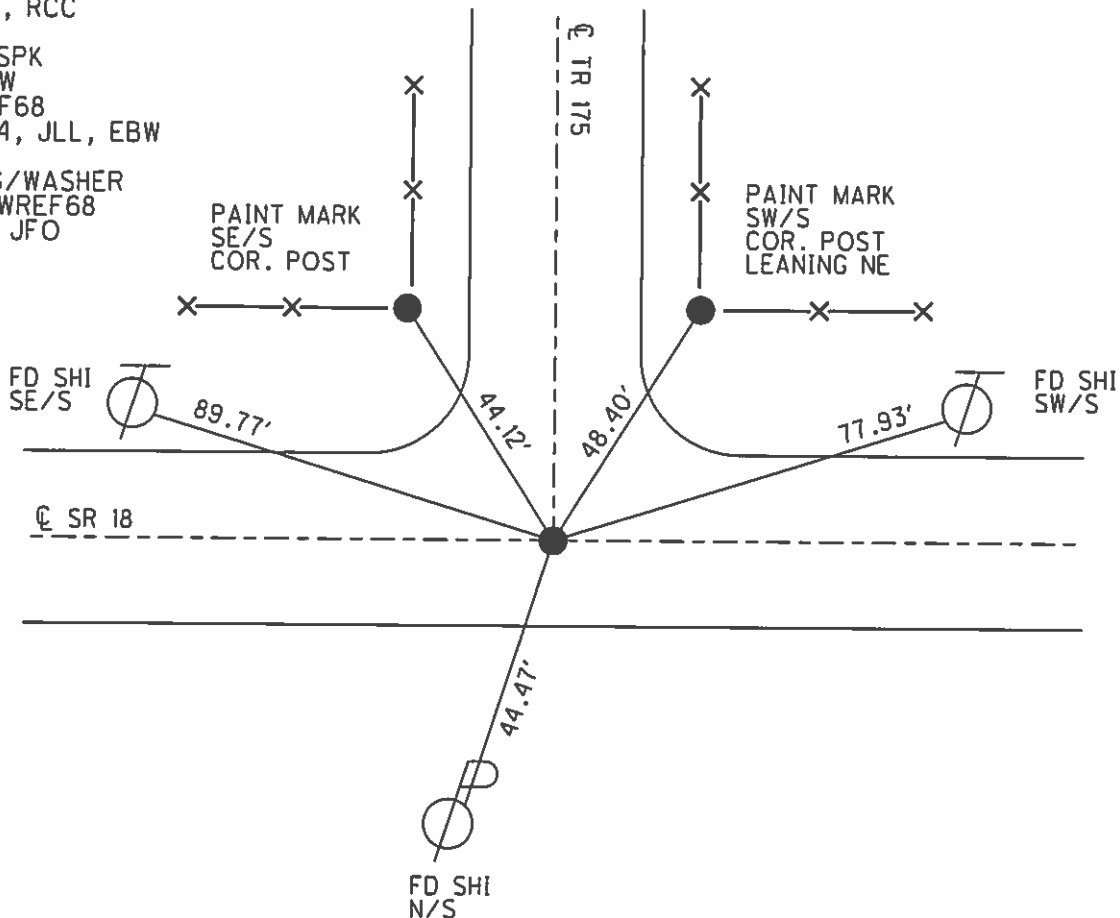

O.D.O.T. DISTRICT 2 SURVEY OFFICE (USE ONLY)

PERSONNEL

REFERENCE NO.

69

SHEET

11

OF

17

NOTES RHOADES

H.C. O'DONNELL

R.C. HOMAN

DATE

7-8-15

WEATHER

SUNNY

TEMP.

61°F

ROUTE

SR 18

COUNTY

SENECA

TOWNSHIP

SCIPIO

SECTION

16

T 2 N

R 16 E

TYPE MONUMENT PK/WASHER


~~ON SURFACE~~ - BELOW 1"

~~LEFT~~ - C PAV'T - RIGHT 1.0'

10' TO RT EDGE PAVEMENT

S.L.M. 1188+93.17

Grid: Northing: 531580.8755 Easting: 1823833.8516

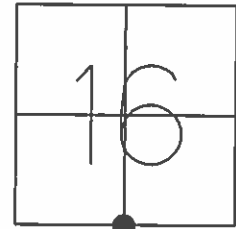

RECORD:

P.I. $\Delta=00^{\circ}30'$ LT

STA 374+37.12

FD RR. SPIKE 4" DOWN

SET SM. RR. SPIKE ATOP

6-14-71


SET PK/WASHER
8-27-93, RCC

FD SHI
SE/S

SET SHI

FD PK/WASHER
GPS, REF69
05-07-14, JLL, EBW

SET MAG/WASHER
GPS, NEWREF69
7-14-16, JFO

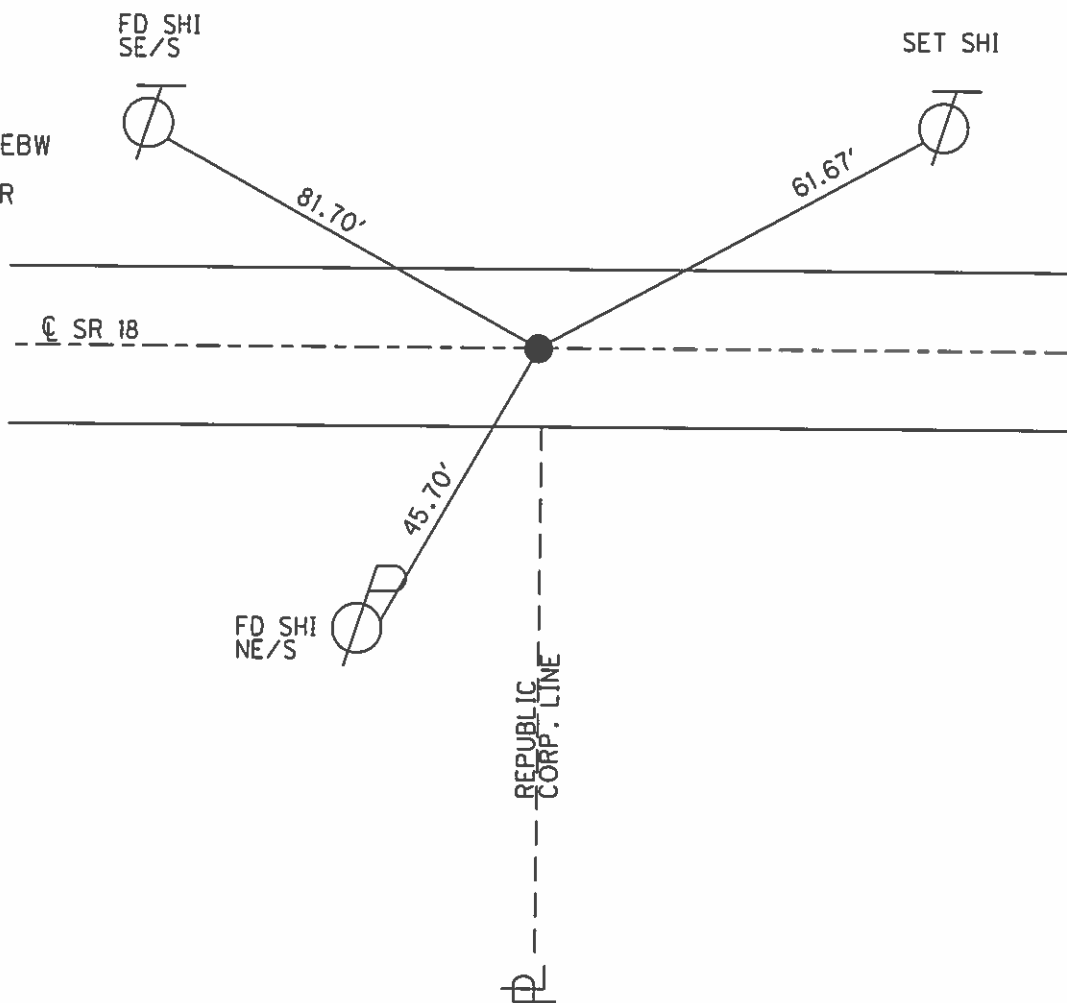

O.D.O.T. DISTRICT 2 SURVEY OFFICE (USE ONLY)

PERSONNEL

REFERENCE NO.

69 A

SHEET

12

OF 17

NOTES RHOADES

DATE 7-8-15

ROUTE SR 18

H.C. O'DONNELL

WEATHER SUNNY

COUNTY SENECA

R.C. HOMAN

TEMP. 61°F

TOWNSHIP SCIPIO

SECTION 16

T 2 N R 16 E

TYPE MONUMENT 5/8" IPIN


~~ON SURFACE~~ - BELOW 1"

LEFT - Q PAV'T - RIGHT ON

11.8' TO LT EDGE PAVEMENT


S.L.M. 1201+76.72

Grid: Northing: 531599.8591 Easting: 1825117.1773

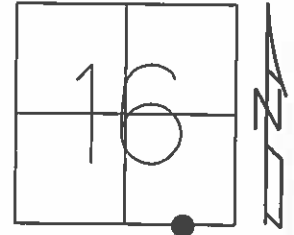

RECORD:
FD IPIN
GPS, RW15

SET MAG/WASHER
GPS, NEWREFA69
7-14-16, JFO

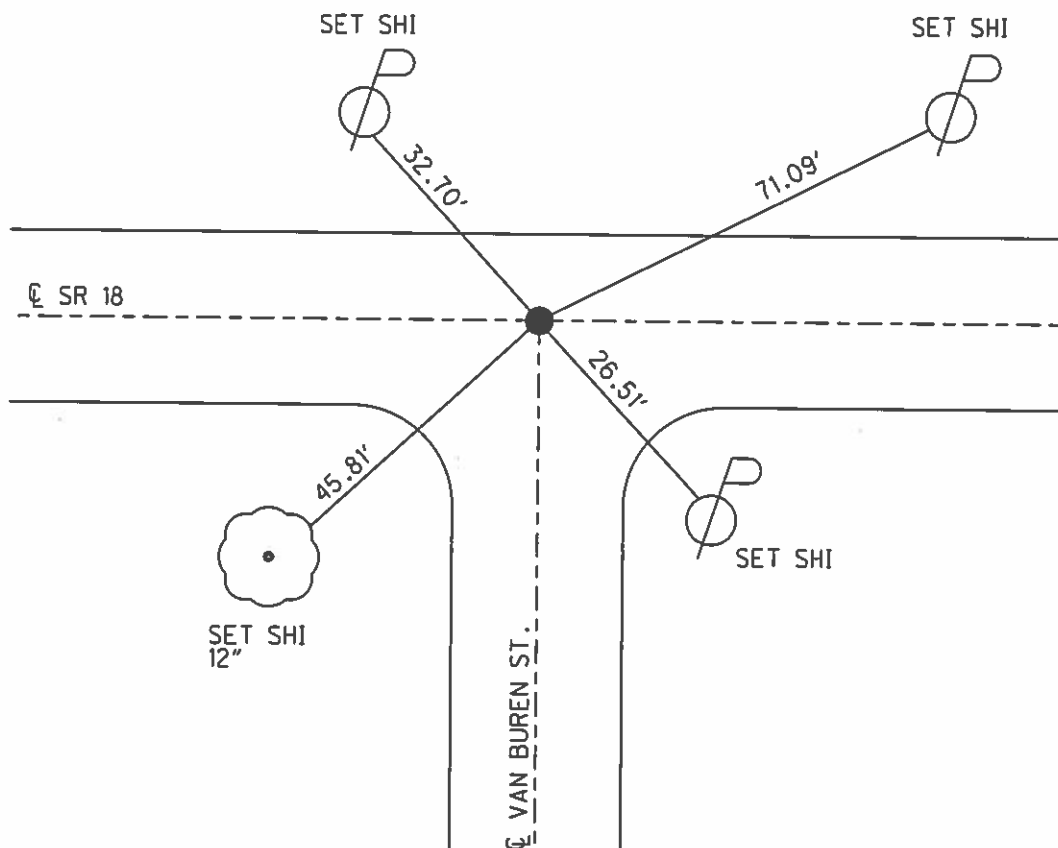

O.D.O.T. DISTRICT 2 SURVEY OFFICE (USE ONLY)

PERSONNEL

REFERENCE NO.

70

SHEET

13

OF 17

NOTES

RHOADES

DATE

7-8-15

ROUTE

SR 18

H.C.

O'DONNELL

WEATHER

SUNNY

COUNTY

SENECA

R.C.

HOMAN

TEMP.

61°F

TOWNSHIP

SCIPIO

SECTION

16

T 2 N R 16 E

TYPE MONUMENT

PK NAIL

~~ON SURFACE~~ - BELOW

3"

LEFT - $\odot$ PAV'T - ~~RIGHT~~


1'

11' TO LT EDGE PAVEMENT

S.L.M. 1206+27.84

Grid: Northing: 531607.094

Easting: 1825568.2442

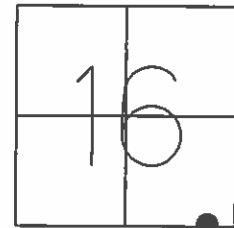

RECORD:

P.I. $\Delta=00^{\circ}47'$ RT. (OBS)

STA. 391+72.20

6-15-72

FD PK

3" BELOW


GPS, REF70

05-07-14, JLL, EBW

SET MAG/WASHER

GPS, NEWREF70


7-14-16, JFO

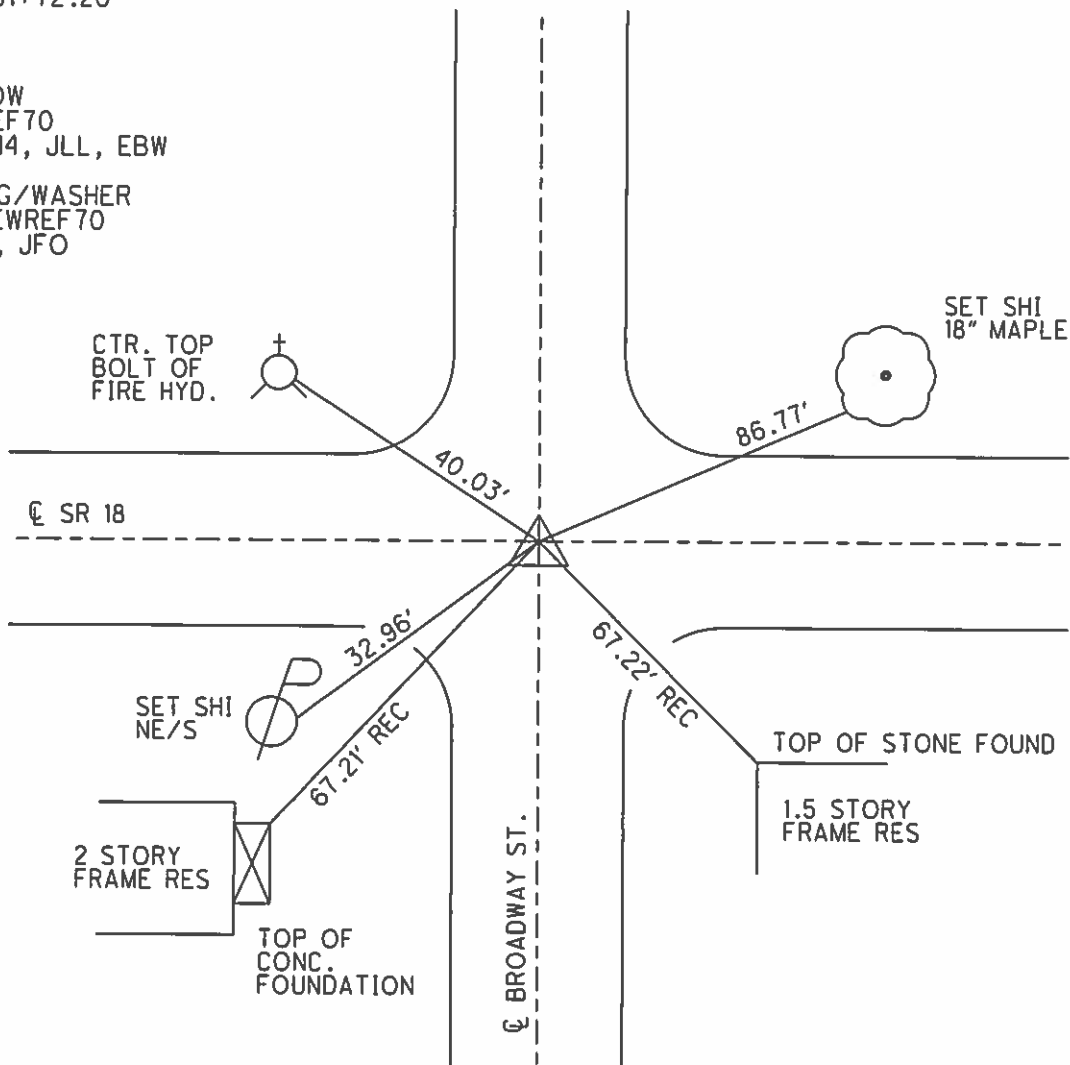

O.D.O.T. DISTRICT 2 SURVEY OFFICE (USE ONLY)


PERSONNEL	REFERENCE NO.	<u>71</u>	SHEET	<u>14</u>	OF	<u>17</u>
NOTES	RHOADES	DATE	<u>8/1/17</u>	ROUTE	<u>SR 18</u>	
H.C.	HOMAN	WEATHER	<u>SUNNY</u>	COUNTY	<u>SENECA</u>	
R.C.	CARSON	TEMP.	<u>70°</u>	TOWNSHIP	<u>SCIPIO</u>	
	POORE			SECTION	<u>16</u>	
				T <u>2</u> N	R <u>16</u> E	

TYPE MONUMENT MAG/WASHER
ON SURFACE - ~~BELOW~~ ON
LEFT - ℄ PAV'T - ~~RIGHT~~ 1.5'
12' TO LT EDGE PAVEMENT
S.L.M. 1211+58.04
Grid: Northing: 531607.876 Easting: 1826098.508

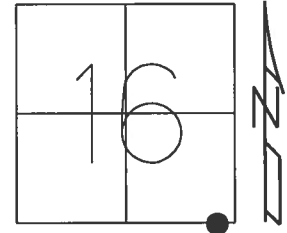

RECORD:
FD MINE SPIKE
3.5" DOWN ATOP
5/8" IPIN
6.5" DOWN
SET MAG/WASHER
8/18/04, MB
FD MAG/WASHER
REF71
5/7/14, EBW
FD MAG/WASHER
REF1
1/8/16, JFO
FD MAG/WASHER
REF29
2/5/16, JFO
SET MAG/WASHER
8/1/17, DCH

NOTE:
SR 162=REF 1
SR 67=REF 29

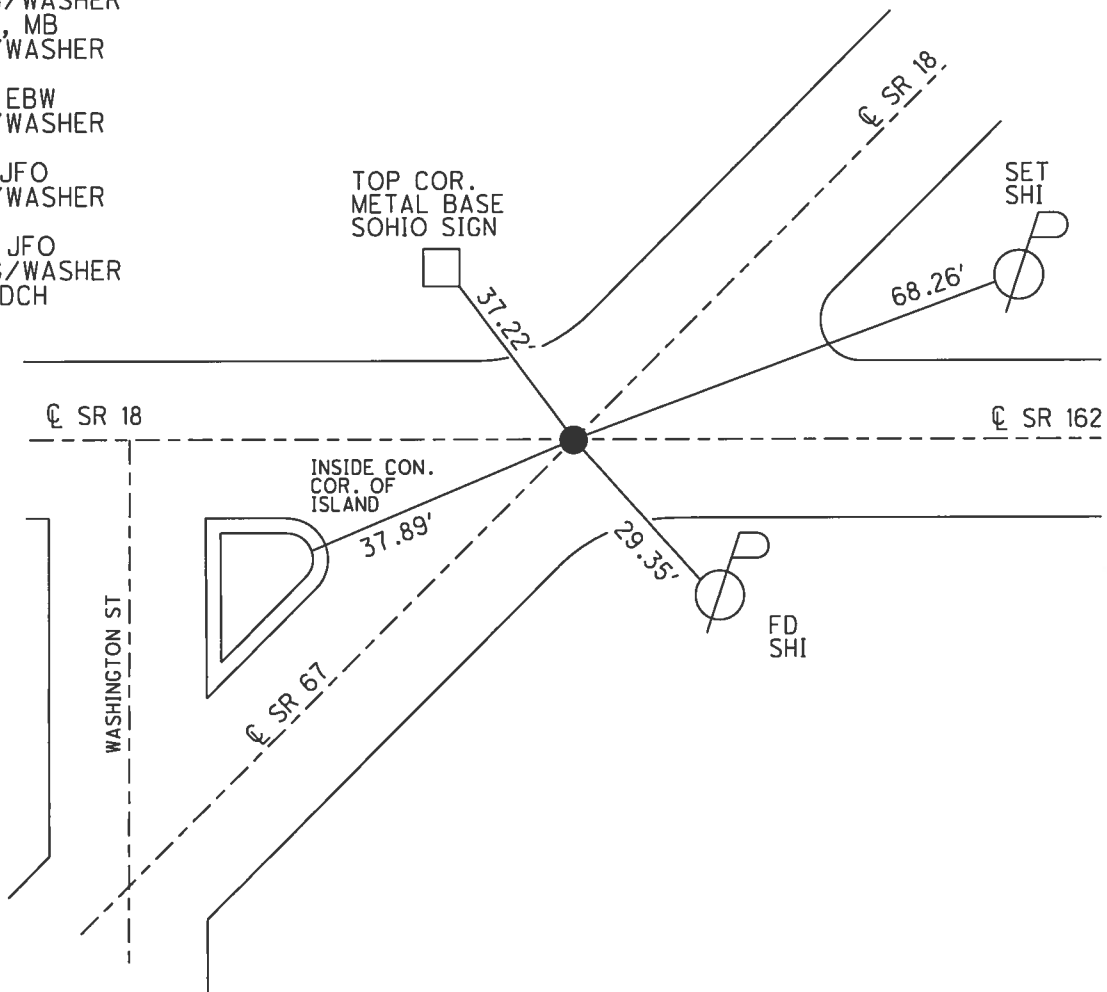

O.D.O.T. DISTRICT 2 SURVEY OFFICE (USE ONLY)

PERSONNEL

REFERENCE NO. 72

SHEET 1 OF 28

NOTES TRENKA

DATE 5-29-18

ROUTE SR 18

H.C. RHOADES

WEATHER SUNNY

COUNTY SENECA

R.C. TRENKA

TEMP. 85°

TOWNSHIP SCIPIO

SECTION 16

DWG BY JAMES PID 101281

T 2 N R 16 E

TYPE MONUMENT P.K./WASHER

~~ON SURFACE~~ - BELOW 1.5"

OFFSET Q PAVEMENT 0.5' ~~LT~~ : RT

10.5' TO RT EDGE PAVEMENT


STATION: 1216+15.90

HORIZ.DATUM: NAD83 2011

GEOID: NAVD88 2012A


GRID: NORTHING: 532175.120

EASTING: 1826480.835

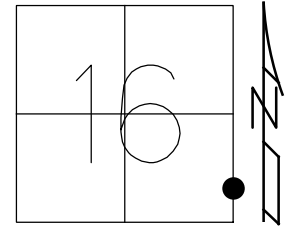

RECORD: P.I.
 $\Delta=00^{\circ}13'$ RT
STA. 403+86.66
6-16-1971
SET P.K./WASHER
8-27-1993, RCC
FD P.K./WASHER
1.5" DOWN
REF72
5-08-14, EBW
FD P.K./WASHER
1 1/2" DOWN
REF72
2/27/17, JFO
5-24-18, JMR
SET MAG/WASHER
1-8-19, JFO

NOTE: SR 19 REF 56

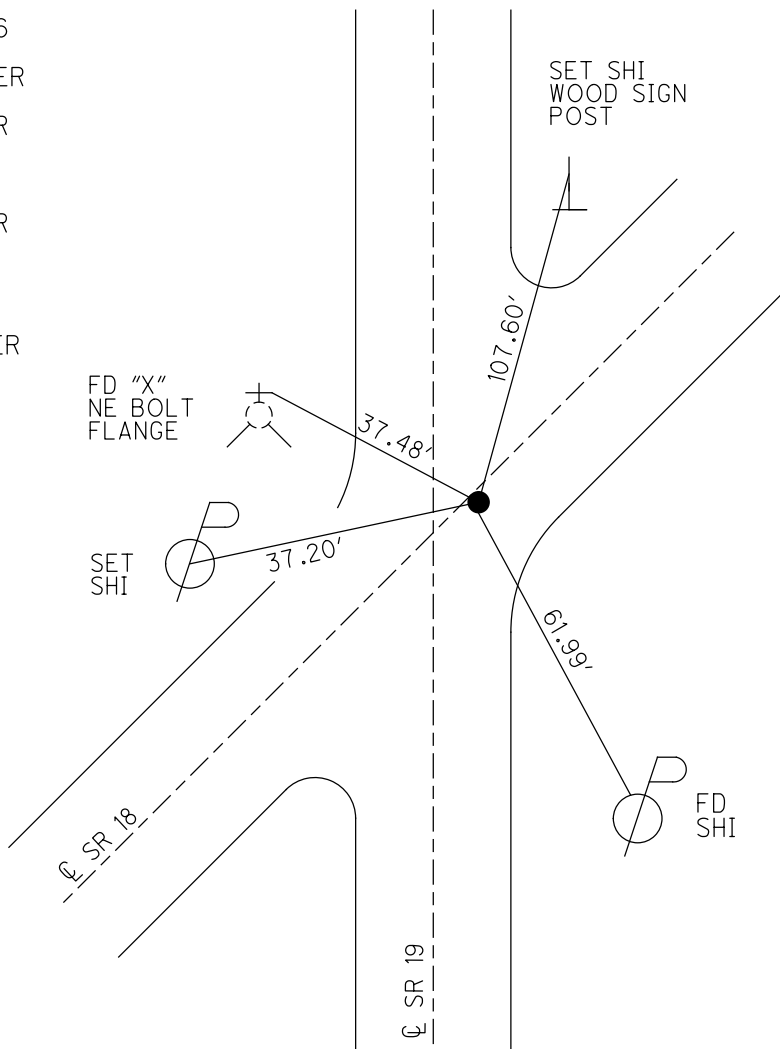

O.D.O.T. DISTRICT 2 SURVEY OFFICE (USE ONLY)

PERSONNEL

REFERENCE NO. 73

SHEET 2 OF 28

NOTES TRENKA

DATE 5-29-18

ROUTE SR 18

H.C. RHOADES

WEATHER SUNNY

COUNTY SENECA

R.C. TRENKA

TEMP. 85°

TOWNSHIP SCIPIO

DWG BY JAMES PID 101281

SECTION 15

T 2 N R 16 E

TYPE MONUMENT MAG/WASHER

ON SURFACE - ~~BELOW~~ ON

OFFSET CL PAVEMENT 0.4' ~~LT~~ : RT

9.8' TO RT EDGE PAVEMENT


STATION: 1241+01.01

HORZ.DATUM: NAD83 2011


GEOID: NAVD88 2012A

GRID: NORTHING: 534236.623

EASTING: 1827868.631

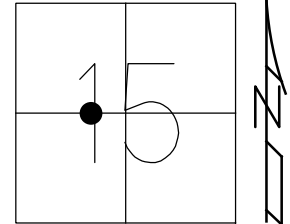

RECORD: P.O.T.
 $\Delta = 33^{\circ}56'56''$
STA 24+84.70
FD R.R.SPIKE
7/15/85, CL
7-9-02
12-05-02, DCH
DNF
5-22-14, EBW
SET MAG/WASHER
REF73
6-11-14, JLL
FD MAG/WASHER
REF73
2-27-17, JFO
5-29-18, JMR
SET MAG/WASHER
1-8-19, JFO

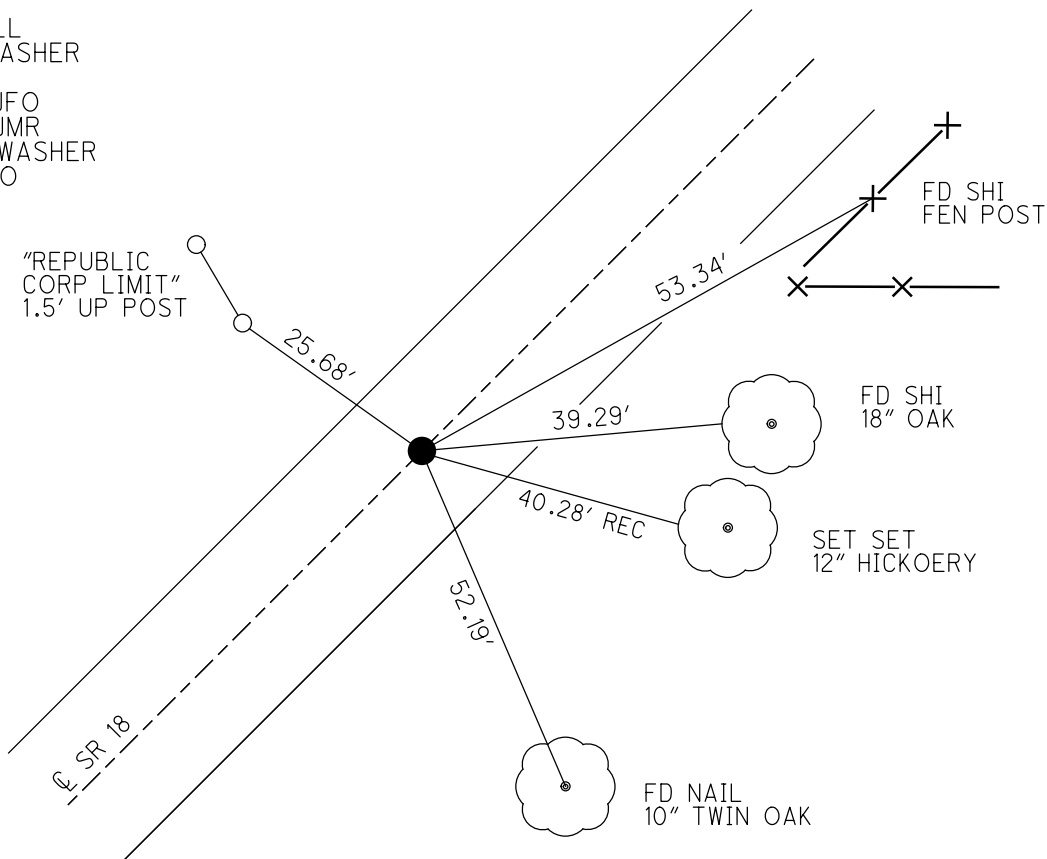

O.D.O.T. DISTRICT 2 SURVEY OFFICE (USE ONLY)

PERSONNEL

REFERENCE NO. 74

SHEET 3 OF 28

NOTES TRENKA

DATE 5-29-18

ROUTE SR 18

H.C. RHOADES

WEATHER SUNNY

COUNTY SENECA

R.C. TRENKA

TEMP. 85°

TOWNSHIP SCIPIO

SECTION 15

DWG BY JAMES PID 101281

T 2 N R 16 E

TYPE MONUMENT P.K./WASHER

ON SURFACE - ~~BELOW~~ ON

OFFSET 0.2' ~~LT~~ : RT

10.3' TO LT EDGE PAVEMENT


STATION: 1246+97.10

HORIZ.DATUM: NAD83 2011


GEOID: NAVD88 2012A

GRID: NORTHING: 534731.062

EASTING: 1828201.582

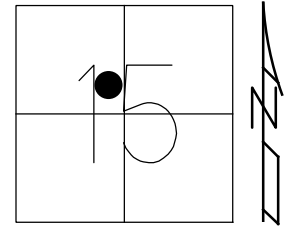

RECORD: P.I.
 $\Delta = 00^\circ 29' RT$
STA 30+83.56
FD P.K./WASHER
7-9-02
12-05-02, DCH
FD P.K./WASHER
REF74
5-29-14, EBW
REF74
2-27-17, JFO
SET MAG/WASHER
1-8-19, JFO

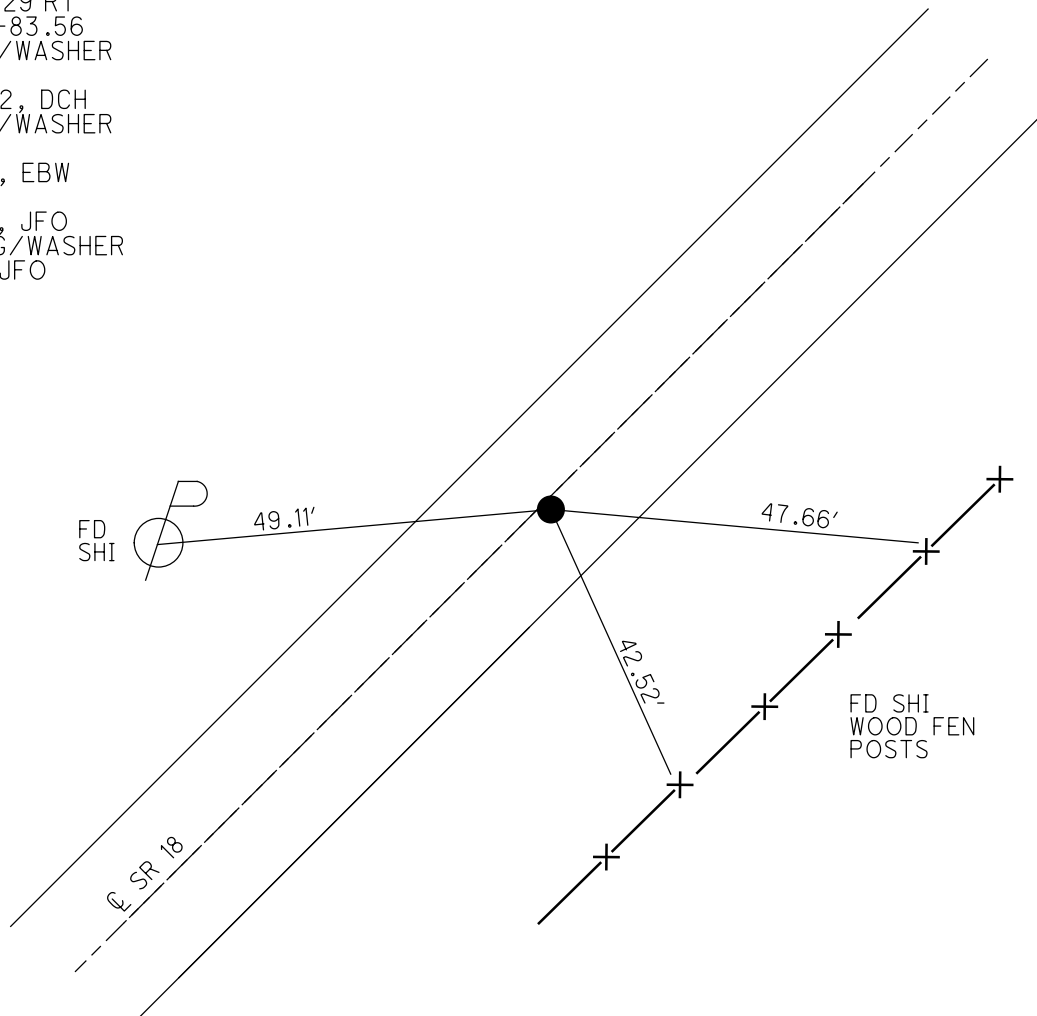

O.D.O.T. DISTRICT 2 SURVEY OFFICE (USE ONLY)

PERSONNEL

REFERENCE NO. 75

SHEET 4 OF 28

NOTES TRENKA
H.C. RHOADES
R.C. TRENKA

DATE 5-29-18
WEATHER SUNNY
TEMP. 85°

ROUTE SR 18
COUNTY SENECA
TOWNSHIP SCIPIO
SECTION 15
T 2 N R 16 E

DWG BY JAMES PID 101281

TYPE MONUMENT P.K.NAIL

ON SURFACE - ~~BELOW~~ ON

OFFSET CL PAVEMENT ON LT : RT

- TO - EDGE PAVEMENT


STATION: 1273+21.64

HORZ.DATUM: NAD83 2011

GEOID: NAVD88 2012A


GRID: NORTHING: 536895.217

EASTING: 1829686.309

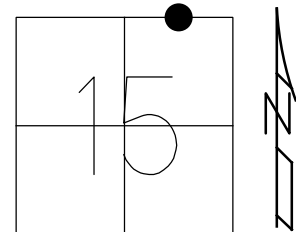

RECORD: P.I.
 $\Delta = 0^\circ 11' \text{ LT}$
STA. 57+07.53 REC
FD BOAT SPIKE/WASHER
10-15-85, BC
FD P.K./WASHER
7-9-02, DCH
REF75
FD P.K.NAIL
REF75
2-27-17, JFO
SET MAG/WASHER
1-8-19, JFO
NEWREF75
1-11-19, JFO

DIST. 75-75A=0.28'

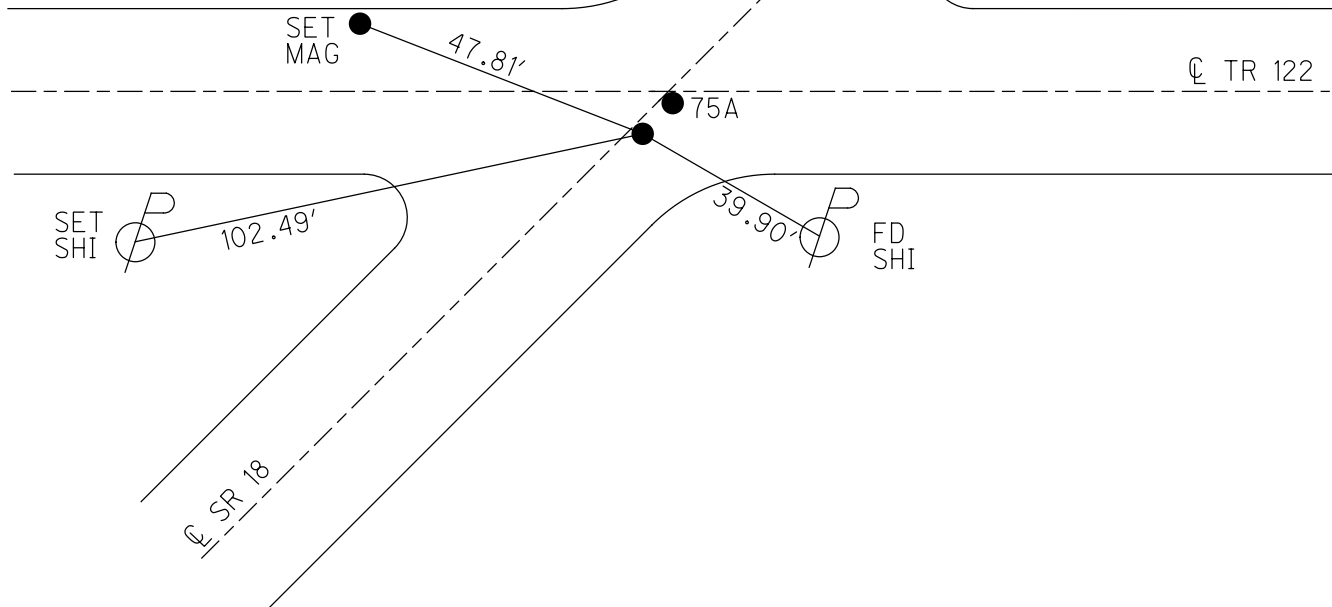

O.D.O.T. DISTRICT 2 SURVEY OFFICE (USE ONLY)

PERSONNEL

REFERENCE NO. 75 A

SHEET 5 OF 28

NOTES TRENKA

DATE 5-29-18

ROUTE SR 18

H.C. RHOADES

WEATHER SUNNY

COUNTY SENECA

R.C. TRENKA

TEMP. 85°

TOWNSHIP SCIPIO

SECTION 15

DWG BY JAMES

PID 101281

T 2 N R 16 E

TYPE MONUMENT P.K./WASHER

ON SURFACE - ~~BELOW~~ ON

OFFSET 0.7' LT : RT

- TO - EDGE PAVEMENT


STATION: 1273+21.36

HORIZ.DATUM: NAD83 2011


GEOID: NAVD88 2012A

GRID: NORTHING: 536895.434

EASTING: 1829686.467

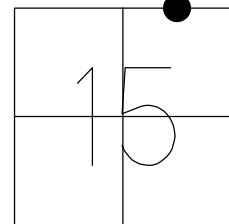

RECORD: P.I.
 $\Delta = 0^\circ 11' 40''$ LT
STA. 57+08.19 MEA
FD BOAT SPIKE/WASHER
10-15-85, BC
FD P.K./WASHER
7-9-02, DH
REFA75
2-27-17, JFO
SET MAG/WASHER
1-8-19, JFO
NEWREFA75
1-11-19, JFO

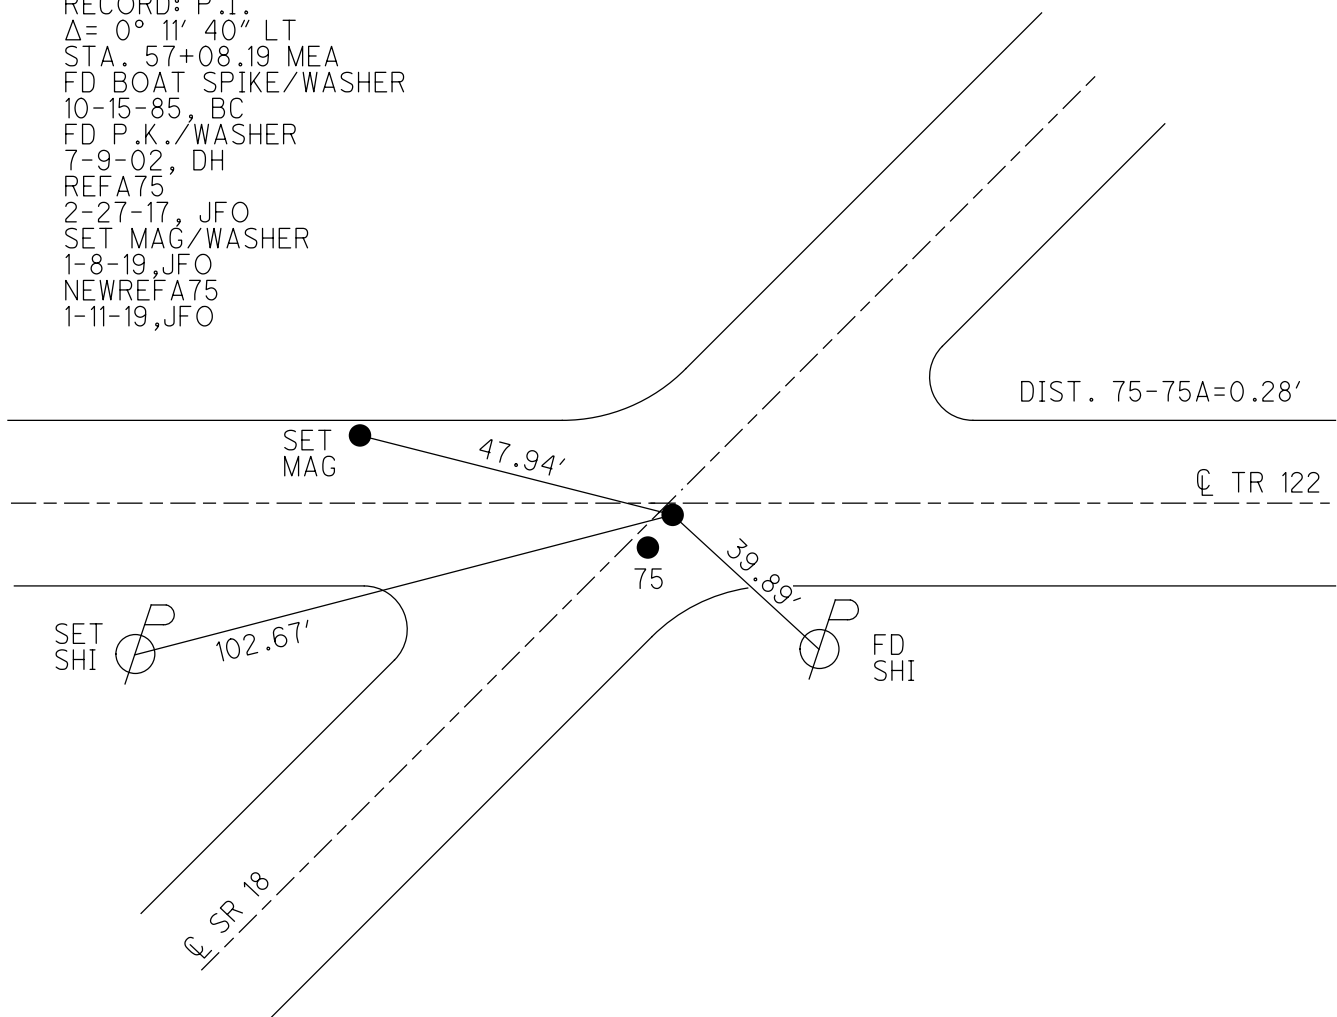

O.D.O.T. DISTRICT 2 SURVEY OFFICE (USE ONLY)

PERSONNEL

REFERENCE NO. 76

SHEET 6 OF 28

NOTES TRENKA

DATE 5-29-18

ROUTE SR 18

H.C. RHOADES

WEATHER SUNNY

COUNTY SENECA

R.C. TRENKA

TEMP. 85°

TOWNSHIP SCIPIO

DWG BY JAMES

PID 101281

SECTION 10

T 2 N R 16 E

TYPE MONUMENT P.K./WASHER

ON SURFACE - ~~BELOW~~ ON

OFFSET CL PAVEMENT 0.8' LT : ~~RT~~

9.8' TO LT EDGE PAVEMENT


STATION: 1289+15.57

HORIZ.DATUM: NAD83 2011


GEOID: NAVD88 2012A

GRID: NORTHING: 538212.637

EASTING: 1830583.616

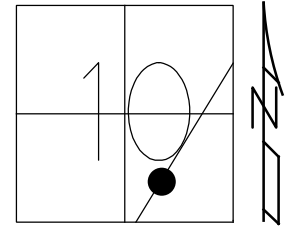

RECORD: P.I.
 $\Delta = 0^\circ 29' \text{ RT}$
STA. 73+02.28
FD P.K./WASHER
7-15-85, CL
9-26-85, SWH
7-9-02, DH
FD P.K./WASHER
REF76
2-27-17, JFO
5-29-18, JMR
SET MAG/WASHER
1-8-19, JFO

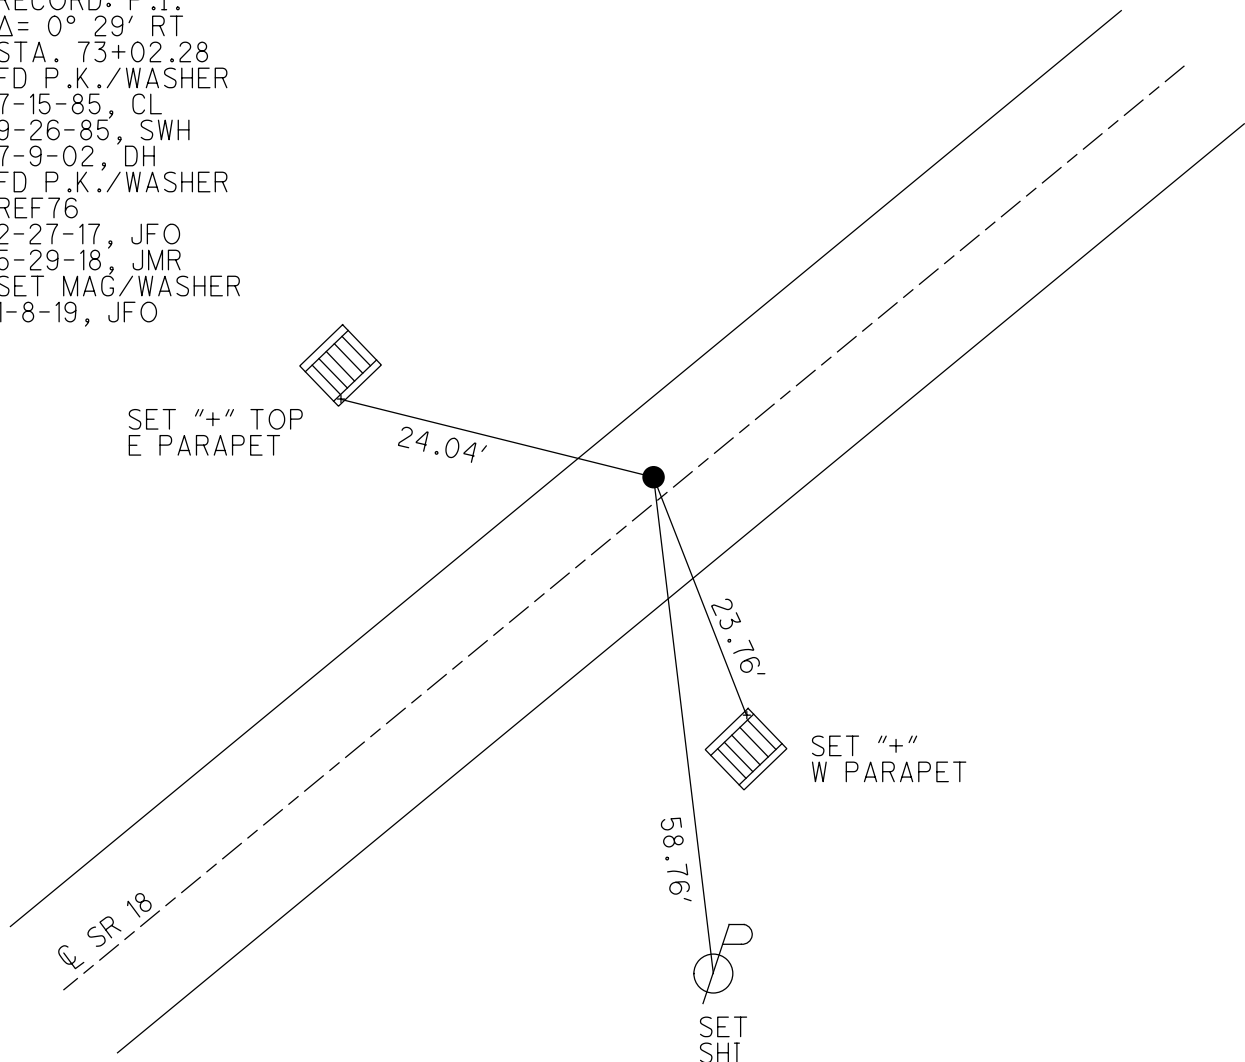

O.D.O.T. DISTRICT 2 SURVEY OFFICE (USE ONLY)

PERSONNEL

REFERENCE NO. 76 A

SHEET 7 OF 28

NOTES TRENKA

DATE 5-29-18

ROUTE SR 18

H.C. RHOADES

WEATHER SUNNY

COUNTY SENECA

R.C. TRENKA

TEMP. 85°

TOWNSHIP SCIPIO

DWG BY JAMES

PID 101281

SECTION 10

T 2 N R 16 E

TYPE MONUMENT 2" ALUM DISK

~~ON SURFACE~~ - BELOW 0.5"

OFFSET CL PAVEMENT ON LT : RT

10.8 TO LT EDGE PAVEMENT


STATION: 1305+28.70

HORIZ.DATUM: NAD83 2011


GEOID: NAVD88 2012A

GRID: NORTHING: 539538.212

EASTING: 1831502.871

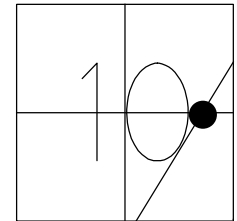

RECORD:
ORIGIN UNKNOWN
2-13-84
FD P.K./WASHER
7-15-85, CL
SET P.K./WASHER
9-26-85, SWH
FD P.K./WASHER
7-9-02, DCH
12/05/02
FD 2" ALUM DISK
1/2" DOWN
REFA76
2-27-17, JFO
5-29-18, JMR
SET MAG/WASHER
1-8-19, JFO

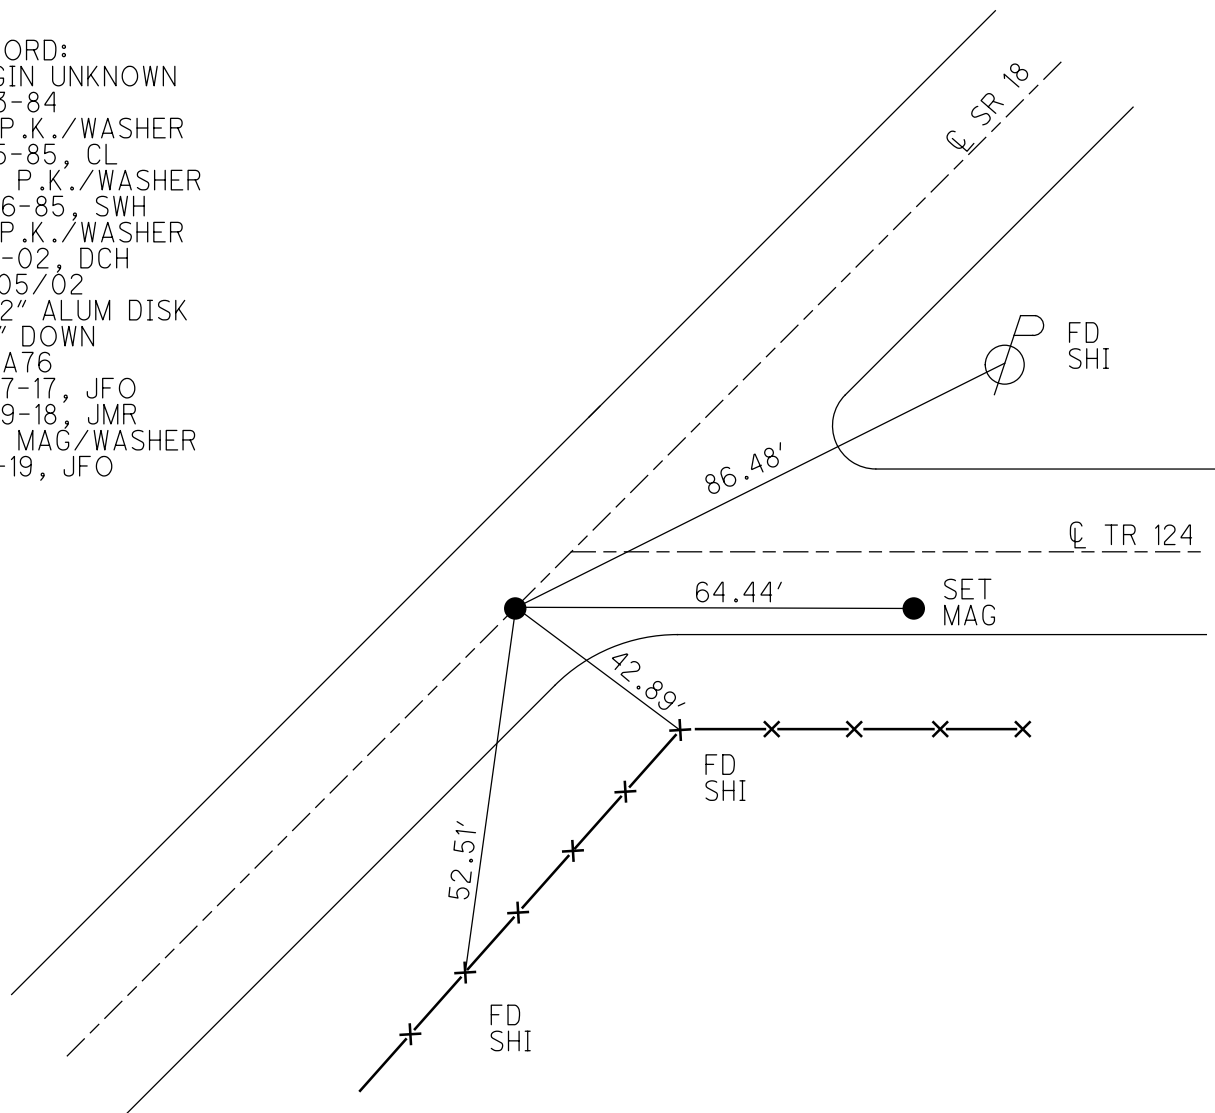

O.D.O.T. DISTRICT 2 SURVEY OFFICE (USE ONLY)

PERSONNEL

REFERENCE NO. 77

SHEET 8 OF 28

NOTES TRENKA
H.C. RHOADES
R.C. TRENKA

DATE 5-29-18
WEATHER SUNNY
TEMP. 80°

ROUTE SR 18
COUNTY SENECA
TOWNSHIP SCIPIO
SECTION 10
T 2 N R 16 E

DWG BY JAMES PID 101281

TYPE MONUMENT P.K./WASHER

ON SURFACE - ~~BELOW~~ ON

OFFSET CL PAVEMENT ON LT : RT

9.6' TO LT EDGE PAVEMENT



STATION: 1307+23.40

HORZ.DATUM: NAD83 2011

GEOID: NAVD88 2012A

GRID: NORTHING: 539698.579

EASTING: 1831613.294

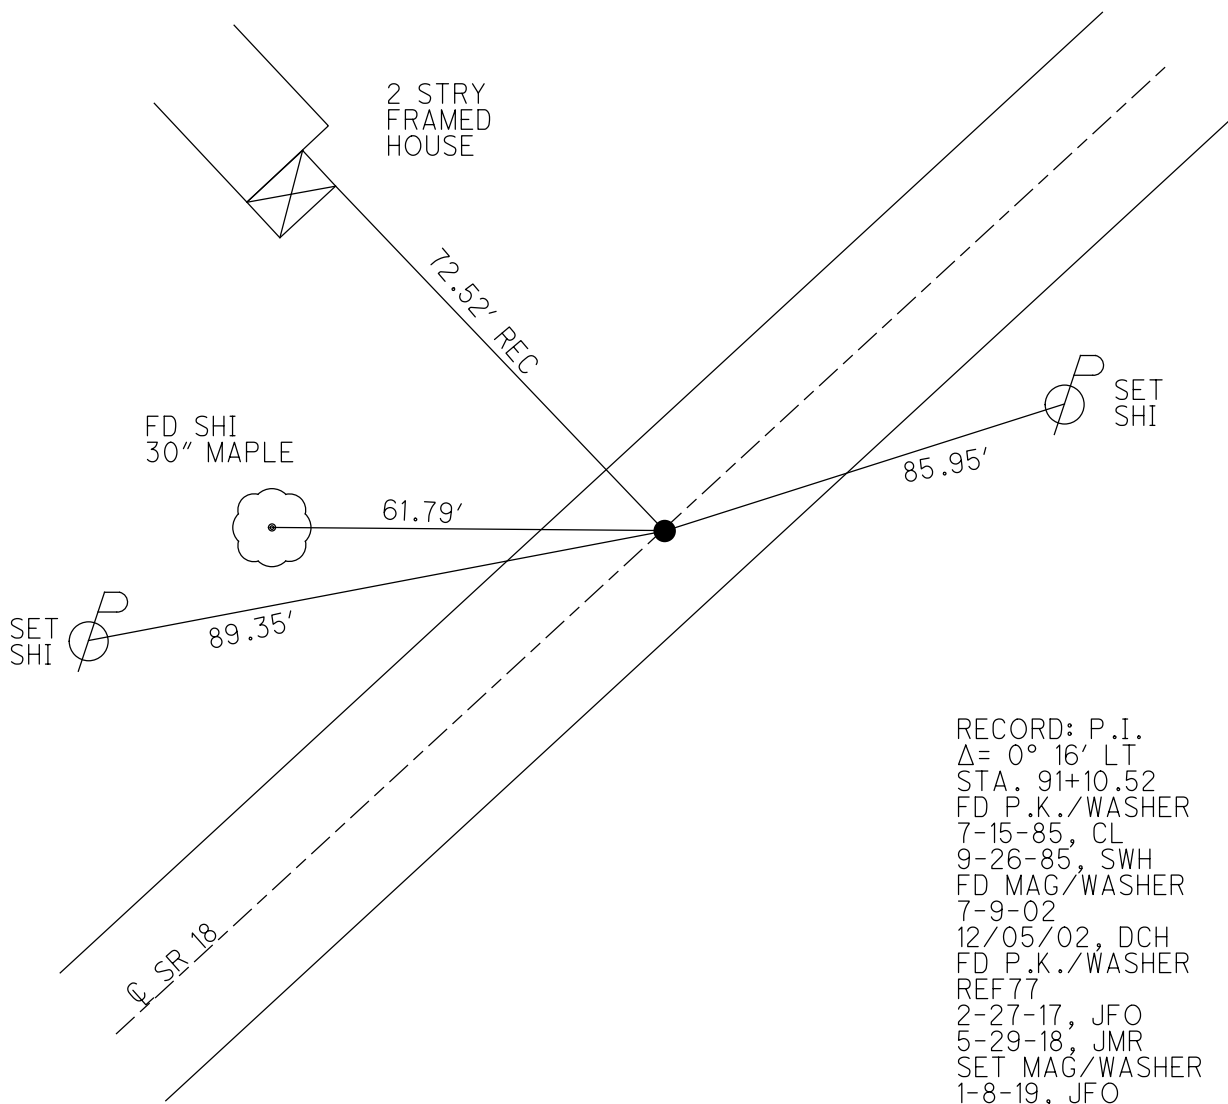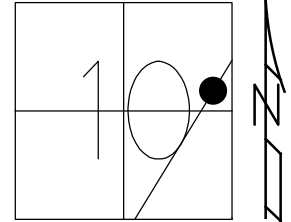

RECORD: P.I.
 $\Delta = 0^\circ 16' \text{ LT}$
STA. 91+10.52
FD P.K./WASHER
7-15-85, CL
9-26-85, SWH
FD MAG/WASHER
7-9-02
12/05/02, DCH
FD P.K./WASHER
REF77
2-27-17, JFO
5-29-18, JMR
SET MAG/WASHER
1-8-19, JFO

O.D.O.T. DISTRICT 2 SURVEY OFFICE (USE ONLY)

PERSONNEL

REFERENCE NO. 78

SHEET 9 OF 28

NOTES TRENKA

DATE 5-29-18

ROUTE SR 18

H.C. RHOADES

WEATHER SUNNY

COUNTY SENECA

R.C. TRENKA

TEMP. 80°

TOWNSHIP SCIPIO

SECTION 10

DWG BY JAMES

PID 101281

T 2 N R 16 E

TYPE MONUMENT P.K./WASHER

ON SURFACE - ~~BELOW~~ ON

OFFSET Q PAVEMENT ON LT : RT

10.0' TO RT EDGE PAVEMENT


STATION: 1328+64.27

HORZ.DATUM: NAD83 2011


GEOID: NAVD88 2012A

GRID: NORTHING: 541464.307

EASTING: 1832823.885

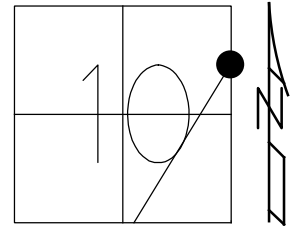

RECORD: P.I.
 $\Delta = 0^\circ 12' \text{ LT}$
STA 113+05.20
FD P.K./WASHER
7-15-85, CL
9-26-85, SWH
FD P.K./WASHER
7-31-02, MB
FD P.K.NAIL
REF78
2-27-17, JFO
5-29-18, JMR
SET MAG/WASHER
1-8-19, JFO

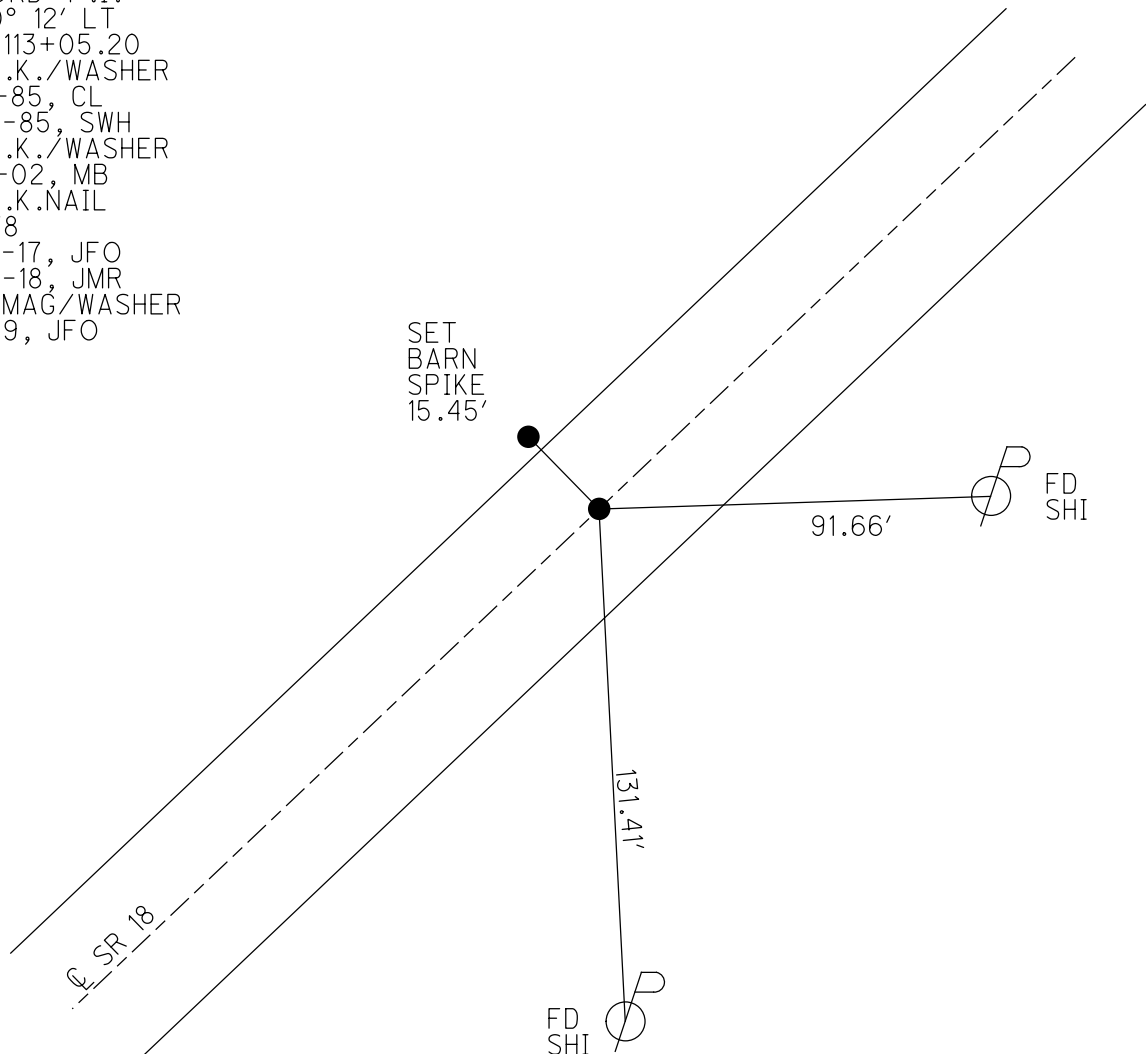

O.D.O.T. DISTRICT 2 SURVEY OFFICE (USE ONLY)

PERSONNEL

REFERENCE NO. 79

SHEET 10 OF 28

NOTES TRENKA

DATE 5-29-18

ROUTE SR 18

H.C. RHOADES

WEATHER SUNNY

COUNTY SENECA

R.C. TRENKA

TEMP. 80°

TOWNSHIP SCIPIO

DWG BY JAMES PID 101281

T 2 N R 16 F

TYPE MONUMENT P.K./WASHER

ON SURFACE - ~~BELOW~~ ON _____

OFFSET C PAVEMENT 0.2' ~~LT~~ : RT


10' TO RT EDGE PAVEMENT

STATION: 1352+52.85

HORZ.DATUM: NAD83 2011

GEOID: NAVD88 2012A

GRID: NORTHING: 543439.441

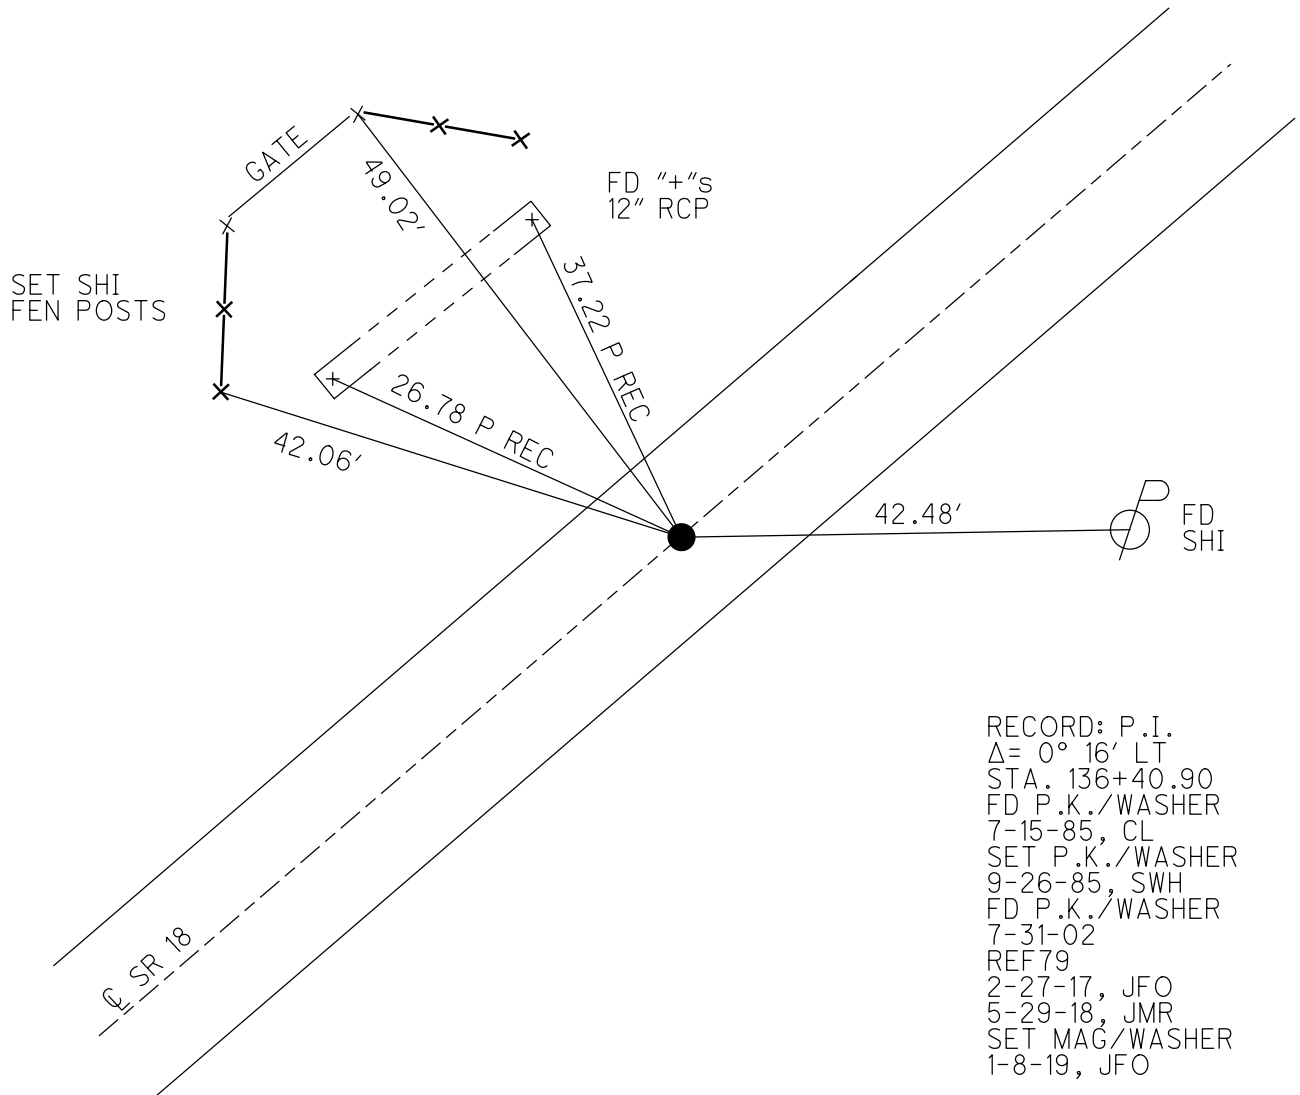EASTING: 1834167.070

RECORD: P.I.
 $\Delta = 0^{\circ} 16' \text{ LT}$
 STA. 136+40.90
 FD P.K./WASHER
 7-15-85, CL
 SET P.K./WASHER
 9-26-85, SWH
 FD P.K./WASHER
 7-31-02
 REF 79
 2-27-17, JFO
 5-29-18, JMR
 SET MAG/WASHER
 1-8-19, JFO

O.D.O.T. DISTRICT 2 SURVEY OFFICE (USE ONLY)

PERSONNEL

REFERENCE NO. 80

SHEET 11 OF 28

NOTES TRENKA

DATE 5-29-18

ROUTE SR 18

H.C. RHOADES

WEATHER SUNNY

COUNTY SENECA

R.C. TRENKA

TEMP. 80°

TOWNSHIP SCIPIO

SECTION 2

DWG BY JAMES PID 101281

T 2 N R 16 E

TYPE MONUMENT P.K./WASHER

~~ON SURFACE~~ - BELOW 3"

OFFSET Q PAVEMENT ON LT : RT

- TO - EDGE PAVEMENT


STATION: 1369+43.14

HORIZ.DATUM: NAD83 2011


GEOID: NAVD88 2012A

GRID: NORTHING: 544841.816

EASTING: 1835110.693

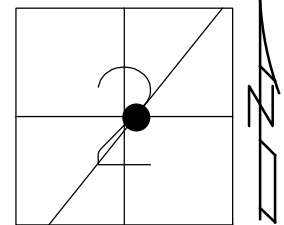

RECORD: P.I.
 $\Delta = 0^\circ 34' \text{ RT}$
STA. 153+31.08
FD SMALL SPIKE
7-15-85, CL
SET P.K./WASHER
9-26-85, SWH
7-31-02, MB
FD P.K./WASHER
3" DOWN
REF80
2-27-17, JFO
5-29-18, JMR
SET MAG/WASHER
1-10-19, JFO

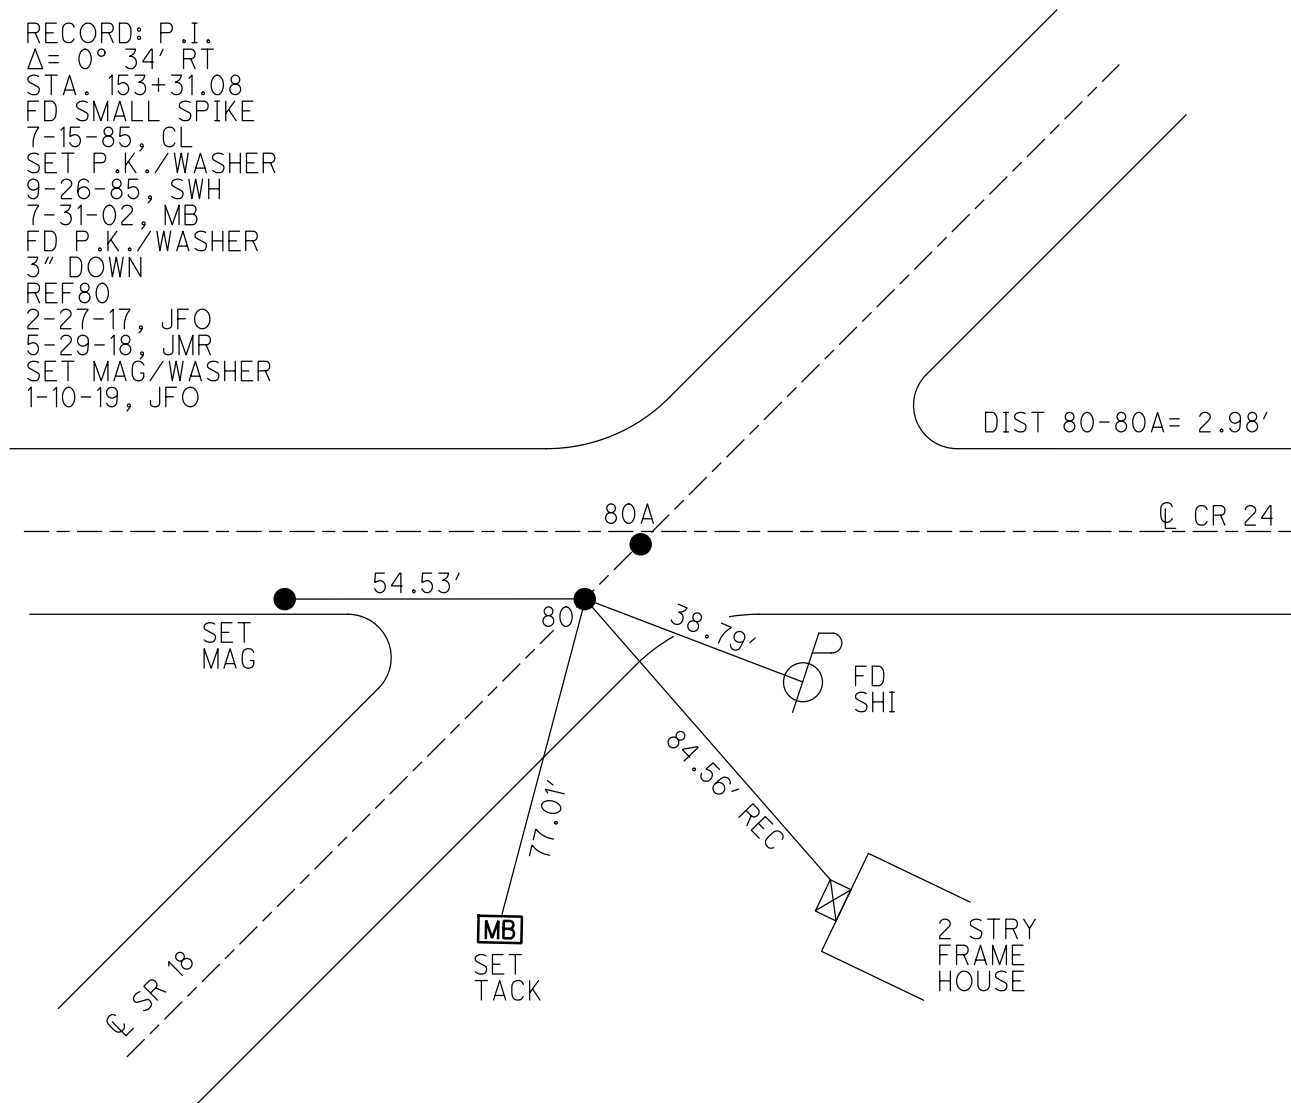

O.D.O.T. DISTRICT 2 SURVEY OFFICE (USE ONLY)

PERSONNEL

REFERENCE NO. 80 A

SHEET 12 OF 28

NOTES TRENKA

DATE 5-29-18

ROUTE SR 18

H.C. RHOADES

WEATHER SUNNY

COUNTY SENECA

R.C. TRENKA

TEMP. 80°

TOWNSHIP SCIPIO

SECTION 2

T 2 N R 16 E

DWG BY JAMES

PID 101281

TYPE MONUMENT P.K./WASHER

ON SURFACE - ~~BELOW~~ ON

OFFSET Q PAVEMENT ON LT : RT

- TO - EDGE PAVEMENT


STATION: 1369+46.14

HORZ.DATUM: NAD83 2011


GEOID: NAVD88 2012A

GRID: NORTHING: 544844.367

EASTING: 1835112.280

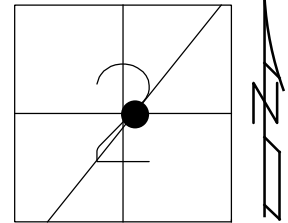

RECORD:
ORIGIN UNKNOWN
FD P.K.NAIL
7-15-85, CL
SET P.K./WASHER
9-26-85, SWH
FD P.K./WASHER
7-31-02, MB
FD P.K./WASHER
REFA80
2-27-17, JFO
5-29-18, JMR
SET MAG/WASHER
1-10-19, JFO

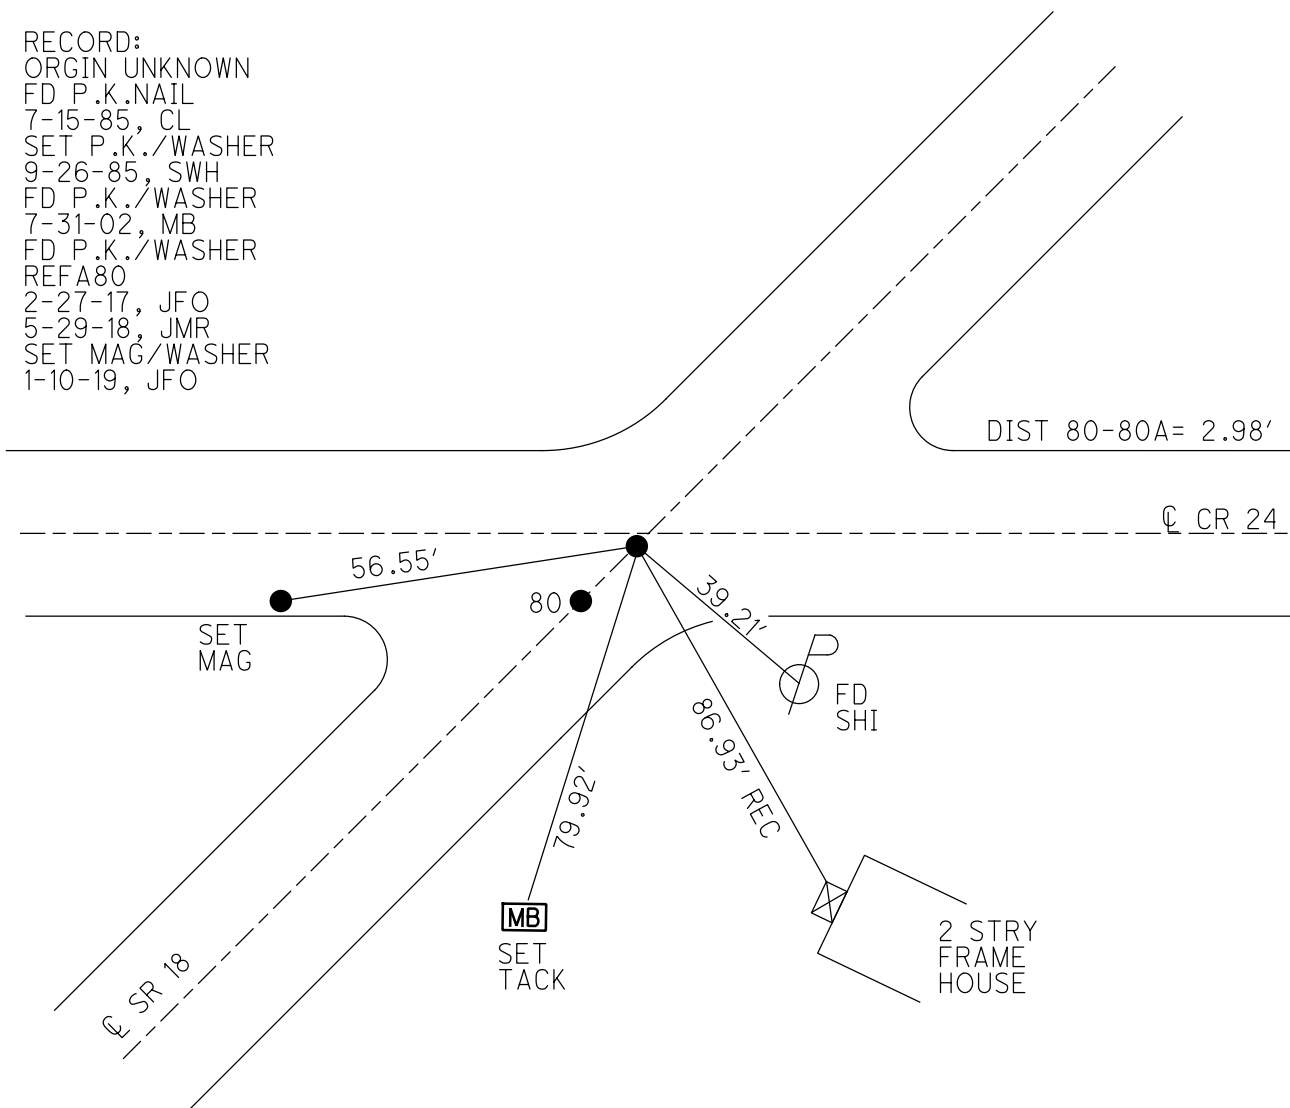

O.D.O.T. DISTRICT 2 SURVEY OFFICE (USE ONLY)

PERSONNEL

REFERENCE NO. 81

SHEET 13 OF 28

NOTES TRENKA

DATE 5-29-18

ROUTE SR 18

H.C. RHOADES

WEATHER SUNNY

COUNTY SENECA

R.C. TRENKA

TEMP. 80°

TOWNSHIP SCIPIO

SECTION 2

DWG BY JAMES PID 101281

T 2 N R 16 E

TYPE MONUMENT P.K./WASHER

~~ON SURFACE~~ - BELOW 3"

OFFSET CL PAVEMENT 0.6' ~~LT~~ : RT

9.5' TO RT EDGE PAVEMENT



STATION: 1381+50.64

HORIZ.DATUM: NAD83 2011

GEOID: NAVD88 2012A

GRID: NORTHING: 545837.450

EASTING: 1835793.888

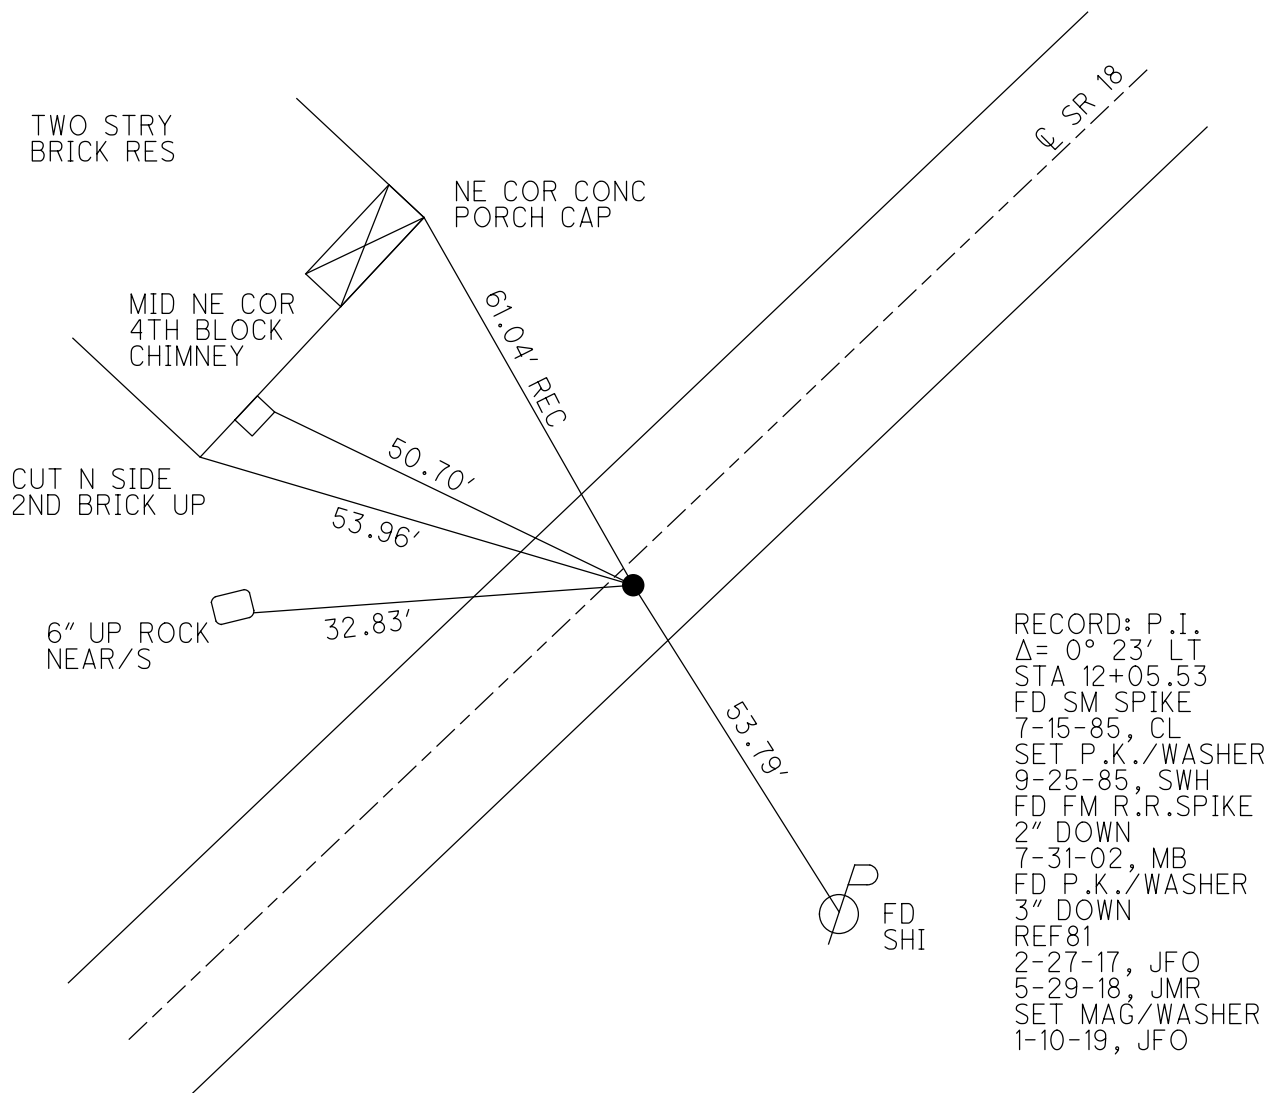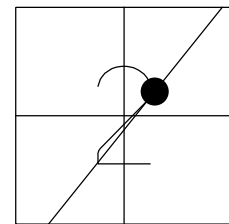

O.D.O.T. DISTRICT 2 SURVEY OFFICE (USE ONLY)

PERSONNEL

REFERENCE NO. 81 A

SHEET 14 OF 28

NOTES RHOADES

DATE 5-25-18

ROUTE SR 18

H.C. O'DONNELL

WEATHER SUNNY

COUNTY SENECA

R.C. HAGEMEYER

TEMP. 78°

TOWNSHIP SCIPIO

TRENKA

SECTION 2

DWG BY JAMES

PID 101281

T 2 N R 16 E

TYPE MONUMENT MAG/WASHER

ON SURFACE - ~~BELOW~~ ON

OFFSET CL PAVEMENT 0.2' LT : RT

- TO - EDGE PAVEMENT


STATION: 1404+00.8

HORIZ.DATUM: NAD83 2011

GEOID: NAVD88 2012A

GRID: NORTHING: 547700.388

EASTING: 1837056.008

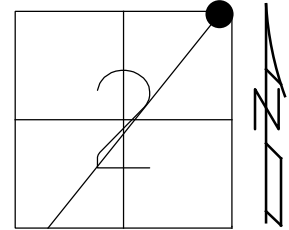

RECORD:
ORIGIN UNKNOWN
FD P.K.NAIL
7-15-85, CL
SET P.K./WASHER
9-25-85, SWH
FD MAG NAIL
REFA81
2-27-17, JFO
5-25-18, JFO
SET MAG/WASHER
1-10-19, JFO

1' UP NEAR FACE
GAS LINE VENT

36.83'

CL SR 18

CL CR 38

66.50'

SET
SHI

76.17'

SET SHI
40" MAPLE

O.D.O.T. DISTRICT 2 SURVEY OFFICE (USE ONLY)

PERSONNEL

REFERENCE NO. 82

SHEET 15 OF 28

NOTES RHOADES

DATE 5-29-18

ROUTE SR 18

H.C. O'DONNELL

WEATHER SUNNY

COUNTY SENECA

R.C. HAGEMEYER

TEMP. 80°

TOWNSHIP ADAMS

TRENKA

SECTION 36

DWG BY JAMES

PID 101281

T 2 N R 16 E

TYPE MONUMENT P.K./WASHER

~~ON SURFACE~~ - BELOW 3"

OFFSET CL PAVEMENT 0.3' ~~LT~~ : RT

9.5' TO RT EDGE PAVEMENT


STATION: 1411+82.10

HORZ.DATUM: NAD83 2011


GEOID: NAVD88 2012A

GRID: NORTHING: 548347.013

EASTING: 1837494.435

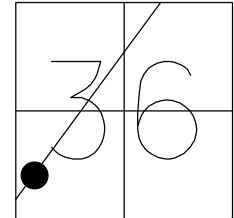

RECORD: P.I.
Δ= 0° 25' RT
STA 42+39
FD P.K./WASHER
7-15-85, CL
SET P.K./WASHER
9-25-85 SWH
FD P.K./WASHER
7-31-02, MB
FD P.K./WASHER
3" DOWN
REF82
2-27-17, JFO
5-25-18, JFO
SET MAG/WASHER
1-10-19, JFO

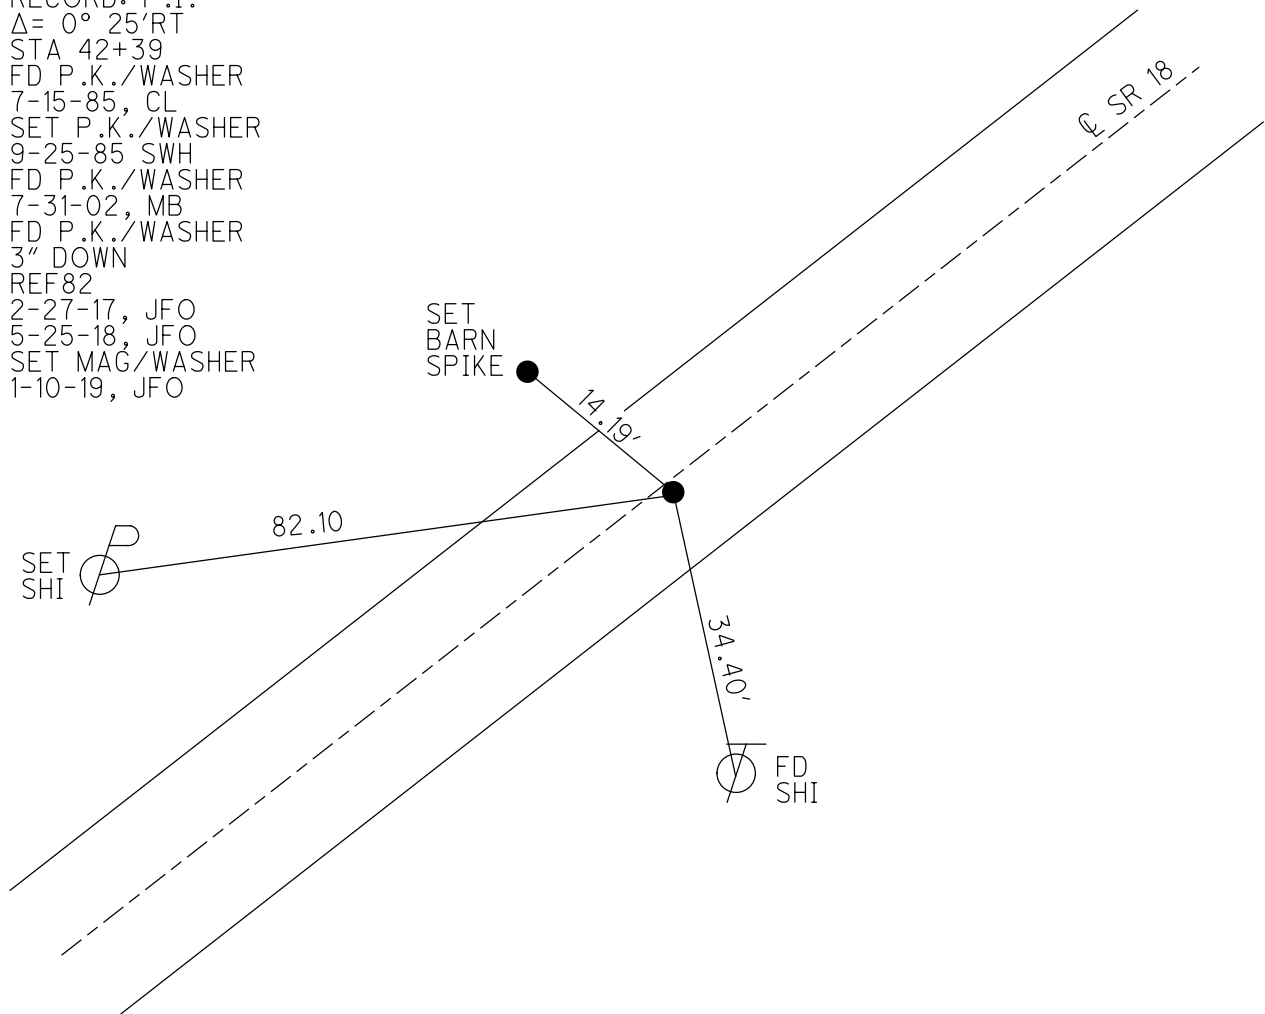

O.D.O.T. DISTRICT 2 SURVEY OFFICE (USE ONLY)

PERSONNEL

REFERENCE NO. 83

SHEET 16 OF 28

NOTES RHOADES

DATE 5-25-18

ROUTE SR 18

H.C. O'DONNELL

WEATHER SUNNY

COUNTY SENECA

R.C. HAGEMeyer

TEMP. 78°

TOWNSHIP ADAMS

TRENKA

SECTION 36

DWG BY JAMES

PID 101281

T 3 N R 16 E

TYPE MONUMENT P.K./WASHER

~~ON SURFACE~~ - BELOW 3"

OFFSET Q PAVEMENT ON LT : RT

9.2' TO LT EDGE PAVEMENT



STATION: 1421+49.43

HORZ.DATUM: NAD83 2011

GEOID: NAVD88 2012A

GRID: NORTHING: 549144.542

EASTING: 1838041.865

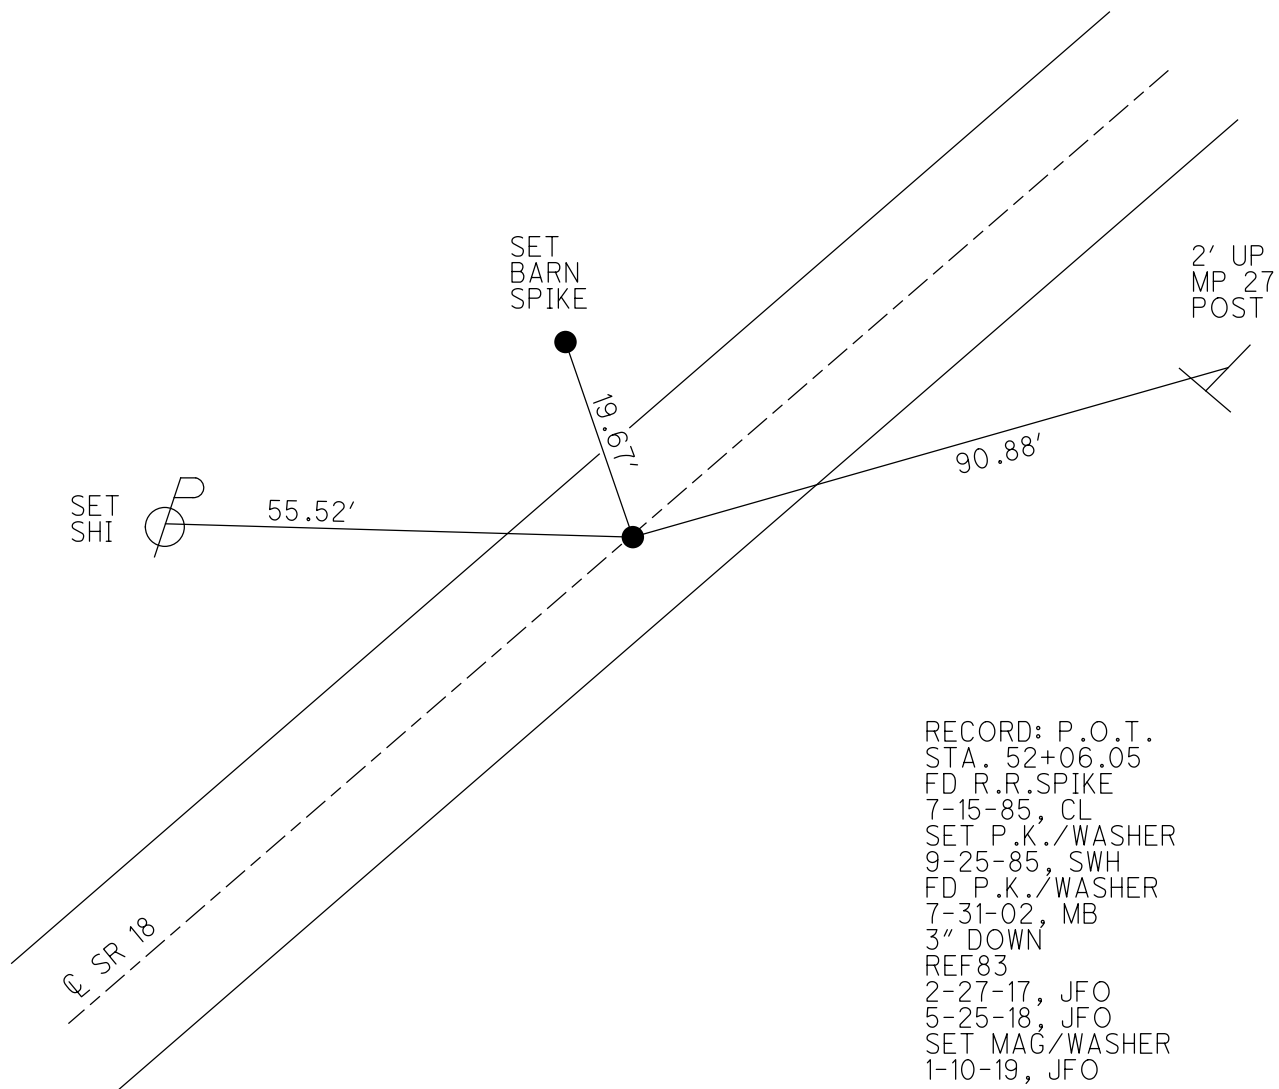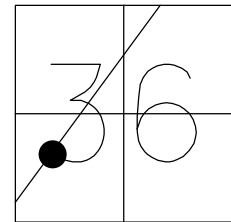

RECORD: P.O.T.
STA. 52+06.05
FD R.R.SPIKE
7-15-85, CL
SET P.K./WASHER
9-25-85, SWH
FD P.K./WASHER
7-31-02, MB
3" DOWN
REF83
2-27-17, JFO
5-25-18, JFO
SET MAG/WASHER
1-10-19, JFO

O.D.O.T. DISTRICT 2 SURVEY OFFICE (USE ONLY)

PERSONNEL

REFERENCE NO. 84

SHEET 17 OF 28

NOTES RHOADES

DATE 5-25-18

ROUTE SR 18

H.C. O'DONNELL

WEATHER SUNNY

COUNTY SENECA

R.C. HAGEMeyer

TEMP. 78°

TOWNSHIP ADAMS

TRENKA

SECTION 36

DWG BY JAMES PID 101281

T 3 N R 16 E

TYPE MONUMENT P.K./WASHER

ON SURFACE - ~~BELOW~~ ON

OFFSET CL PAVEMENT 1.0' ~~LT~~ : RT

9.7' TO RT EDGE PAVEMENT



STATION: 1441+42.52

HORZ.DATUM: NAD83 2011

GEOID: NAVD88 2012A

GRID: NORTHING: 550786.719

EASTING: 1839171.319

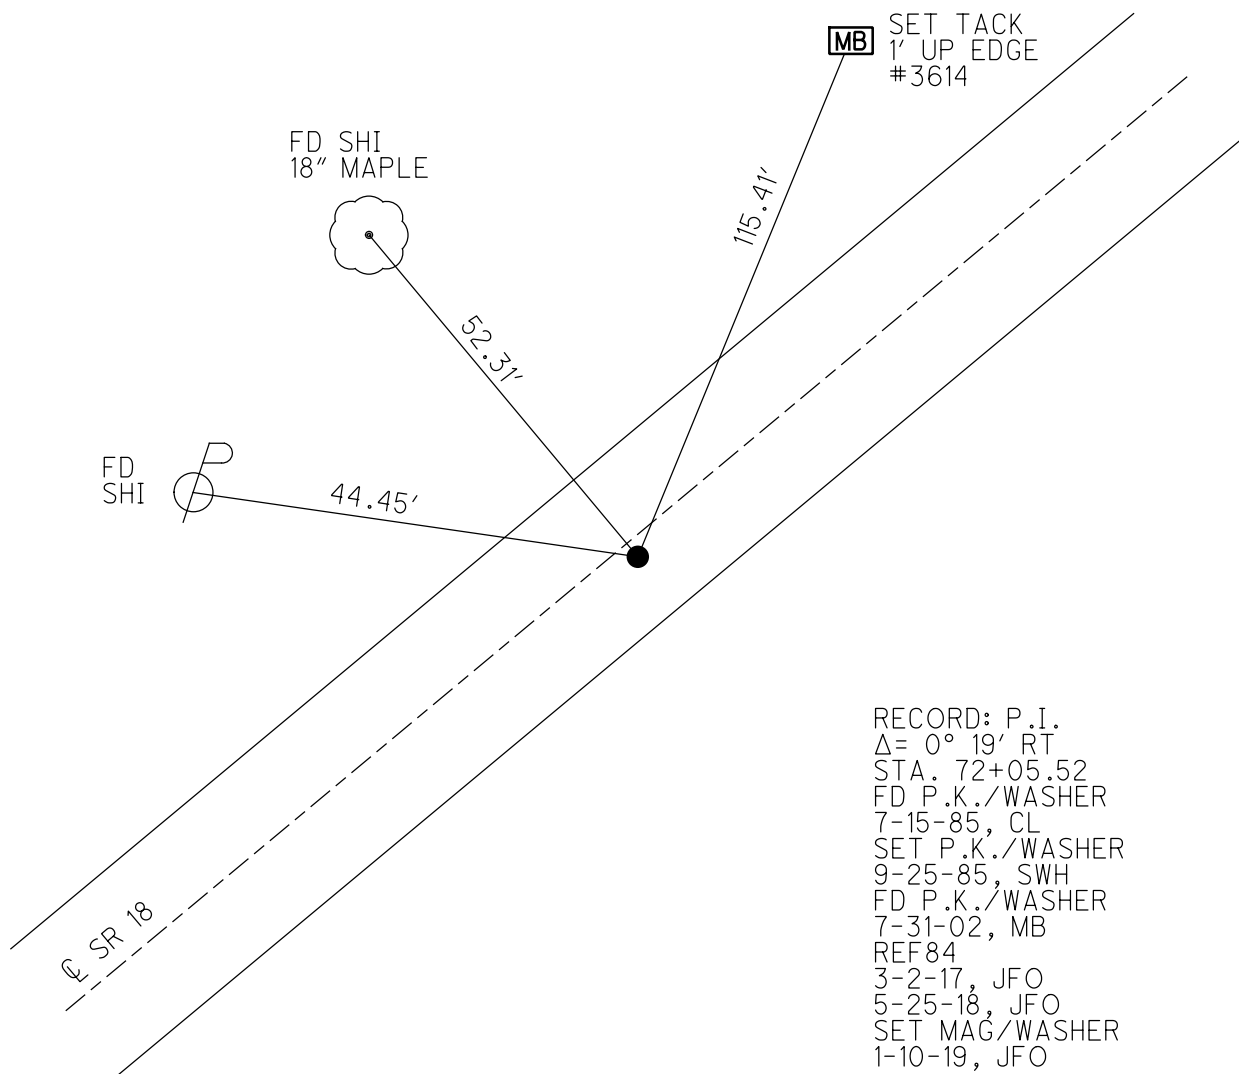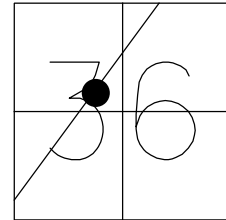

O.D.O.T. DISTRICT 2 SURVEY OFFICE (USE ONLY)

PERSONNEL

REFERENCE NO. 85

SHEET 18 OF 28

NOTES RHOADES

DATE 5-25-18

ROUTE SR 18

H.C. O'DONNELL

WEATHER SUNNY

COUNTY SENECA

R.C. HAGEMeyer

TEMP. 78°

TOWNSHIP ADAMS

TRENKA

SECTION 36

DWG BY JAMES PID 101281

T 3 N R 16 E

TYPE MONUMENT P.K. SHANK

~~ON SURFACE~~ - BELOW 0.1'

OFFSET $\varnothing$ PAVEMENT ON LT : RT

- TO - EDGE PAVEMENT



STATION: 1466+59.12

HORIZ.DATUM: NAD83 2011

GEOID: NAVD88 2012A

GRID: NORTHING: 552853.096

EASTING: 1840607.763

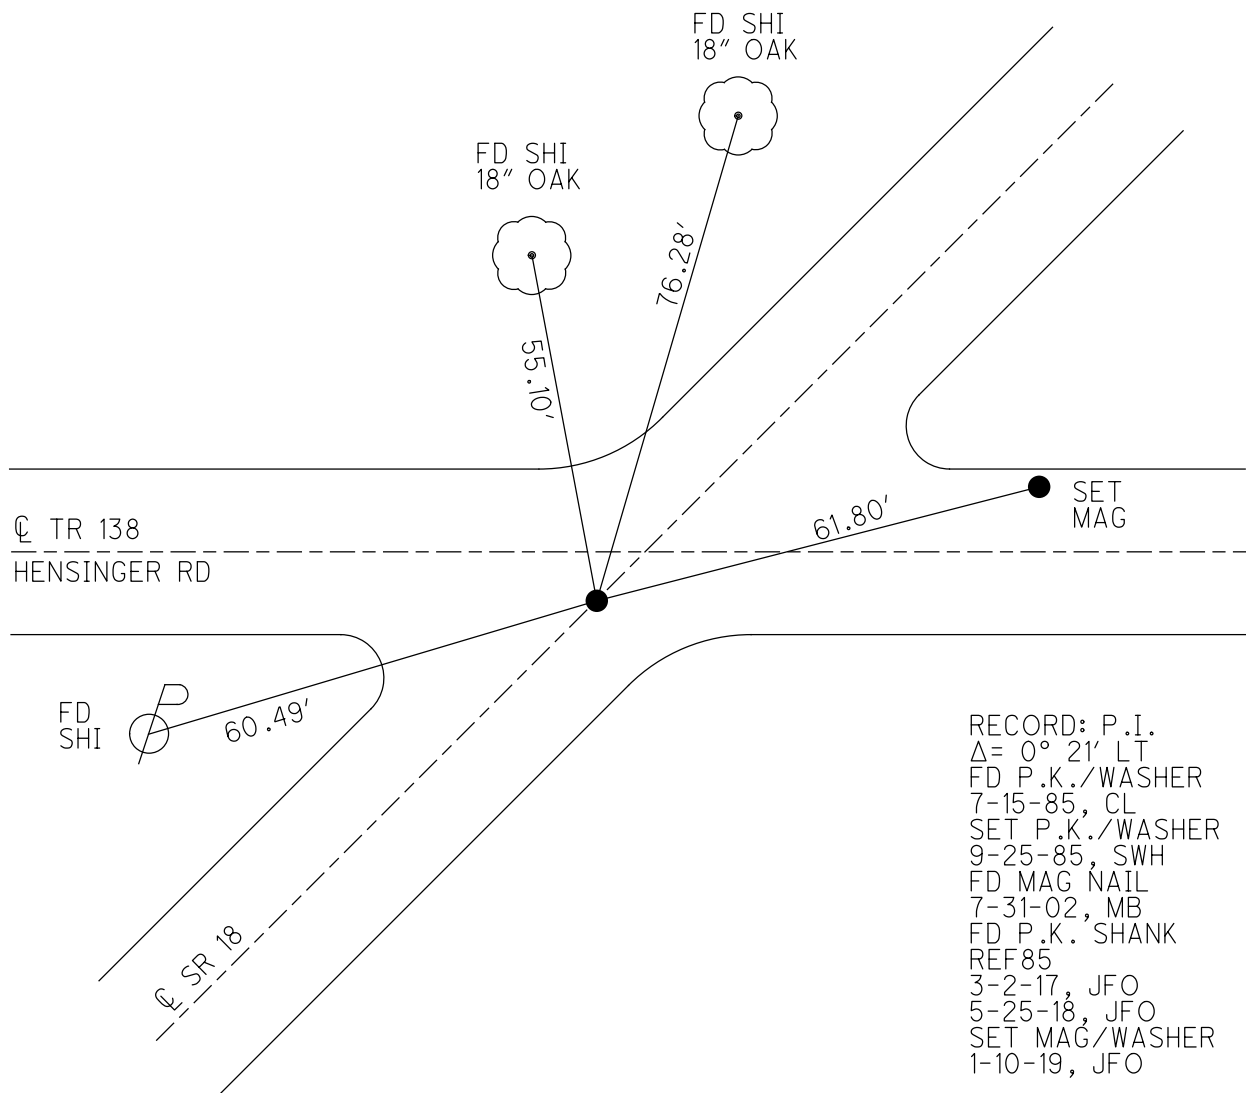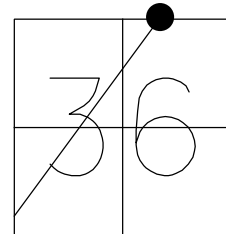

O.D.O.T. DISTRICT 2 SURVEY OFFICE (USE ONLY)

PERSONNEL

REFERENCE NO. 86

SHEET 19 OF 28

NOTES RHOADES

DATE 5-25-18

ROUTE SR 18

H.C. O'DONNELL

WEATHER SUNNY

COUNTY SENECA

R.C. HAGEMEYER

TEMP. 78°

TOWNSHIP ADAMS

TRENKA

SECTION 25

DWG BY JAMES

PID 101281

T 3 N R 16 E

TYPE MONUMENT P.K. SHANK

~~ON SURFACE~~ - BELOW 2.5"

OFFSET CL PAVEMENT 0.6' LT : ~~RT~~

9.2' TO LT EDGE PAVEMENT



STATION: 1481+47.75

HORIZ.DATUM: NAD83 2011

GEOID: NAVD88 2012A

GRID: NORTHING: 554080.094

EASTING: 1841450.666

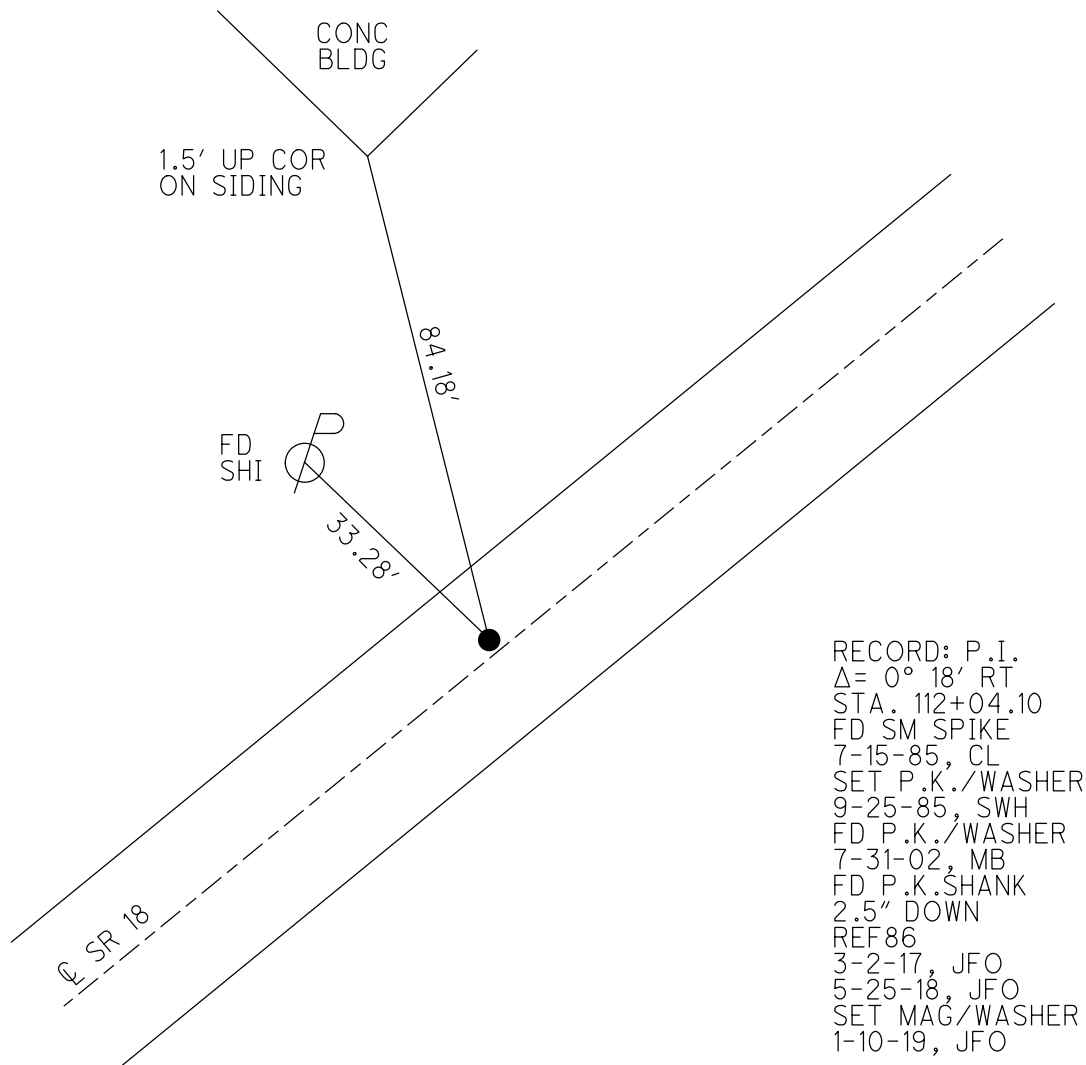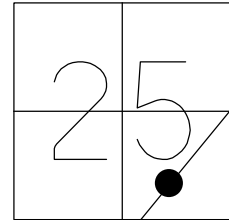

RECORD: P.I.
 $\Delta = 0^\circ 18' \text{ RT}$
STA. 112+04.10
FD SM SPIKE
7-15-85, CL
SET P.K./WASHER
9-25-85, SWH
FD P.K./WASHER
7-31-02, MB
FD P.K.SHANK
2.5" DOWN
REF86
3-2-17, JFO
5-25-18, JFO
SET MAG/WASHER
1-10-19, JFO

O.D.O.T. DISTRICT 2 SURVEY OFFICE (USE ONLY)

PERSONNEL

REFERENCE NO. 87

SHEET 20 OF 28

NOTES RHOADES

DATE 5-25-18

ROUTE SR 18

H.C. O'DONNELL

WEATHER SUNNY

COUNTY SENECA

R.C. HAGEMEYER

TEMP. 78°

TOWNSHIP ADAMS

TRENKA

DWG BY JAMES

SECTION 25

PID 101281

T 3 N R 16 E

TYPE MONUMENT P.K./WASHER

~~ON SURFACE~~ - BELOW 3"

OFFSET CL PAVEMENT 1.0' LT : ~~RT~~

9.2' TO LT EDGE PAVEMENT



STATION: 1496+47.05

HORIZ.DATUM: NAD83 2011

GEOID: NAVD88 2012A

GRID: NORTHING: 555311.606

EASTING: 1842305.809

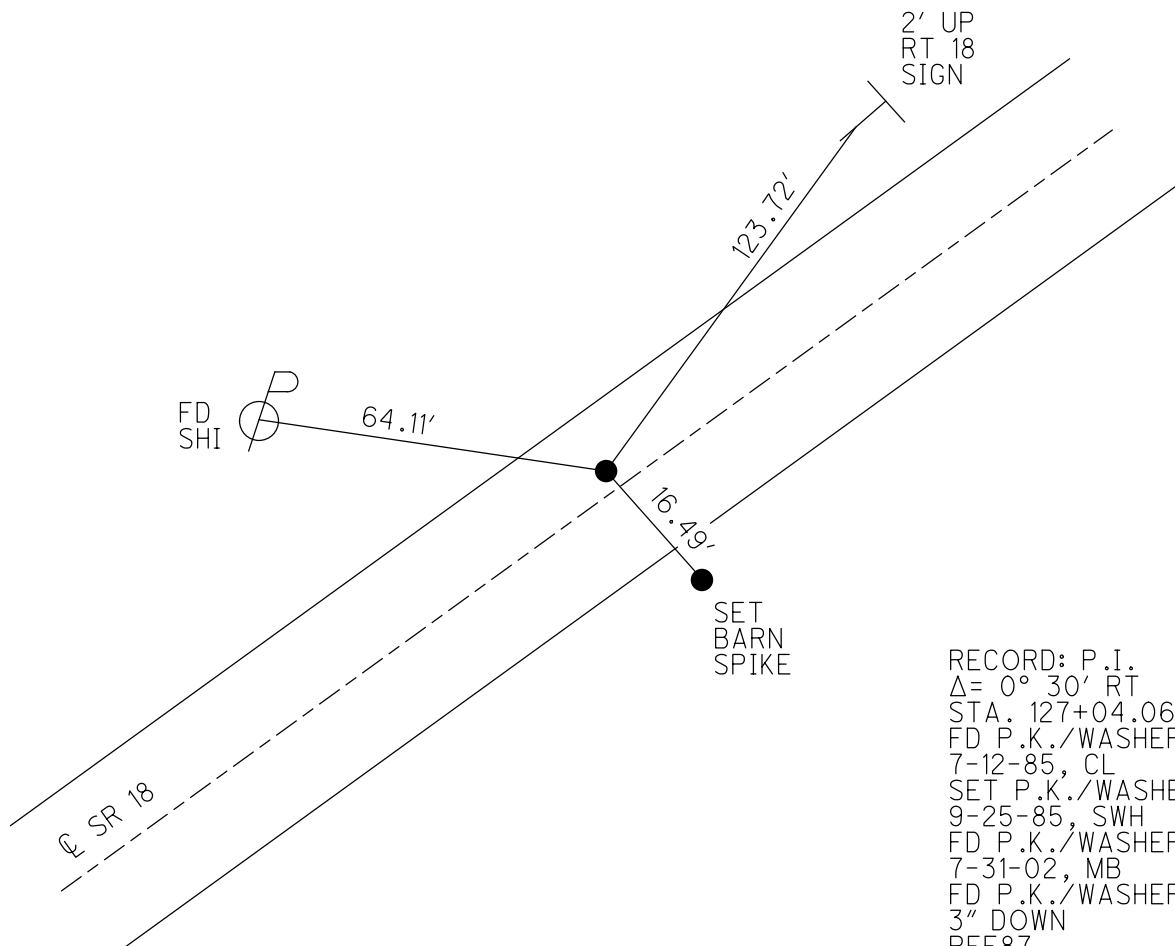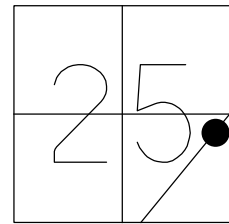

RECORD: P.I.
 $\Delta = 0^\circ 30' \text{ RT}$
STA. 127+04.06
FD P.K./WASHER
7-12-85, CL
SET P.K./WASHER
9-25-85, SWH
FD P.K./WASHER
7-31-02, MB
FD P.K./WASHER
3" DOWN
REF87
3-2-17, JFO
5-25-18, JFO
SET MAG/WASHER
1-14-19, JFO

O.D.O.T. DISTRICT 2 SURVEY OFFICE (USE ONLY)

PERSONNEL

REFERENCE NO. 88

SHEET 21 OF 28

NOTES RHOADES

DATE 5-24-18

ROUTE SR 18

H.C. O'DONNELL

WEATHER SUNNY

COUNTY SENECA

R.C. TRENKA

TEMP. 78°

TOWNSHIP THOMPSON

DWG BY JAMES PID 101281

SECTION 30

T 3 N R 16 E

TYPE MONUMENT P.K. SHANK

~~ON SURFACE~~ - BELOW 3"

OFFSET CL PAVEMENT 4.5' LT : ~~RT~~

5.3' TO LT EDGE PAVEMENT



STATION: 1510+11.37

HORZ.DATUM: NAD83 2011

GEOID: NAVD88 2012A

GRID: NORTHING: 556422.924

EASTING: 1843097.228

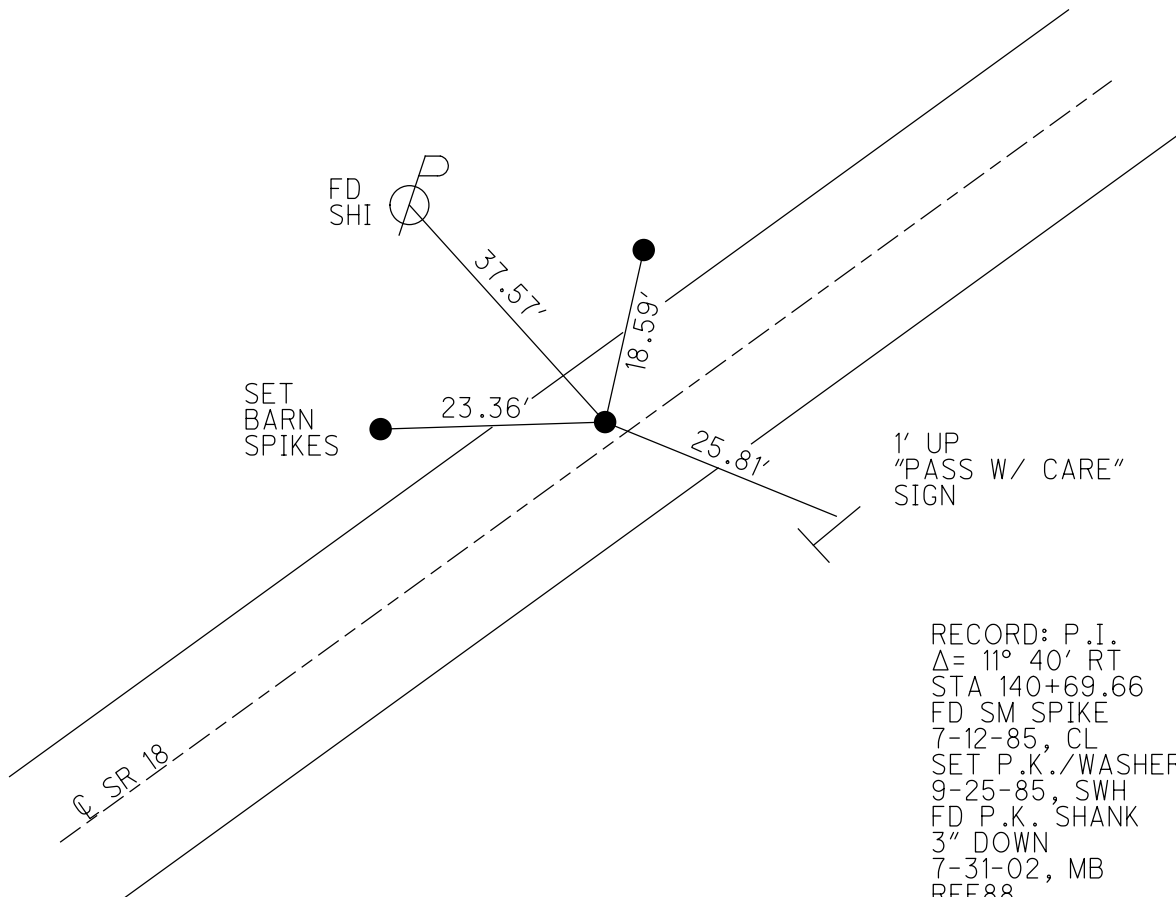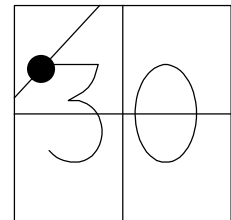

RECORD: P.I.
 $\Delta = 11^\circ 40' \text{ RT}$
STA 140+69.66
FD SM SPIKE
7-12-85, CL
SET P.K./WASHER
9-25-85, SWH
FD P.K. SHANK
3" DOWN
7-31-02, MB
REF88
3-2-17, JFO
5-24-18, JFO
SET MAG/WASHER
1-14-19, JFO

O.D.O.T. DISTRICT 2 SURVEY OFFICE (USE ONLY)

PERSONNEL

REFERENCE NO. 89

SHEET 22 OF 28

NOTES RHOADES

DATE 5-24-18

ROUTE SR 18

H.C. O'DONNELL

WEATHER SUNNY

COUNTY SENECA

R.C. TRENKA

TEMP. 78°

TOWNSHIP THOMPSON

DWG BY JAMES PID 101281

SECTION 30

T 3 N R 17 E

TYPE MONUMENT P.K. NAIL

ON SURFACE - ~~BELOW~~ ON

OFFSET CL PAVEMENT 0.5' ~~LT~~ : RT

10.1' TO LT EDGE PAVEMENT



STATION: 1523+86.95

HORIZ.DATUM: NAD83 2011

GEOID: NAVD88 2012A

GRID: NORTHING: 557366.054

EASTING: 1844098.590

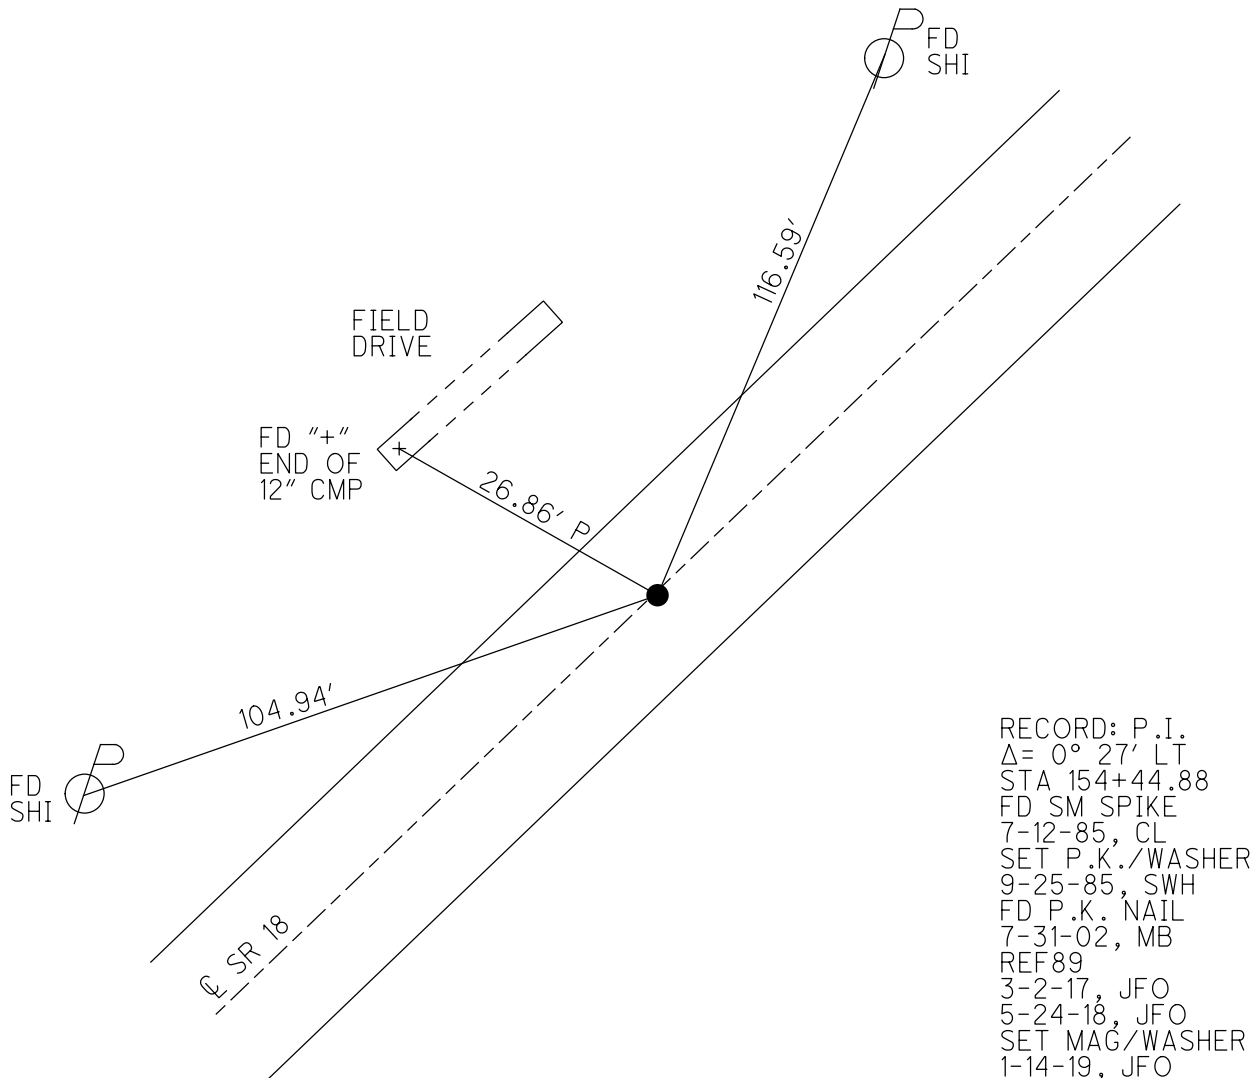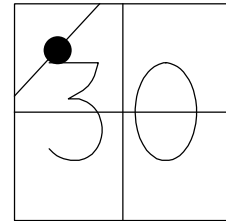

RECORD: P.I.
 $\Delta = 0^\circ 27' \text{ LT}$
STA 154+44.88
FD SM SPIKE
7-12-85, CL
SET P.K./WASHER
9-25-85, SWH
FD P.K. NAIL
7-31-02, MB
REF89
3-2-17, JFO
5-24-18, JFO
SET MAG/WASHER
1-14-19, JFO

O.D.O.T. DISTRICT 2 SURVEY OFFICE (USE ONLY)

PERSONNEL

REFERENCE NO. 90

SHEET 23 OF 28

NOTES RHOADES

DATE 5-24-18

ROUTE SR 18

H.C. O'DONNELL

WEATHER SUNNY

COUNTY SENECA

R.C. TRENKA

TEMP. 78

TOWNSHIP THOMPSONSECTION 30

DWG BY JAMES

PID 101281

T 3 N R 17 E

TYPE MONUMENT P.K./WASHER

~~ON SURFACE~~ - BELOW 3"

OFFSET C PAVEMENT 0.7' ~~LT~~ : RT


_____TO_____EDGE PAVEMENT

STATION: 1534+79.43

HORZ.DATUM: NAD83 2011

GEOID: NAVD88 2012A

GRID: NORTHING: 558118.191

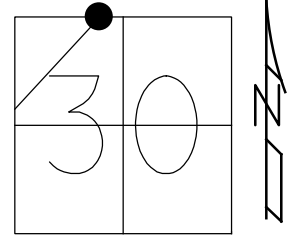EASTING: 1844890.927

RECORD: P.I.

$$\Delta = 1^{\circ} 21' \text{ LT}$$

STA. 165+35.99

FD P.K./WASHER

7-12-85, CL

SET P.K./WASHER

9-25-85, SWH

3" DOWN

7-31-02, MB


REF90

3-2-17, JFO

5-24-18, JFO

SET MAG/WASHER

1-14-19, JFO

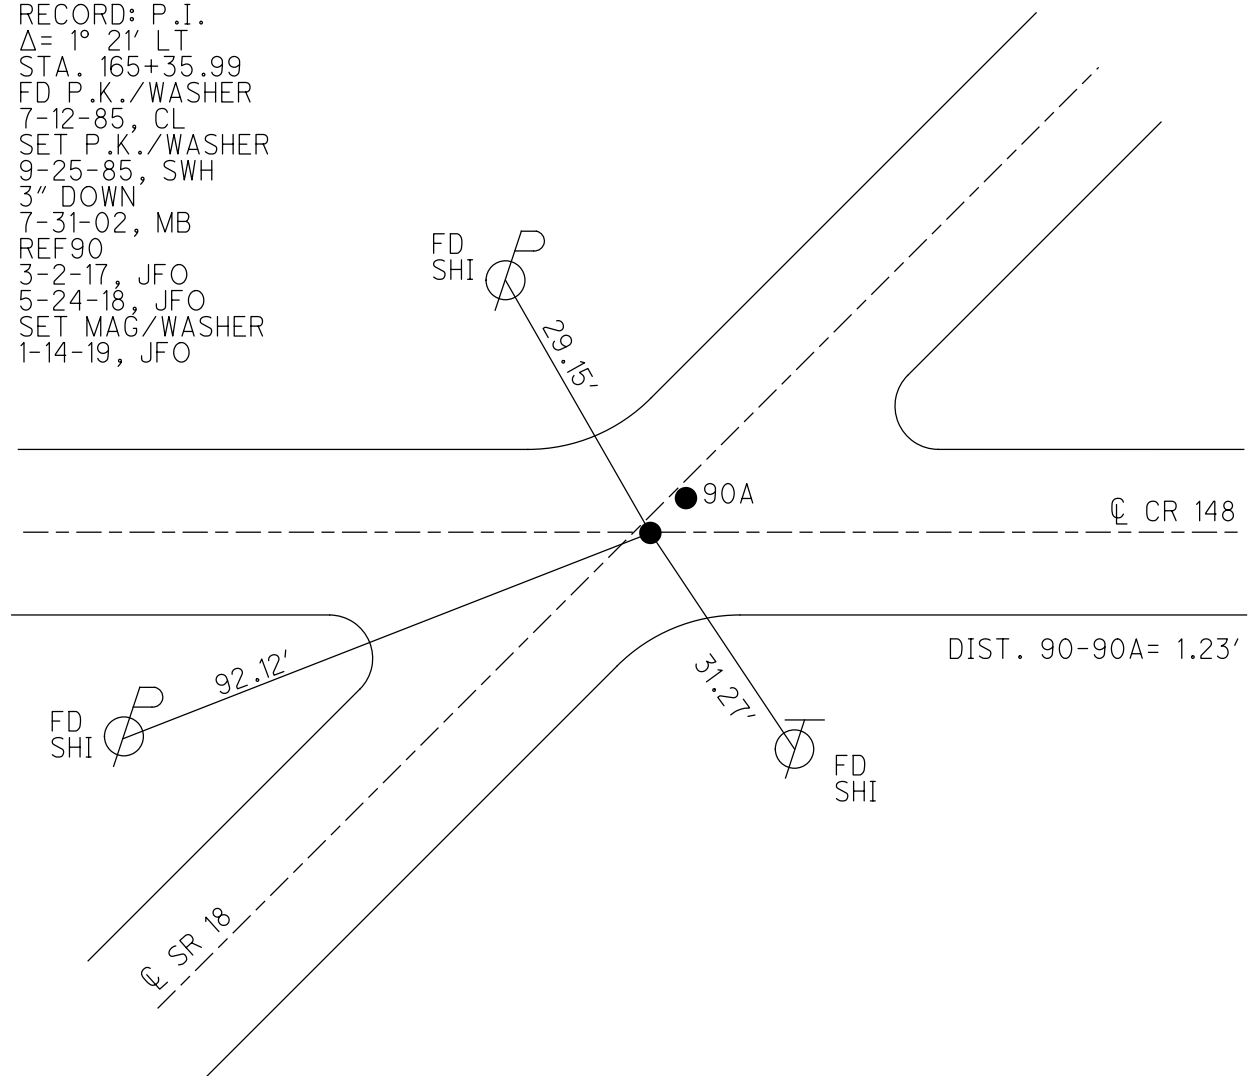

O.D.O.T. DISTRICT 2 SURVEY OFFICE (USE ONLY)

PERSONNEL

REFERENCE NO. 90 A

SHEET 24 OF 28

NOTES RHOADES

DATE 5-24-18

ROUTE SR 18

H.C. O'DONNELL

WEATHER SUNNY

COUNTY SENECA

R.C. TRENKA

TEMP. 78°

TOWNSHIP THOMPSON

DWG BY JAMES

PID 101281

SECTION 19

T 3 N R 17 E

TYPE MONUMENT P.K./WASHER

~~ON SURFACE~~ - BELOW 3"

OFFSET 0.7' ~~LT~~ : RT

- TO - EDGE PAVEMENT


STATION: 1534+80.66

HORIZ.DATUM: NAD83 2011


GEOID: NAVD88 2012A

GRID: NORTHING: 558119.100

EASTING: 1844891.766

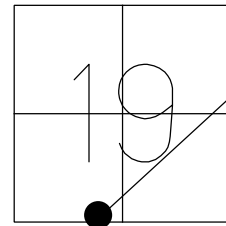

RECORD:
FD P.K./WASHER
4-8-75, JC
7-12-85, CL
SET P.K./WASHER
9-25-85, SWH
FD P.K./WASHER
3" DOWN
7-31-02, MB
REFA90
3-2-17, JFO
5-24-18, JFO
SET MAG/WASHER
1-14-19, JFO

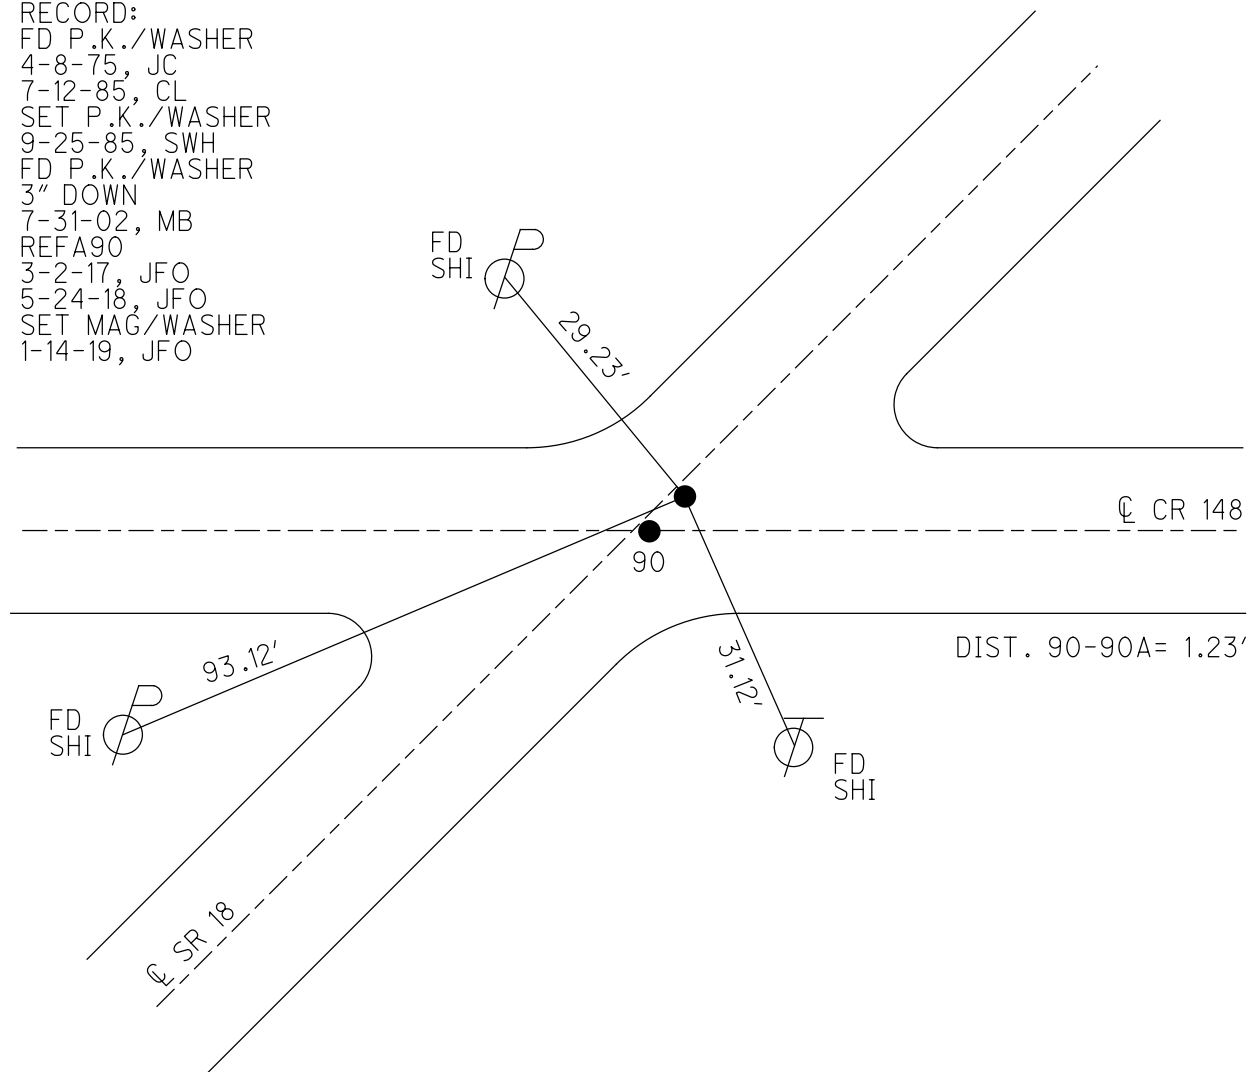

O.D.O.T. DISTRICT 2 SURVEY OFFICE (USE ONLY)

PERSONNEL

REFERENCE NO. 91

SHEET 25 OF 28

NOTES RHOADES

DATE 5-24-18

ROUTE SR 18

H.C. O'DONNELL

WEATHER SUNNY

COUNTY SENECA

R.C. TRENKA

TEMP. 78°

TOWNSHIP THOMPSON

DWG BY JAMES PID 101281

SECTION 19

T 3 N R 17 E

TYPE MONUMENT P.K./WASHER

ON SURFACE - ~~BELOW~~ ON

OFFSET CL PAVEMENT 1.6' LT : ~~RT~~

9.2' TO LT EDGE PAVEMENT


STATION: 1546+95.17

HORZ.DATUM: NAD83 2011

GEOID: NAVD88 2012A

GRID: NORTHING: 558977.199

EASTING: 1845751.242

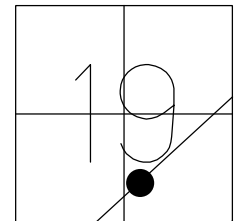

RECORD:

FD P.K./WASHER

7-12-85

SET P.K./WASHER

9-27-85, SWH

FD P.K./WASHER

7-31-02, MB

FD P.K.NAIL

REF91

3-2-17, JFO

5-24-18, JFO

SET MAG/WASHER

1-14-19, JFO

SET
BARN
SPIKE

13.59'

CL SR 18

O.D.O.T. DISTRICT 2 SURVEY OFFICE (USE ONLY)

PERSONNEL

REFERENCE NO. 92

SHEET 26 OF 28

NOTES RHOADES

DATE 5-24-18

ROUTE SR 18

H.C. O'DONNELL

WEATHER SUNNY

COUNTY SENECA

R.C. TRENKA

TEMP. 78°

TOWNSHIP THOMPSON

DWG BY JAMES PID 101281

SECTION 19

T 3 N R 17 E

TYPE MONUMENT P.K./WASHER

ON SURFACE - ~~BELOW~~ ON

OFFSET Q PAVEMENT 1.0 LT : ~~RT~~

9.4' TO LT EDGE PAVEMENT


STATION: 1561+92.38

HORZ.DATUM: NAD83 2011


GEOID: NAVD88 2012A

GRID: NORTHING: 560019.936

EASTING: 1846825.645

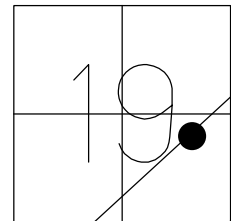

RECORD:
STA. 27+13.77
FD P.K./WASHER
7-12-85, CL
SET P.K./WASHER
9-27-85, SWH
FD P.K./WASHER
7-31-02, MB
REF92
3-2-17
12/06/02, JFO
5-24-18, JFO
SET MAG/WASHER
1-14-19, JFO

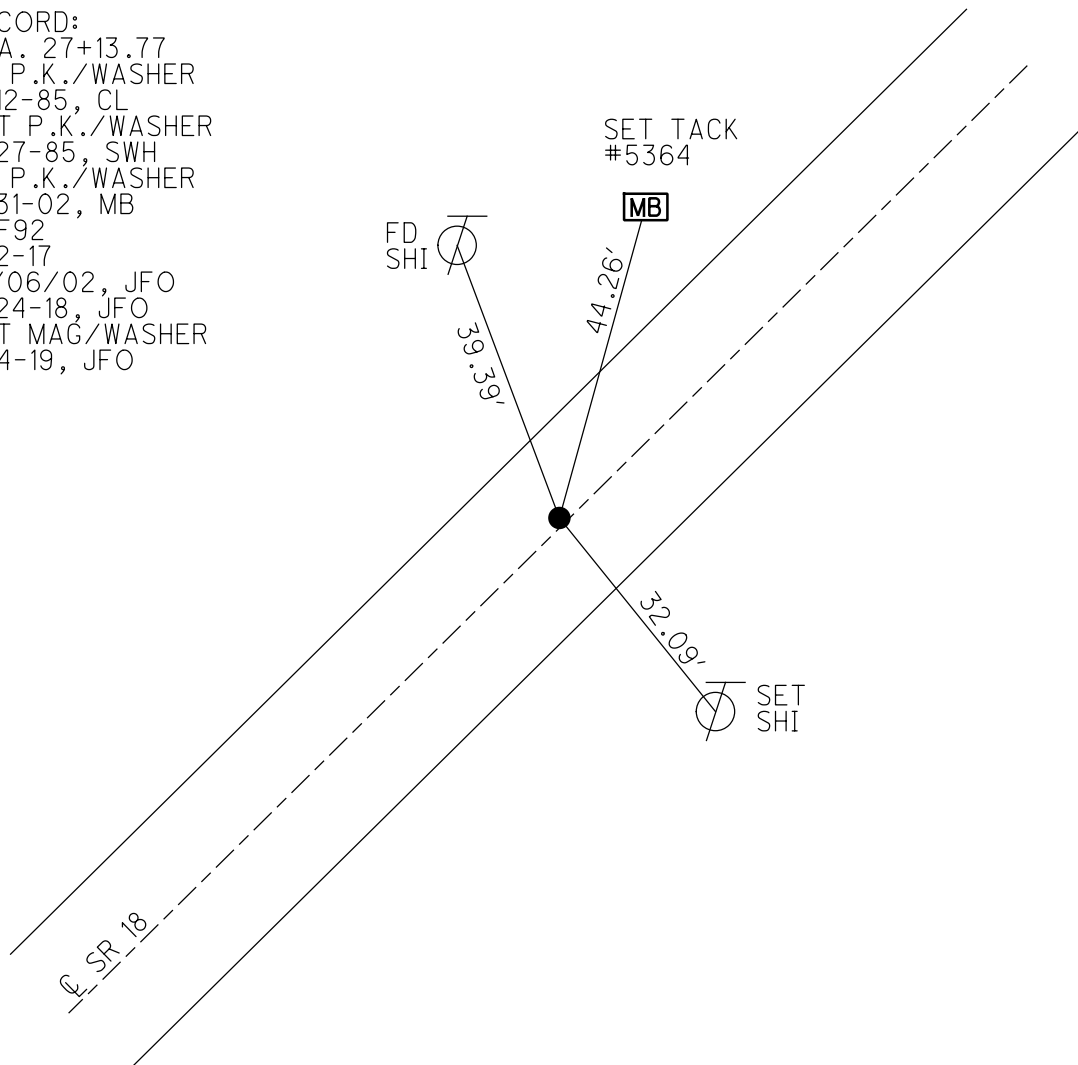

O.D.O.T. DISTRICT 2 SURVEY OFFICE (USE ONLY)

PERSONNEL

REFERENCE NO. 93

SHEET 27 OF 28

NOTES RHOADES

DATE 5-24-18

ROUTE SR 18

H.C. O'DONNELL

WEATHER SUNNY

COUNTY SENECA

R.C. TRENKA

TEMP. 74°

TOWNSHIP THOMPSON

DWG BY JAMES

PID 101281

SECTION 19

T 3 N R 17 E

TYPE MONUMENT P.K./WASHER

~~ON SURFACE~~ - BELOW 3"

OFFSET $\varnothing$ PAVEMENT ON LT : RT

- TO - EDGE PAVEMENT


STATION: 1580+38.51

HORZ.DATUM: NAD83 2011


GEOID: NAVD88 2012A

GRID: NORTHING: 561280.081

EASTING: 1848174.800

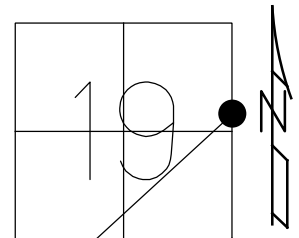

RECORD:
FD P.K./WASHER
7-12-85, CL
SET P.K./WASHER
9-27-85, SWH
FD P.K./WASHER
7-31-02, MB
3" DOWN
REF93
3-3-17, JFO
5-24-18, JFO
SET MAG/WASHER
1-14-19, JFO

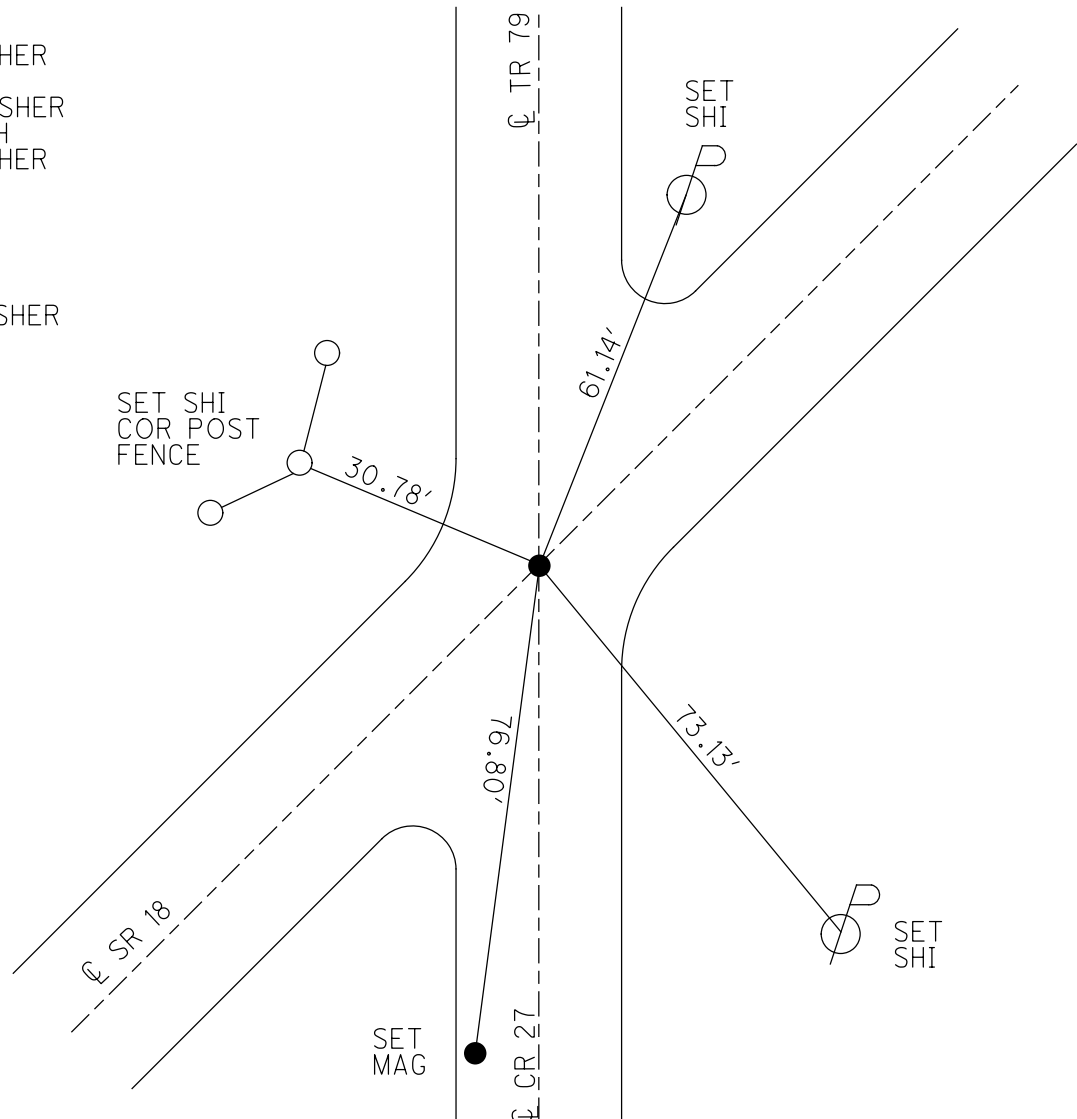

O.D.O.T. DISTRICT 2 SURVEY OFFICE (USE ONLY)

PERSONNEL

REFERENCE NO. 94

SHEET 28 OF 28

NOTES RHOADES

DATE 5-24-18

ROUTE SR 18

H.C. O'DONNELL

WEATHER SUNNY

COUNTY SENECA

R.C. TRENKA

TEMP. 74°

TOWNSHIP THOMPSON

DWG BY JAMES PID 101281

SECTION 20

T 3 N R 17 E

TYPE MONUMENT 1" IPIPE

~~ON SURFACE~~ - BELOW 4"

OFFSET Q PAVEMENT 1' ~~LT~~ : RT

10.4' TO LT EDGE PAVEMENT


STATION: 1595+77.98

HORIZ.DATUM: NAD83 2011


GEOID: NAVD88 2012A

GRID: NORTHING: 562352.165

EASTING: 1849279.610

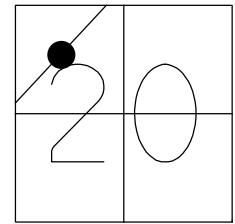


RECORD: P.I.
 $\Delta = 0^\circ 49'$ LT
STA. 15+41.36
FD P.K./WASHER
7-12-85, CL
SET P.K./WASHER
9-27-85, SWH
FD P.K. NAIL
7-31-02, MB
FD 1" IPIPE
4" DOWN
REF94
3-3-17, JFO
5-24-18, JFO
SET MAG/WASHER
1-14-19, JFO

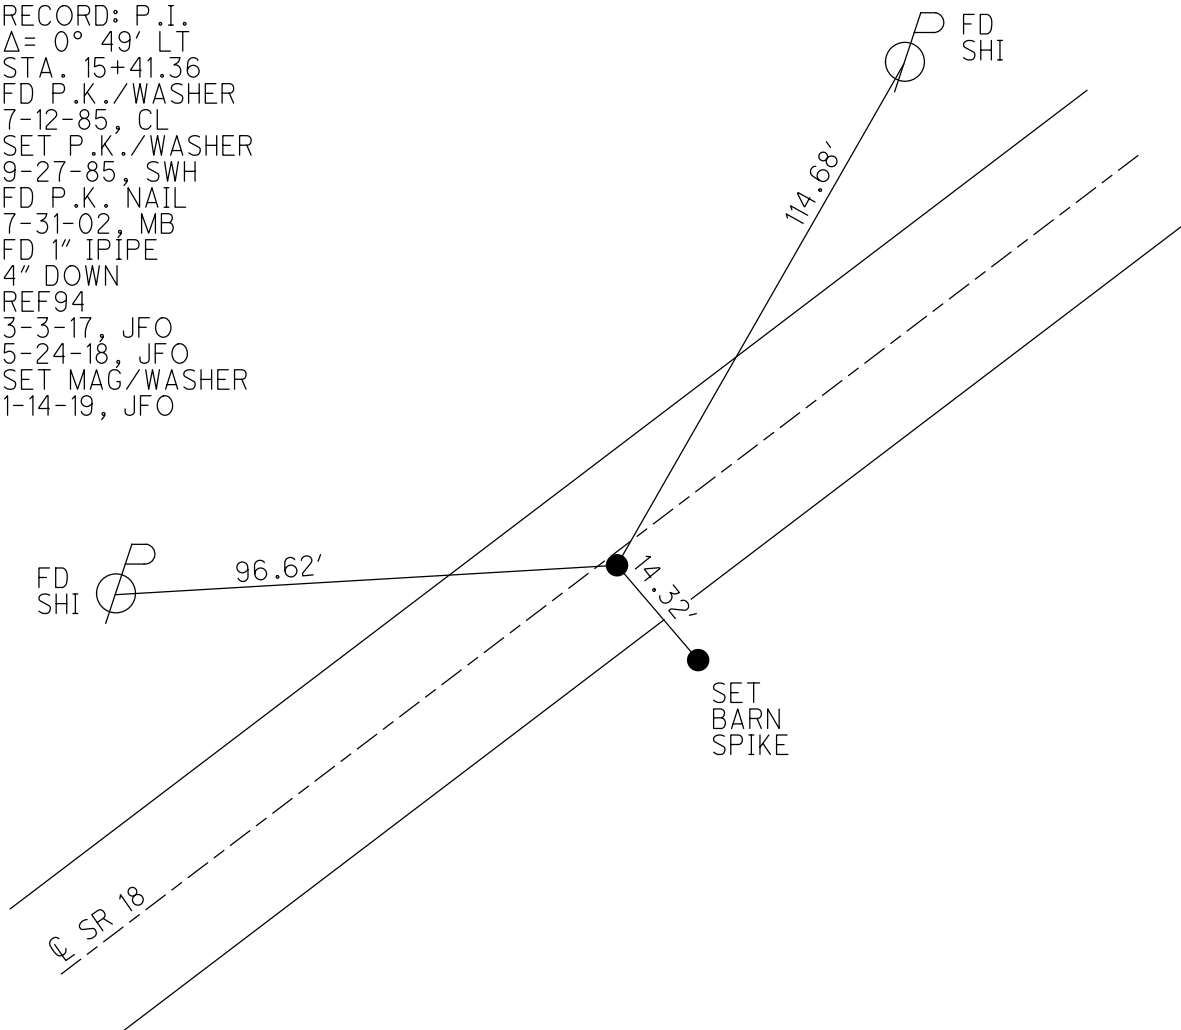


O.D.O.T. DISTRICT 2 SURVEY OFFICE (USE ONLY)

PERSONNEL	REFERENCE NO. <u>95</u>	SHEET <u>1</u> OF <u>18</u>
NOTES <u>WESTFALL</u>	DATE <u>4/16/15</u>	ROUTE <u>SR 18</u>
H.C. <u>LEU</u>	WEATHER <u>OVERCAST/WINDY</u>	COUNTY <u>SENECA</u>
R.C. <u>WESTFALL</u>	TEMP. <u>60°</u>	TOWNSHIP <u>THOMPSON</u>
		SECTION <u>17</u>
		T <u>3</u> N R <u>17</u> E

TYPE MONUMENT P.K./WASHER
~~ON SURFACE~~ - BELOW 0.25'
 LEFT - ℄ PAV'T - RIGHT ON
- TO - EDGE PAVEMENT
 S.L.M. 1611+98.40
 Grid: Northing: 563345.482 Easting: 1850274.142

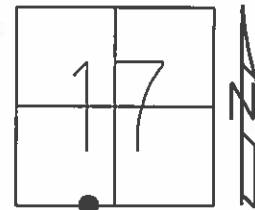


RECORD: P.I.
 $\Delta = 0^\circ 06' \text{ LT}$
 STA. 29+47.45
 FD P.K./WASHER
 7/12/85, MB
 SET P.K./WASHER
 9/27/85, SWH
 FD P.K./WASHER
 7/31/02, MB
 SET MAG/WASHER
 GPS, NEWREF95
 6/30/15, JFO

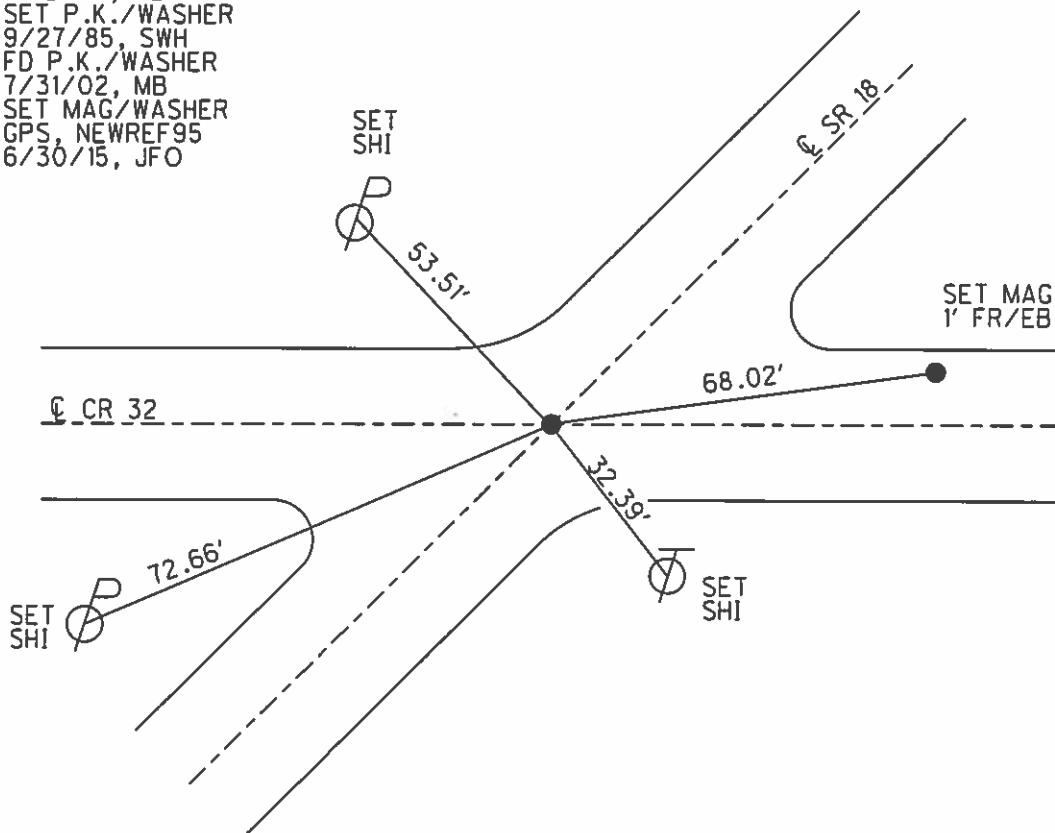

O.D.O.T. DISTRICT 2 SURVEY OFFICE (USE ONLY)


PERSONNEL _____ REFERENCE NO. 97 SHEET 2 OF 18
 NOTES WESTFALL DATE 4/16/15 ROUTE SR 18
 H.C. LEU WEATHER OVERCAST/WINDY COUNTY SENECA
 R.C. WESTFALL TEMP. 60° TOWNSHIP THOMPSON
 _____ SECTION 17
 _____ T 3 N R 17 E

TYPE MONUMENT SM.R.R.SPIKE
~~ON SURFACE~~ - BELOW .35'
 LEFT - ℄ PAV'T - ~~RIGHT~~ 0.5'
9.6' TO LT EDGE PAVEMENT
 S.L.M. 1624+98.82

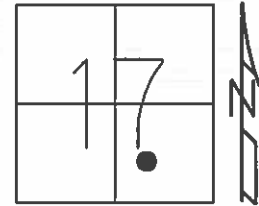

Grid: Northing: 564266.169 Easting: 1851192.547

RECORD: P.I.
 $\Delta = 10^{\circ}00'$ LT
 STA. 42+48.08
 FD SM.R.R.SPIKE
 7/12/85, MB
 SET P.K./WASHER
 9/27/85, SWH
 FD SM.R.R.SPIKE
 7/31/02, MB
 SET MAG/WASHER
 GPS, NEWREF97
 6/30/15, JFO

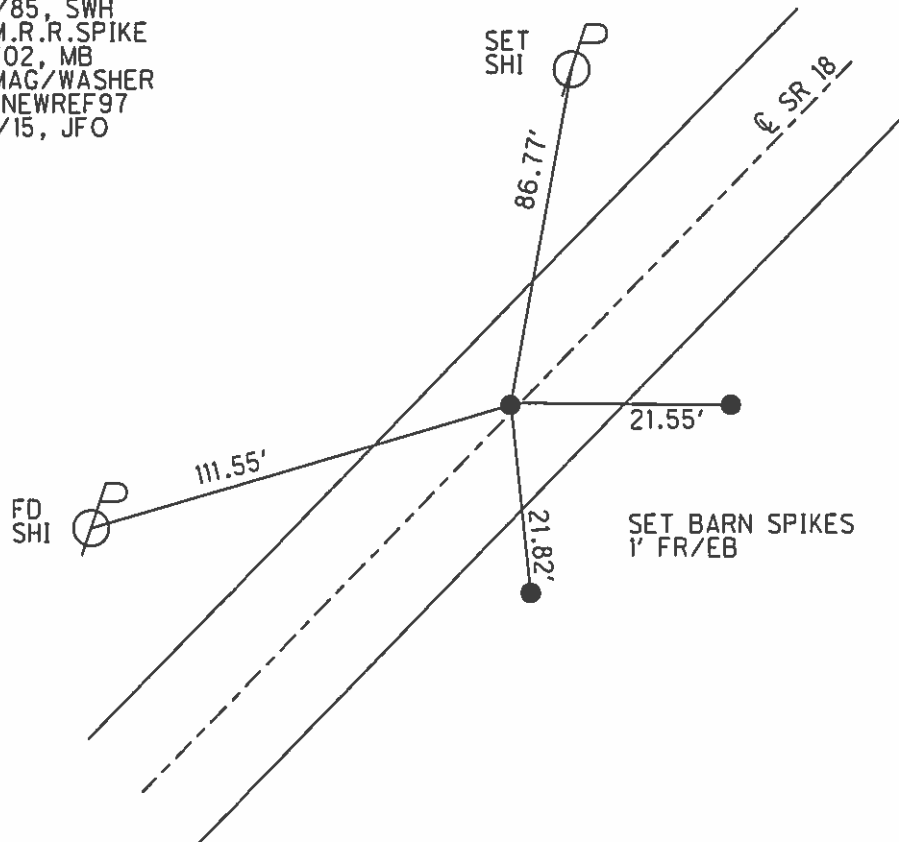

O.D.O.T. DISTRICT 2 SURVEY OFFICE (USE ONLY)

PERSONNEL

REFERENCE NO. 98

SHEET 3 OF 18

NOTES WESTFALL

DATE 4/16/15

ROUTE SR 18

H.C. LEU

WEATHER OVERCAST/WINDY

COUNTY SENECA

R.C. WESTFALL

TEMP. 60°

TOWNSHIP THOMPSON

SECTION 17

T 3 N R 17 E

TYPE MONUMENT P.K./WASHER



ON SURFACE - ~~BELOW~~ ON

LEFT - Q PAV'T - ~~RIGHT~~ 1.0'

9.2' TO LT EDGE PAVEMENT

S.L.M. 1648+38.62

Grid: Northing: 565951.626 Easting: 1852815.505

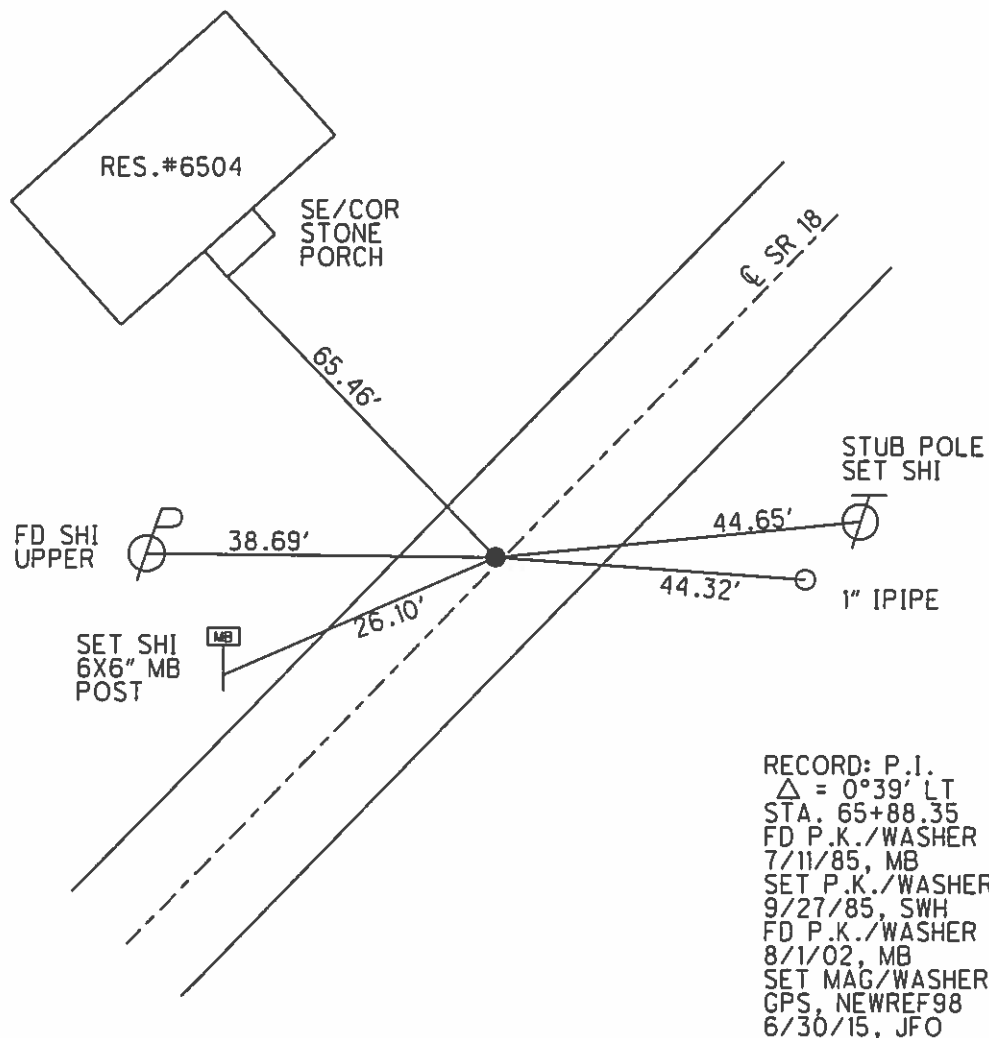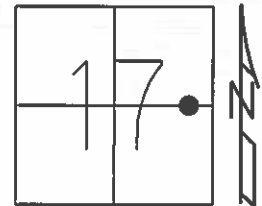

RECORD: P.I.
 $\Delta = 0^{\circ}39' \text{ LT}$
 STA. 65+88.35
 FD P.K./WASHER
 7/11/85, MB
 SET P.K./WASHER
 9/27/85, SWH
 FD P.K./WASHER
 8/1/02, MB
 SET MAG/WASHER
 GPS, NEWREF98
 6/30/15, JFO

O.D.O.T. DISTRICT 2 SURVEY OFFICE (USE ONLY)


PERSONNEL

REFERENCE NO. 98 A SHEET 4 OF 18


NOTES RHOADES DATE 6/30/15 ROUTE SR 18
H.C. O'DONNELL WEATHER CLEAR COUNTY SENECA
R.C. RHOADES TEMP. 73° TOWNSHIP THOMPSON
SECTION 17
T 3 N R 17 E

TYPE MONUMENT MAG/WASHER
ON SURFACE - ~~BELOW~~ ON
LEFT - ℄ PAV'T - ~~RIGHT~~ 2.0'
9.7' TO LT EDGE PAVEMENT
S.L.M. 1659+21.58

Grid: Northing: 566740.042 Easting: 1853557.817

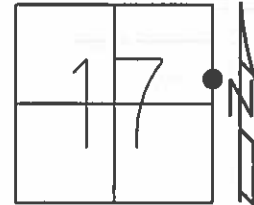

RECORD:
UNKNOWN ORIGIN
FD NAIL
7/11/85, MB
SET P.K./WASHER
9/27/85, SWH
FD P.K./WASHER
8/1/02, MB
SET MAG/WASHER
WITH TIES
GPS, NEWREFA98
6/30/15, JFO

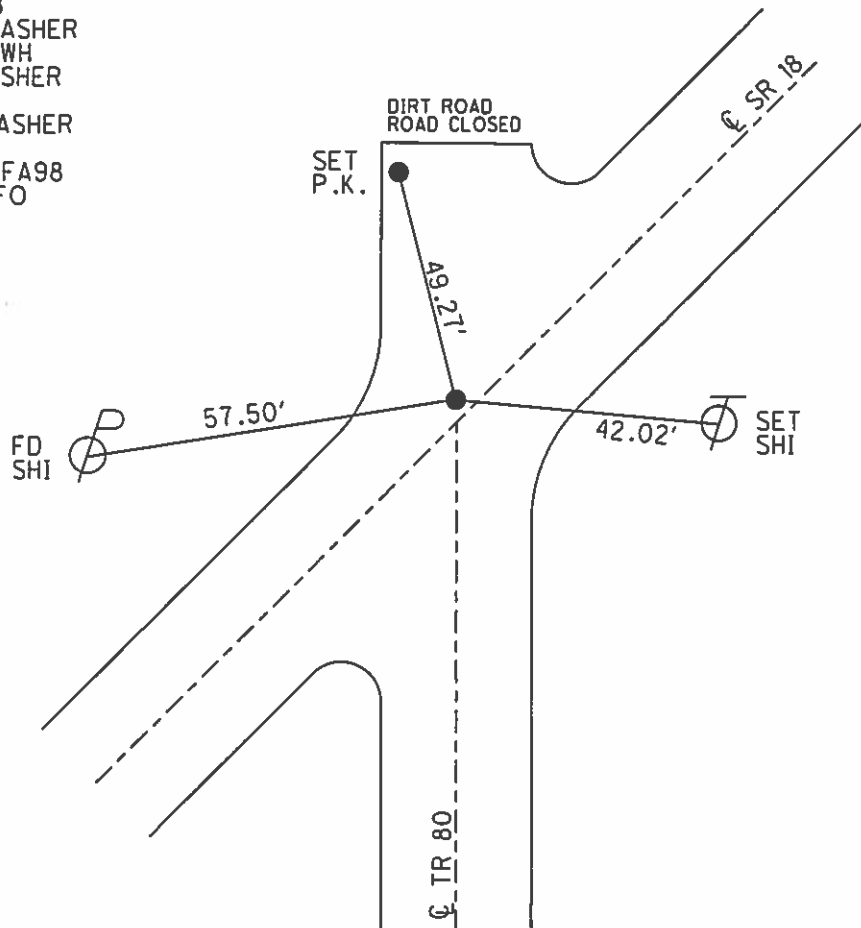


O.D.O.T. DISTRICT 2 SURVEY OFFICE (USE ONLY)

PERSONNEL _____ REFERENCE NO. 99 SHEET 5 OF 18


NOTES RHOADES DATE 4/16/15 ROUTE SR 18
H.C. WESTFALL WEATHER OVERCAST/WINDY COUNTY SENECA
R.C. O'DONNELL TEMP. 60° TOWNSHIP THOMPSON
SECTION 16
T 3 N R 17 E

TYPE MONUMENT P.K./WASHER
~~ON SURFACE~~ - BELOW 0.1'
LEFT - ℄ PAV'T - ~~RIGHT~~ 3.1'
8.1' TO LT EDGE PAVEMENT
S.L.M. 1663+28.83

Grid: Northing: 567036.507 Easting: 1853837.052

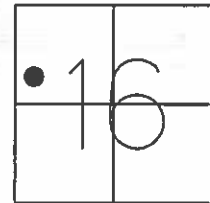

RECORD: P.I.
 $\Delta = 1^\circ 09' \text{ RT}$
STA. 80+78.70
FD P.K./WASHER
7/11/85, MB
SET P.K./WASHER
9/27/85, SWH
FD P.K./WASHER
8/1/02, MB
SET MAG/WASHER
GPS, NEWREF99
6/30/15, JFO

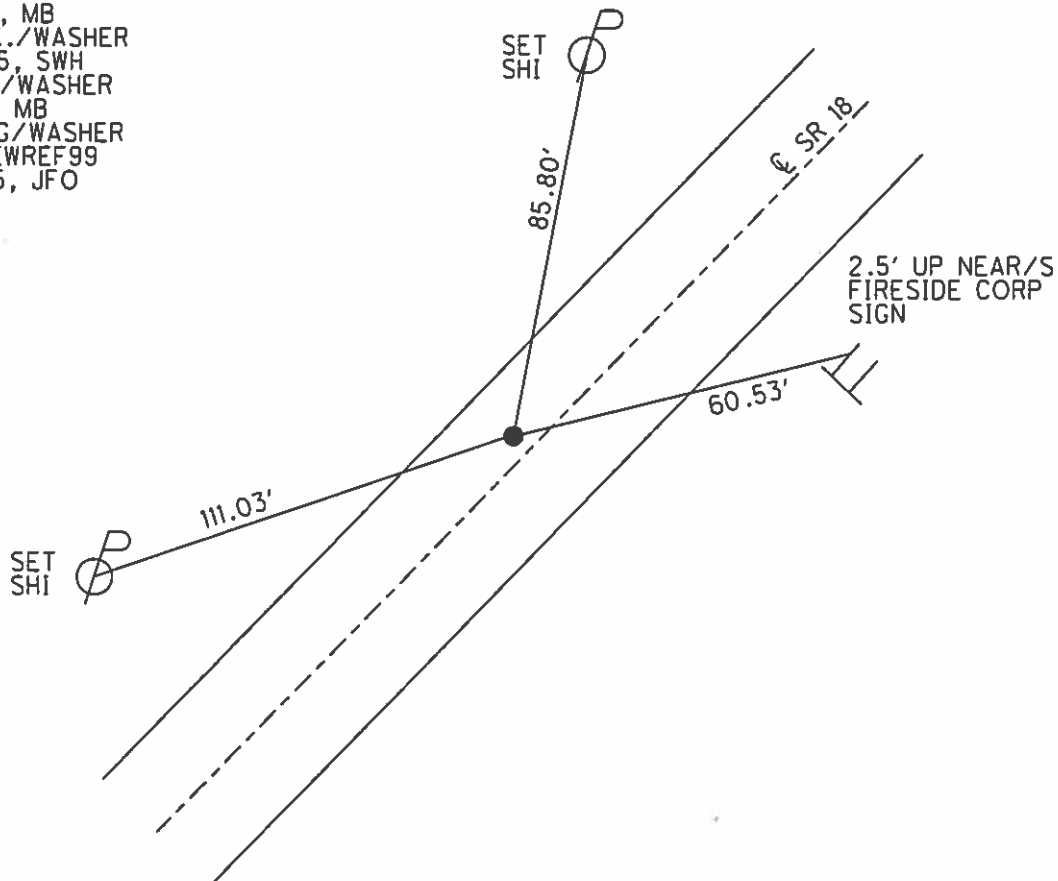


O.D.O.T. DISTRICT 2 SURVEY OFFICE (USE ONLY)


PERSONNEL _____ REFERENCE NO. 100 SHEET 6 OF 18
NOTES RHOADES DATE 4/16/15 ROUTE SR 18
H.C. WESTFALL WEATHER OVERCAST/WINDY COUNTY SENECA
R.C. O'DONNELL TEMP. 60° TOWNSHIP THOMPSON
SECTION 16
T 3 N R 17 E

TYPE MONUMENT P.K./WASHER
~~ON SURFACE~~ - BELOW 0.2'
LEFT - ℄ PAV'T - ~~RIGHT~~ 1.5'
9.8' TO LT EDGE PAVEMENT
S.L.M. 1675+30.18

Grid: Northing: 567894.538 Easting: 1854677.930

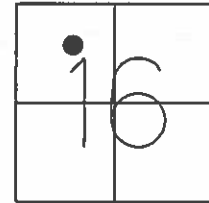

RECORD: P.I.
Δ = 0°22' LT
STA. 92+80.50
FD P.K./WASHER
7/11/85, MB
SET P.K./WASHER
9/27/85, SWH
FD P.K./WASHER
8/1/02, MB
SET MAG/WASHER
GPS, NEWREF100
6/30/15, JFO

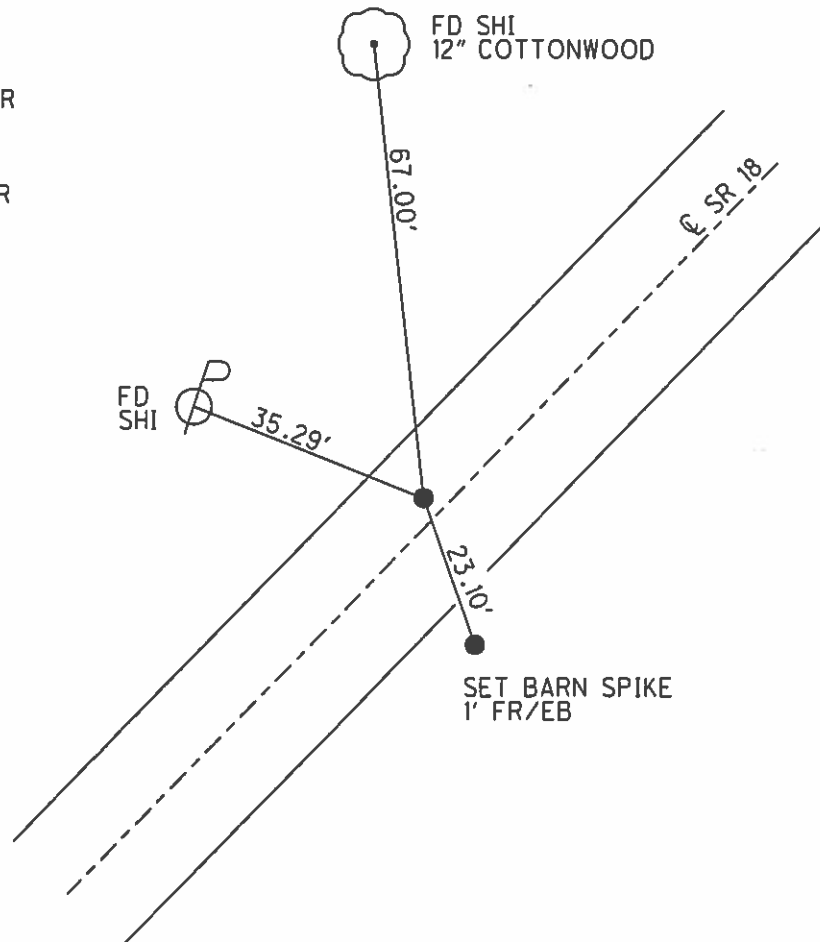


O.D.O.T. DISTRICT 2 SURVEY OFFICE (USE ONLY)


PERSONNEL _____ REFERENCE NO. 101 SHEET 7 OF 18
 NOTES RHOADES DATE 4/16/15 ROUTE SR 18
 H.C. WESTFALL WEATHER OVERCAST/WINDY COUNTY SENECA
 R.C. O'DONNEL TEMP. 60° TOWNSHIP THOMPSON
 _____ SECTION 16
 _____ T 3 N R 17 E

TYPE MONUMENT P.K./WASHER
 ON SURFACE - ~~BELOW~~ ON
~~LEFT~~ - C PAV'T - RIGHT 1.0'
- TO - EDGE PAVEMENT
 S.L.M. 1684+62.93

Grid: Northing: 568564.933 Easting: 1855326.464

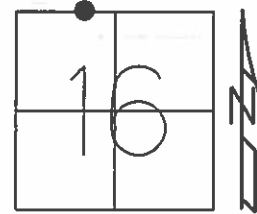

RECORD:
 FD HINGE NAIL
 2 3/4" BELOW
 1972, J. CRONIN
 FD P.K./WASHER
 7/11/85, MB
 SET P.K./WASHER
 10/1/85, SWH
 FD P.K./WASHER
 8/1/02, MB
 SET MAG/WASHER
 GPS, NEWREF101
 7/7/15, JFO

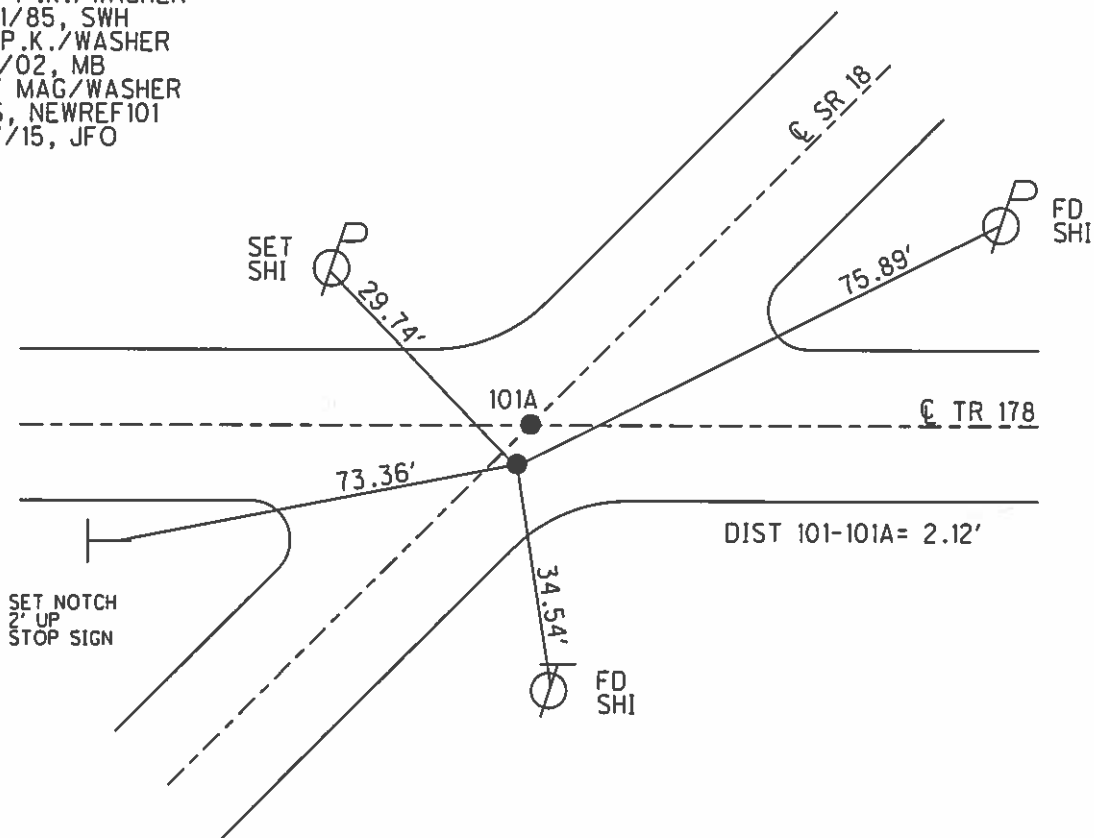


O.D.O.T. DISTRICT 2 SURVEY OFFICE (USE ONLY)


PERSONNEL	REFERENCE NO.	101 A	SHEET	8	OF	18
NOTES	RHOADES	DATE	4/16/15	ROUTE	SR 18	
H.C.	WESTFALL	WEATHER	OVERCAST/WINDY	COUNTY	SENECA	
R.C.	O'DONNELL	TEMP.	60°	TOWNSHIP	THOMPSON	
				SECTION	9	
				T	3	N
				R	17	E

TYPE MONUMENT P.K.NAIL
 ON SURFACE - ~~BELOW~~ ON
~~LEFT~~ - Q PAV'T - RIGHT 1.0'
 - TO - EDGE PAVEMENT
 S.L.M. 1684+65.05

Grid: Northing: 568566.454 Easting: 1855327.967

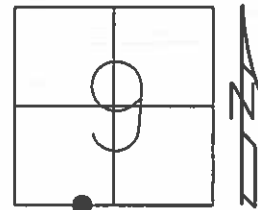

RECORD: P.I.
 $\Delta = 1^{\circ}11' \text{ LT}$
 STA. 102+15.41
 FD P.K./WASHER
 7/11/85, MB
 SET P.K./WASHER
 10/1/85, SWH
 FD P.K./WASHER
 8/1/02, MB
 SET MAG/WASHER
 GPS, NEWREFA101
 7/7/15, JFO

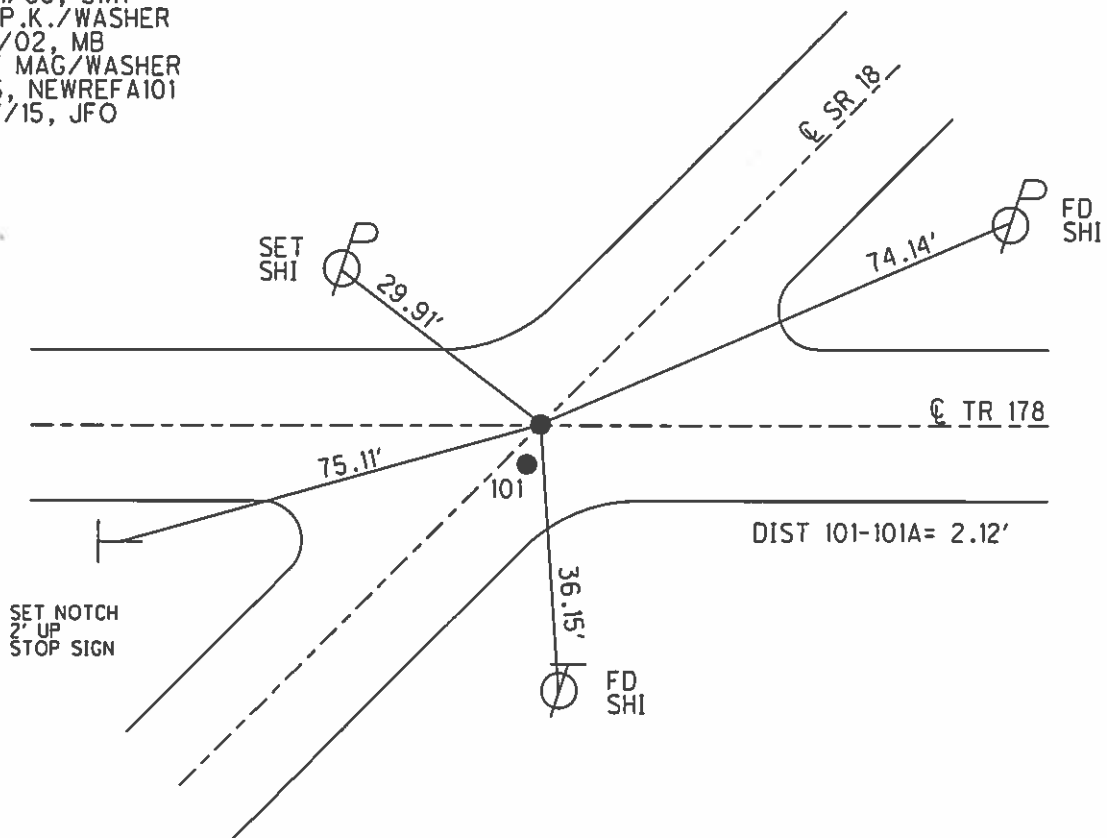


O.D.O.T. DISTRICT 2 SURVEY OFFICE (USE ONLY)


PERSONNEL	REFERENCE NO.	102	SHEET	9	OF	18
NOTES	RHOADES	DATE	4/16/15	ROUTE	SR 18	
H.C.	WESTFALL	WEATHER	OVERCAST/WINDY	COUNTY	SENECA	
R.C.	O'DONNELL	TEMP.	60°	TOWNSHIP	THOMPSON	
				SECTION	9	
				T	3	N
				R	17	E

TYPE MONUMENT P.K.NAIL
 ON SURFACE - ~~BELOW~~ ON
 LEFT - ℄ PAV'T - ~~RIGHT~~ 4.2'
7.2' TO LT EDGE PAVEMENT
 S.L.M. 1688+20.34

Grid: Northing: 568826.842 Easting: 1855569.515

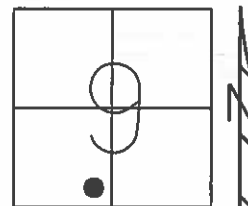

RECORD: P.I.
 $\Delta = 2^{\circ}14'$ RT
 STA. 1690+49
 FD P.K.NAIL
 7/11/85, MB
 SET P.K./WASHER
 10/1/85, SWH
 FD P.K.NAIL
 8/1/02, MB
 SET MAG/WASHER
 GPS, NEWREF102
 7/7/15, JFO

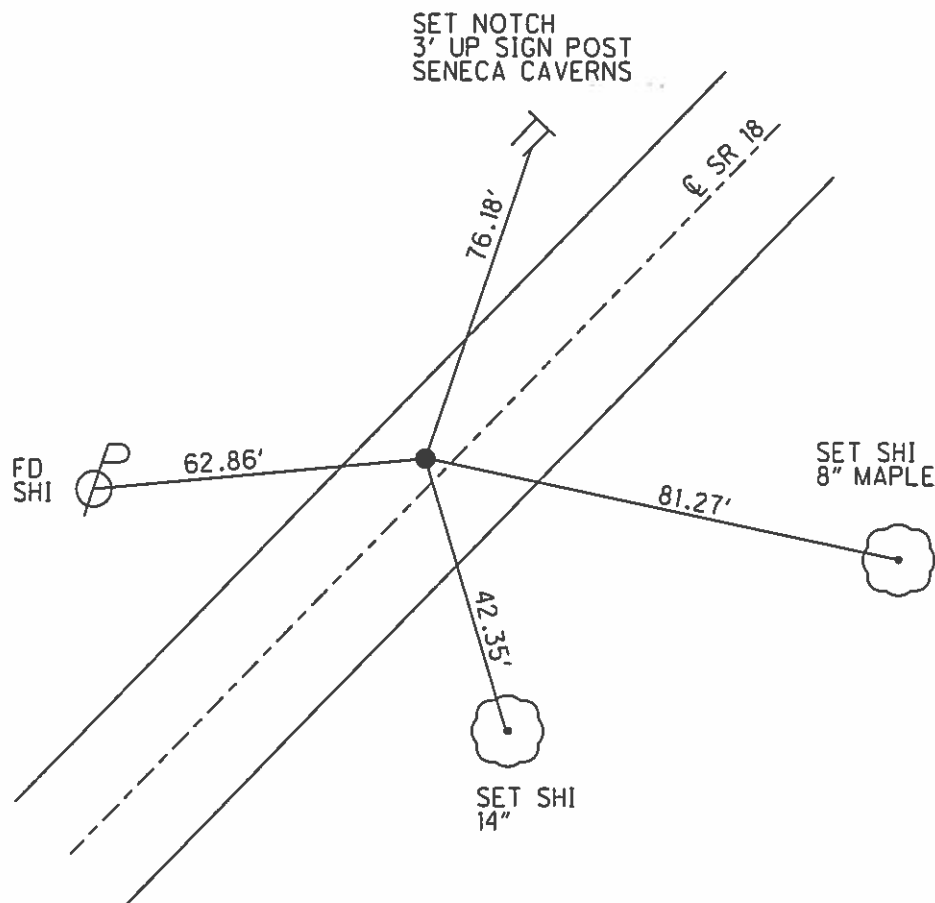


O.D.O.T. DISTRICT 2 SURVEY OFFICE (USE ONLY)


PERSONNEL _____ REFERENCE NO. 103 SHEET 10 OF 18
NOTES RHOADES DATE 4/16/15 ROUTE SR 18
H.C. O'DONNELL WEATHER OVERCAST/WINDY COUNTY SENECA
R.C. RHOADES TEMP. 60° TOWNSHIP THOMPSON
SECTION 9
T 3 N R 17 E

TYPE MONUMENT P.K./WASHER
ON SURFACE - ~~BELOW~~ ON _____
LEFT - ℄ PAV'T - ~~RIGHT~~ 2.1'
8.8' TO LT EDGE PAVEMENT
S.L.M. 1707+73.31

Grid: Northing: 570204.786 Easting: 1856953.637

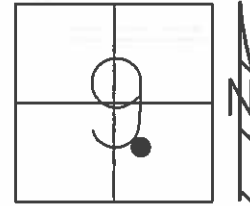

RECORD:
STA. 1710+03
FD P.K./WASHER
7/11/85, MB
SET P.K./WASHER
10/1/85, SWH
FD P.K./WASHER
8/1/02, MB
SET MAG/WASHER
GPS, NEWREF103
7/7/15, JFO


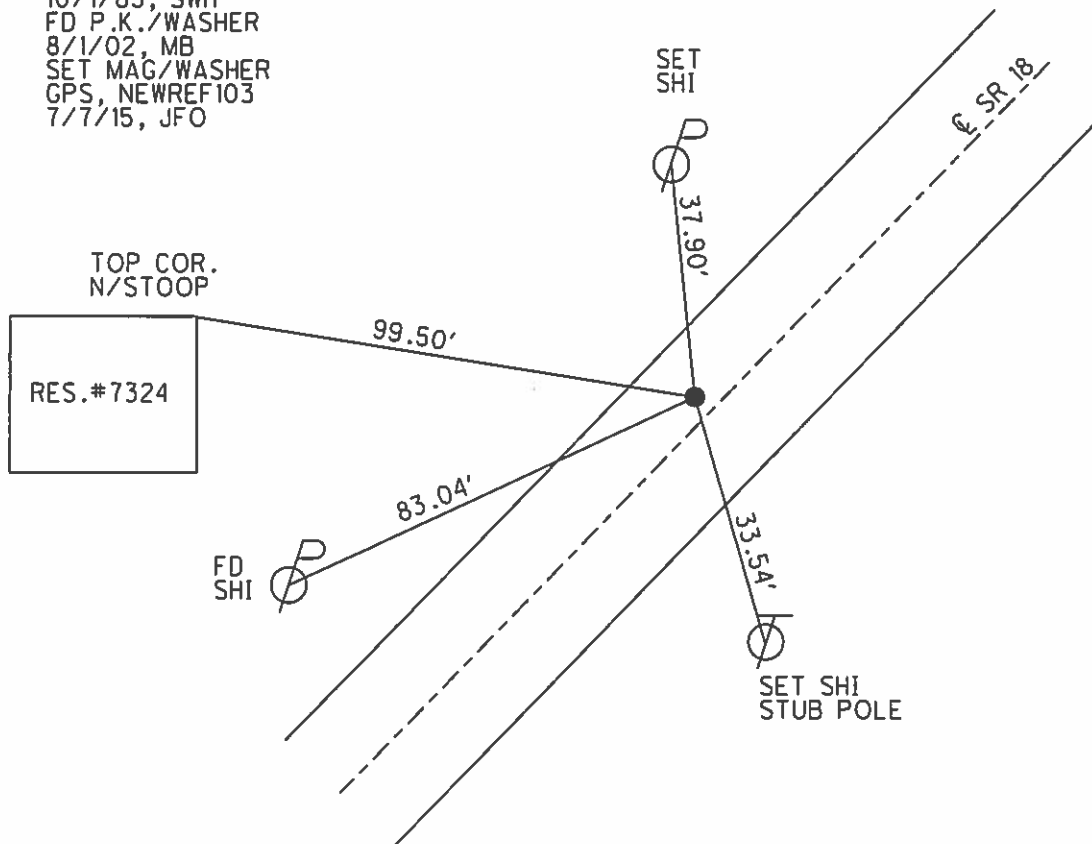


O.D.O.T. DISTRICT 2 SURVEY OFFICE (USE ONLY)

PERSONNEL	REFERENCE NO.	<u>104</u>	SHEET	<u>11</u>	OF	<u>18</u>
NOTES	<u>RHOADES</u>	DATE	<u>4/16/15</u>	ROUTE	<u>SR 18</u>	
H.C.	<u>O'DONNELL</u>	WEATHER	<u>OVERCAST/WINDY</u>	COUNTY	<u>SENECA</u>	
R.C.	<u>RHOADES</u>	TEMP.	<u>60°</u>	TOWNSHIP	<u>THOMPSON</u>	
				SECTION	<u>10</u>	
				T	<u>3</u>	R
				N	<u>17</u>	E

TYPE MONUMENT P.K.NAIL
~~ON SURFACE~~ - BELOW 0.3'
 LEFT - Q PAV'T - ~~RIGHT~~ 0.5'
 - TO - EDGE PAVEMENT
 S.L.M. 1735+83.55

Grid: Northing: 572188.988 Easting: 1858943.829

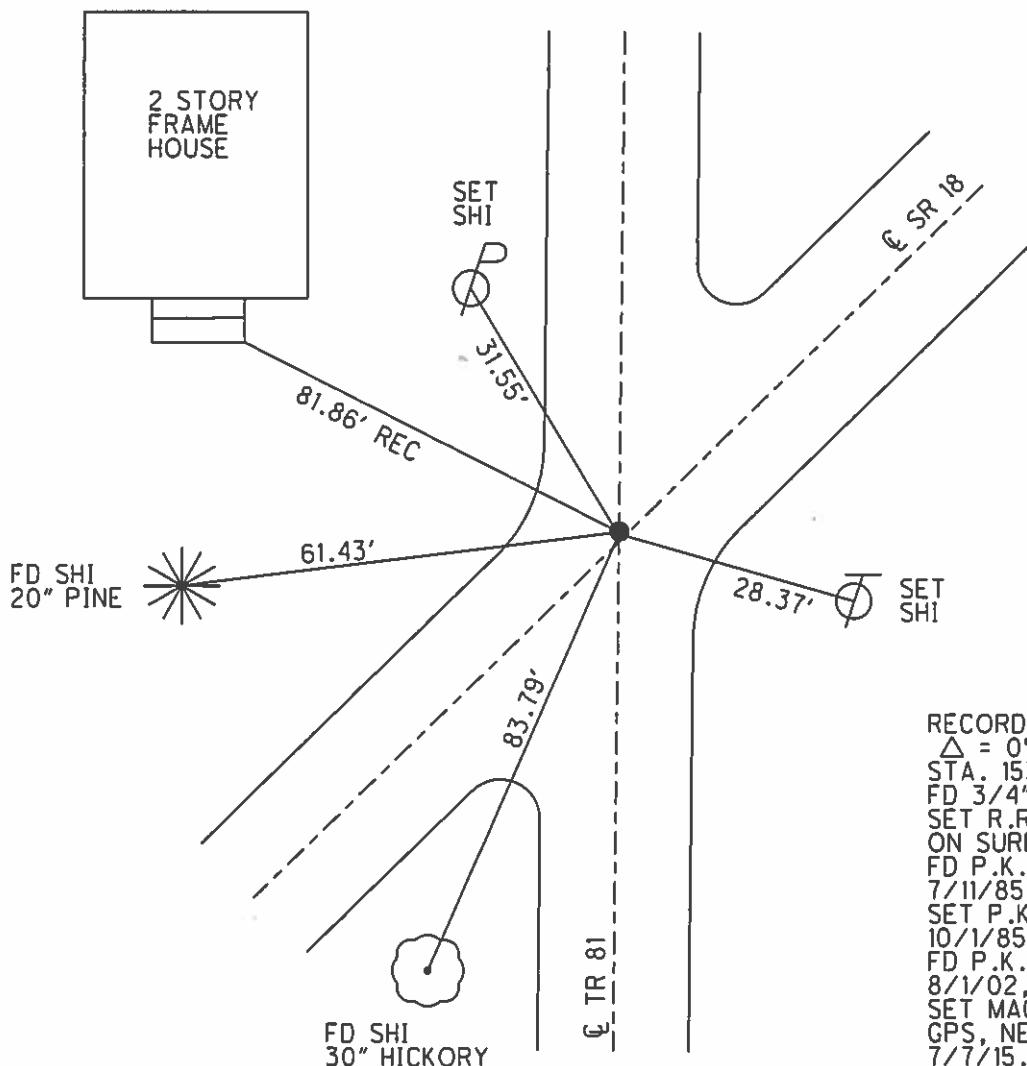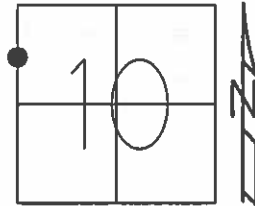

RECORD: P.I.
 $\Delta = 0^{\circ}06' RT$
 STA. 153+34.60
 FD 3/4" IPIN
 SET R.R.SPIKE
 ON SURFACE.
 FD P.K.NAIL
 7/11/85, MB
 SET P.K./WASHER
 10/1/85, SWH
 FD P.K.NAIL
 8/1/02, MB
 SET MAG/WASHER
 GPS, NEWREF104
 7/7/15, JFO

O.D.O.T. DISTRICT 2 SURVEY OFFICE (USE ONLY)

PERSONNEL

REFERENCE NO.

105

SHEET 12 OF 18

NOTES RHOADES

DATE _____

4/16/15

ROUTE SR 18

H.C. O'DONNELL

WEATHER OVERCAST/WINDY

CITY OF SENeca

R.C.	RHOADES
------	---------

TEMP. 60°

TOWNSHIP THOMPSON

SECTION 3

T3N R17E

TYPE MONUMENT R.R.SPIKE


~~ON SURFACE~~ - BELOW 3"

~~LEFT~~ - C PAV'T - RIGHT 0.5'

____TO____EDGE PAVEMENT

S.L.M. 1758+78.80

Grid: Northing: 576806.613 Easting: 1860571.999

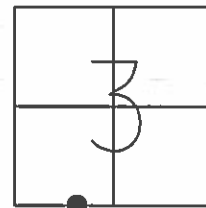

RECORD:

FD R,R,SPIKE

7/11/85, MB

SET P.K./WASHER

10/1/85, SWH

FD SM.R.R.SPIKE


3" DOWN

8/1/02, MB
SET 1102 44

SET MAG/WASHER
PSC NEWBEE105

GPS, NEWREF105

7/7/15, JFO

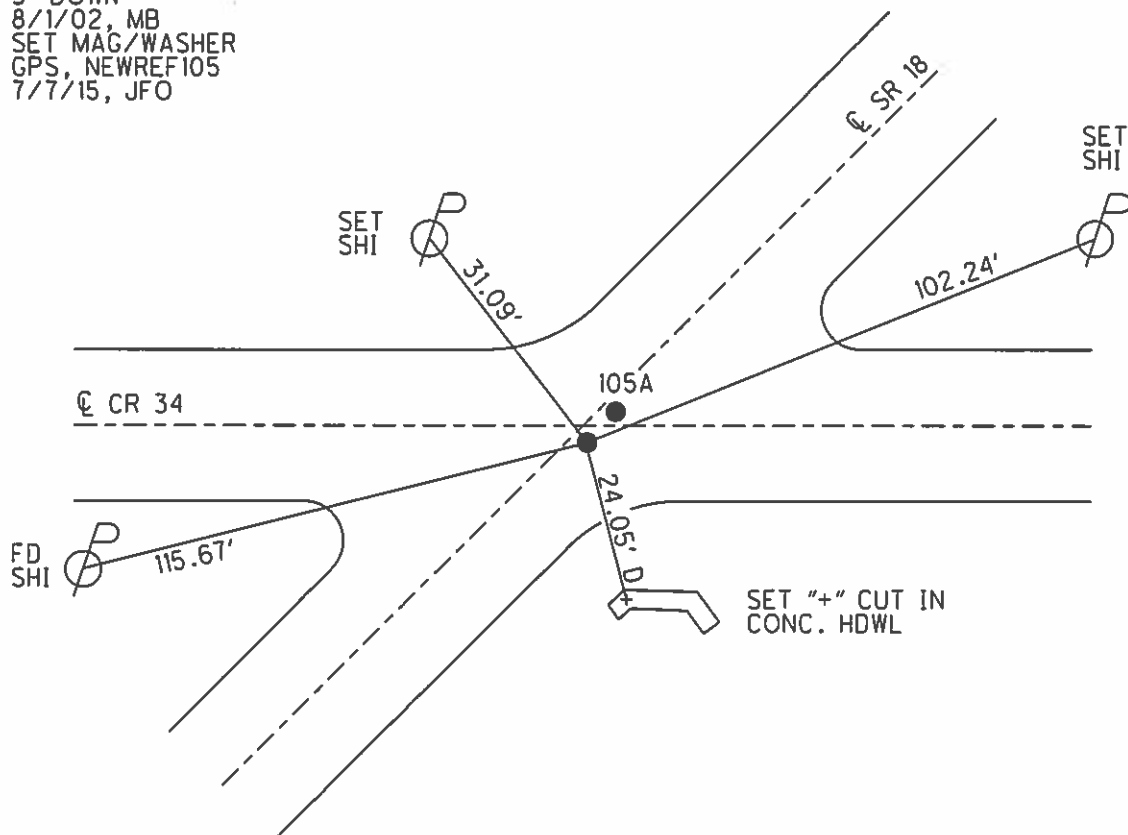


O.D.O.T. DISTRICT 2 SURVEY OFFICE (USE ONLY)


PERSONNEL _____ REFERENCE NO. 106 SHEET 14 OF 18
NOTES RHOADES DATE 4/16/15 ROUTE SR 18
H.C. O'DONNELL WEATHER OVERCAST/WINDY COUNTY SENECA
R.C. RHOADES TEMP. 60° TOWNSHIP THOMPSON
SECTION 3
T 3 N R 17 E

TYPE MONUMENT R.R.SPIKE
ON SURFACE - BELOW 0.3'
LEFT - Q PAV'T - RIGHT ON
8.7' TO LT EDGE PAVEMENT
S.L.M. 1760+94.10

Grid: Northing: 573958.473 Easting: 1860724.699

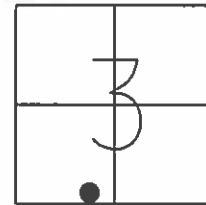

RECORD: P.I.
 $\Delta = 0^\circ 53' \text{ RT}$
STA. 25+00.45
FD 3/4" IPIN
SET R.R.SPIKE
ON SURFACE
FD R.R.SPIKE
7/11/85, MB
SET P.K./WASHER
10/1/85, SWH
FD P.K./WASHER
8/1/02, MB
SET MAG/WASHER
GPS, NEWREF106
7/7/15, JFO

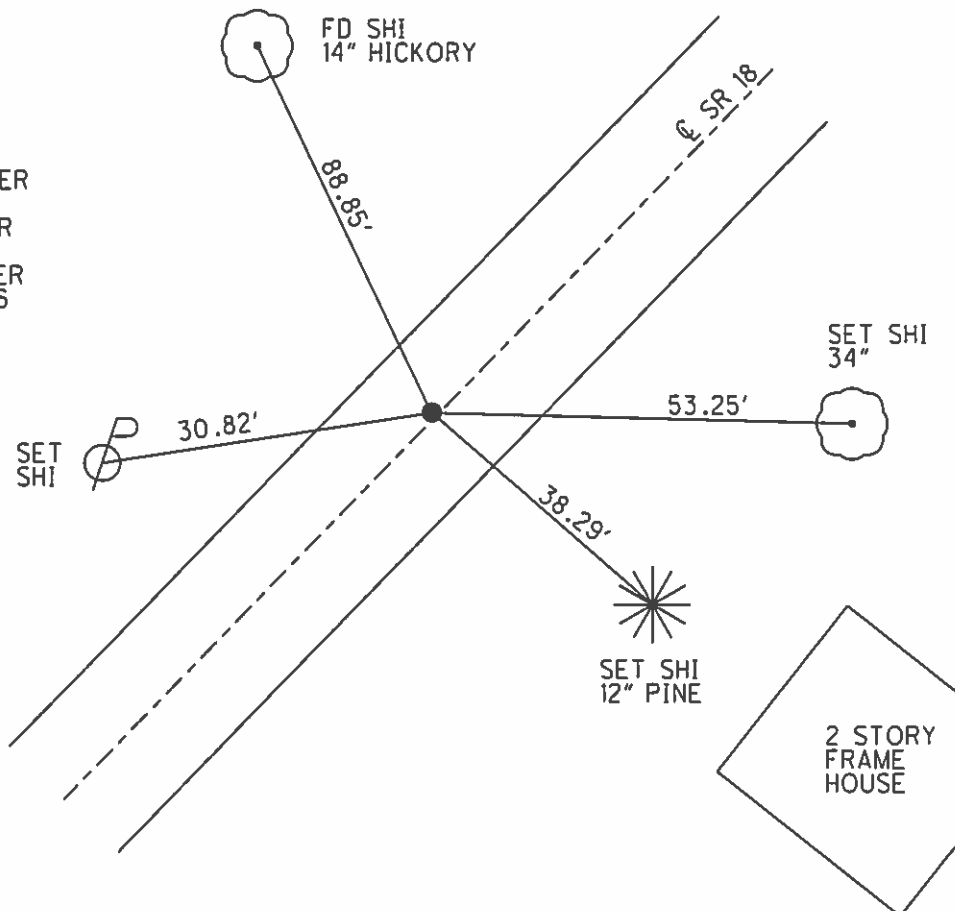


O.D.O.T. DISTRICT 2 SURVEY OFFICE (USE ONLY)


PERSONNEL	REFERENCE NO.	107	SHEET	15	OF	18
NOTES	RHOADES	DATE	4/16/15	ROUTE	SR 18	
H.C.	O'DONNELL	WEATHER	OVERCAST/WINDY	COUNTY	SENECA	
R.C.	RHOADES	TEMP.	60°	TOWNSHIP	THOMPSON	
				SECTION	3	
				T	3	N
				R	17	E

TYPE MONUMENT P.K.NAIL
ON SURFACE - ~~BELOW~~ ON
LEFT - Q PAV'T - ~~RIGHT~~ 2.4'
8.8' TO LT EDGE PAVEMENT
S.L.M. 1770+94.70

Grid: Northing: 574652.313 Easting: 1861445.679

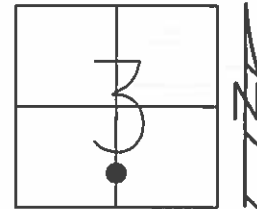

RECORD: P.I.
 $\Delta = 0^\circ 40' \text{ RT}$
STA. 35+01.20
FD R.R.SPIKE
SET R.R.SPIKE
ON SURFACE.
FD R.R.SPIKE
7/11/85, MB
SET P.K./WASHER
10/1/85, SWH
FD P.K./WASHER
8/1/02, MB
SET MAG/WASHER
GPS, NEWREF107
7/7/15, JFO

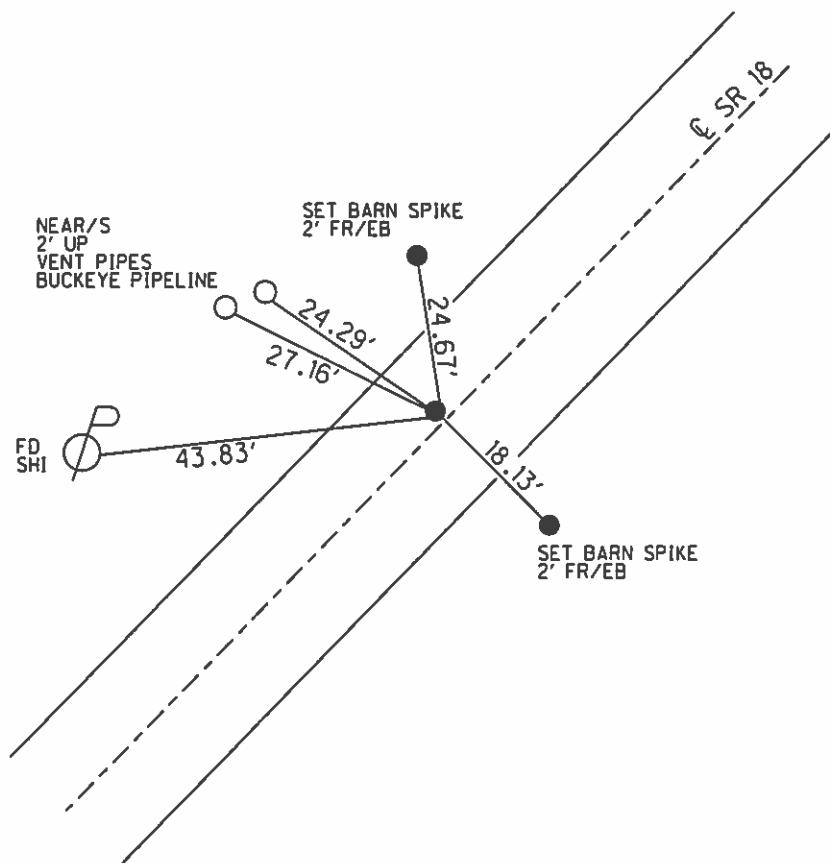


O.D.O.T. DISTRICT 2 SURVEY OFFICE (USE ONLY)


PERSONNEL	REFERENCE NO. <u>108</u>	SHEET <u>16</u> OF <u>18</u>	
NOTES	DATE <u>4/16/15</u>	ROUTE <u>SR 18</u>	
H.C. <u>RHOADES</u>	WEATHER <u>OVERCAST/WINDY</u>	COUNTY <u>SENECA</u>	
R.C. <u>O'DONNELL</u>	TEMP. <u>60°</u>	TOWNSHIP <u>THOMPSON</u>	
		SECTION <u>3</u>	
		T <u>3</u> N R <u>17</u> E	

TYPE MONUMENT P.K.NAIL
 ON SURFACE - ~~BELOW~~ ON
~~LEFT~~ - C PAV'T - RIGHT 0.7'
11.0' TO LT EDGE PAVEMENT
 S.L.M. 1790+95.98

Grid: Northing: 576023.081 Easting: 1862903.839

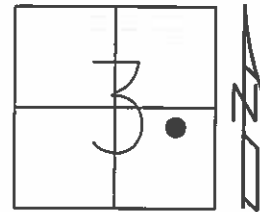


RECORD: P.I.
 $\Delta = 0^{\circ}05' \text{ LT}$
 STA. 55+02.15
 FD 3/4" IPIN
 SET R.R.SPIKE
 ON SURFACE.
 FD R.R.SPIKE
 7/11/85, MB
 SET P.K./WASHER
 10/1/85, SWH
 FD P.K./NAIL
 8/1/02, MB
 SET MAG/WASHER
 GPS, NEWREF108
 7/7/15, JFO

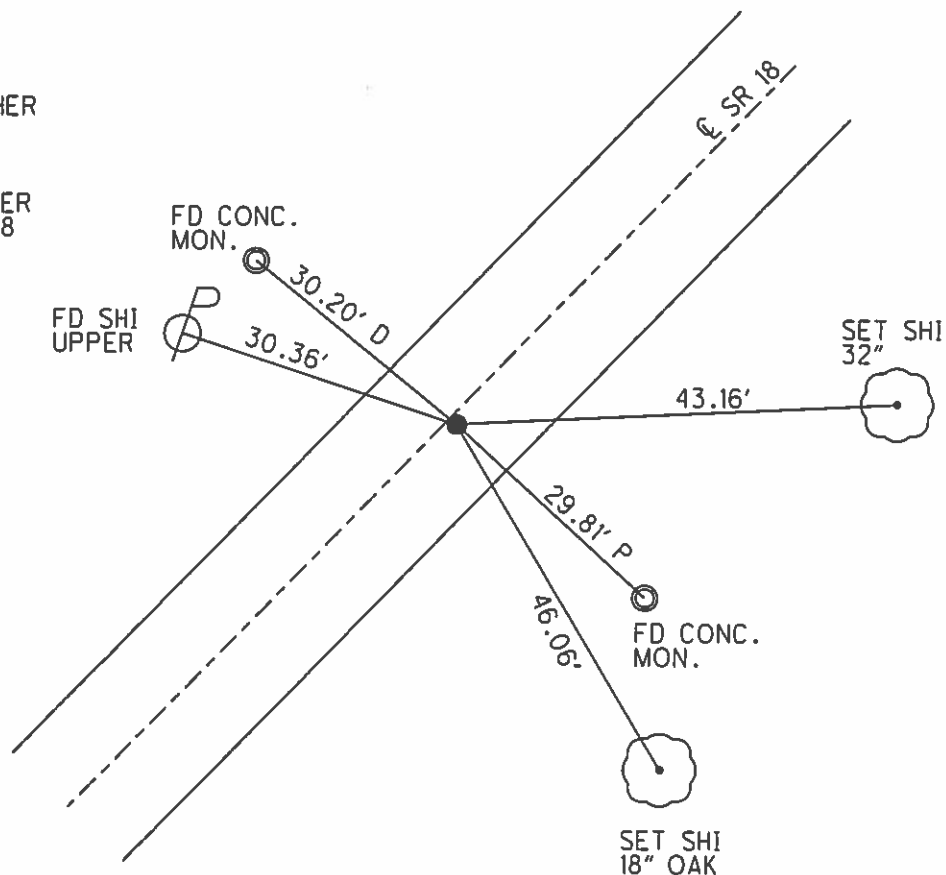

O.D.O.T. DISTRICT 2 SURVEY OFFICE (USE ONLY)


PERSONNEL _____ REFERENCE NO. 109 SHEET 17 OF 18
 NOTES RHOADES DATE 4/16/15 ROUTE SR 18
 H.C. WESTFALL WEATHER OVERCAST/WINDY COUNTY SENECA
 R.C. O'DONNELL TEMP. 60° TOWNSHIP THOMPSON
 _____ SECTION 2
 _____ T 3 N R 17 E

TYPE MONUMENT P.K.NAIL
 ON SURFACE - ~~BELOW~~ ON
~~LEFT~~ - CL PAV'T - RIGHT 0.7'
 - TO - EDGE PAVEMENT
 S.L.M. 1811+17.28

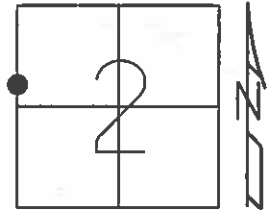

Grid: Northing: 577409.573 Easting: 1864374.352


RECORD: P.O.T.
 STA. 75+03.15
 FD R.R.SPIKE
 7/11/85, MB
 SET P.K./WASHER
 10/1/85, SWH
 FD P.K./WASHER
 8/1/02, MB
 SET MAG/WASHER
 GPS, NEWREF109
 7/7/15, JFO

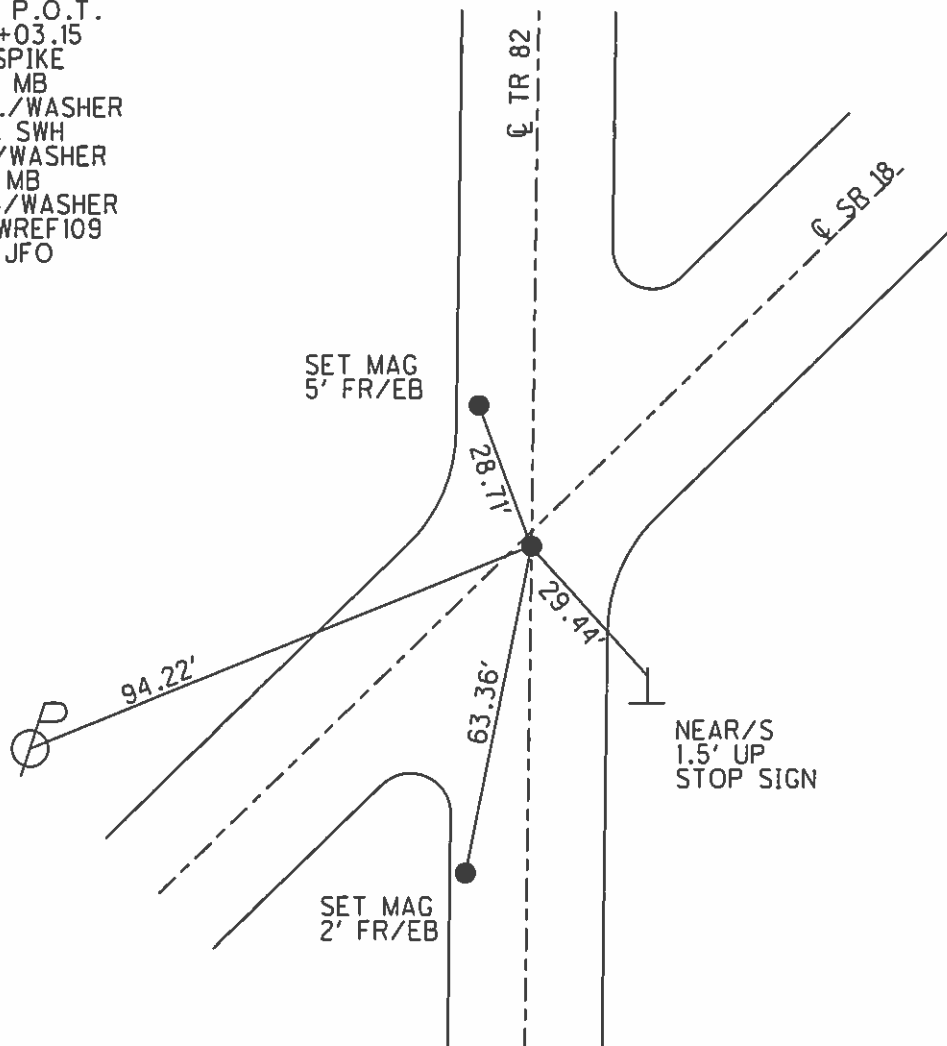

PERSONNEL _____ REFERENCE NO. 109 A SHEET 18 OF 18
 NOTES RHOADES DATE 4/16/15 ROUTE SR 18
 H.C. WESTFALL WEATHER OVERCAST/WINDY COUNTY SENECA
 R.C. O'DONNELL TEMP. 60° TOWNSHIP THOMPSON
 _____ SECTION 2
 _____ T 3 N R 17 E

Grid: Northing: 579095.396 Easting: 1866161.202


R.R.SPIKE
R.R.SPIKE
SET P.K./WASHER
9/16/91, CHENEY
FD P.K./WASHER
8/1/02, MB
4/16/15, JFO
GPS, REFA109

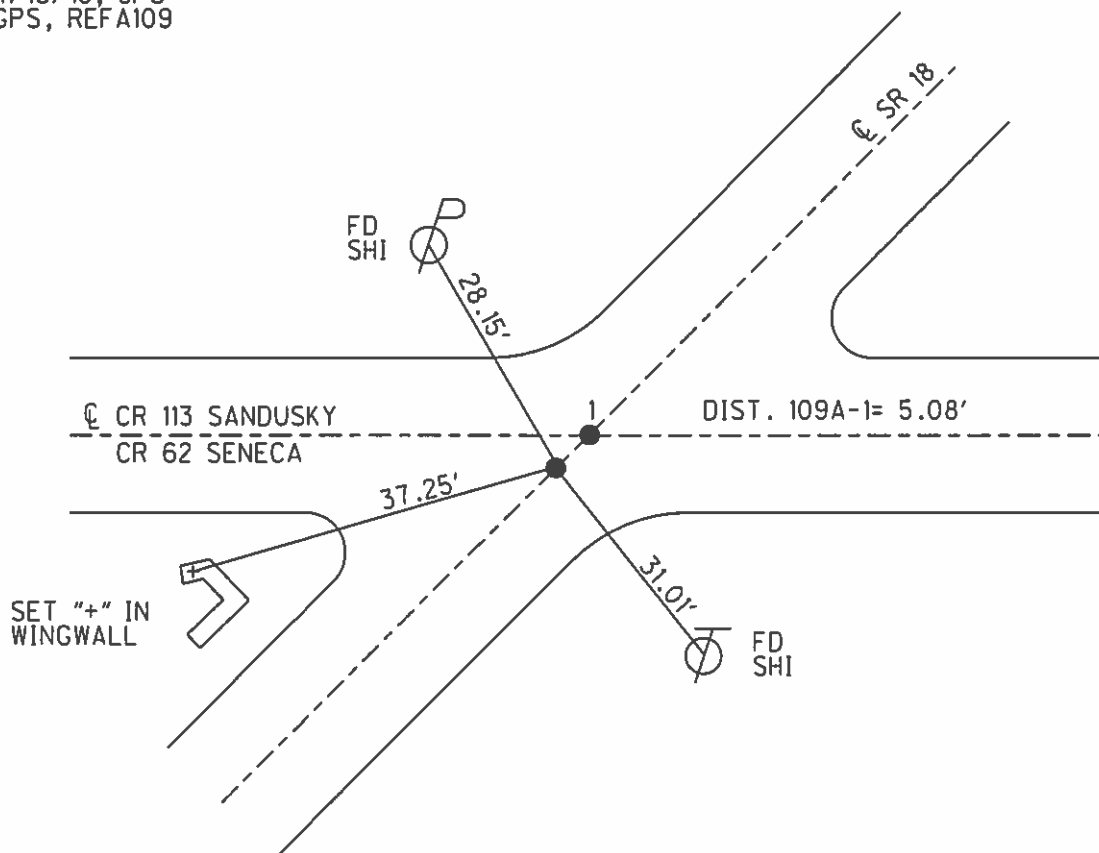

O.D.O.T. DISTRICT 2 SURVEY OFFICE (USE ONLY)

PERSONNEL _____ REFERENCE NO. 1 SHEET 1 OF 5
 NOTES RHOADES DATE 4/16/15 ROUTE SR 18
 H.C. WESTFALL WEATHER OVERCAST/WINDY COUNTY SANDUSKY
 R.C. O'DONNELL TEMP. 60° TOWNSHIP YORK
 SECTION 35
 T 4 N R 17 E

TYPE MONUMENT P.K./WASHER
 ON SURFACE - ~~BELOW~~ ON _____
 LEFT - ℄ PAV'T - ~~RIGHT~~ 1.5'
 - TO - EDGE PAVEMENT
 S.L.M. 0+00, (1835+78.80 - SR 18)

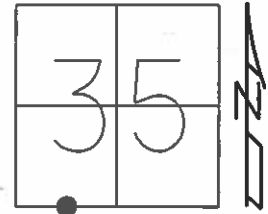

Grid: Northing: 579098.721 Easting: 1866165.020

PREVIOUS MONUMENTS:
 R.R.SPIKE
 R.R.SPIKE
 IRON PIN
 SET P.K./WASHER
 9/16/91, CHENEY
 FD P.K./WASHER
 8/1/02, MB
 4/16/15, JFO
 GPS, REF1

