

O.D.O.T. DISTRICT 2 SURVEY OFFICE (USE ONLY)

PERSONNEL

REFERENCE NO. 1

SHEET OF

NOTES ASTON

DATE 4/5/24

ROUTE SR 18

H.C. NIESE

WEATHER BREEZY

COUNTY SENECA

R.C. MILLER

TEMP. 37°

TOWNSHIP LOUDON

RHODES

SECTION 8

DWG BY BARRIERE

PID 92371

T 2 N R 13 E

TYPE MONUMENT PK NAIL

ON SURFACE - BELOW 1.5" DOWN

OFFSET $\odot$ PAVEMENT LT : RT

 TO EDGE PAVEMENT

STATION: 100+19.70

HORZ.DATUM: NAD83 (2011)


GEOID: 18

GRID: NORTHING: 540438.983

EASTING: 1721355.349


LDP: NORTHING:

EASTING:

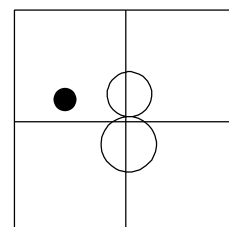

RECORD:
STA 87+93.95

FD P.K./WASHER
ATOP R.R. SPIKE
FD P.K./WASHER
7/10/97, MRC
SET P.K./WASHER
9/10/97, MRC
FD PK SHANK
REF1
9/21/22, TDN
FD PK NAIL
1 1/2" DOWN
4/5/24, TDN

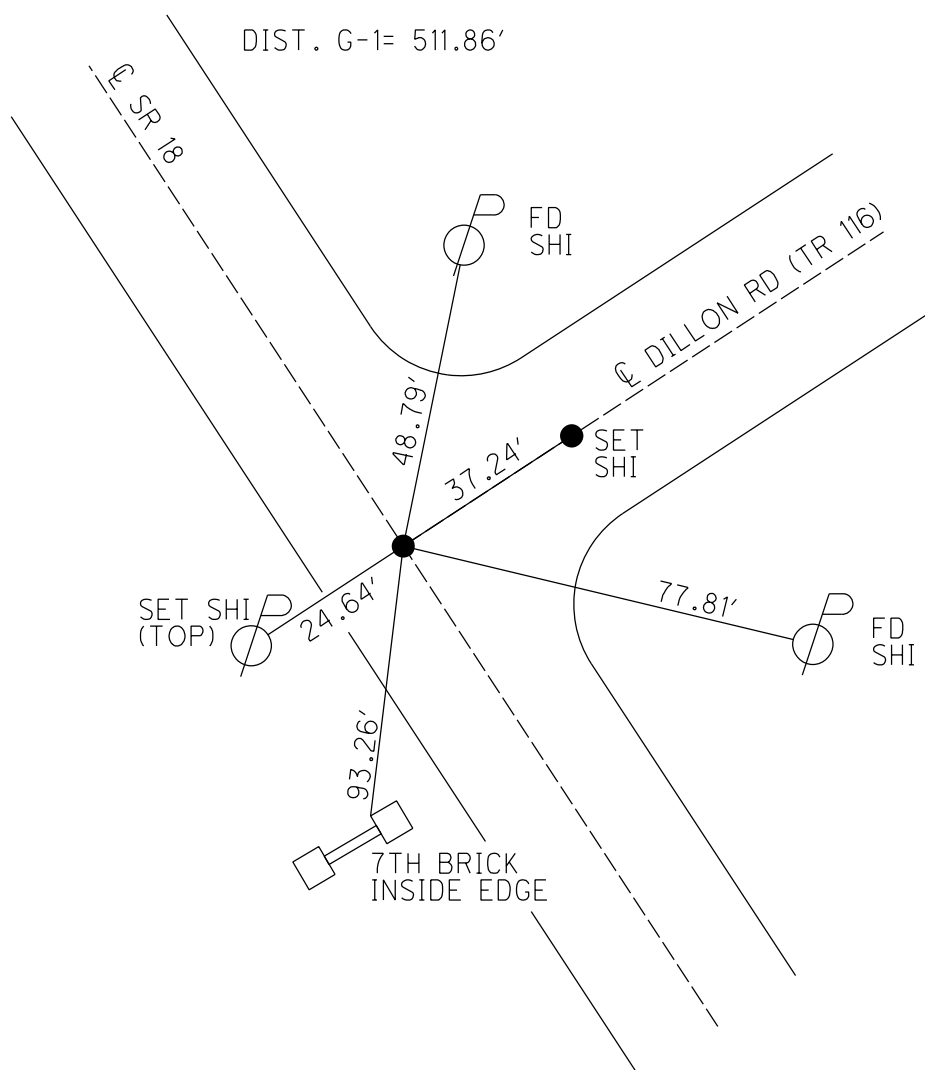

O.D.O.T. DISTRICT 2 SURVEY OFFICE (USE ONLY)

PERSONNEL

REFERENCE NO. 1

SHEET 1 OF 6

NOTES BARNHISEL

DATE 7/10/97

ROUTE SR 18

H.C. CANTERBURY

WEATHER CLOUDY

COUNTY SENECA

R.C. WEAVER

TEMP. 70°

TOWNSHIP LOUDON

ROUSOS

SECTION 8

DWG BY NIESE

PID

T 2 N R 13 E

TYPE MONUMENT P.K./WASHER

ON SURFACE - ~~BELOW~~ ON

OFFSET Q PAVEMENT ON LT : RT

11.8' TO RT EDGE PAVEMENT



STATION: 100+19.70

HORZ.DATUM:

GEOID:

GRID: NORTHING:

EASTING:

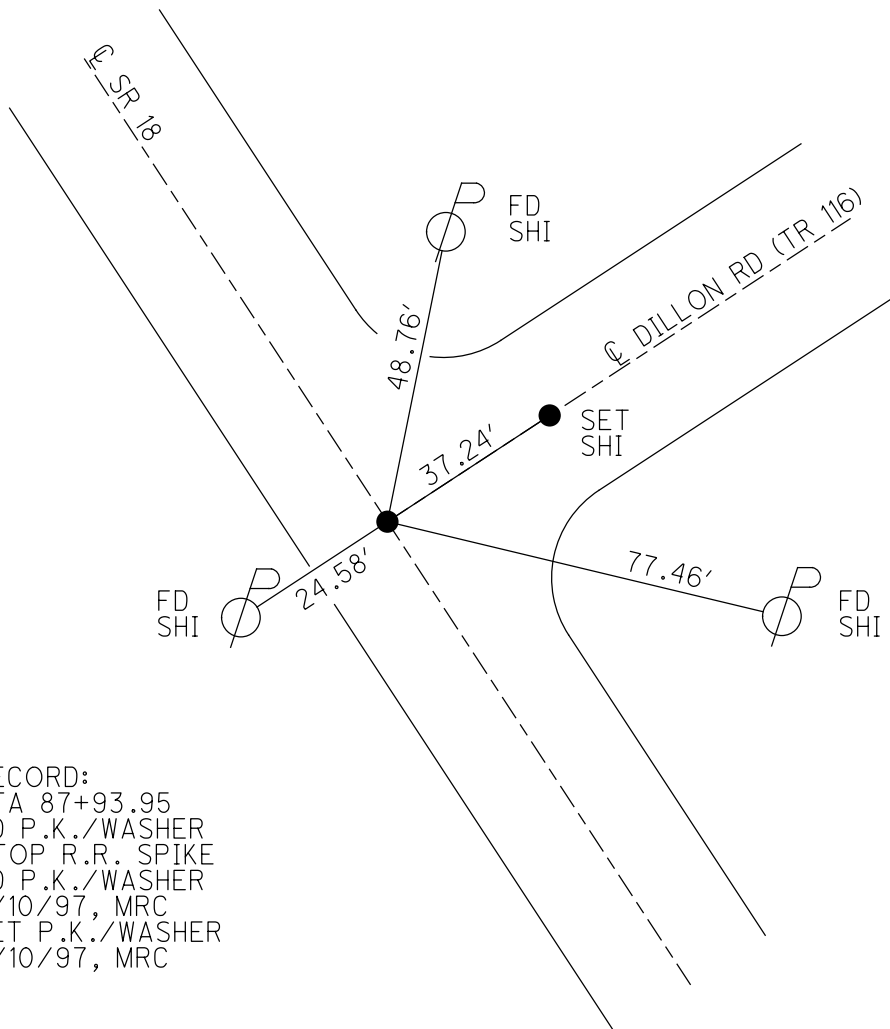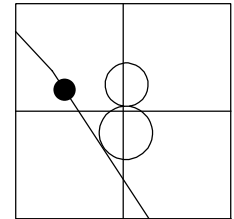

RECORD:
STA 87+93.95
FD P.K./WASHER
ATOP R.R. SPIKE
FD P.K./WASHER
7/10/97, MRC
SET P.K./WASHER
9/10/97, MRC

O.D.O.T. DISTRICT 2 SURVEY OFFICE

PERSONNEL

REFERENCE NO. 1

SHEET 1 OF 22

NOTES BARNHISEL

H.C. CANTERBURY

R.C. WEAVER

P ROUSOS

DRAWING — CANTERBURY

DATE 7-10-97

WEATHER CLOUDY

TEMP. +70°

ROUTE #18

COUNTY SENECA

TOWNSHIP LOUDON

SECTION 8

T Z N R 1 3


TYPE MONUMENT P.K. & WASHER

ON SURFACE - BELOW SURFACE


LEFT - C PAV'T. - RIGHT ON E

11.8 TO RT. EDGE PAVEMENT

S.L.M. 3+054

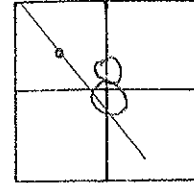

RESET P.K. & WASHER
9/10/97 M.R.C.

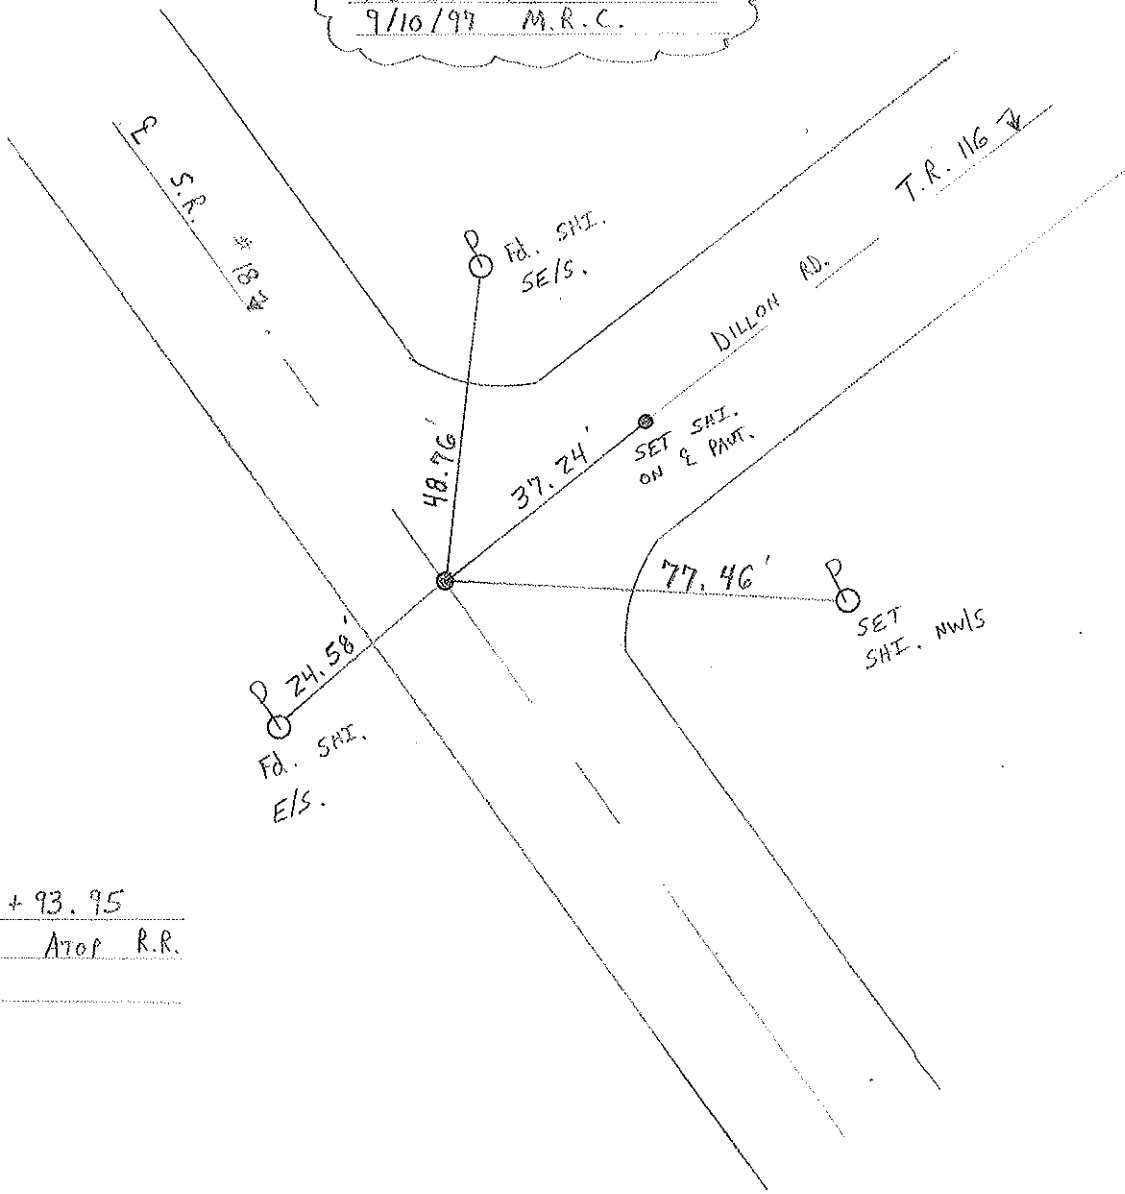

RECORD: 87+93.95
P.K. & WASHER ATOP R.R.
SPK.

Resurfaced 1997

O.D.O.T. DISTRICT 2 SURVEY OFFICE

PERSONNEL

REFERENCE NO. 1

SHEET 1 OF

NOTES CRONIN (DRAW)

DRAWN 1/16/90

H.C. RIPPLE

DATE 11/10/87

R.C. BARBOUR MEAS.

WEATHER OVERCAST

GEYMAN

TEMP. 28°

ROUTE #18

COUNTY SENECA

TOWNSHIP LOUDON

SECTION 8

T. 2 N. R. 13




TYPE MONUMENT P.K. & WASHER

ON SURFACE - BELOW

LEFT - & PAV'T. - RIGHT

TO EDGE PAVEMENT

S.L.M.

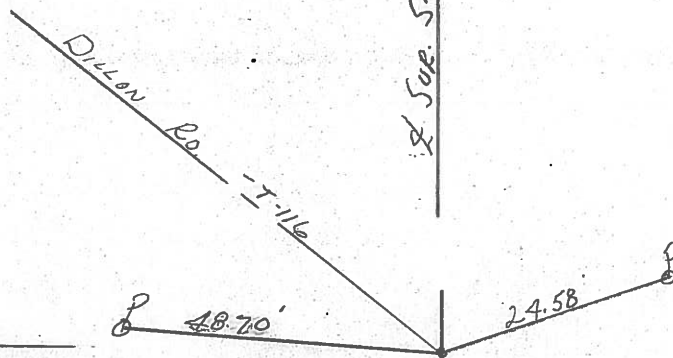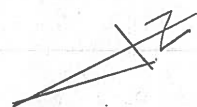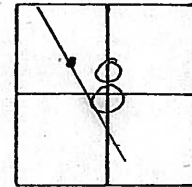


87+93.95

P.K. & WASHER ATOP R.R.

SPIKE

PERSONNEL	TITLE	PERSONNEL	TITLE	COUNTY	DATE
Schneider				Seneca	10-15-68
Mosser				S. R. 18	WEATHER Fair - windy
Barbour				SEC. Eastoria to Bascom	TEMP. 70°
Potts					

DESCRIPTION Ties for Control Points JOB NO. _____

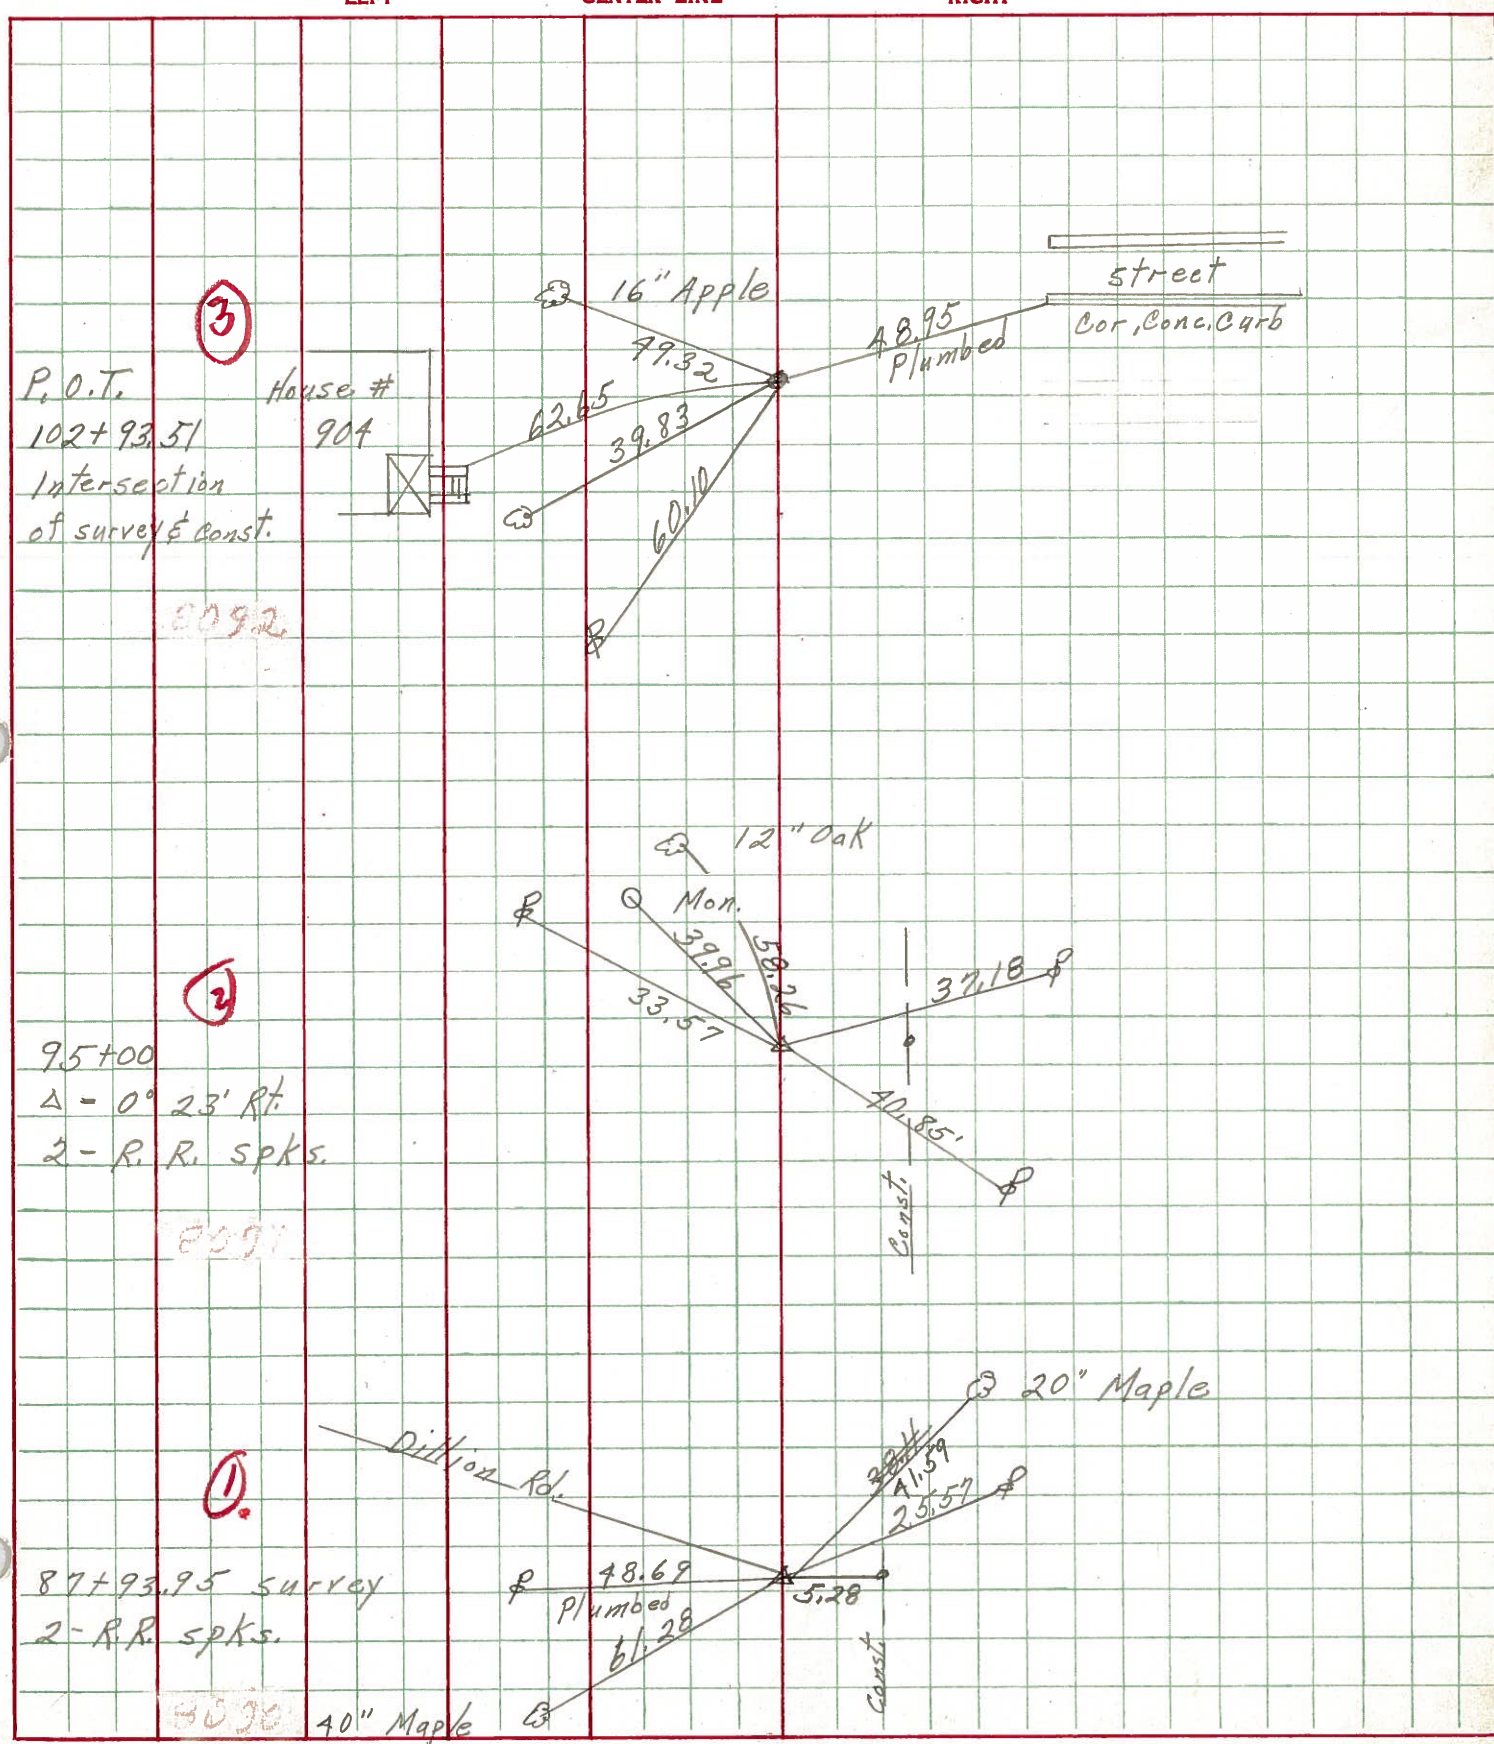

PERSONNEL TITLE PERSONNEL TITLE
 CRONIN + CREW

COUNTY SENECA

DATE 9-27-65

S. R. #18 FOSTORIA-BASCON Rd.
 WEATHER

SEC. SEN. 18- (1.79-8.60) TEMP.

DESCRIPTION Control Point TIES - & SURVEY + CONST. JOB NO.


LEFT

CENTER LINE

RIGHT

③


ONTOP
 STA. 102+93.51 P.O.T.
 R.R. Spk.
 & SURVEY + CONST.
 "X" Intersection

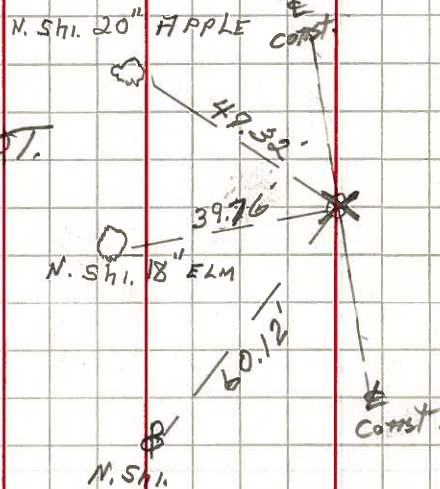

STA 102+93.51 P.O.T.
 R.R. Spk.
 "X" Intersection of
 & CONST + SURVEY

②


8/16/71
 1/2" below surface
 P.I. = 95+00 SURVEY
 $\Delta = 0^\circ - 23' RT$
 R.R. Spk. (I.P.?)
 Corp. LITTO

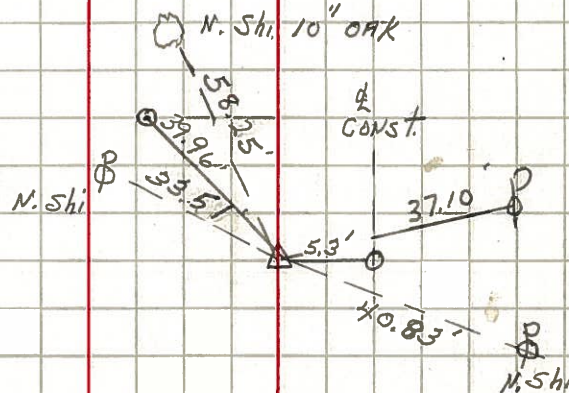

P.O.T. 95+00 CONST.
 R.R. Spk.

①

8/16/71
 Set P.K. Nail atop
 STA. 87+93.95 SURVEY
 R.R. Spk.
 Intersection SR #18 + DILLON Rd.

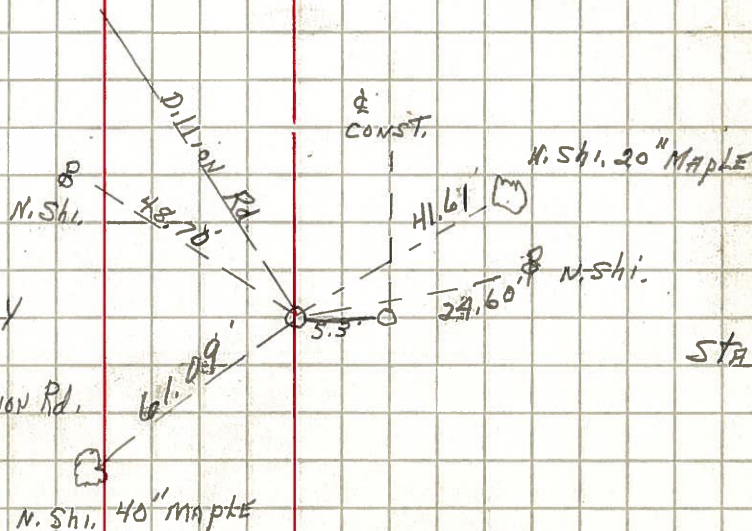

STA 87+93.95 CONST.
 R.R. Spk.

PERSONNEL TITLE PERSONNEL TITLE

Hsh

COUNTY Seneca

DATE Nov. 12, '58

Cronin

S. R. #18 Foster-Bascom Rd. WEATHER Clear

Ripple

Leemaster

SEC. 577-18-(1.79-8.60) TEMP. 50°

DESCRIPTION

Control Point ties - Survey & Const.

JOB NO.

LEFT

CENTER LINE Survey

RIGHT

Sta. 102+93.51 P.O.T.

P.K. Nail & Shi.

"X" Intersection of
Survey & Const.Found R.R. Spk.
checked by Cronin & Crew
9/27/58

N. Shi. 20" Maple

9-1-59 P.R. Spk.

N. Shi. 18" Elm

N. Shi.

Sta. 102+93.51 P.O.T.

P.K. Nail & Shi.

"X" Intersection of
Const. & SurveyFound RR Spk.
9/27/58 checked by
Cronin & Crew

9-1-59 P.R. Spk.

9-1-59 P.R. Spk.

P.I. = 95+00 Survey

 $\Delta = 0^\circ - 23' \text{ Rt.}$

I.P.

P.O.T. 95+00 Const.

P.K. Nail & Shi.

Sta. 87+93.95 Survey

P.R. Spk. (Nail & Shi.)

Intersection S.R. #18 & Dillon Rd.

N. Shi.

N. Shi. 20" Maple

N. Shi. 20" Maple

9-1-59 P.R. Spk.

Sta. 87+93.95 Const.

Found R.R. Spk.
9-27-58 checked by
Cronin & Crew

PERSONNEL	TITLE	PERSONNEL	TITLE
R. Darr			
R. Zeyen			
H. Ward			

COUNTY Seneca (Fosteria) DATE 2-20-58

S. R. 18 WEATHER Clear & Mild

SEC. _____ TEMP. +25°

DESCRIPTION Ties for points on Columbus Ave. from Lytle St. to S.E. JOB NO. _____

