

O.D.O.T. DISTRICT 2 SURVEY OFFICE (USE ONLY)

PERSONNEL

REFERENCE NO. A3

SHEET OF

NOTES MILLER

DATE 8/5/24

ROUTE SR 18

H.C. NIESE

WEATHER BREEZY

COUNTY SENECA

R.C. PRESTON-COLVIN

TEMP. 80°

TOWNSHIP LOUDON

ASTON

SECTION 8

DWG BY BARRIERE

PID 92371

T 2 N R 13 E

TYPE MONUMENT MAG NAIL

ON SURFACE - BELOW ON

OFFSET Q PAVEMENT 8.3' RT LT : RT

 TO EDGE PAVEMENT

STATION: 128+14.63

HORZ.DATUM: NAD83 (2011)


GEOID: 18

GRID: NORTHING: 538067.681

EASTING: 1722847.906

LDP: NORTHING:


EASTING:

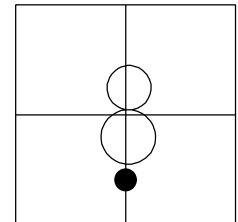

RECORD:
POINT UNKNOWN
FD P.K./WASHER
7/10/97, MRC
SET P.K./WASHER
9/10/97, MRC
FD PK WASHER
REFA3
9/21/22, TDN
FD PK
4/5/24, TDN
SET MAG/WASHER
8/5/24

DIST A3-4= 7.55'
DIST A3-3AA= 0.36'
DIST 3AA-4= 7.72'

RECORD:
UNKNOWN POINT
FD MAG NAIL
REF 3AA
4/5/24

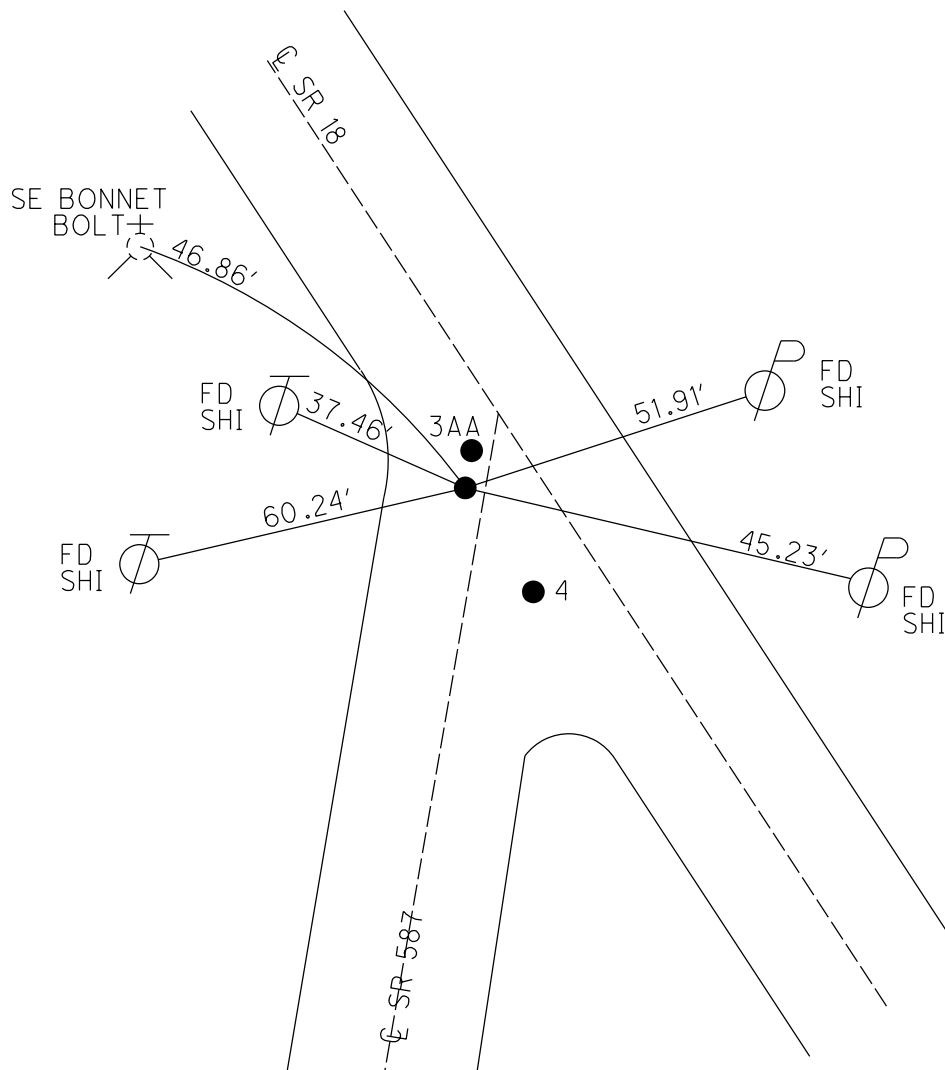

O.D.O.T. DISTRICT 2 SURVEY OFFICE (USE ONLY)

PERSONNEL

REFERENCE NO. 3 A

SHEET 4 OF 6

NOTES BARNHISEL

DATE 7/10/97

ROUTE SR 18

H.C. CANTERBURY

WEATHER CLOUDY

COUNTY SENECA

R.C. WEAVER

TEMP. 70°

TOWNSHIP LOUDON

ROUSOS

SECTION 8

DWG BY NIESE

PID _____

T 2 N R 13 E

TYPE MONUMENT P.K./WASHER

ON SURFACE - ~~BELOW~~ ON

OFFSET CL PAVEMENT 8.3' LT : RT

3.7' TO RT EDGE PAVEMENT


STATION: 128+14.63

HORZ.DATUM: _____


GEOID: _____

GRID: NORTHING: _____

EASTING: _____

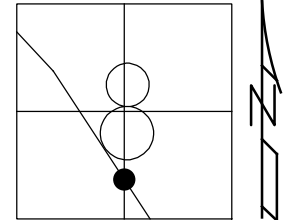

RECORD:
POINT UNKNOWN
FD P.K./WASHER
7/10/97, MRC
SET P.K./WASHER
9/10/97, MRC

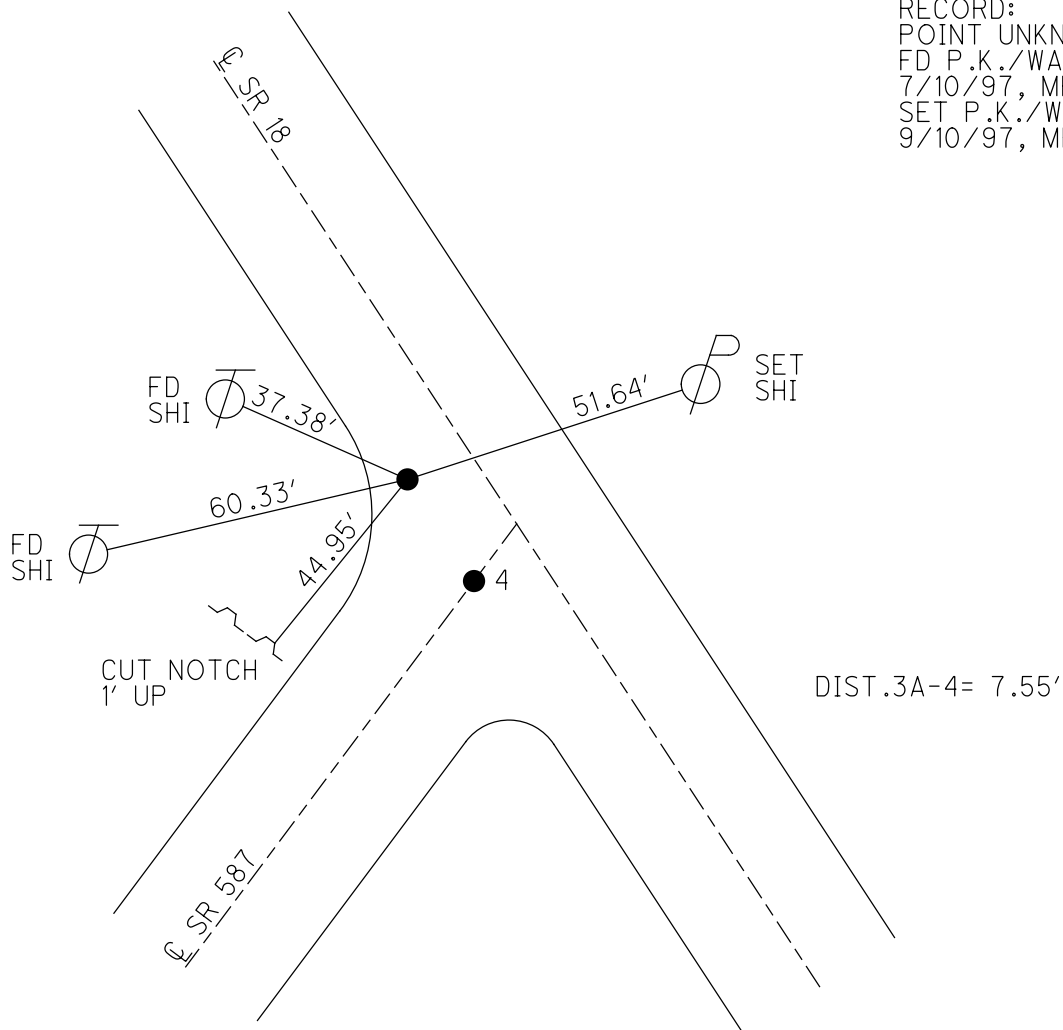

O.D.O.T. DISTRICT 2 SURVEY OFFICE

PERSONNEL

REFERENCE NO. 4

SHEET 4 OF 22

NOTES BARNHISEL

H.C. CANTERBURY

R.C. WEAVER

Rousos

DRAWING CANTERBURY

DATE 7/10/97

WEATHER CLOUDY

TEMP. +70°

ROUTE #18

COUNTY SENECA

TOWNSHIP LODON

SECTION 8

T Z N R 13 E


TYPE MONUMENT P.K. & WASHERS

ON SURFACE - BELOW SURFACE

LEFT - CL PAV'T. - RIGHT 8.3 RIGHT

3.7 TO RT EDGE PAVEMENT

S.L.M. 3+908.2

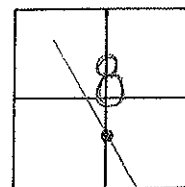


RESET P.K. & WASHERS

9/10/97 M.R.C.

RECORD:

P.I. 115+96.07

$\Delta = 00^{\circ} 47' 00''$ LT.

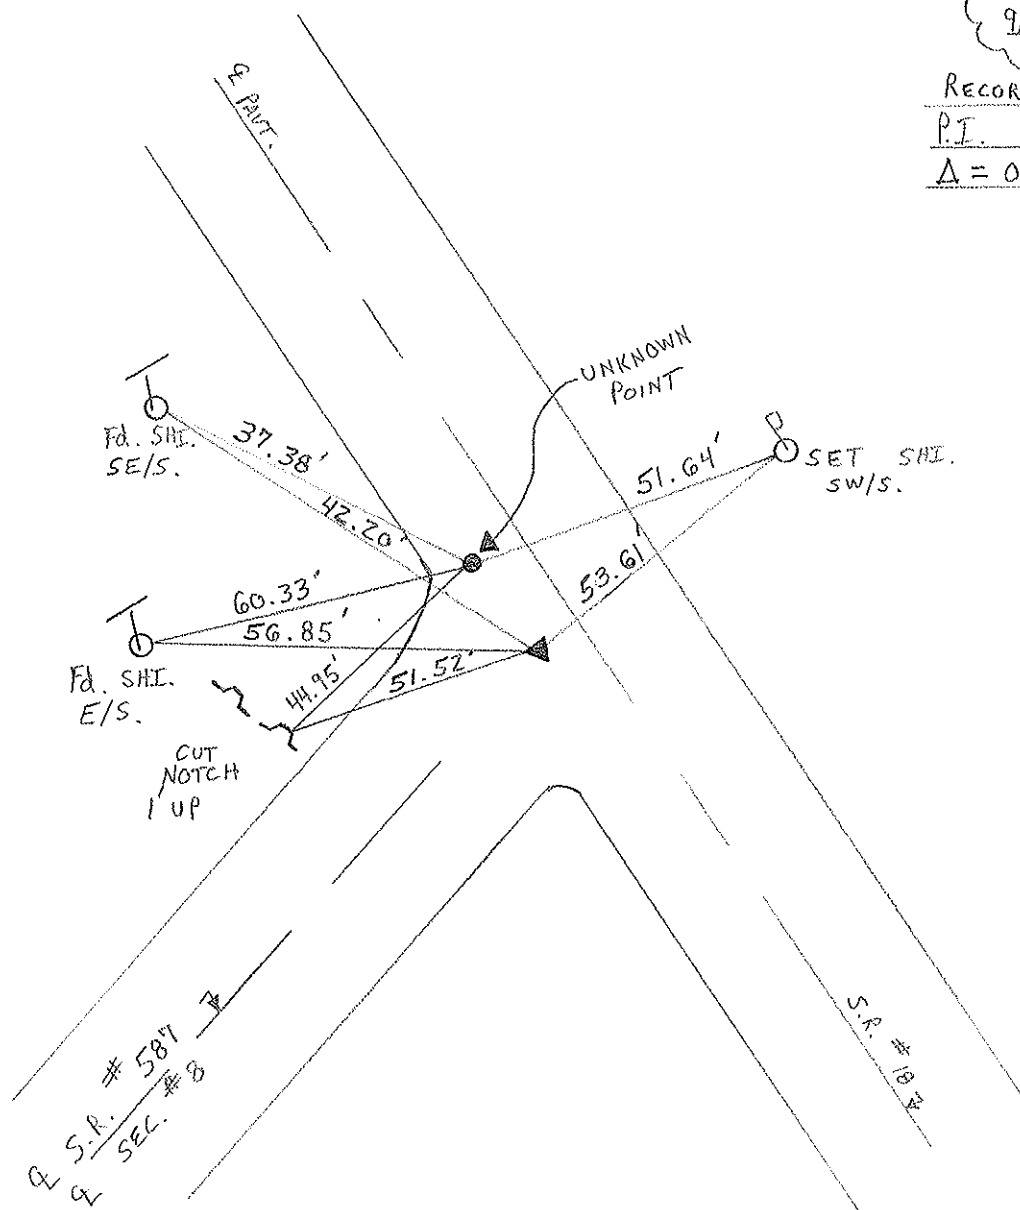

O.D.O.T. DISTRICT 2 SURVEY OFFICE

PERSONNEL

REFERENCE NO. 4

SHEET 4 OF

NOTES Cronin

H.C. RIPPLE

R.C. BARBOUR

GEYMAN

DATE 01/18/90

WEATHER OVERCAST - MIST

TEMP. 38°

ROUTE #18

COUNTY SENECA

TOWNSHIP LODDON

SECTION 8

T 2 N R 13 E


TYPE MONUMENT R.R SPIKE

ON SURFACE - BELOW 2'±

LEFT - ¢ PAV'T. - RIGHT 8.7±

 TO EDGE PAVEMENT


S.L.M.

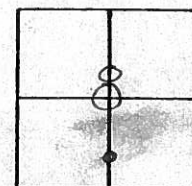

P.I. SURVEY

115+96.0±

A = 00°47'00" L

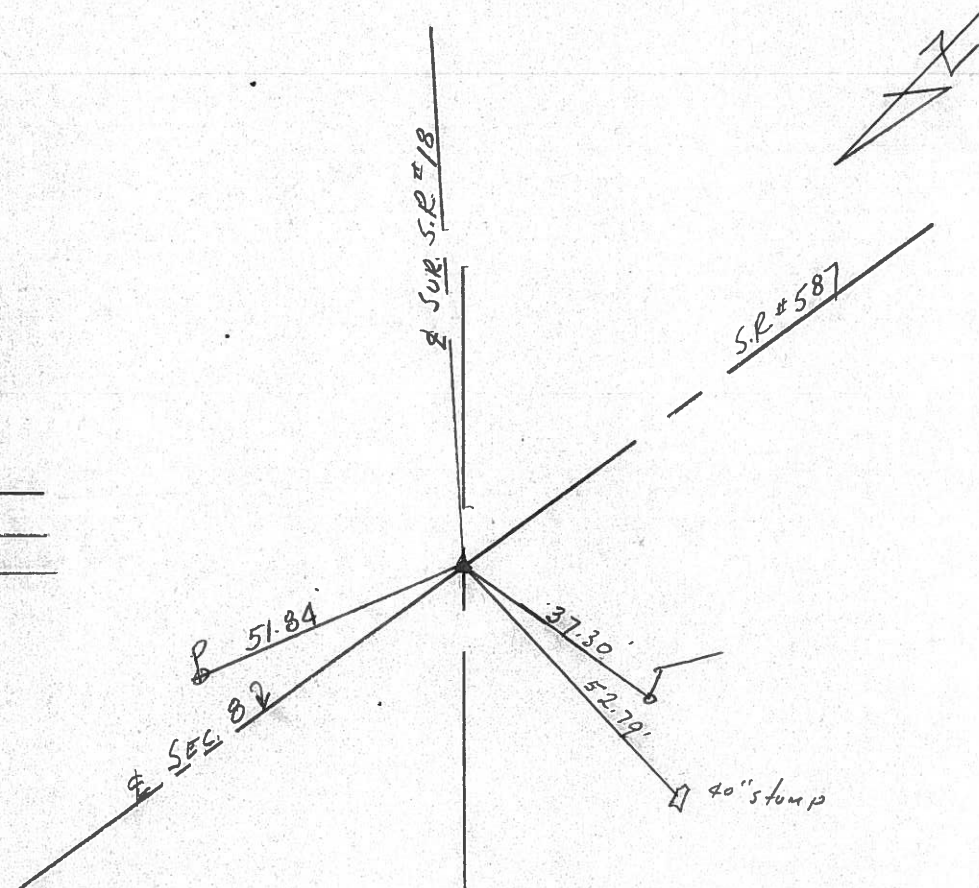

PERSONNEL TITLE PERSONNEL TITLE

COUNTY SARASOTA DATE 11-16-65S. R. 18 WEATHER Fair - windySEC. Eastern to Bascom TEMP. 70°

DESCRIPTION

Ties for Control Points

JOB NO.

LEFT


CENTER LINE

RIGHT

(6)

P.T.
142+40.63 survey
R.R. spk.


8095

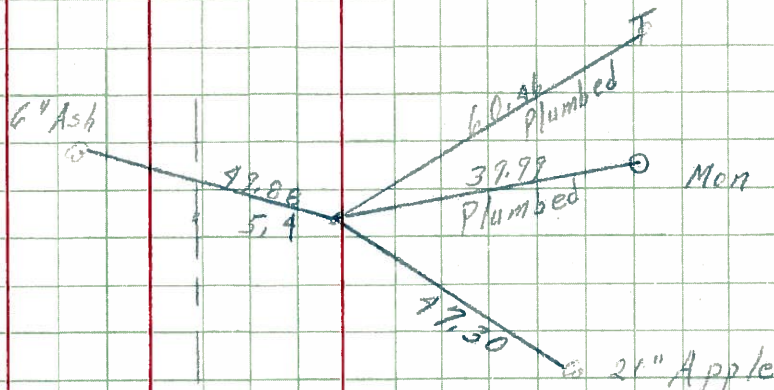

(5)

P.C.
122+98.63
R.R. spk.


8094

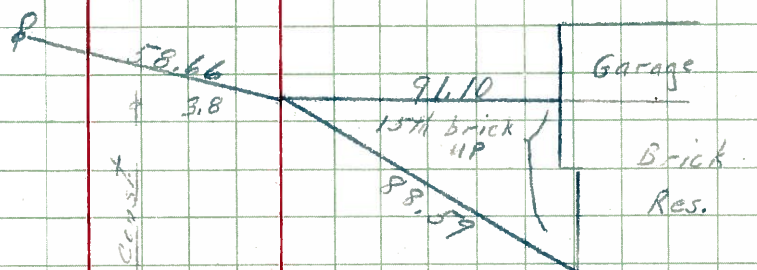

(4)

P.C.T.
115+96.02 & const. Bk.
3- R.R. spks.

8093

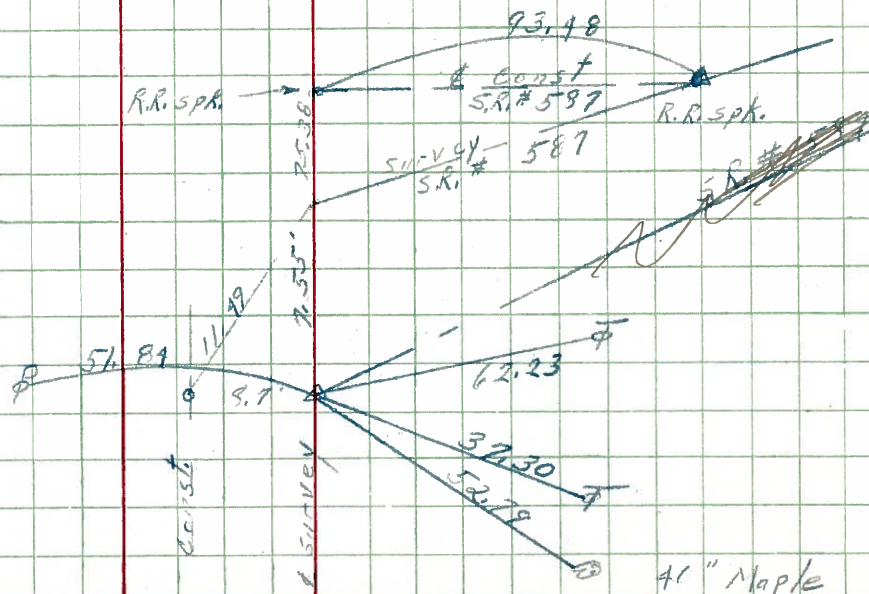

PERSONNEL TITLE PERSONNEL TITLE

Schneider

COUNTY Seneca DATE 10-16-68

Mosser

S. R. 18 WEATHER Fair - windy

Barbour

SEC. Fostoria to Boscom TEMP. 70°

Potts

DESCRIPTION


Ties for Control Points

JOB NO.

LEFT

CENTER LINE

RIGHT

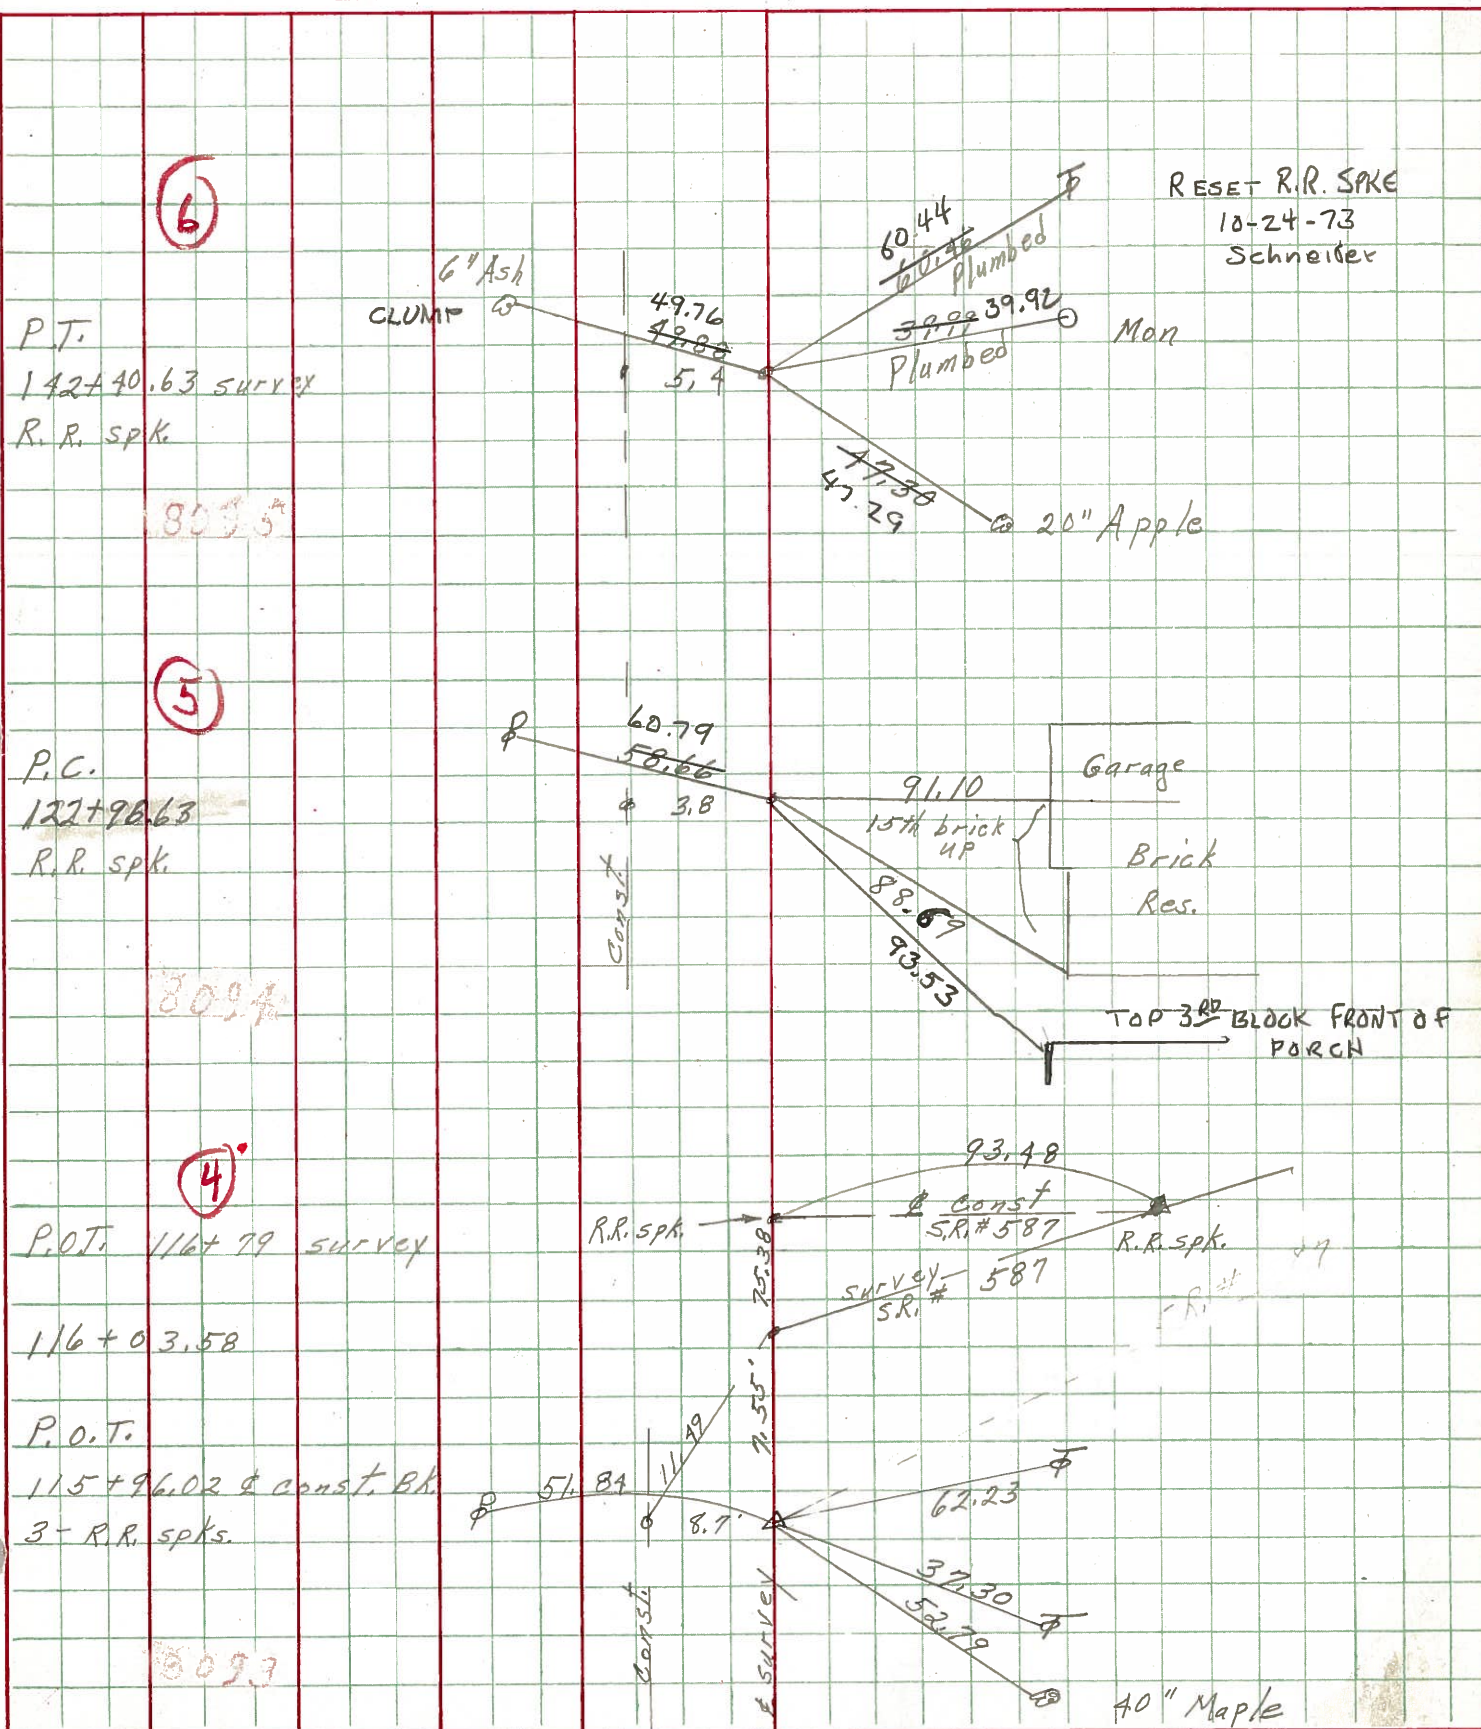

PERSONNEL TITLE PERSONNEL TITLE

Hsh
Cronin
RippleLeemaster
Lahr

COUNTY Seneca

DATE Nov. 12, '58

S. R. #18 Fortoria-Bascom Rd. WEATHER C/021

SEC. Sen.-18-(1.79-8.60) TEMP. 50°

DESCRIPTION

Control Point ties - Survey & Const.

JOB NO.

LEFT

CENTER LINE

Survey


RIGHT

9/12/65


Found. R.R. Spk & Sur. @ P.C.
checked by Cronin & Crew

(5)

Const. Curve

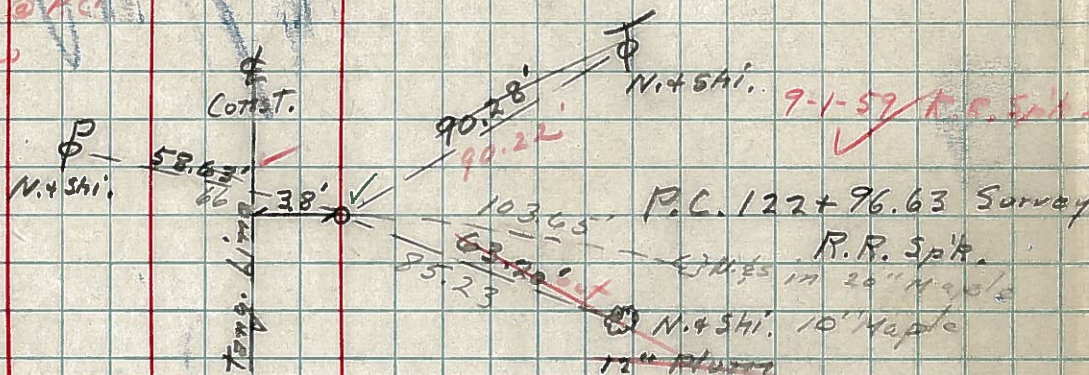

✓ 9-1-59 R.R. Spk.

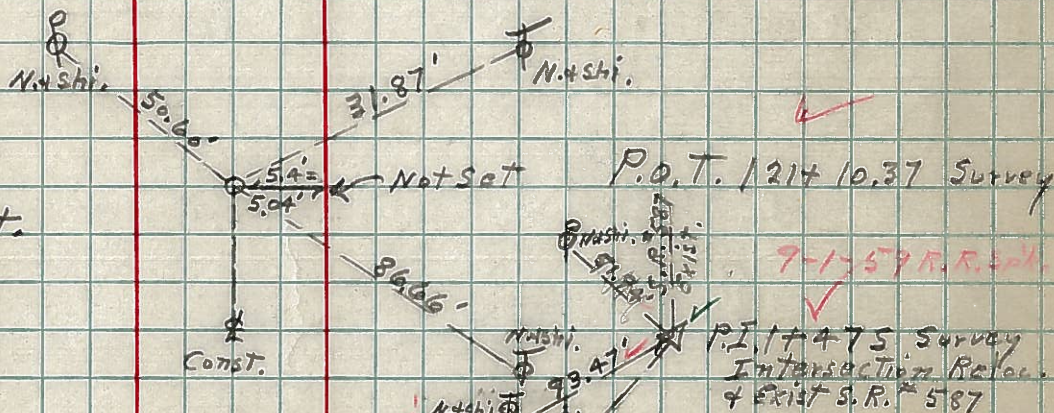T.S. 121+09.17 P.I. =
T.S. 121+10.37 Const.
P.K. Nail & Shi.

Const. Tang.

(4)

✓ 9-1-59 R.R. Spk.

P.O.T. 115+96.02 Const. Bk =
115+96.07 Const. Hhd.
P.K. Nail & Shi.