

O.D.O.T. DISTRICT 2 SURVEY OFFICE (USE ONLY)

PERSONNEL

REFERENCE NO. 5

SHEET OF

NOTES MILLER DATE 8/5/24

H.C. NIESE WEATHER CLOUDY

R.C. PRESTON-COLVIN TEMP. 80°

ASTON

DWG BY BARRIERE PID 92371

ROUTE SR 18

COUNTY SENECA

TOWNSHIP LOUDON

SECTION 8

T 2 N R 13 E

TYPE MONUMENT MAG NAIL/WASHER

ON SURFACE - BELOW ON

OFFSET Q PAVEMENT 5.1' RT LT : RT

 TO EDGE PAVEMENT

STATION: 128+22.18

HORZ.DATUM: NAD83 (2011)



GEOID: 18

GRID: NORTHING: 537479.312


EASTING: 1723227.806

LDP: NORTHING:

EASTING:

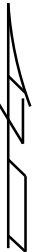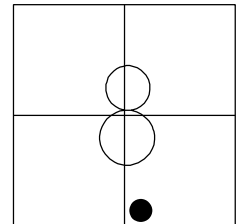

RECORD: P.C.
STA 122+96.63
FD R.R.SPIKE
4" DOWN
7/10/97, MRC
SET P.K./WASHER
9/10/97, MRC
FD PK/WASHER
REF5
9/21/22
SET MAG/WASHER
8/5/24, TDN

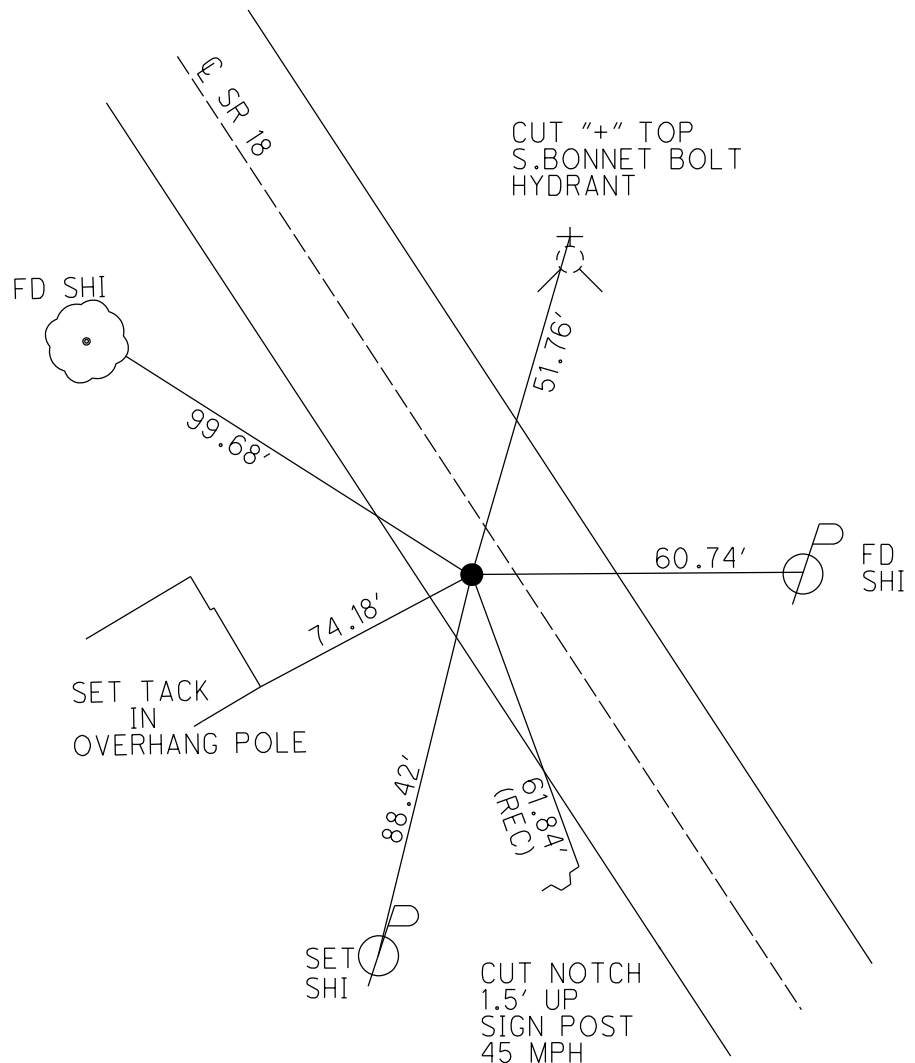

O.D.O.T. DISTRICT 2 SURVEY OFFICE (USE ONLY)

PERSONNEL

REFERENCE NO. 5

SHEET 6 OF 6

NOTES BARNHISEL

DATE 7/10/97

ROUTE SR 18

H.C. CANTERBURY

WEATHER SUNNY

COUNTY SENECA

R.C. WEAVER

TEMP. 75°

TOWNSHIP LOUDON

ROUSOS

SECTION 8

DWG BY NIESE

PID _____

T 2 N R 13 E

TYPE MONUMENT R.R. SPIKE

~~ON SURFACE~~ - BELOW 4"

OFFSET CL PAVEMENT 5.1' ~~LT~~ : RT

6.6' TO RT EDGE PAVEMENT



STATION: 135+22

HORIZ.DATUM: _____

GEOID: _____

GRID: NORTHING: _____

EASTING: _____

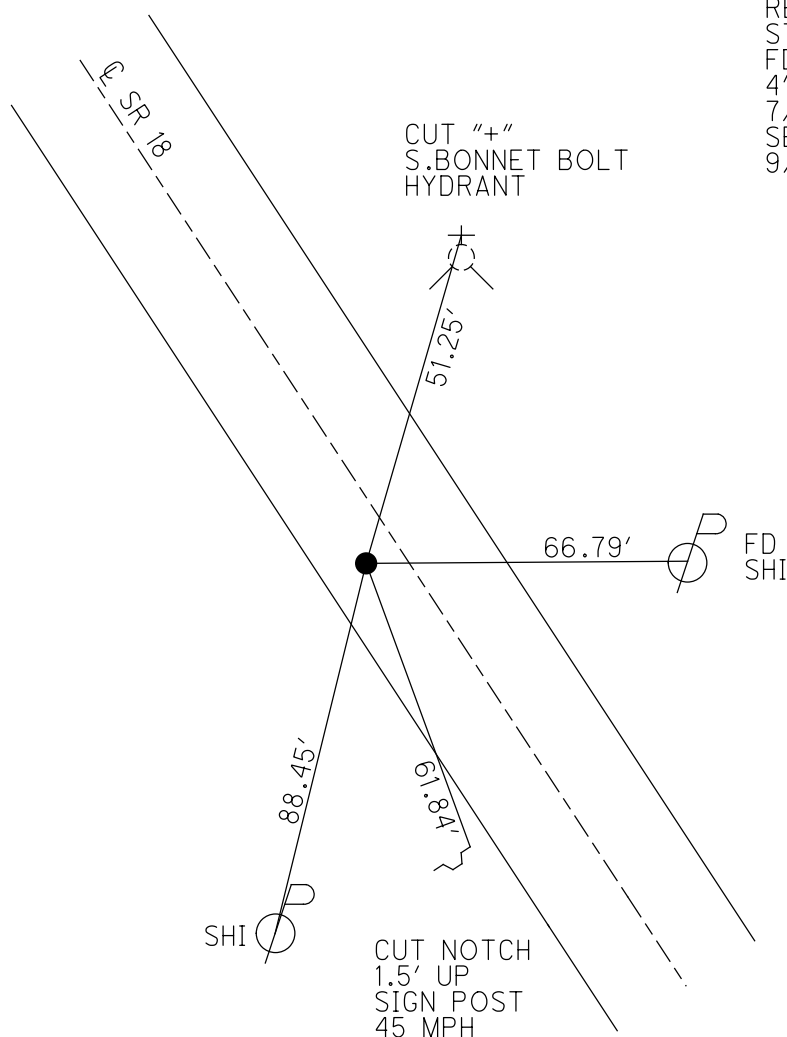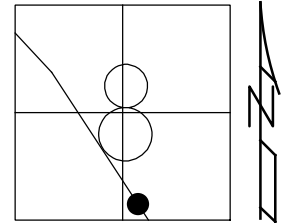

RECORD: P.C.
STA 122+96.63
FD R.R.SPIKE
4" DOWN
7/10/97, MRC
SET P.K./WASHER
9/10/97, MRC

O.D.O.T. DISTRICT 2 SURVEY OFFICE

PERSONNEL

REFERENCE NO. 5

SHEET 5 OF 22

NOTES Barnhart

H.C. CANTERBURY

R.C. WENGER

Rousos

Drawn BY Rousos

DATE 7-10-97

WEATHER Sunny

TEMP. +75°

ROUTE 18

COUNTY SENECA

TOWNSHIP LOUDON

SECTION 8

T. 2 N. R. 13 E.


TYPE MONUMENT R.D. SPIKE

ON SURFACE BELOW 4" BELOW

LEFT - CL PAV'T. - RIGHT 5.1 RT

6.6 TO RT. EDGE PAVEMENT


S.L.M. 4+121.6 SLK

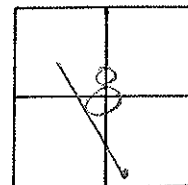

RESET PK/WASHER

9/10/97

M.R.C

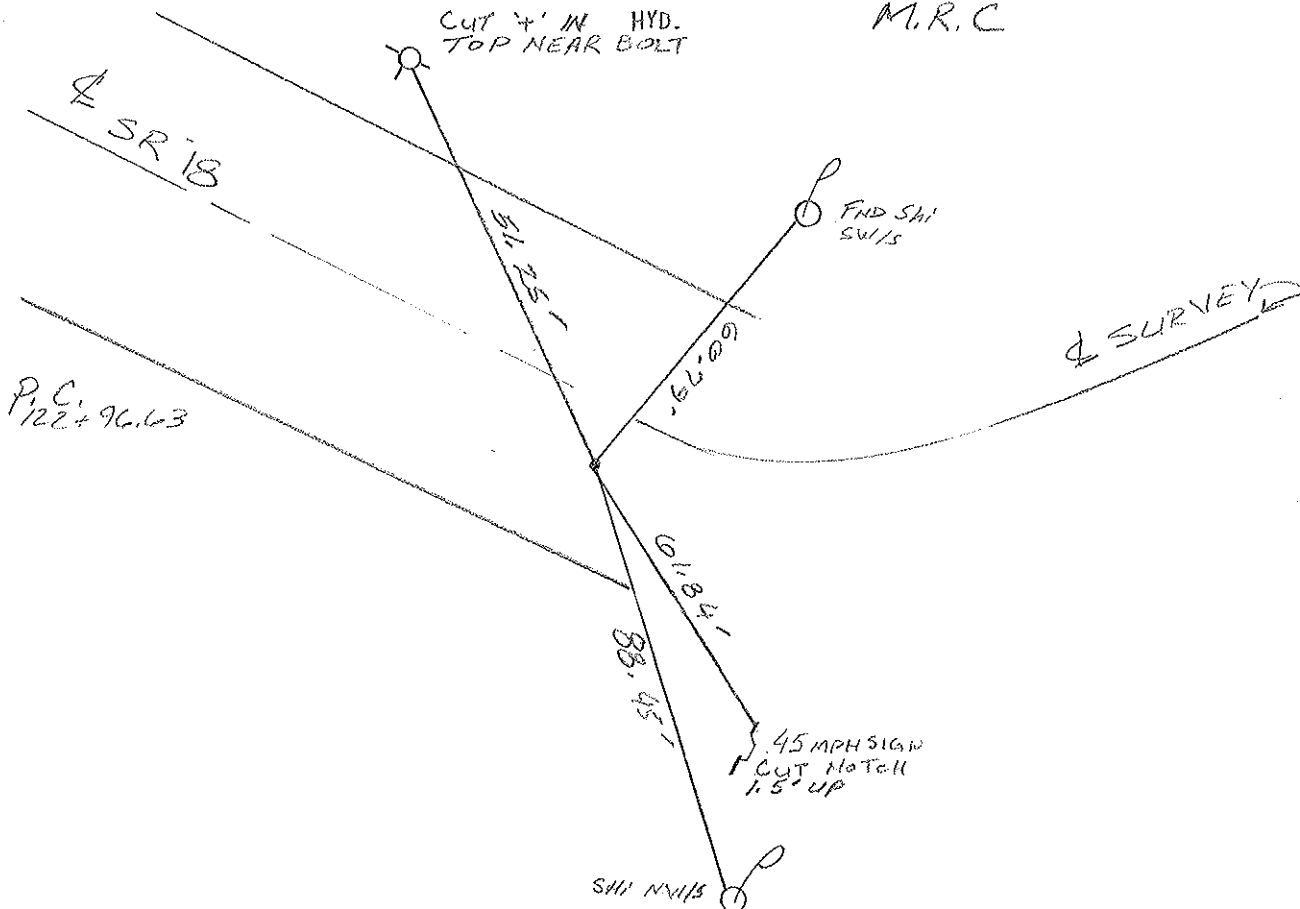

O.D.O.T. DISTRICT 2 SURVEY OFFICE

PERSONNEL

NOTES CRONIN (DRAW)

H.C. RIPPLE

R.C. BARBOUR MEAS.

GEYMAN

REFERENCE NO. 5

DRAWN 1/16/90

DATE 11/12/87

WEATHER OVERCAST

TEMP. 39°

SHEET 5 OF

ROUTE #18

COUNTY SENECA

TOWNSHIP LOUDON

SECTION 8

T. 2 N R. 13 E


TYPE MONUMENT R.R. SPIKE

ON SURFACE - BELOW 2"±

LEFT- & PAV'T. - RIGHT 5.0±

TO EDGE PAVEMENT

S.L.M.

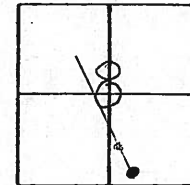


P.C.

122+96.63

DIG WHEN NEEDED


TIES MAY NOT BE TRUE

DIRECTION

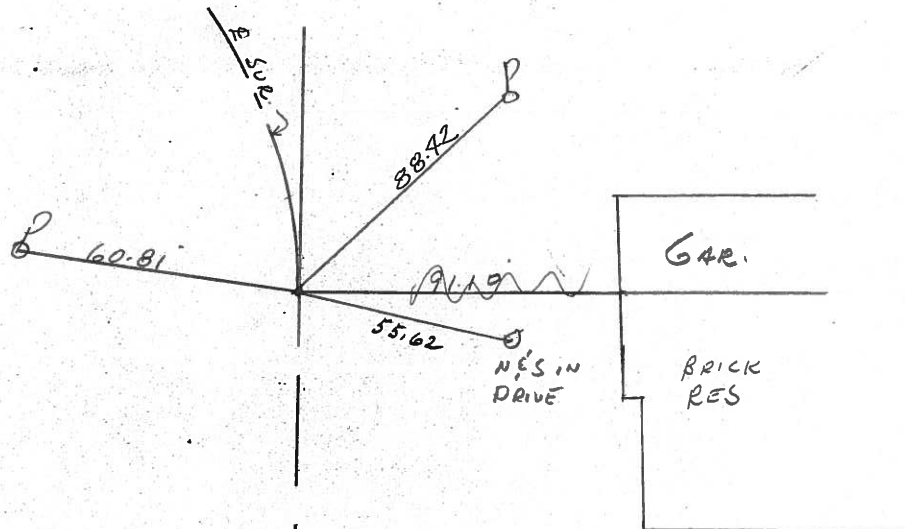

PERSONNEL	TITLE	PERSONNEL	TITLE	COUNTY	DATE	S. R.	WEATHER	TEMP.
Schwartz				Sanct	10-11-65	18	Fair - windy	76°
M. G. M.								
Barbour								
P. H.								


DESCRIPTION Ties for control points JOB NO. _____

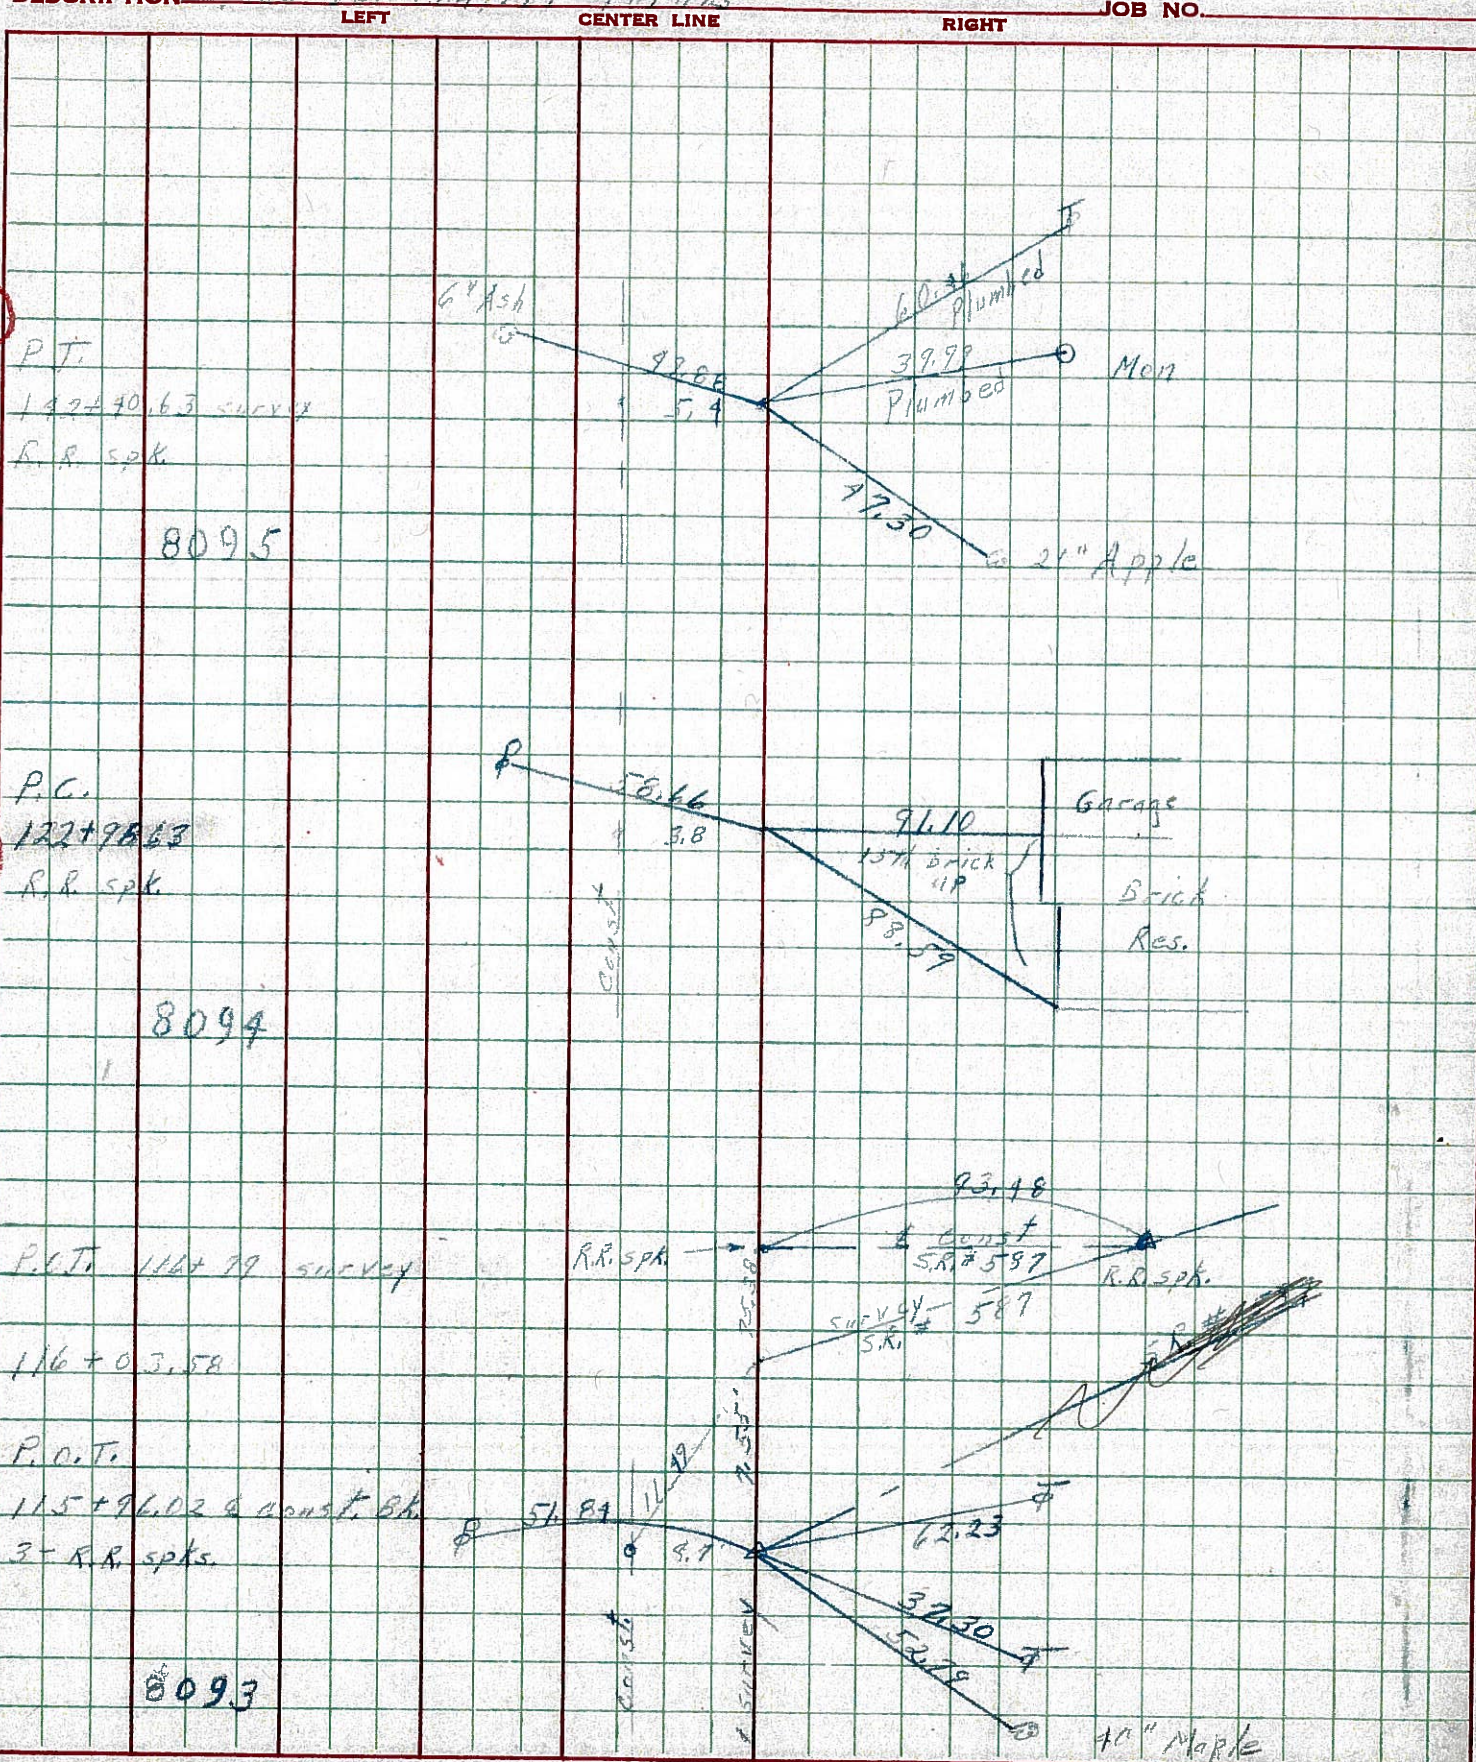

PERSONNEL	TITLE	PERSONNEL	TITLE	COUNTY	DATE	S. R.	WEATHER	TEMP.
Schneider				Seneca	10-16-68	18	Fair - windy	70°
Mosser								
Barbour								
Potts								

DESCRIPTION Ties for Control Points

LEFT CENTER LINE RIGHT JOB NO.

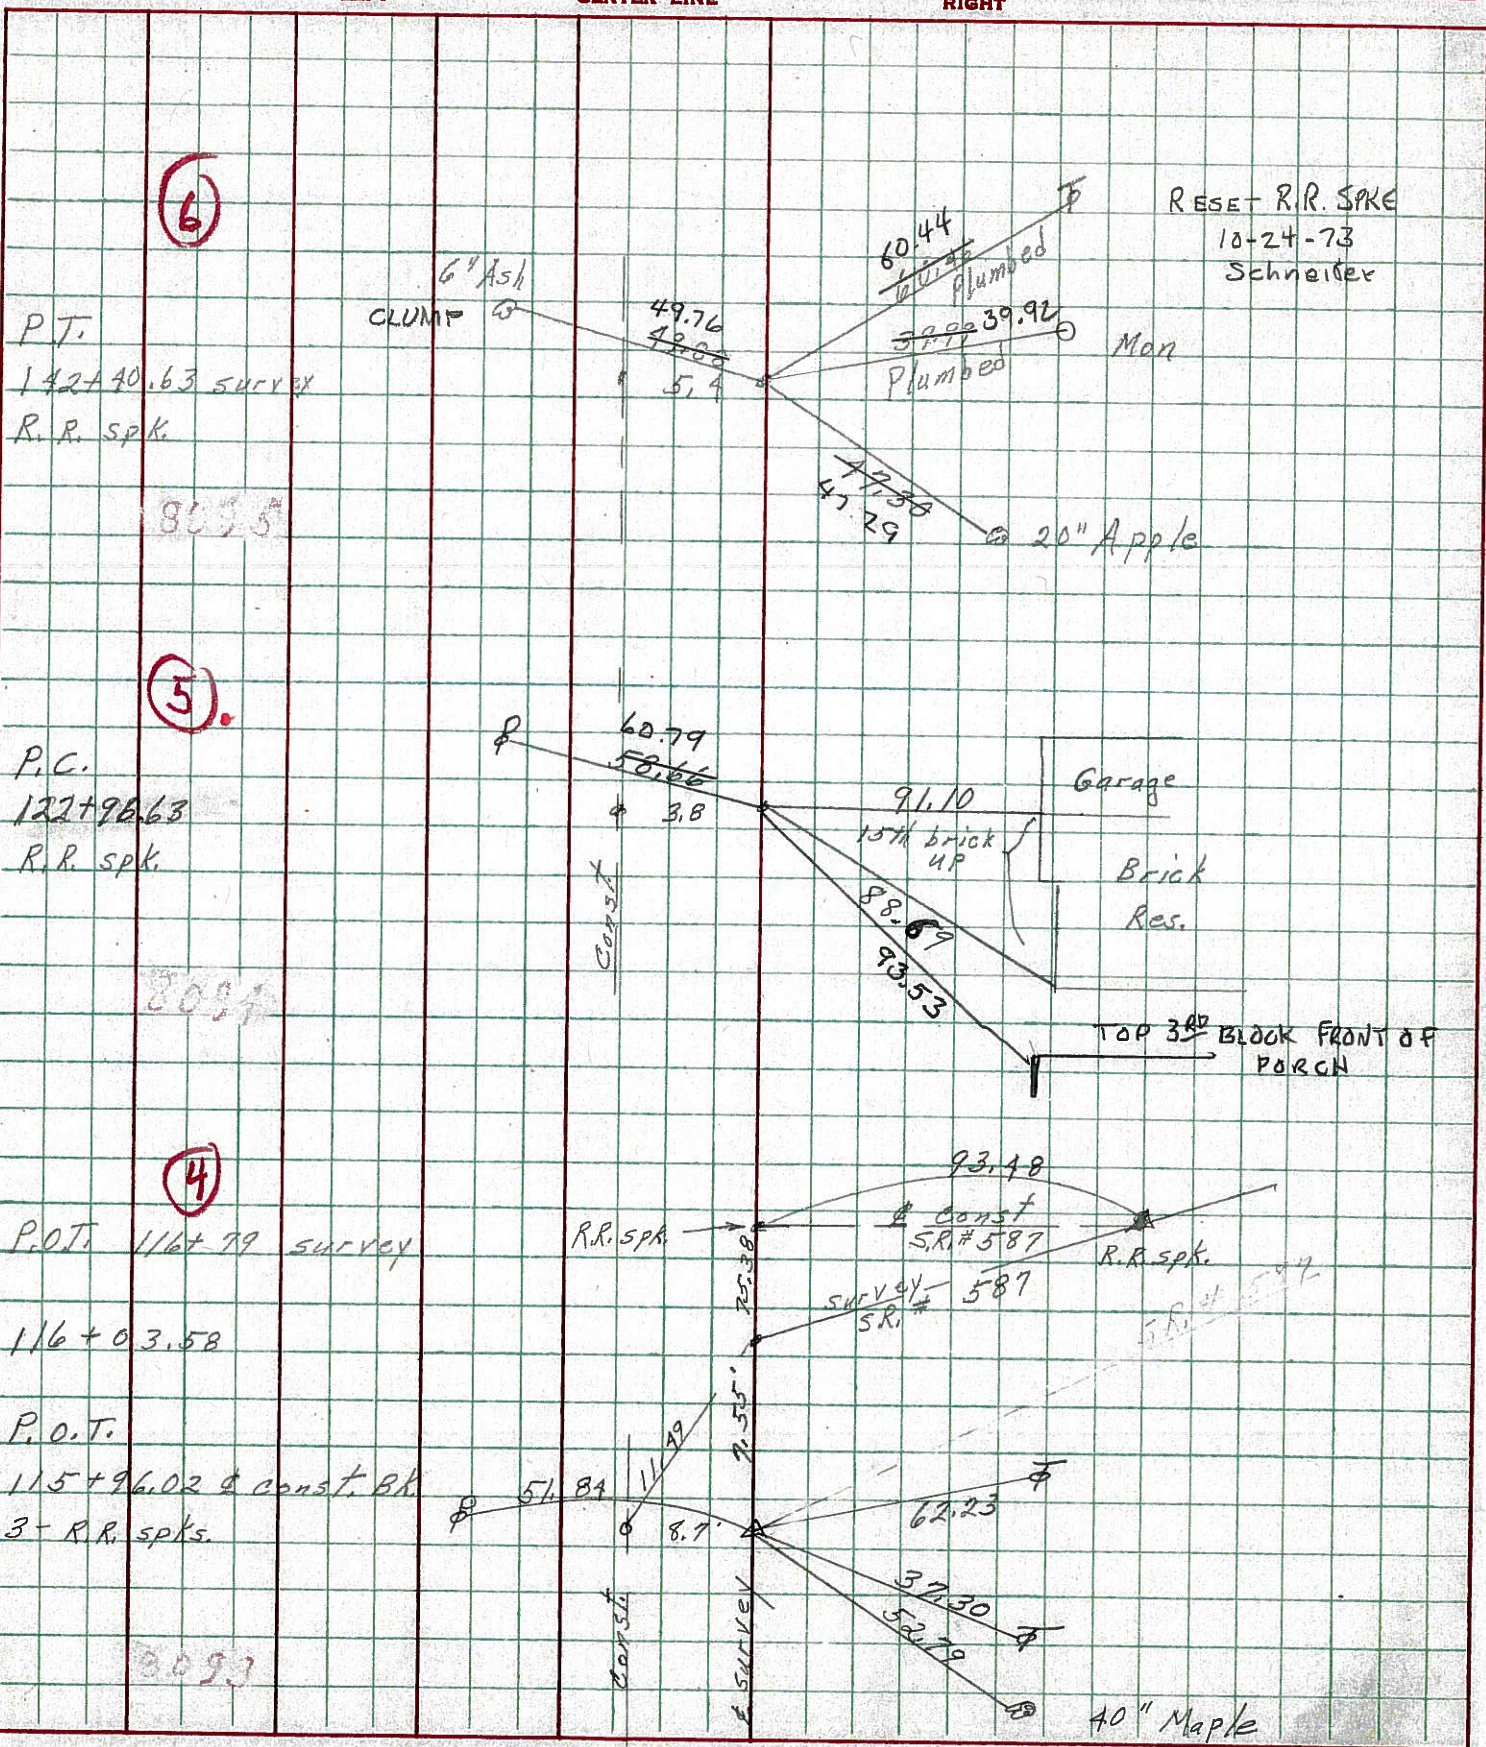

PERSONNEL TITLE PERSONNEL TITLE

COUNTY Seneca

DATE Nov. 12, '58

Hsh
Cronin
RippleLeemaster
Lahr

S. R. #18 Fortaria-Bascom Rd

WEATHER C/cst

SEC. Sen.-18-(179-860)

TEMP. 50°

DESCRIPTION

Control Point ties - Survey & Const.

JOB NO.

LEFT

CENTER LINE

Survey

RIGHT

