

O.D.O.T. DISTRICT 2 SURVEY OFFICE (USE ONLY)

PERSONNEL

REFERENCE NO. 8

SHEET OF

NOTES MILLER DATE 8/5/24

H.C. NIESE WEATHER SUNNY

R.C. PRESTON-COLVIN TEMP. 80°

ASTON

ROUTE SR 18

COUNTY SENECA

TOWNSHIP LOUDON

SECTION 16

DWG BY BARRIERE PID 92371

T 2 N R 13 E

TYPE MONUMENT MAG NAIL/WASHER

ON SURFACE - BELOW ON

OFFSET Q PAVEMENT 9.3' RT LT : RT

 TO EDGE PAVEMENT

STATION: 161+11.28

HORZ.DATUM: NAD83 (2011)


GEOID: 18

GRID: NORTHING: 536177.099


EASTING: 1726660.377

LDP: NORTHING:

EASTING:

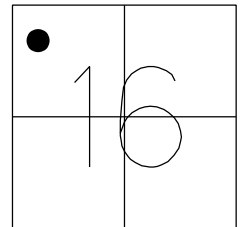

RECORD: P.I.
STA. 161+11.28
 $\Delta=4^{\circ}32'00''$ LT
FD P.K./WASHER
ATOP MINE SPIKE
FD P.K.SHANK
7/10/97, MB
SET P.K./WASHER
10/22/97, TR
FD P.K./WASHER
REF8
4/22/19
8/19/19
2/15/22, JFO
2/10/23, JMR
9/21/22, TDN
4/5/24, TDN
SET MAG/WASHER
8/5/24, TDN

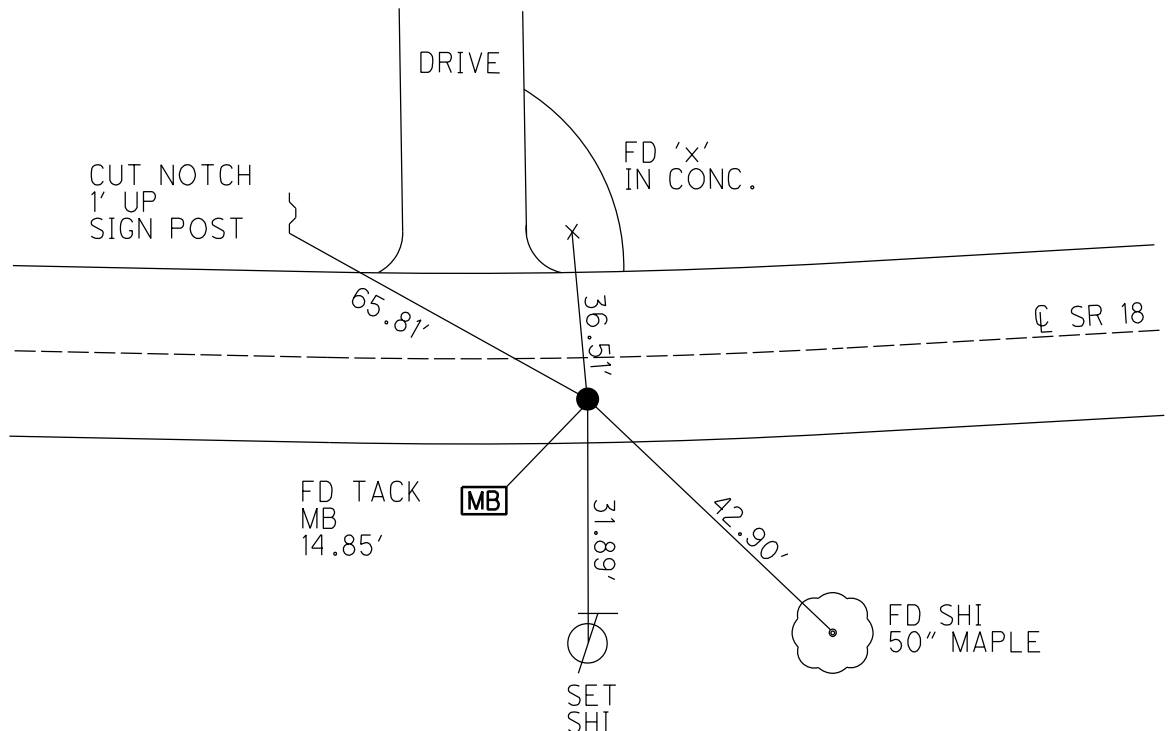

O.D.O.T. DISTRICT 2 SURVEY OFFICE (USE ONLY)

PERSONNEL

REFERENCE NO. 8

SHEET 3 OF 48

NOTES AUBLE

DATE 9/1/21

ROUTE SR 18

H.C. NIESE

WEATHER WINDY

COUNTY SENECA

R.C. AUBLE

TEMP. 72°

TOWNSHIP LOUDON

SECTION 16

DWG BY RHOADES PID PVTRAIN

T 2 N R 13 E

TYPE MONUMENT P.K./WASHER

ON SURFACE - ~~BELOW~~ ON

OFFSET CL PAVEMENT 9.3' LT : RT

3.1' TO RT EDGE PAVEMENT


STATION: 161+11.28

HORZ.DATUM: NAD83(2011)


GEOID: 2012A

GRID: NORTHING: 536177.168

EASTING: 1726660.515

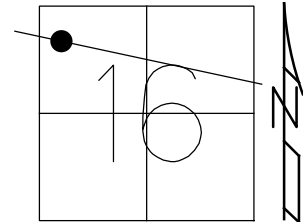

RECORD: P.I.
STA. 161+11.28
 $\Delta = 4^{\circ}32'00''$ LT
FD P.K./WASHER
ATOP MINE SPIKE
FD P.K.SHANK
7/10/97, MB
SET P.K./WASHER
10/22/97, TR
FD P.K./WASHER
REF8
4/22/19
8/19/19
2/15/22, JFO
2/10/23, JMR

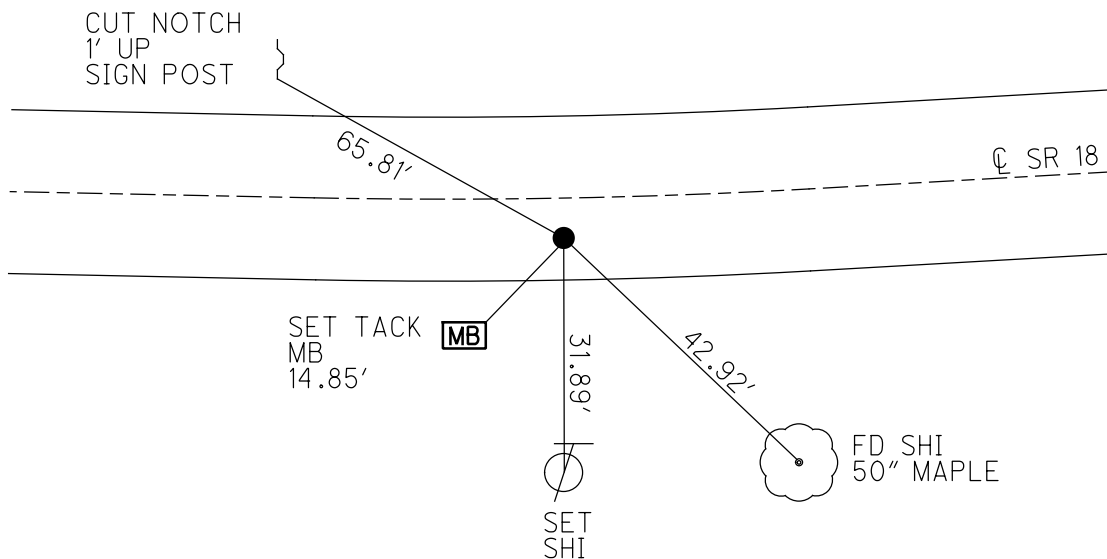

O.D.O.T. DISTRICT 2 SURVEY OFFICE (USE ONLY)

PERSONNEL

REFERENCE NO. 8

SHEET 3 OF 48

NOTES AUBLE

DATE 9/1/21

ROUTE SR 18

H.C. NIESE

WEATHER WINDY

COUNTY SENECA

R.C. AUBLE

TEMP. 72°

TOWNSHIP LOUDON

DWG BY RHOADES

PID PVTRAIN

SECTION 16

T 2 N R 13 E

TYPE MONUMENT P.K./WASHER

ON SURFACE - ~~BELOW~~ ON

OFFSET CL PAVEMENT 9.3' LT : RT

3.1' TO RT EDGE PAVEMENT


STATION: 161+11.28

HORZ.DATUM: NAD83(2011)


GEOID: 2012A

GRID: NORTHING: 536177.168

EASTING: 1726660.515

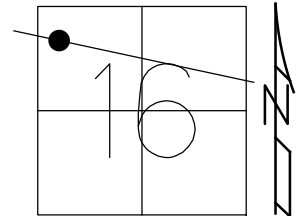

RECORD: P.I.
STA. 161+11.28
 $\Delta = 4^{\circ}32'00''$ LT
FD P.K./WASHER
ATOP MINE SPIKE
FD P.K.SHANK
7/10/97, MB
SET P.K./WASHER
10/22/97, TR
FD P.K./WASHER
REF8
4/22/19
8/19/19
2/15/22, JFO

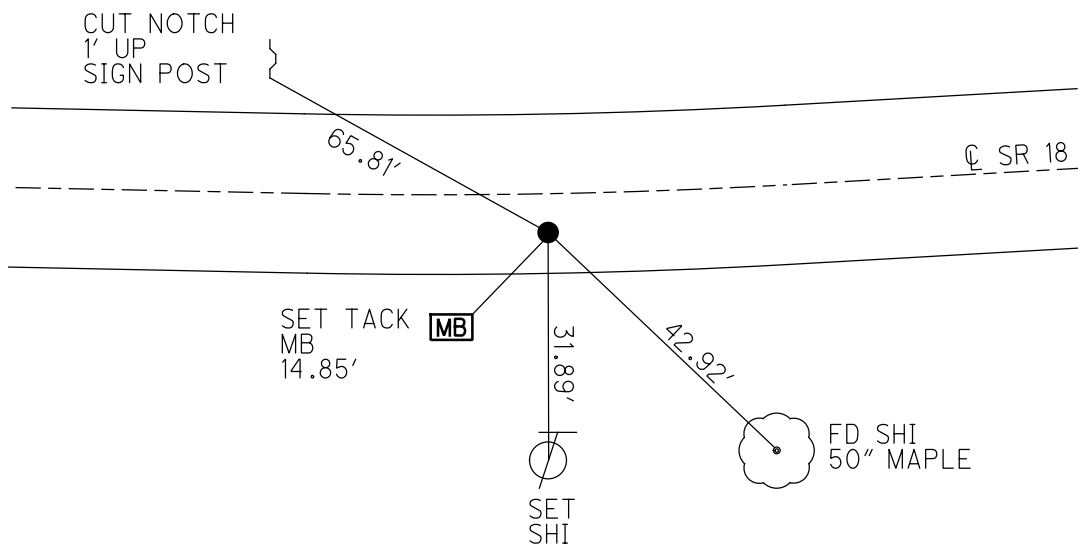

O.D.O.T. DISTRICT 2 SURVEY OFFICE (USE ONLY)

PERSONNEL

REFERENCE NO. 8

SHEET 3 OF 48

NOTES BARNHISEL

DATE 7/10/97

ROUTE SR 18

H.C. CANTERBURY

WEATHER SUNNY

COUNTY SENECA

R.C. WEAVER

TEMP. 75°

TOWNSHIP LOUDON

ROUSOS

SECTION 16

DWG BY NIESE PID NO PID

T 2 N R 13 E

TYPE MONUMENT P.K.SHANK

ON SURFACE - ~~BELOW~~ ON

OFFSET CL PAVEMENT 9.3' ~~LT~~ : RT

3.1' TO RT EDGE PAVEMENT


STATION: 161+11.28

HORZ.DATUM: NAD83(2011)


GEOID: 2012A

GRID: NORTHING: 536177.168

EASTING: 1726660.515

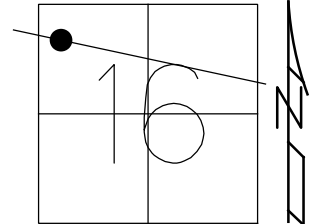

RECORD: P.I.
STA.161+11.28
 $\Delta=4^{\circ}32'00''$ LT
FD P.K./WASHER
ATOP MINE SPIKE
FD P.K.SHANK
7/10/97, MB
SET P.K./WASHER
10/22/97, TR
FD P.K./WASHER
REF8
4/22/19
8/19/19, JFO

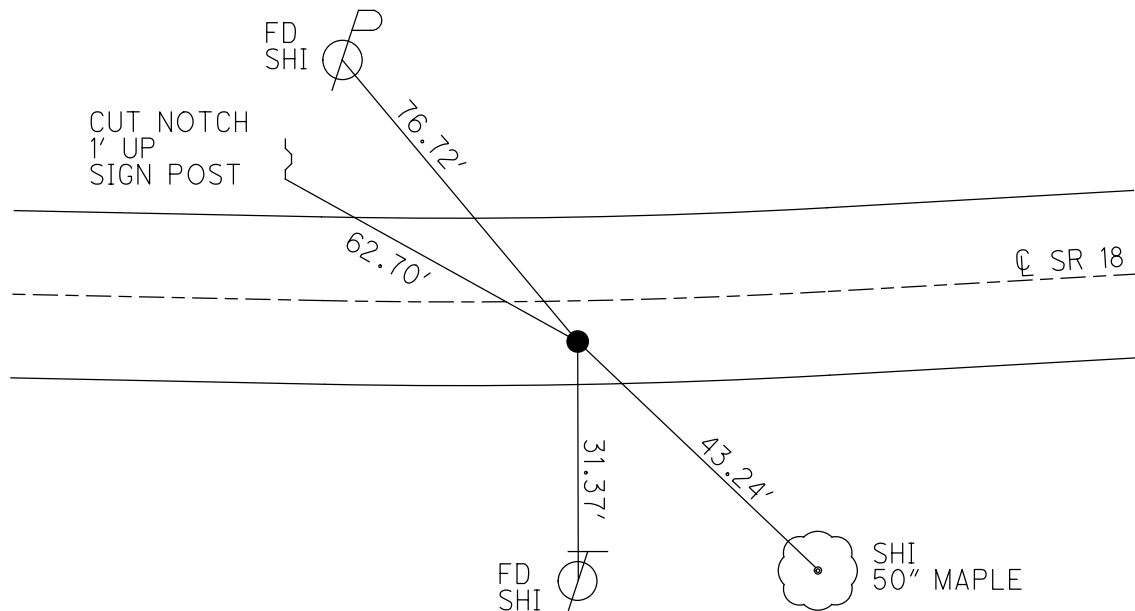

O.D.O.T. DISTRICT 2 SURVEY OFFICE

PERSONNEL

REFERENCE NO. 8

SHEET 8 OF 22

NOTES BARNHISEL

H.C. CANTERBURY

R.C. WEAVER

ROUSO

DRAWN BY ROUSO

DATE 7/10/97

WEATHER SUNNY

TEMP. +25°

ROUTE 18

COUNTY SENECA

TOWNSHIP LODON

SECTION 16

T. 2 N. R. 13 E.


TYPE MONUMENT P.K. WASHER (FWD PK. SHANK)

ON SURFACE - BELOW SURFACE

LEFT - 0 PAV'T. - RIGHT 9.3'


3.1 TO RT EDGE PAVEMENT

S.L.M. 5.286.9 SLK

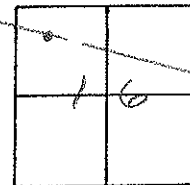

RESET P.K. WASHER
10-22-97
TR

161+11.28
P.I. SURVEY
Δ = 04° 32' 00" LT
PK WASHER
ATOP MINE SPIKE

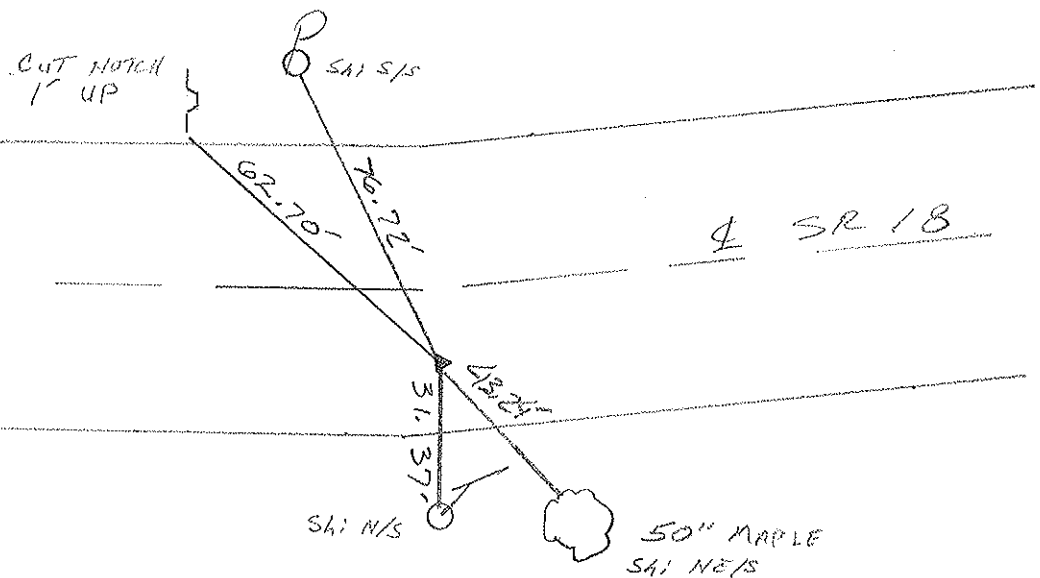

O.D.O.T. DISTRICT 2 SURVEY OFFICE

PERSONNEL

NOTES ORDIN

H.C. RIPPLE

R.C. BARBOUR

GEYMAN

REFERENCE NO. 8

DRAWN 1/16/90

DATE 1/18/90

WEATHER OVERCAST - MIST

TEMP. 38°

SHEET 8 OF

ROUTE #18

COUNTY SENECA

TOWNSHIP LOODON

SECTION 16

T.2 N. R.13 E


TYPE MONUMENT P.K. & WASHER

ON SURFACE - BELOW

LEFT - & PAV'T. - RIGHT 40' E

TO EDGE PAVEMENT

S.L.M.

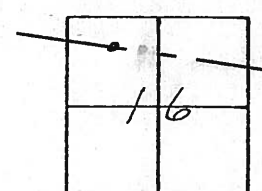


161+11.28

P.I. SURVEY

A = 04°32'00" Lt

P.K. & WASHER

Atop MINE SPIKE

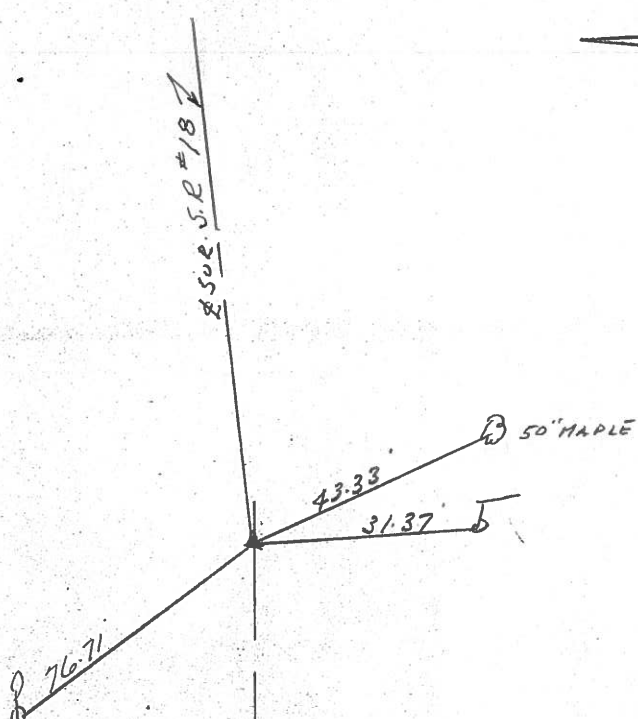

TITLE

PERSONNEL

TITLE

COUNTY Seneca

DATE 10-16-68

Schneider

Mosser

Barbour

Pc 1/5

S. R. _____

WEATHER Fair-Windy

SEC. Easteria to Bascom

TEMP. 78°

DESCRIPTION


Ties for Control Points

JOB NO.

LEFT

CENTER LINE

RIGHT

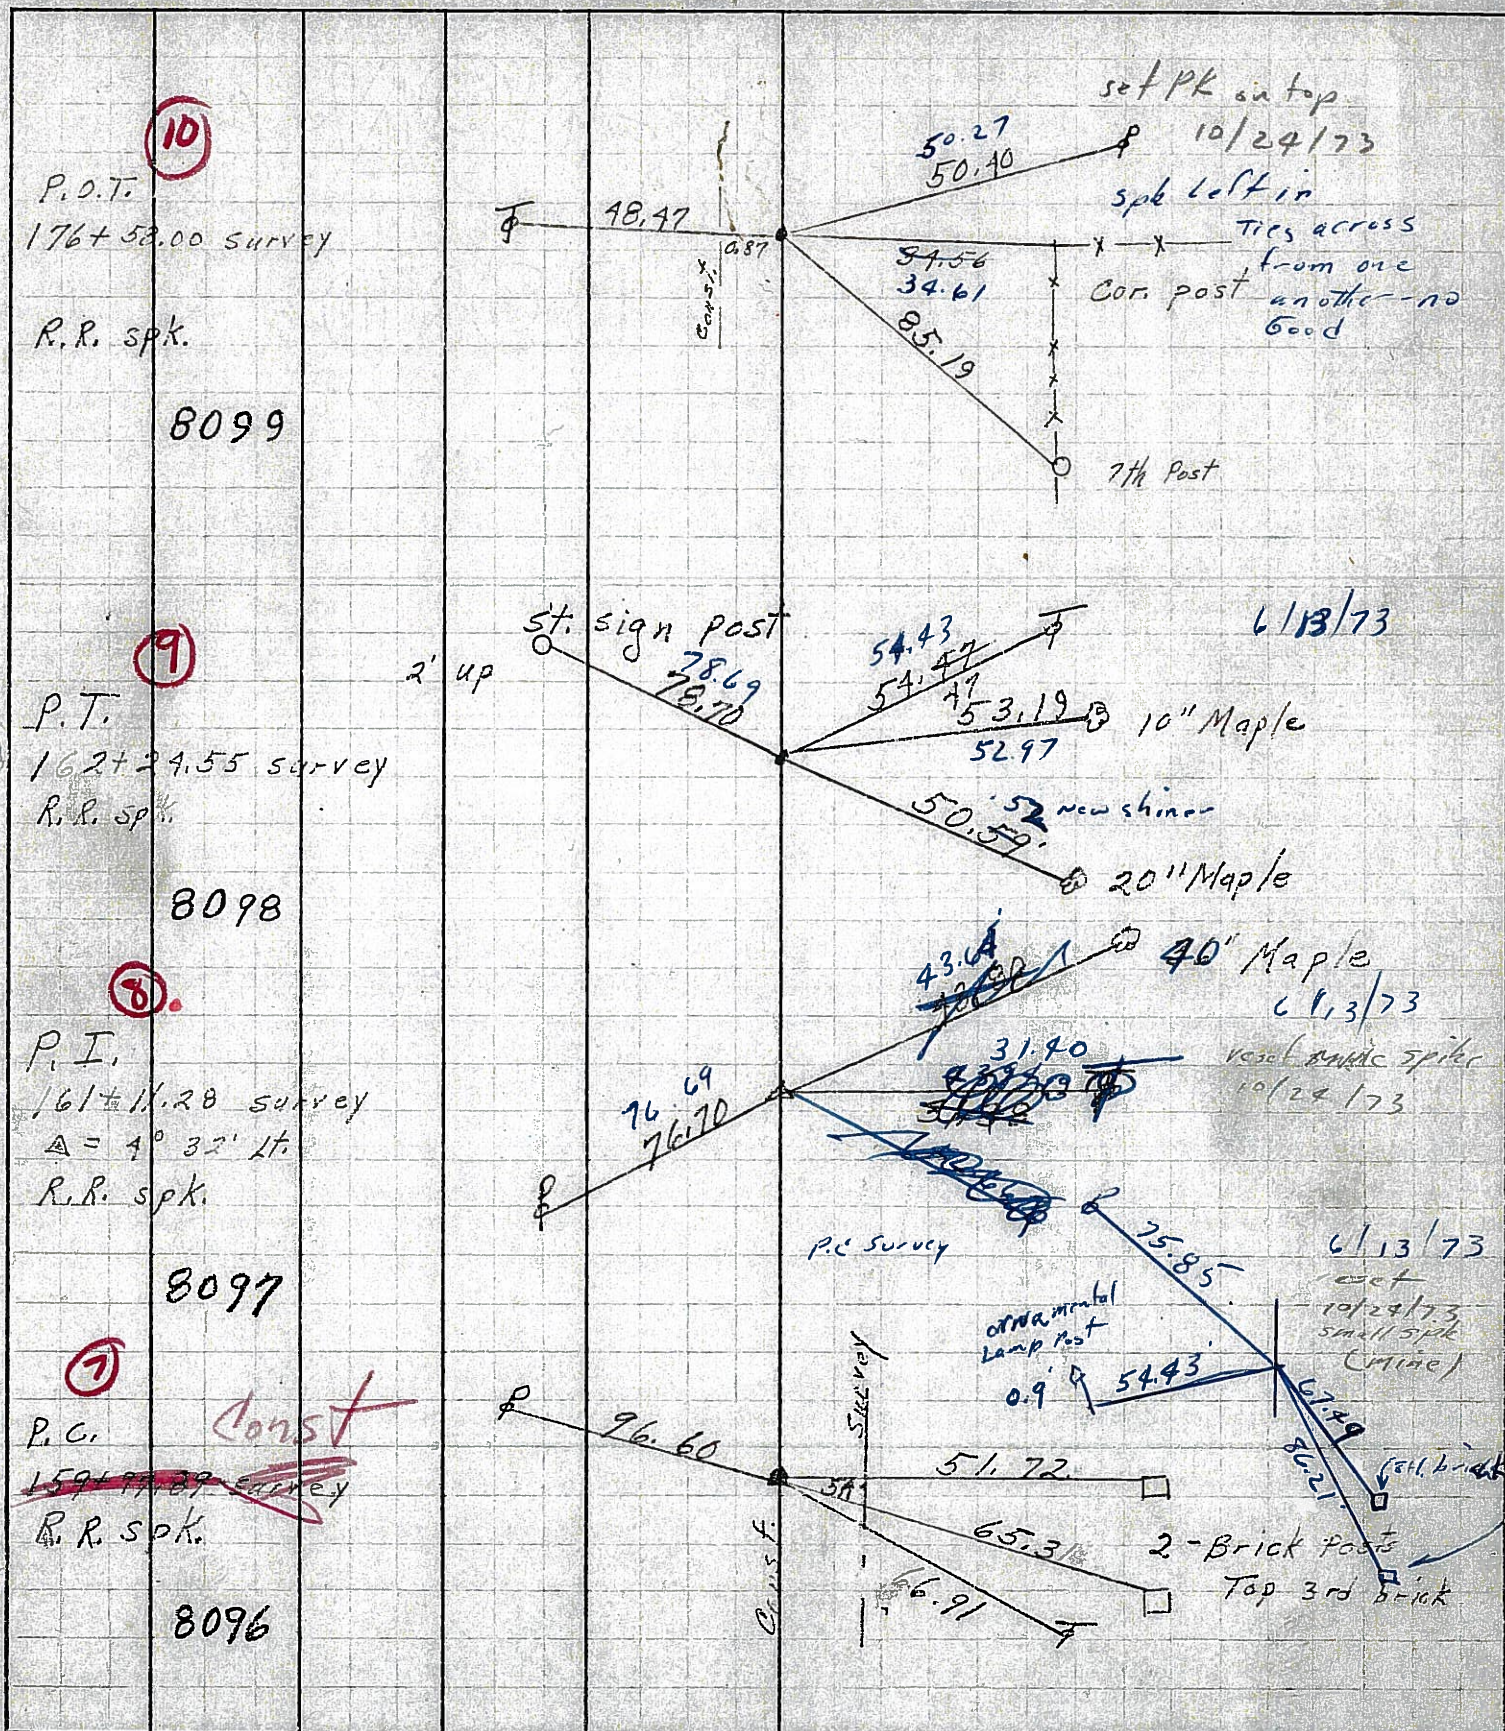
JOB NO.

PERSONNEL	TITLE	PERSONNEL	TITLE	COUNTY	DATE	WEATHER	TEMP.
Schneider				Seneca	10-16-68	Fair-Windy	78°
Messner				S. R. 18			
Brubaker				SEC. Fostoria to Bascom			
Perkins							

DESCRIPTION Ties for Control Points JOB NO. _____


10

P.O.T.
176+58.00 survey
R.R. spk.
8099

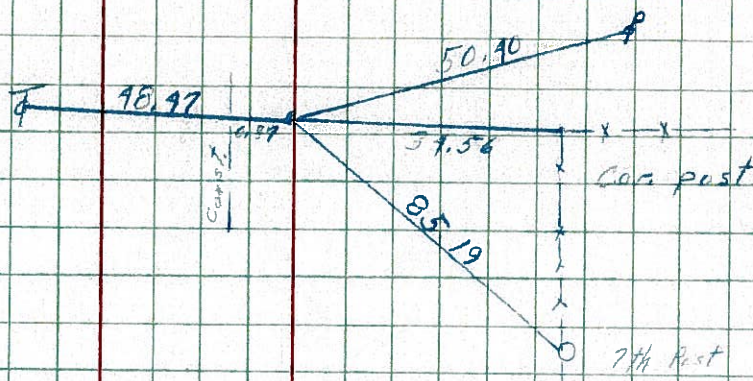


9

P.T.
162+29.55 survey
R.R. spk.
8098

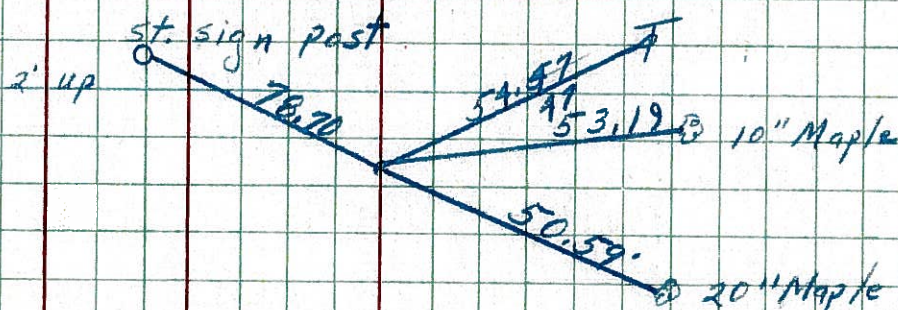


8

P.T.
161+11.26 survey
 $\Delta = 4^\circ 32' 11''$
R.R. spk.
8097

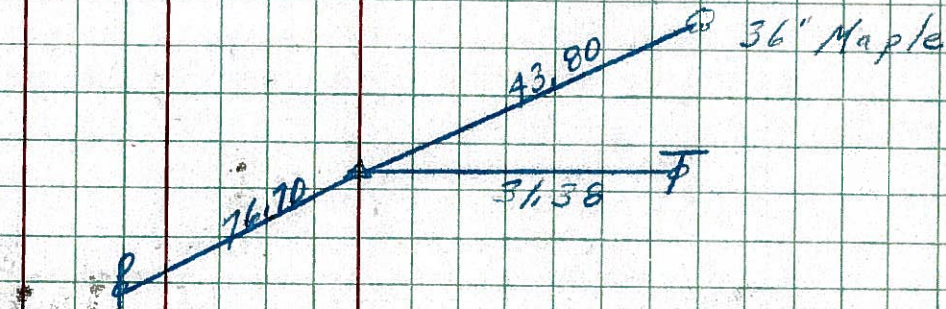

7

P.C.
159+72.89 survey
R.R. spk.
8096

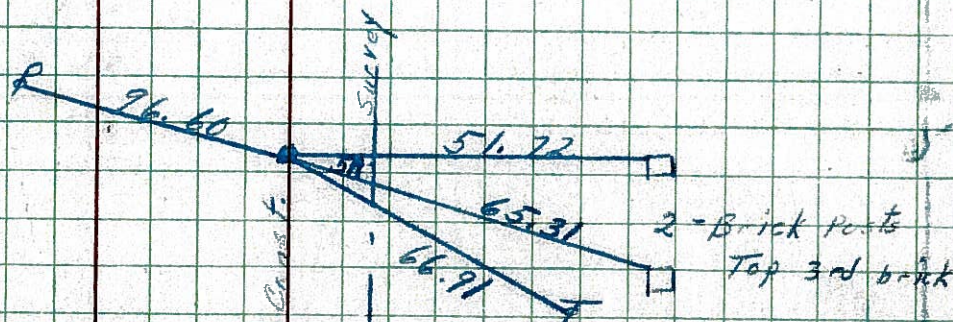

PERSONNEL TITLE PERSONNEL TITLE

Schneider

COUNTY Seneca

DATE 10-16-68

Mosser

S. R. 18

WEATHER Fair-Windy

Barbour

SEC. Fostoria to Bascom

TEMP. 78°

Potts

DESCRIPTION Ties for Control Points

JOB NO.

LEFT


CENTER LINE

RIGHT

P.O.T. (10)
176+58.00 Survey


R.R. spk.

8023

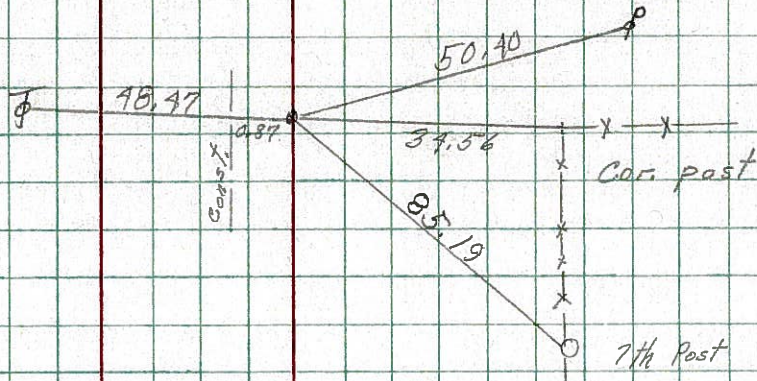


P.T. (9)
162+24.55 Survey
R.R. spk.

8078

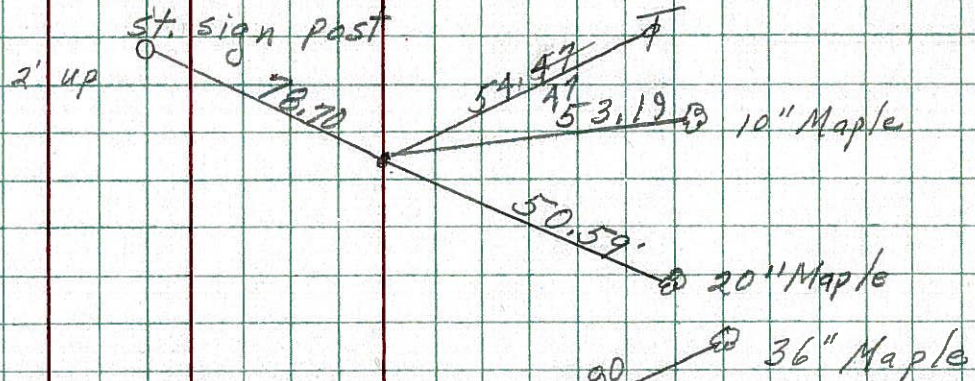


P.I. (8)
161+11.28 Survey
 $\Delta = 4^\circ 32' 11''$
R.R. spk.

8077

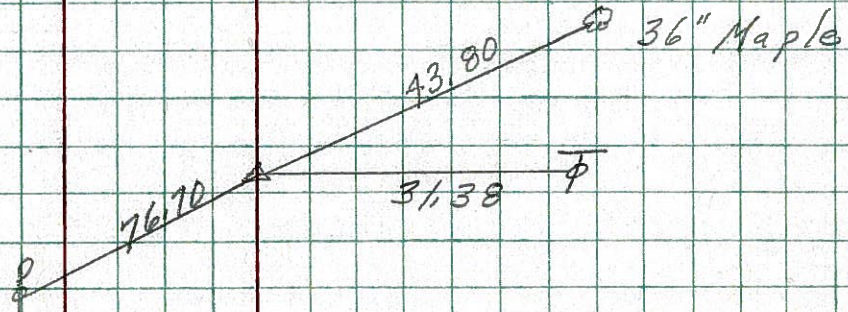

P.C. (7)
159+92.89 Survey
CONST.
R.R. spk.

8076

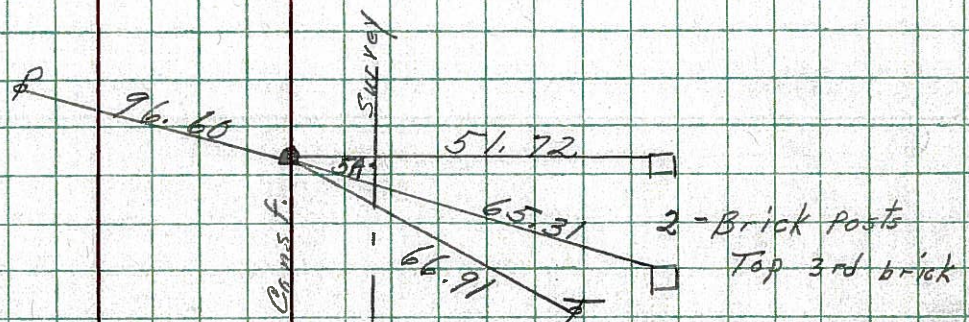

PERSONNEL TITLE PERSONNEL TITLE

COUNTY Seneca

DATE Dec. 3, '58

Hsh

Cronin

Leemaster

Lahr

John K.

S. R. #18 Foster's - 1325 Comp Rd. WEATHER Cloudy

SEC 5018-(1.79-8.60)

TEMP 35°

DESCRIPTION Control Point Ties - Survey & Const.

JOB NO.

LEFT

CENTER LINE Survey

RIGHT

