

O.D.O.T. DISTRICT 2 SURVEY OFFICE (USE ONLY)

PERSONNEL

REFERENCE NO. 10

SHEET OF

NOTES MILLER

DATE 8/5/24

ROUTE SR 18

H.C. NIESE

WEATHER SUNNY

COUNTY SENECA

R.C. PRESTON-COLVIN

TEMP. 80°

TOWNSHIP LOUDON

ASTON

SECTION 16

DWG BY BARRIERE

PID 92371

T 2 N R 13 E

TYPE MONUMENT MAG NAIL/WASHER

ON SURFACE - BELOW ON

OFFSET $\odot$ PAVEMENT 0.5' RT LT : RT

 TO EDGE PAVEMENT

STATION: 176+58

HORZ.DATUM: NAD83 (2011)


GEOID: 18

GRID: NORTHING: 536069.814


EASTING: 1728203.030

LDP: NORTHING:

EASTING:

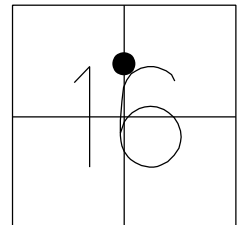

RECORD: P.O.T.
STA.176+58
FD P.K.SHINER
ATOP R.R.SPIKE
FD P.K./WASHER
7/10/97, MB
SET P.K./WASHER
10/22/97, MRC
FD P.K./WASHER
REF10
4/22/19
8/19/19, JFO
FD P.K./WASHER
2" DOWN
2/10/23, JMR
4/5/24, TDN
SET MAG/WASHER
8/5/24, TDN

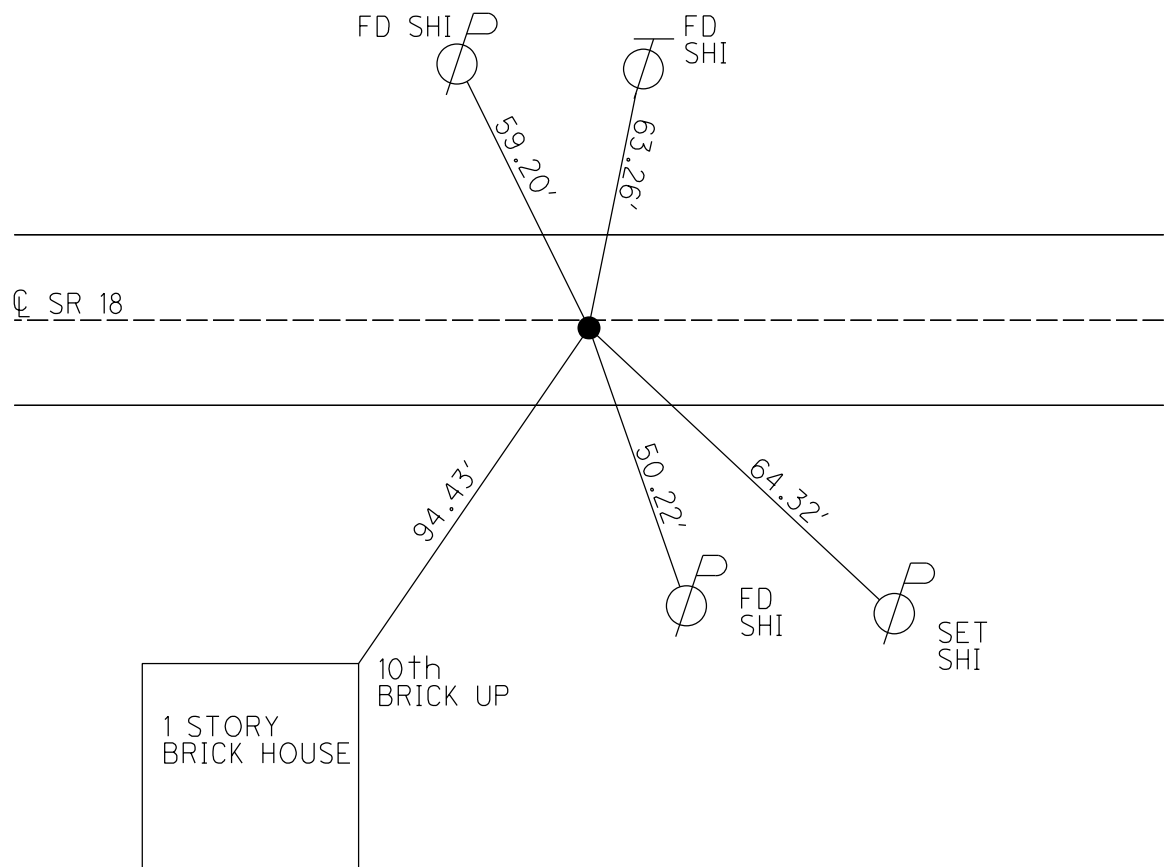

O.D.O.T. DISTRICT 2 SURVEY OFFICE (USE ONLY)

PERSONNEL

REFERENCE NO. 10

SHEET 5 OF 48

NOTES BARNHISEL

DATE 7/10/97

ROUTE SR 18

H.C. CANTERBURY

WEATHER SUNNY

COUNTY SENECA

R.C. WEAVER

TEMP. +75°

TOWNSHIP LOUDON

ROUSOS

SECTION 16

DWG BY NIESE

PID NO PID

T 2 N R 13 E

TYPE MONUMENT P.K. SHINER

ON SURFACE - ~~BELOW~~ ON

OFFSET Q PAVEMENT 0.5' ~~LT~~ : RT

11.6' TO RT EDGE PAVEMENT


STATION: 176+58

HORZ.DATUM: NAD83(2011)

GEOID: 2012A

GRID: NORTHING: 536069.864

EASTING: 1728203.030

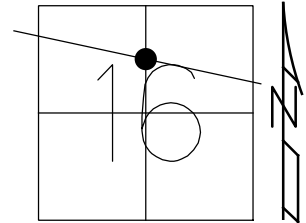

RECORD: P.O.T.
STA.176+58
FD P.K.SHINER
ATOP R.R.SPIKE
FD P.K./WASHER
7/10/97, MB
SET P.K./WASHER
10/22/97, MRC
FD P.K./WASHER
REF10
4/22/19
8/19/19, JFO
FD P.K./WASHER
2" DOWN
2/10/23, JMR

SET SHI
CUT OFF
TEL. POLE

Q SR 18

SET SHI
14" MAPLE

SET SHI
12" MAPLE


FD
SHI

69.25'

41.84'

50.23'

48.54'

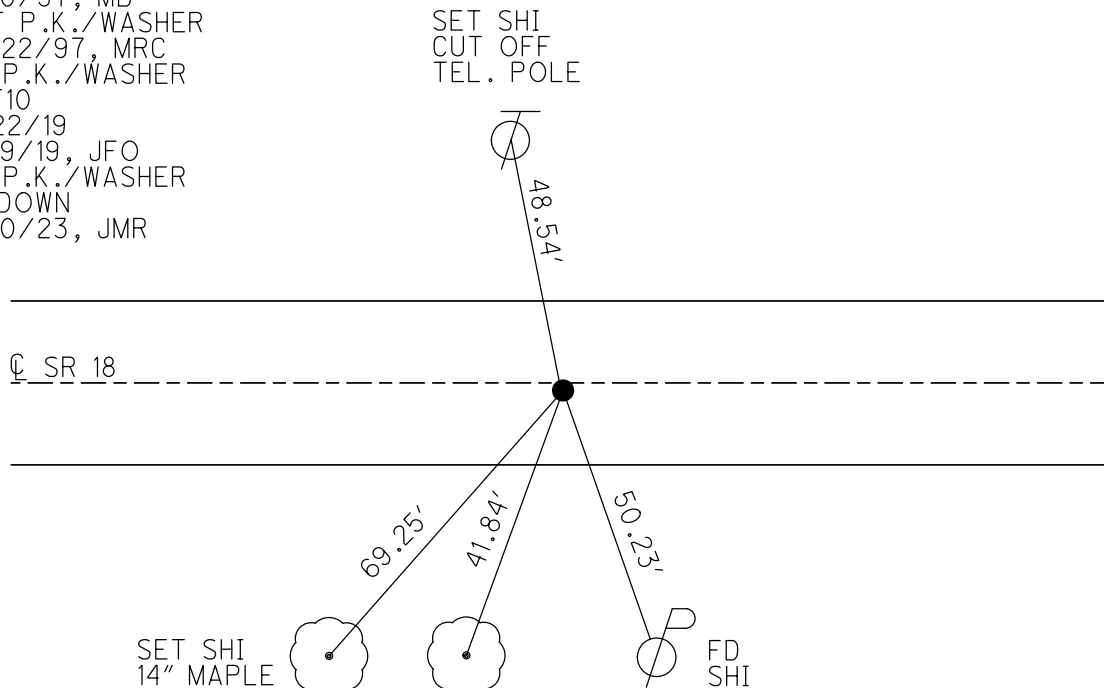

O.D.O.T. DISTRICT 2 SURVEY OFFICE (USE ONLY)

PERSONNEL

REFERENCE NO. 10

SHEET 5 OF 48

NOTES BARNHISEL

DATE 7/10/97

ROUTE SR 18

H.C. CANTERBURY

WEATHER SUNNY

COUNTY SENECA

R.C. WEAVER

TEMP. +75°

TOWNSHIP LOUDON

ROUSOS

SECTION 16

DWG BY NIESE PID NO PID

T 2 N R 13 E

TYPE MONUMENT P.K. SHINER

ON SURFACE - ~~BELOW~~ ON

OFFSET CL PAVEMENT 0.5' ~~LT~~ : RT

11.6' TO RT EDGE PAVEMENT


STATION: 176+58

HORZ.DATUM: NAD83(2011)

GEOID: 2012A


GRID: NORTHING: 536069.864

EASTING: 1728203.030

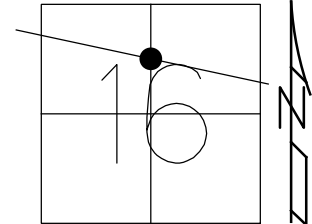

RECORD: P.O.T.
STA.176+58
FD P.K.SHINER
ATOP R.R.SPIKE
FD P.K./WASHER
7/10/97, MB
SET P.K./WASHER
10/22/97, MRC
FD P.K./WASHER
REF10
4/22/19
8/19/19, JFO

SET SHI
CUT OFF
TEL. POLE

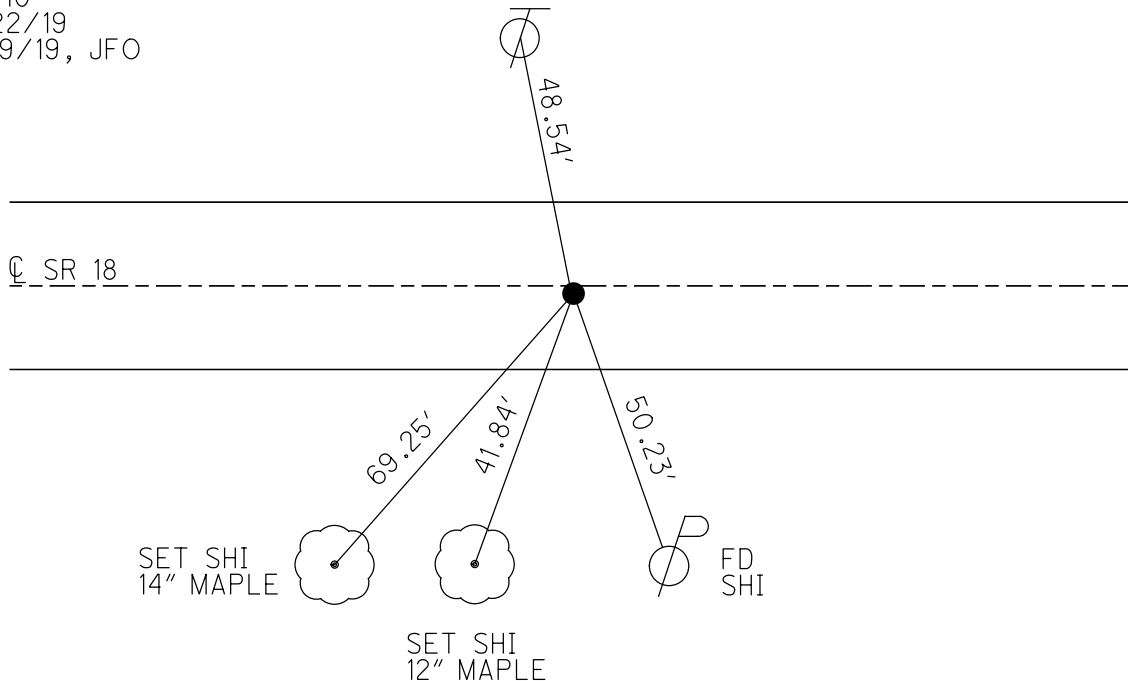

O.D.O.T. DISTRICT 2 SURVEY OFFICE

PERSONNEL

REFERENCE NO. 10

SHEET 10 OF 22

NOTES BARNHISEL

H.C. CANTERBURY

R.C. WEAVER

RANSOS

DRAWN BY RANSOS

DATE 7-10-97

WEATHER SUNNY

TEMP. +75°

ROUTE 18

COUNTY SENECA

TOWNSHIP LODOW

SECTION 16

T2 N R13 E


TYPE MONUMENT P.K. SHINER

ON SURFACE - BELOW SURFACE

LEFT - 0 PAV'T. - RIGHT 0.5' RT

11.6 TO RT EDGE PAVEMENT


S.L.M. 5+758.5 SLK

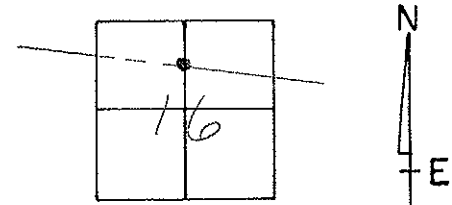

RESET P.K. & WASHER

10/22/97 MRL

P.O.T. SURVEY
176+58.00
P.K. SHINER ATOP
R.R. SPLE

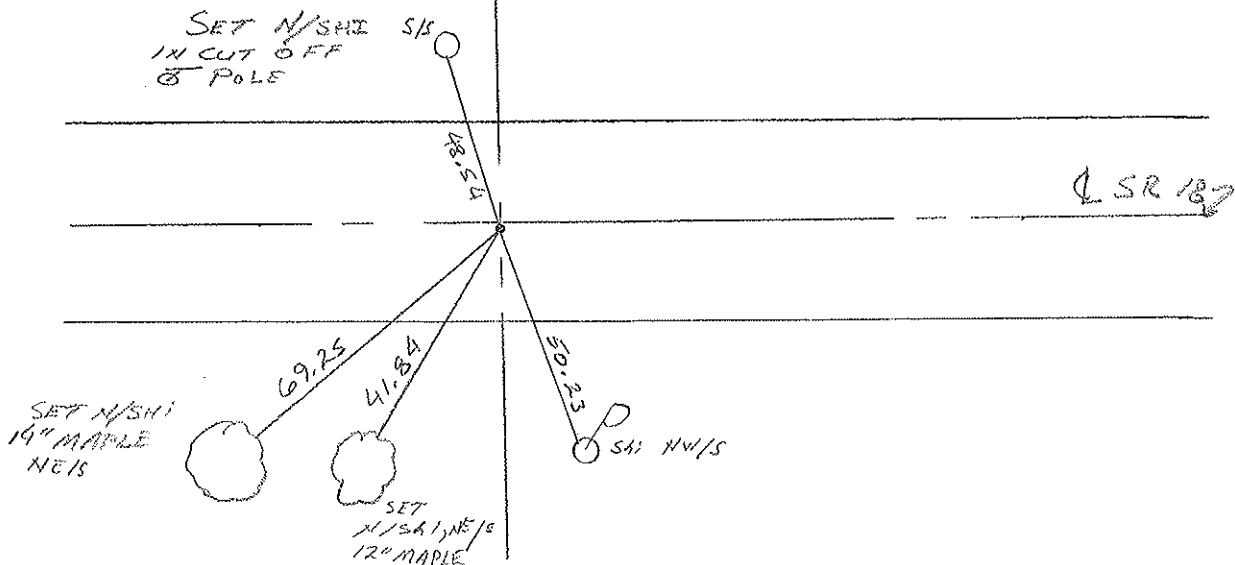

O.D.O.T. DISTRICT 2 SURVEY OFFICE

PERSONNEL

REFERENCE NO. 10

SHEET 10 OF 10

NOTES CROWIN (DRAW)

DRAWN 1/18/90

H.C. RIPPLE

DATE 11/12/87

R.G. BARBOUR MEAS.

WEATHER OVERCAST

GEYMAN

TEMP. 39°

ROUTE #18

COUNTY SENECA

TOWNSHIP LOORDON

SECTION 16

T 2 N R 13 E


TYPE MONUMENT P.K. & SHINER

ON SURFACE - BELOW

LEFT - & PAV'T. - RIGHT 1'±

TO EDGE PAVEMENT

S.L.M.

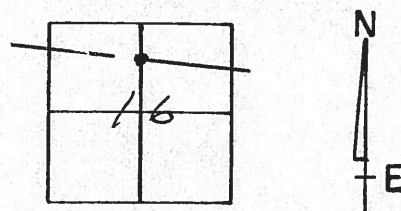


P.O.T. SURVEY

176+58.00

P.K. & SHINER ATOP

R.R. SPIKE

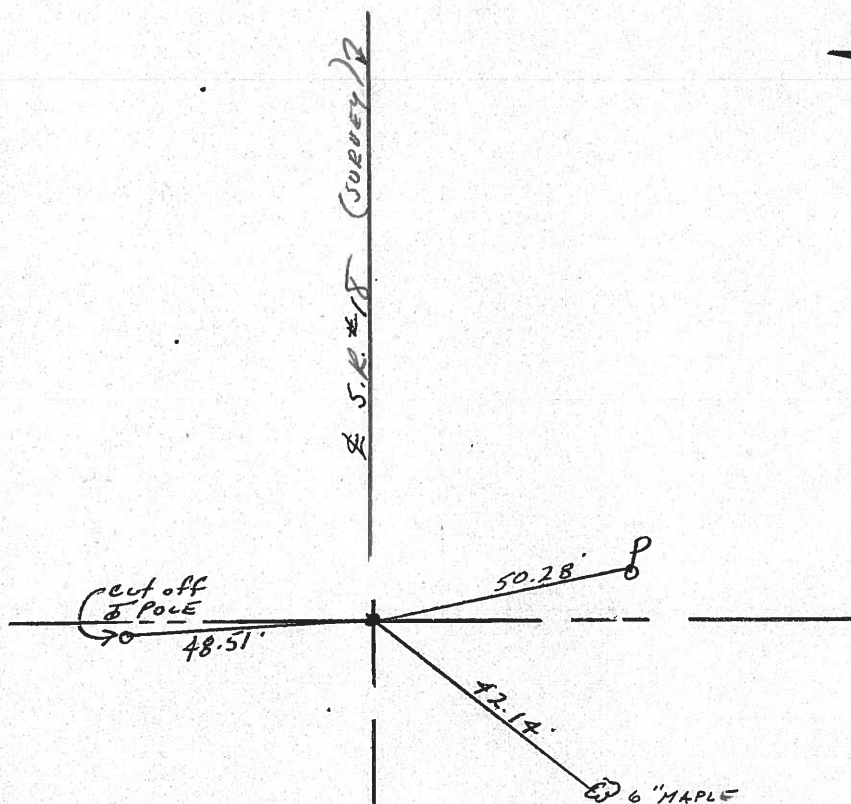

PERSONNEL

TITLE

PERSONNEL

TITLE

Schneider

COUNTY

Seneca

DATE

10-16-68

Mosser

S. R.

18

WEATHER

Fair-Windy

Barbour

SEC. Easterie to Bascom

TEMP.

78°

Potts

DESCRIPTION


Ties for Control Points

LEFT

CENTER LINE

RIGHT

JOB NO.

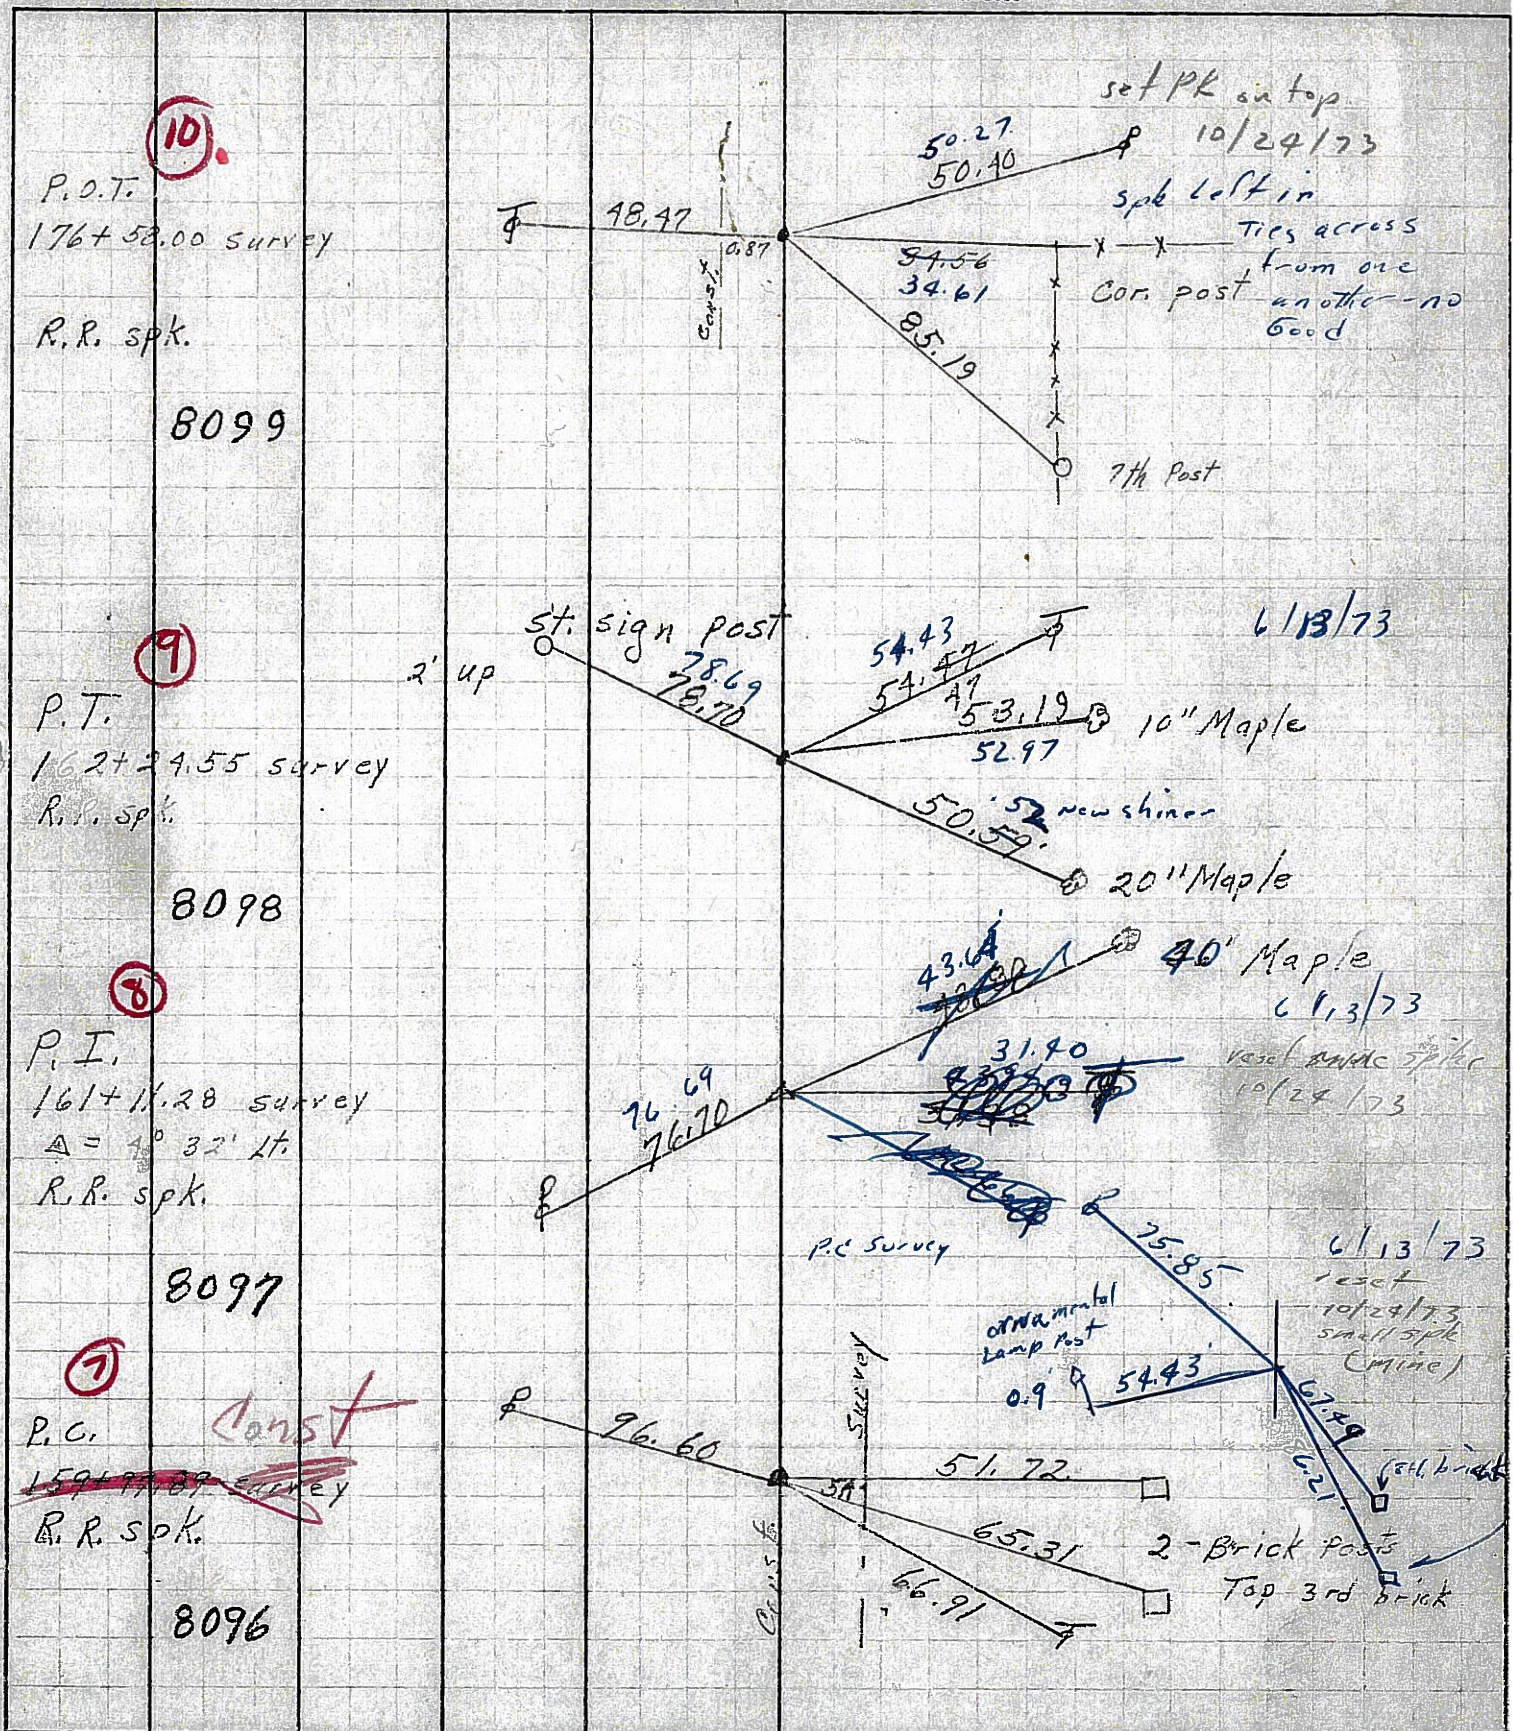

PERSONNEL	TITLE	PERSONNEL	TITLE	COUNTY	DATE	WEATHER	TEMP
Schneider				Seneca	10-16-68	Fair-Windy	78
Masser				S. R. 18			
Barbour				SEC. Fosteria to Bascom			
Potts							


DESCRIPTION Ties for Control Points JOB NO. _____

10

P.O.T.
176+58.00 survey

R.R. spk.

8099

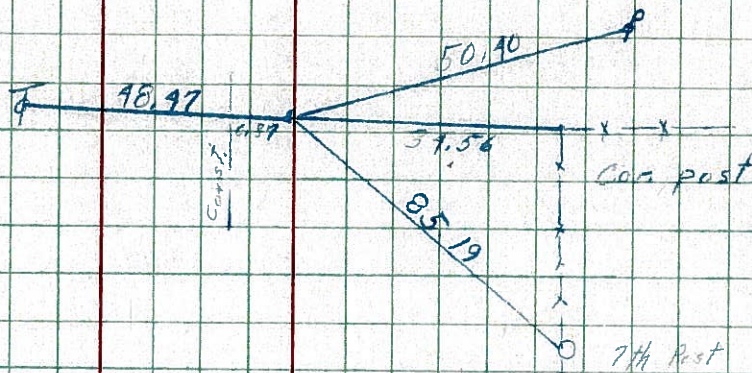


9

P.T.
162+29.55 survey

R.R. spk.

8098

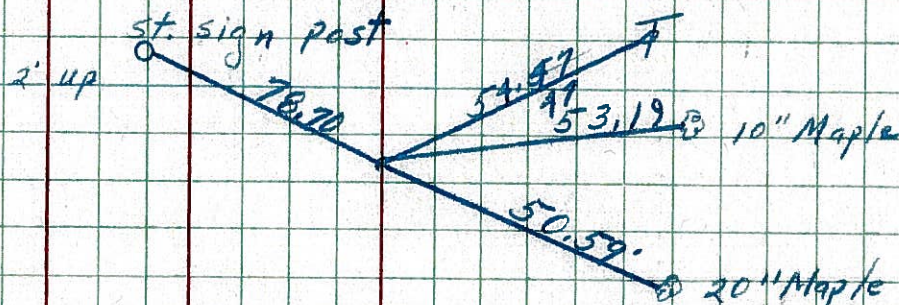


8

P.I.
161+11.26 survey

 $\Delta = 4^\circ 32' 11''$

R.R. spk.

8097

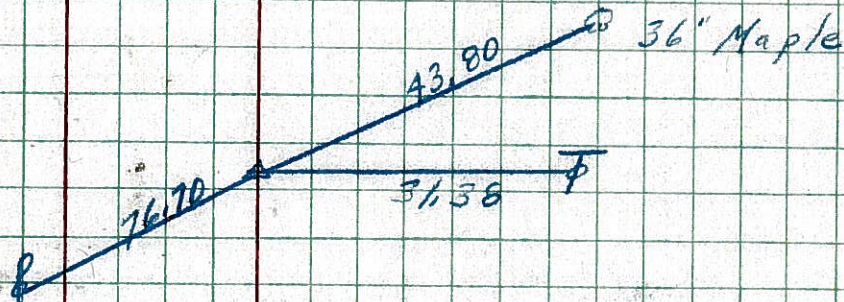


7

P.C.
159+72.89 survey

R.R. spk.

8096

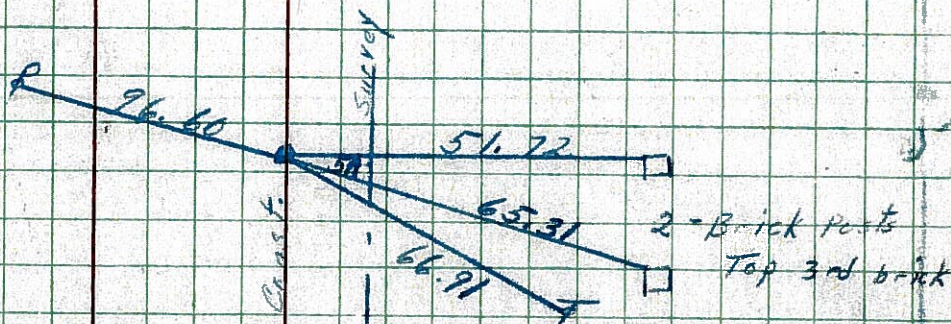

PERSONNEL TITLE PERSONNEL TITLE

Schneider

COUNTY Seneca

DATE 10-16-68

Messer

S. R. 18

WEATHER Fair-Windy

Barbour

SEC. Eastoria to Bascom

TEMP. 78°

Potts


DESCRIPTION Ties for Control Points

JOB NO.

LEFT

CENTER LINE

RIGHT

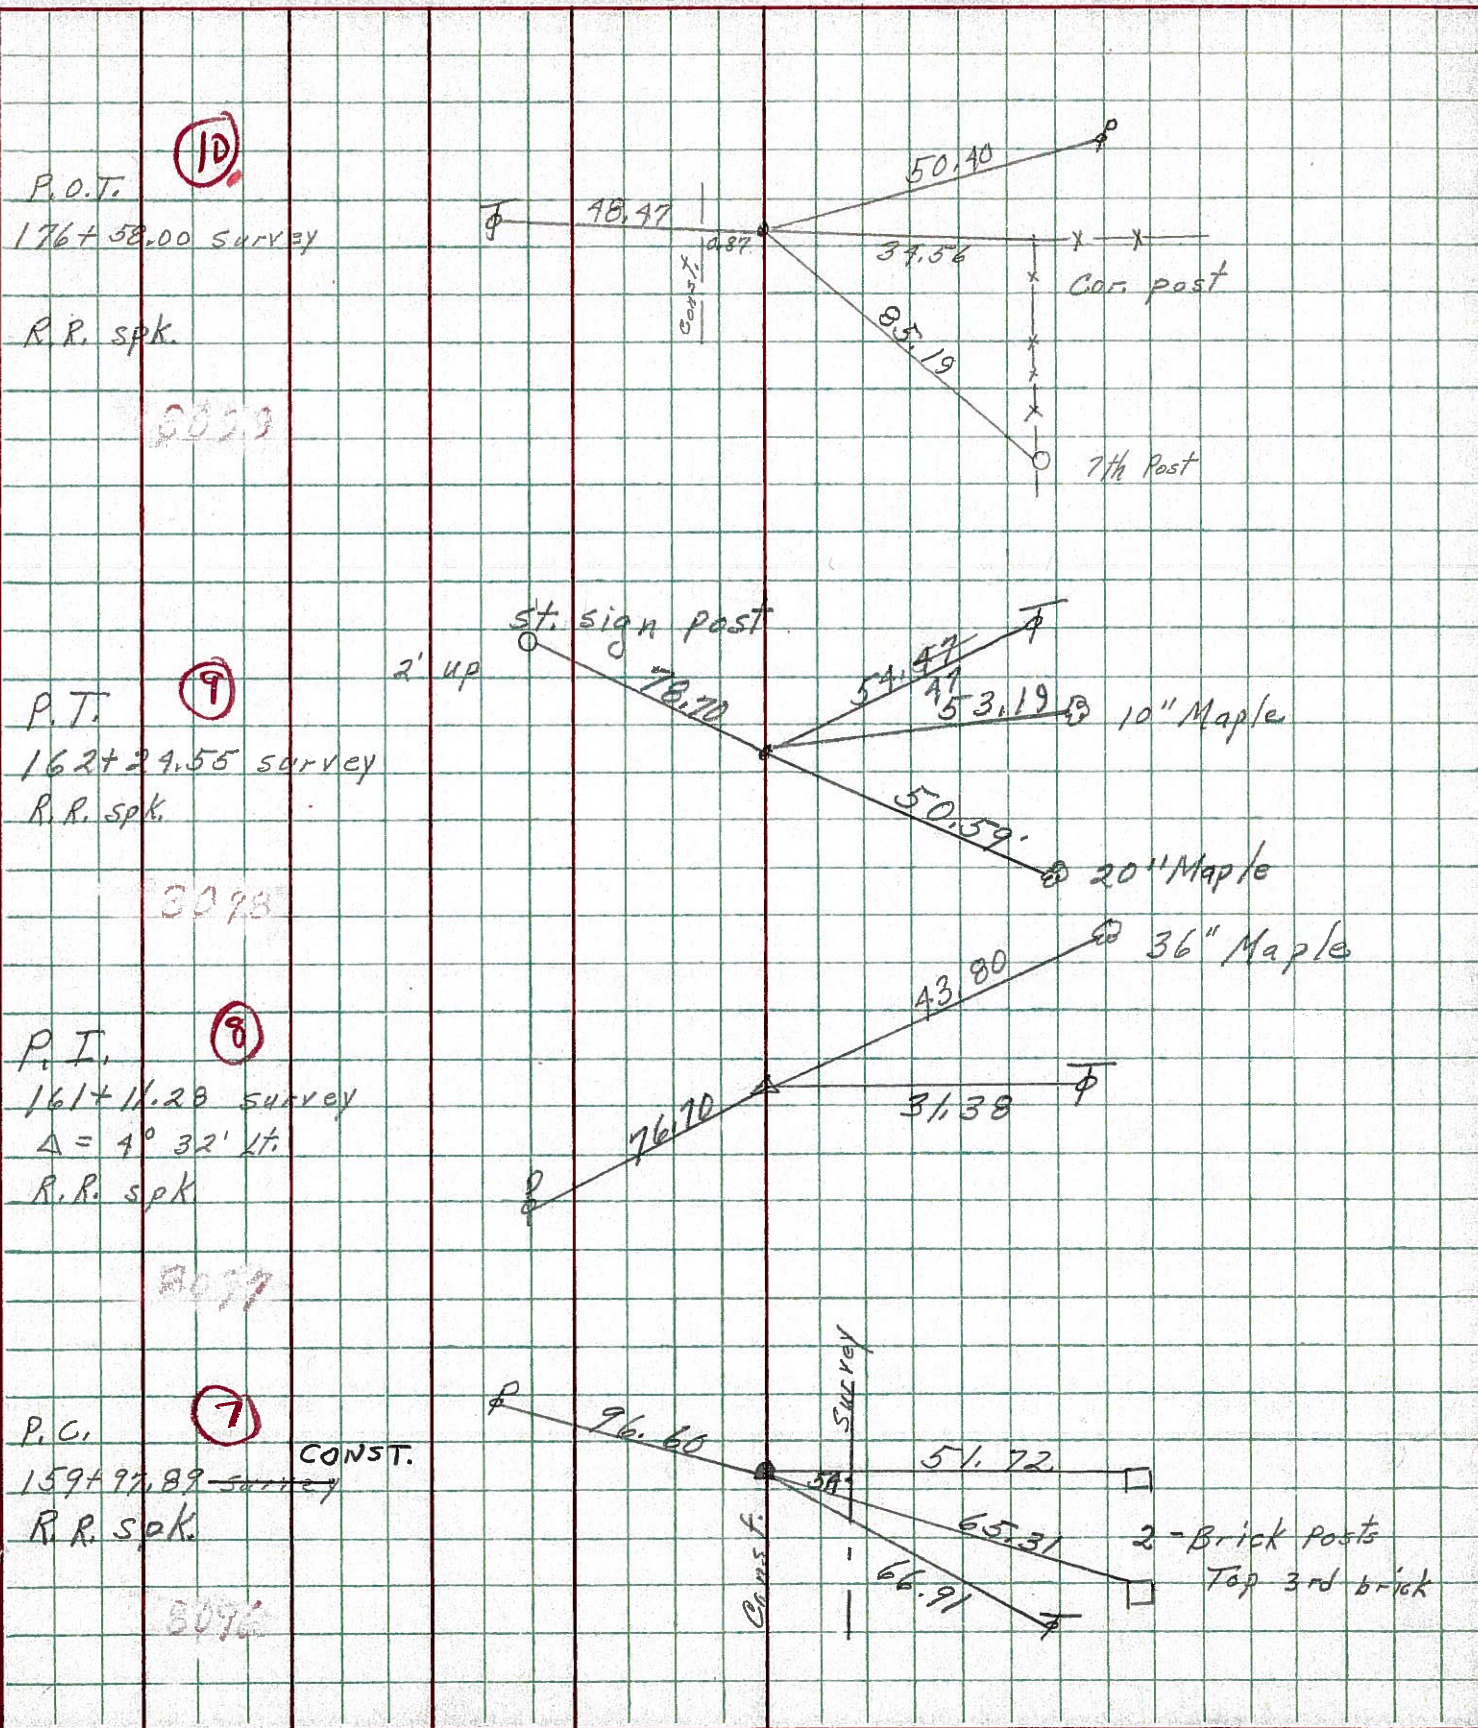

37.81

PERSONNEL TITLE PERSONNEL TITLE

Hsh

COUNTY Seneca

DATE Dec. 4, '58

Cronin

S. R. #18 Foster's - Bascom Rd. WEATHER Cloudy

Leemaster

Lahr.

SEC. Sen-18-(179-860) TEMP. 30°

DESCRIPTION Control Point ties - Survey & Const. JOB NO.

LEFT

CENTER LINE Survey

RIGHT

P.O.T. 200+60.31 Const.

P.O.T. 200+61.31 Survey

P.K. Nail & Shi.

P.K. Nail & Shi.

"X" Intersection of
Survey & Const."X" Intersection of
Const. & SurveyFound R.R. on top
10/29/65

Top 2nd Block

9-1-59 R.R. Spk.

P.O.T. 196+63.75 Plan Survey

P.I. 196+63.75 Survey

A = 0°-29' RT.

R.R. Spk.

Const. Tang.

R.R. spk on top - Did not rotate
(= R/W)

Const. Tang.

P.O.T. 190+00.62 Survey

Twp. Rd.

P.K. Nail & Shi.

P.O.T. 181+40.63

P.K. Nail & Shi.

"X" Intersection of
Survey & Const.

P.O.T. 181+40.63

P.K. Nail & Shi.

"X" Intersection of
Const. & SurveyFound R.R. Spk on top
10/29/65

9-1-59 R.R. Spk.

Const. Tang.

P.O.T. 176+58.00 Survey

R.R. Spk.

N. & Shi. in 7th Fence Post
From East Cor. Post. South Side